



2' BSMNT

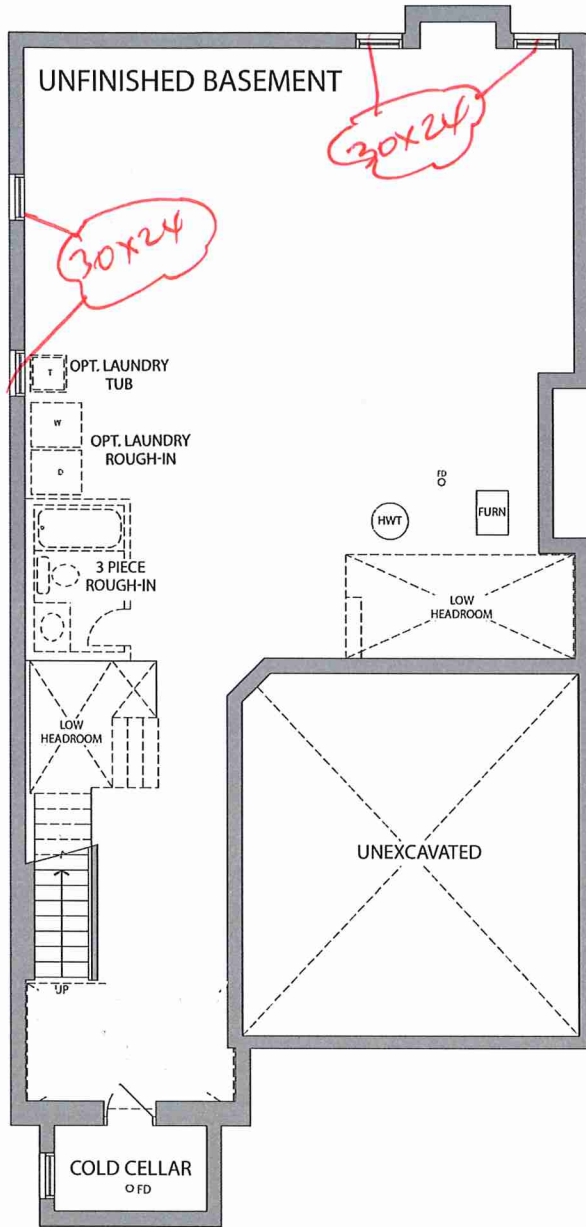


BASEMENT ELEV. A

SIDE DOOR

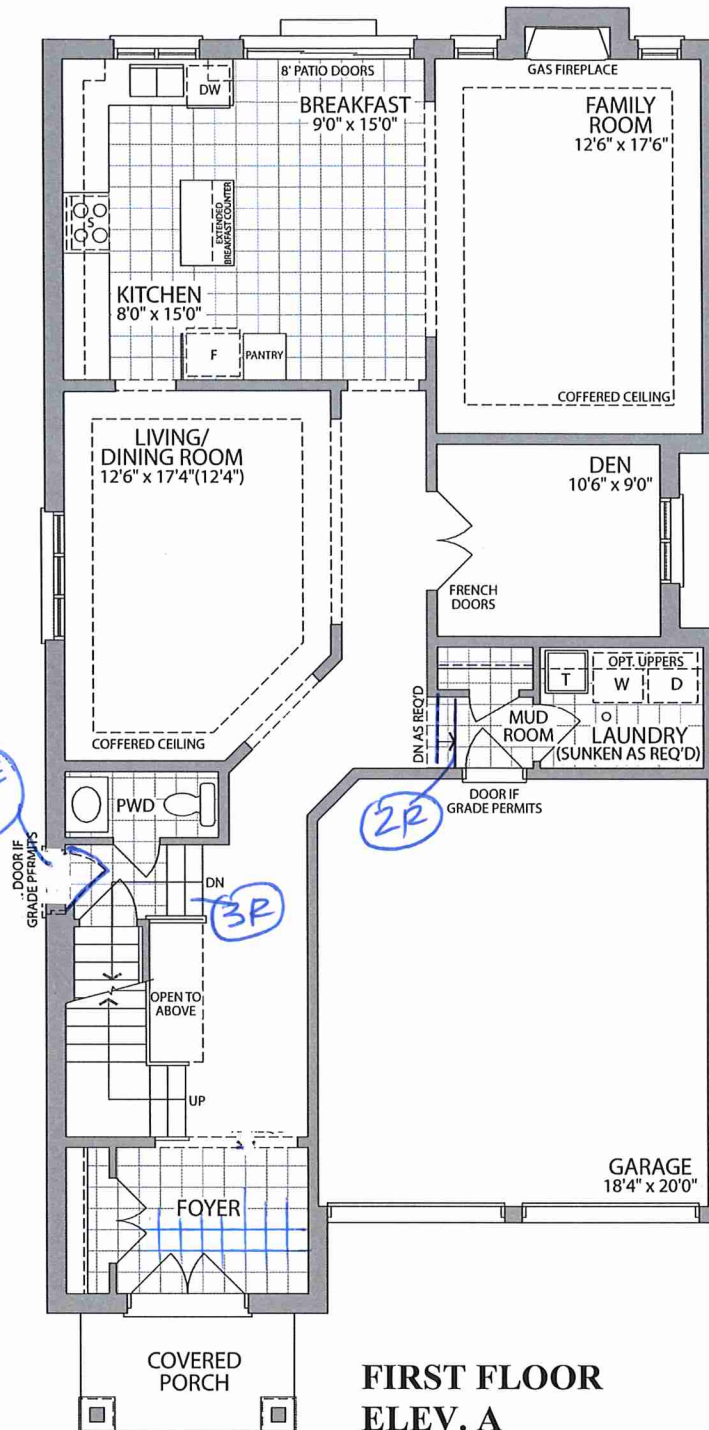

FIRST FLOOR
ELEV. A

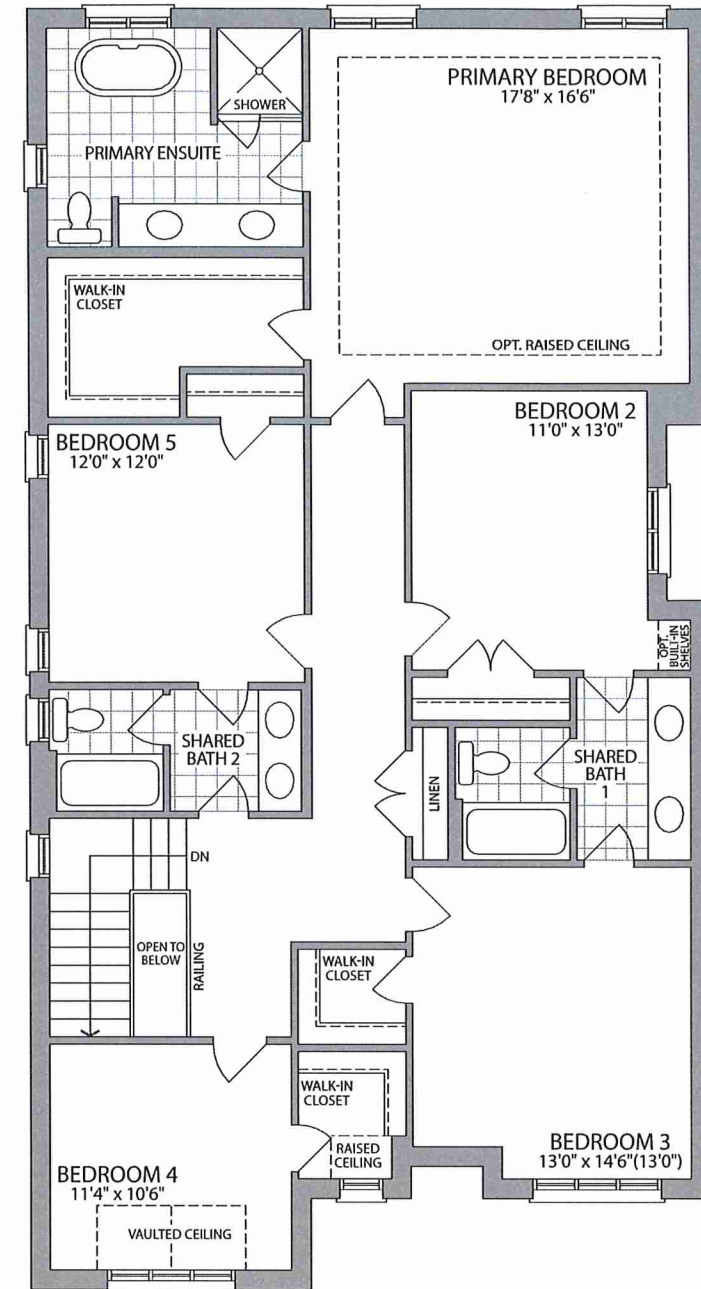

SECOND FLOOR
ELEV. A

Materials, specifications and floor plans are subject to change without notice. All renderings are artist's concept. All floor plans are approximate dimensions. Actual usable floor space may vary from the stated floor area. E.&O.E.

LOT 34. 38-03 . The Blue Elder . El. A. 5 Bedroom . 3215 SQ. FT.



THE BLUE ELDER (38-03)



ELEVATION A

38' LOT 34

3215

SQUARE FEET