

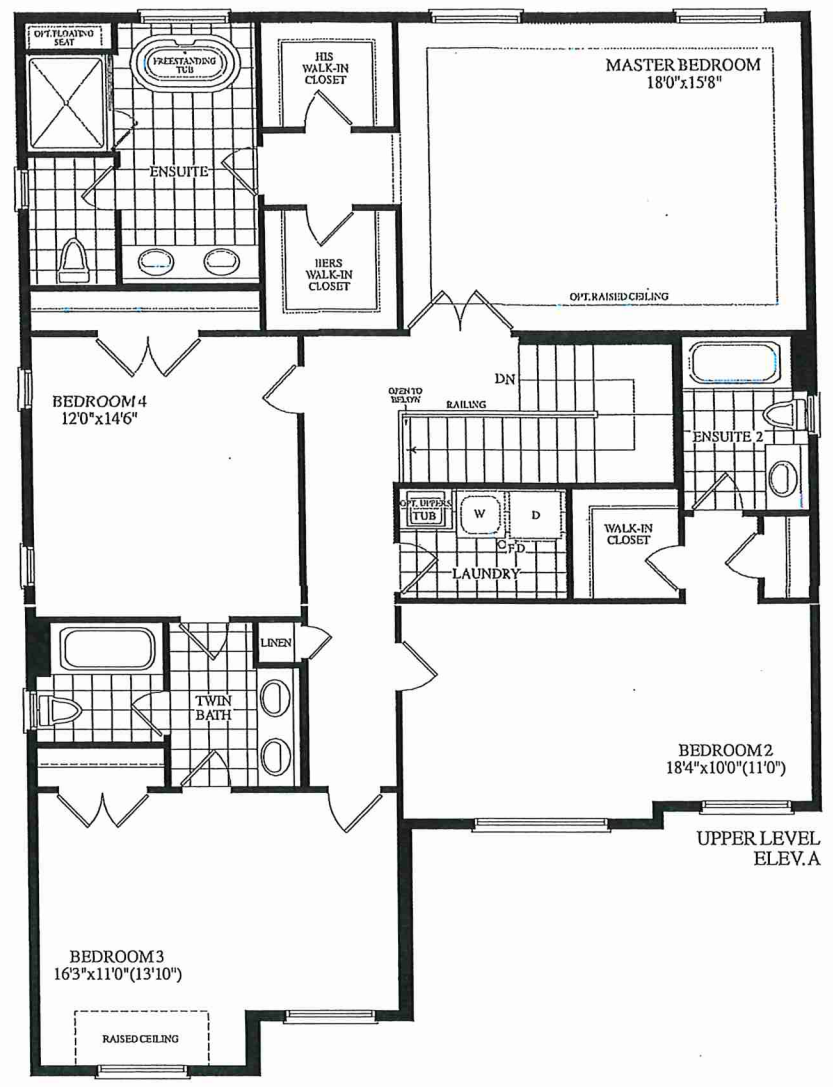


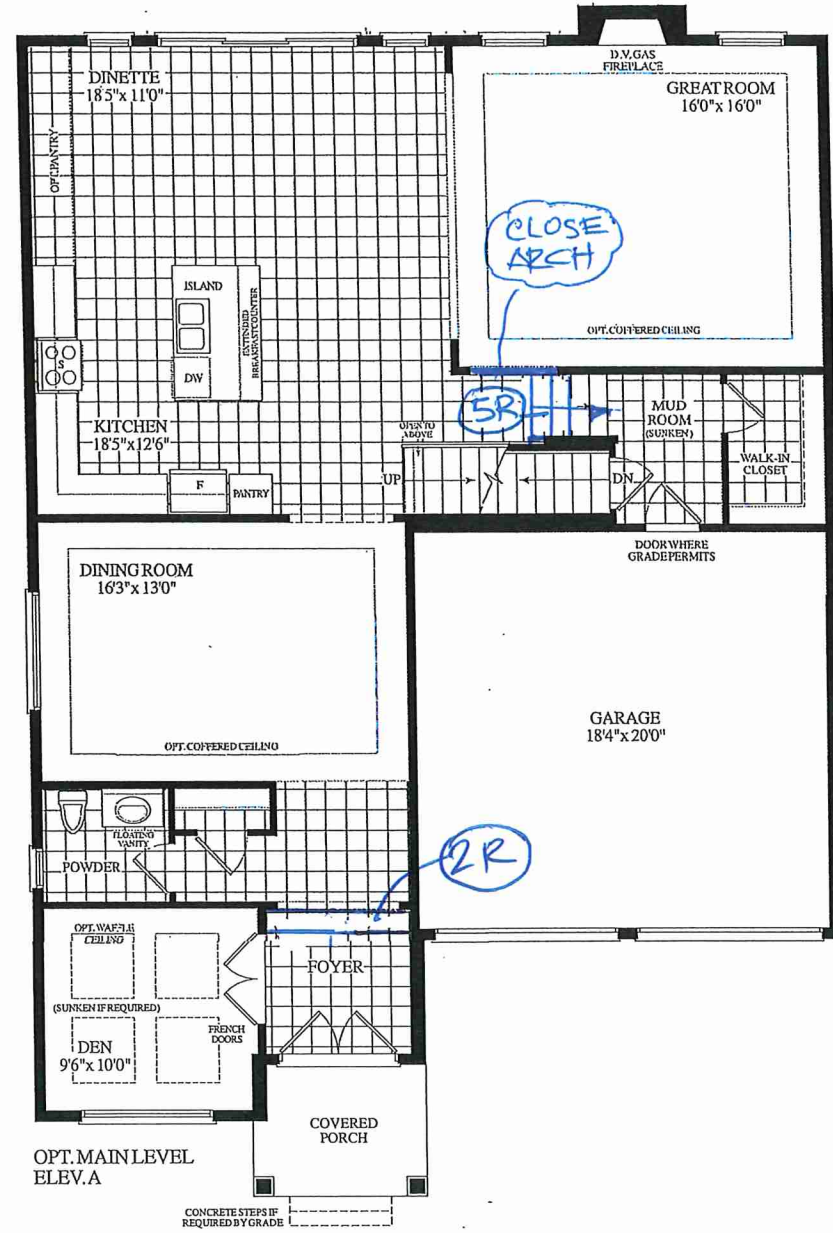

LOT 161. 45-04 DUNCAN . EL. A. OPTIONAL MAIN LEVEL
4 BEDROOM 3225 Sq. Ft.

45' LOTS

THE DUNCAN (45-04)
OPTIONAL LAYOUT

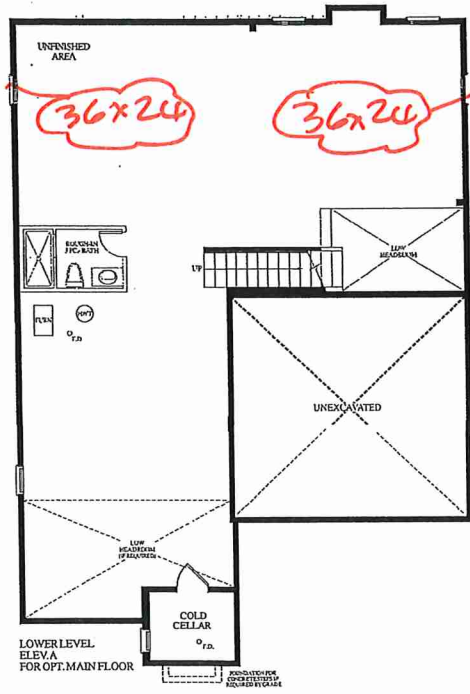

ELEVATION A

3225

SQUARE FEET