

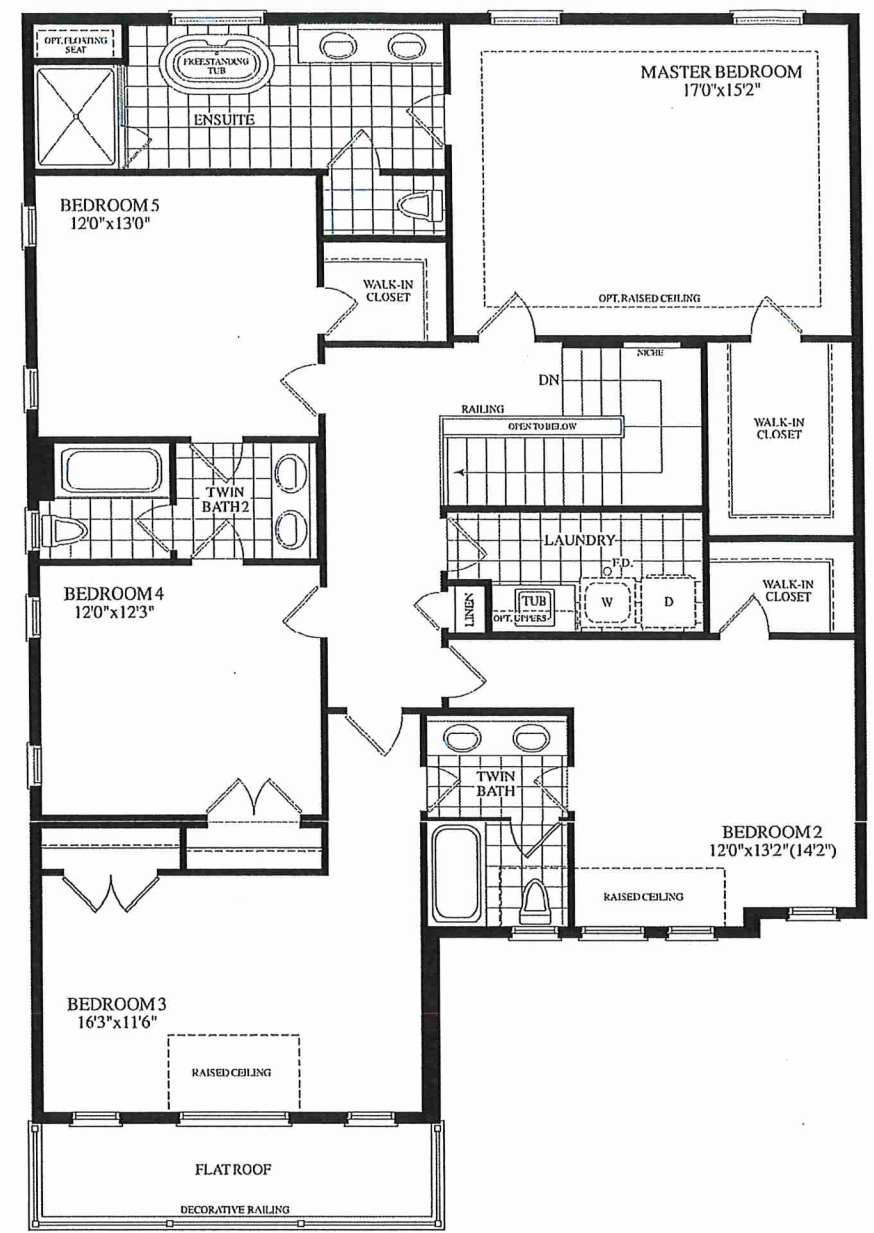


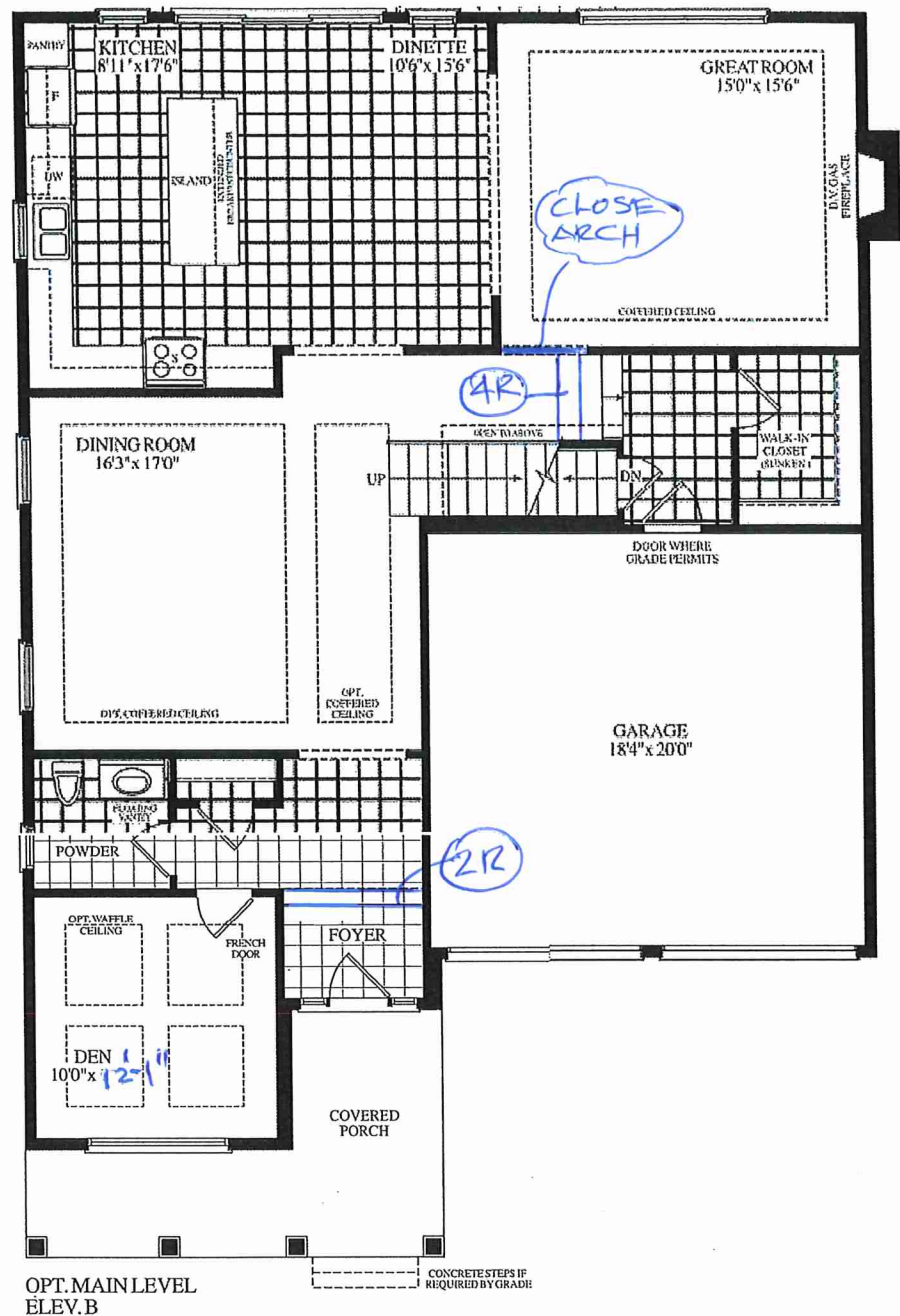

OPT. UPPER LEVEL &
OPT. 5 BEDROOM
UPPER LEVEL
ELEV. B
FOR OPT. MAIN LEVEL
(5 BEDROOM & 4 BATH) &
OPT. MAIN LEVEL

LOT 162 . 45-05 . Elmwood . EL. B. Opt Main 5 Bedroom 3295 sq. ft

45' LOTS | THE **ELMWOOD** (45-05)
OPTIONAL LAYOUT

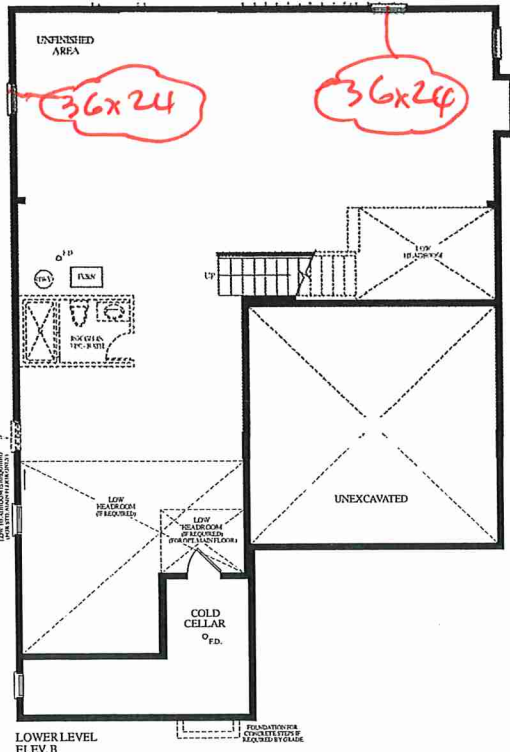

ELEVATION B
3295
SQUARE FEET