

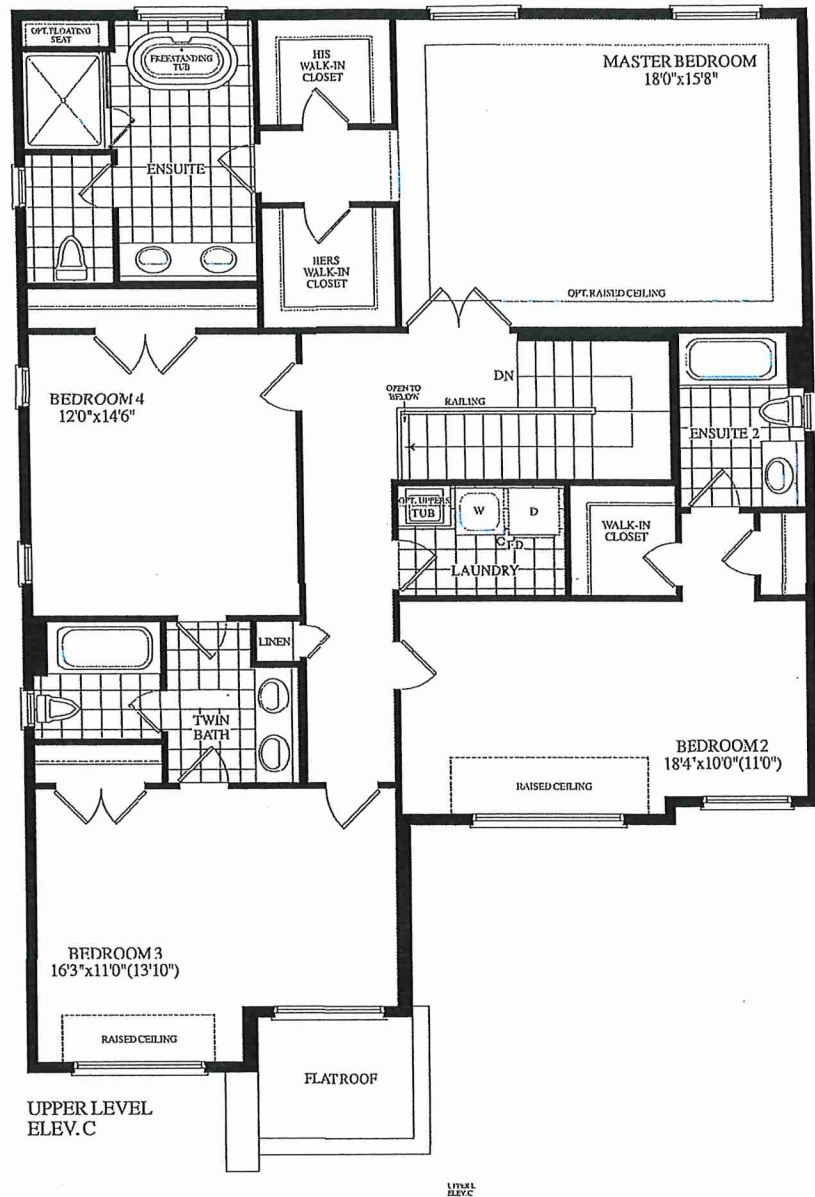


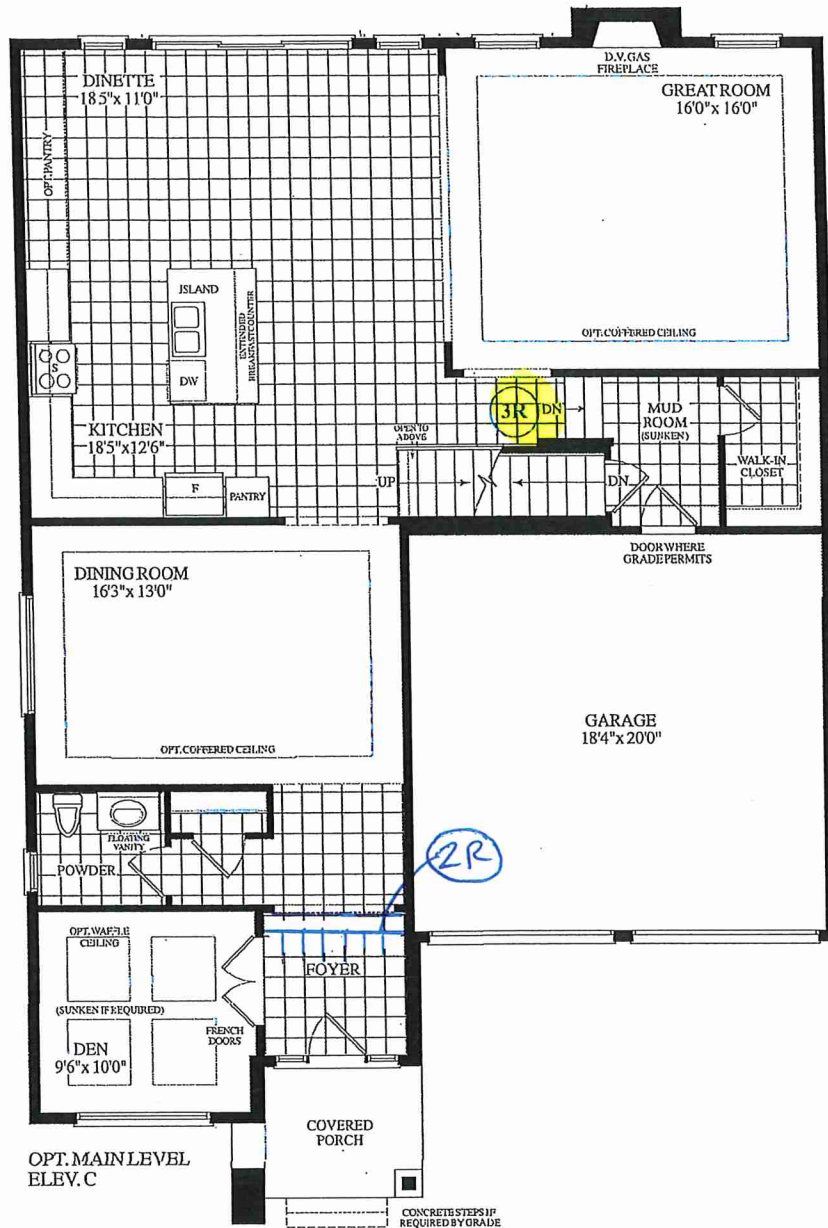

LOT 154 . 45-04 - DUNCAN . OPTIONAL LAYOUT .  
 . EL C . 3225 Sq. Ft.

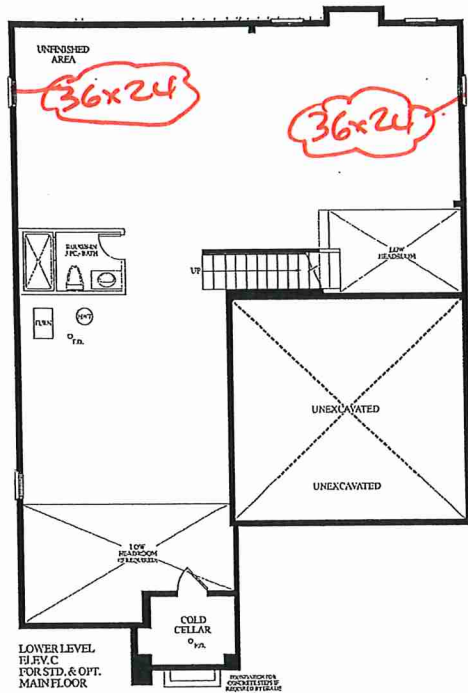

ELEVATION C  
**3225**  
SQUARE FEET