

## SITE PILE COPY

STRUCTURAL

## CONSTRUCTION SUMMARY

Forestside Estates Inc. 12-8

PURCHASER: KARAMJIT, SINGH CHEEMA

TEL:

LOT NUMBER	PHASE	HOUSE TYPE	CLOSING DATE	
29	8	BLUE ELM (38-04A4) - ELEV A - 4 BEDRM	18-Jul-24	

Offer BONUS PACKAGE -PURCHASER TO RECEIVE \$20,000 (INCLUSIVE OF TAXES) WORTH OF UPGRADES AT DECOR CENTRE AT TIME OF COLOUR CHART Note:

Date Added: 16-Aug-23 Invoice Number: 8521

4 - BASEMENT - Increase FOUR (X4) Basement Windows from Standard 30 IN (W) x 16 IN (H) TO LARGER 30 IN (W) x 24 IN (H) (with Possible Window Wells (See Sketch)

Note:

1 - BASEMENT - Install ONE (1) ADDITIONAL BASEMENT WINDOW 30 IN (W) x 24 IN (H) (with Possible Window Well) To be intsalled on right side elevation (See Sketch)

Note:

1 - SIDE EXTERIOR - Install OPTIONAL SIDE DOOR ENTRANCE (Includes Applicable Exterior Coach Light) \*\*If Grade Permits\*\* (See Sketch)

Note

1 - BASEMENT - Install Upgrasde 200 AMP Service in lieu of builders standard 100 Amp (See Sketch)

Note:

1 - KITCHEN - Install ADDITIONAL ROUGH-IN BAR SINK at Kitchen Island \*\*If Possible\*\* (See Sketch)

Location of Sink to be Determined During Decor Appointment

Note: PLEASE NOTE - Price is ONLY for Rough-In Plumbing

\*\*Selection of Bar Sink and Faucet to be Determined During Decor Appointment\*\*

1 - BONUS PACKAGE - PURCHASER HAS APPLIED \$20,000.00 (Incudes Taxes) WORTH OF UPGRADE PROMOTIONAL PACKAGE TOWARDS THE PURCHASE OF STRUCTURAL UPGRADES COMPLETED AT THE DECOR CENTRE

Note: \*\*Remaining Bonus Package of \$6,050.15 (Includes Taxes) will be applied to upgrades completed during decor appointment\*\*

1 - PURCHASER HAS ATTENDED A STRUCTURAL APPOINTMENT AT THE DESIGN STUDIO AND HAS DECLINED ANY ADDITIONAL UPGRADES. Purchaser accepts & acknowledges that there will be no further structural changes/additions/deletions to be made upon signing on AUGUST 16,2023

Note:

1 - PURCHASER AWARE AND ACCEPTS THAT ANY CHANGES MADE TO UPGRADES AFTER SIGNING THIS PURCHASERS EXTRA FORM ARE SUBJECT TO A MINIMUM ADMINISTRATION FEE OF \$1,000

Note:

Date Added: Invoice Number: 8496

1 - BASEMENT - Purchaser has declined the extended 9'-0" basement ceiling height

Note:


1 - PURCHASER AWARE AND ACCEPTS THAT ANY CHANGES MADE TO UPGRADES AFTER SIGNING THIS PURCHASERS EXTRA FORM ARE SUBJECT TO A MINIMUM ADMINISTRATION FEE OF \$1,000

FORN Note:

This Document is Extremely Time Sensitive - Printed <u>5 Sep 23</u> at <u>16:25</u>

StaConstructionSuymmarySQL.rpt 09May22

Page 1 of 1

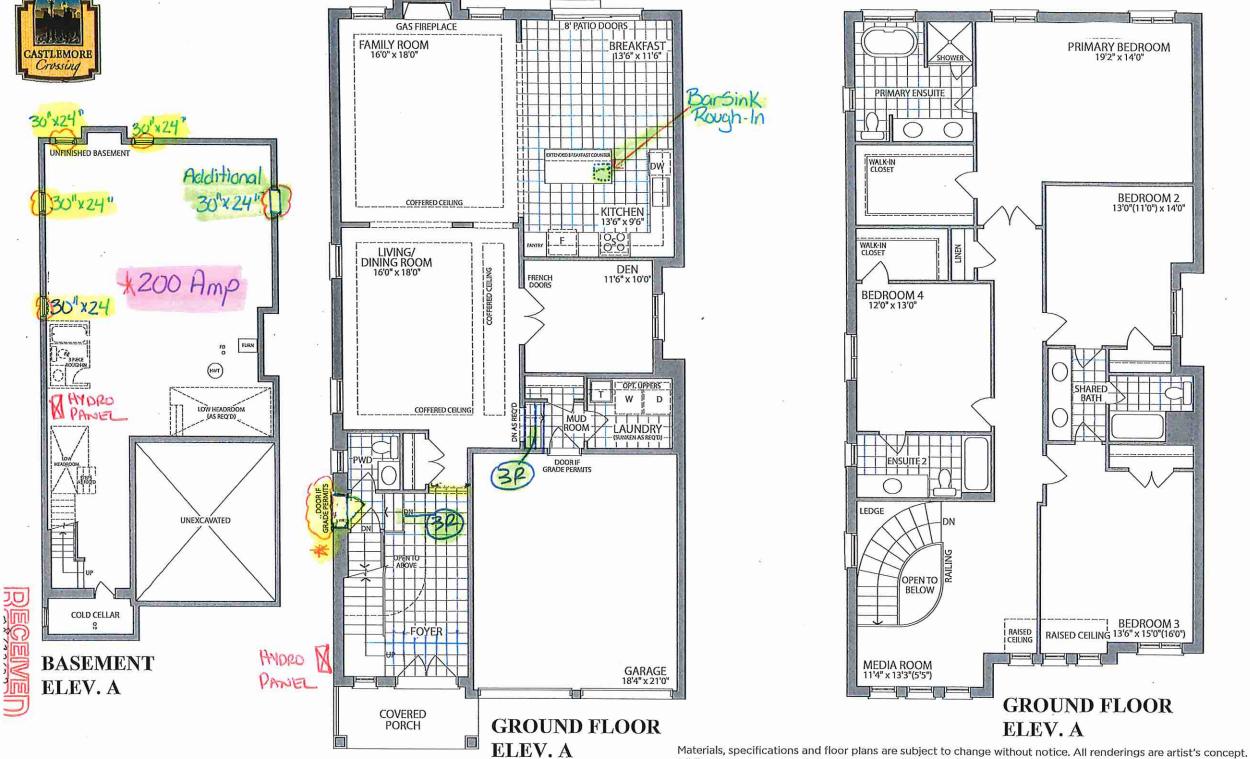

All floor plans are approximate dimensions. Actual usable floor space may vary from the stated floor area. E.&O.E.