



SITE FILE COPY

STRUCTURAL

CONSTRUCTION SUMMARY

Forestside Estates Inc.

PURCHASERS: SANDEEP SINGH CHOHAN and KULWINDER KAUR KOONER

TEL:

LOT NUMBER	PHASE	HOUSE TYPE	CLOSING DATE
22	8	BLUE ELDER (38-03B) - ELEV B	06-Jun-24

Offer	BONUS PACKAGE -PURCHASER TO RECEIVE \$20,000 (INCLUSIVE OF TAXES) WORTH OF UPGRADES AT DECOR CENTRE AT TIME OF COLOUR CHART
Worksheet	Note:

Date Added: 07-Sep-23


Invoice Number: 8533

4 - BASEMENT- Install FOUR (X4) larger basement windows, 30"x24", in lieu of the builders standard. (With possible window wells) (See Sketch) Note:
1 - BASEMENT- AMP- install 200 Amp Service to the home (See Sketch) Note:
1 - LIVING ROOM / DINING ROOM- Purchaser's request to Delete the builders standard Coffered Ceiling in the Living/ Dining Room (See Sketch) Note:
1 - FAMIL YOOM- Purchaser's request to Delete the builders standard Coffered Ceiling in theFamily Room (See Sketch) Note:
1 - PURCHASER HAS ATTENDED A STRUCTURAL APPOINTMENT AT THE DESIGN STUDIO AND HAS DECLINED ANY ADDITIONAL UPGRADES Note:
1 - PURCHASER AWARE AND ACCEPTS THAT ANY CHANGES MADE TO UPGRADES AFTER SIGNING THIS PURCHASERS EXTRA FORM ARE SUBJECT TO A MINIMUM ADMINISTRATION FEE OF \$1,000 Note:
1 - BONUS PACKAGE-PURCHASER TO RECEIVE \$20,000 BONUS PACKAGE-PURCHASER TO RECEIVE \$7,500 (INCLUSIVE OF TAXES) WORTH OF UPGRADES AT THE DESIGN STUDIO AT TIME OF COLOUR CHART Note: Purchaser has a remainin balance of \$16,067.60 BONUS PACKAGE-PURCHASER TO RECEIVE \$7,500 (INCLUSIVE OF TAXES) WORTH OF UPGRADES AT THE DESIGN STUDIO AT TIME OF COLOUR CHART


This Document is Extremely Time Sensitive - Printed 11 Sep 23 at 14:10




KK

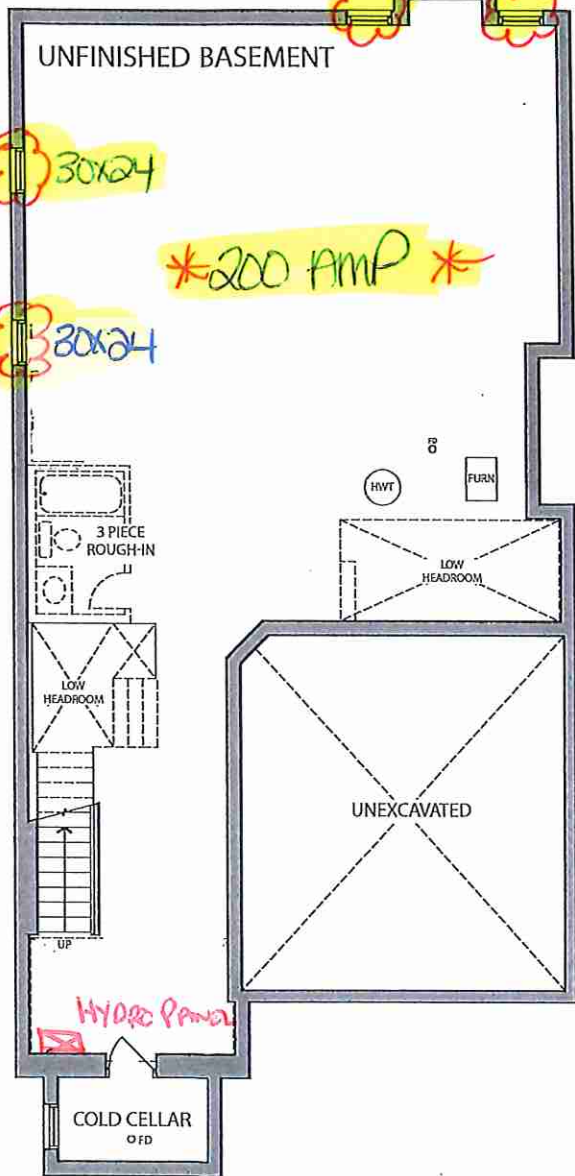

BASEMENT ELEV. B

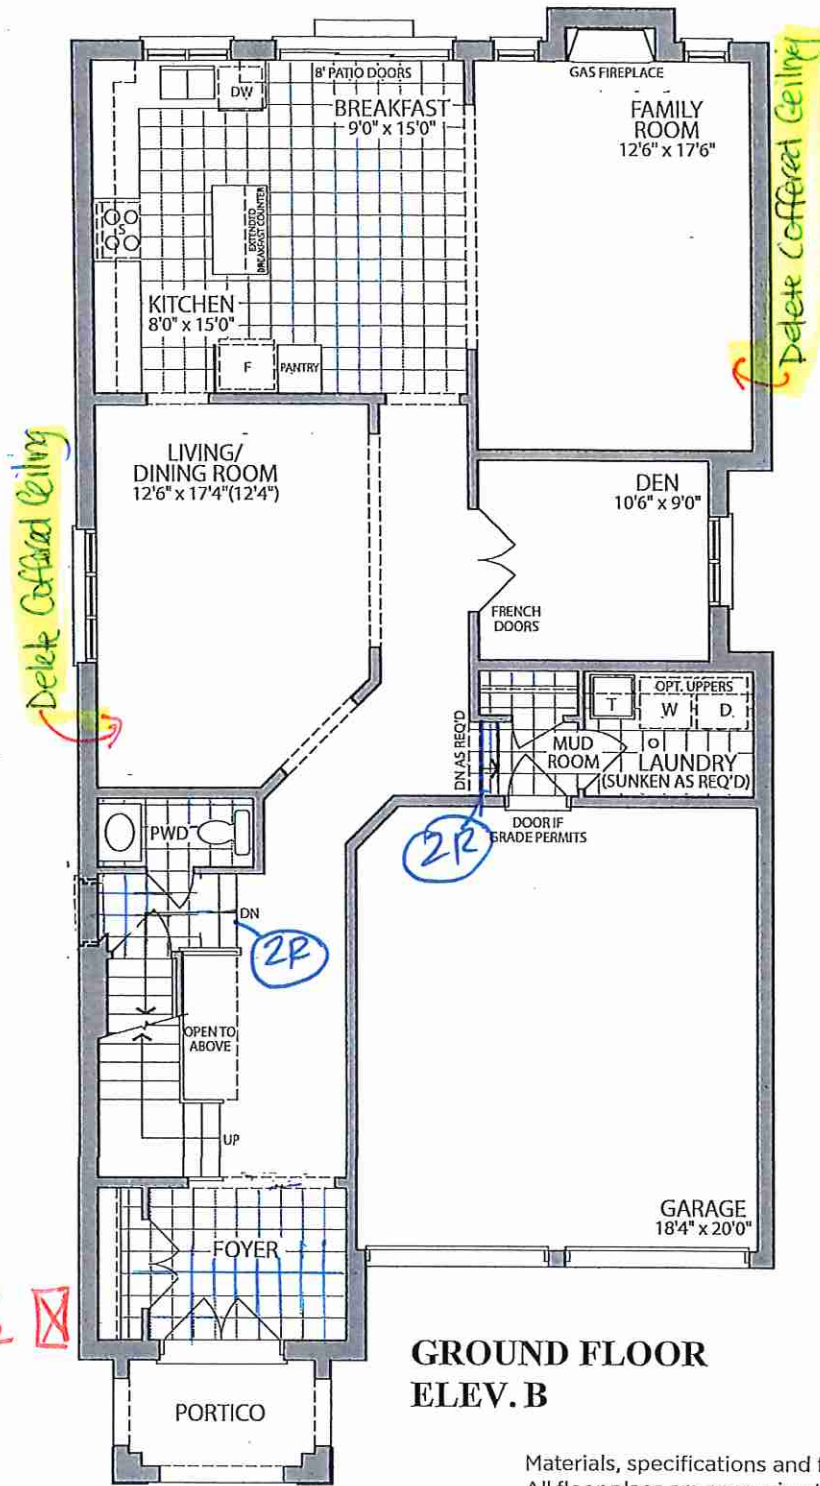

GROUND FLOOR ELEV. B

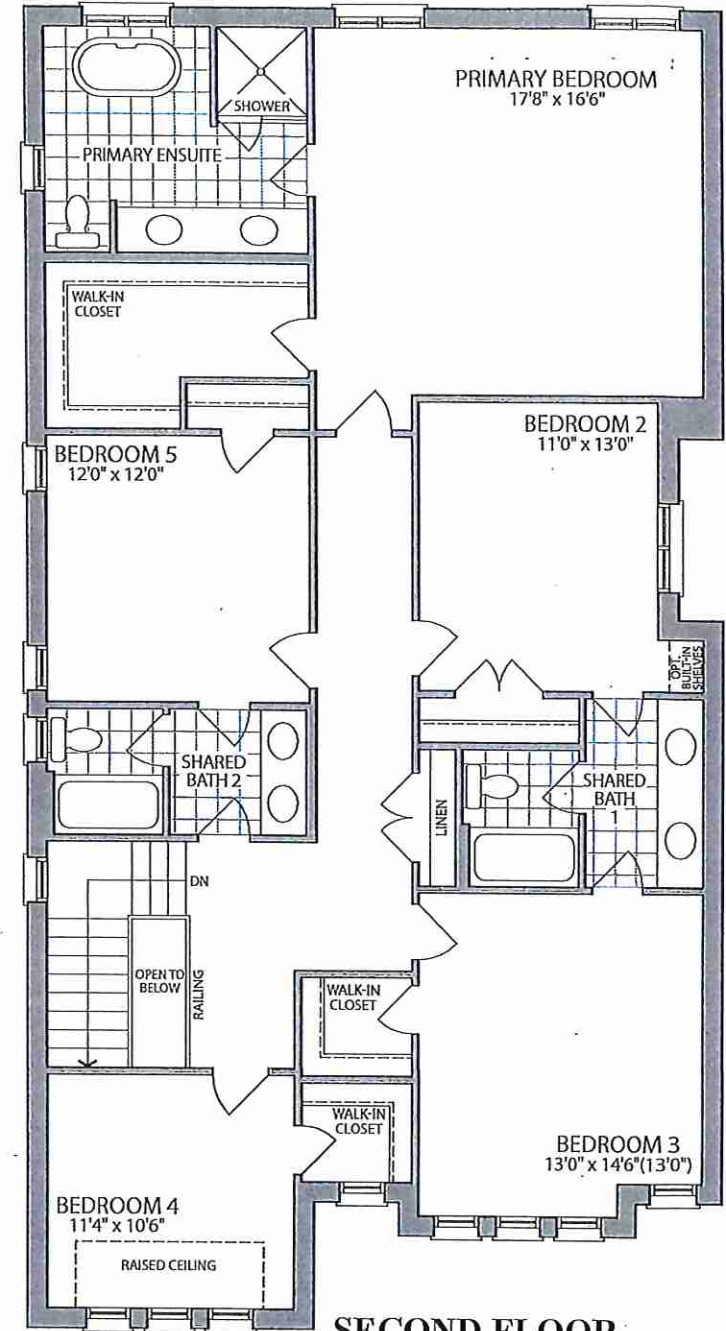

SECOND FLOOR ELEV. B

Materials, specifications and floor plans are subject to change without notice. All renderings are artist's concept. All floor plans are approximate dimensions. Actual usable floor space may vary from the stated floor area. E.&O.E.

LOT 22 . 38-03 . The Blue Elder. EL. B. 5 Bedroom . 3210 .SQ. FT.

RECEIVED
R08123/93