



CONSTRUCTION SUMMARY
Forestside Estates Inc.

PURCHASERS: PRATIK SHAILESHKUMAR MEHTA and KRISHNA PRATIK MEHTA

TEL:

LOT NUMBER	PHASE	HOUSE TYPE	CLOSING DATE
39	8	SILVER POPLAR (40-02A) - ELEV A	19-Jun-24

Date Added: 22-Nov-23 Invoice Number: 8568

1 - Install Standard Cable Rough-Ins (x2) and Install Standard Telephone Rough-Ins (x2) (See Sketch) Note:
1 - BEDROOM #2 - Install ONE (x1) CAT-6 Rough-In at Bedroom #2 (See Sketch) Note:
1 - BEDROOM #3 - Install ONE (x1) CAT-6 Rough-In at Bedroom #3 (See Sketch) Note:
1 - FAMILY ROOM - Install ONE (1) ADDITIONAL ELECTRICAL PLUG at family room. To be installed above fireplace, to accommodate wall mount TV. Plug to be installed Approx. 60" AFF (See Sketch) Note:
1 - FAMILY ROOM - Install Standard Conduit Pipe at family room above fireplace mantle. To accommodate future installation of wall mount TV. Conduit installed beside electrical plug (See Sketch) Note:
1 - PRIMARY BEDROOM - Install ONE (1) ADDITIONAL ELECTRICAL PLUG at primary bedroom. To accommodate future wall mount TV. Plug to be installed Approx. 50" AFF (See Sketch) Note: **Purchaser Declined Upgrade Conduit Pipe**
1 - BEDROOM #2 - Install ONE (1) ADDITIONAL ELECTRICAL PLUG at bedroom #2. To accommodate future wall mount TV. Plug to be installed Approx. 50" AFF (See Sketch) Note: **Purchaser Declined Upgrade Conduit Pipe**
1 - BEDROOM #3 - Install ONE (1) ADDITIONAL ELECTRICAL PLUG at bedroom #3. To accommodate future wall mount TV. Plug to be installed Approx. 50" AFF (See Sketch) Note: **Purchaser Declined Upgrade Conduit Pipe**
1 - LIVING ROOM - In addition to builders standard switch operated plugs, Install ONE (x1) CEILING LIGHT COMPLETE with ONE (x1) SEPERATE SWITCH - To be installed at living room, in line with standard ceiling light at dining room (See Sketch) Note:
1 - FAMILY ROOM - In addition to builders standard ceiling light, Install ONE (x1) ADDITIONAL CEILING LIGHT with ONE (x1) SEPERATE SWITCH - To be installed in line with standard ceiling light at family room. Note:
1 - MAIN FLOOR & SECOND FLOOR - BASEBOARD & CASING - Install UPGRADE 3" COLONIAL BACKBEND CASING WITH 5 1/4" COLONIAL BASEBOARD - To be installed throughout main floor and second floor, where applicable (See Sketch) Note:
1 - MAIN FLOOR & SECOND FLOOR - INTERIOR DOOR HARDWARE - Install UPGRADE MONTREAL SQUARE, SATIN NICKEL with Standard Hinges - To be installed throughout main floor and second floor interior doors, where applicable (See Sketch) Note:
1 - MAIN FLOOR & SECOND FLOOR - INTERIOR DOORS - Install UPGRADE LIVINGSTON Interior Doors - To be installed throughout main floor and second floor, where applicable (See Sketch) Note:
1 - MAIN FLOOR & UPPER HALL - FLOORING - HARDWOOD - Install prefinished 3 1/4" x 3/4" VINTAGE RED OAK TITANIUM (Pearl) in lieu of builders standard prefinished 3 1/4" x 3/4" Vintage Red Oak Natural. To be installed throughout main floor and upper hall. Note: To Include; Main Hall, Living Room/Dining Room, Den, Family Room, Upper Hall and Applicable Landings (See Sketch)
1 - STAIRCASE - Stain Oak Staircase from Main Floor to Second Floor, where applicable. To be Stained - Vintage Red Oak Titanium - To Include; Treads, Risers, Handrail and Post, where applicable (See Sketch) Note:



CONSTRUCTION SUMMARY

Forestside Estates Inc.

PURCHASERS: PRATIK SHAILESHKUMAR MEHTA and KRISHNA PRATIK MEHTA

TEL:

LOT NUMBER	PHASE	HOUSE TYPE	CLOSING DATE
39	8	SILVER POPLAR (40-02A) - ELEV A	19-Jun-24

Date Added: 22-Nov-23 Invoice Number: 8568

1 - STAIRCASE VS FLOORING WOOD SPECIES DIFFERENCE: STAIRCASE - The purchaser was advised and therefore accepts and acknowledges that the wood species of the staircase and flooring chosen do not match. This difference may result in a stain colour variance. Note: The purchaser agrees that the vendor is to be exempt from any and all claims by the purchaser regarding this colour variance.
1 - STAIRCASE VS FLOORING STAINING DIFFERENCE: STAIRCASE - The purchaser was advised and therefore accepts and acknowledges that the stain of the staircase and flooring chosen do not match. This difference might result in an undesirable colour variance. Note: The purchaser agrees that the vendor is to be exempt from any and all claims by the purchaser regarding this colour variance.
1 - STAIRCASE - RAILING - Install UPGRADE PACKAGE #3 - To be installed throughout staircase from main floor to second floor, where applicable (See Sketch) Note: To Include; POST - Tudor PICKETS - Steel 1/2" Square, Plain/Single Collar/Plain with shoes - Flat Black POST - 3 1/2" Square IRP-1/w PC1 Cap
1 - SECOND FLOOR BEDROOMS - FLOORING - Install UPGRADE #1 UNDERPAD (Satin Step) - To be installed throughout bedrooms, where applicable. To Include; Primary Bedroom, Bedroom #2, Bedroom #3, Bedroom #4 and Bedroom #5 (See Sketch) Note: **Install Builders Standard Broadloom as per Color Chart**
1 - KITCHEN - CABINETRY - Purchaser has DECLINED All Kitchen Upgrades through the Decor Centre. Purchaser accepts and acknowledges that their will be a void space NO CABINETRY on fridge wall, where entrance has been closed. Note:
1 - DISCLAIMER - THERMOFOIL CABINETRY; KITCHEN - Purchasers accept & acknowledge that they were advised by vendor to NOT install thermofoil cabinets in kitchen. Due to the vapor & moisture from the stove & dishwasher, the cabinets may result in peeling. Th Note:
1 - KITCHEN - COUNTERTOP - Install Builders Standard Stone Countertop – EMMERSTONE GREY GALAXY with STANDARD " A " EDGE PROFILE - To be installed throughout kitchen, where applicable (does not include stone backsplash) (See Sketch) Note:
1 - DISCLAIMER - STONE COUNTERTOP KITCHEN - Due to the many variables that can affect the pattern, colour and/or design and “pitting” of natural products, granite installed will not be identical to the samples displayed. Note: Every effort is made to provide granite countertops as close as possible but the vendor is not responsible for results which differ from the sample displayed. All countertop surfaces may have seams, and product pattern and shade can change in areas containing seams.
1 - DISCLAIMER - STONE COUNTERTOP KITCHEN - Stone slabs vary in size & all seams are visible & the fabricator reserves the right to position the seams as necessary. Note:
1 - KITCHEN - KITCHEN - Install Builders Standard Undermount Sink - Blanco Horizon U2 (7" Deep) Undermount Sink - Model #401022 Note:
1 - KITCHEN - KITCHEN FAUCET - Install Builders Standard Faucet - MOEN Method Single Handle Pull-Out (Single Hole) Kitchen Faucet - Model # 7585 – Chrome Note:
1 - KITCHEN - POT FILLER - Purchaser has Declined Upgrade Pot Filler Faucet at Decor Centre. Purchaser Requests that Pot Filler Rough-In to be LEFT CAPPED - Purchaser to supply and install their own pot filler faucet AFTER CLOSING (See Sketch) Note: Vendor is Exempt
1 - SHARED BATH #2 - Install TOE TESTER to Shower Stall at Shared Bath #2 - MOEN Eco Performance Posi-Temp Tub/Shower Faucet - Model #TL183EP/62320-Chrome (See Sketch) Note:



CONSTRUCTION SUMMARY

Forestside Estates Inc.

PURCHASERS: PRATIK SHAILESHKUMAR MEHTA and KRISHNA PRATIK MEHTA

TEL:

LOT NUMBER	PHASE	HOUSE TYPE	CLOSING DATE
39	8	SILVER POPLAR (40-02A) - ELEV A	19-Jun-24

Date Added: 22-Nov-23 Invoice Number: 8568

1 - PURCHASER HAS ATTENDED A DECOR APPOINTMENT AT THE DESIGN STUDIO AND HAS DECLINED ANY ADDITIONAL UPGRADES. Purchaser accepts and acknowledges that there will be no further structural changes/additions/deletions to be made upon signing on NOVEMBER 22,2023

Note:

1 - PURCHASER AWARE AND ACCEPTS THAT ANY CHANGES MADE TO UPGRADES AFTER SIGNING THIS PURCHASERS EXTRA FORM ARE SUBJECT TO A MINIMUM ADMINISTRATION FEE OF \$1,000

Note:

Date Added: 07-Sep-23 Invoice Number: 8503

1 - FRONT EXTERIOR- Install additional exterior stone at the front of the house, in lieu of the standard brick. To be installed around the garage doors & between the doors, & around the front door. (See Sketch)

Note: **PLEASE NOTE**Additional stone to have an Approximate 2'-0" return on either side of home (See Sketch)

**Priced As Per Steve C

1 - FRONT EXTERIOR DOOR- Install Extended Height Double Front Doors with Glass. Delete the transom above to accommodate extended height. (See Sketch)

Note:

1 - KITCHEN- Install an 8" Duct in kitchen, above the stove, In lieu of the builders standard 6" (See Sketch)

Note:

1 - KITCHEN/DINING ROOM- Delete the opening between the kitchen and Dining Room area. Install a full wall (See Sketch)

Note: **Purchaser is aware taht teh price above does NOT include builders standard Upper / Lower Cabinets and builders standard counter top

Purchaser to be charged accordingly for additional cbainetry and counter top at time of colour chart if requested

1 - KITCHEN- Install the Pot Filler Rough in ONLY above the stove (See Sketch)

Note: **Purchaser is aware that the above price is only for the rough in and does NOT include the pot filler fixture

Purcaser will have the opportunity to purchase the pot filler faucet at time of colour chart

1 - MASTER ENSUITE- Delete the builders standard framed glass shower door and framed panels, and Install frameless glass shower enclosure (See Sketch)

Note:

1 - MASTER ENSUITE- Install a shower niche for Master Ensuite To include White Quartz stone. Niche to be approximately 16"x24" (See Attached)

Note: **Please Note: Purchaser will have the option to further upgrade the Quartz colour at time of Colour Chart**

Location of Niche to be at Vendors discretion

Vednor will install a Dummy Wall if needed to accommodate the Niche

1 - SHARED BATH #1- Delete the builders standard Tub/Shower and install a shower stall in Shared Bath #1. To include: 2x2 mosaic shower floor, shower curb with with stone top, shower potlight and Frameless Glass shower enclosure. (See Sketch)

Note:

1 - SHARED BATH #1- Install a shower niche for Shared Bath #1. To include White Quartz stone. Niche to be approximately 16"x24" (See Attached)

Note: **Please Note: Purchaser will have the option to further upgrade the Quartz colour at time of Colour Chart**

Vendor will install a Dummy Wall if needed to accommodate the Niche

1 - SHARED BATH #2- Delete the builders standard Tub/Shower and install a shower stall in Shared Bath #1. To include: 2x2 mosaic shower floor, shower curb with with stone top, shower potlight and "Incognito " Framed Glass shower sliders. (See Sketch)

Note:

1 - SHARED BATH #2- Install a floating shower seat for Shared Bath #2 shower stall. Shower seat to be White Quartz (See Sketch)

Note:

1 - PRIMARY BEDROOM- Install the Optional Raised Ceiling in the Primary Bedroom

Note: **PLEASE NOTE** The coffered ceiling in the Primary Bedroom does NOT include Cornice Moulding

The purchaser will have the option to choose and upgrade to install cornice moulding at time of colour chart



CONSTRUCTION SUMMARY

Forestside Estates Inc.

PURCHASERS: PRATIK SHAILESHKUMAR MEHTA and KRISHNA PRATIK MEHTA

TEL:

LOT NUMBER	PHASE	HOUSE TYPE	CLOSING DATE
39	8	SILVER POPLAR (40-02A) - ELEV A	19-Jun-24

Date Added: 07-Sep-23 Invoice Number: 8503

1 - DEN- Install a Coffered ceiling in the Den (See Sketch)

Note: **PLEASE NOTE** The coffered ceiling in the Den does NOT include Cornice Moulding

The purchaser will have the option to choose and upgrade to install cornice moulding at time of colour chart

1 - SECOND FLOOR-Install Smooth ceilings throughout the Second Floor. To include: Upper hall, Primary Bedroom, Bedroom #2, #3, #4 and #5

Note:

1 - FRONT EXTERIOR- In addition to the builders standard Front door Coach Light, Install an additional Coach Light. To be installed on the opposite side and to be on teh same switch as standard coach light (See Sketch)

Note:

1 - BACK EXTERIOR- In addition to the builders standard Back Coach Light, Install an additional Coach Light. To be installed on the opposite side and to be on the same switch as standard coach light (See Sketch)

Note:

1 - SIDE EXTERIOR- Install the optional Side Door, To include the builders standard coach light (See Sketch)

Note:

1 - BASEMENT- AMP- Install 200 Amp Service to the home (See Sketch)

Note:

1 - BEDROOM #2 WIC/LINEN- Decrease the Bedroom #2 WIC by APPROX. 1'-0" Shift the WIC door-To be centred as per the new WIC dimensions. Delete the Linen Closet on the Upper Hall in its entirety (Delete:return walls,door & applicable shelving). (SeeSketch)

Note: **PLEASE NOTE** Purchasers request to leave an open Nook (See Sketch)

1 - LIVING / DINING ROOM: Decrease the Dining Room opening and Install a full wall at the Dining (directly infront of Den). Full wall to be inline with the French Doors (See Sketch)

Note:

1 - PURCHASER AWARE AND ACCEPTS THAT ANY CHANGES MADE TO UPGRADES AFTER SIGNING THIS PURCHASERS EXTRA FORM ARE SUBJECT TO A MINIMUM ADMINISTRATION FEE OF \$1,000

Note:

1 - PURCHASER HAS ATTENDED A STRUCTURAL APPOINTMENT AT THE DESIGN STUDIO AND HAS DECLINED ANY ADDITIONAL UPGRADES

Note:

1 - BONUS PACKAGE-PURCHASER TO RECEIVE \$20,000 (INCLUSIVE OF TAXES) WORTH OF UPGRADES AT THE DESIGN STUDIO AT TIME OF COLOUR CHART

Note:

Date Added: 29-May-23 Invoice Number: 8478

1 - BASEMENT- Purchaser has declined extended height basement ceiling.

Note:

1 - PURCHASER AWARE AND ACCEPTS THAT ANY CHANGES MADE TO UPGRADES AFTER SIGNING THIS PURCHASERS EXTRA FORM ARE SUBJECT TO A MINIMUM ADMINISTRATION FEE OF \$1,000

Note:

This Document is Extremely Time Sensitive - Printed 24 Nov 23 at 9:25



* INTERIOR COLOUR SCHEME *

Purchasers	Decor Consultant	Model and Elevation	Telephone Res. / Bus	Project	Closing Date	Property
RATIK SHAILESHKUMAR MEHTA & KRISHNA PRATIK MEHTA	Melissa Di Marino	SILVER POPLAR (40-02A) - ELEV A	/	Forestside Estates Inc.	19/06/2024	39

Page 1 of 3


Flooring		Wall Tile				Plumbing	
	Description	Main	Accent/Insert	Border / Listello	Pattern		
Primary Ensuite	✓ 13x13 NEW REEDS SILVER (STD)	✓ 8x10 NEW REEDS SILVER (STD)	NONE	NONE	NONE	WHITE	
Shared Bath #1	✓ 13x13 NEW REEDS GREY (STD)	✓ 8x10 NEW REEDS GREY (STD)	NONE	NONE	NONE	WHITE	
Shared Bath #2	✓ 13x13 CINQ GREY (STD)	✓ 8x10 CINQ GREY (STD)	NONE	NONE	NONE	WHITE	
Powder Room	✓ 12x24 H-STONE LIGHT BEIGE (Stacked) (STD)	N/A	N/A	N/A	NONE	WHITE	
Laundry Room	✓ 12x24 H-STONE LIGHT BEIGE (Stacked) (STD)	N/A	N/A	N/A	NONE	STD	
Garage Landing	✓ 12x24 H-STONE LIGHT BEIGE (Stacked) (STD)	N/A	N/A	N/A	NONE	N/A	
Kitchen/Breakfast	✓ 18x18 LIVORNO GRIS (STD)	NONE	NONE	NONE	NONE	STD	
Foyer	✓ 18x18 LIVORNO GRIS (STD)	Railings and Stairs Railings ✓ UPG - Tudor Vintage Red Oak Titanium Pickets ✓ UPG-Steel 1/2" Square Plain/Single Collar-Blk Posts ✓ Upg-31/2" Square RP1/wPC1 Cap-Vint Titanium Stringers ✓ - VINTAGE RED OAK TITANIUM Treads ✓ - VINTAGE RED OAK TITANIUM Risers ✓ - VINTAGE RED OAK TITANIUM Runner NONE Trim Baseboard & Casing ✓ UPGRADE - SEE NOTES Front Door Glass ✓ STANDARD Interior Doors ✓ UPGRADE - LIVINGSTON, SMOOTH Knobs ✓ UPGRADE - Montreal, Square Satin Nickel Hinges ✓ STANDARD Grip Set STANDARD					
Main Hall	✓ 3 1/4"x3/4" Vintage Red Oak Titanium (Pearl) (UPG)					Landing - Upper	✓ 3 1/4" Vintage Red Oak Titanium (Upg)
Family Room	✓ 3 1/4"x3/4" Vintage Red Oak Titanium (Pearl) (UPG)					Landing - Lower	✓ 3 1/4" Vintage Red Oak Titanium (Upg)
Living Room	✓ 3 1/4"x3/4" Vintage Red Oak Titanium (Pearl) (UPG)					Ledge - Upper	N/A
Dining Room	✓ 3 1/4"x3/4" Vintage Red Oak Titanium (Pearl) (UPG)					Ledge - Lower	N/A
Den	✓ 3 1/4"x3/4" Vintage Red Oak Titanium (Pearl) (UPG)						
Upper Hall	✓ 3 1/4"x3/4" Vintage Red Oak Titanium (Pearl) (UPG)			Cornice Moulding / Medalion Foyer NONE Living Room NONE Dining Room NONE Family Room NONE Main Hall NONE Kitchen NONE 2nd Floor Hall NONE			
Primary Bedroom	✓ BROADLOOM - Opening Night - 4002-04 (STD)	Notes BASEBOARD & CASING - Install Upgrade - 3" Colonial Backbend Casing with 5 1/4" Colonial Baseboard ***PRIMARY ENSUITE- Install 2x2 WHITE Mosaic Floor Tiles and 6" Curb with White Quartz ***SHARED BATH #1- Install 2x2 WHITE Mosaic Floor Tiles and 6" Curb with White Quartz ***SHARED BATH #2- Install 2x2 WHITE Mosaic Floor Tiles and 6" Curb with White Quartz					
Bedroom 2	✓ BROADLOOM - Opening Night - 4002-04 (STD)						
Bedroom 3	✓ BROADLOOM - Opening Night - 4002-04 (STD)						
Bedroom 4	✓ BROADLOOM - Opening Night - 4002-04 (STD)						
Bedroom 5	✓ BROADLOOM - Opening Night - 4002-04 (STD)						

Page 1 of 3

Consultant: 
Melissa Di Marino

Purchaser: 
PRATIK SHAILESHKUMAR MEHTA

Purchaser: 
KRISHNA PRATIK MEHTA

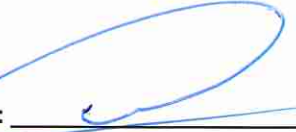Vendor: 
Forestside Estates Inc.
Printed Nov 22, 2023 10:24 am



* INTERIOR COLOUR SCHEME *

Purchasers	Decor Consultant	Model and Elevation	Telephone Res. / Bus	Project	Closing Date	Property
RATIK SHAILESHKUMAR MEHTA & KRISHNA PRATIK MEHTA	Melissa Di Marino	SILVER POPLAR (40-02A) - ELEV A	/	Forestside Estates Inc.	19/06/2024	39

Page 2 of 3

Primary Ensuite

Shared Bath #1

Shared Bath #2

Powder Room

Laundry Room

Garage Landing

Kitchen/Breakfast

Foyer

Main Hall

Family Room

Living Room

Dining Room

Den

Upper Hall

Primary Bedroom

Bedroom 2

Bedroom 3

Bedroom 4

Bedroom 5

Interior Paint
Description
STANDARD - SILVER BIRCH
STANDARD - SILVER BIRCH
Cabinet	Countertop	Counter Edge	Handle / Knob
Style			
EURO MELAMINE - DARK CHOCOLATE 494 (STD)	4925K-07 Calacutta Marble (STD)	STANDARD	9357-37BSN
EURO MELAMINE - WHITE W100 (STD)	1885K-07 MARMO BIANCO (STD)	STANDARD	9770-DBK
EURO KARISMA - FREE SPIRIT L580 (STD)	1876K-52 SPRING CARNIVAL (STD)	STANDARD	9357-37BSN
NY THERMOFOIL - DARK CHOCOLATE (STD)	7022-58 NATURAL CANVAS (STD)	STANDARD	9357-37BSN
EURO MELAMINE - WHITE W100 (STD)	949-58 WHITE MATTE (STD)	STANDARD	9531-PC
N/A	N/A	N/A	N/A
NY THERMOFOIL - FOG GREY (STD)	Emmerstone Grey Galaxy (STD)	" A " EDGE (STD)	9303-96BSN

Appliance Opening/Dimension

Fridge Size	SEE VILLA LAYOUT	Range	SEE VILLA LAYOUT
Built-Ins	None	Microwave	None
Hood Fan	Std 30in	Exhaust Opening	☐ 6" ☒ 8"
Dishwasher Cabinet	SEE VILLA LAYOUT		

Fireplace

Fireplace	☒ FAMILY ROOM	Fireplace	N/A
Location Flooring	☒ 3 1/4" HARDWOOD	Location Flooring	N/A
Style	☒ VILLA NOVA	Style	N/A
Finish	STONE	Finish	N/A
Marble	N/A	Marble	N/A
Hearth	NONE	Hearth	N/A

Notes

**KITCHEN - INSTALL BUILDERS STANDARD STAINLESS STEEL EXHAUST FAN

Page 2 of 3

Decor Consultant: 
Melissa Di Marino

Purchaser: 
PRATIK SHAILESHKUMAR MEHTA


Purchaser: 
KRISHNA PRATIK MEHTA

Vendor: 
Forestside Estates Inc.
Printed Nov 22, 2023 10:24 am




Cable - (x2)
Telephone - (x2)
Electrical (x4)
Conduit (x1)


CAT6 (x2)

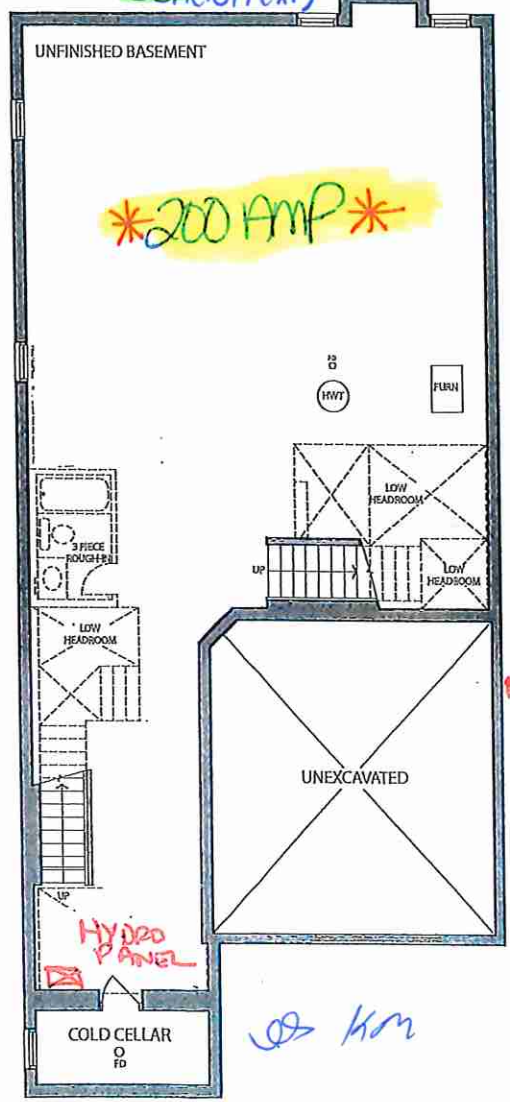

BASEMENT ELEV. A

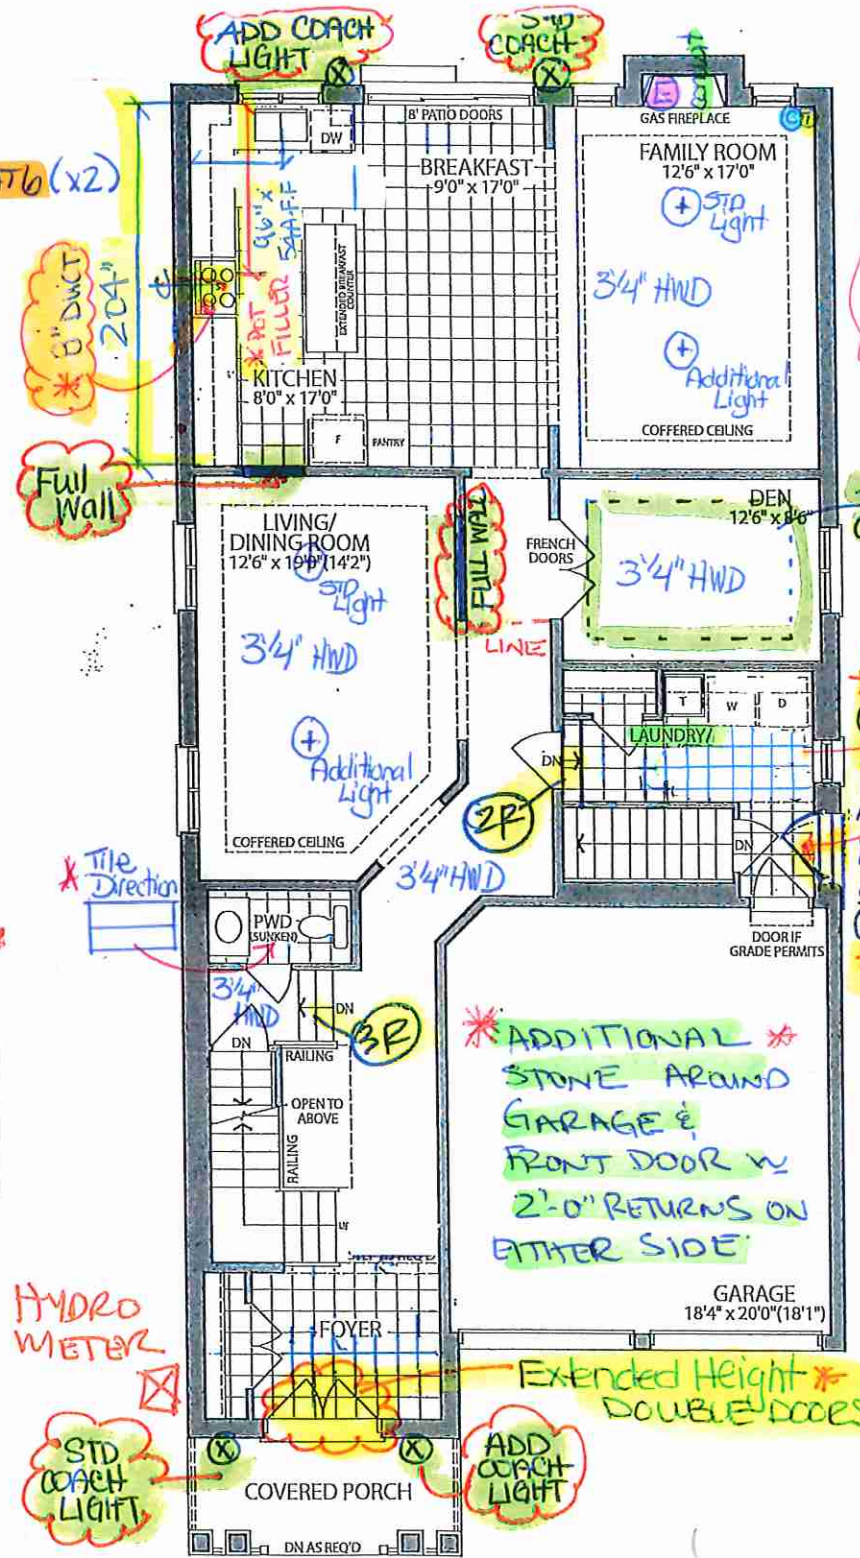

GROUND FLOOR ELEV. A

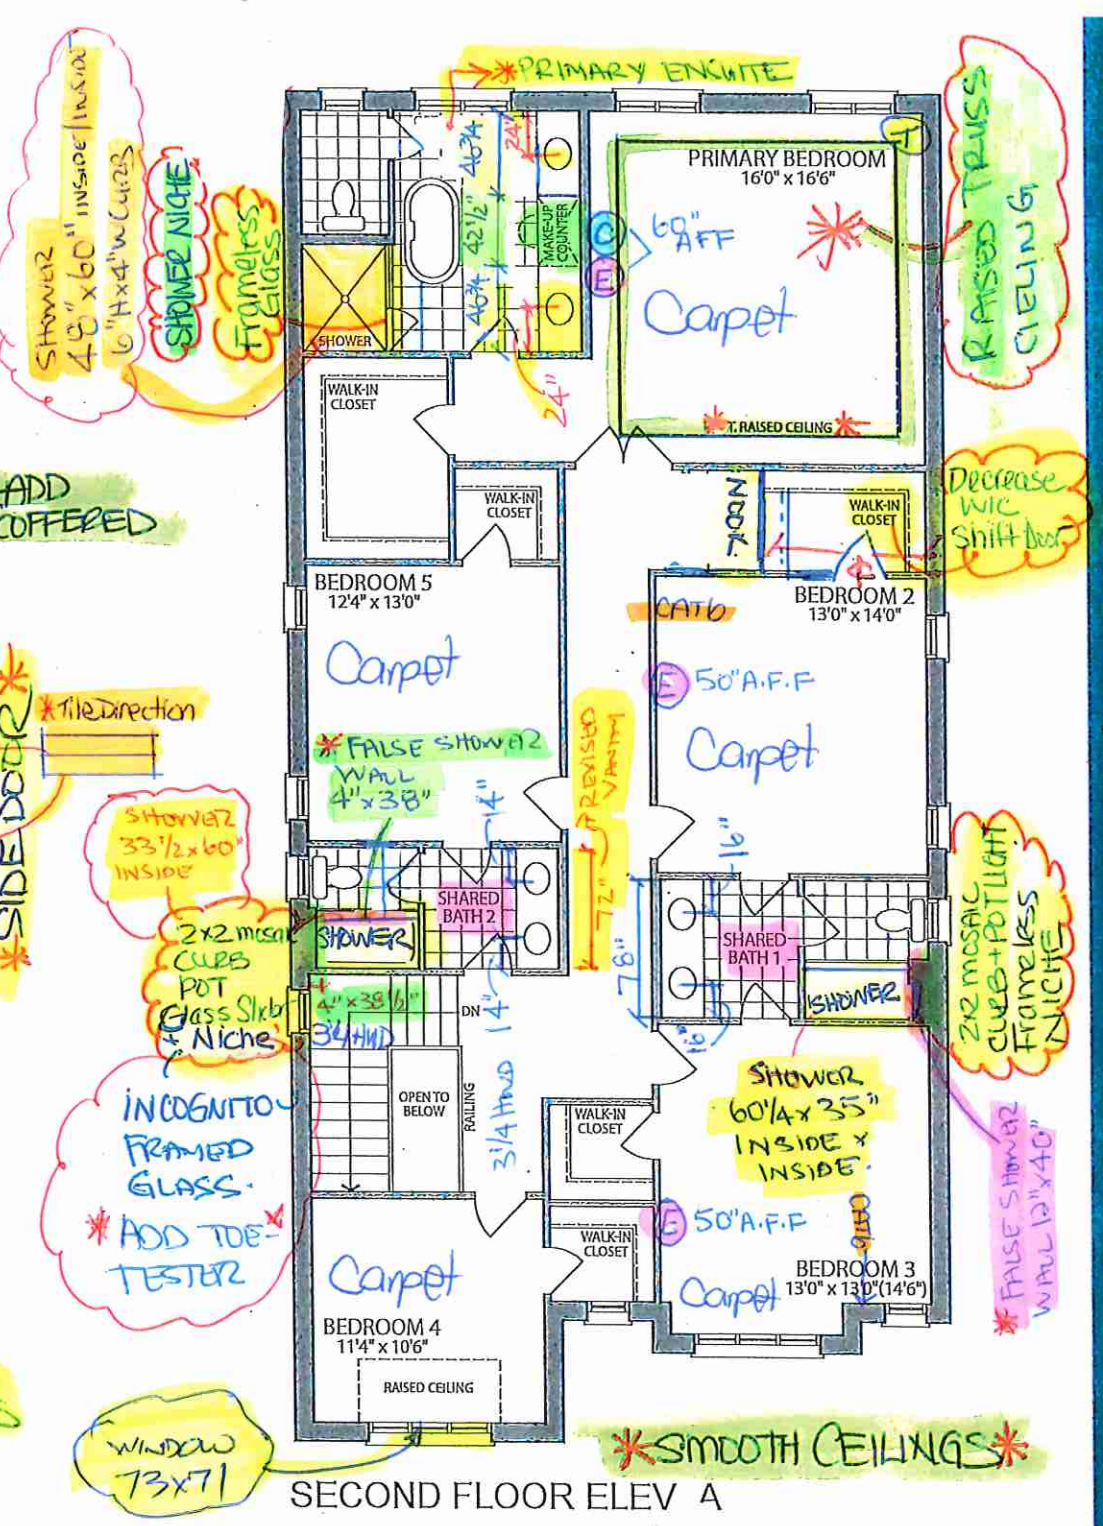

SECOND FLOOR ELEV. A

s, specifications and floor plans are subject to change without notice. All renderings are artist's concept. plans are approximate dimensions. Actual usable floor space may vary from the stated floor area. E.&O.E.

LOT 39 . 40-02 . Silver Poplar . El.A . 5 Bedroom . 3495 SQ. FT.

Villa

KITCHENS & FINE CABINETRY LTD

8111 Jane St. Unit 10
Concord, Ontario L4K 4L7
Tel. (905) 669- 7028
Fax. (905) 669 - 7903
email: designstudio@villakitchens.ca
www.villakitchens.ca

CLIENT: ROYAL PINE

PROJECT: FORESTSIDE PH 8

ADDRESS:

MODEL: 40-02-ELEV A B C

KITCHEN


DRAWN BY: LAI -YEE

DATE: JULY 06, 2023

REVISION: NOVEMBER 8, 2023

SCALE:

PAGE: 1 OF 8

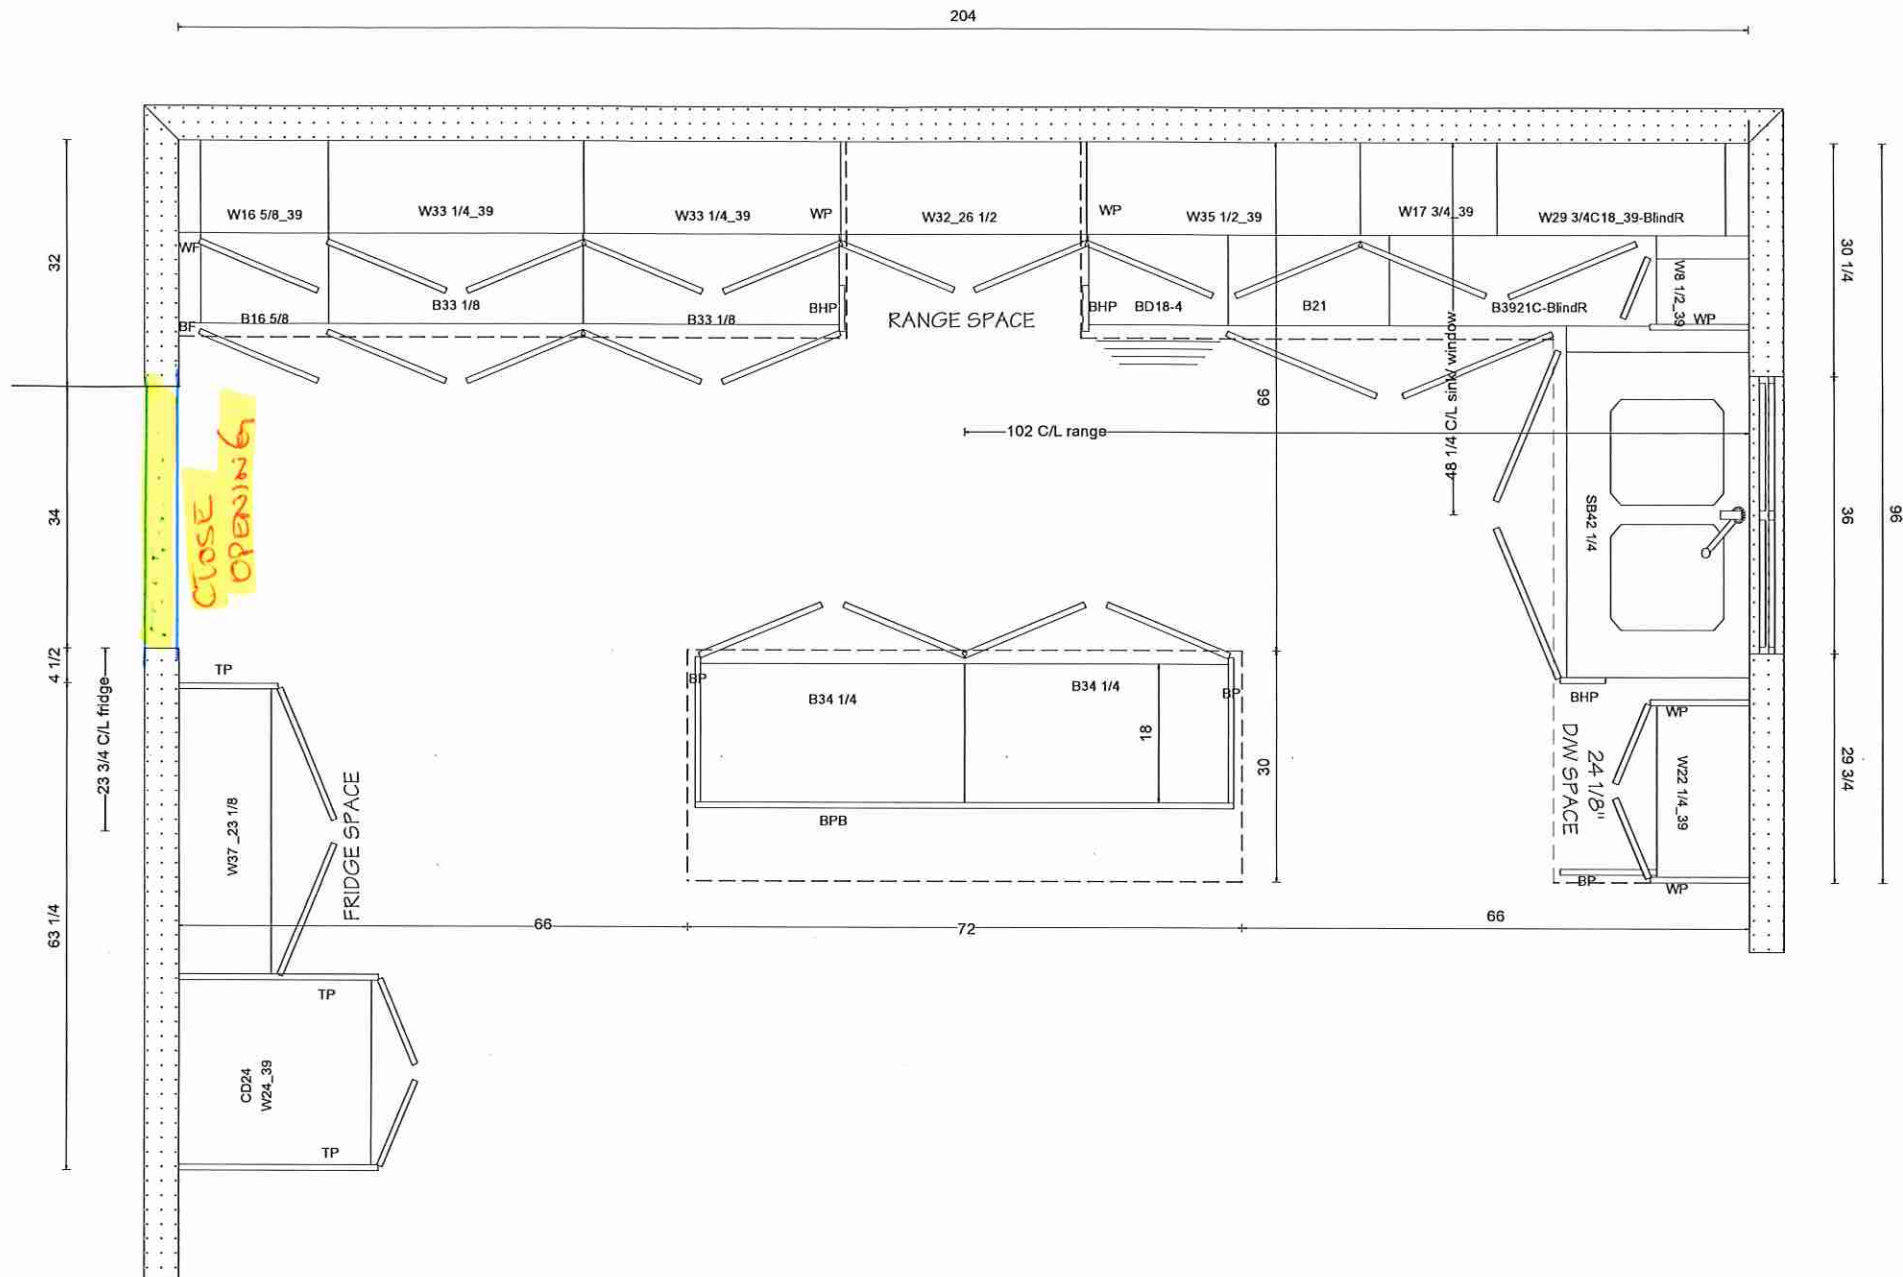

Lot 39 Forestside (Ph8)




KITCHENS & FINE CABINETRY LTD

8111 Jane St. Unit 10
Concord, Ontario L4K 4L7
Tel. (905) 669- 7028
Fax. (905) 669 - 7903
email: designstudio@villakitchens.ca
www.villakitchens.ca

CLIENT: ROYAL PINE
PROJECT: FORESTSIDE PH 8
ADDRESS:
MODEL: 40-02-ELEV A B C

RANGE WALL

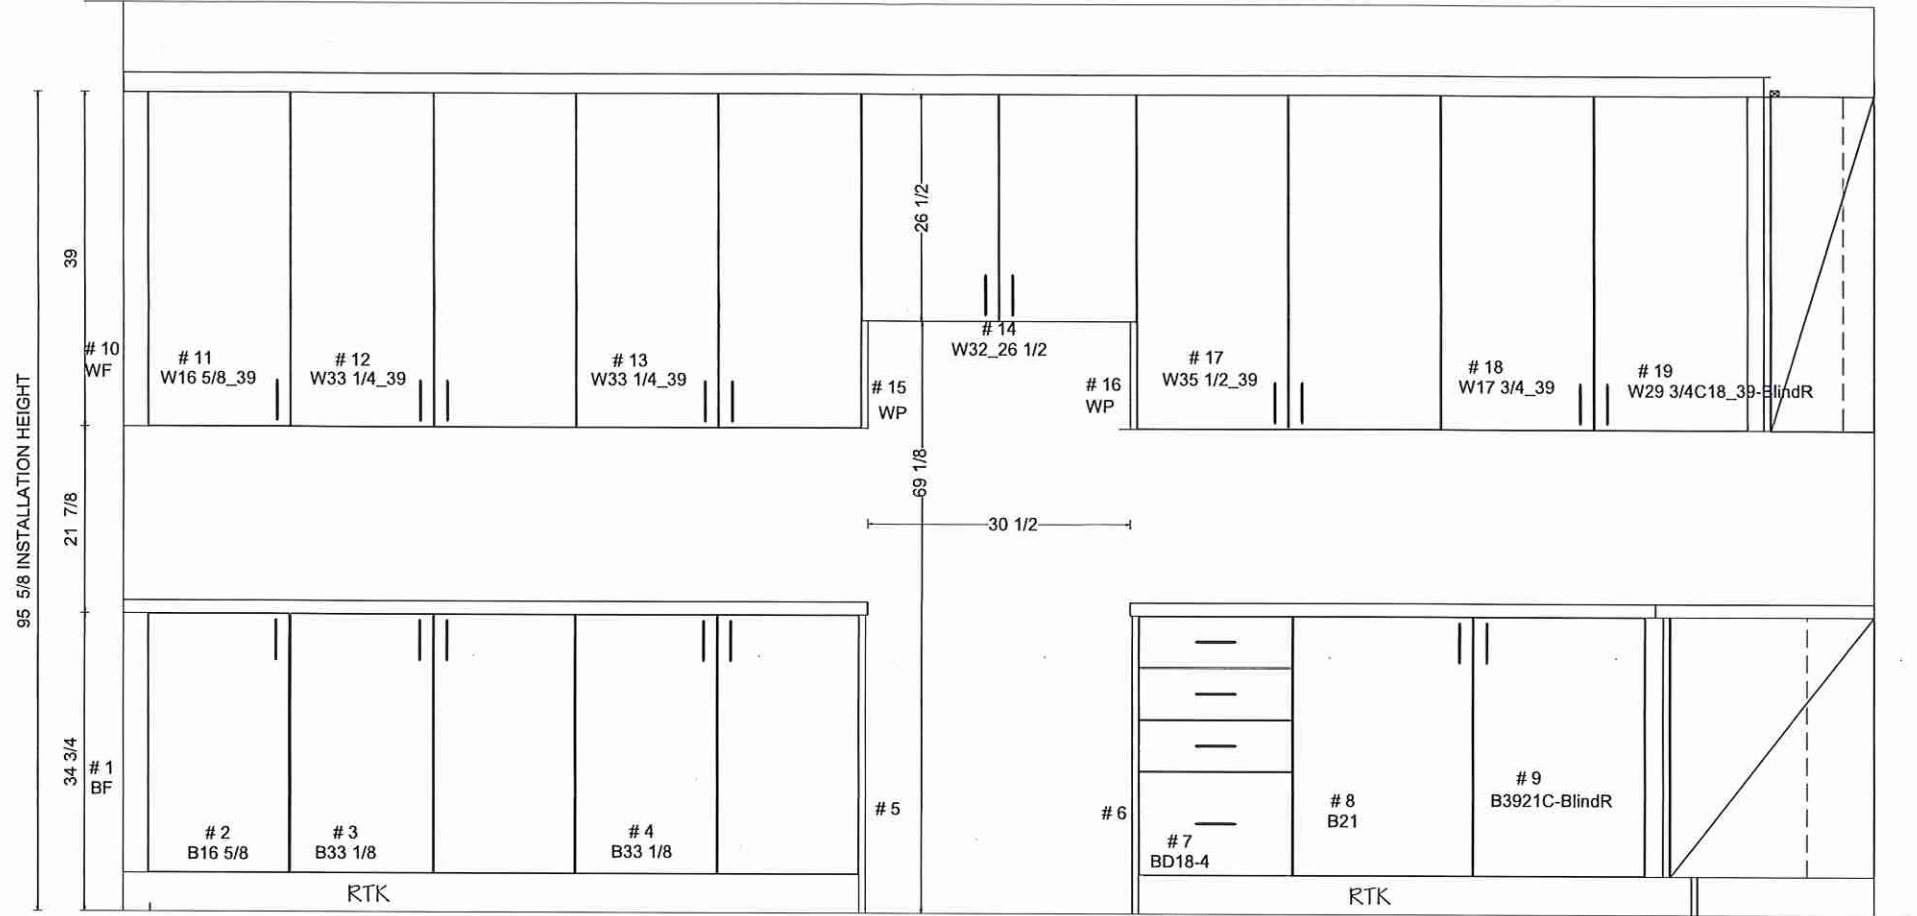

DRAWN BY: LAI -YEE
DATE: JULY 06, 2023
REVISION: NOVEMBER 8, 2023
SCALE:
PAGE: 2 OF 8

Lot 39 Forestside (Ph8)





KITCHENS & FINE CABINETRY LTD

8111 Jane St. Unit 10
Concord, Ontario L4K 4L7
Tel. (905) 669- 7028
Fax. (905) 669 - 7903
email: designstudio@villakitchens.ca
www.villakitchens.ca

CLIENT: ROYAL PINE
PROJECT: FORESTSIDE PH 8
ADDRESS:
MODEL: 40-02-ELEV A B C

SINK WALL & FRIDGE WALL

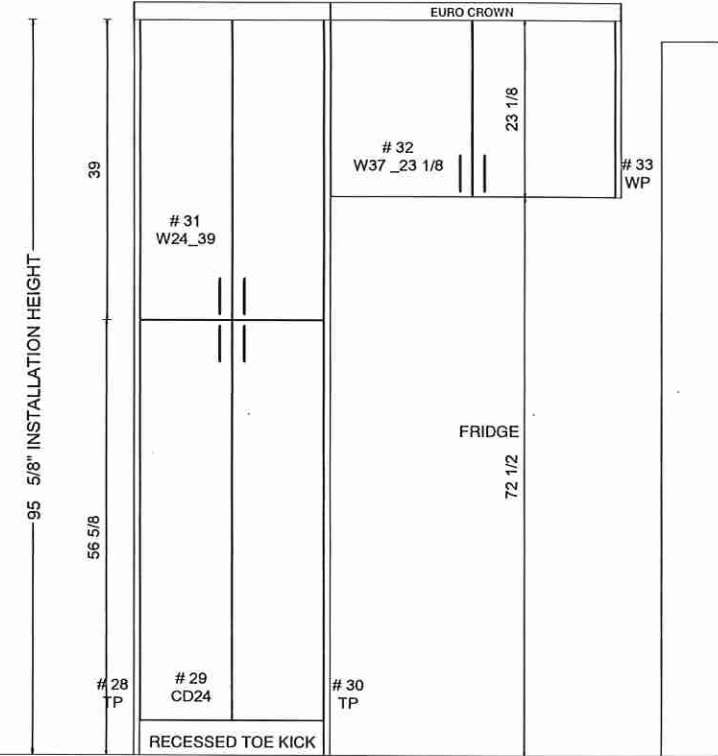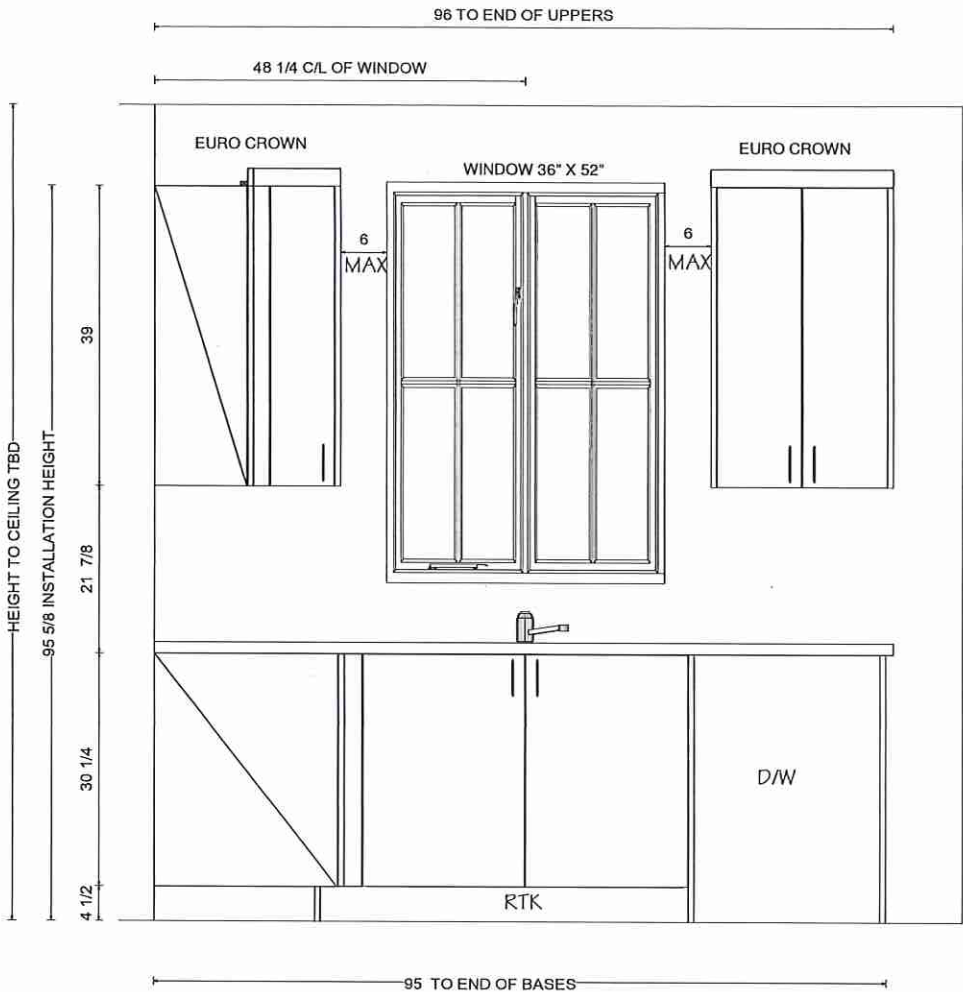

DRAWN BY: LAI -YEE
DATE: JULY 06, 2023
REVISION: NOVEMBER 8, 2023
SCALE:
PAGE: 3 OF 8

Lot 39 Forestside (Ph8)

Villa

KITCHENS & FINE CABINETRY LTD

8111 Jane St. Unit 10
Concord, Ontario L4K 4L7
Tel. (905) 669- 7028
Fax. (905) 669 - 7903
email: designstudio@villakitchens.ca
www.villakitchens.ca

CLIENT: ROYAL PINE

PROJECT: FORESTSIDE PH 8

ADDRESS:

MODEL: 40-02-ELEV A B C

ISLAND



DRAWN BY: LAI - YEE

DATE: JULY 06, 2023



REVISION: NOVEMBER 8, 2023

SCALE:

PAGE: 4 OF 8

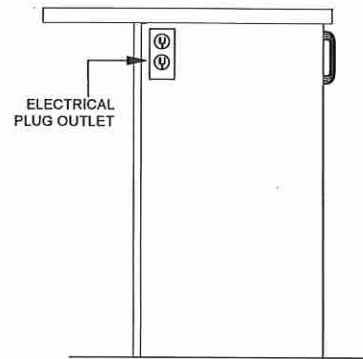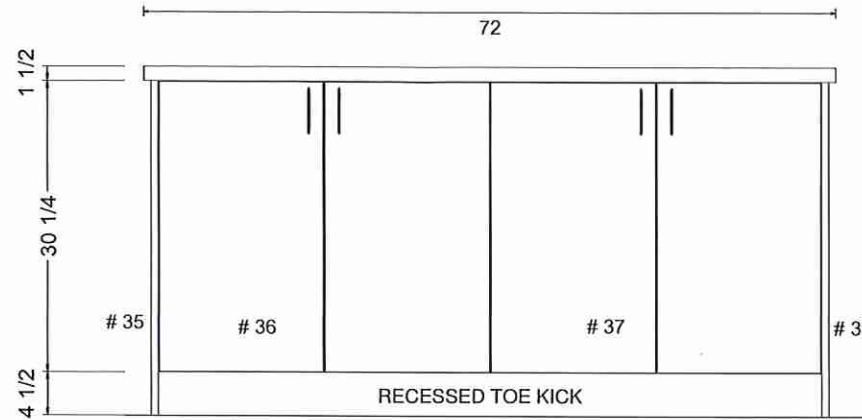

OUTLET LOCATION ON ISLAND TBD
FOR THE OWNER PRIOR PRODUCTION

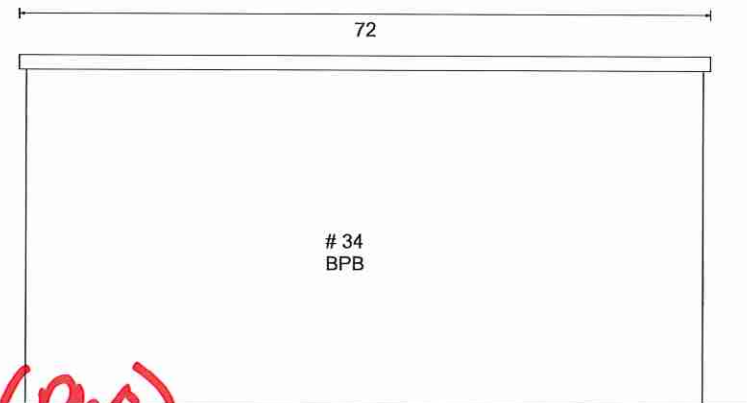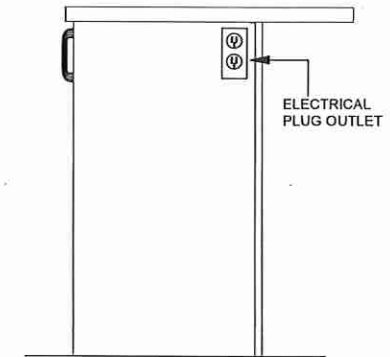

Lot 39 Forestside (Ph8)

Villa


KITCHENS & FINE CABINETRY LTD

8111 Jane St. Unit 10
 Concord, Ontario L4K 4L7
 Tel. (905) 669- 7028
 Fax. (905) 669 - 7903
 email: designstudio@villakitchens.ca
 www.villakitchens.ca



CLIENT: ROYAL PINE
 PROJECT: FORESTSIDE PH 8
 ADDRESS:
 MODEL: 40-02-ELEV A B C

VANITIES


DRAWN BY: LAI -YEE
 DATE: JULY 06, 2023
 REVISION: NOVEMBER 8, 2023
 SCALE:
 PAGE: 5 OF 8

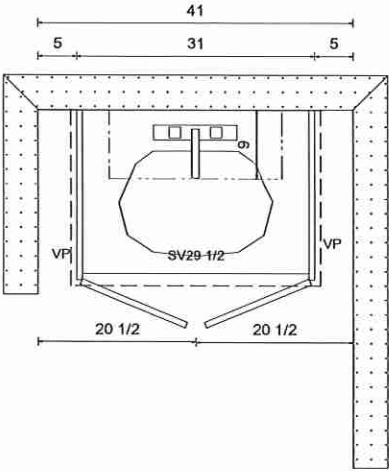

POWDER ROOM

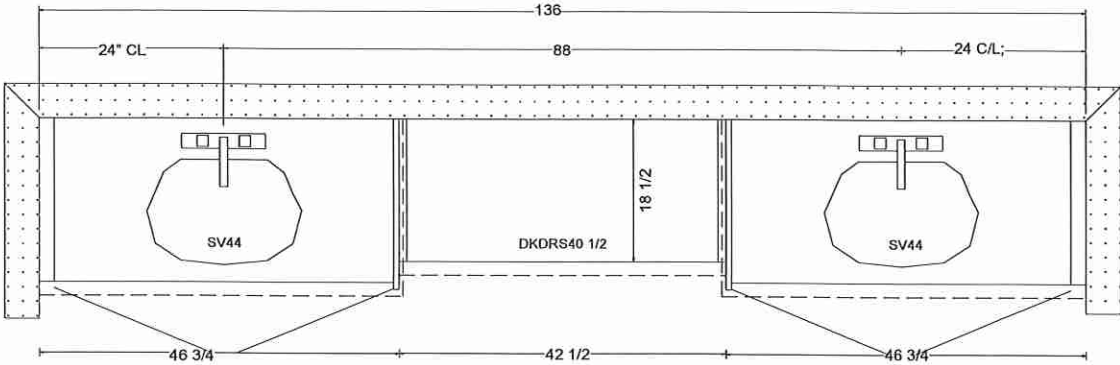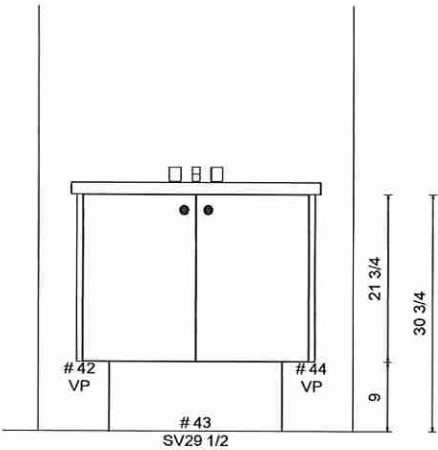

PRIMARY ENSUITE

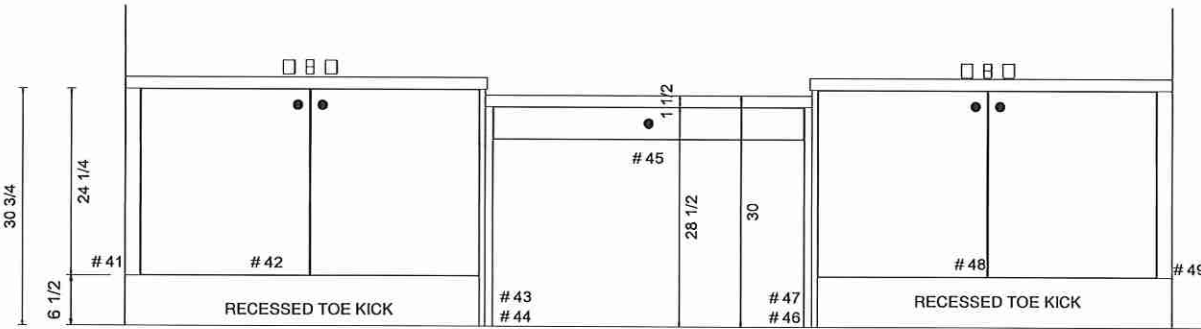


Lot 39 Forestside (Ph 8)




8111 Jane St. Unit 10
Concord, Ontario L4K 4L7
Tel. (905) 669- 7028
Fax. (905) 669 - 7903
email: designstudio@villakitchens.ca
www.villakitchens.ca

CLIENT: ROYAL PINE
PROJECT: FORESTSIDE PH 8
ADDRESS:
MODEL: 40-02-ELEV A B C



VANITIES

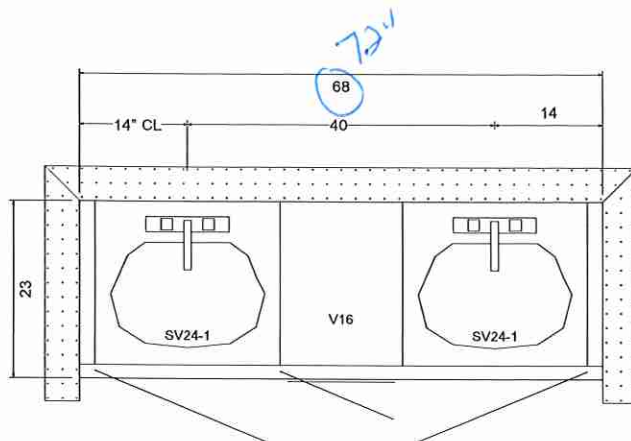

SHARED BATH 2 (BED 5 ENS)

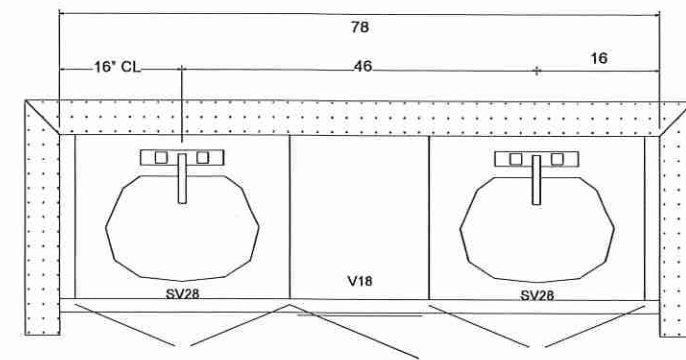

SHARED BATH 1 (BED 2 & 3)

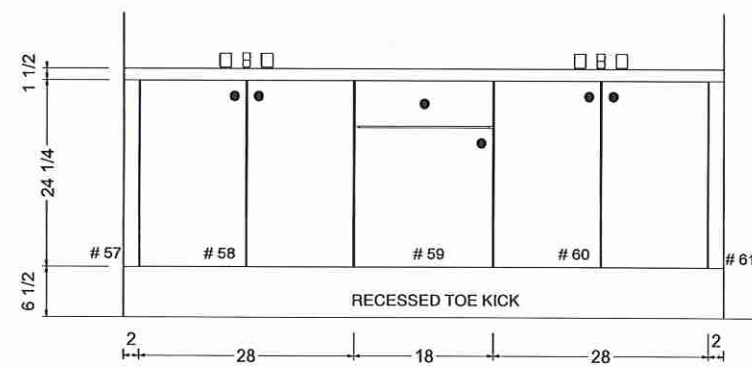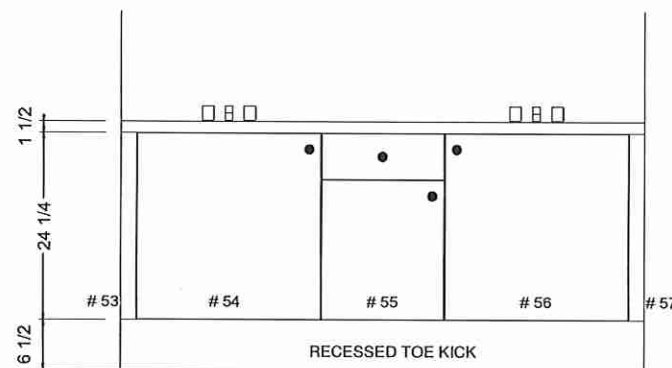

DRAWN BY: LAI -YEE
DATE: JULY 06, 2023
REVISION: NOVEMBER 8, 2023
SCALE:
PAGE: 6 OF 8

Lot 39 Forestside (Ph8)

Villa

KITCHENS & FINE CABINETS LTD

8111 Jane St. Unit 10
Concord, Ontario L4K 4L7
Tel. (905) 669- 7028
Fax. (905) 669 - 7903
email: designstudio@villakitchens.ca
www.villakitchens.ca

CLIENT: ROYAL PINE
PROJECT: FORESTSIDE PH 8
ADDRESS:
MODEL: 40-02-ELEV A B C

LAUNDRY



DRAWN BY: LAI -YEE

DATE: JULY 06, 2023

REVISION: NOVEMBER 8, 2023

SCALE:


PAGE: 7 OF 8

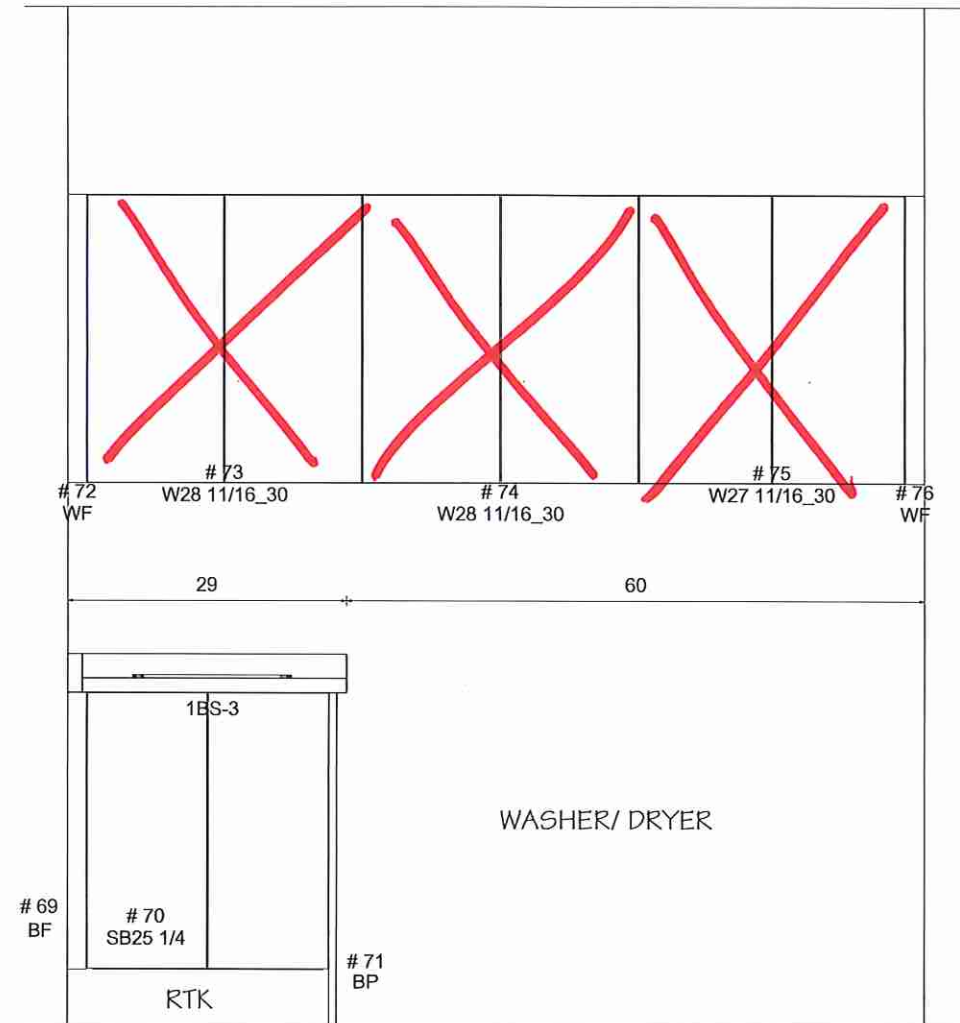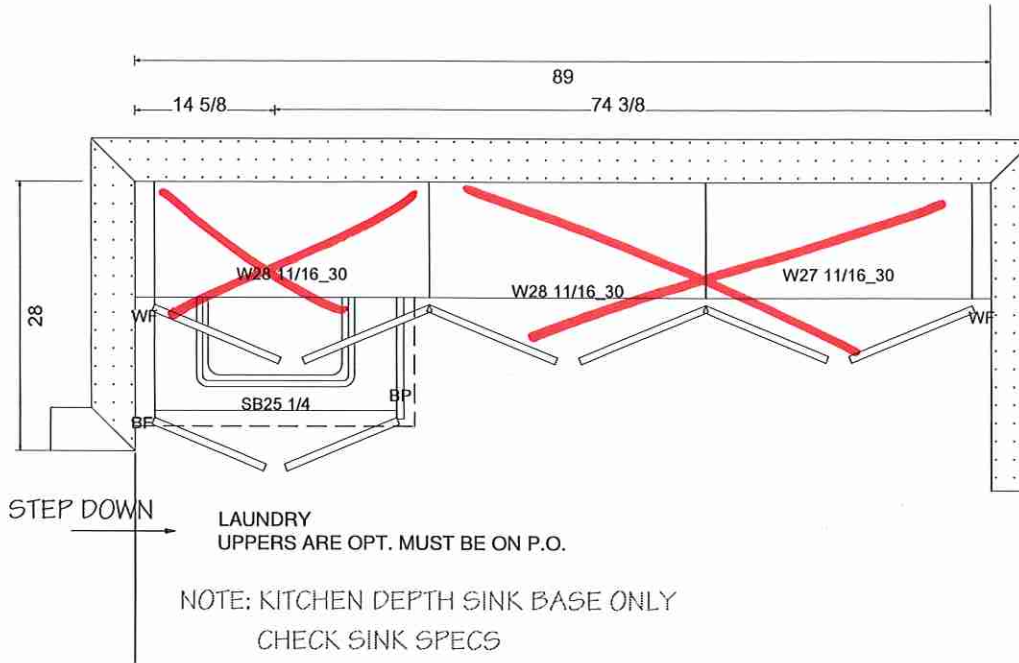

Lot 39 Forestside (Ph8)


97 1177

POSI-TEMP®

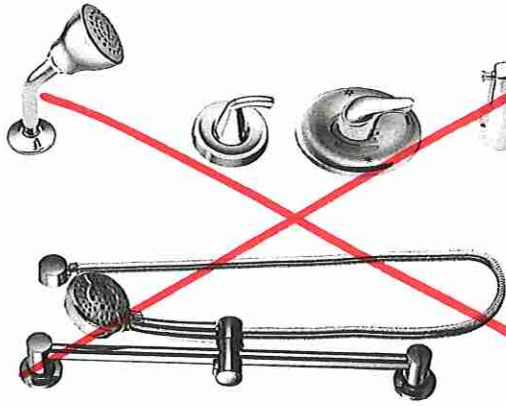


Posi-Temp® Tub/Shower Faucet with 3 Function Transfer Valve/Trim and Slide Bar with Hand Shower*

TL183EP / U361CI / UT2721 / 3669EP / A725 / 62320

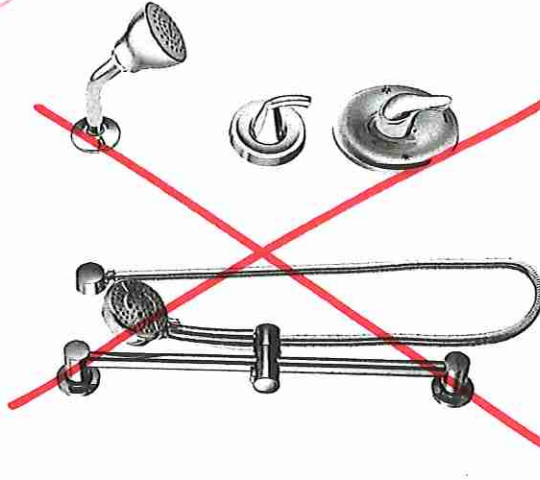

Posi-Temp® Shower Only with 3 Function Transfer Valve/Trim and Slide Bar with Hand Shower*

TL182EP / U361CI / UT2721 / 3669EP / A725 / 62320

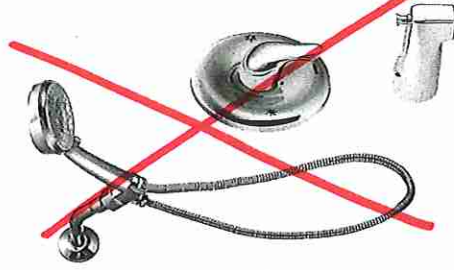

Posi-Temp® Tub/Shower Faucet with 4 Function Hand Shower*

TL2359EP / 62320



Eco-Performance Posi-Temp® Tub/Shower Faucet*

TL183EP / 62320



Eco-Performance Posi-Temp® Shower Only*

TL182EP / 62320

CHATEAU
FINISH OPTION



Chrome

To order Chrome (C) model, use model number only.
* Refer to the Shower Design Guide for installation instructions

Shared Bath #2