



CONSTRUCTION SUMMARY

Forestside Estates Inc.

PURCHASERS: GURJIT SINGH PALRA and DILDEEP KAUR PALRA

TEL: RES.: 437-995-1007

LOT NUMBER	PHASE	HOUSE TYPE	CLOSING DATE
50	8	WHITE ORCHID (45-0505B)-ELEV B-OPT MAIN-5 BED	02-Jul-24

Date Added: 23-Jan-24

Invoice Number: 8623

1 - Install Standard Cable Rough-Ins (x2) and Install Standard Telephone Rough-Ins (x2) (See Sketch)

Note:

1 - GREAT ROOM - Install Standard Conduit Pipe at family room above fireplace mantle. To accommodate future installation of wall mount TV. Conduit installed beside electrical plug (See Sketch)

Note:

1 - GREAT ROOM - Install ONE (1) ADDITIONAL ELECTRICAL PLUG at family room. To be installed above fireplace, to accommodate wall mount TV. Plug to be installed Approx. 60" AFF (See Sketch)

Note:

1 - KITCHEN - In addition to builders standard ceiling light at kitchen. Install ONE (x1) ADDITIONAL CEILING LIGHT COMPLETE with ONE (x1) Separate Switch - To be installed centred above kitchen island (See Sketch)

Note:

1 - MAIN FLOOR & UPPER HALL - FLOORING - HARDWOOD - Install prefinished 5" x 3/4" VINTAGE WHITE OAK BAROQUE (Character UVF) in lieu of builders standard prefinished 3 1/4" x 3/4" Vintage Red Oak Natural Hardwood.

Note: To be installed throughout main floor and upper hall, where applicable. To Include; Main Hall, Dining Room, Side Hall, Great Room, In-Law Suite(MainFlr), Upper Hall and Applicable Landing. (See Sketch)

1 - STAIRCASE - Stain Oak Staircase from Main Floor to Second Floor, where applicable. To be Stained - Vintage Red Oak BAROQUE - To Include; Treads, Risers, Handrail and Post, where applicable (See Sketch)

Note:

1 - STAIRCASE VS FLOORING
WOOD SPECIES DIFFERENCE:

STAIRCASE - The purchaser was advised and therefore accepts and acknowledges that the wood species of the staircase and flooring chosen do not match. This difference may result in a stain colour variance.

Note: The purchaser agrees that the vendor is to be exempt from any and all claims by the purchaser regarding this colour variance.

1 - STAIRCASE VS FLOORING
STAINING DIFFERENCE:

STAIRCASE - The purchaser was advised and therefore accepts and acknowledges that the stain of the staircase and flooring chosen do not match. This difference might result in an undesirable colour variance.

Note: The purchaser agrees that the vendor is to be exempt from any and all claims by the purchaser regarding this colour variance.

1 - DISCLAIMER - THERMOFOIL CABINETRY;

KITCHEN - Purchasers accept & acknowledge that they were advised by vendor to NOT install thermofoil cabinets in kitchen.

Note: Due to the vapor & moisture from the stove & dishwasher, the cabinets may result in peeling. The vendor will be exempt.

1 - KITCHEN - CABINETRY - Install FULL DEPTH FRIDGE ENCLOSURE (Includes Applicable Gable) at Kitchen (See Sketch)

Note:

1 - KITCHEN - CABINETRY - Install ONE (x1) BASE BI-FOLD CORNER CABINET WITH SHELF - To be installed at corner between stove and sink at kitchen (See Sketch)

Note:

1 - KITCHEN - CABINETRY - Install ONE (x1) UPPER BI-FOLD CORNER CABINET WITH SHELF - To be installed at corner between stove and sink at kitchen (See Sketch)

Note:

1 - KITCHEN - Purchasers request to NOT INSTALL builder's standard hood fan and standard cabinets above stove. DELETE. Do not supply, install, and/or credit. Purchasers are installing their own chimney hood fan after closing.

Note: Purchasers accept and acknowledge that the exhaust fan duct hole may be off-centered with stove in kitchen due to purchasers installing their own chimney hood fan after closing. The vendor is exempt.

1 - KITCHEN & SERVERY - BACKSPLASH - Purchaser Requests to DELETE Do Not Install / Supply / and/or Credit for Builders Standard Backsplash Tile at Kitchen and Servery (See Sketch)

Note:



CONSTRUCTION SUMMARY

Forestside Estates Inc.

PURCHASERS: GURJIT SINGH PALRA and DILDEEP KAUR PALRA

TEL: RES.: 437-995-1007

LOT NUMBER	PHASE	HOUSE TYPE	CLOSING DATE
50	8	WHITE ORCHID (45-0505B)-ELEV B-OPT MAIN-5 BED	02-Jul-24

Date Added: 23-Jan-24

Invoice Number: 8623

1 - KITCHEN & SERVERY - COUNTERTOP - Install Builders Standard Stone Countertop – EMMERSTONE MAPLE WHITE with STANDARD " A " EDGE PROFILE - To be installed throughout kitchen & servery, where applicable (does not include stone backsplash) (See Sketch) Note:
1 - DISCLAIMER - STONE COUNTERTOP; KITCHEN & SERVERY - Due to the many variables that can affect the pattern, colour and/or design of stone products, stone installed will not be identical to the samples displayed. Note: Every effort is made to provide stone countertops as close as possible but the vendor is not responsible for results which differ from the sample displayed. All countertop surfaces may have seams, and product pattern and shade can change in areas containing seams.
1 - DISCLAIMER - STONE COUNTERTOP; KITCHEN & SERVERY - Stone slabs vary in size & all seams are visible & the fabricator reserves the right to position the seams as necessary. Note:
1 - KITCHEN - KITCHEN SINK - Install Builders Standard Undermount Sink - Blanco Essential U2 (7" Deep) Undermount Sink - Model #400008 Note:
1 - KITCHEN - KITCHEN FAUCET - Install Builders Standard Faucet - MOEN Method Single Handle Pull-Out (Single Hole) Kitchen Faucet - Model # 7585 – Chrome Note:
1 - SERVERY - SERVERY SINK - Install Builders Standard Undermount Sink - Blanco Formera U Bar Undermount Sink - Model #402245 Note:
1 - SERVERY - SERVERY FAUCET - Install Builders Standard Faucet - MOEN Chateau Two Handle Bar Faucet - Model # 4903 – Chrome Note:
1 - MAIN FLOOR ENSUITE - COUNTERTOP - Install Builders Standard Stone Countertop – EMMERSTONE PURE GREY with STANDARD " A " EDGE PROFILE - To be installed throughout main floor ensuite vanity, where applicable (Includes Applicable Splash) (See Sketch) Note: **To be Installed with Builders Standard Sink and Builders Standard Faucet**
1 - POWDER ROOM - COUNTERTOP - Install Builders Standard Stone Countertop – EMMERSTONE PURE GREY with STANDARD " A " EDGE PROFILE - To be installed throughout powder room vanity, where applicable (Includes Applicable Splash) (See Sketch) Note: **To be Installed with Builders Standard Sink and Builders Standard Faucet**
1 - PRIMARY ENSUITE - COUNTERTOP - Install Builders Standard Stone Countertop – EMMERSTONE MAPLE WHITE with STANDARD " A " EDGE PROFILE - To be installed throughout primary ensuite vanity, where applicable (Includes Applicable Splash) (See Sketch) Note: **To be Installed with Builders Standard Sink and Builders Standard Faucet**
1 - ENSUITE #2 - COUNTERTOP - Install Builders Standard Stone Countertop – EMMERSTONE MAPLE WHITE with STANDARD " A " EDGE PROFILE - To be installed throughout ensuite #2 vanity, where applicable (Includes Applicable Splash) (See Sketch) Note: **To be Installed with Builders Standard Sink and Builders Standard Faucet**
1 - ENSUITE #3 - COUNTERTOP - Install Builders Standard Stone Countertop – EMMERSTONE MAPLE WHITE with STANDARD " A " EDGE PROFILE - To be installed throughout ensuite #3 vanity, where applicable (Includes Applicable Splash) (See Sketch) Note: **To be Installed with Builders Standard Sink and Builders Standard Faucet**
1 - TWIN BATH 4/5 - COUNTERTOP - Install Builders Standard Stone Countertop – EMMERSTONE MAPLE WHITE with STANDARD " A " EDGE PROFILE - To be installed throughout twin bath 4/5 vanity, where applicable (Includes Applicable Splash) (See Sketch) Note: **To be Installed with Builders Standard Sink and Builders Standard Faucet**
1 - DISCLAIMER - STONE COUNTERTOP; ALL BATHROOMS - Stone slabs vary in size & all seams are visible & the fabricator reserves the right to position the seams as necessary. Note:



CONSTRUCTION SUMMARY

Forestside Estates Inc.

PURCHASERS: GURJIT SINGH PALRA and DILDEEP KAUR PALRA

TEL: RES.: 437-995-1007

LOT NUMBER	PHASE	HOUSE TYPE	CLOSING DATE	
50	8	WHITE ORCHID (45-0505B)-ELEV B-OPT MAIN-5 BED	02-Jul-24	

Date Added: 23-Jan-24

Invoice Number: 8623

1 - PURCHASER HAS ATTENDED A DECOR APPOINTMENT AT THE DESIGN STUDIO AND HAS DECLINED ANY ADDITIONAL UPGRADES. Purchaser accepts and acknowledges that there will be no further changes/additions/deletions to be made upon signing on JANUARY 16,2024
Note:

1 - PURCHASER AWARE AND ACCEPTS THAT ANY CHANGES MADE TO UPGRADES AFTER SIGNING THIS PURCHASERS EXTRA FORM ARE SUBJECT TO A MINIMUM ADMINISTRATION FEE OF \$1,000
Note:

Date Added: 02-Oct-23

Invoice Number: 8548

1 - FRONT EXTERIOR - Install EXTENDED HEIGHT SINGLE DOOR 36" WIDE with ONE (x1) 27" WIDE SIDE LIGHT (Delete transom window above) in lieu of builders standard height single door with applicable side lite (See Sketch)
Note:

1 - SIDE EXTERIOR - Install OPTIONAL SIDE DOOR ENTRANCE (Includes Applicabel Exterior Coach Light) **If Grade Permits** (See Sketch)
Note:

1 - GARAGE - Relocate Central Vac Trunk Rough-In to Garage in lieu of basement (See Sketch)
Location to be Determined by Vendor
Note:

1 - BASEMENT - Install UPGRADE 200 AMP Service in lieu of standard 100 amp (See Sketch)
Note:

1 - FRONT EXTERIOR - GARAGE - Install ONE (x1) FESTIVE SOFIT PLUG On a Single Pole Switch (See Sketch)
Note: **Location of Switch to be Determined by Vendor

1 - KITCHEN - Install GAS LINE ROUGH-IN **Includes Additional Applicable Electrical** for stove at kitchen. (See Sketch)
Note: **PLEASE NOTE - Additional electrical may be required once appliance specifications have been submitted

1 - KITCHEN - Install UPGRADE 8 INCH EXHAUST DUCT at stove area of kitchen, in lieu of standard 6 inch exhaust (See Sketch)
Note:

1 - KITCHEN - Install WATER LINE ROUGH-IN for fridge at kitchen (See Sketch)
Note:

1 - KITCHEN - Enlarge depth of pantry approx. 2'-0" by reducing the opening betweennn kitchen/dinette and side hall by Approx 2'-0". Pantry to become an "L" Shaped Walk-In, with Door to swing out. (See Sketch)
Note:

1 - BONUS PACKAGE - PURCHASER HAS APPLIED \$20,000.00 (Incudes Taxes) WORTH OF UPGRADE PROMOTIONAL PACKAGE TOWARDS THE PURCHASE OF STRUCTURAL UPGRADES COMPLETED AT THE DECOR CENTRE
Note:

1 - PURCHASER HAS ATTENDED A STRUCTURAL APPOINTMENT AT THE DESIGN STUDIO & HAS DECLINED ANY ADDITIONAL UPGRADES.Purchaser accepts & acknowledges that there will be no further structural changes/additions/deletions to be made upon signing on SEPTEMBER 26,2023
Note:

1 - PURCHASER AWARE AND ACCEPTS THAT ANY CHANGES MADE TO UPGRADES AFTER SIGNING THIS PURCHASERS EXTRA FORM ARE SUBJECT TO A MINIMUM ADMINISTRATION FEE OF \$1,000
Note:

Date Added: 28-Jun-23

Invoice Number: 8475



CONSTRUCTION SUMMARY

Forestside Estates Inc.

PURCHASERS: GURJIT SINGH PALRA and DILDEEP KAUR PALRA

TEL: RES.: 437-995-1007

LOT NUMBER	PHASE	HOUSE TYPE	CLOSING DATE	
50	8	WHITE ORCHID (45-0505B)-ELEV B-OPT MAIN-5 BED	02-Jul-24	

Date Added: 28-Jun-23

Invoice Number: 8475

1 - BASEMENT- Purchaser has declined extended height basement ceiling.

Note:

1 - PURCHASER AWARE AND ACCEPTS THAT ANY CHANGES MADE TO UPGRADES AFTER SIGNING THIS PURCHASERS EXTRA FORM ARE SUBJECT TO A MINIMUM ADMINISTRATION FEE OF \$1,000

Note:

This Document is Extremely Time Sensitive - Printed 30 Jan 24 at 9:03

* INTERIOR COLOUR SCHEME *

Purchasers	Decor Consultant	Model and Elevation	Telephone Res. / Bus	Project	Closing Date	Property
GURJIT SINGH PALRA & DILDEEP KAUR PALRA	Melissa Di Marino	HITE ORCHID (45-0505B)-ELEV B-OPT MAIN-5 B	(437) 995-1007 /	Forestside Estates Inc.	02/07/2024	50


Page 1 of 3


Flooring	Wall Tile	Plumbing
Description	Main Accent/Insert Border / Listello Pattern	
Primary Ensuite ✓ 13x13 KEATON ICE (STD)	8x10 KEATON ICE (STD) NONE	WHITE
Ensuite #2 ✓ 13x13 KEATON CARBON (STD)	8x10 KEATON CARBON (STD) NONE	WHITE
Ensuite #3 ✓ 13x13 KEATON CARBON (STD)	8x10 KEATON CARBON (STD) NONE	WHITE
Twin Bath 4/5 ✓ 13x13 KEATON ICE (STD)	8x10 KEATON ICE (STD) NONE	WHITE
Laundry (2nd Floor) ✓ 13x13 CINQ BLACK (STD)	N/A N/A	STD
Main Floor Ensuite ✓ 18x18 LIVORNO GRIS (STD)	8x10 UNIWALL WHITE GLOSSY (STD) NONE	WHITE
Kitchen/Dinette ✓ 18x18 LIVORNO GRIS (STD)	DELETE - Do Not Install/Supply/Credit NONE	STD
Servery ✓ 18x18 LIVORNO GRIS (STD)	DELETE - Do Not Install/Supply/Credit NONE	STD
Powder Room ✓ 18x18 LIVORNO GRIS (STD)	N/A N/A	WHITE
Mud Room ✓ 18x18 LIVORNO GRIS (STD)		
Foyer ✓ 18x18 Livorno Gris (STD)		
Main Hall ✓ 5"x 3/4" Vintage White Oak Baroque(UVF) (Upg)		
Side Hall ✓ 5"x 3/4" Vintage White Oak Baroque(UVF) (Upg)		
Dining Room ✓ 5"x 3/4" Vintage White Oak Baroque(UVF) (Upg)		
Great Room ✓ 5"x 3/4" Vintage White Oak Baroque(UVF) (Upg)		
In-Law Suite(MainFlr) ✓ 5"x 3/4" Vintage White Oak Baroque(UVF) (Upg)		
Upper Hall ✓ 5"x 3/4" Vintage White Oak Baroque(UVF) (Upg)		
Primary Bedroom ✓ BROADLOOM - Opening Night 4002-03 (STD)		
Bedroom 2 ✓ BROADLOOM - Opening Night 4002-03 (STD)		
Bedroom 3 ✓ BROADLOOM - Opening Night 4002-03 (STD)		
Bedroom 4 ✓ BROADLOOM - Opening Night 4002-03 (STD)		
Bedroom 5 ✓ BROADLOOM - Opening Night 4002-03 (STD)		


Railings and Stairs	Cornice Moulding / Medalion
Railings ✓ STD - OVAL - Vintage Red Oak Baroque	Foyer NONE
Pickets ✓ STD - Steel 1/2" Square, Plain - Flat Black	Living Room NONE
Posts ✓ STD-31/2"Sqaure w/Cap-Vint.RedOakBaroque	Dining Room NONE
Stringers ✓ STD - VINTAGE RED OAK BAROQUE	Family Room NONE
Treads ✓ STD - VINTAGE RED OAK BAROQUE	Main Hall NONE
Risers ✓ STD - VINTAGE RED OAK BAROQUE	Kitchen NONE
Runner NONE	2nd Floor Hall NONE
Trim	
Baseboard & Casing ✓ STANDARD - COLONIAL	
Front Door Glass ✓ STANDARD	
Interior Doors ✓ STANDARD - CARRARA, SMOOTH	
Knobs ✓ STANDARD	
Hinges ✓ STANDARD	
Grip Set ✓ STANDARD	


Notes
PRIMARY ENSUITE - Install 2x2 WHITE Mosaic Floor Tiles and 6" Curb with White Quartz**MAIN FLOOR ENSUITE - Install 2x2 WHITE Mosaic Floor Tiles and 6" Curb with White Quartz

Page 1 of 3

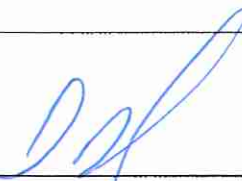Consultant: 
Melissa Di Marino

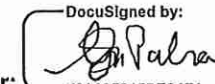Purchaser: 
GURJIT SINGH PALRA

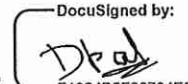Purchaser: 
DILDEEP KAUR PALRA

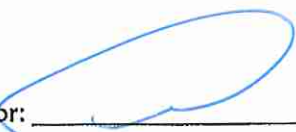Vendor: 
Forestside Estates Inc.
Printed Jan 17, 2024 10:29 am

* INTERIOR COLOUR SCHEME *

Purchasers	Decor Consultant	Model and Elevation	Telephone Res. / Bus	Project	Closing Date	Property
GURJIT SINGH PALRA & DILDEEP KAUR PALRA	Melissa Di Marino	HITE ORCHID (45-0505B)-ELEV B-OPT MAIN-5 B	(437) 995-1007 /	Forestside Estates Inc.	02/07/2024	50

Page 2 of 3

Primary Ensuite	STANDARD - SILVER BIRCH	EURO KARISMA - FREE SPIRIT L580 (STD)	☒ Emmerstone Maple White (STD)	☒ A " EDGE (STD)	9357-37 BSN
Ensuite #2	STANDARD - SILVER BIRCH	NY THERMOFOIL - ONTARIO WHITE (STD)	☒ Emmerstone Maple White (STD)	☒ A " EDGE (STD)	9357-37 BSN
Ensuite #3	STANDARD - SILVER BIRCH	NY THERMOFOIL - ONTARIO WHITE (STD)	☒ Emmerstone Maple White (STD)	☒ A " EDGE (STD)	9357-37 BSN
Twin Bath 4/5	STANDARD - SILVER BIRCH	NY THERMOFOIL - DARK CHOCOLATE (STD)	☒ Emmerstone Maple White (STD)	☒ A " EDGE (STD)	9357-37 BSN
Laundry (2nd Floor)	STANDARD - SILVER BIRCH	EURO MELAMINE - WHITE W100 (STD)	949-58 WHITE (STD)	STANDARD	9357-37 BSN
Main Floor Ensuite	STANDARD - SILVER BIRCH	NY THERMOFOIL - FOG GREY (STD)	☒ Emmerstone Pure Grey (STD)	☒ A " EDGE (STD)	9357-37 BSN
Kitchen/Dinette	STANDARD - SILVER BIRCH	NY THERMOFOIL - FOG GREY (STD)	☒ Emmerstone Maple White (STD)	☒ A " EDGE (STD)	9303-96 BSN
Servery	STANDARD - SILVER BIRCH	NY THERMOFOIL - FOG GREY (STD)	☒ Emmerstone Maple White (STD)	☒ A " EDGE (STD)	
Powder Room	STANDARD - SILVER BIRCH	NY THERMOFOIL - FOG GREY (STD)	☒ Emmerstone Pure Grey (STD)	☒ A " EDGE (STD)	9357-37 BSN
Mud Room	STANDARD - SILVER BIRCH	N/A	N/A	N/A	N/A
Foyer	STANDARD - SILVER BIRCH	Notes			
Side Hall	STANDARD - SILVER BIRCH				
Main Hall	STANDARD - SILVER BIRCH				
Dining Room	STANDARD - SILVER BIRCH				
In-Law Suite(MainFlr)	STANDARD - SILVER BIRCH				
Upper Hall	STANDARD - SILVER BIRCH				
Primary Bedroom	STANDARD - SILVER BIRCH				
Bedroom 2	STANDARD - SILVER BIRCH				
Bedroom 3	STANDARD - SILVER BIRCH				
Bedroom 4	STANDARD - SILVER BIRCH				
Bedroom 5	STANDARD - SILVER BIRCH				

Appliance Opening/Dimension

Fridge Size

Range

Built-Ins

Microwave

Hood Fan

Exhaust Opening ☐ 6" ☒ 8"

Dishwasher Cabinet

Fireplace

Fireplace ☒ GREAT ROOM

Location Flooring ☒ 5" HARDWOOD

Style ☒ VILLA NOVA

Finish

Marble

Hearth

Fireplace

Location Flooring


Style


Finish


Marble

Hearth

Page 2 of 3

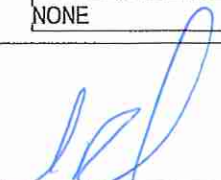Decor Consultant: 
Melissa Di Marino

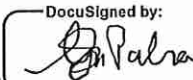Purchaser: 
GURJIT SINGH PALRA

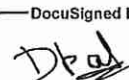
Purchaser: 
DILDEEP KAUP PALRA

Vendor: 
Forestside Estates Inc.





- * GAS LINE RIN
- * FUTURE CHIMNEY HOOD FAN
- * 8" EXHAUST PIPE

Cable - (x2)
Telephone - (x2)
Electrical - (x1)
Conduit (x1)

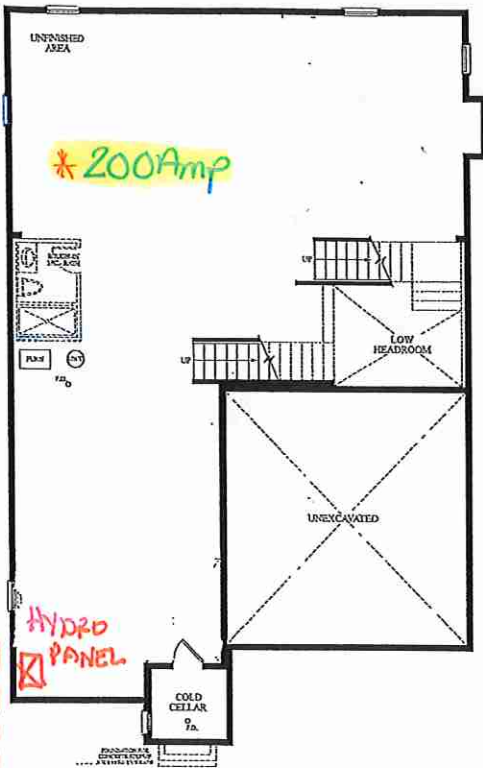

BASEMENT
ELEV. B
Sept 26 2023

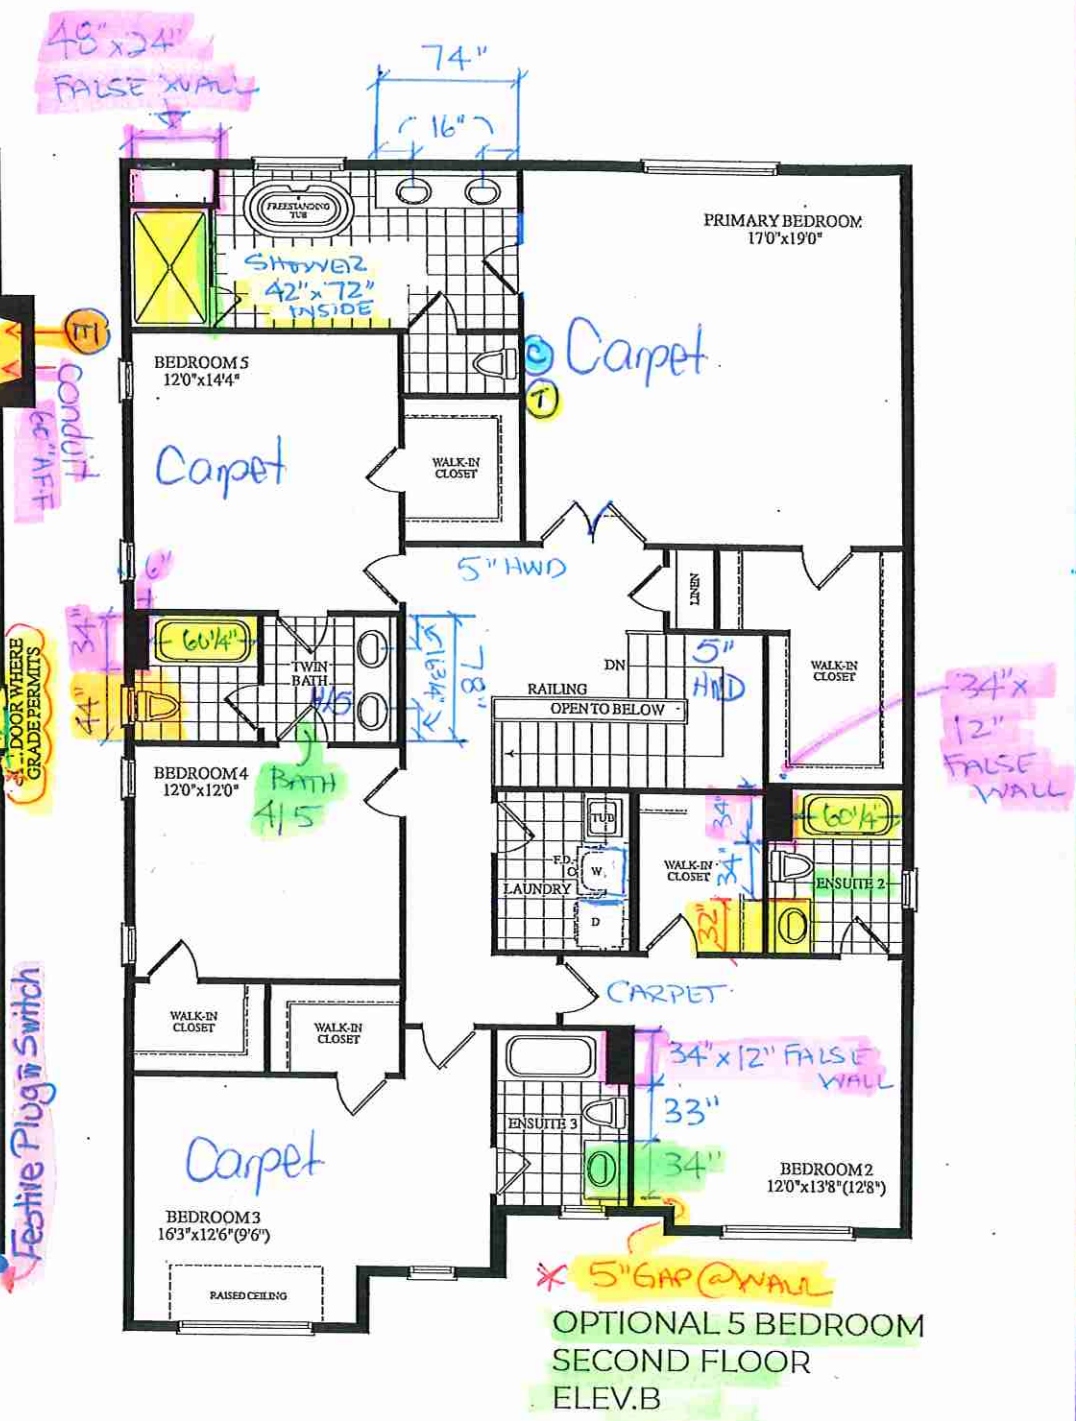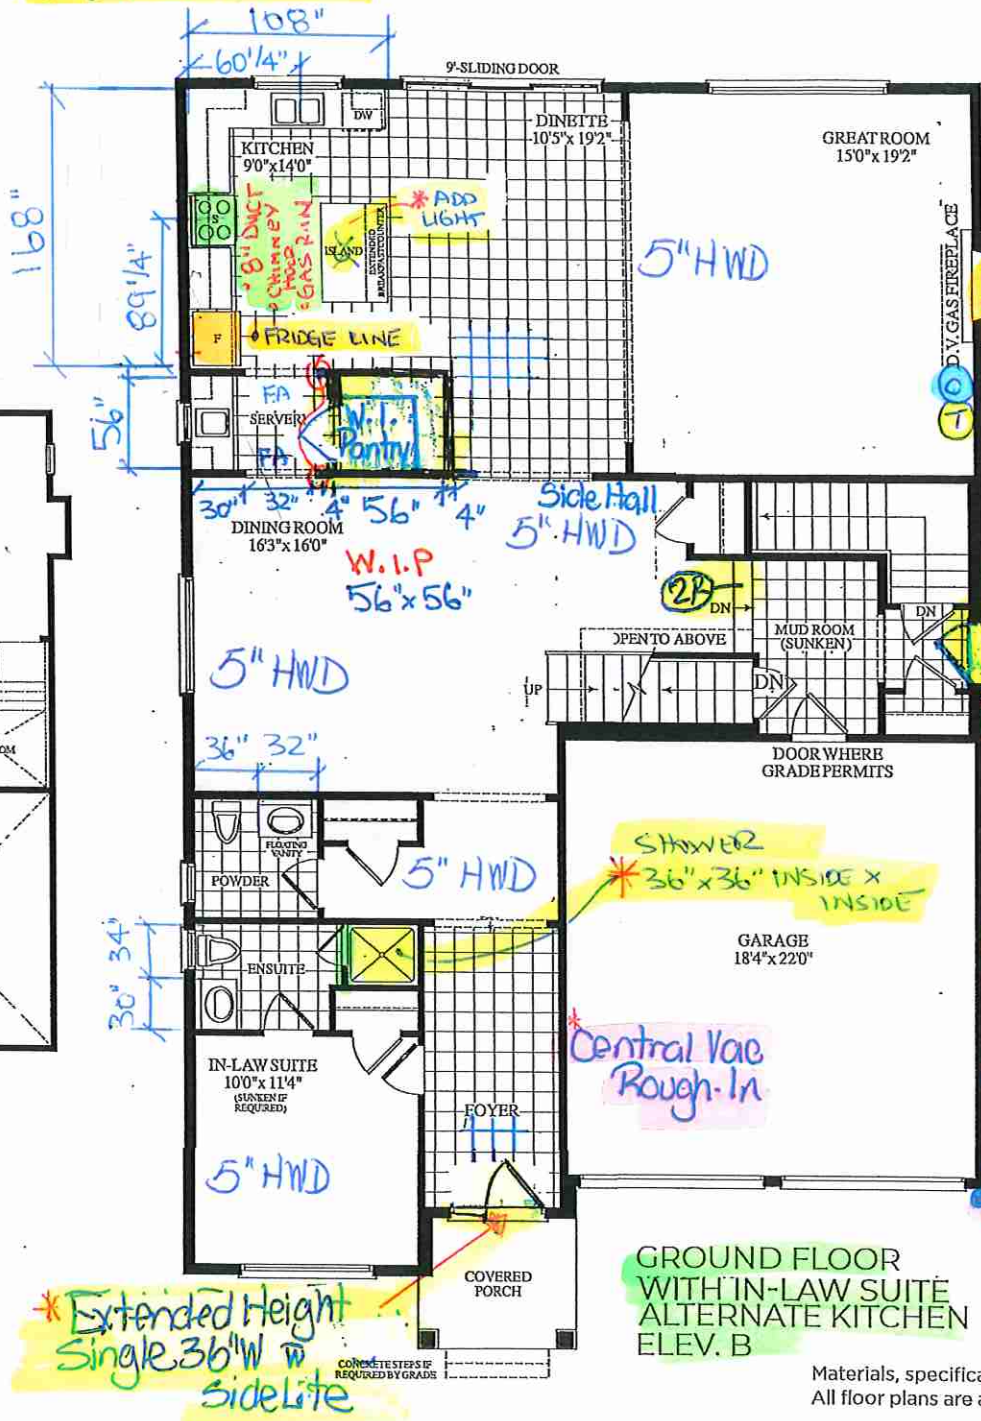

Materials, specifications and floor plans are subject to change without notice. All renderings are artist's concept. All floor plans are approximate dimensions. Actual usable floor space may vary from the stated floor area. E.&O.E.

Villa

KITCHENS & FINE CABINETRY LTD

8111 Jane St. Unit 10
Concord, Ontario L4K 4L7
Tel. (905) 669- 7028
Fax. (905) 669 - 7903
email: designstudio@villakitchens.ca
www.villakitchens.ca

CLIENT: ROYAL PINE

PROJECT: FORESTSIDE

ADDRESS: RP-FS(8)-LOT 50

MODEL: 45-05-ELEVA B C WHITE ORCHID

KITCHEN

DOOR STYLE : NEW YORK
DOOR PROFILE: N/A
MATERIAL: THERMOFOIL
FINISH: FOG GREY
INTERIORS: WHITE
CROWN MOLD: STD EURO
LIGHT VALANCE: N/A
INT HW: STANDARD
INSTALL HEIGHT: 95 5/8"H
HW:
CT:


LOT 50

DRAWN BY: ELISA

DATE: JAN 24, 2024

SCALE:

PAGE: 1 OF 4

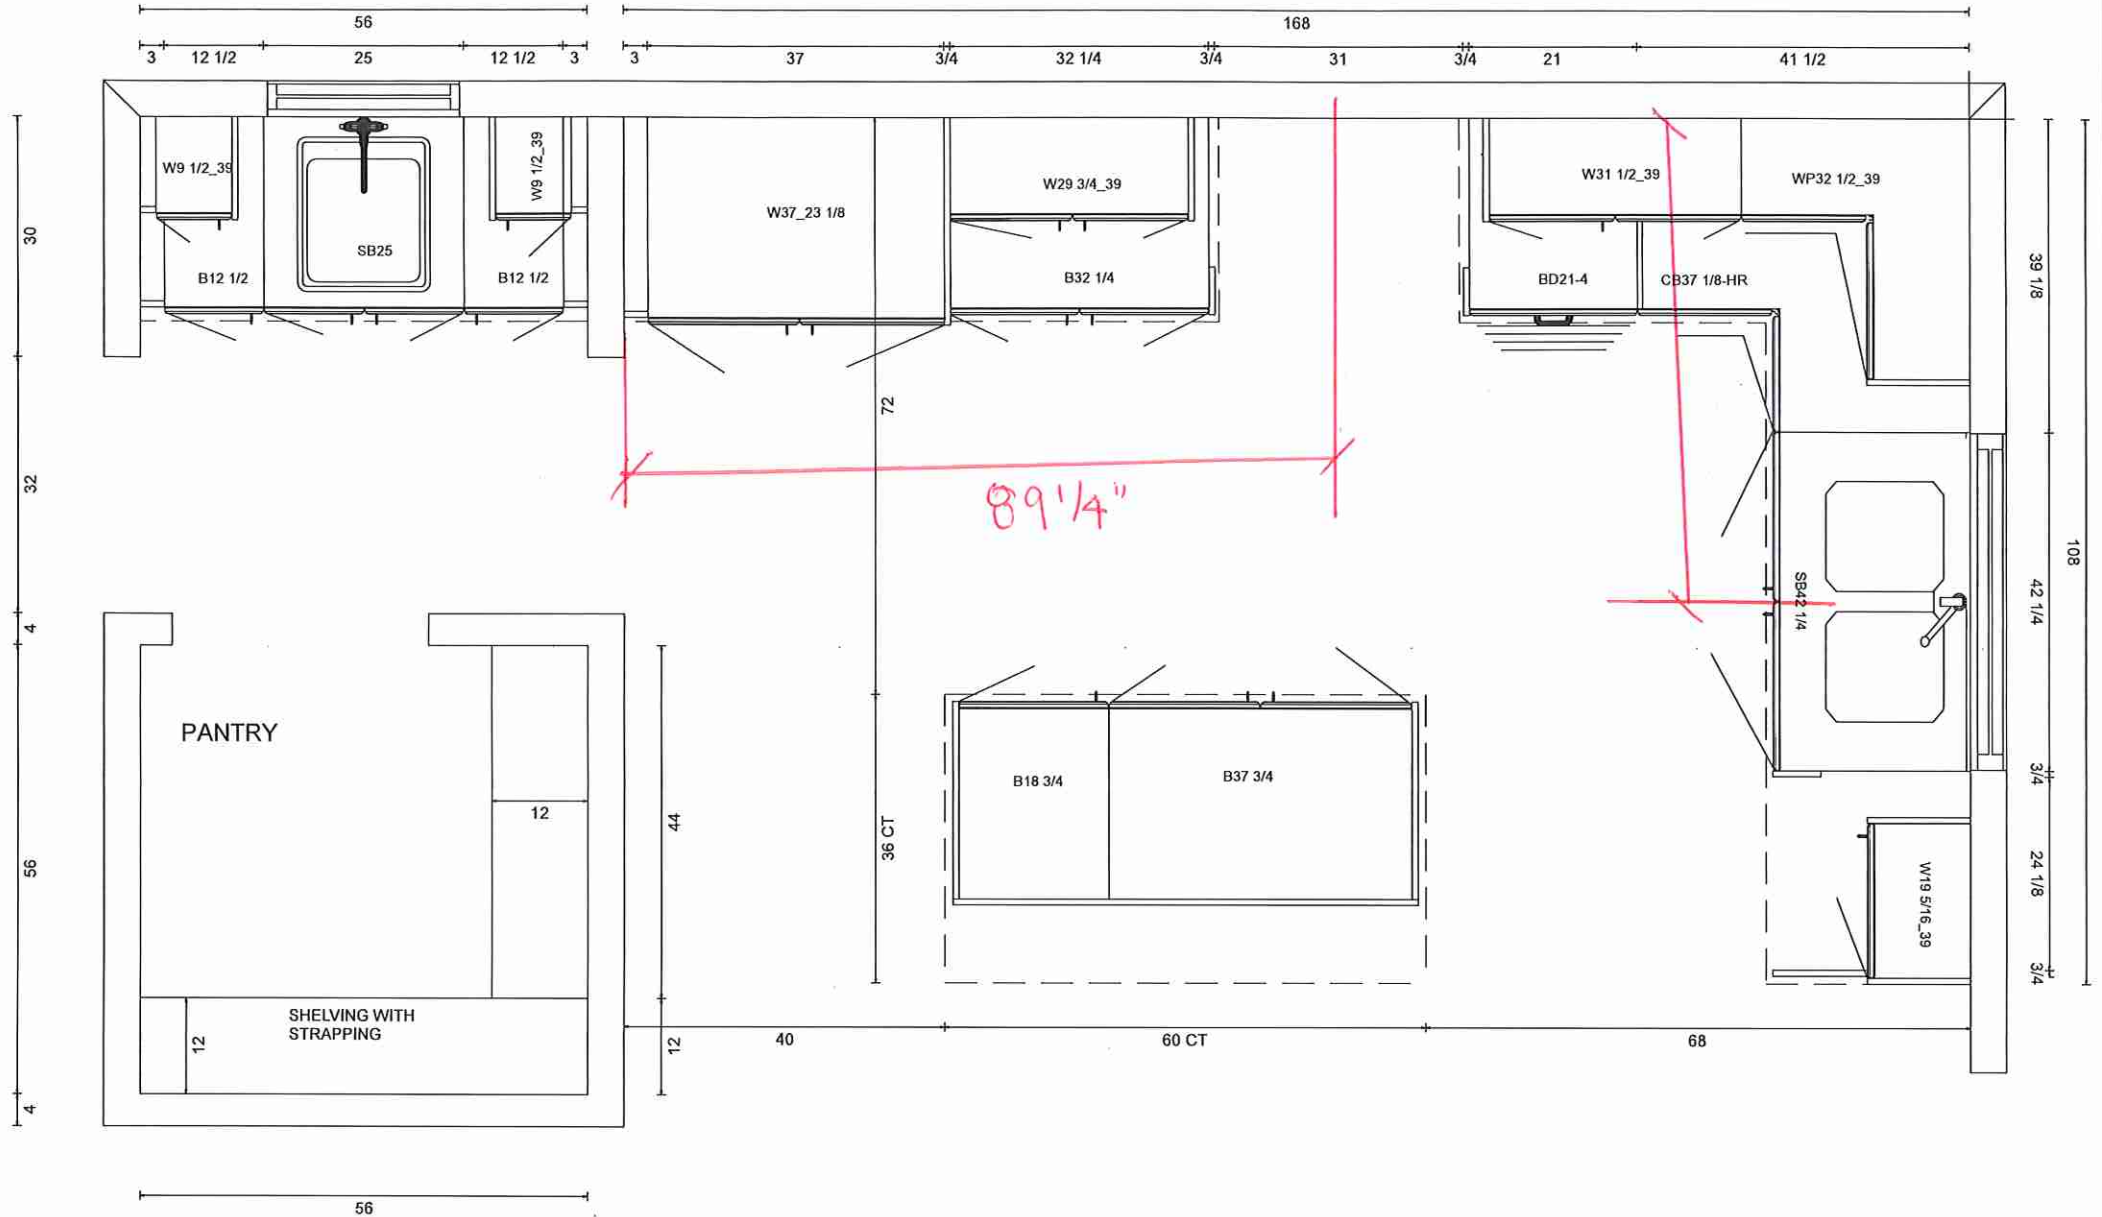

8111 Jane St. Unit 10
Concord, Ontario L4K 4L7
Tel. (905) 669- 7028
Fax. (905) 669 - 7903
email: designstudio@villakitchens.ca
www.villakitchens.ca


CLIENT: ROYAL PINE
PROJECT: FORESTSIDE
ADDRESS: RP-FS(8)-LOT 50
MODEL: 45-05-ELEV A B C WHITE ORCHID

PANTRY SHELVING
MATERIAL: WHITE MELAMINE
INSTALL HEIGHT: 72"H

LOT50

DRAWN BY: ELISA
DATE: JAN 24/24

SCALE:
PAGE: 2 OF 4

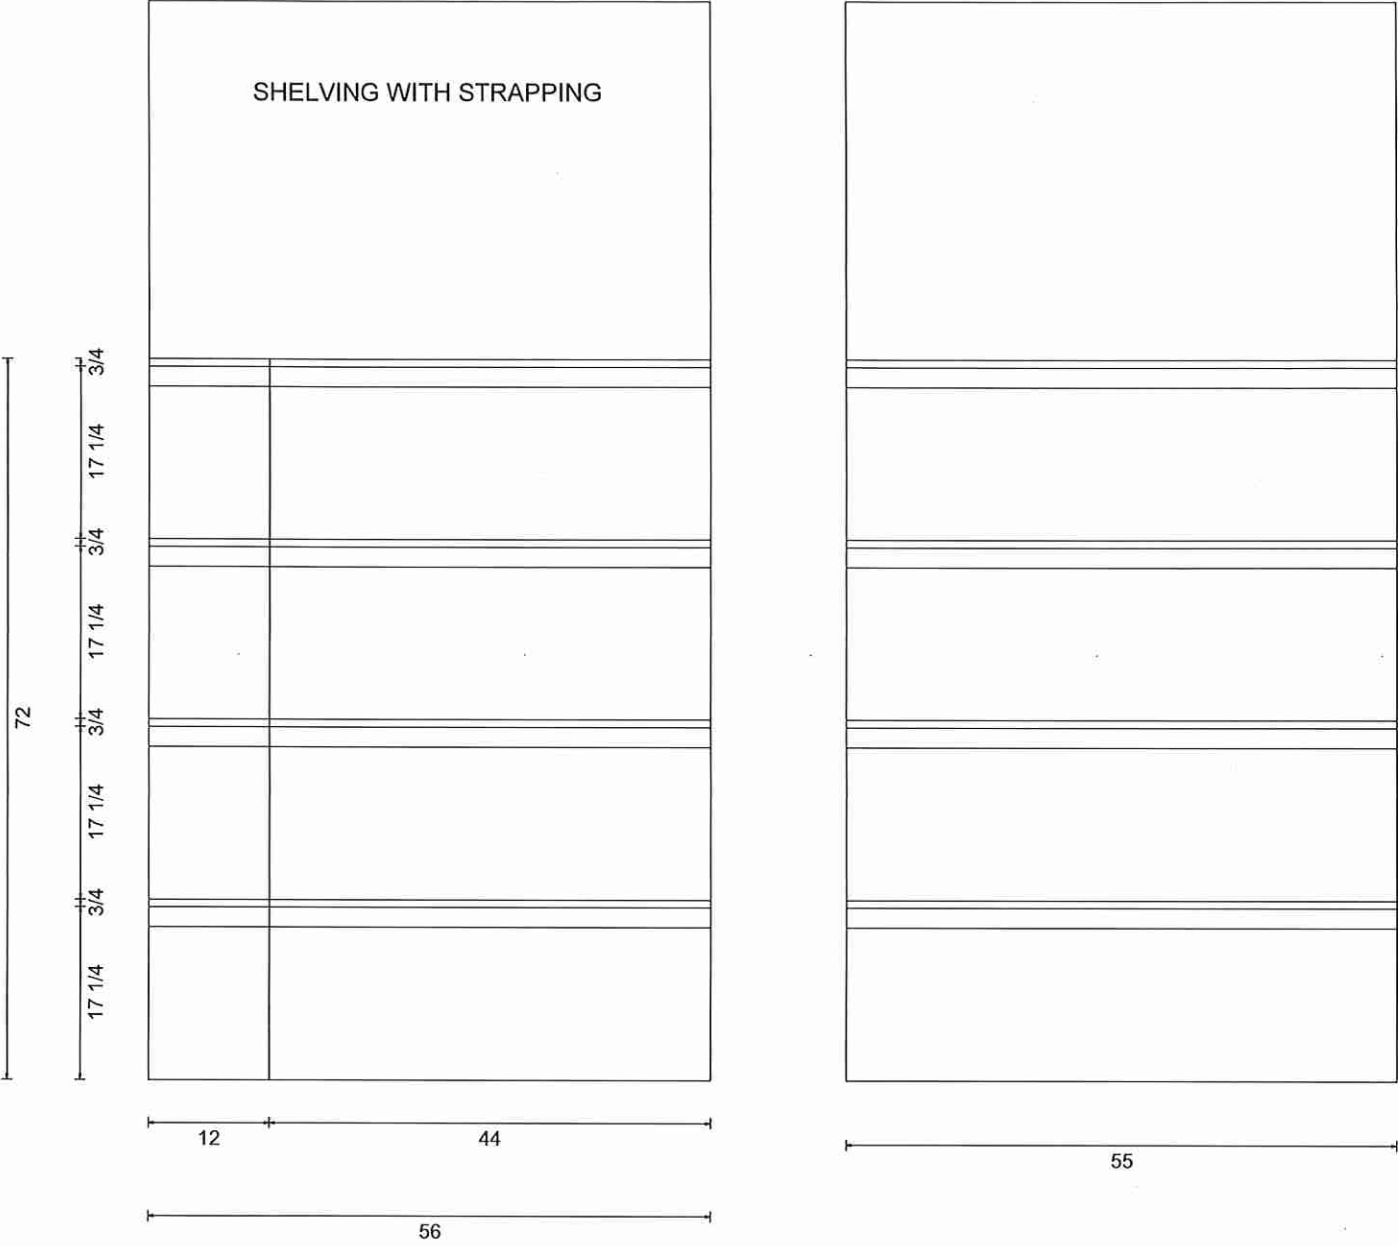

Villa

KITCHENS & FINE CABINETRY LTD

8111 Jane St. Unit 10
Concord, Ontario L4K 4L7
Tel. (905) 669- 7028
Fax. (905) 669 - 7903
email: designstudio@villakitchens.ca
www.villakitchens.ca

CLIENT: ROYAL PINE

PROJECT: FORESTSIDE

ADDRESS: RP-FS(8)-LOT 50

MODEL: 45-05-ELEVA B C WHITE ORCHID

KITCHEN

DOOR STYLE : NEW YORK

DOOR PROFILE: N/A

MATERIAL: THERMOFOIL

FINISH: FOG GREY

INTERIORS: WHITE

CROWN MOLD: STD EURO

LIGHT VALANCE: N/A


INT HW: STANDARD

INSTALL HEIGHT: 95 5/8"H

HW:

CT:

LOT 50

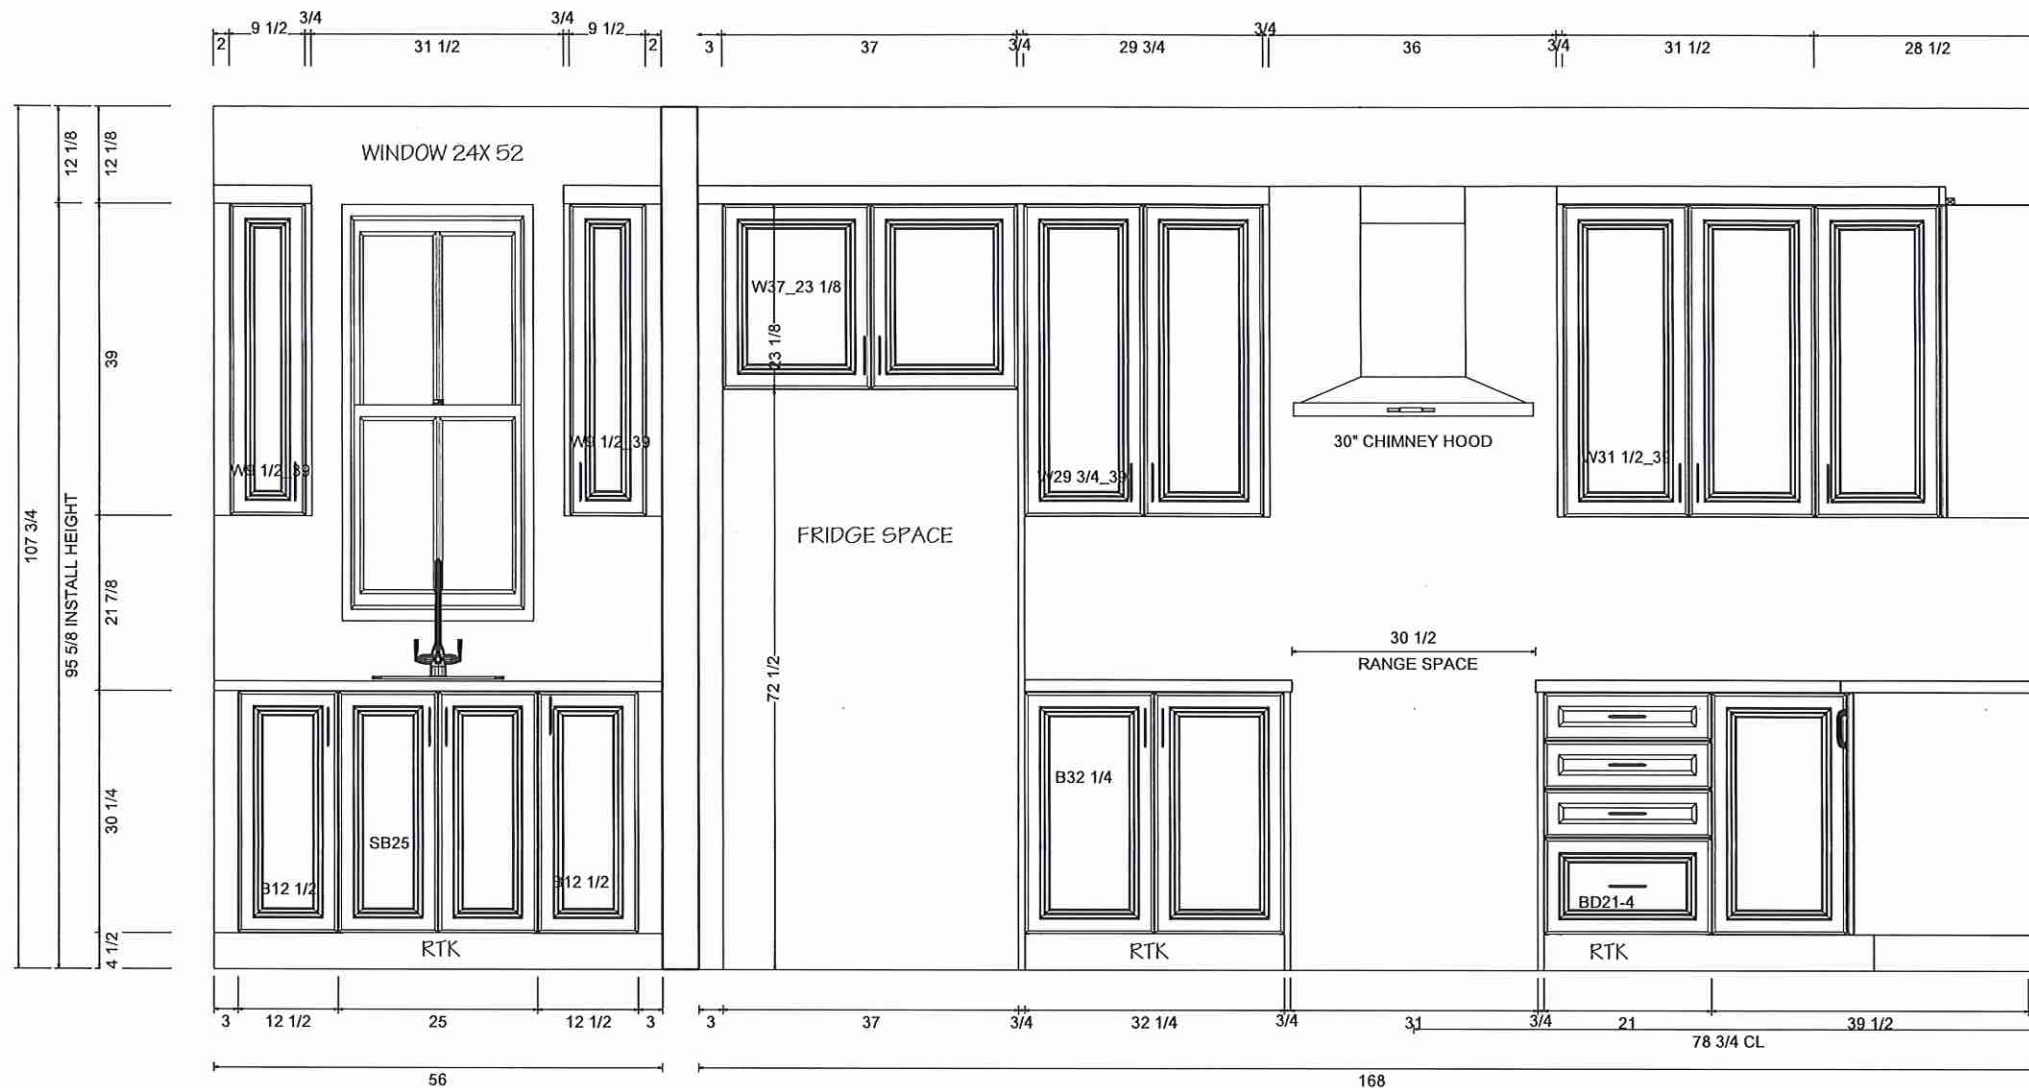

DRAWN BY: ELISA

DATE: JAN 24,2024

SCALE:

PAGE: 3 OF 4

KITCHENS & FINE CABINETRY LTD

8111 Jane St. Unit 10
Concord, Ontario L4K 4L7
Tel. (905) 669-7028
Fax. (905) 669-7903
email: designstudio@villakitchens.ca
www.villakitchens.ca

CLIENT: ROYAL PINE

PROJECT: FORESTSIDE

ADDRESS: RP-FS(8)-LOT 50

MODEL: 45-05-ELEV A B C WHITE ORCHID

KITCHEN

DOOR STYLE : NEW YORK

DOOR PROFILE: N/A

MATERIAL: THERMOFOIL

FINISH: FOG GREY

INTERIORS: WHITE

CROWN MOLD: STD EURO

LIGHT VALANCE: N/A

INT HW: STANDARD

INSTALL HEIGHT: 95 5/8"H

HW:

CT:


LOT 50

DRAWN BY: ELISA




DATE: JAN 24, 2024

SCALE:

PAGE: 4 OF 4

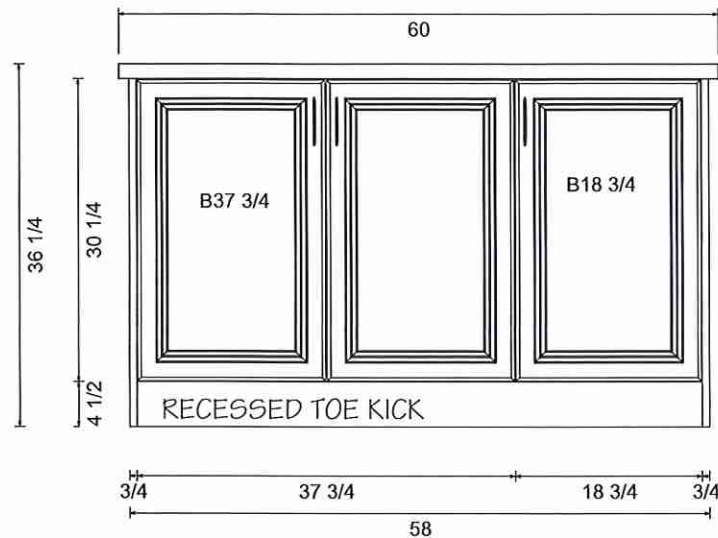

OUTLET LOCATION ON ISLAND TBD
BY CLIENT PRIOR TO PRODUCTION

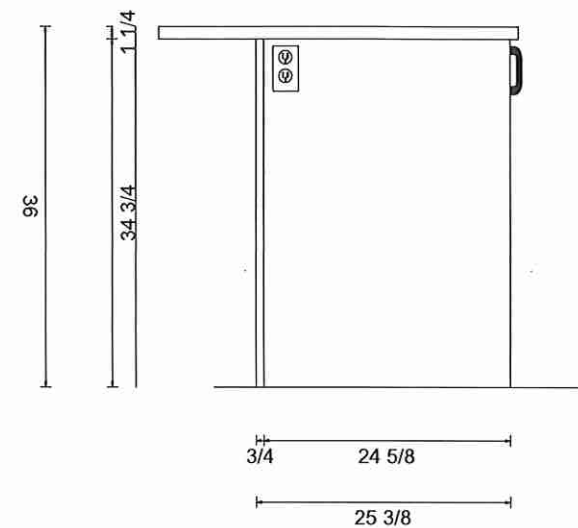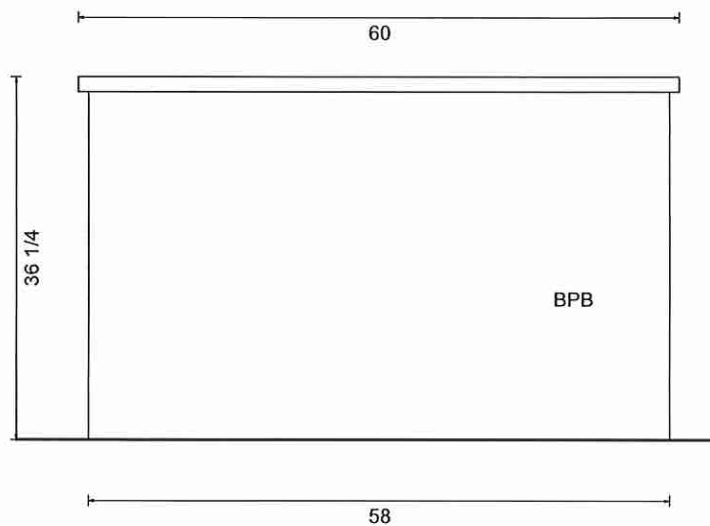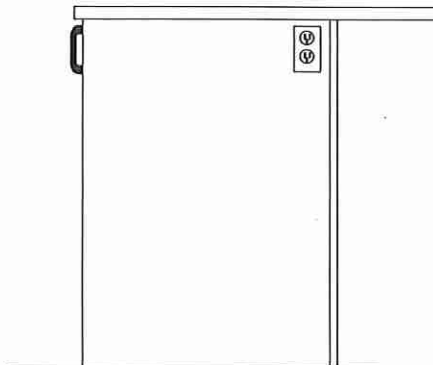

Villa


KITCHENS & FINE CABINETRY LTD

8111 Jane St. Unit 10
Concord, Ontario L4K 4L7
Tel. (905) 669- 7028
Fax. (905) 669 - 7903
email: designstudio@villakitchens.ca
www.villakitchens.ca



CLIENT: ROYAL PINE
PROJECT: FORESTSIDE
ADDRESS: RP-PH(8) MASTER
MODEL: 45-05-ELEV A B C WHITE ORCHID

VANITIES
ELEV A, B & C


DRAWN BY: LAI-YEE
DATE: July 24, 2023
REVISION: NOVEMBER 8, 2023
SCALE:
PAGE: 9 OF 15

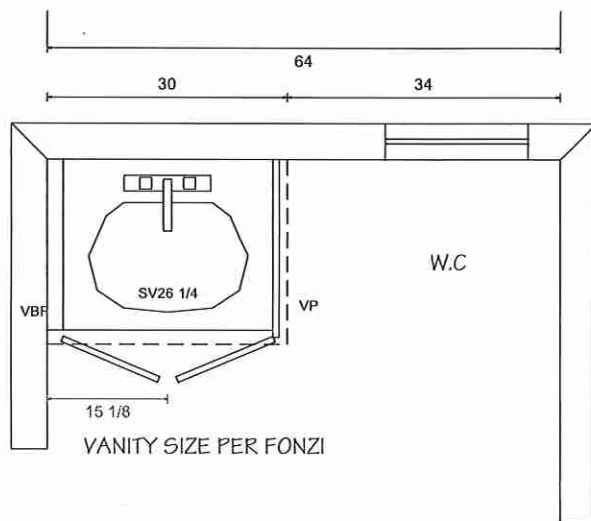

OPTIONAL IN-LAW SUITE
(Main Floor Ensuite)

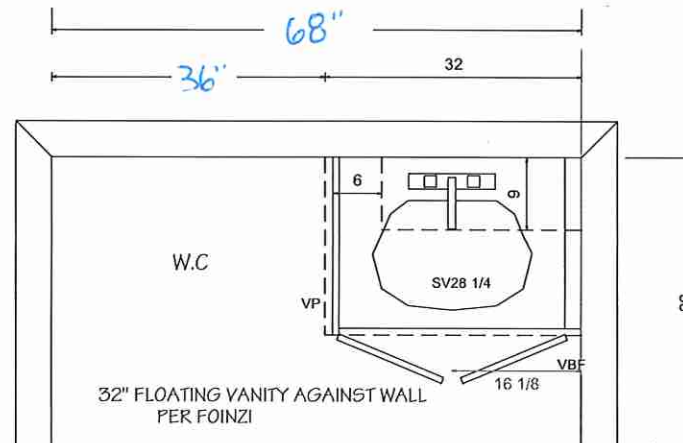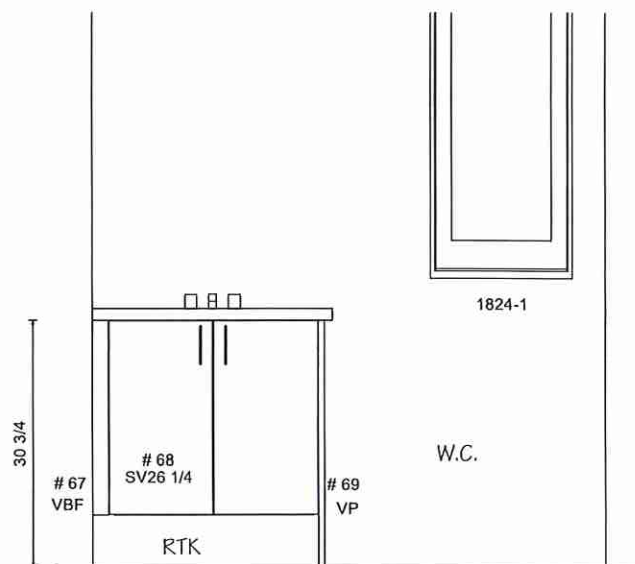

POWDER ROOM

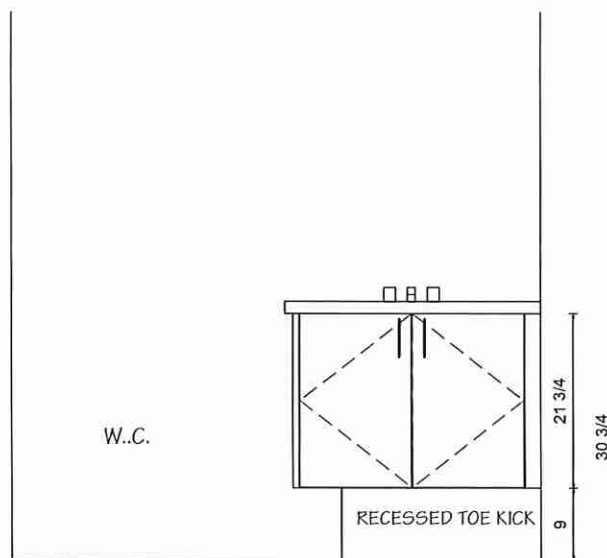

Lot 50 Forestside (Ph8)


Villa

KITCHENS & FINE CABINETRY LTD


8111 Jane St. Unit 10
Concord, Ontario L4K 4L7
Tel. (905) 669- 7028
Fax. (905) 669 - 7903
email: designstudio@villakitchens.ca
www.villakitchens.ca

CLIENT: ROYAL PINE
PROJECT: FORESTSIDE
ADDRESS: RP-PH(8) MASTER
MODEL: 45-05-ELEV A B C WHITE ORCHID



VANITIES
5 BEDROOM
ELEV A, B & C

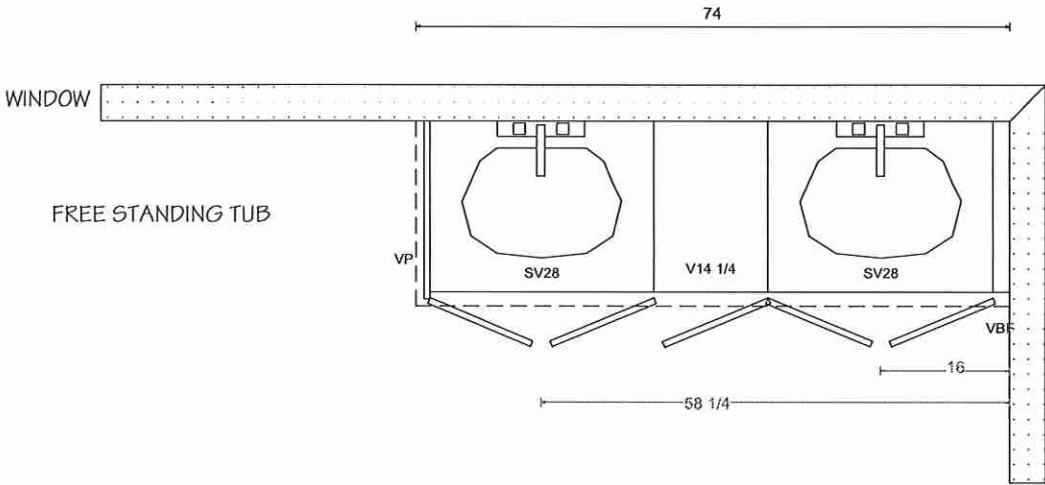

PRIMARY ENSUITE

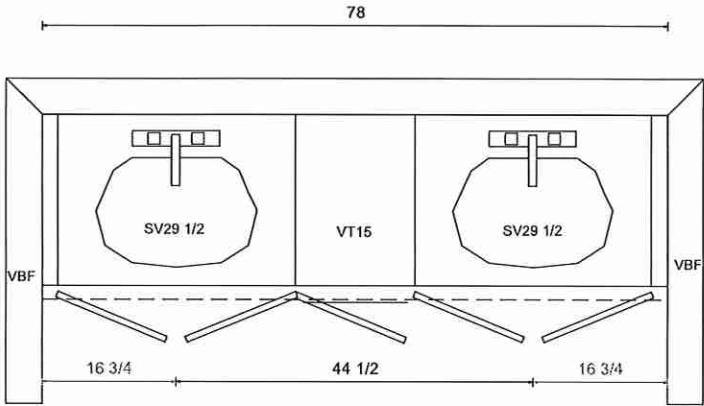

Twin BATH ^{4 1/2} (BEDROOM 4 & 5)

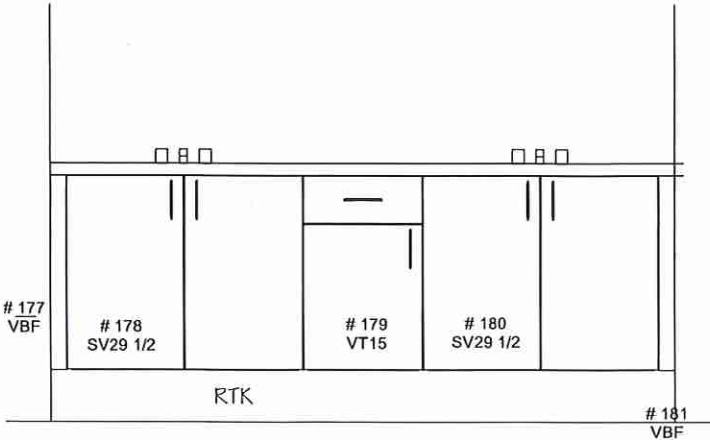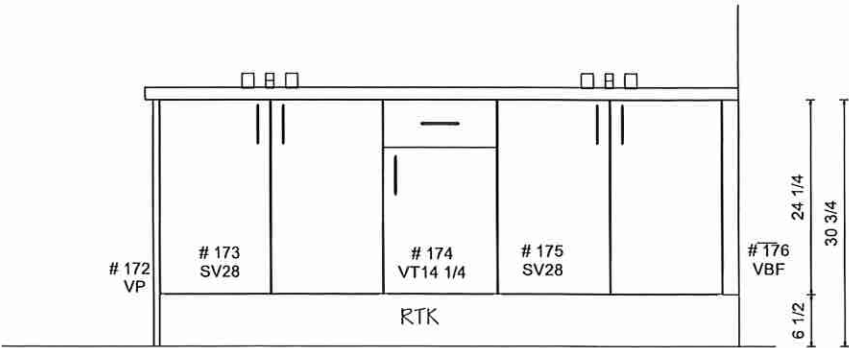

Lot 50 Forestside (Ph8)

Villa

KITCHENS & FINE CABINETRY LTD

8111 Jane St. Unit 10
Concord, Ontario L4K 4L7
Tel. (905) 669- 7028
Fax. (905) 669 - 7903
email: designstudio@villakitchens.ca
www.villakitchens.ca

CLIENT: ROYAL PINE
PROJECT: FORESTSIDE
ADDRESS: RP-PH(8) MASTER
MODEL: 45-05-ELEV A B C WHITE ORCHID

VANITIES
5 BEDROOM
ELEV A, B & C


DRAWN BY: LAI-YEE

DATE: July 24, 2023



REVISION: NOVEMBER 8, 2023

SCALE:


PAGE: 11 OF 15

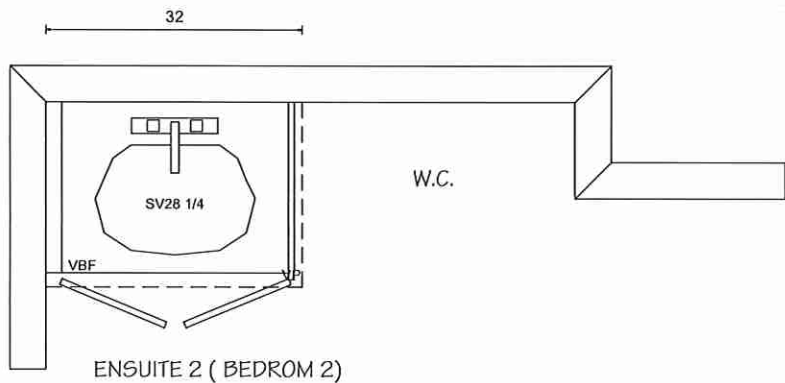

EN SUITE 2 (BEDROOM 2)

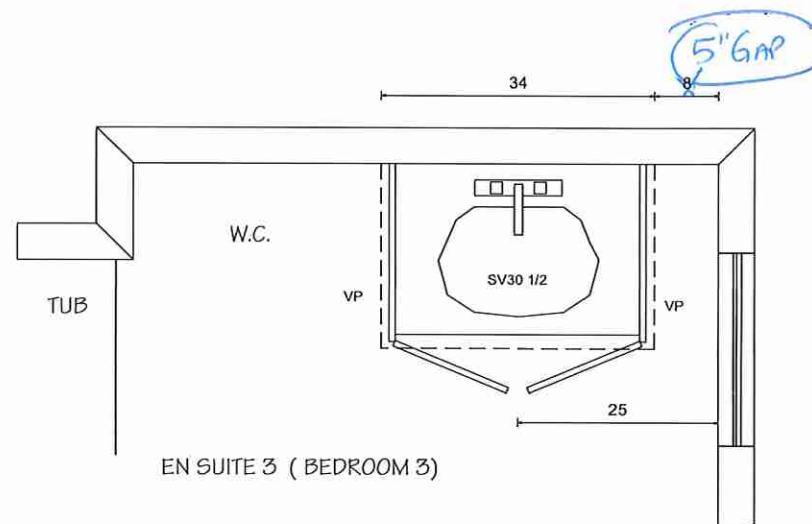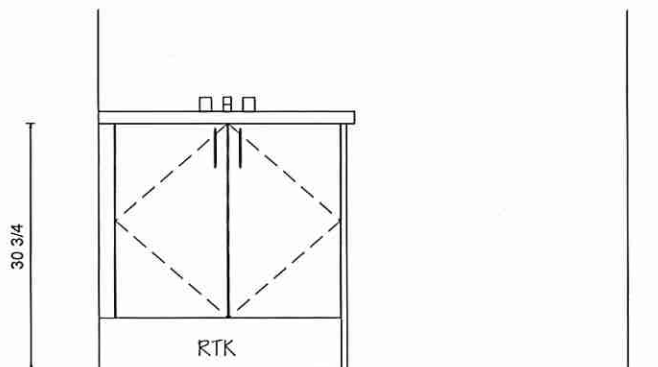

EN SUITE 3 (BEDROOM 3)

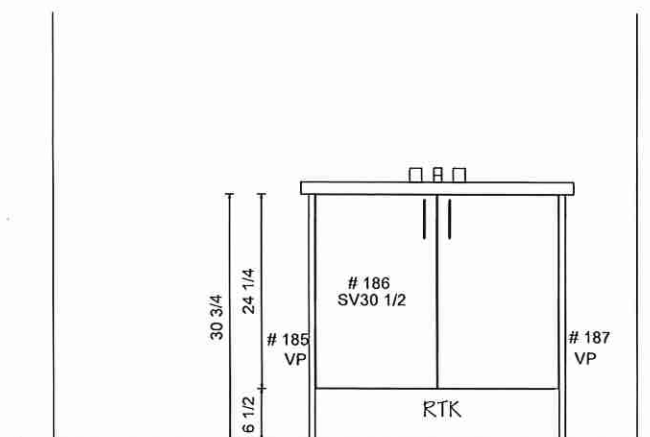

Lot 50 Forestside (Ph 8)

Villa



KITCHENS & FINE CABINETRY LTD

8111 Jane St. Unit 10
 Concord, Ontario L4K 4L7
 Tel. (905) 669- 7028
 Fax. (905) 669 - 7903
 email: designstudio@villakitchens.ca
 www.villakitchens.ca

CLIENT: ROYAL PINE
 PROJECT: FORESTSIDE
 ADDRESS: RP-PH(8) MASTER
 MODEL: 45-05-ELEV A B C WHITE ORCHID

2ND FLOOR LAUNDRY
 5 BEDROOM LAYOUT

DRAWN BY: LAI-YEE
 DATE: July 24, 2023
 REVISION: NOVEMBER 8, 2023
 SCALE:
 PAGE: 14 OF 15

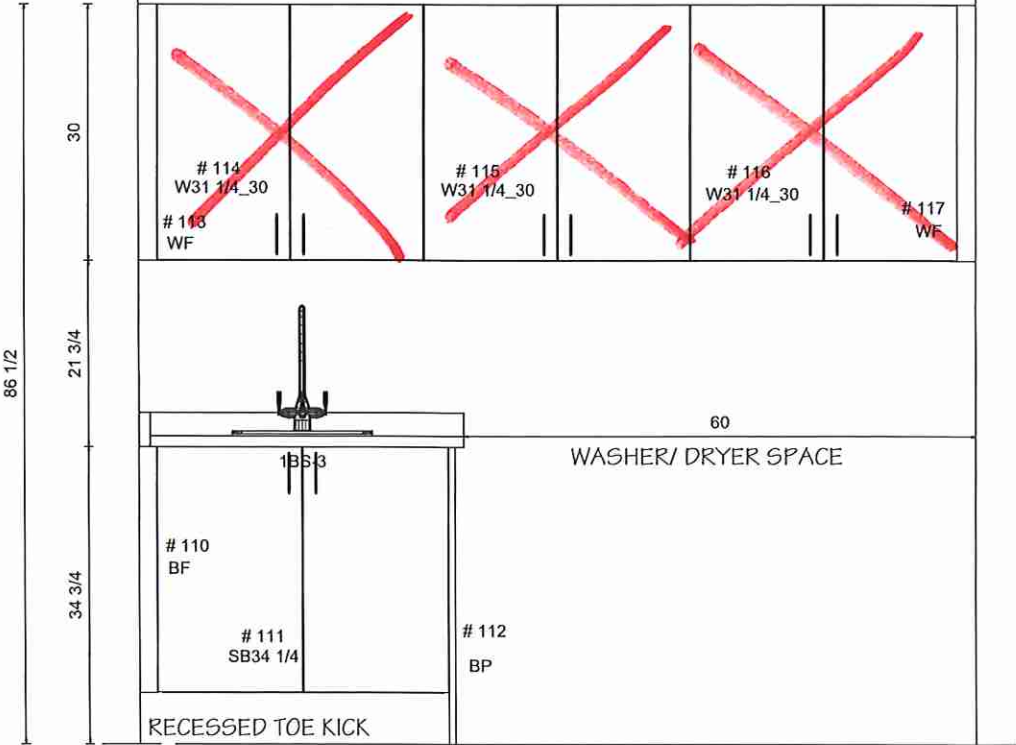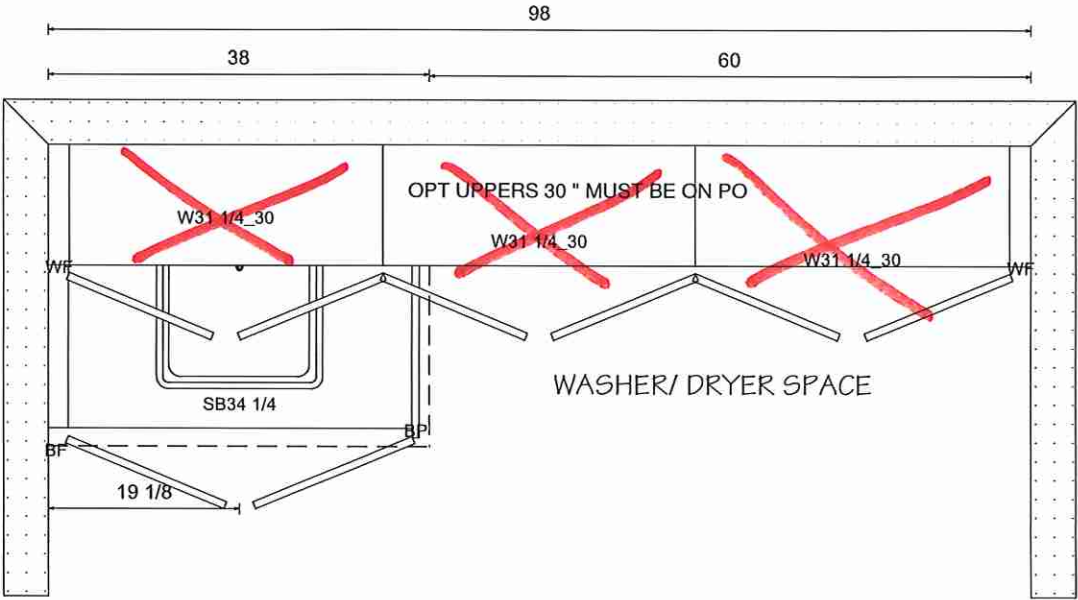

Lot 50 Forestside (Ph8)