

Forestside Estates Inc.

PURCHASERS: NAMRATA NAVANG GANDHI and NAVANG VINODKUMAR GANDHI

TEL:

LOT NUMBER	PHASE	HOUSE TYPE	CLOSING DATE	
51	8	WHITE FIR (45-02B5) - ELEV B - 5 BEDROOM	03-Jul-24	

Date Added: 07-Feb-24 Invoice Number: 8619

1 - Install Standard Cable Rough-Ins (x2) and Install Standard Telephone Rough-Ins (x2) (See Sketch)

Note:

1 - FAMILY ROOM - Install ONE (1) ADDITIONAL ELECTRICAL PLUG at family room. To be installed above fireplace, to accommodate wall mount TV. Plug to be installed Approx. 60" AFF (See Sketch)

Note:

1 - FAMILY ROOM - Install Standard Conduit Pipe at family room above fireplace mantle. To accommodate future installation of wall mount TV. Conduit installed beside electrical plug (See Sketch)

Note:

1 - KITCHEN - In addition to builders standard ceiling light, Install ONE (x1) ADDITIONAL CEILING LIGHT with ONE (x1) Seperate Switch - To be installed centred above kitchen island (See Sketch)

Note

1 - KITCHEN - Relocate Fridge to Sink Wall, beside built-in microwave & wall oven unit. (See Sketch)

Note: As per Nadia Villa

1 - KITCHEN - CABINETRY - Install ADDITIONAL BASE CABINETRY (Approx. 3'-0") on stove wall, to fill opening of original fridge location.

(See Sketch)

Note: As per Nadia Villa

1 - KITCHEN - CABINETRY - Install ADDITIONAL UPPER CABINETRY (Approx. 3'-0") on stove wall, to fill opening of original fridge location.

(See Sketch)

Note: As per Nadia Villa

1 - KITCHEN - CABINETRY - Install FULL DEPTH FRIDGE ENCLOSURE (Includes Applicable Gables) (See Sketch)

Note: As per Nadia Villa

1 - KITCHEN - CABINETRY - Install PRO-SERIES GAS COOK-TOP with TWO (x2) Pot and Pan Drawers Below (See Sketch)

Note: As per Nadia Villa

1 - KITCHEN - Install Upgrade 36" Stainless Steel Exhaust Fan in lieu of builders standard 30" stainless steel exhaust fan (See Sketch)

Note

1 - KITCHEN - Accommodate Stone Countertop for PRO-SERIES Gas Cook-Top at Kitchen (See Sketch)

Note: **Above Price is Subject to Change, Once Appliance Specifications have been Submitted and Reviewed**

1 - KITCHEN - CABINETRY - Install BUILT-IN MICROWAVE AND WALL OVEN with Applicable Drawer Below - To be installed at sink wall,

between dishwasher and relocated fridge. (See Sketch)

Note: As per Nadia Villa

1 - KITCHEN - Install Rough-In Electrical for Built-In Microwave at kitchen (See Sketch)

Note: **Above Price is Subject to Change, Once Appliance Specifications have been Submitted and Reviewed**

1 - KITCHEN - Install Rough-In Electrical for Built-In Wall Oven at kitchen (See Sketch)

Note: **Above Price is Subject to Change, Once Appliance Specifications have been Submitted and Reviewed**

1 - KITCHEN - CABINETRY - Install UPGRADE EXTENDED HEIGHT UPPERS (42" Tall) with LARGE CROWN MOULDING and Applicable

Pan and Fascia - To Extend Up to Touch Ceiling (See Sketch)

Includes Additional Upper Cabinetry Area

Note: As per Nadia Villa

StaConstructionSuymmarySQL.rpt 09May22



Forestside Estates Inc.

PURCHASERS: NAMRATA NAVANG GANDHI and NAVANG VINODKUMAR GANDHI

TEL:

LOT NUMBER	PHASE	HOUSE TYPE	CLOSING DATE	
51	8	WHITE FIR (45-02B5) - ELEV B - 5 BEDROOM	03-Jul-24	

Date Added: 07-Feb-24

Invoice Number: 8619

1 - KITCHEN - CABINETRY - Install DUAL RECYCLE BIN DRAWER WITH SOFT CLOSE - To be installed at kitchen island. (See Sketch)

Note: As per Nadia Villa

1 - KITCHEN - CABINETRY - Install BASE SPICE/OIL PULL OUT with SOFT CLOSE - To be installed beside cook-top (See Sketch)

Note: As per Nadia Villa

1 - KITCHEN - CABINETRY - Accommodate Side of Kitchen Island for STONE WATERFALL EDGE (See Sketch)

Note: As per Nadia Villa

1 - KITCHEN - COUNTERTOP - Install Builders Standard Stone Countertop - EMMERSTONE MAPLE WHITE with - To be installed throughout kitchen, where applicable (does not include stone backsplash) (See Sketch)

Note: As per Andrew Continental

1 - KITCHEN - COUNTERTOP - Install UPGRADE COUNTERTOP "L" EDGE - To be installed throughout kitchen countertop, where applicable

(See Sketch)

Note: As per Andrew Continental

1 - KITCHEN - FULL HEIGHT BACKSPLASH - Install FULL HEIGHT STONE BACKSPLASH - EMMERSTONE MAPLE WHITE - To be

installed throughout kitchen, where applicable (does not include behind the fridge) (See Sketch)

Note: As per Andrew Continental

1 - KITCHEN - COUNTERTOP - Install STONE WATERFALL at Kitchen Island (x1 Side) (Emmerstone Maple White) (See Sketch)

Note: As per Andrew Continental

Please Note - Stone Waterfall to accommodate standard electrical plug

1 - DISCLAIMER - STONE COUNTEROP & BACKSPLASH;

KITCHEN - Due to the many variables that can affect the pattern, colour and/or design of stone installed will not be identical to the samples displayed.

Note: Every effort is made to provide stone countertops as close as possible but the vendor is not responsible for results which differ from the sample displayed. All countertop surfaces may have seams, and product pattern and shade can change in areas containing seams.

1 - DISCLAIMER - STONE COUNTERTOP & BACKSPLASH;

KITCHEN - Stone slabs vary in size & all seams are visible & the fabricator reserves the right to position the seams as necessary. Note:

1 - KITCHEN - KITCHEN SINK - Install Upgrade Undermount Sink - BLANCO FORMERA U Super Single Undermount Sink - Model #402241 (See Sketch)

Sketch

1 - KITCHEN - KITCHEN FAUCET - Install Builders Standard Faucet - MOEN Method Single Handle Pull-Out (Single Hole) Kitchen Faucet - Model

7585 – Chrome Note:

1 - MAIN FLOOR BATHROOM - COUNTERTOP - Install Builders Standard Stone Countertop - EMMERSTONE MAPLE WHITE with

STANDARD " A " EDGE PROFILE - To be installed throughout main floor bathroom vanity, where applicable (Includes Applicable Splash) (See Sketch)
Note:

1 - PRIMARY ENSUITE - COUNTERTOP - Install Builders Standard Stone Countertop – EMMERSTONE MAPLE WHITE with STANDARD "A" EDGE PROFILE - To be installed throughout primary ensuite vanity, where applicable (Includes Applicable Splash) (See Sketch)

Note:

1 - ENSUITE #2 - COUNTERTOP - Install Builders Standard Stone Countertop - EMMERSTONE MAPLE WHITE with STANDARD " A " EDGE

PROFILE - To be installed throughout ensuite #2 vanity, where applicable (Includes Applicable Splash) (See Sketch)

Note:

StaConstructionSuymmarySQL.rpt 09May22 Page 3 of 5



Forestside Estates Inc.

PURCHASERS: NAMRATA NAVANG GANDHI and NAVANG VINODKUMAR GANDHI

TEL:

	,			
LOT NUMBER	PHASE	HOUSE TYPE	CLOSING DATE	
51	8	WHITE FIR (45-02B5) - ELEV B - 5 BEDROOM	03-Jul-24	

Date Added: 07-Feb-24

Invoice Number: 8619

- 1 ENSUITE #3 COUNTERTOP Install Builders Standard Stone Countertop EMMERSTONE MAPLE WHITE with STANDARD " A " EDGE PROFILE To be installed throughout ensuite #3 vanity, where applicable (Includes Applicable Splash) (See Sketch)
- 1 SHARED BATH 4/5 COUNTERTOP Install Builders Standard Stone Countertop EMMERSTONE MAPLE WHITE with STANDARD "A" EDGE PROFILE To be installed throughout shared bath 4/5 vanity, where applicable (Includes Applicable Splash) (See Sketch). Note:
- 1 DISCLAIMER STONE COUNTEROP
- ALL BATHROOMS Due to the many variables that can affect the pattern, colour and/or design of stone installed will not be identical to the samples displayed.

Note: Every effort is made to provide stone countertops as close as possible but the vendor is not responsible for results which differ from the sample displayed. All countertop surfaces may have seams, and product pattern and shade can change in areas containing seams.

- 1 DISCLAIMER STONE COUNTERTOP;
- ALL BATHROOMS Stone slabs vary in size & all seams are visible & the fabricator reserves the right to position the seams as necessary. Note:
- 1 MAIN FLOOR BATHROOM VANITY SINK Install Upgrade Undermount Sink CONTRAC CATENA Undermount Sink Model #4210 CIY WHITE (x1 Sink) **Includes Cut & Polish** (See Sketch)

Note: **To Be Installed with Standard Faucet**

2 - PRIMARY ENSUITE - VANITY SINK - Install Upgrade Undermount Sink - CONTRAC CATENA Undermount Sink - Model #4210 CIY WHITE (x2 Sink) **Includes Cut & Polish** (See Sketch)

Note: **To Be Installed with Standard Faucet**

1 - ENSUITE #2 - VANITY SINK - Install Upgrade Undermount Sink - CONTRAC CATENA Undermount Sink - Model #4210 CIY WHITE (x1 Sink) **Includes Cut & Polish** (See Sketch)

Note: **To Be Installed with Standard Faucet**

1 - ENSUITE #3 - VANITY SINK - Install Upgrade Undermount Sink - CONTRAC CATENA Undermount Sink - Model #4210 CIY WHITE (x1 Sink) **Includes Cut & Polish** (See Sketch)

Note: **To Be Installed with Standard Faucet**

1 - SHARED BATH 4/5 - VANITY SINK - Install Upgrade Undermount Sink - CONTRAC CATENA Undermount Sink - Model #4210 CIY WHITE (x1 Sink) **Includes Cut & Polish** (See Sketch)

Note: **To Be Installed with Standard Facuet**

1 - PURCHASER HAS ATTENDED A DECOR APPOINTMENT AT THE DESIGN STUDIO AND HAS DECLINED ANY ADDITIONAL UPGRADES. Purchaser accepts & acknowledges that there will be no further changes/additions/deletions to be made upon signing on FEBRUARY 7 2024

Note:

1 - PURCHASER AWARE AND ACCEPTS THAT ANY CHANGES MADE TO UPGRADES AFTER SIGNING THIS PURCHASERS EXTRA FORM ARE SUBJECT TO A MINIMUM ADMINISTRATION FEE OF \$1,000

Note:

Date Added: 04-Dec-23

Invoice Number: 8538

1 - BASEMENT - Purchaser has DECLINED upgrade to increase basement ceiling height.

Note:

5 - BASEMENT - Increase FIVE (x5) Basement Windows from Standard 30 IN (W) x 16 IN (H) TO LARGER 30 IN (W) x 24 IN (H) (with Possible Window Wells) (See Sketch)

Note:

1 - FRONT EXTERIOR - FRONT DOORS - Install EXTENDED HEIGHT DOUBLE DOOR ENTRY (Delete Transom Window Above) in lieu of builders standard height double door entry (See Sketch)

Note:



Forestside Estates Inc.

PURCHASERS: NAMRATA NAVANG GANDHI and NAVANG VINODKUMAR GANDHI

TEL:

LOT NUMBER	PHASE	HOUSE TYPE	CLOSING DATE	
51	8	WHITE FIR (45-02B5) - ELEV B - 5 BEDROOM	03-Jul-24	

Date Added: 04-Dec-23

Invoice Number: 8538

- 1 SIDE EXTERIOR Install OPTIONAL SIDE DOOR ENTRANCE (Includes Applicable Exterior Coach Light) **If Grade Permits** (See Sketch) Note:
- 1 BASEMENT Install UPGRADE 200 AMP Service in lieu of builders standard 100 amp (See Sketch)

Note:

1 - KITCHEN - Install GAS LINE ROUGH-IN for stove at kitchen **Includes Applicable Electrical** (See Sketch)

Note: PLEASE NOTE - Additional Electrical May Be Required Once Appliance Specifications are Submitted & Reviewed

1 - PLAN CHANGE - Plan Change Fee To Accommodate Changes Listed in Below Items (See Below Items)

Note: As per Steve C.

1 - MUD ROOM - Location of side door and closet to be switched. Closet to be installed on exterior wall of mud room. Side door to be installed beside laundry room. (See Sketch)

Note: Entry door from garage to mud room to shift towards main hall to accommodate new locations of side door and closet (See Sketch)

Approved by Tony Priced as per Steve C

1 - POWDER ROOM - Increase Powder Room by shifting wall between powder room into living room. Living room size to decrease. Add Shower Stall Approx. 36" x 36" to powder room. Shower to include chrome framed shower door & panel. (See Sketch)

Note: Approved by Tony

1 - LIVING ROOM - Install STANDARD INTERIOR DOOR (Standard Height, & Standard Style) at entrance of living room from main hall (See Sketch)

Note: Approved by Tony

1 - BEDROOM #2 - Re-locate bathroom between bedroom #2 and bedroom #3 to Bedroom #2. To be installed against staircase wall. Bathroom to Include; Standard Tub/Shower Enclosure, Toilet and Sink Sink Vanity (See Sketch)

Note: Walk-In Closet at bedroom #2 to increase in length.

Approved by Tony

1 - BEDROOM #3 - Convert Walk-In Closet at bedroom #3 to FULL BATHROOM. To Include; Standard Floor & Wall Tiles, Standard Plumbing, Tub/Shower Enclousre, Toilet and Single Sink Vanity (See Sketch)

Note: Approved by Tony

1 - BEDROOM #3 - Install TWO (x2) DOUBLE DOOR CLOSETS at Bedroom #3 (See Sketch)

Note: Approved by Tony

1 - BONUS PACKAGE - PURCHASER HAS APPLIED \$30,000.00 (Incudes Taxes) WORTH OF UPGRADE PROMOTIONAL PACKAGE TOWARDS THE PURCHASE OF STRUCTURAL UPGRADES COMPLETED AT THE DECOR CENTRE

Note:

1 - PURCHASER HAS ATTENDED A STRUCTURAL APPOINTMENT AT THE DESIGN STUDIO & HAS DECLINED ANY ADDITIONAL UPGRADES. Purchaser accepts & acknowledges that there will be no further structural changes/additions/deletions to be made upon signing on NOVEMBER 28.2023

Note:

Note:

1 - PURCHASER AWARE AND ACCEPTS THAT ANY CHANGES MADE TO UPGRADES AFTER SIGNING THIS PURCHASERS EXTRA FORM ARE SUBJECT TO A MINIMUM ADMINISTRATION FEE OF \$1,000

This Document is Extremely Time Sensitive - Printed 13 Feb 24 at 10:55

StaConstructionSuymmarySQL.rpt 09May22 Page 5 of 5

* INTERIOR COLOUR SCHEME *

(NE)	Purchasers	Decor Consultant	Model and Elevation	Telephone Res. / Bus	Project	Clo	Closing Date	Property
RATA NAVANG GANDI	OHI & NAVANG VINODKUMAR GANDH	Melissa Di Marino	WHITE FIR (45-02B5) - ELEV B - 5 BEDROOM	1	Forestside Estates Inc.	C	3/07/2024	51
ge 1 of 3	Flooring	3.0000	all Tile			3	*	Plumbii
MARY ENSUITE	Description 13x13 KEATON ICE (STD)	Mair 4 8v10		<u>ccent/Insert</u> ONE	Border / Listello NONE		Pattern NONE	WHITE
suite #2								
	13x13 KEATON ICE (STD)			ONE	NONE		NONE	WHITE
suite #3	13x13 KEATON ICE (STD)	8x10) KEATON ICE (STD)	ONE	NONE	NONE		WHITE
ared Bath 4/5	13x13 KEATON ICE (STD)	₩ 8x10) KEATON ICE (STD)	ONE	NONE		NONE	WHITE
inFloor Bathroom	18x18 TAJ MAHAL (STD)	8X10	0 MALENA ICE (STD)	ONE	NONE		NONE	WHITE
chen/Breakfast	18x18 TAJ MAHAL (STD)	Emm	nerstone Maple White (UPG)	ONE	NONE		NONE	SeeNotes
undry Room	18x18 TAJ MAHAL (STD)	N/A	N	/A	N/A		NONE	STD
d Room	V 18x18 TAJ MAHAL (STD)	N/A	N		N/A		NONE	N/A
			ailings and Stairs		<u> </u>	Camala a Massia][[
	. (10.10.74 1444141 (077)		ullings STD - OVAL - Vintage Red Oak Nat	ural Landing - Uppe 31/	4" VintageRedOakNatural (STD)	Cornice Mould	NONE	
yer	18x18 TAJ MAHAL (STD)	Pic	ckets STD - Steel 1/2" Square, Plain - Flat			Living Room NONE		
in Hall	3 1/4" x 3/4" VINTAGE REDOAK N	ATURAL (STD)	osts STD- 3 1/2"Squarew/Cap-Vint.RedC			Dining Room		
nily Room	3 1/4" x 3/4" VINTAGE REDOAK N	ATURAL (STD)	ringers STD - VINTAGE RED OAK NATUR	Family Room	NONE			
ing Room	√ 3 1/4" x 3/4" VINTAGE REDOAK N.	TUDAL (CTD)	eads STD - VINTAGE RED OAK NATUR			Main Hall	NONE	
ing Room	✓ 3 1/4" x 3/4" VINTAGE REDOAK N		Risers &TD - VINTAGE RED OAK NATURAL			Kitchen	NONE	
		Ru	Inner NONE			2nd Floor Hall	NONE	
		— Tr	rim —	14		Ziiu Fiooi Haii	NONE	
	6	Ba	seboard & Casing STANDARD - COLO	NIAL Knobs STANE	DARD			
per Hall	√3 1/4" x 3/4" VINTAGE REDOAK N	ATURAL (STD) Fro	ont Door Glass STANDARD	Hinges STAND	DARD			
		Inte	terior Doors STANDARD - CARR	ARA,SMOOTH Grip Set STAND	DARD			
mary Bedroom	BROADLOOM - Opening Night 400		otes					
droom 2	BROADLOOM - Opening Night 400	2-21 (STD)	IMARY ENSUITE - Install 2x2 WHITE Mosa artz	ic Floor Tiles and 6" Curb with White Qu	iartz <mark>**MAIN FLOOR BATHROOM - I</mark>	Install 2x2 WHITE M	osaic Floor Tiles a	nd 6" Curb with
droom 3	BROADLOOM - Opening Night 400							
droom 4	BROADLOOM - Opening Night 400							
droom 5	BROADLOOM - Opening Night 400							
aroom v	BNOADLOOM - Opening Night 400		ge 1 of 3	aldCordhi	Soordhi	ı		0

Lot: 51 Project: Forestside Estates Inc. Model: WHITE FIR (45-02B5) - ELEV B - 5 BEDROOM

Printed Feb 07, 2024 11:44 am


* INTERIOR COLOUR SCHEME *

		Decor Consultant Melissa Di Marino	1 1 1 1 1 1 1 1 1 1 1 1 1 1 1 1 1 1 1		Res. / Bus	Project Forestside Estates Inc.	Closing Date 03/07/2024	Property 51
Page 2 of 3	Interior Paint	Cabinet	-					d
Primary Ensuite	Description CHANDARD CHANDARD	Style	MINE EDGE ODIDIT LEGG (OTD)			Countertop	Counter Edge	Handle / Knob
	STANDARD - SILVER BIRCH	EURO MELA	AMINE - FREE SPIRIT L580 (STD)		√ [Emmerstone Maple White (STD)	" A " EDGE (STD)	BP81092-195
Ensuite #2	STANDARD - SILVER BIRCH	EURO MELA	AMINE - FREE SPIRIT L580 (STD)			Emmerstone Maple White (STD)	A " EDGE (STD)	BP81092-195
Ensuite #3	STANDARD - SILVER BIRCH	EURO MELA	AMINE - FREE SPIRIT L580 (STD)		√E	Emmerstone Maple White (STD)	" A " EDGE (STD)	BP81092-195
Shared Bath 4/5	STANDARD - SILVER BIRCH	EURO MELA	AMINE - FREE SPIRIT L580 (STD)		VE	Emmerstone Maple White (STD)	A " EDGE (STD)	BP81092-195
MainFloor Bathroom	STANDARD - SILVER BIRCH	EURO MELA	AMINE - FREE SPIRIT L580 (STD)		E	Emmerstone Maple White (STD)	" A " EDGE (STD)	BP81092-195
Kitchen/Breakfast	STANDARD - SILVER BIRCH	EURO MELA	AMINE - FREE SPIRIT L580 (STD)		$\checkmark_{\scriptscriptstyle{E}}$	Emmerstone Maple White (STD)	L * EDGE (UPG)	BP81092-195
Laundry Room	STANDARD - SILVER BIRCH	EURO MELA	AMINE - WHITE W100 (STD)] 9	949-58 WHITE (STD)	STANDARD	9531-PC
Mud Room	STANDARD - SILVER BIRCH	N/A			<u> </u>	N/A	N/A	N/A
Foyer Main Hall	STANDARD - SILVER BIRCH STANDARD - SILVER BIRCH			Range SEE VILLA LA		SINK - Install Upgrade I Model #402241 **KITCH	JPGRADE 36" STAINLESS STEEL EXHA Jndermount Sink - Blanco Formera U Sup EN FAUCET - Install Standard Kitchen F Single Hole) Kitchen Faucet - Model # 75	er Single Undermount aucet - MOEN Method
Family Room	STANDARD - SILVER BIRCH			Exhaust Opening	6" 08"			
Living Room	STANDARD - SILVER BIRCH	Dishwash	er Cabinet SEE VILLA LAYOUT					
Dining Room	STANDARD - SILVER BIRCH	Fireplace						
		Fireplace		Fireplace	N/A			
Upper Hall	STANDARD - SILVER BIRCH		Flooring_3 1/4" HARDWOOD	Location Floor	ing N/A			
Primary Bedroom	STANDARD - SILVER BIRCH	Style Finish	VILLA NOVA STONE	Style Finish	N/A N/A			
Bedroom 2	STANDARD - SILVER BIRCH	Marble	N/A	Marble	N/A			
Bedroom 3	STANDARD - SILVER BIRCH	Hearth	NONE	Hearth	N/A			
Bedroom 4	STANDARD - SILVER BIRCH	Page 2 of 3	3		1 W			
Bedroom 5	STANDARD - SILVER BIRCH	Decor Con	DOL	de	production	Purchaser: Mouralk	v.	

Lot: 51 Project: Forestside Estates Inc. Model: WHITE FIR (45-02B5) - ELEV B - 5 BEDROOM

NAVANG VINODKUMAR GANDHI

Printed Feb 07, 2024 11:44 am

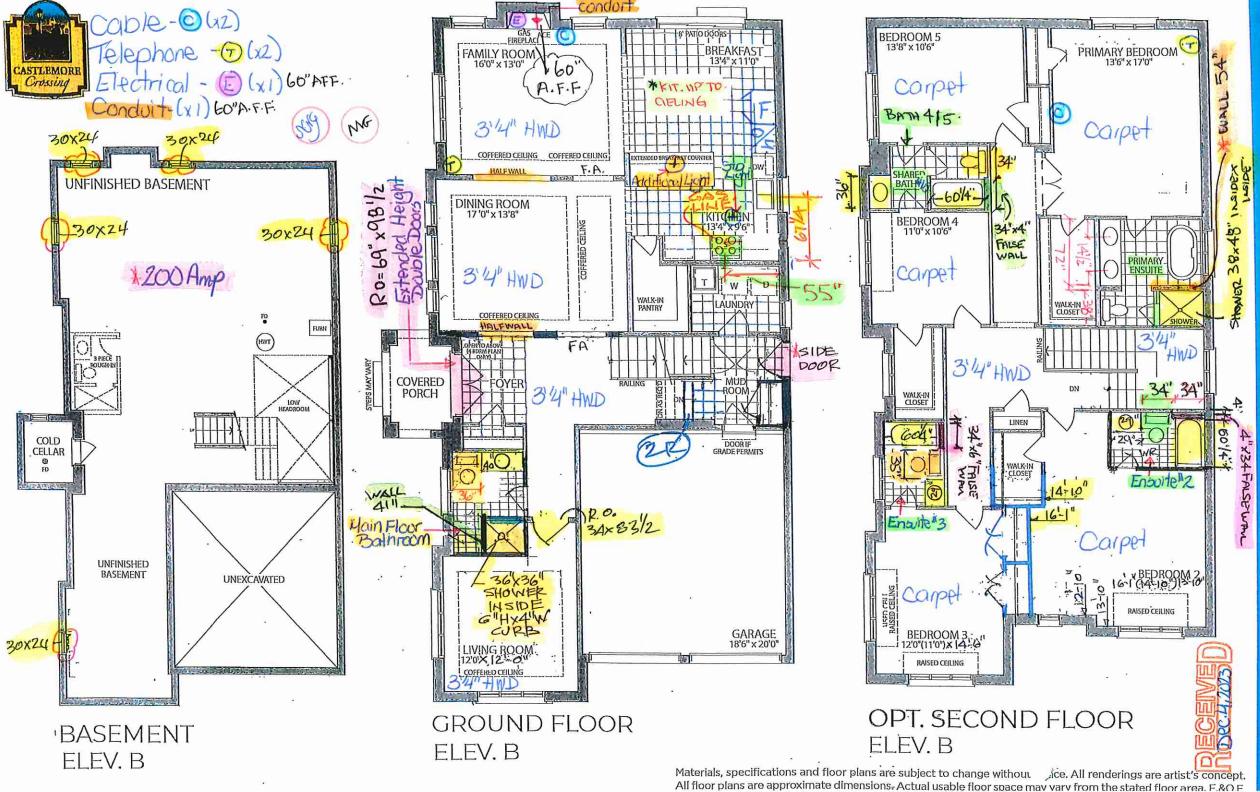



8111 Jane St. Unit 10 Concord, Ontario L4K 4L7 Tel. (905) 669- 7028 Fax. (905) 669 - 7903 email: designstudio@villakitchens.ca www.villakitchens.ca

CLIENT: ROYAL PINE

PROJECT: FORESTSIDE PH8

ADDRESS: RP-FS(8)-LOT 51 REVISED

MODEL: 45-02-CORNER-ELEV A B C

KITCHEN

DOOR STYLE: EURO DOOR PROFILE: N/A MATERIAL: MELAMINE FINISH: FREE SPIRIT L580

INTERIORS: WHITE

CROWN MOLD: LRG EURO CM

PAN MOLD: SQUARE PAN LIGHT VALANCE: N/A INSTALL HEIGHT: 98 5/8"H

INT HW: STANDARD

HW:

COUNTERTOP






DRAWN BY: ELISA

DATE:

REVISION: FEB 5, 2024

SCALE:

PAGE: 1 OF 10

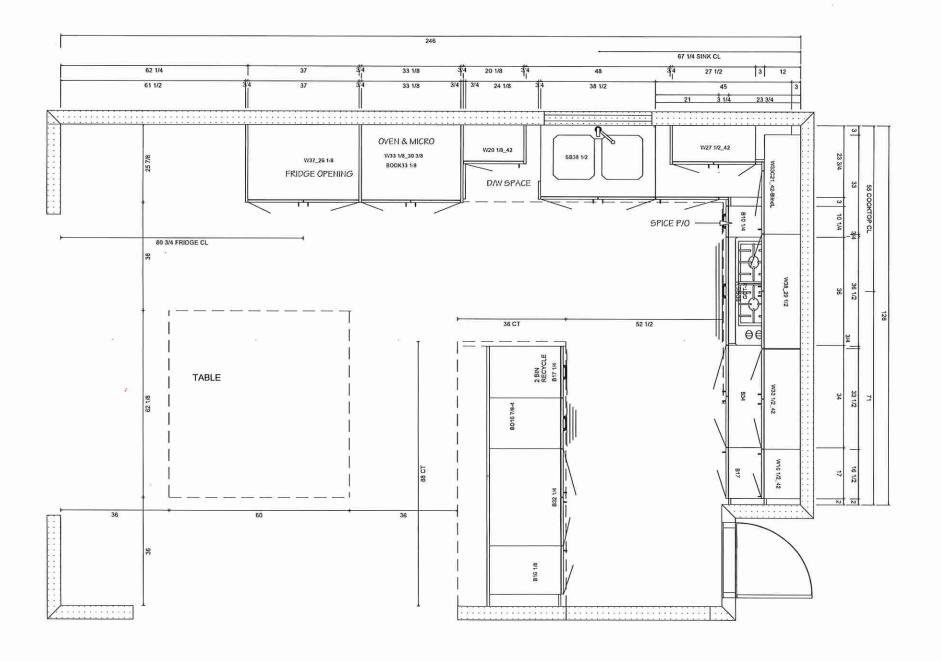



8111 Jane St. Unit 10 Concord, Ontario L4K 4L7 Tel. (905) 669-7028 Fax. (905) 669 - 7903 email: designstudio@villakitchens.ca www.villakitchens.ca

CLIENT: ROYAL PINE

PROJECT: FORESTSIDE PH8

ADDRESS: RP-FS(8)-LOT 51 REVISED

MODEL: 45-02-CORNER-ELEV A B C

SINK WALL DOOR STYLE: EURO DOOR PROFILE: N/A MATERIAL: MELAMINE FINISH: FREE SPIRIT L580

INTERIORS: WHITE

CROWN MOLD: LRG EURO CM PAN MOLD: SQUARE PAN LIGHT VALANCE: N/A INSTALL HEIGHT: 98 5/8"H

INT HW: STANDARD

HW:


COUNTERTOP



DRAWN BY: ELISA DATE: FEB 5, 2024

REVISION: SCALE:

PAGE: 2 OF 10

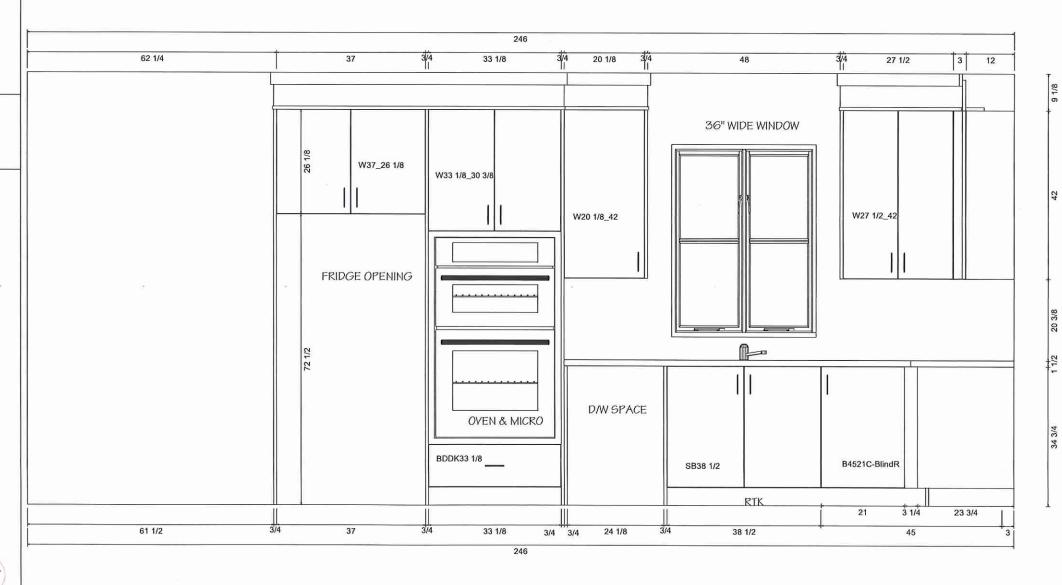



8111 Jane St. Unit 10 Concord, Ontario L4K 4L7 Tel. (905) 669- 7028 Fax. (905) 669 - 7903 email: designstudio@villakitchens.ca www.villakitchens.ca

CLIENT: ROYAL PINE

PROJECT: FORESTSIDE PH8

ADDRESS: RP-FS(8)-LOT 51 REVISED

MODEL: 45-02-CORNER-ELEV A B C

RANGE WALL DOOR STYLE: EURO DOOR PROFILE: N/A MATERIAL: MELAMINE FINISH: FREE SPIRIT L580 INTERIORS: WHITE

CROWN MOLD: LRG EURO CM PAN MOLD: SQUARE PAN LIGHT VALANCE: N/A INSTALL HEIGHT: 98 5/8"H

INT HW: STANDARD

HW:

COUNTERTOP




DRAWN BY: ELISA

DATE:

REVISION: FEB 5, 2024

SCALE:

PAGE: 3 OF 10

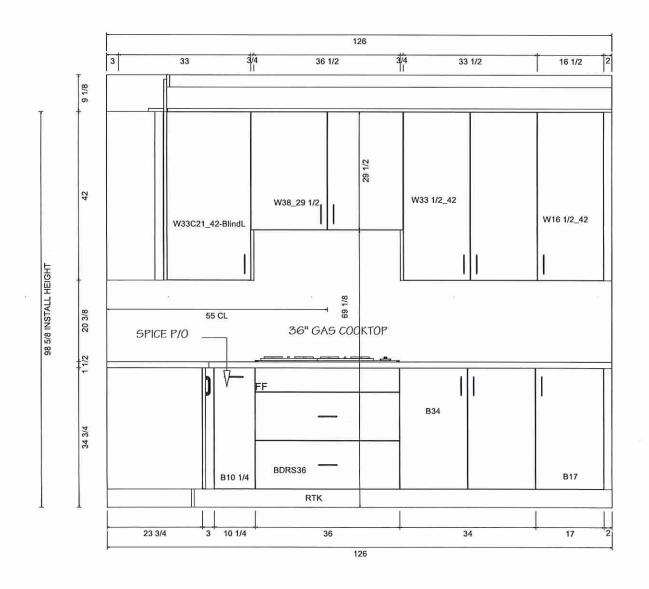

SITCHENS & FINE CABINETRY LTD

8111 Jane St. Unit 10 Concord, Ontario L4K 4L7 Tel. (905) 669- 7028 Fax. (905) 669 - 7903 email: designstudio@villakitchens.ca www.villakitchens.ca


CLIENT: ROYAL PINE


PROJECT: FORESTSIDE PH8

ADDRESS: RP-FS(8)-LOT 51 REVISED

MODEL: 45-02-CORNER-ELEV A B C


ISLAND

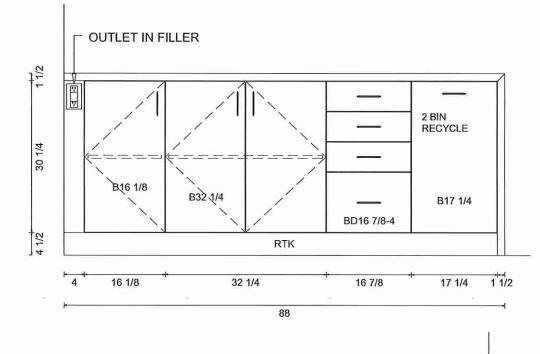

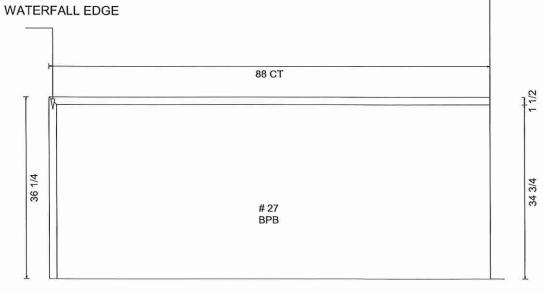

86 1/2

OUTLET LOCATION ON ISLAND TBD FOR THE CLIENT PRIOR PRODUCTION

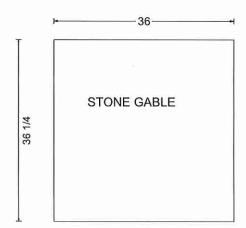



1 1/2

DRAWN BY: ELISA

DATE:

REVISION: FEB 5, 2024

SCALE:

PAGE: 4 OF 10

Lot 51 Forestside (Pha)

Jilla KITCHENS & FINE CABINETRY LID

8111 Jane St. Unit 10 Concord, Ontario L4K 4L7 Tel. (905) 669-7028 Fax. (905) 669 - 7903 email: designstudio@villakitchens.ca www.wilakitchens.ca

CLIENT: ROYAL PINE

PROJECT: FORESTSIDE PH8

ADDRESS: RP-FS(8)-LOT 51 REVISED

MODEL: 45-02-CORNER-ELEV A B C

VANITIES STANDARD LAYOUT




DRAWN BY: LAI- YEE


DATE: JULY 06, 2023 REVISION: NOVEMBER 8, 2023


SCALE:

PAGE: 5 OF 7

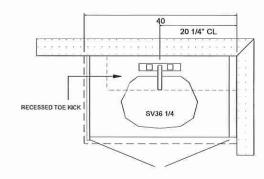




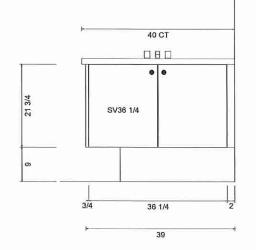

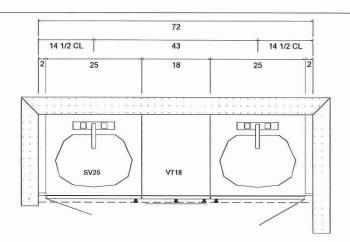

PRIMARY ENSUITE

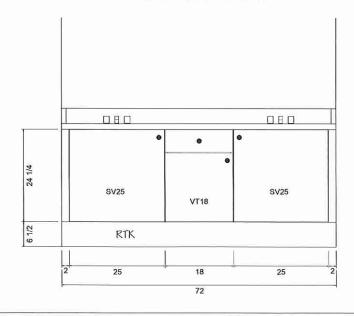

Lot 51 Forestside (Ph8)

Julia KITCHENS & EINE CABINETS VI TO

8111 Jane St. Unit 10 Concord, Ontario L4K 4L7 Tel. (905) 669- 7028 Fax. (905) 669 - 7903 email: designstudio@villakitchens.ca www.villakitchens.ca

CLIENT: ROYAL PINE

PROJECT: FORESTSIDE PH8

ADDRESS: RP-FS(8)-LOT 51 REVISED

MODEL: 45-02-CORNER-ELEV A B C

VANITIES VANITIES




DRAWN BY: LAI- YEE

DATE: JULY 06, 2023

REVISION: NOVEMBER 8, 2023

SCALE

PAGE: 6 OF 7

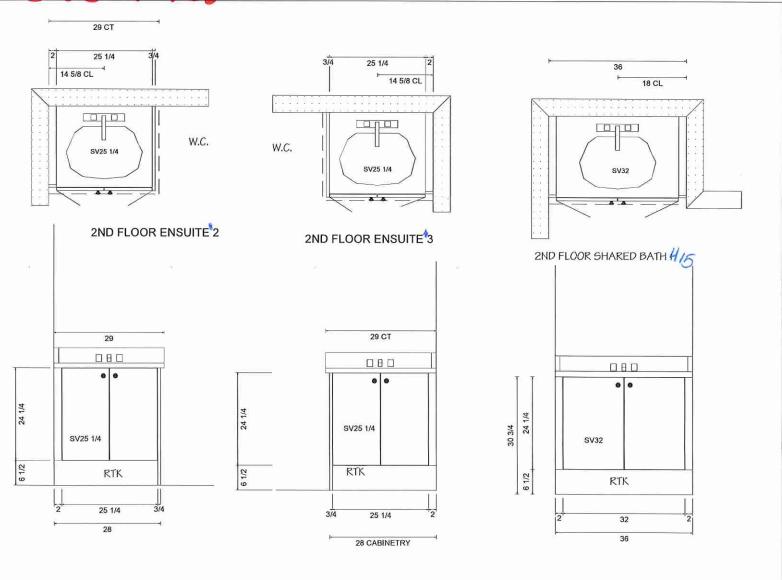

Lot 51 Forestside (Ph.8)

Tilla KITCHENS & FINE CABINETRY I TO

8111 Jane St. Unit 10 Concord, Ontario L4K 4L7 Tel. (905) 669-7028 Fax. (905) 669-7903 email: designstudio@villakitchens.ca www.villakitchens.ca

CLIENT: ROYAL PINE

PROJECT: FORESTSIDE PH8


ADDRESS: RP-FS(8)-LOT 51 REVISED

MODEL: 45-02-CORNER-ELEV A B C

LAUNDRY



DRAWN BY: LAI- YEE
DATE: JULY 06, 2023
REVISION: NOVEMBER 8, 2023
SCALE:
PAGE: 7 OF 7

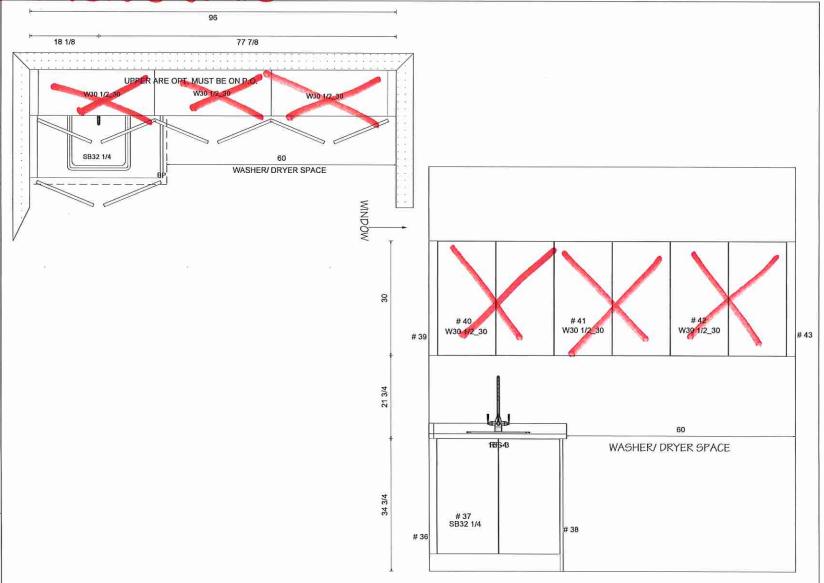

Lot 51 Forestside (Ph.8) BLANCO





Sink Specifications

Colour

SKU

satin polish

402241

Design and planning tips

· Min cabinet size: 36 in (915 mm)

Specifications:

3 ½" stainless steel strainer(s), Installation instructions, Cut-out template, Undermount clips, Limited Lifetime Warranty

Codes & Standards

ASME A112.19.3-2017/CSA B45.4-17

Optional Accessories

CapFlow Strainer Cover 517666 Sink Grid 402248

32"

FORMERA U Super Single

Stainless steel satin polish



Warranty

Limited lifetime warranty on all sinks and faucets. One-year warranty on all accessories and soap dispensers.

Code/Standards Compliance

BLANCO sinks and faucets are third-party tested and certified to CSA, cUPC, ANSI/ASME, IAPMO and NSF standards and listed by applicable certification bodies. For more information on individual product listings, contact our office or listing organization.



Need support? Learn more by watching our sink & faucet How-to videos: https://www.blanco.com/ca-en/support/how-to-videos/how-to-videos-for-sinks/



BLANCO Canada Inc 100 Corporation Drive Brampton ON L6S 6B5 Tel & Fax

Tel: 905-494-2400 Toll free: 1-877-425-2626 Fax: 905-494-2425 Toll free: 1-877-825-2626


While BLANCO strives to provide accurate information, all images and dimensions in this document are intended for reference only and are subject to change at any time without notice. This document is not intended for use as an installation guide. For technical installation details, refer to installation instructions provided with the product. BLANCO assumes no responsibility for the use of superseded or voided specifications.

Lot 51 Forestside (Ph.8)

CONTRAC CATENA





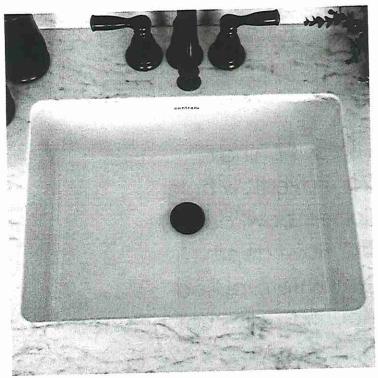

Rectangular Undermount Sink 4210CIY

Vitreous china
Front overflow hole
Template supplied
Faucet not included
Mounting clips not included
20" W x 15%" D x 7½" H



* Primary Ensuite (x2)

* Ensuite #2 (x1)

* Ensuite *3 (x1)



6/13/2023

CONTRAC.CA

Installed with Builders Standard Faucel