




9' BSMNT

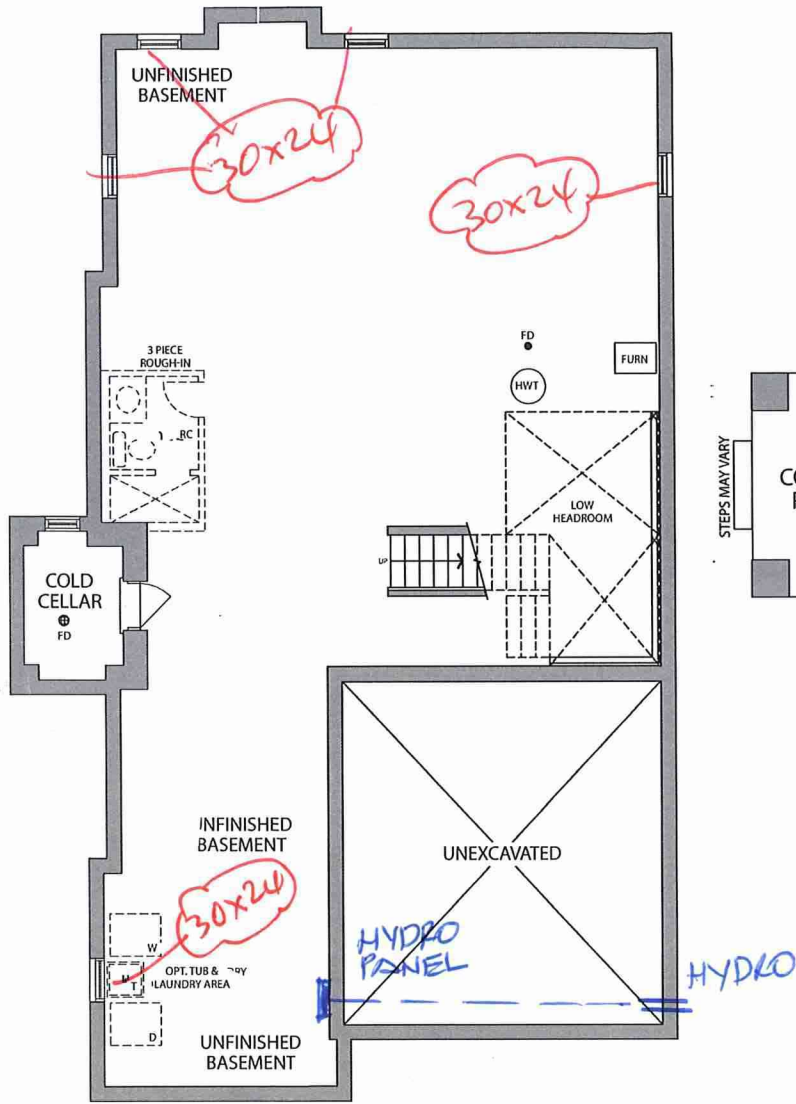

BASEMENT
ELEV.C

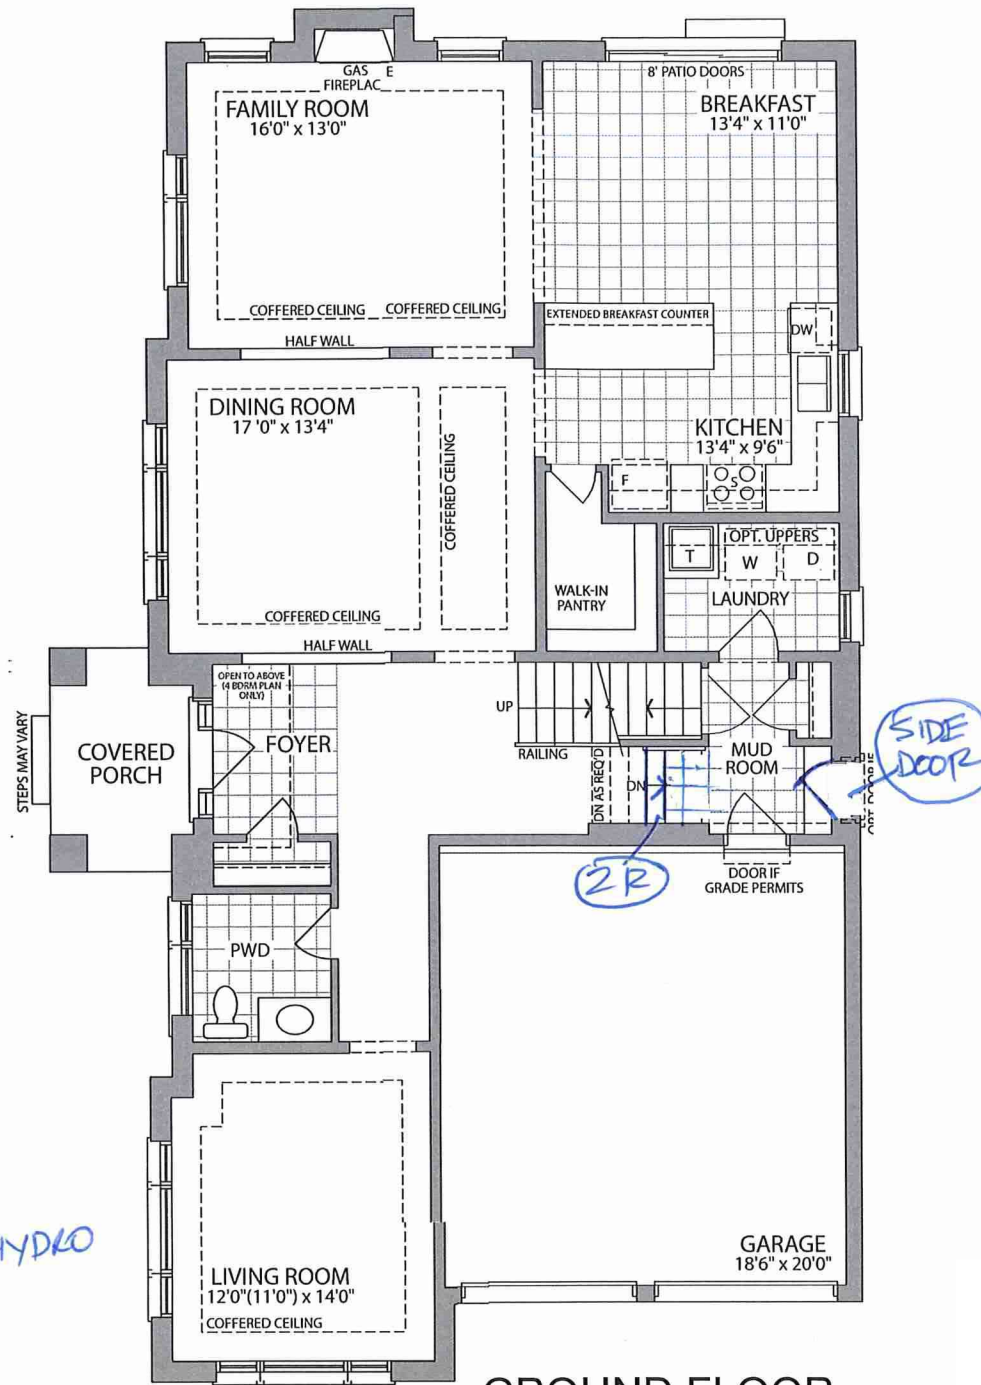

GROUND FLOOR
ELEV. C

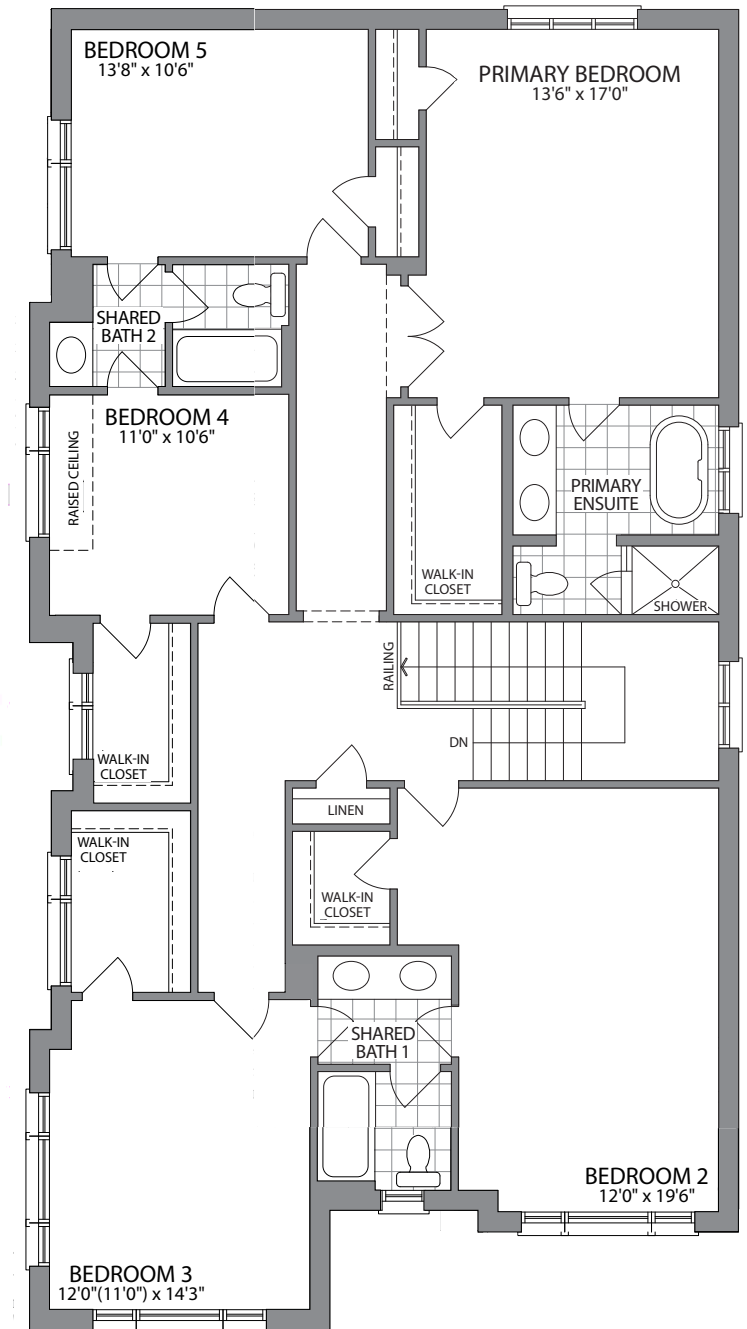

OPT. SECOND FLOOR
ELEV. C

Materials, specifications and floor plans are subject to change without notice. All renderings are artist's concept. All floor plans are approximate dimensions. Actual usable floor space may vary from the stated floor area. E.&O.E.


LOT 33. 45-02 . The White Fir . EL.C. 5 BEDROOMS . 3350 SQ.FT.




THE WHITE FIR (45-02)



45' LOT 33 ELEVATION C 3350 SQUARE FEET

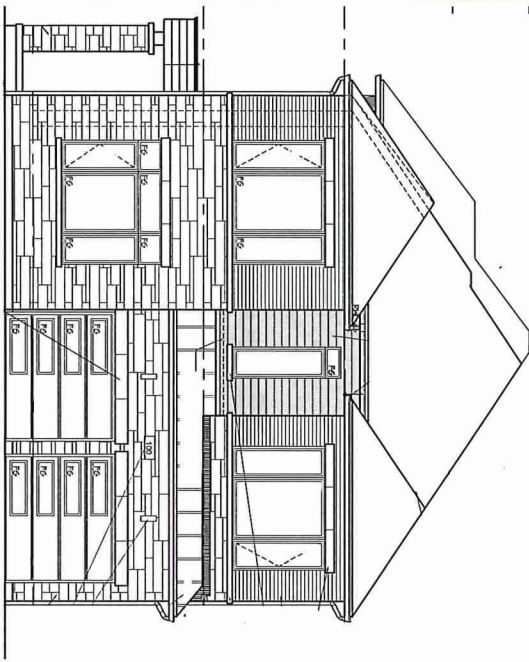

FRONT ELEVATION 'C'

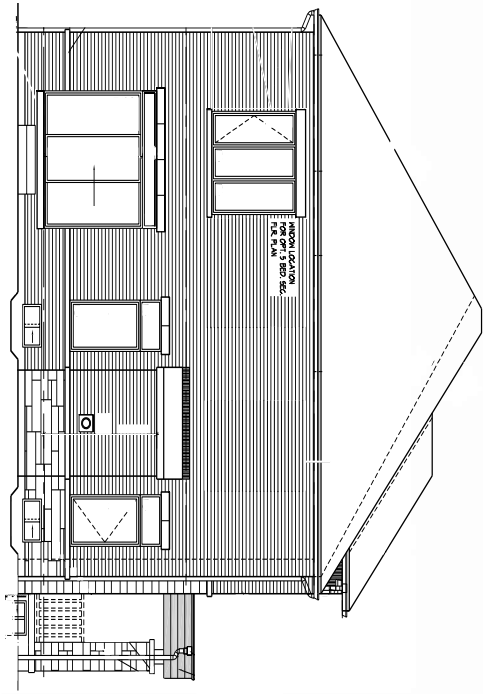

REAR ELEVATION 'C'
OPT. 5 BED. SEC. FLR. PLAN