



SITE FILE COPY

STRUCTURAL

CONSTRUCTION SUMMARY
Forestside Estates Inc.

* INVENTORY *


* INVENTORY *

LOT NUMBER	PHASE	HOUSE TYPE	CLOSING DATE
32	8	SILVER POPLAR (40-02B) - ELEV B	


Offer	
Worksheet	Note:

1 - SIDE EXTERIOR - Install OPTIONAL SIDE DOOR ENTRANCE (Includes Applicable Exterior Coach Light) **If Grade Permits** (See Sketch) Note:
4 - BASEMENT - Increase FOUR (x4) Basement Windows from Standard 30 IN (W) x 16 IN (H) TO LARGER 30 IN (W) x 24 IN (H) (with Possible Window Wells) (See Sketch) Note:
1 - FRONT EXTERIOR - FRONT DOOR - Install EXTENDED HEIGHT DOUBLE DOORS (Delete Transom Window Above) in lieu of builders standard height double doors (See Sketch) Note:
1 - BASEMENT - Install 200 AMP SERVICE in lieu of builders standard 100 Amp Service (See Sketch) Note:
* 1 - MAIN FLOOR Extended height doors -Den double French Door -Foyer Double Closet Doors -Hallway to Laundry Door
* 1 - LIVING ROOM Remove Return Arches to left open with continues standard drop
* 1 - SHARED BATH #1 Delete standard tub + add false cavity; install 35"x72" shower with pot-light; front to be left open for future glass.
1 - BASEMENT- Increase basement height to APPROXIMATELY 9'-0" as per vendors specifications and architentural drawings. Note:

1 - ADDED BLACK WINDOWS TO EXTERIOR BRICK PACKAGE

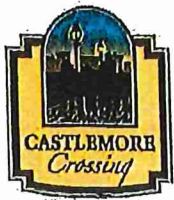


ADDED BLACK WINDOWS TO
EXTERIOR BRICK PACKAGE

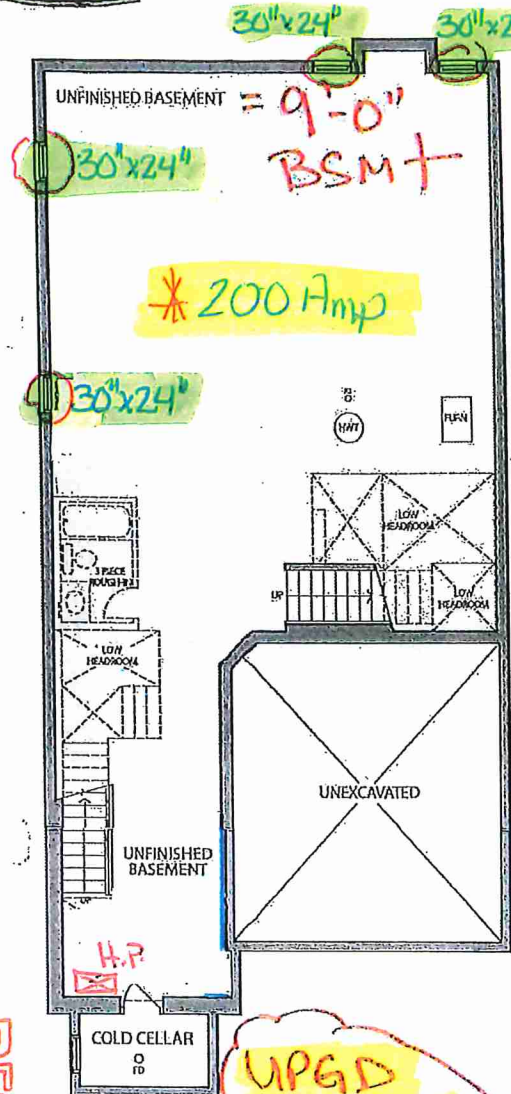

BASEMENT
ELEV. B


UPGD
9'-0"
BSM+

HYDRO
METER

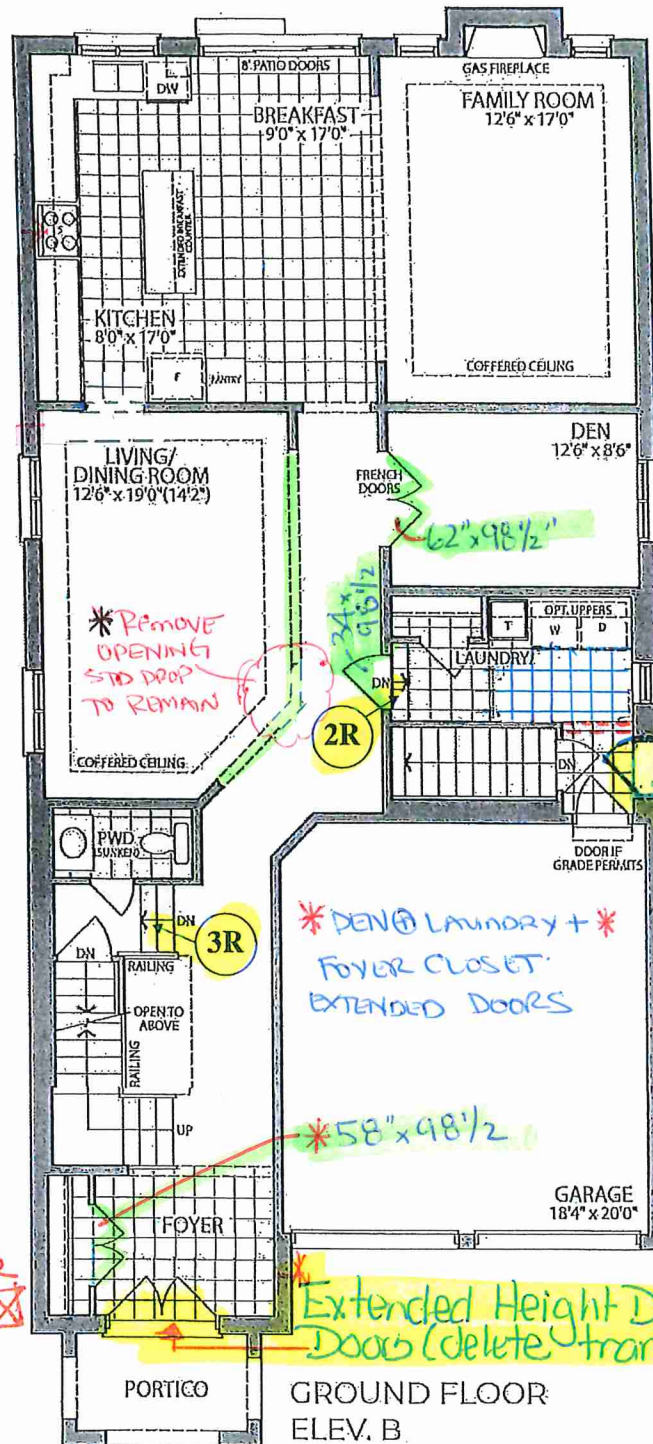

GROUND FLOOR
ELEV. B

34'x4" →
34" →
FALSE
WALL

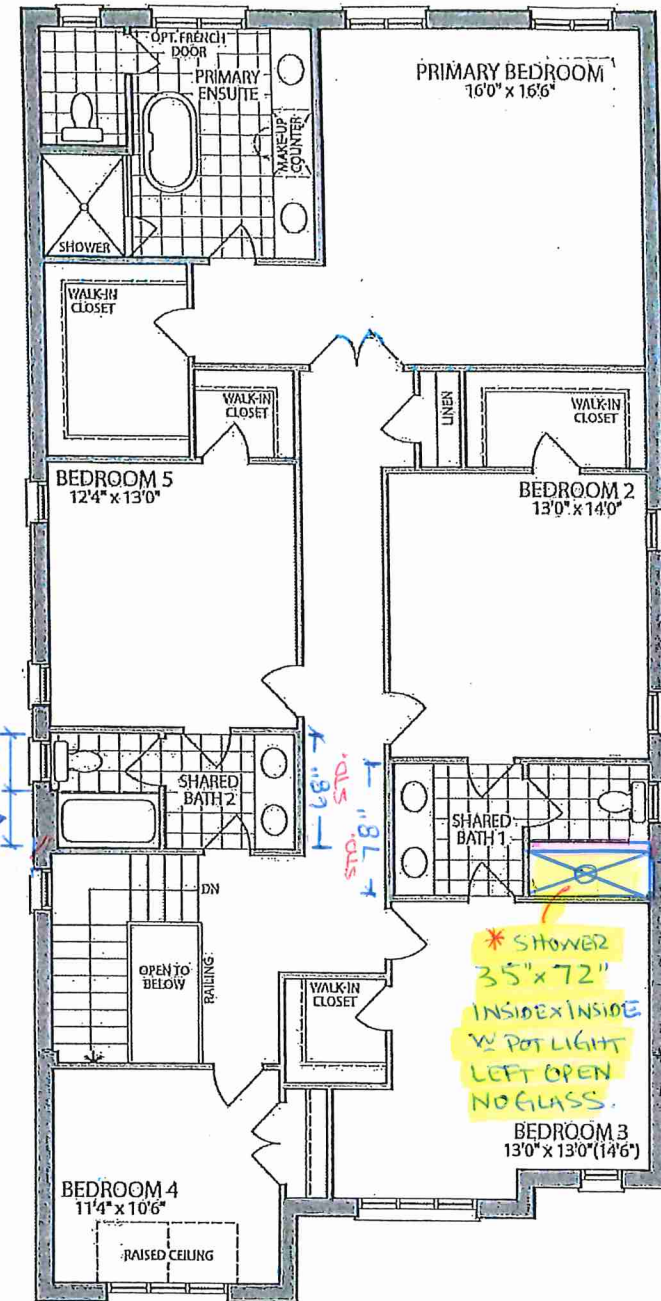

SECOND FLOOR
ELEV. B

Specifications and floor plans are subject to change without notice. Drawings are artist's concept. Plans are approximate dimensions. Actual usable floor space may vary from the stated floor area. E.&O.E.

LOT 32 . 40-02 . Silver Poplar . El. B . 5 Bedroom . 3495 SQ. FT.

INVENTORY LOT



THE SILVER POPLAR (40-02)



Extended Height
Double Doors



LOT 32

ELEVATION B

3495

SQUARE FEET

SCHEDULE "B"

INVENTORY LOT

LOT 32 . 40-02 . Silver Poplar . El. B . 5 Bedroom . 3495 SQ. FT.