



CONSTRUCTION SUMMARY
Forestside Estates Inc.



* INVENTORY *

* INVENTORY *


LOT NUMBER	PHASE	HOUSE TYPE	CLOSING DATE	
12	8	BLUE DAWN (38-02) - ELEV. C 4 BEDROOM		

Offer	
Worksheet	Note:


4 - BASEMENT - Increase FOUR (x4) Basement Windows LARGER 36 IN (W) x 24 IN (H) (See Sketch)
Note:
1 - BASEMENT - Install 200 AMP SERVICE in lieu of builders standard 100 Amp Service (See Sketch)
Note:

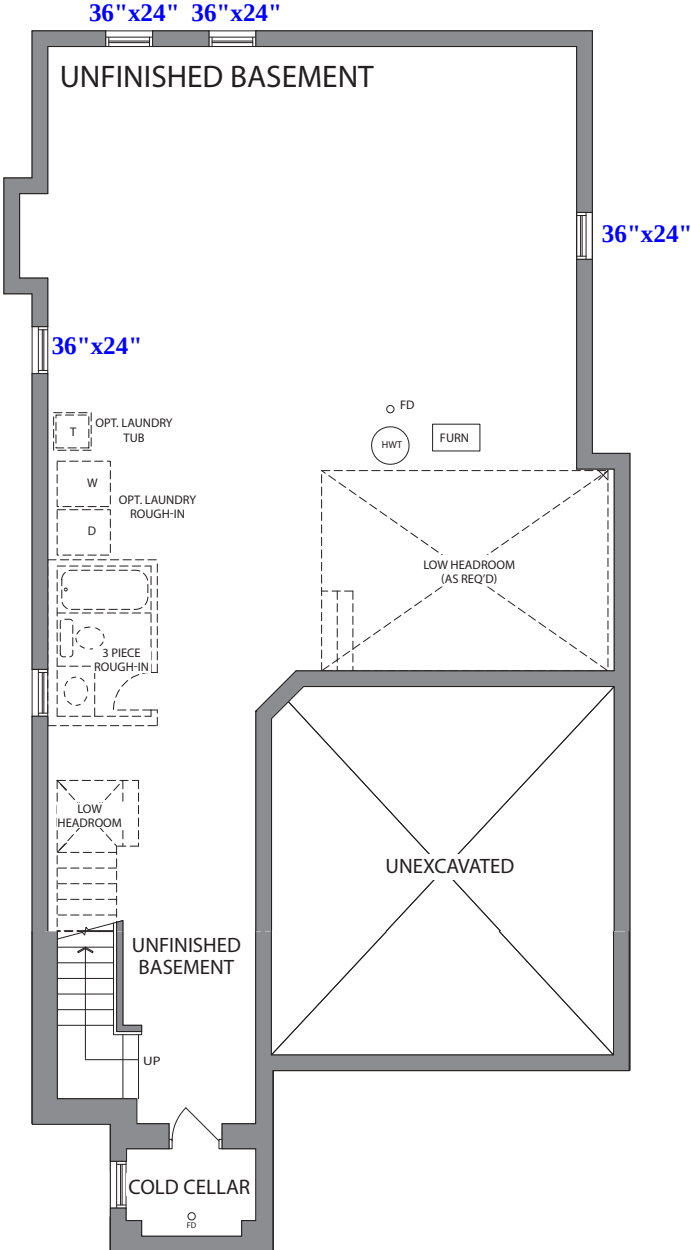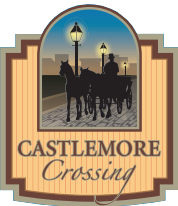

BASEMENT ELEV. C

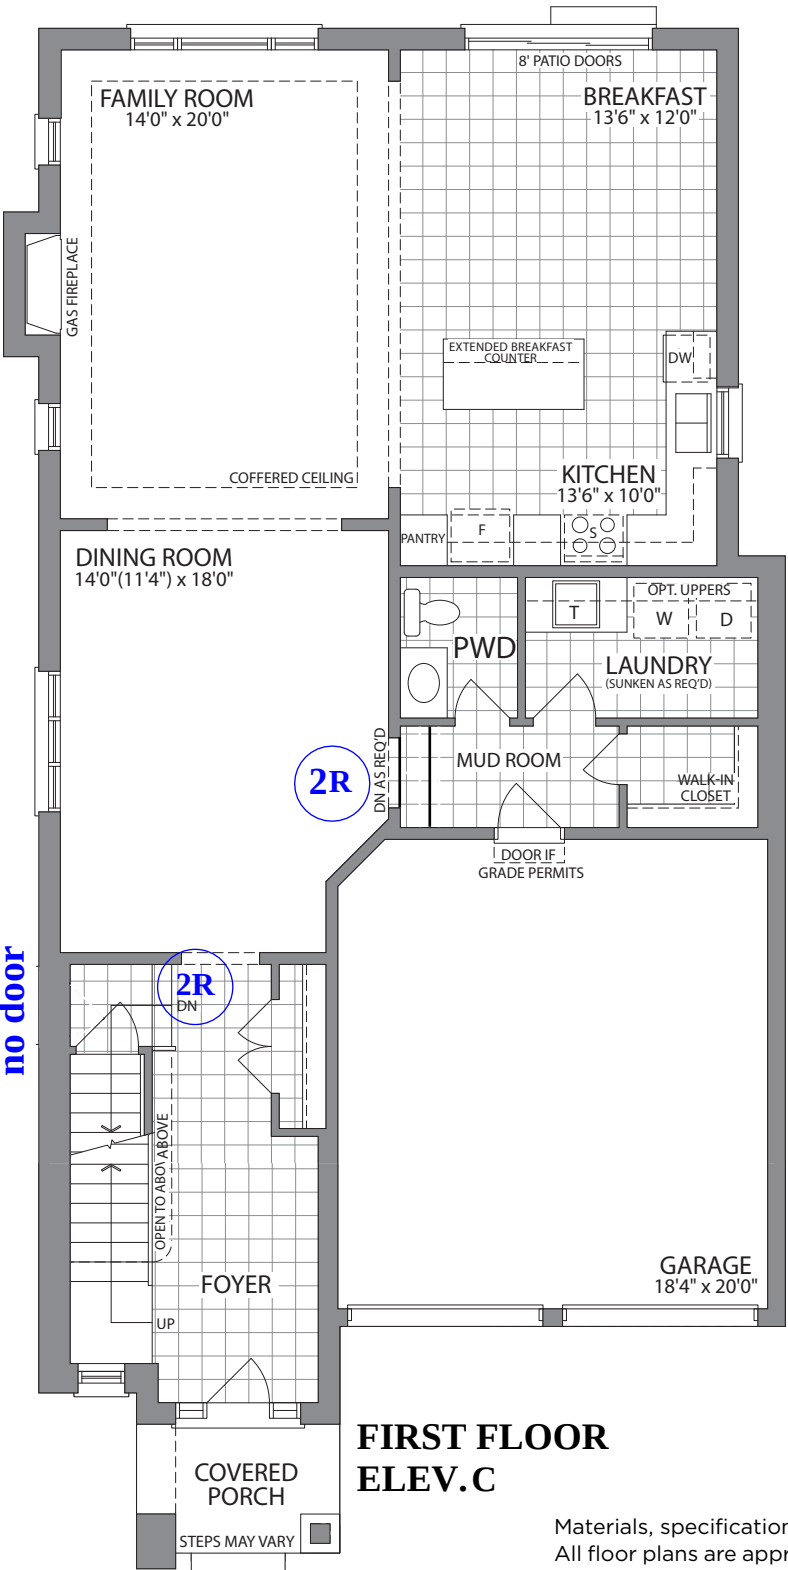

FIRST FLOOR ELEV. C

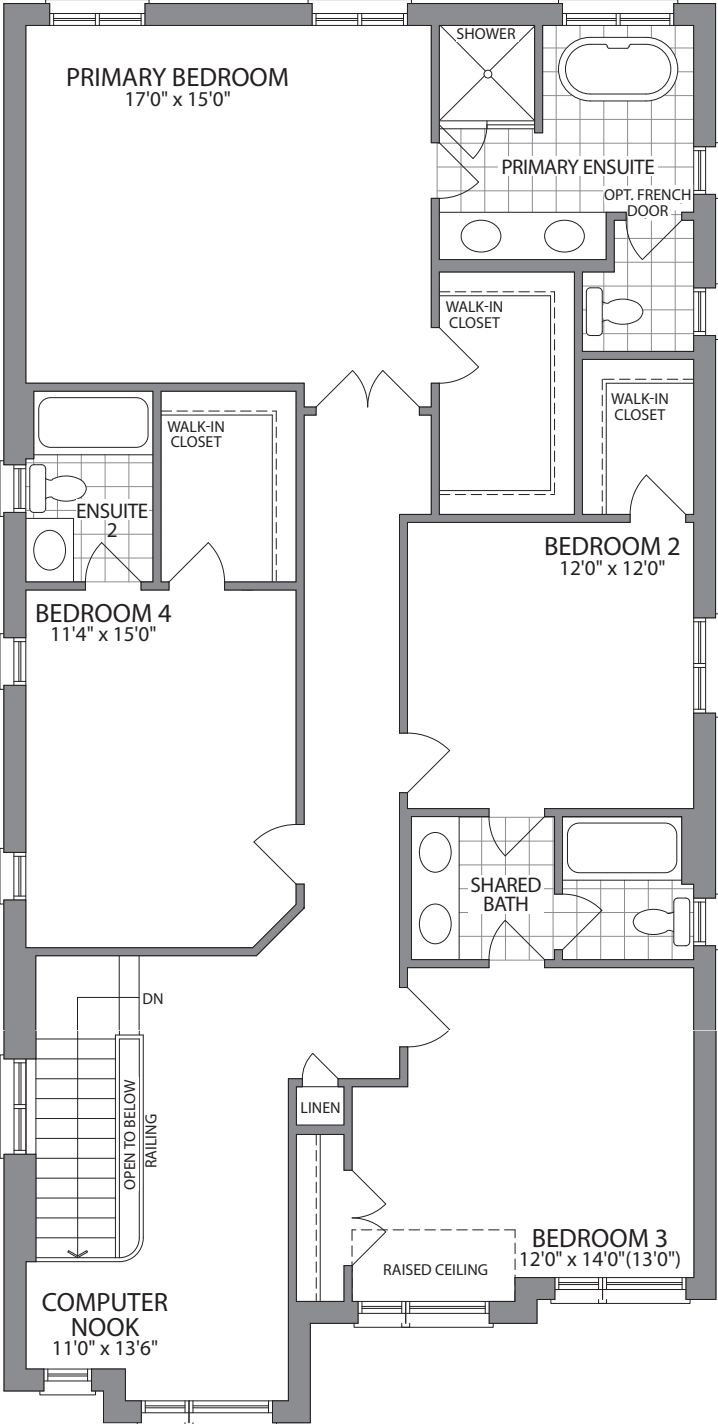

SECOND FLOOR ELEV. C

Materials, specifications and floor plans are subject to change without notice. All renderings are artist's concept. All floor plans are approximate dimensions. Actual usable floor space may vary from the stated floor area. E.&O.E.

LOT 12 . 38-02 . The Blue Dawn . El. C . 4 Bedroom . 3075 SQ. FT.



THE BLUE DAWN (38-02)



ELEVATION C

38'

LOT 12

3075

SQUARE FEET

LOT 12. 38-02 . The Blue Dawn . El. C. 4 Bedroom . 3075 SQ. FT. .