



CONSTRUCTION SUMMARY
Forestside Estates Inc.




* INVENTORY *

* INVENTORY *

LOT NUMBER	PHASE	HOUSE TYPE	CLOSING DATE	
12	8	BLUE DAWN (38-02) - ELEV. C 4 BEDROOM		

Offer	
Worksheet	Note:

5 - BASEMENT - Increase TWO (x2) Basement Windows LARGER 36 IN (W) x 24 IN (H) (See Sketch) THREE (x3) Basement Windows LARGER 30IN (W) x 24 IN (H) (See Sketch) Note:
1 - BASEMENT - Install 200 AMP SERVICE in lieu of builders standard 100 Amp Service (See Sketch) Note:
1 - FRONT DOOR - EXTEND Single door NO GLASS, two STD. side lights to remain, DELETE the transom above. Note:
1 - BASEMENT- Increase basement height to APPROXIMATELY 9'-0" as per vendors specifications and architentural drawings. Note:

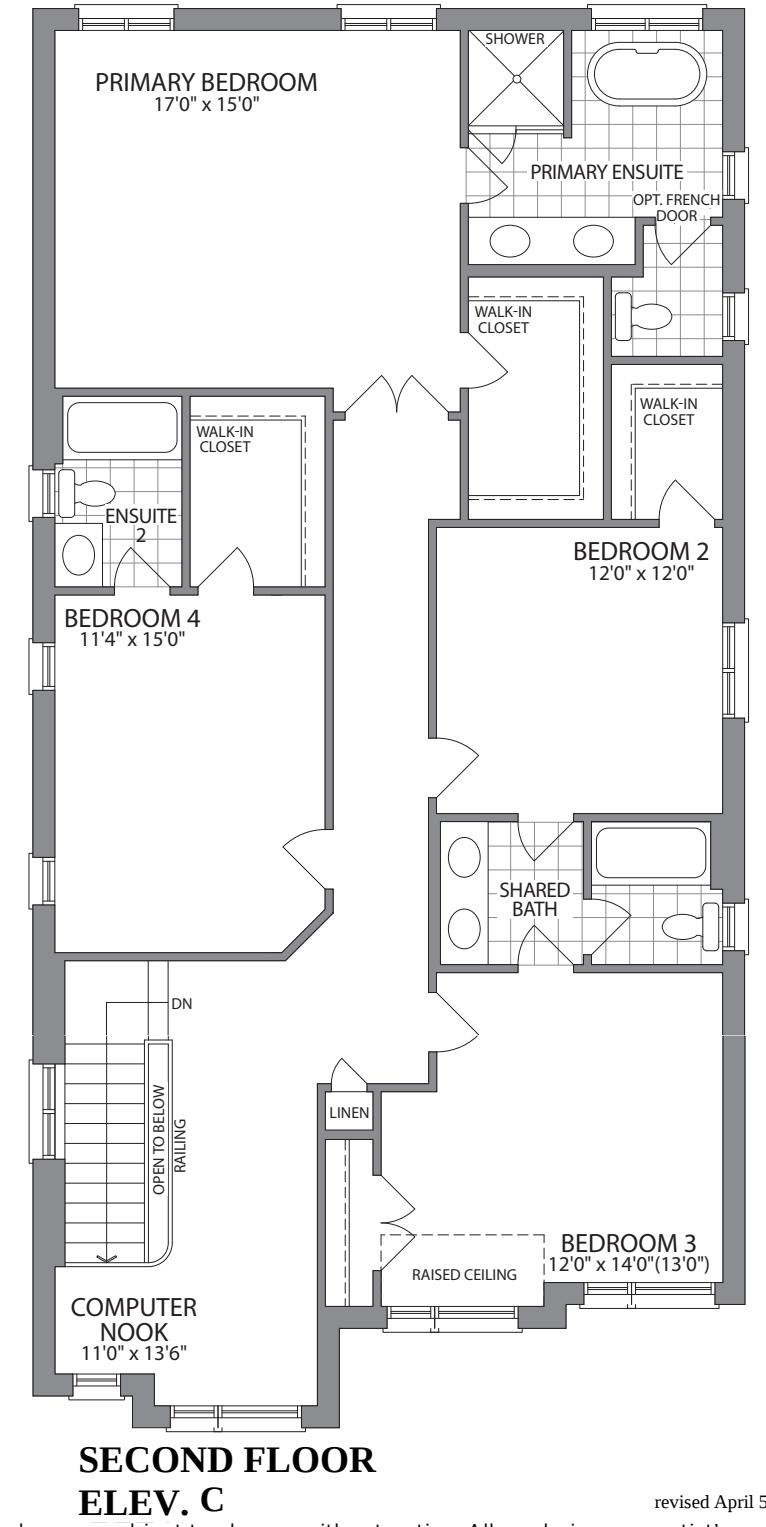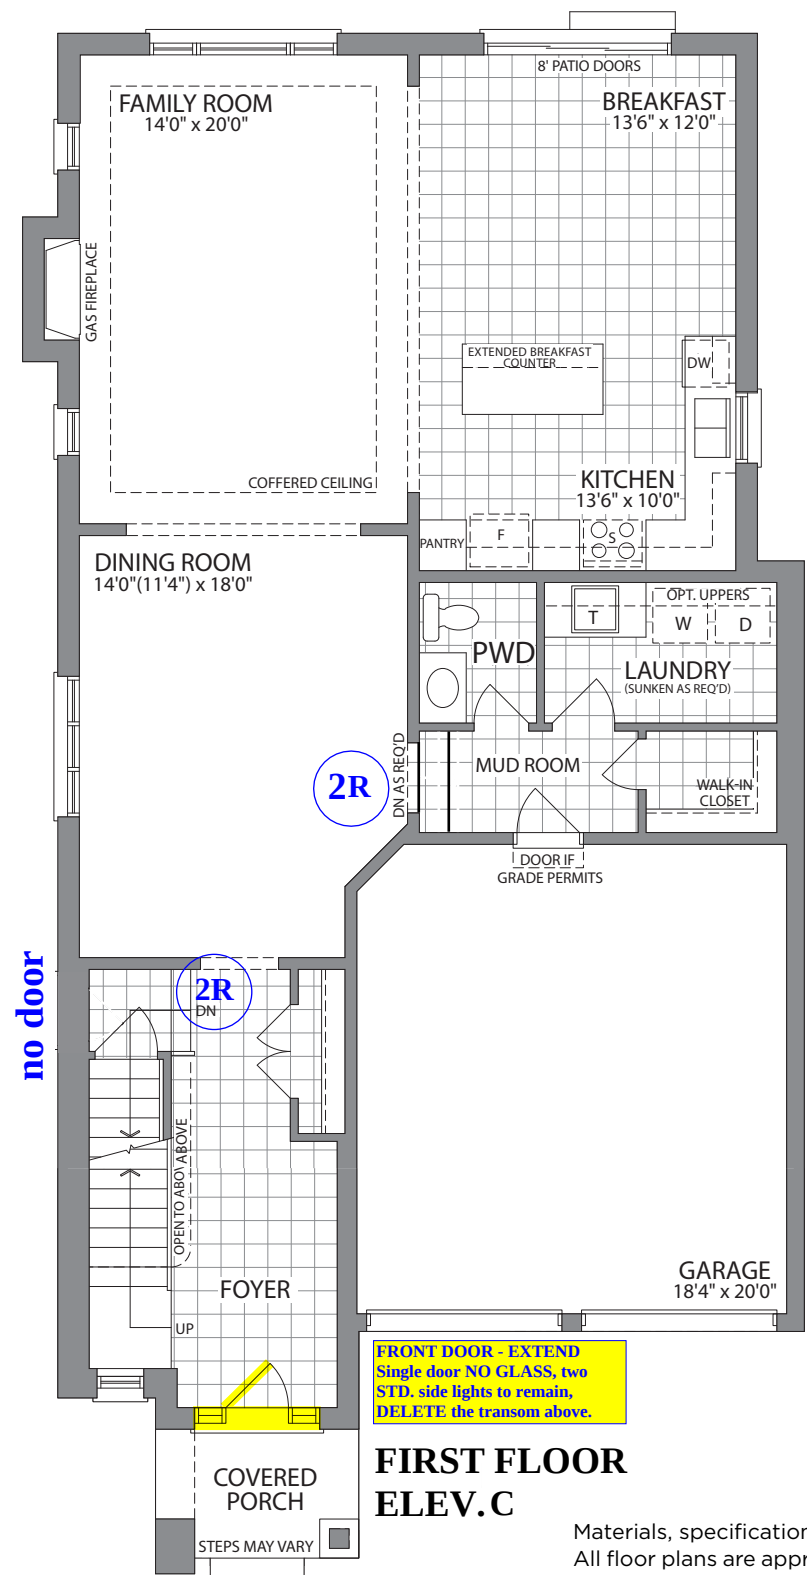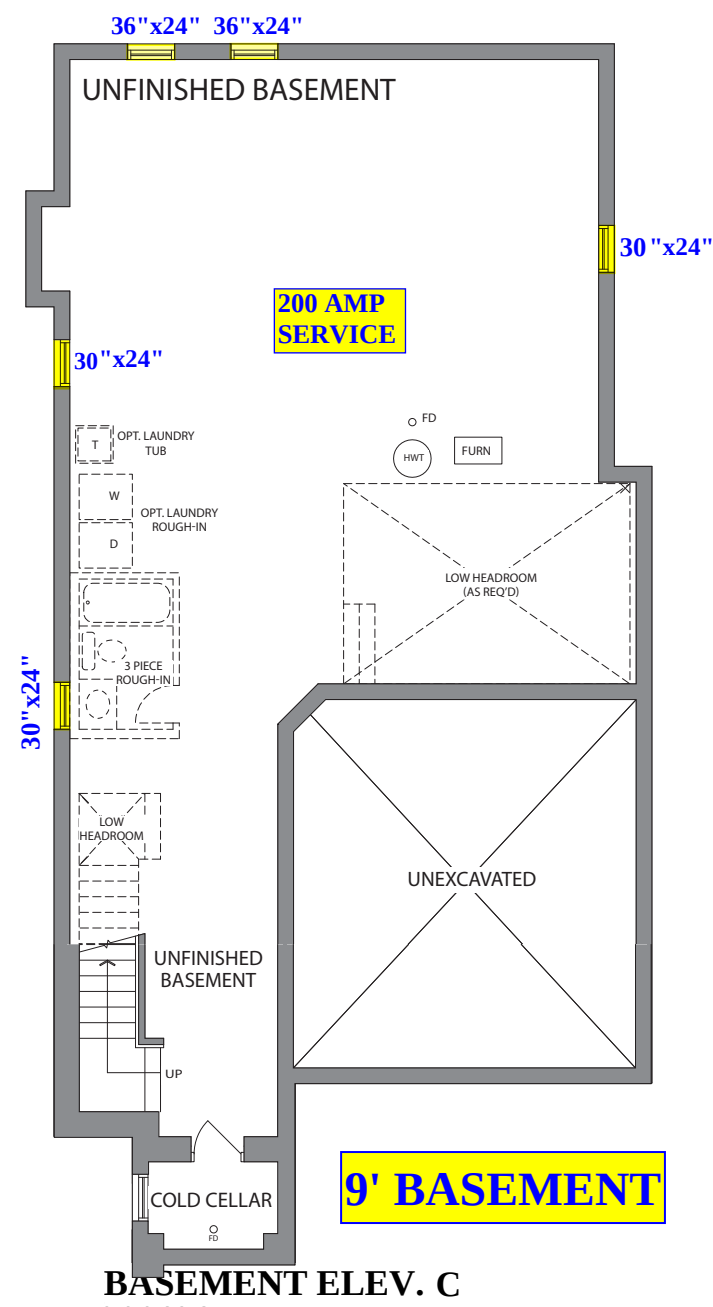

Materials, specifications and floor plans are subject to change without notice. All renderings are artist's concept. All floor plans are approximate dimensions. Actual usable floor space may vary from the stated floor area. E.&O.E.

LOT 12 . 38-02 . The Blue Dawn . El. C . 4 Bedroom . 3075 SQ. FT.

revised April 5, 2024



THE BLUE DAWN (38-02)



38' ELEVATION C
LOT 12 3075
SQUARE FEET

revised April 5, 2024

LOT 12. 38-02 . The Blue Dawn . El. C. 4 Bedroom . 3075 SQ. FT. .