


- △ POLISH IN PLACE STEPS WITH MASONRY VENEER ON SIDES.
- △ DROP OR RAISE BANDING BY AMOUNT INDICATED.
- △ ADD BANDING AND/OR TIMU AS INDICATED.
- △ ADDED CAMBERED HEADERS.
- △ 8"x8" GARAGE DOORS.
- △ DROPPED OR RAISED SOFFIT AS INDICATED.
- △ ADJUSTED ROOF OVERHANG AS INDICATED ON ROOF PLAN.
- △ PROVIDE SQUARED PER CONSTRUCTION NOTE 11.
- △ FOWER STUDS AS INDICATED

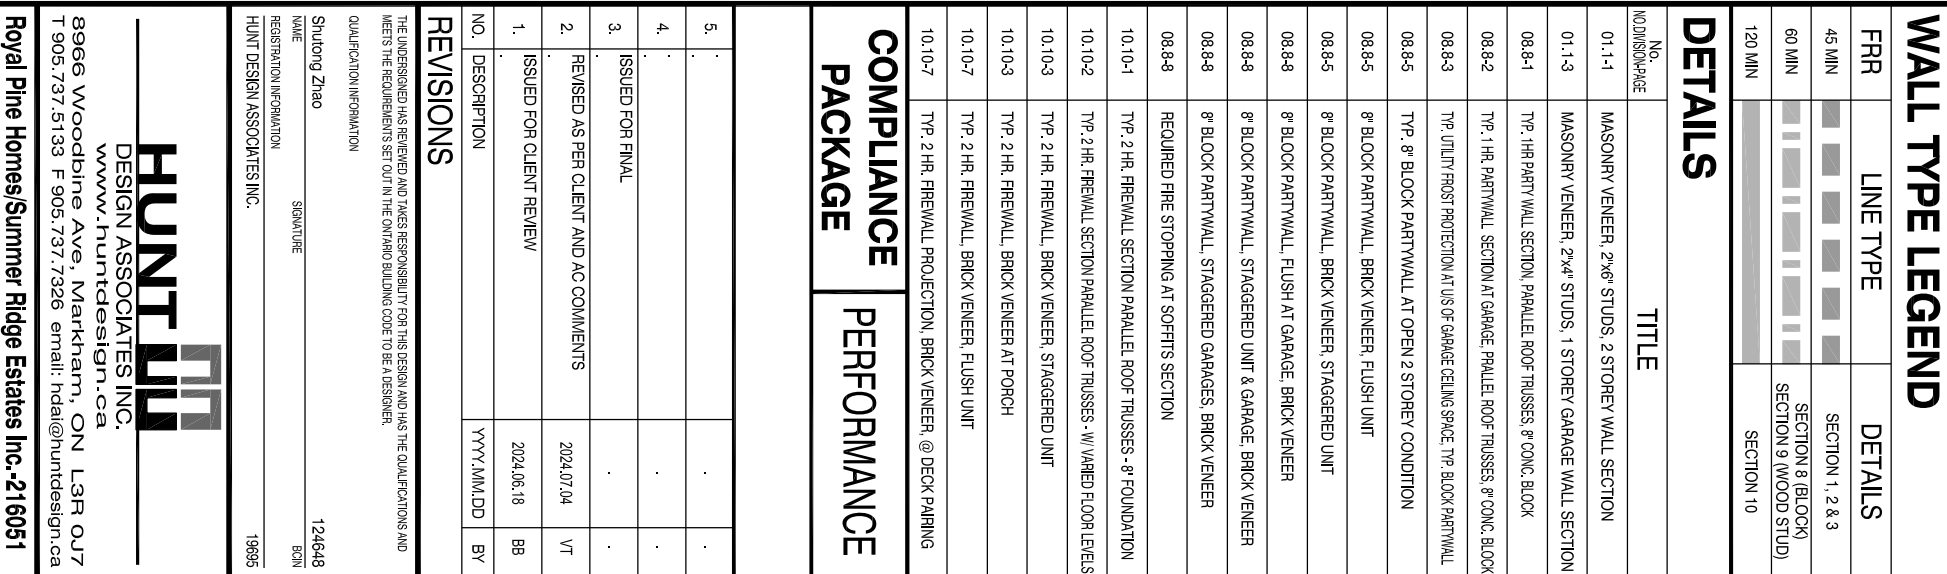



BLOCK 290
LOTS 7 - 12
ELEVATIONS

• Scale: 1" = 10' - 0"

Drawn By: **DD**
 Created By: **CSZ**

REV. 2024.06.28

BLOCK NUMBER 290

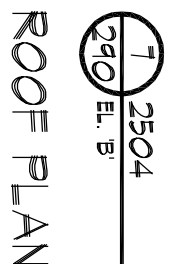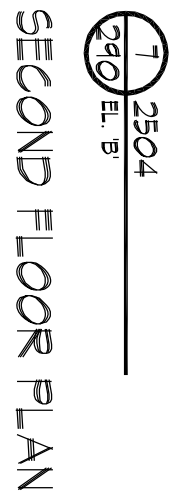

8 2501
EL. B1 (REV.)

250
9
290 EL. B

10 2502
290 EL. 'B' (REV)

2502
EL. B2

12 2504
290 EL. 'B' (REV.)

This is to certify that these plans comply with the applicable Architectural Design Guidelines approved by the City of BIRMINGHAM.

<p>A PERMITSAL IS REQUIRED FOR THE BUILDING AREAS IS GREATER THAN 600 SQ FT AND 669.83 IS AS PER BUILDING CODE PART 1. BUILDINGS SECTION 11.2.2.4.1, 14.1.2.</p> <p>THE EXISTING OF THE GREATER HORIZONTAL BUILDING EXTERIOR WALL AREA IS GREATER TO RECORD THE CENTER OF THE PERMITSAL (DOMINO LANE)</p>	
<p>0.0.6. PART 1. SECTION 11.2.4.1.1. PERMITSAL AS PER BUILDING AREA CALCULATION FOR PERMITSAL AS PER SECTION</p>	
SECTION	BUILDING AREA
LOTS 7-10	4670.51 sq ft
LOTS 11-12	433.90 sq ft
	2445.15 sq ft
	227.6 sq ft
LOTS ###	50.51 sq ft
	0.00 sq ft

GENERAL NOTES

1. PROVIDE FIRESTOPS AS REQUIRED BY O.B. § 10.16
2. REFER TO UNIT WORKING DRAWINGS, ENGINEERS DRAWINGS AND SCHEDULE FOR ADDITIONAL INFORMATION AND INSTALLATION.
3. REFER TO ROOF TRUSS MANUFACTURERS DRAWINGS FOR JOIST, SPACING, INSTALLATION DETAILS AND HANGER SIZES.
4. CONTRACTOR MUST VERIFY ALL DIMENSIONS ON THE JOB REPORT AND RESPONSES TO HUNT DESIGN ASSOCIATES INC. (H.D.A.) BEFORE PROCEEDING WITH THE WORK. ALL DRAWINGS AND SPECIFICATIONS ARE INSTRUMENTS OF SERVICE AND ARE THE PROPERTY OF H.D.A.

LEGEND

2. A WALL THAT ARE MORE THAN 1100mm (3 ft 3 in) ABOVE GROUND SHALL NOT BE PERMITTED WITHIN 1.2m (3 ft 11 in) OF A PROPERTY LINE OR CENTRE LINE OF A PUBLIC WAY OR 2.4m (7 ft 10 in) OF A COMBUSTIBLE PROTECTION ON ANOTHER BUILDING ON THE SAME PROPERTY AS PER PART 9 SECTION 9.10.14.5.(6)

LEGEND

- | | |
|---|---|
| △ | POURED IN PLACE STEPS WITH MASONRY VENEER ON SIDES. |
| △ | DROP OR RAISE BANDING BY AMOUNT INDICATED. |
| △ | ADD BANDING AND/OR TRIM AS INDICATED. |
| △ | ADDED CARBIDE HEADERS. |
| △ | 8'-0" X 8'-0" GARAGE DOORS. |
| △ | DROPPED OR RAISED SLOFT AS INDICATED. |
| △ | ADJUSTED ROOF OVERHANG AS INDICATED ON ROOF PLAN. |
| △ | POWER GUARD PER CONSTRUCTION NOTE 11. |
| △ | FOYER SUMMEN AS INDICATED |
| △ | LIGHT FIXTURE RELOCATED AS INDICATED. |

WALL TYPE LEGEND

LINE TYPE		DETAILS
FRR		SECTION 1, 2 & 3
45 MIN		SECTION 4, 5 & 6
60 MIN		SECTION 7, 8 & 9
120 MIN		SECTION 10

DETAILS

DETAILS

[illegible]

PACKAGE	PERFORMANCE
---------	-------------

NO.	DESCRIPTION	YYYYMMDD	BY
3.		.	.
4.		.	.
5.	ISSUED FOR PAUL	.	.
6.	RECEIVED FOR CLIENT AND NO COMMENTS	2004/07/01	W7
7.	ISSUED FOR CLIENT REVIEW	2004/06/19	89

Shuang Zhao	126648
Owner	85%
ASSOCIATION INFORMATION	
HUNT DESIGN ASSOCIATES INC.	1999



HUNT HILL
DESIGN ASSOCIATES, INC.

www.hundestijn.ca
9866 Woodbine Ave., Markham, ON L3R 0J7
T 905/279/5133 F 905/279/7226 email: info@hundestijn.ca

ROYAL PINE HOMES/SUMMER RIDGE ESTATES INC.-216051
MAYFIELD VILLAGE, BRAMPTON, ON.

BLOCK 290
LOTS 7 - 12

ELEVATIONS

