




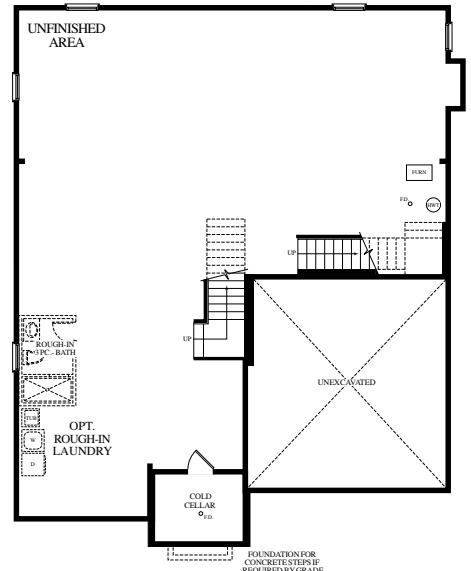

LOWER LEVEL
ELEV.A

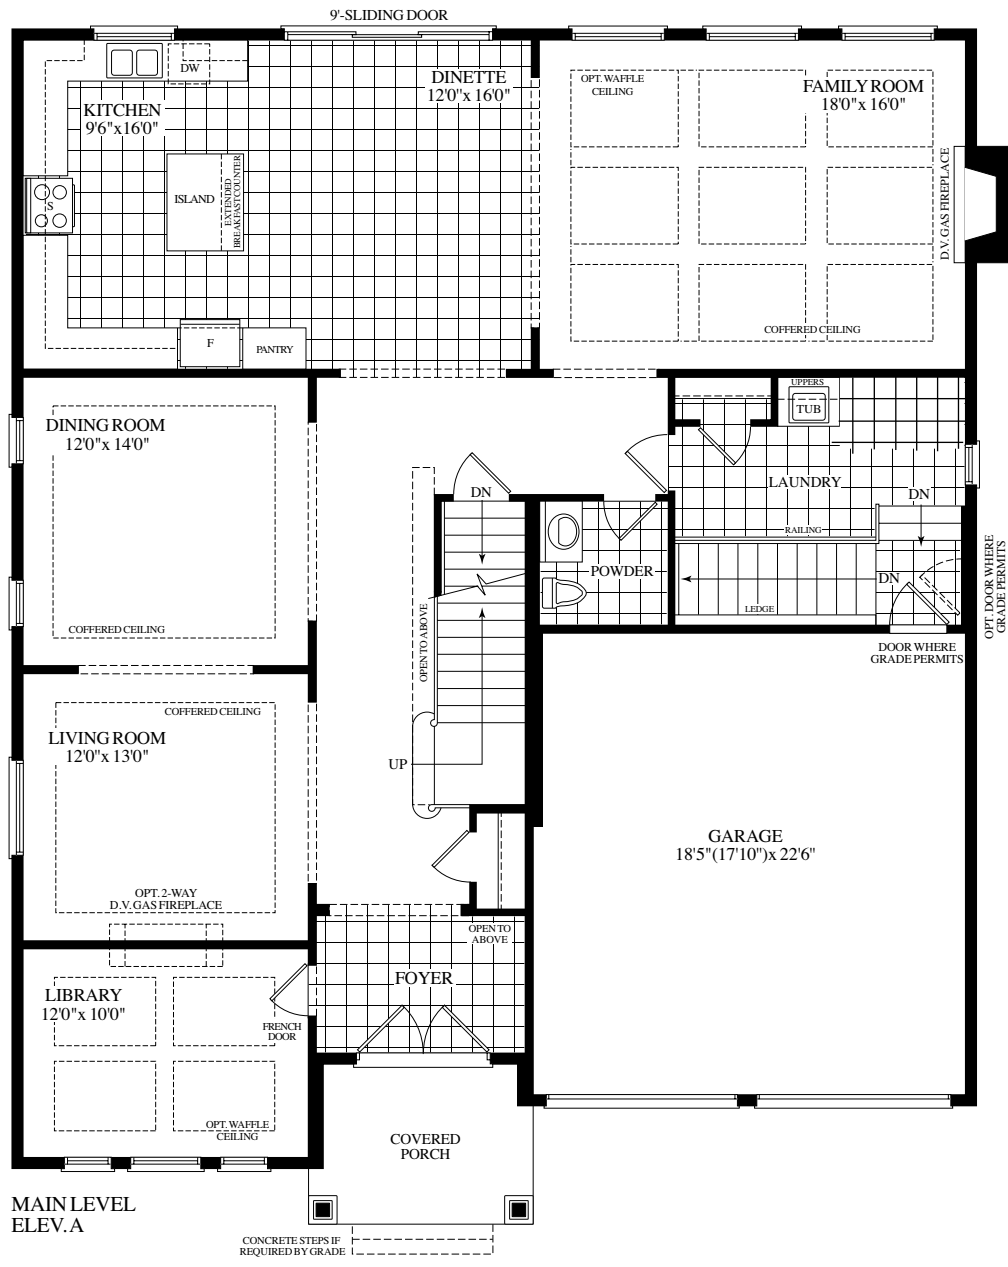


MAIN LEVEL
ELEV.A

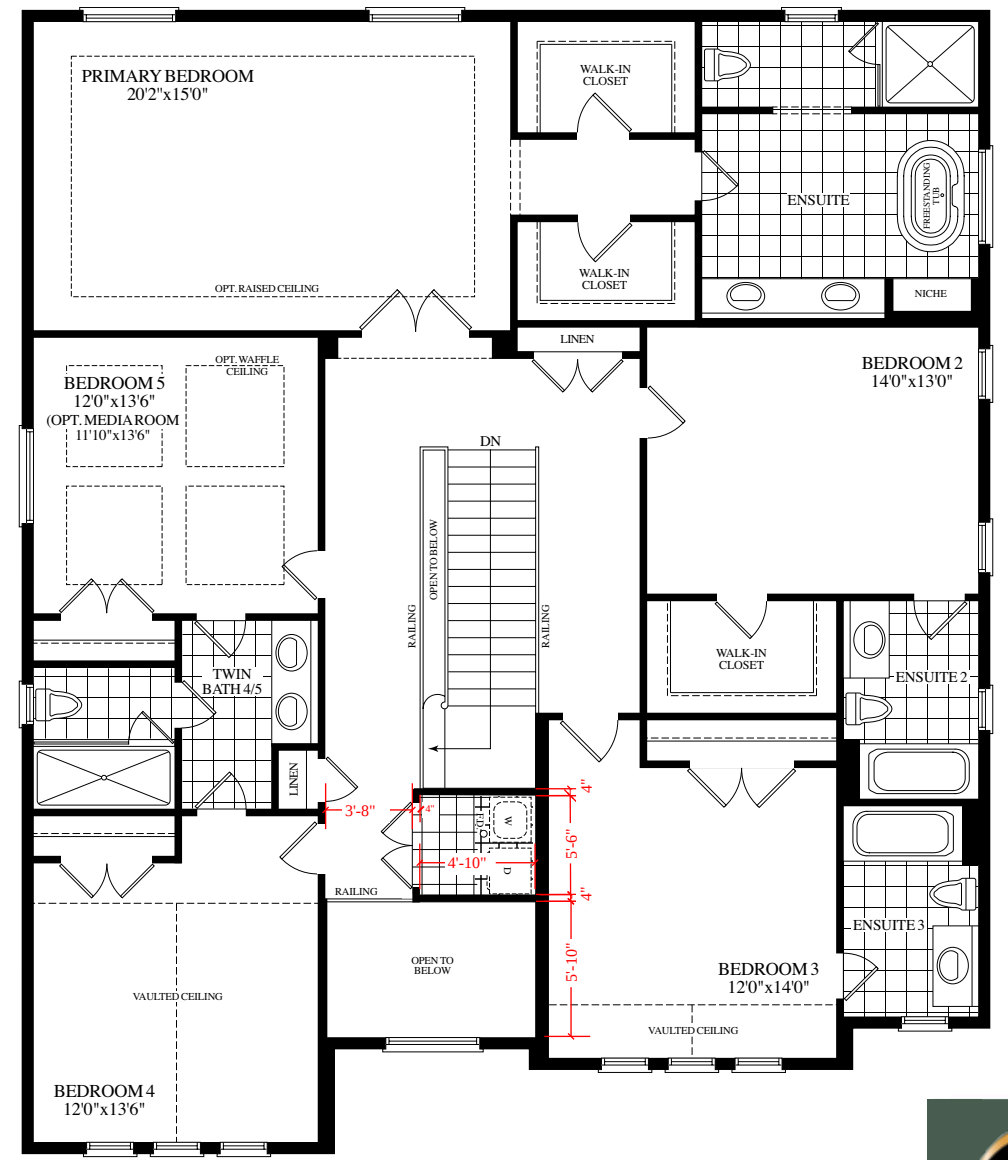

OPT. UPPER LEVEL
ELEV.A



LOT 2 * 50-03 BIRMINGHAM -OPT.2ND FLR. * ELA * 4040 SQ.FT.

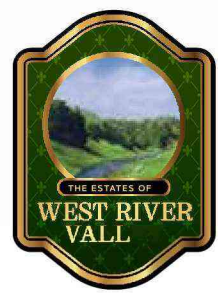

BIRMINGHAM (50-03)
ELEV. A - 4040 SQ. FT.

LOT 2



50'
LOT



SCHEDULE "B"

Purchaser **JASPREET CHHATWAL**
Purchaser **MANDEEP, KAUR, CHHATWAL**
And
Vendor **2185715 Ontario Inc.**
Lot Number **002 GOLD BOTTOM CRESCENT, Phase 2, Plan 43M-2144**
in the **CITY of BRAMPTON**
Date of Offer **October 26, 2024**
Dated Required: **March 06, 2026**
Model: **BIRMINGHAM-OPT 2ND LEVEL-ELEV A (50-03(A0))**

Description - Vendor to Supply and Install the Following as Per Purchase Price

- BONUS PACKAGE FOR 50 FT DETACHED - PURCHASER TO RECEIVE \$40,000 (INCLUSIVE OF TAXES) WORTH OF UPGRADES AT THE DECOR CENTER AT TIME OF COLOUR CHART.
- PROVIDE A CLOSET ON THE UPPER HALLWAY TO INCLUDE ROUGH-IN FOR WASHER DRYER AS PER SKETCH.
- IN THE LAUNDRY ROOM ON THE MAIN FLOOR DELETE ROUGH-IN FOR WASHER AND DRYER AND ONLY PROVIDE A SINK.