



LOWER LEVEL
ELEV. C

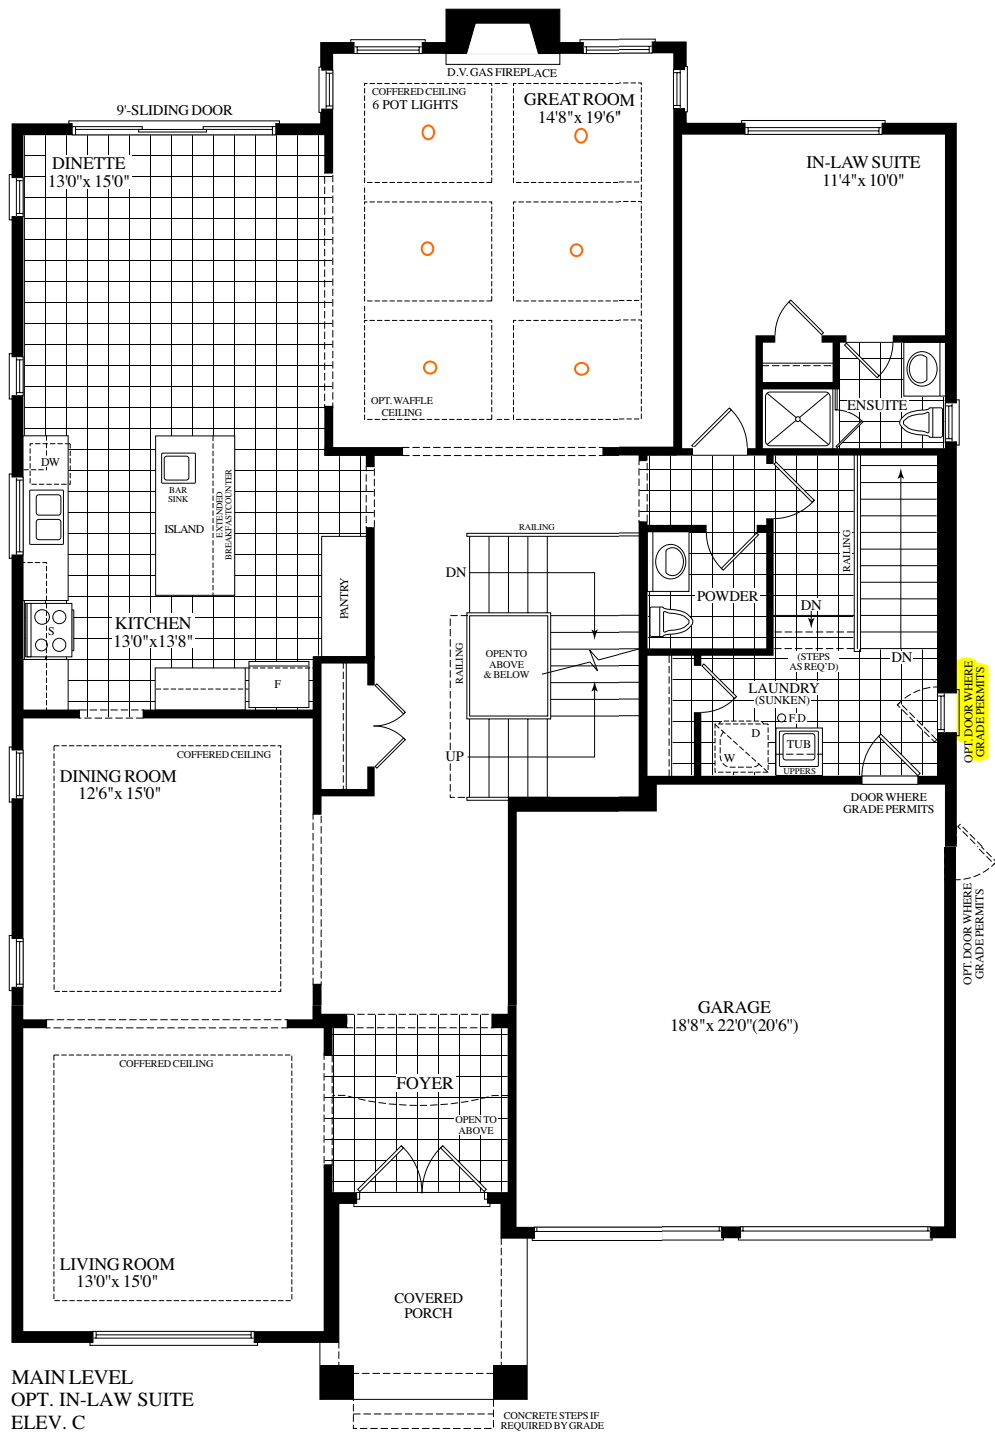


MAIN LEVEL
OPT. IN-LAW SUITE
ELEV. C

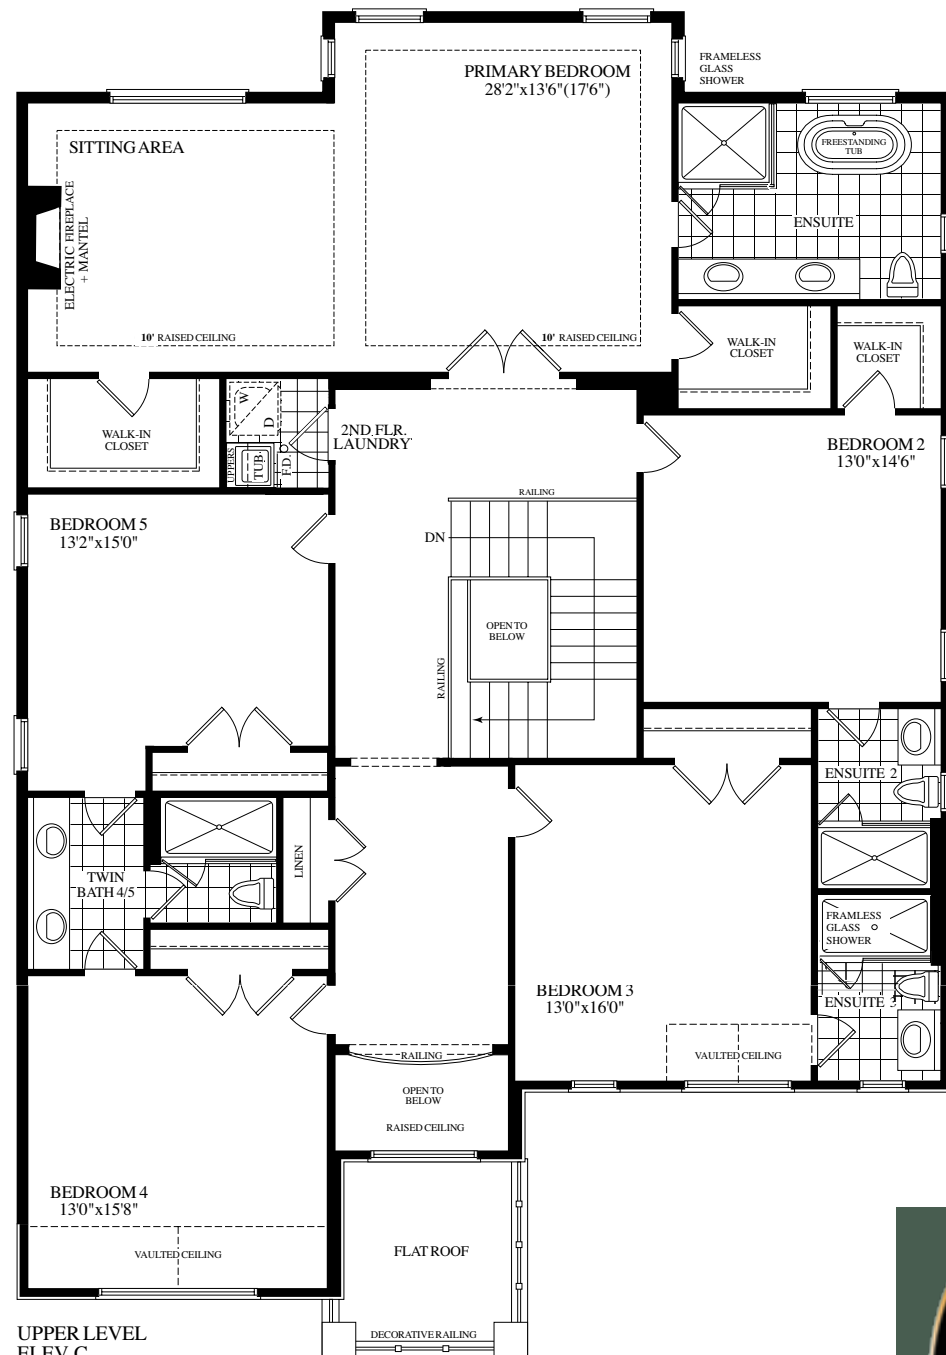

UPPER LEVEL
ELEV. C

LOT 13 * 50-08 EDINBURGH* OPT MAIN. 5BEDR. * EL.C * 3445 SQ.FT.



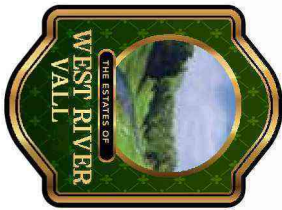

EDINBURGH

(50-08)

LOT 13

ELEV. C - 4560 SQ. FT.



SCHEDULE "B"

Purchaser

Purchaser

And

Vendor

Lot Number

Date of Offer

Dated Required:

Model:

SUKHVIR KAUR BARYAR

CHARANJIT SINGH BARYAR

2185715 Ontario Inc.

013 GOLD BOTTOM CRESCENT, Phase 2, Plan 43M-2144
in the CITY of BRAMPTON

October 26, 2024

February 25, 2026

EDINBURGH-OPT MAIN FLOOR W INLAW SUITE-ELEV C (50-08(COIN))

Description - Vendor to Supply and Install the Following as Per Purchase Price	
<div><div>■</div><div>ADD EXTRA LAUNDRY ROOM TO 2ND FLOOR WITH STACKABLE ROUGH-IN WASHER AND DRYER WITH CABINET LAUNDRY TUB AND 30INCH UPPER CABINETS AS PER BUILDERS STANDARD SAMPLES. BUILDER TO REDUCE SITTING AREA WALK-IN CLOSET IN PRIMARY BEDROOM AND RELOCATE DOOR ENTRY TO LAUNDRY ROOM TO UPPER HALLWAY FROM BEDROOM 5 WALK-IN CLOSET SEE SKETCH.</div></div>	
<div><div>■</div><div>ADD DOBLE DOOR CLOSET IN BEDROOM 5 SEE SKETCH.</div></div>	
<div><div>■</div><div>ADD 6 SQUARE WAFFLE CEILING IN FAMILY ROOM WITH 6 POT LIGHT CENTER TO SQUARES.</div></div>	
<div><div>■</div><div>ADD ELECTRICAL FIREPLACE IN SITTING AREA OF PRIMARY BEDROOM WITH MANEL AS PER BUILDERS STANDARD SELECTIONS.</div></div>	
<div><div>■</div><div>SMOOTH CEILINGS THROUGHOUT HOME INCLUSIVE OF ALL BEDROOMS.</div></div>	
<div><div>■</div><div>ADD OPTIONAL 10FT RAISED CEILINGS IN SITTING AREA AND PRIMARY BEDROOM.</div></div>	
<div><div>■</div><div>7 1/4 BASEBOARDS THROUGHOUT HOME AS PER BUILDERS SAMPLES.</div></div>	
<div><div>■</div><div>PURCHASER TO SELECTED FROM BUILDERS SAMPLES 20 X 20 INCH FLOOR TILES IN FOYER, KITCHEN, DINETTE, POWDER ROOM WASHROOM, IN LAW SUITE BATHROOM, ALL LAUNDRY ROOMS & SECOND FLOOR WASHROOMS.</div></div>	
<div><div>■</div><div>ALL SHOWER STALLS TO HAVE POT LIGHTS.</div></div>	
<div><div>■</div><div>ADD SIDE DOOR OPTION FROM LAUNDRY ROOM TO OUTSIDE IF GRADE PERMITS.</div></div>	
<div><div>■</div><div>DELETE SIDE WALL IN PRIMARY ENSUITE WASHROOM SHOWER STALL BESIDE TUB AND ADD FRAMELESS GLASS.</div></div>	
<div><div>■</div><div>ENSUITE IN BEDROOM 3 REPLACE TUB ENCLOSER WITH SHOWER STALL INCLUDE FRAMELESS GLASS.</div></div>	
Description - Vendor to Supply and Install the Following as Per Purchase Price	
<div><div>■</div><div>BONUS PACKAGE FOR 50 FT DETACHED - PURCHASER TO RECEIVE \$40,000 (INCLUSIVE OF TAXES) WORTH OF UPGRADES AT THE DECOR CENTER AT TIME OF COLOUR CHART.</div></div>	