

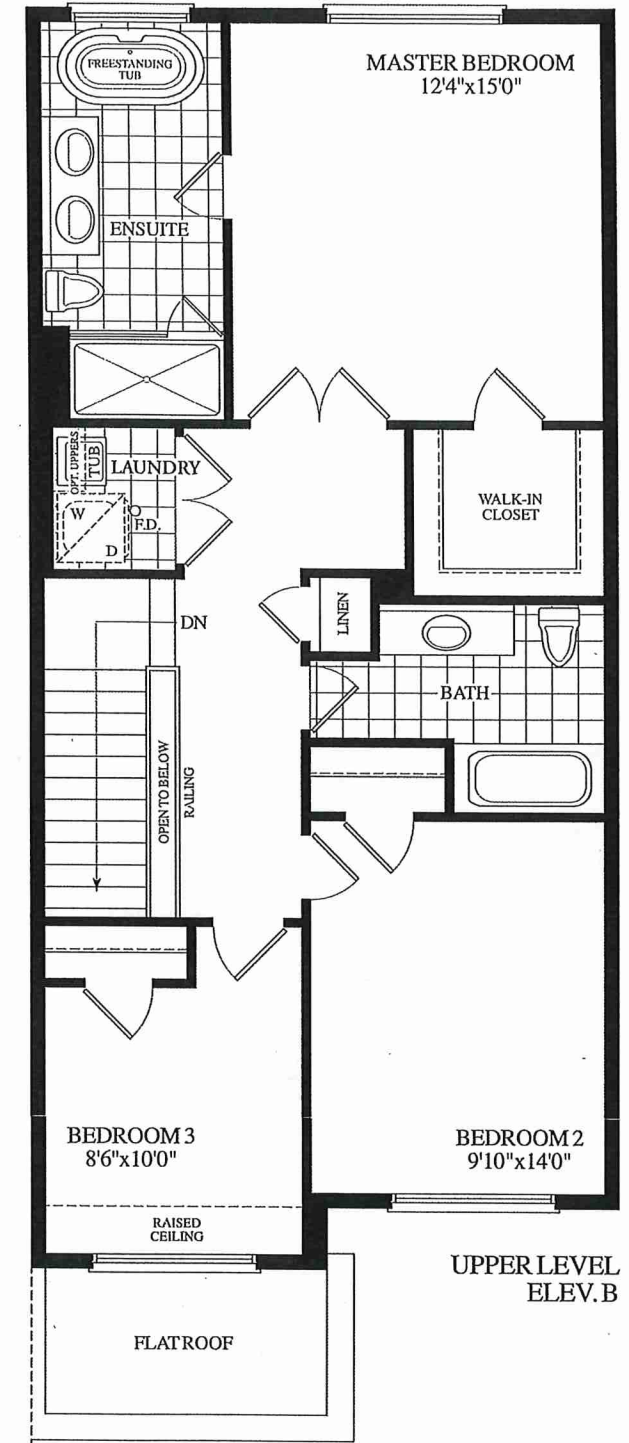
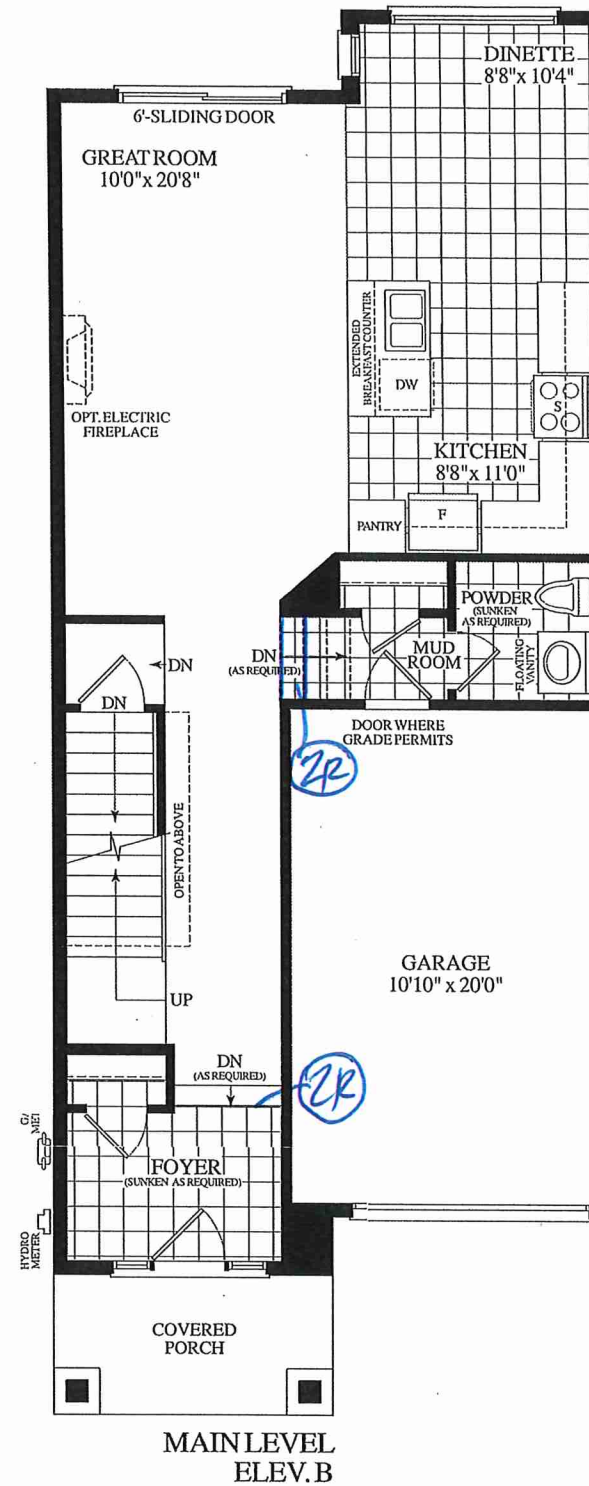


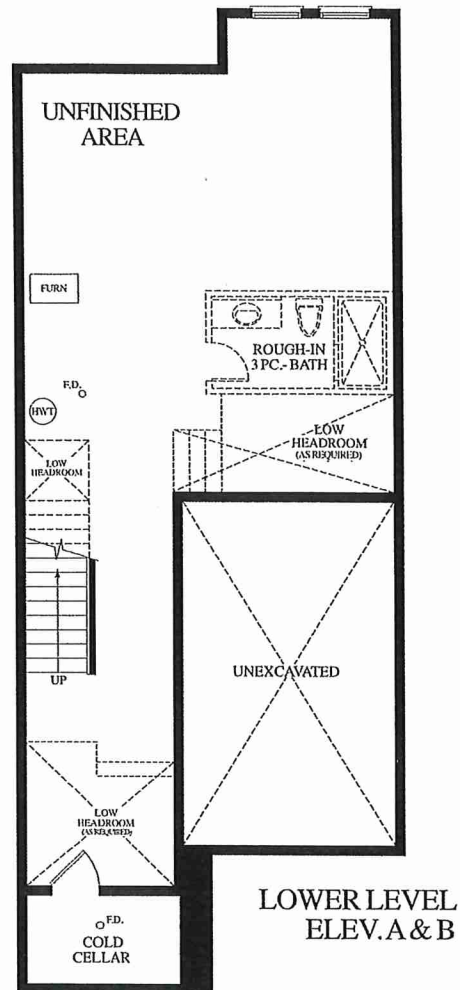

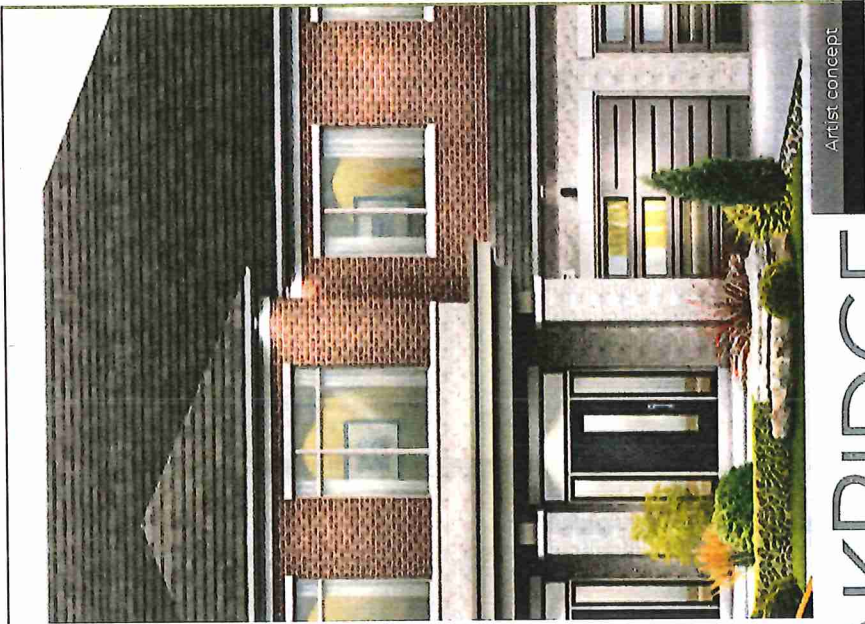

oakridge

MEADOWS

DigiSign Verified - b3822c12-d36c-4208-bbe2-7c147d27b352

SCHEDULE "B"

Purchaser LEI HONG
Purchaser WENJIE QIAO
And
Vendor Grovetrail Developments Inc.
Lot Number 75 BLOCK 242 KAMPER AVENUE, Phase 3, Plan PLAN 65M-4785
 in the CITY of RICHMOND HILL
Date of Offer October 19, 2024
Dated Required: August 06, 2025
Model: MACKENZIE Elev B (20-09BS)

Description - Vendor to Supply and Install the Following as Per Purchase Price
--

- | |
|---|
| ■ BONUS PACKAGE FOR TOWNHOUSE: PURCHASER TO RECEIVE \$7,500.00 (INCLUSIVE OF TAXES) WORTH OF UPGRADES AT DECOR CENTRE AT TIME OF COLOUR CHART |
| ■ BONUS PACKAGE FOR TOWNHOUSE: 5 APPLIANCES TO INCLUDE FRIDGE, STOVE, DISHWASHER WITH STAINLESS STEEL FINISH AND WHITE WASHER AND DRYER AS PER VENDORS SAMPLES. |