



CONSTRUCTION SUMMARY

Grovetrail Developments Inc.

PURCHASERS: ALVIN CHEN and MAN EVA WONG

TEL:

	ATE	CLOSING DATE	HOUSE TYPE	PHASE	LOT NUMBER
68 BLOCK 235 3 MILL POND-Elev A-SIDE UGPRADE 12-Aug-		12-Aug-25	MILL POND-Elev A-SIDE UGPRADE	3	68 BLOCK 235

Offer BONUS PACKAGE FOR TOWNHOUSE: 5 APPLIANCES TO INCLUDE FRIDGE, STOVE, DISHWASHER WITH STAINLESS STEEL FINISH AND WHITE WASHER AND DRYER AS PER VENDORS SAMPLES. Vorksheet Note:

Offer BONUS PACKAGE FOR TOWNHOUSE: PURCHASER TO RECEIVE \$7,500.00 (INCLUSIVE OF TAXES) WORTH OF UPGRADES AT DECOR CENTRE AT TIME OF COLOUR CHART Worksheet Note:

Date Added: 27-Feb-25 **Invoice Number: 8711**

1 - STAIRS- Install a White Oak staircase in lieu of the builders standard Red Oak, from 1st floor to 2nd floor. To include White Oak handrail, applicable posts, nosings, step, riser, applicable stringers (See Sketch) Note:

1 - MASTER BEDROOM- Delete the double door entry and install a single door to Master Bedroom (See Sketch)

- 1 UPPER HALL- Shift the linen closet towards the Master Bedroom and enlarge . Install additional shelving and use the master bedroom door that was deleted to create a double door Linen Closet (See Sketch)
- 1 MAIN BATH- Enlarge the Main Bathroom, in lieu of old Linen closet space. Install additional floor tile. (See Sketch)

Note: MAIN BATH- Extend the vanity and the counter top in the Main Bath. **PLEASE NOTE** additional cost of cunter top and cabinetry to be charged at time of colour chart (See Sketch)

MAIN BATH- Centre the builders standard sink to be centred on vanity (See Sketch)

1 - BASEMENT- Install the 200 Amp Service, in lieu of the builders standard.


Note:

- 1 PURCHASER AWARE AND ACCEPTS THAT ANY CHANGES MADE TO UPGRADES AFTER SIGNING THIS PURCHASERS EXTRA FORM ARE SUBJECT TO A MINIMUM ADMINISTRATION FEE OF \$1,000
- 1 PURCHASER HAS ATTENDED A STRUCTURAL APPOINTMENT AT THE DESIGN STUDIO AND HAS DECLINED ANY ADDITIONAL UPGRADES Note:

1 - BONUS PACKAGE-PURCHASER TO RECEIVE \$7,500 (INCLUSIVE OF TAXES) WORTH OF UPGRADES AT THE DESIGN STUDIO AT TIME OF COLOUR CHART

Note:

This Document is Extremely Time Sensitive - Printed 27 Feb 25 at 11:24

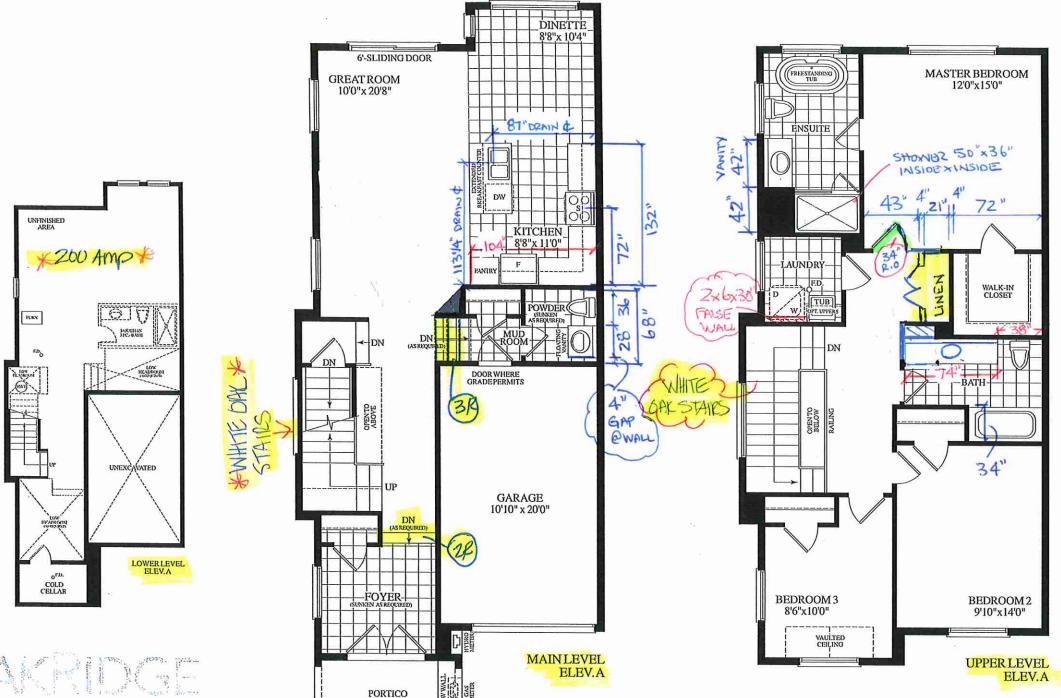

QAKHIDGE KEADOWS