



Structure

PURCHASER'S EXTRAS QUOTATION
Oak Ridge Meadows - Phase 3

PURCHASERS: CONG PANG and LING XIE

TEL:

LOT NUMBER	PHASE	HOUSE TYPE
80 BLOCK 242	3	MACKENZIE-END Elev B

ITEM	EXTRA / CHANGE	QTY	UNIT PRICE	EXTENDED
1 232898	BASEMENT- Install the 200 amp service in lieu of the standard (See Sketch)	1		
2 232899	KITCHEN- Install the 8" duct to exhaust fan in lieu of the standard (See Sketch)	1		
3 232900	KITCHEN- Install the gas line rough in for the stove (See Sketch)	1		
4 232901	MAIN BATH- Install a shower pot light for the tub shower ceiling (See Sketch)	1		
5 232902	FRONT EXTERIOR- Install an exterior Soffit for holiday lights (See Sketch)	1		
6 232903	PURCHASER AWARE AND ACCEPTS THAT ANY CHANGES MADE TO UPGRADES AFTER SIGNING THIS PURCHASERS EXTRA FORM ARE SUBJECT TO A MINIMUM ADMINISTRATION FEE OF \$1,000	1		
7 232904	PURCHASER HAS ATTENDED A STRUCTURAL APPOINTMENT AT THE DESIGN STUDIO AND HAS DECLINED ANY ADDITIONAL UPGRADES	1		
8 232905	BONUS PACKAGE-PURCHASER TO RECEIVE \$7,500 (INCLUSIVE OF TAXES) WORTH OF UPGRADES AT THE DESIGN STUDIO AT TIME OF COLOUR CHART BONUS PACKAGE-PURCHASER HAS A REMAINING BALANCE OF \$1,115.50 (INCLUSIVE OF TAXES) WORTH OF UPGRADES AT THE DESIGN STUDIO AT TIME OF COLOUR CHART	1		

Sub Total
HST
Total



1. In the event the work on the house has progressed beyond the point where the items covered by this extra cannot be installed without entailing any unusual expense, then this order is to be cancelled and any deposit paid in connection with the same is to be refunded to the Purchaser.
2. The Vendor will undertake to incorporate the work covered by the sales extra in the construction of the house but will not be liable to the purchaser in any way, if for any reason the work covered by the extra is not carried out. In that event, any monies paid in connection with the same shall be returned to the Purchaser.
3. It is understood and agreed that if for any reason whatsoever the transaction of Purchase and Sale is not completed, the total cost of extras ordered are not refundable to the Purchaser(s).
4. Extras or changes will not be processed unless signed by the Vendor.
5. These extras may not be amended without the written consent of Grovetrail Developments Inc..
6. The Purchaser(s) and the Vendor acknowledge and agree that this form shall not be deemed to be part of the Agreement of Purchase and Sale entered into between them, nor an addendum thereto.
7. No Estimates or orders will be accepted once construction has commenced.
8. Prices are estimates only and guaranteed for a period of 5 days only.
9. Any cancellations to this order, providing they can be cancelled, are subject to a \$500 minimum administration charge and a 10% cancellation charge for the total amount being cancelled.
10. For Visa, Mastercard and Debit payments, transactions are identified on you statement as "SHERWAY CONSTRUCTION LTD", an Authorized Visa /Mastercard/Debit Merchant and authorized Royal Pine Homes company.

TAX#:1




PREPARED BY: Laura Di Pede
PRINTED: 17-Mar-25 at 12:32 pm
RoyalPine\SOL\mt 07aug20

Initials:

CONSTRUCTION SCHEDULING APPROVAL

PER:

DATE:

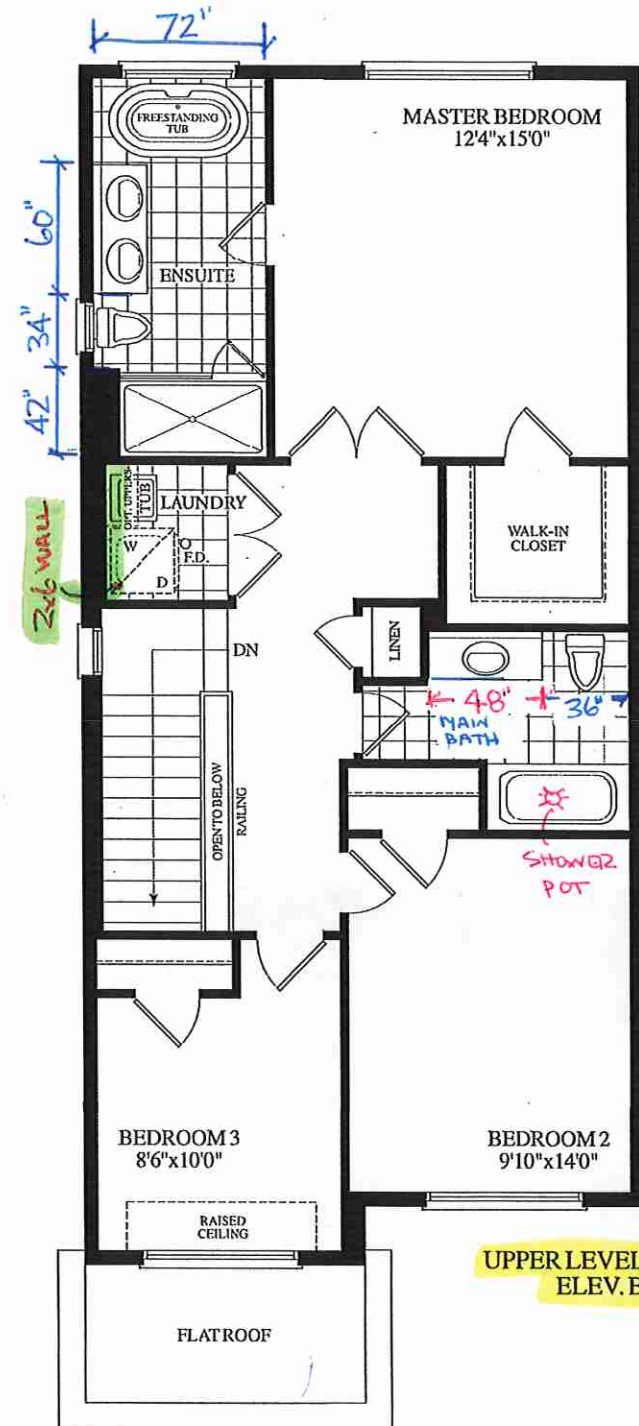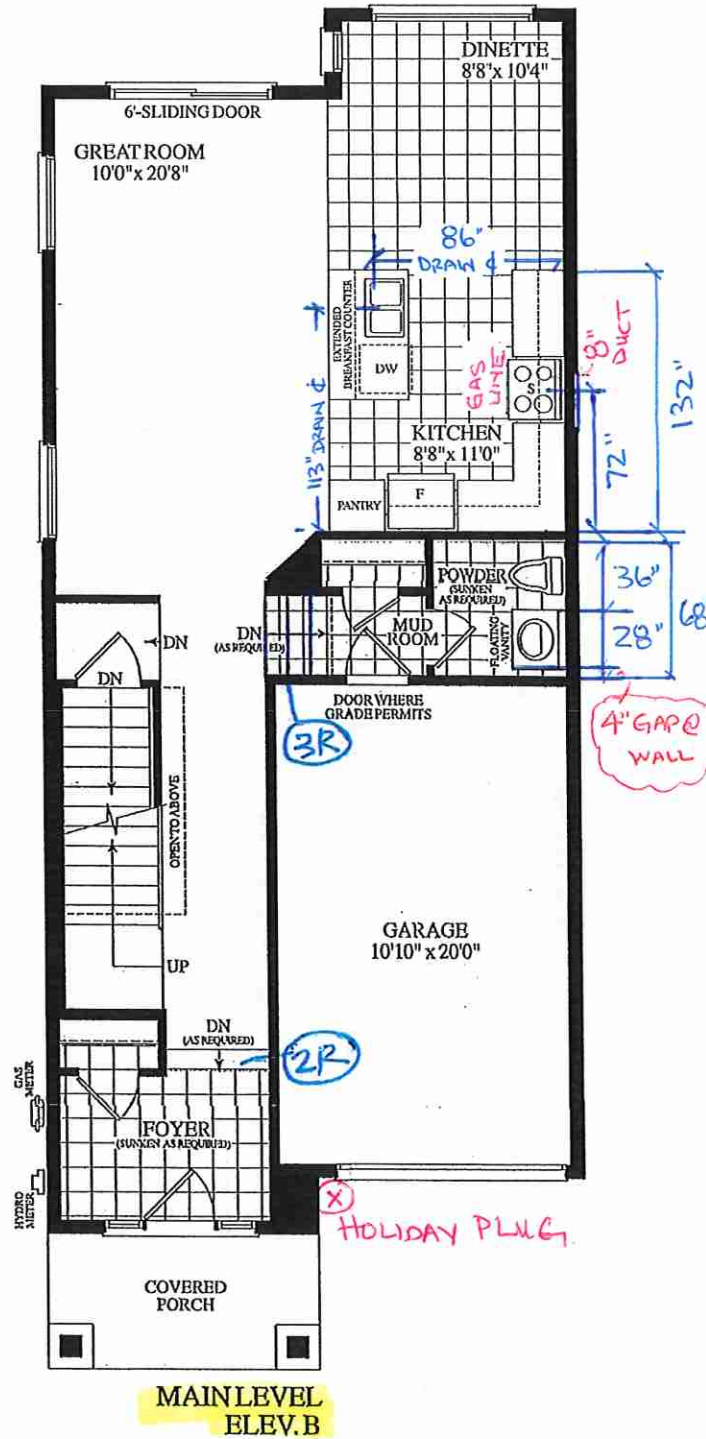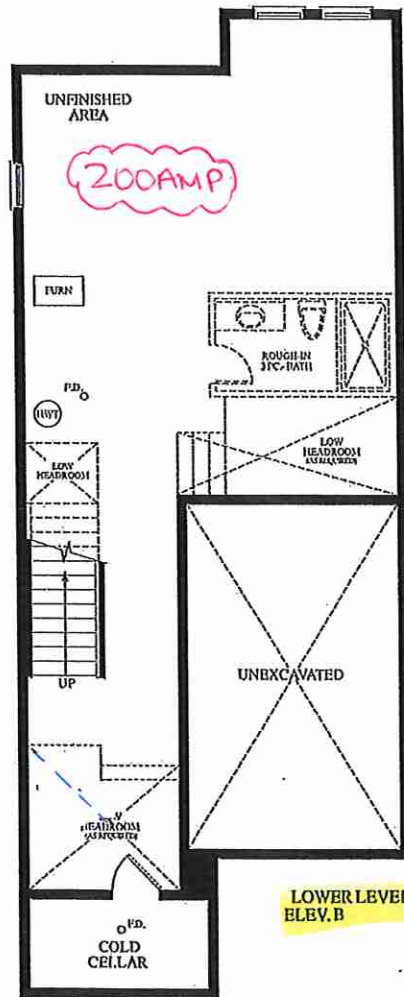

OAKRIDGE
MEADOWS

BLK. 242 TH. 80 20-09 THE MACKENZIE EL. B 1710 SQ. FT.