




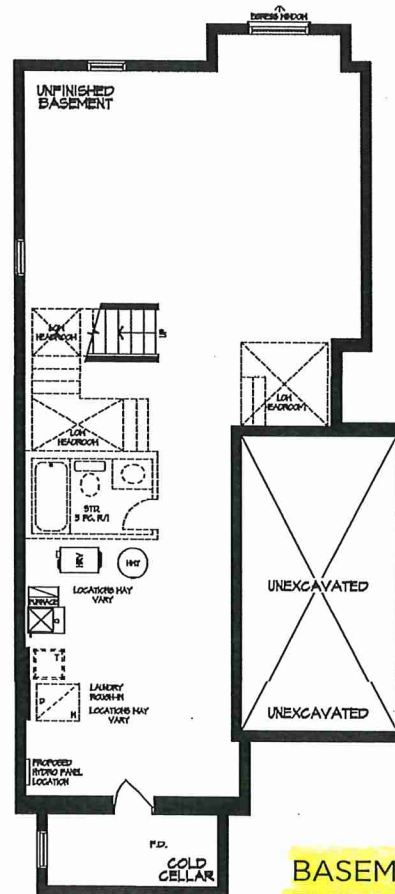

BASEMENT
ELEVATION B1

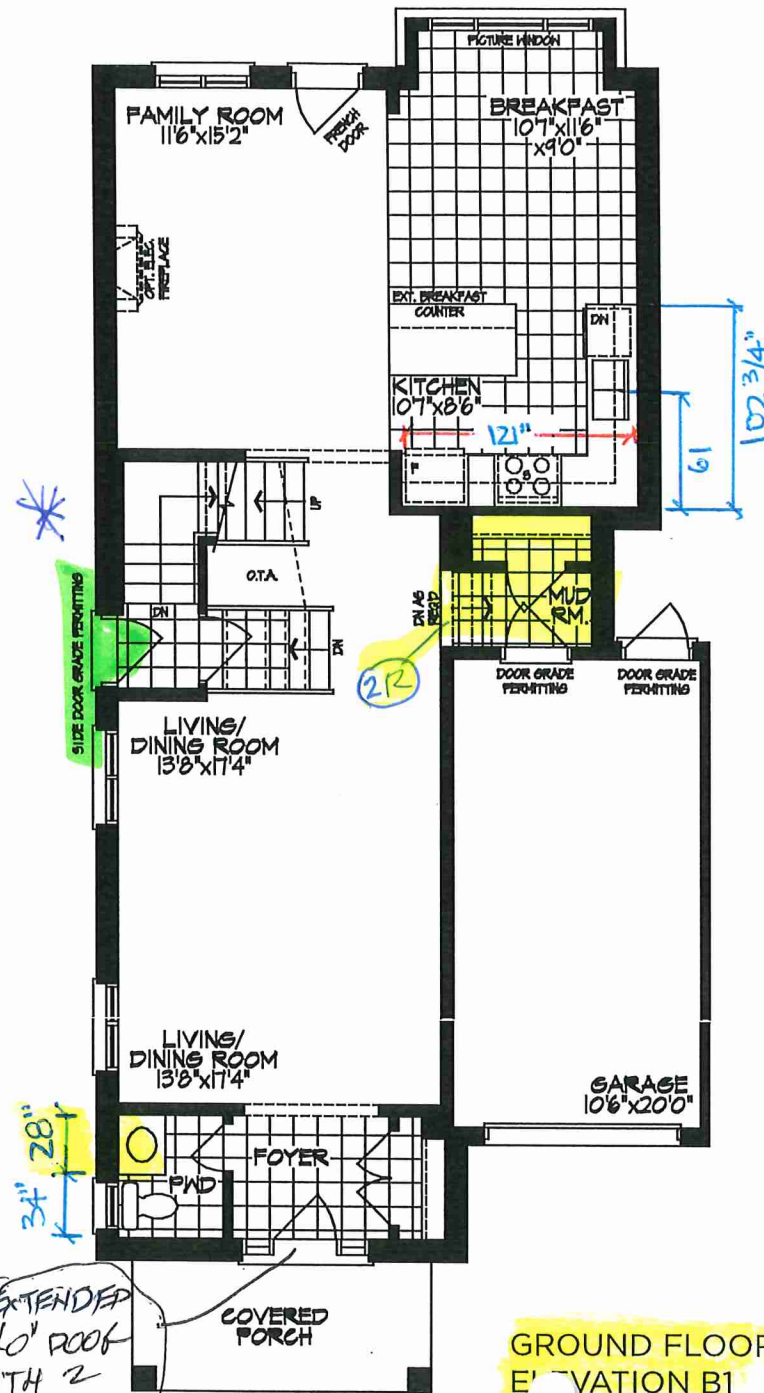

GROUND FLOOR
ELEVATION B1

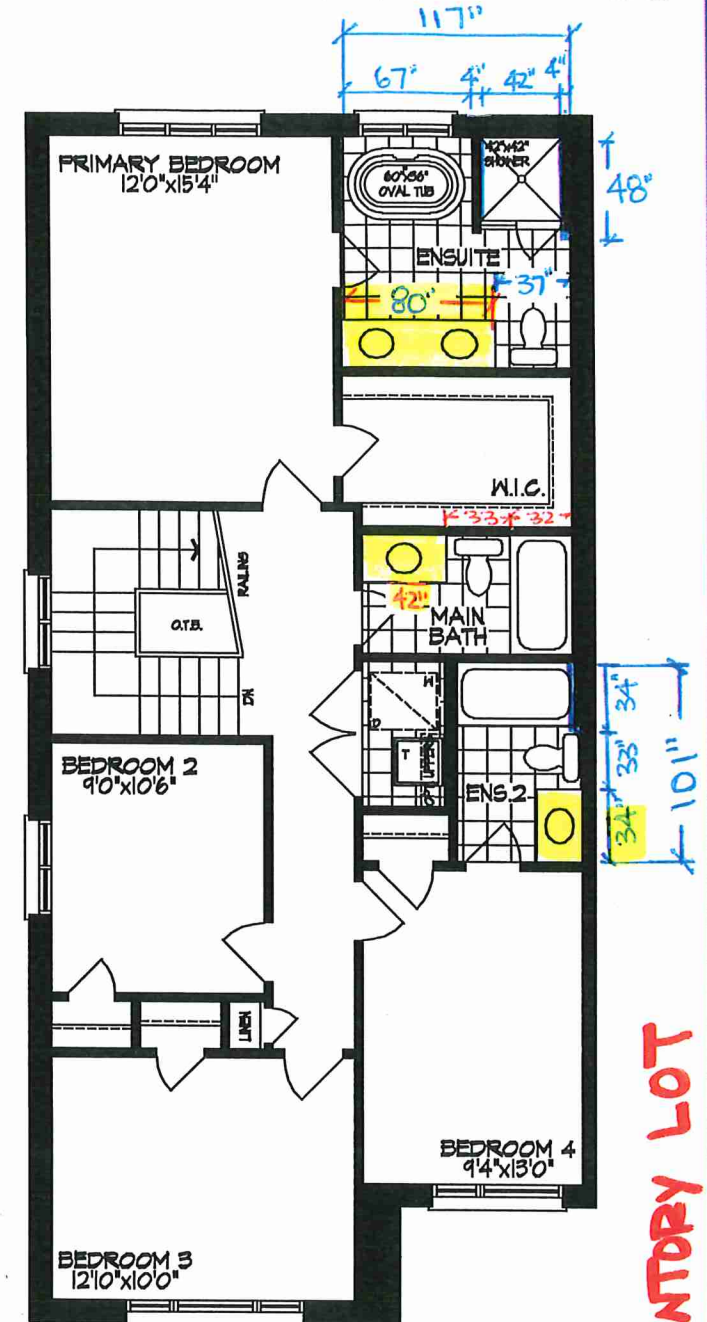


OPT. SECOND FLOOR
W/4 BEDROOMS & 3 PATHROOMS
ELEVATION B1

INVENTORY LOT

LOT 102L 30-03 THE NOLANA EL. B1 4 BEDROOM 2165 SQ. FT.

Materials, specifications and floor plans are subject to change without notice. All renderings are artist's concept. All floor plans are approximate dimensions. Actual usable floor space may vary from the stated floor area. E.&O.E.

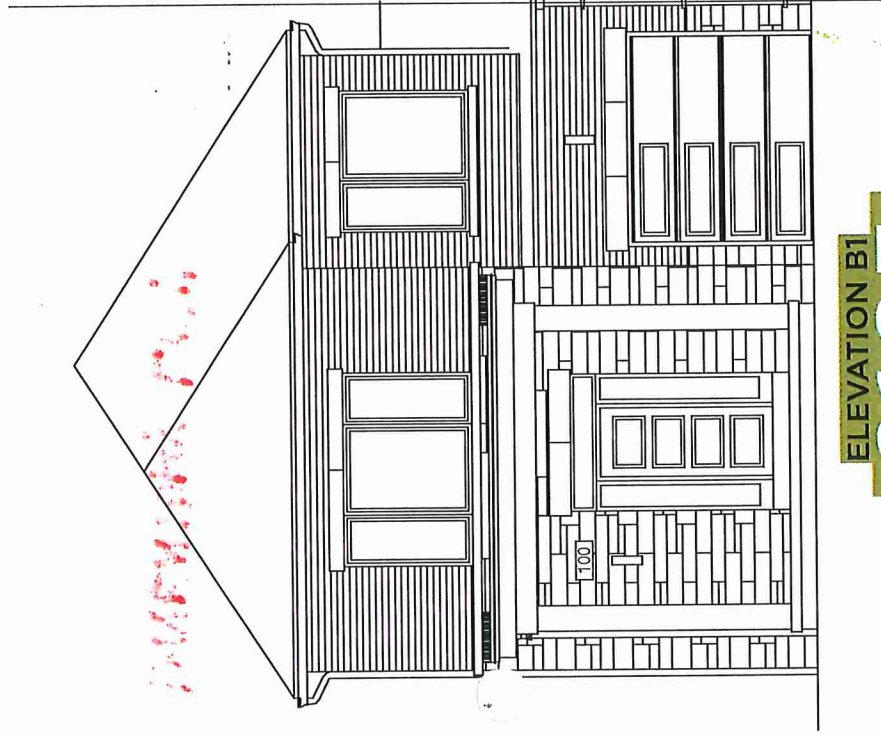

ELEVATION B1
2165
SQUARE FEET