




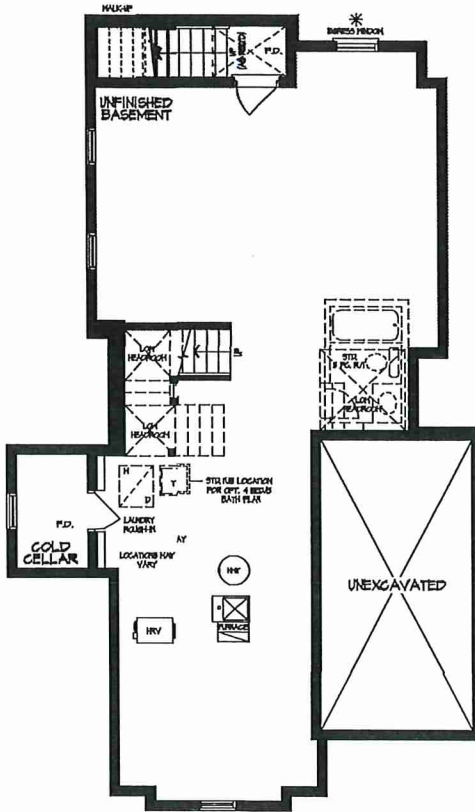

**BASEMENT
ELEVATION B**

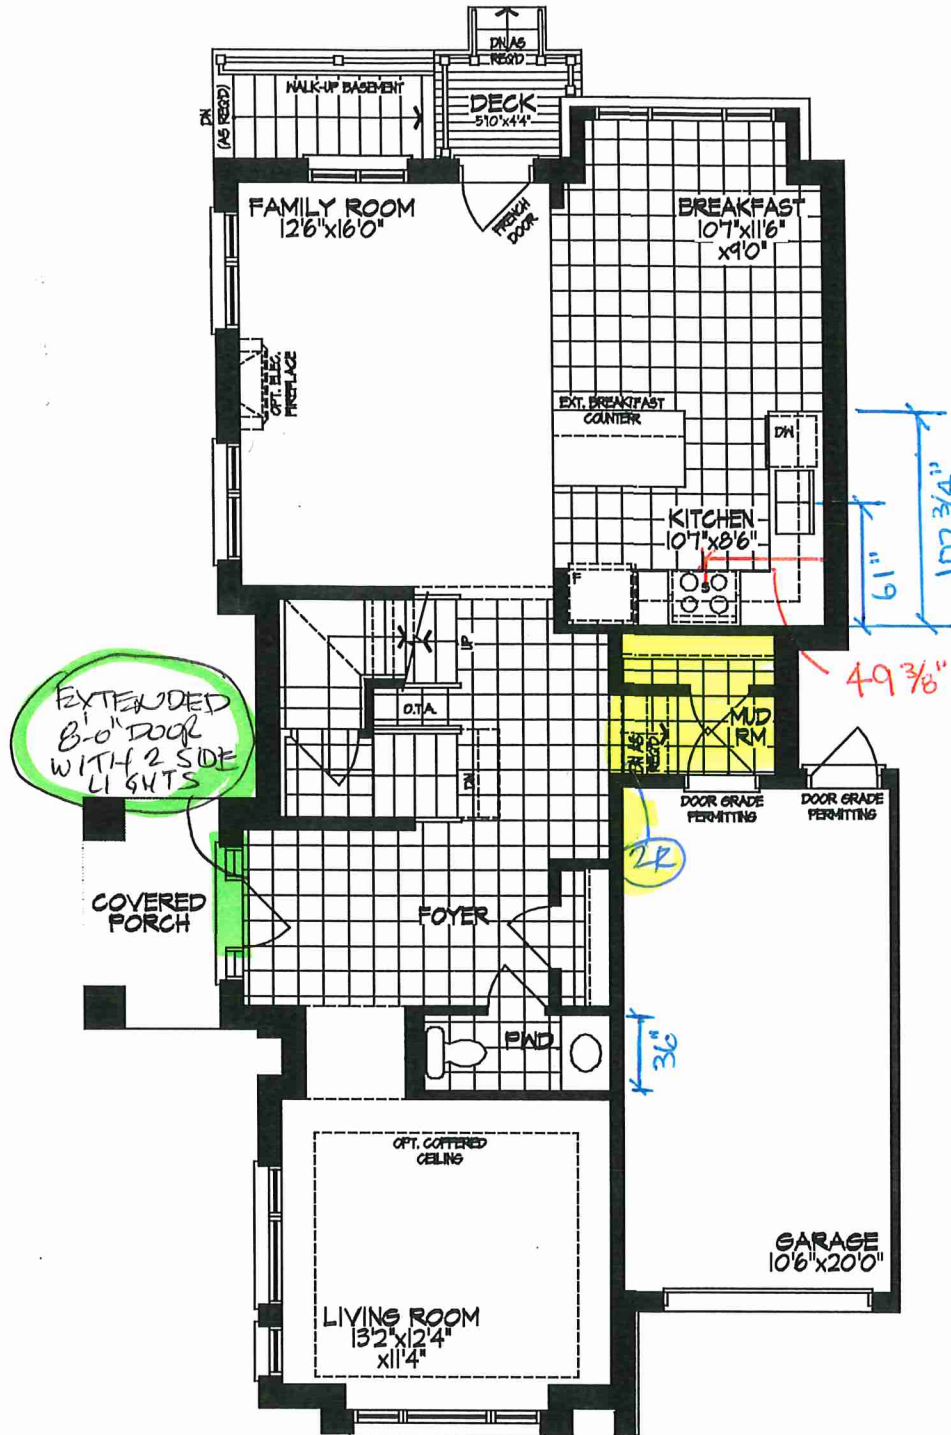

**GROUND FLOOR
ELEVATION B**

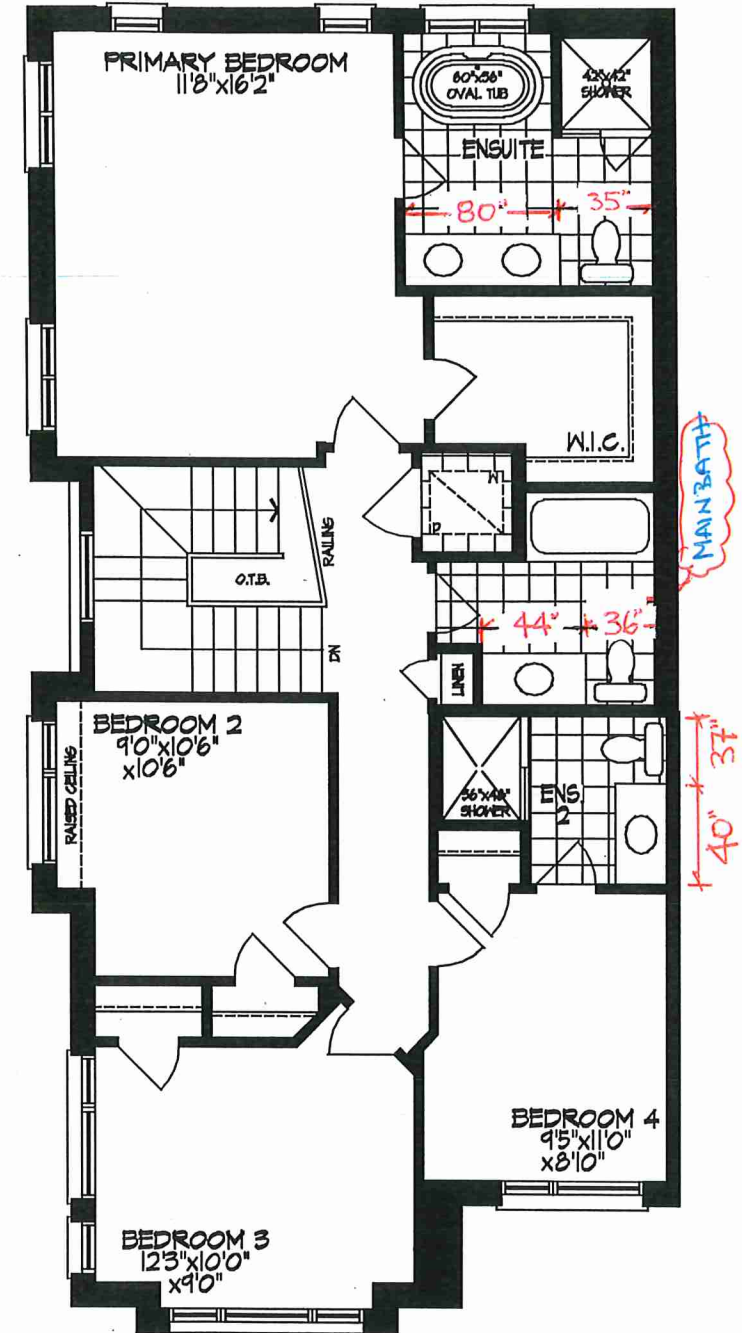



**OPT. SECOND FLOOR
W/4 BEDROOMS & 3 BATHROOMS
ELEVATION B**

Materials, specifications and floor plans are subject to change without notice. All renderings are artist's concept. All floor plans are approximate dimensions. Actual usable floor space may vary from the stated floor area. E.&O.E.

INVENTORY LOT

LOT 102R 30-04 THE POPPY EL. B REV. 4 BEDROOM 2165 SQ.FT.

12/26/03 VOL

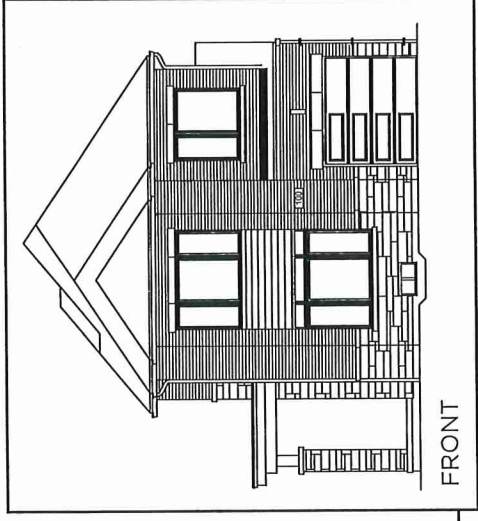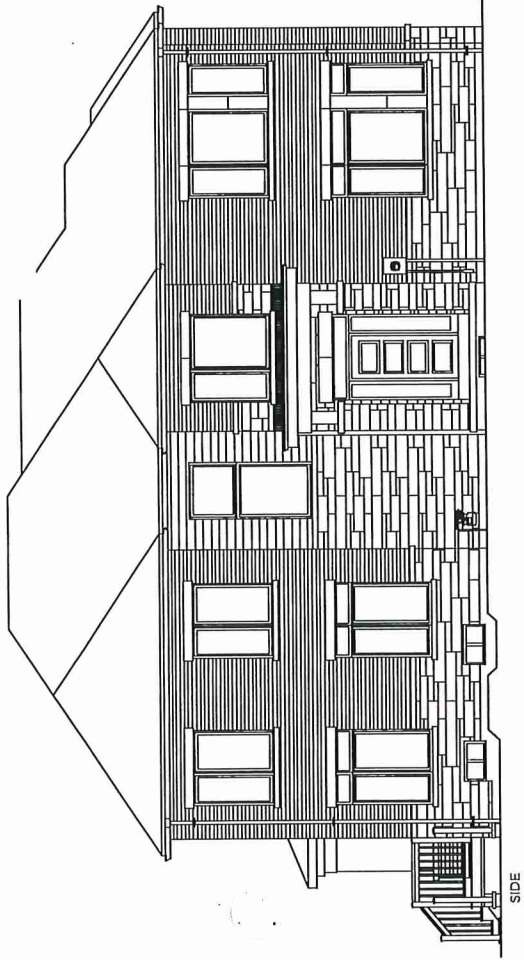

ELEVATION B
2185
SQUARE FEET