

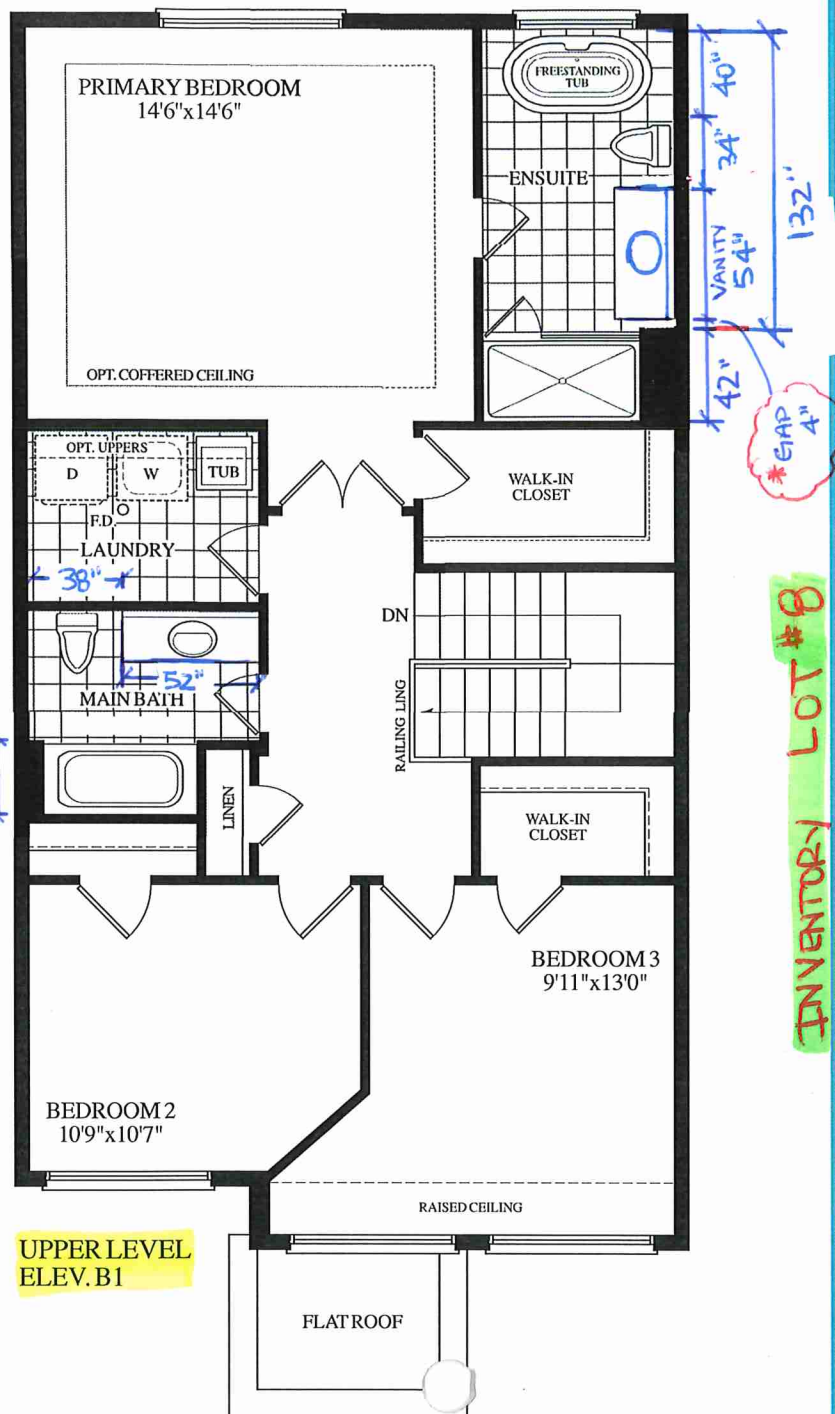


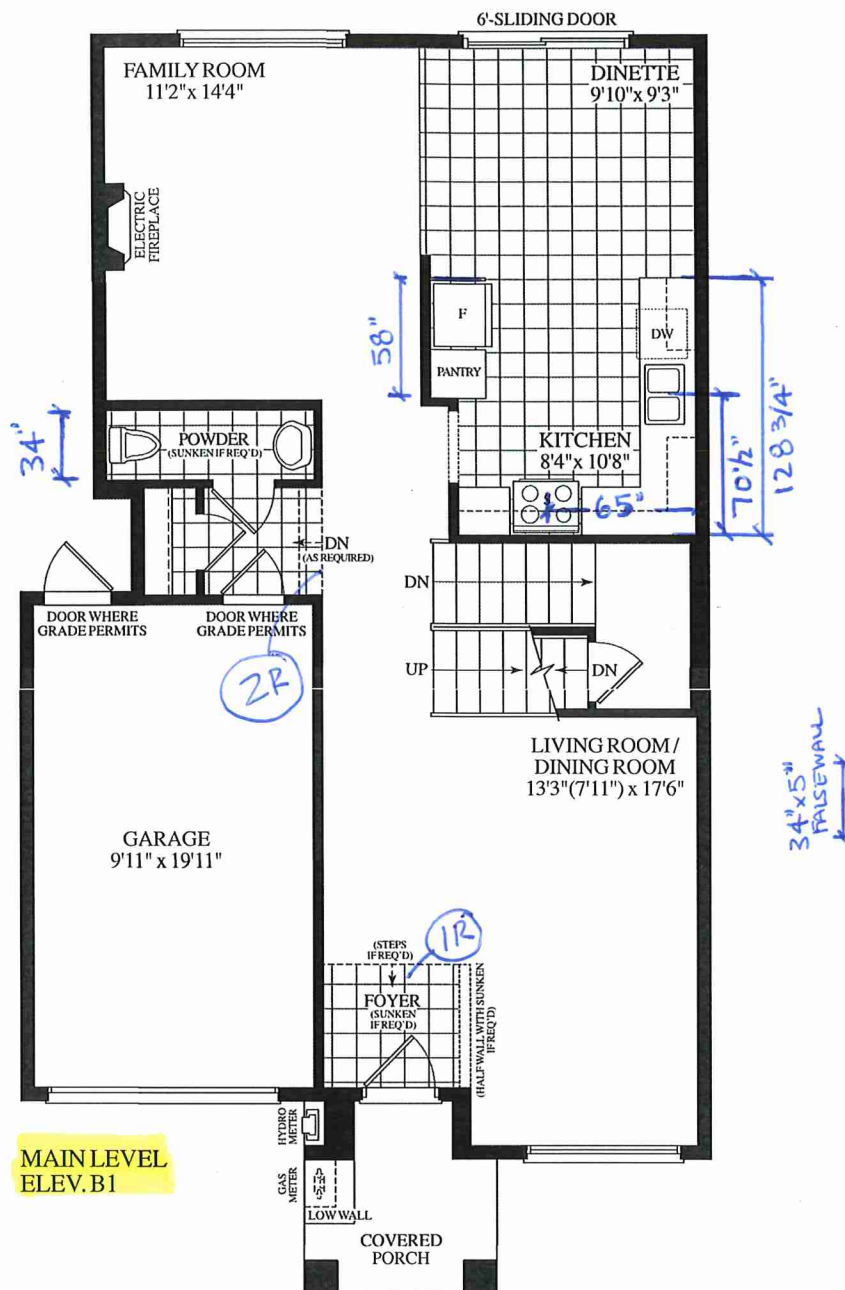

Materials, specifications and floor plans are subject to change without notice. All renderings are artist's concept. All floor plans are approximate dimensions. Actual usable floor space may vary from the stated floor area. E.&O.E.

**BLOCK 290 - TH. 8    25-01 DESERT ROSE EL. B1 REV.    3 BEDROOM    1875 SQ. FT.**

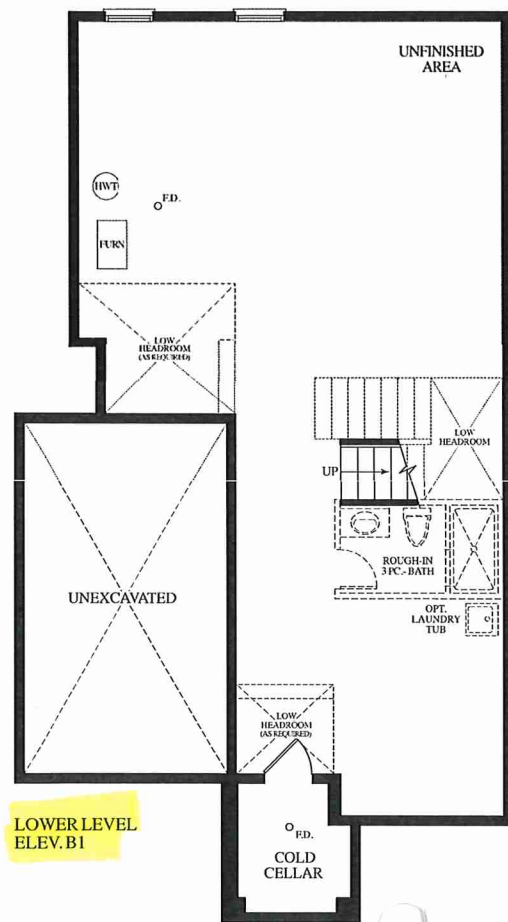

Artist concept

ELEV. B1

**1875**  
SQUARE FEET

