


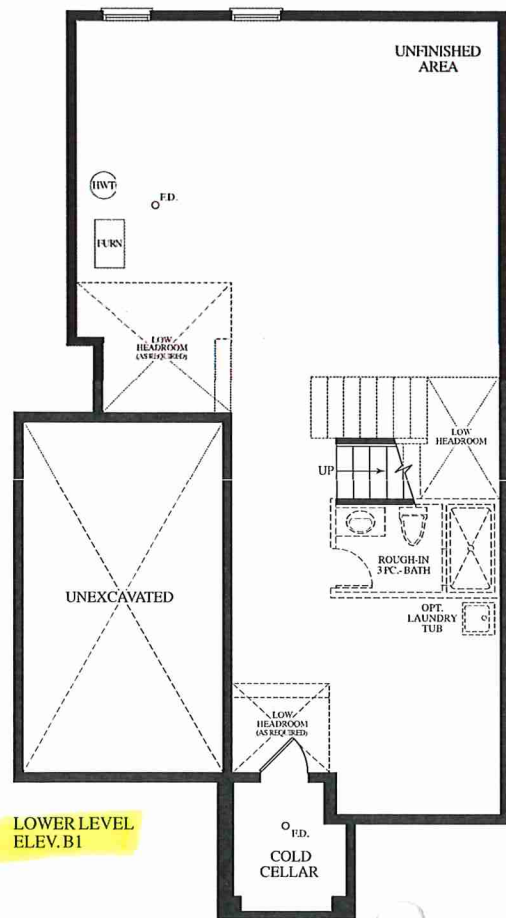


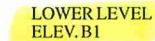

GROUND FLOOR PLAN ELEV. (REV)

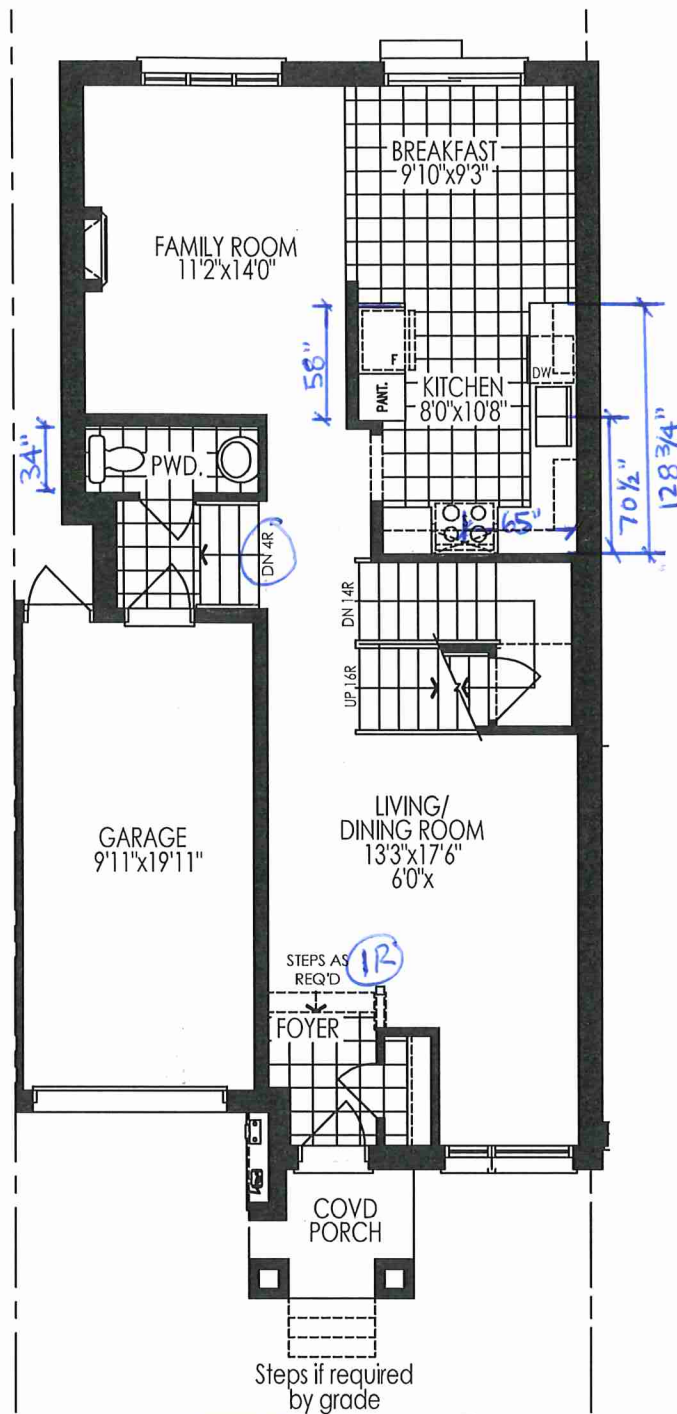


UPPER LEVEL
ELEV. B1

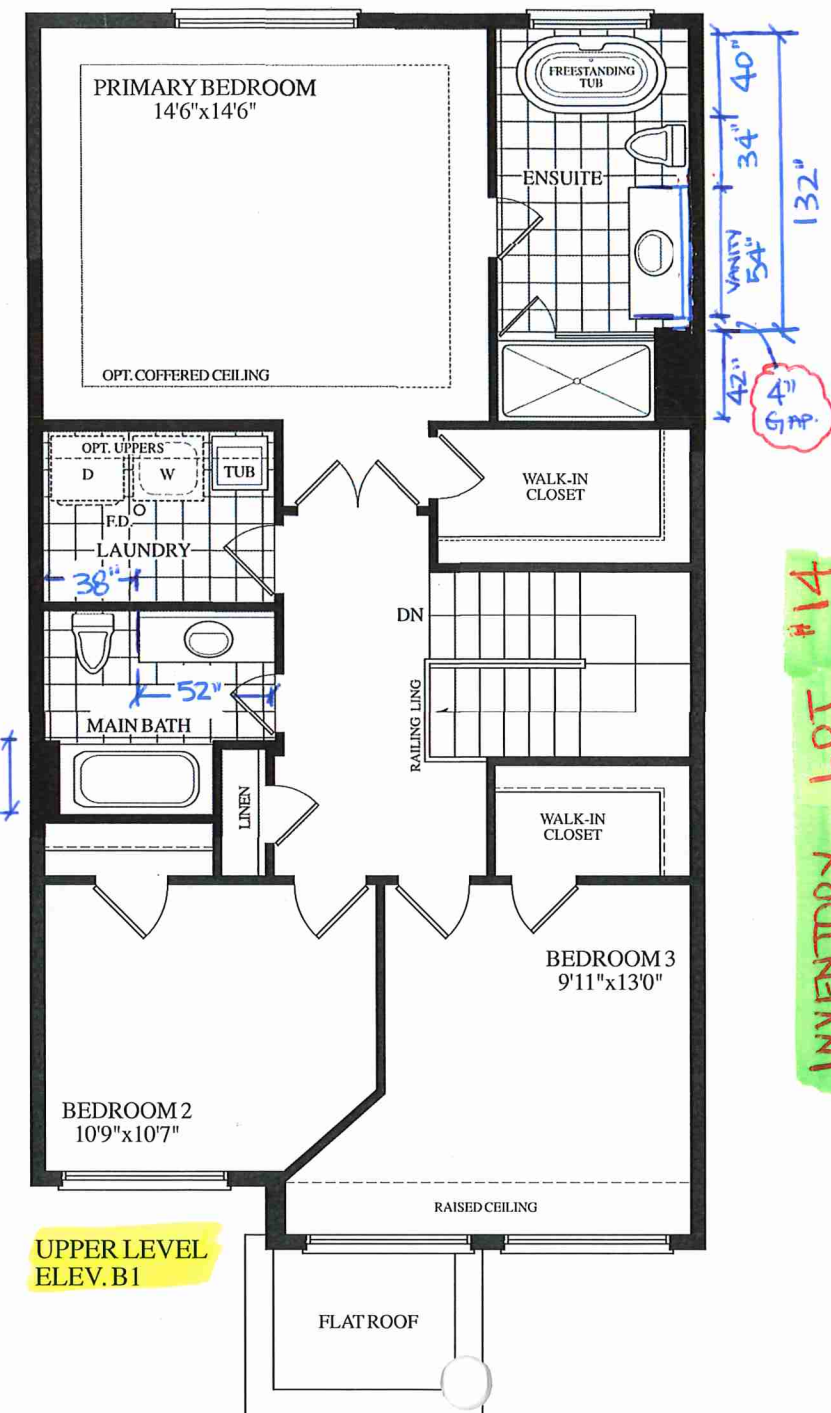

INVENTORY LOT #14

BLOCK 291 - TH 14 25-01 DESERT ROSE EL. B1 3 BEDROOM 1875 SQ. FT.

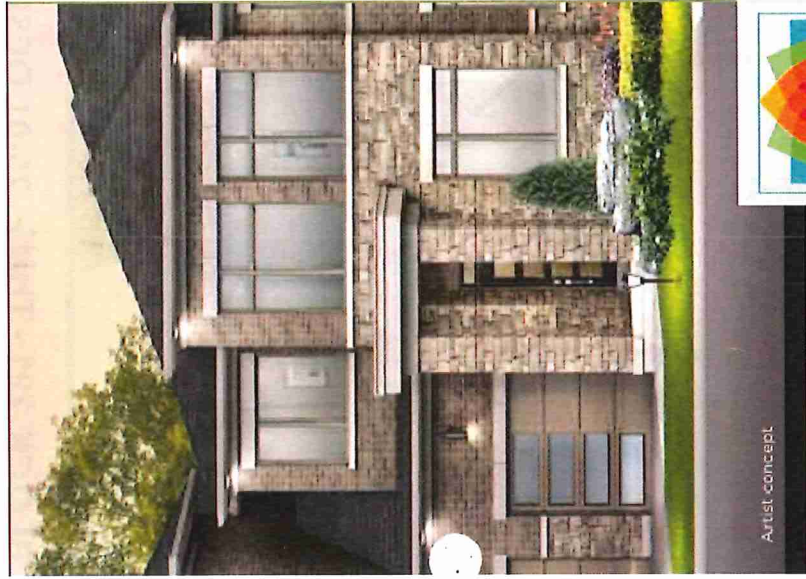

Artist concept

ELEV. B1

1875
SQUARE FEET

