



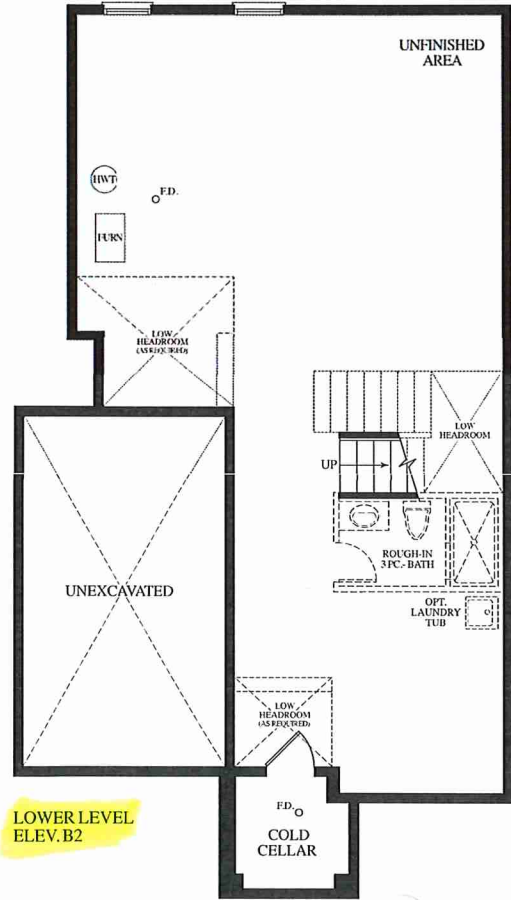


LOWER LEVEL
ELEV. B2

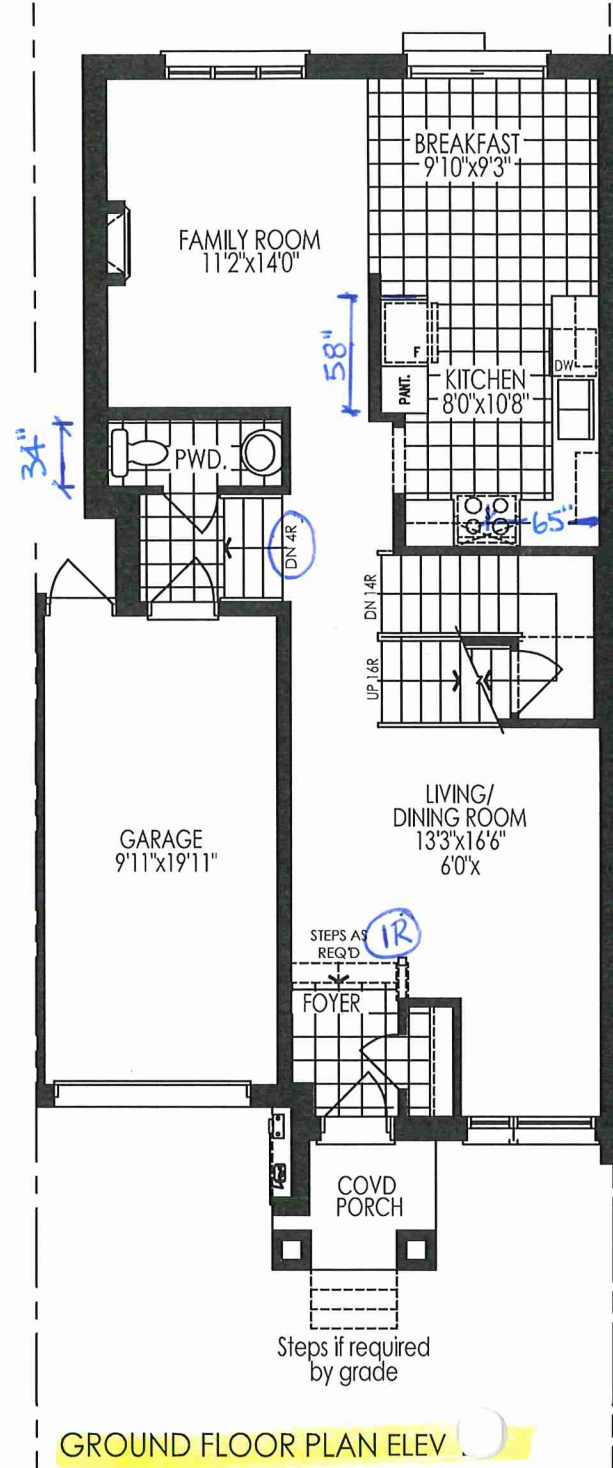

GROUND FLOOR PLAN ELEV.

Materials, specifications and floor plans are subject to change without notice. All renderings are artist's concept. All floor plans are approximate dimensions. Actual usable floor space may vary from the stated floor area. E.&O.E.

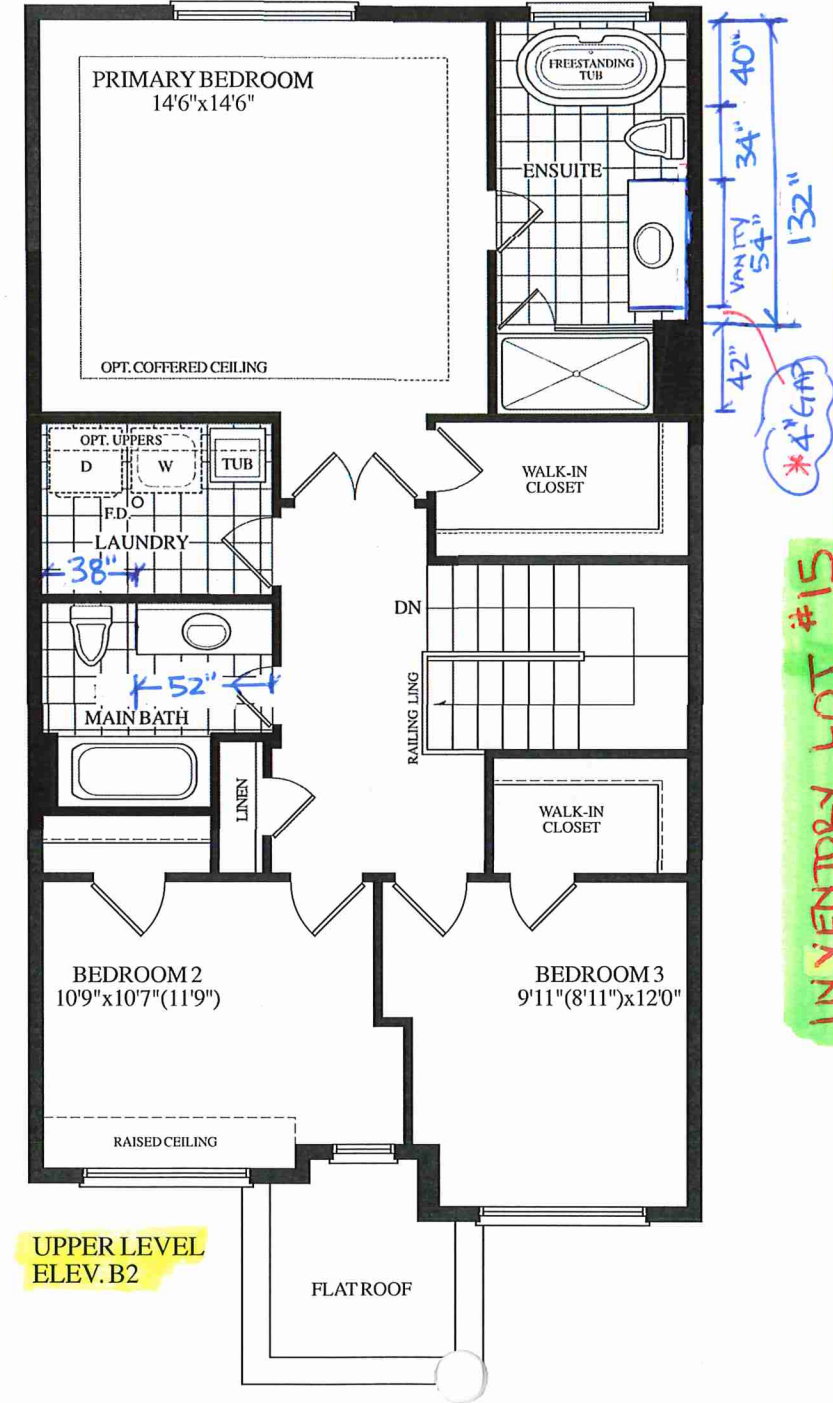

UPPER LEVEL
ELEV. B2

INVENTORY LOT #15

BLOCK 291 - TH.15 25-01 DESERT ROSE EL. B2 3 BEDROOM 1875 SQ. FT.



Artist concept

ELEV. B2