



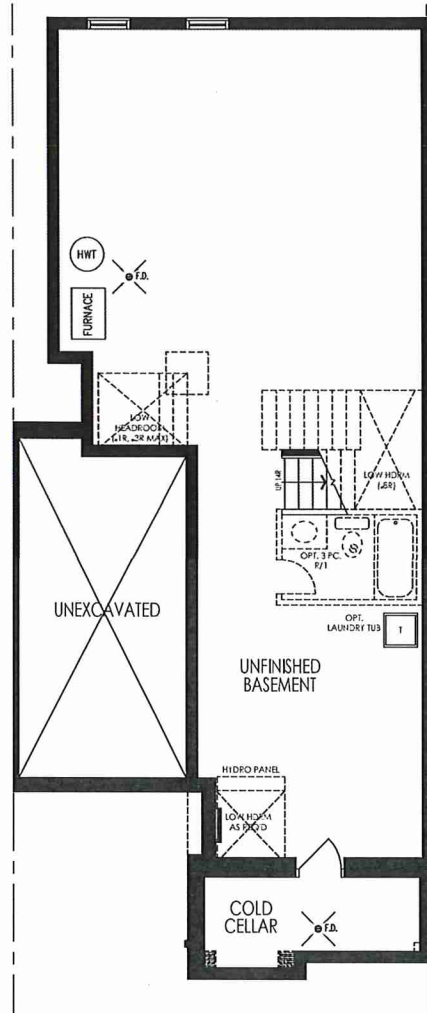


BASEMENT PLAN ELEV 'B1' (REV)

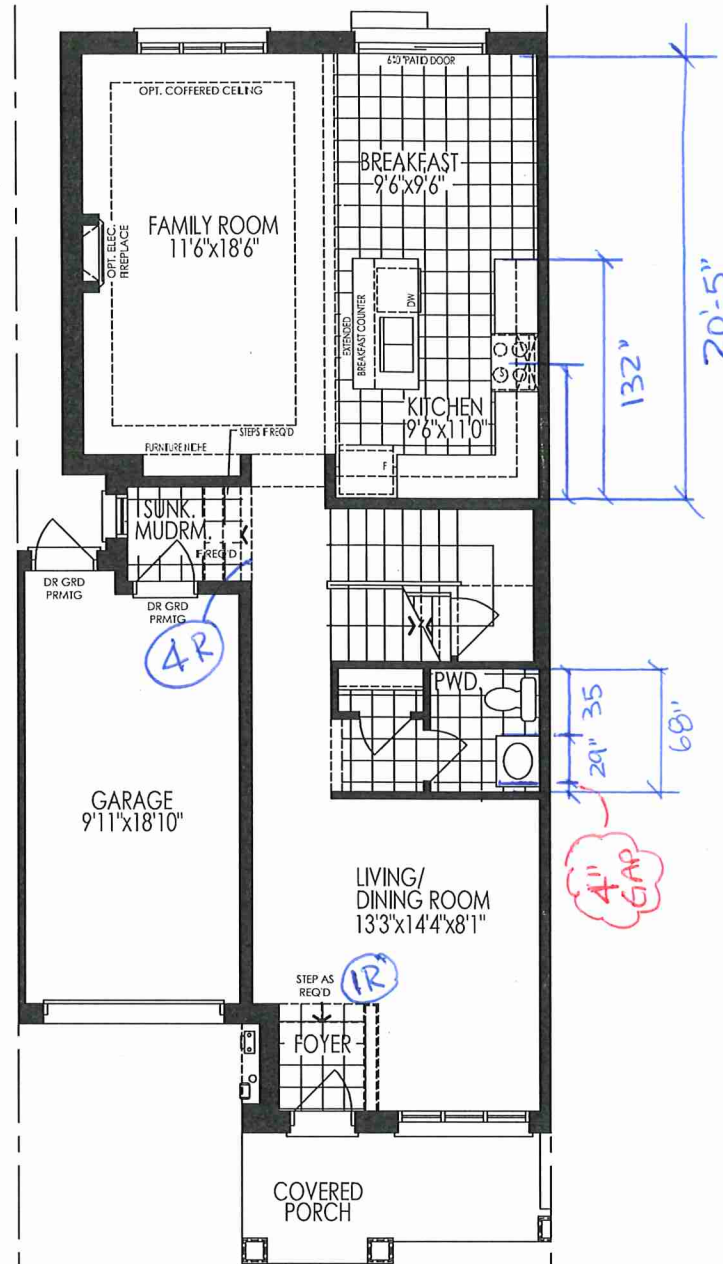


REVISED MAIN
GROUND FLOOR PLAN ELEV B1 (REV)

OPT. SECOND FLOOR
(W/OPT. 4 BEDROOM) PLAN ELEV B1 (REV)

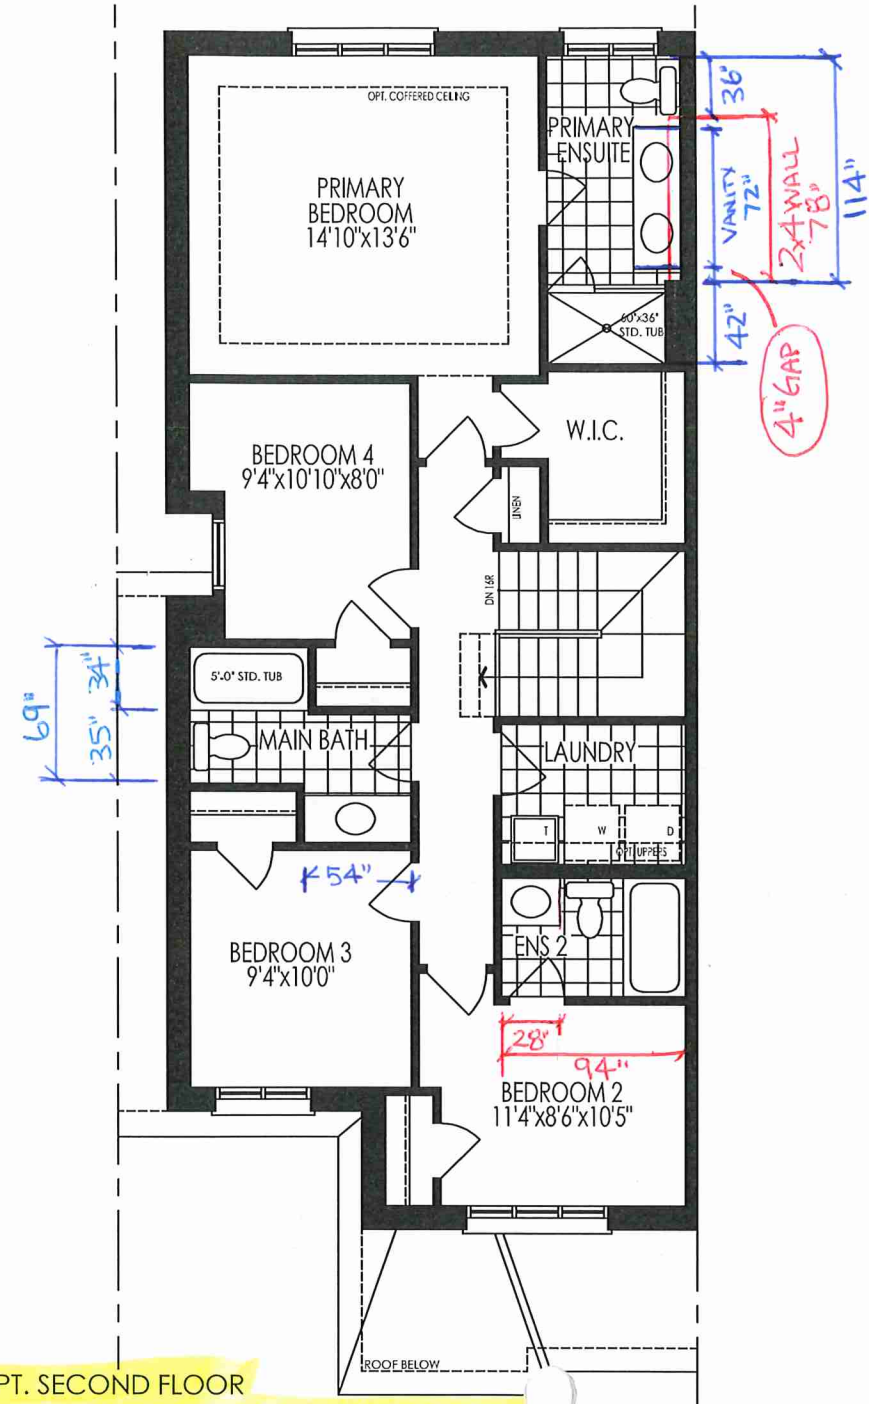

INVENTORY TH #16 = REVISED MAIN / OPT 4 BEDROOM

BLOCK 291.TH. 16 25-02 ROSE GARDEN EL. B1 4 BDR. 1940 SQ. FT.

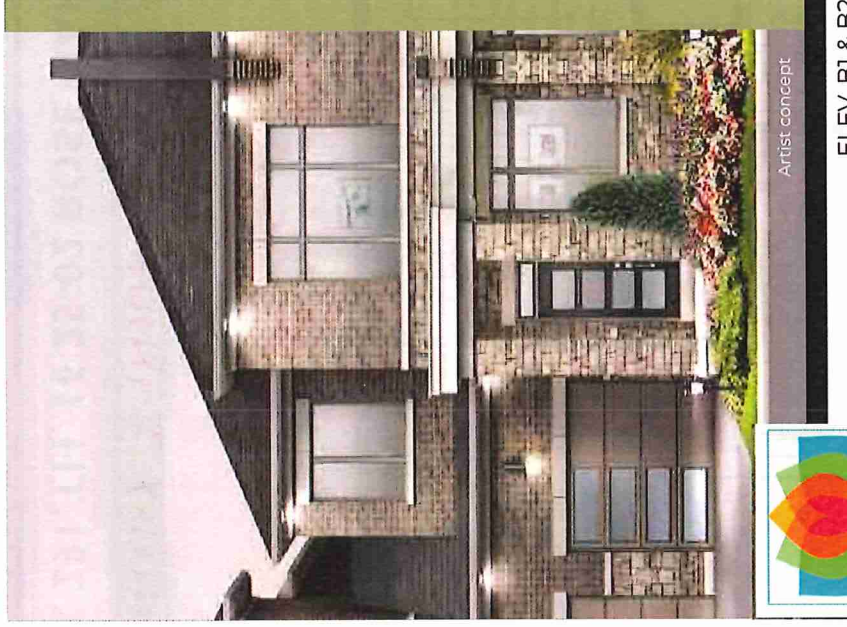

Artist concept

ELEV. B1 & B2



1940
SQUARE FEET