

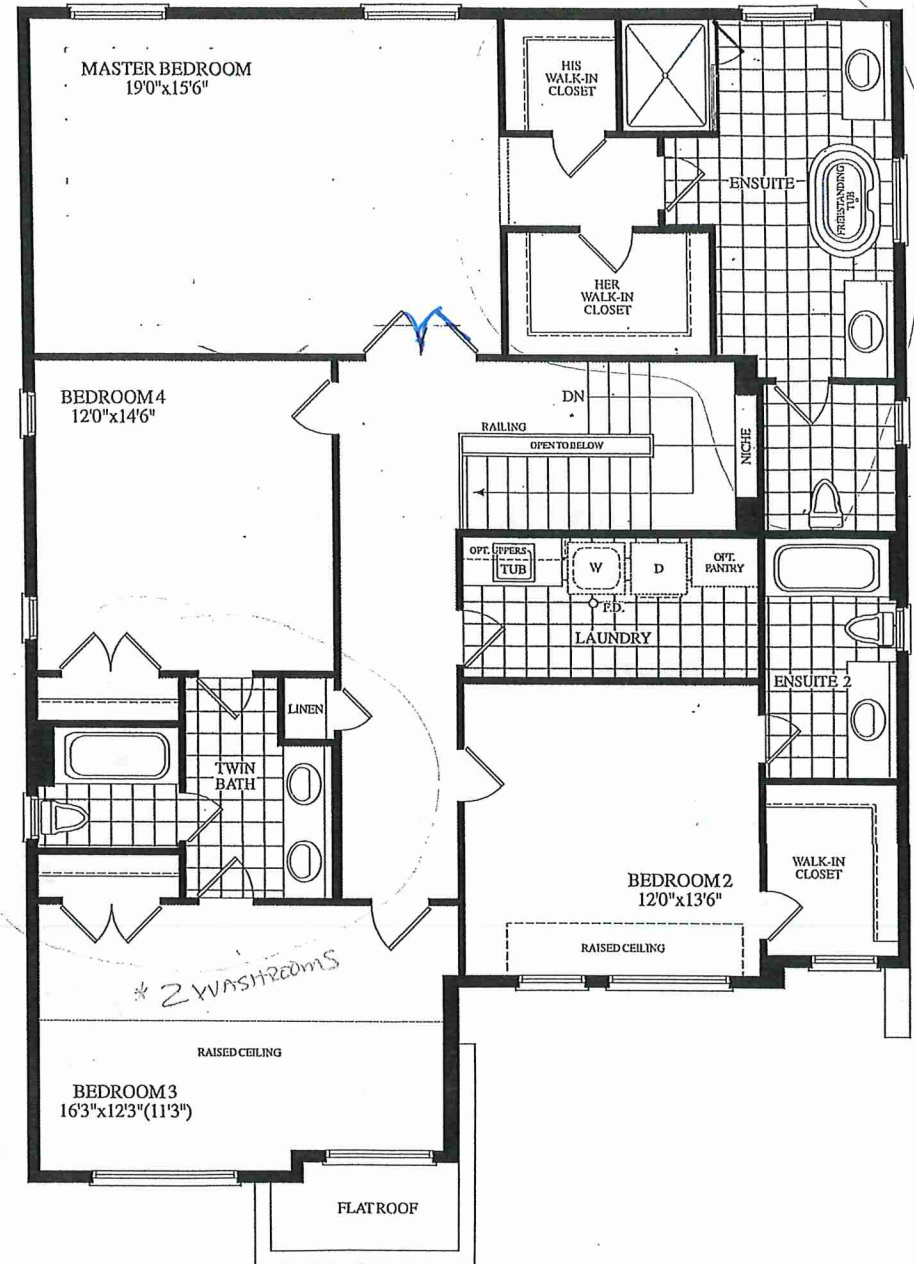


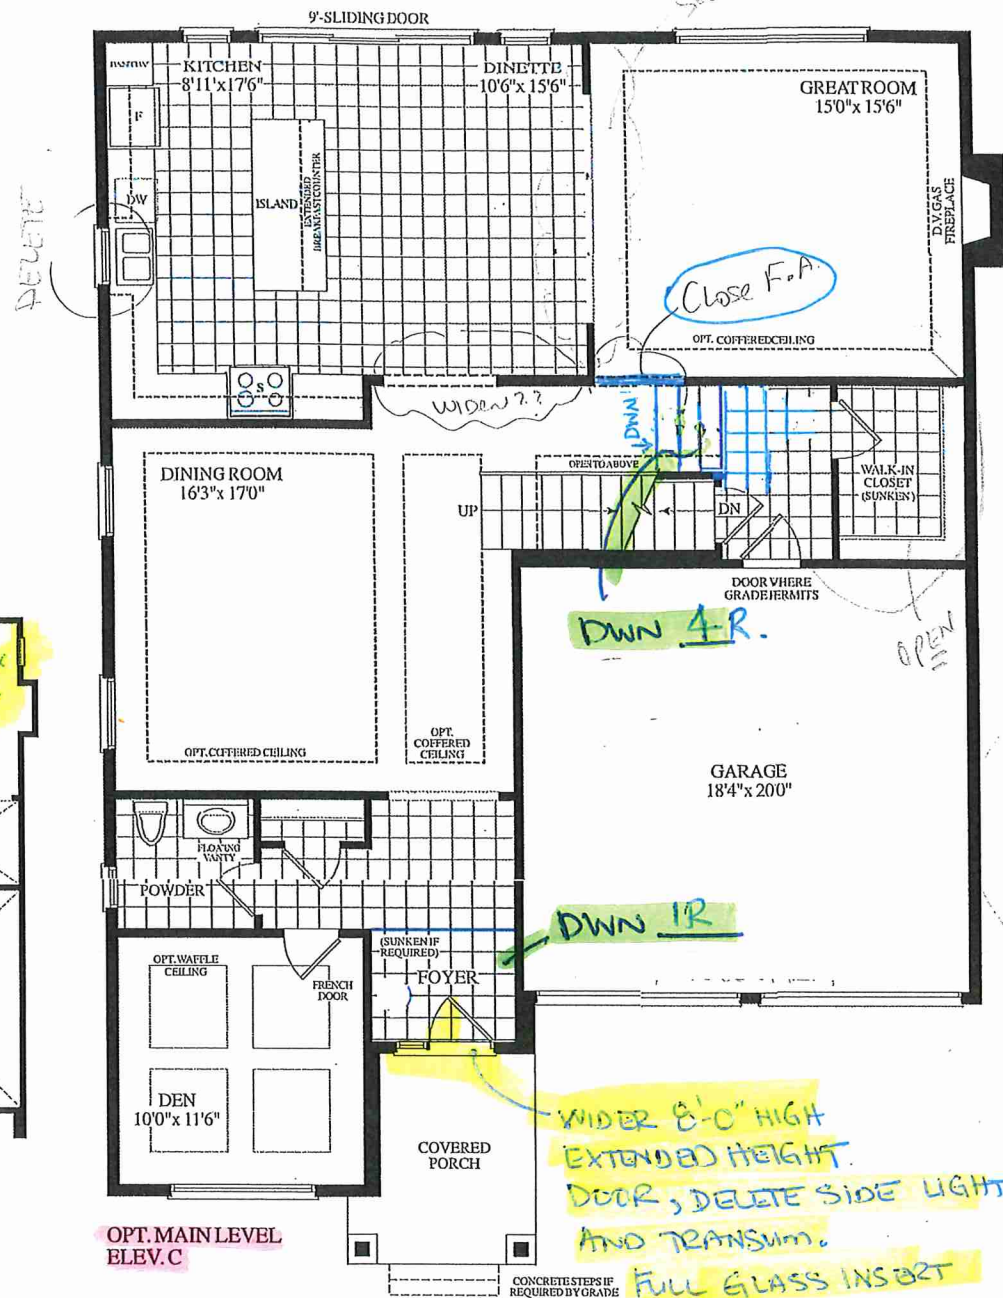

UPPER LEVEL (4 BEDROOM)
ELEV. C
FOR OPT. MAIN LEVEL

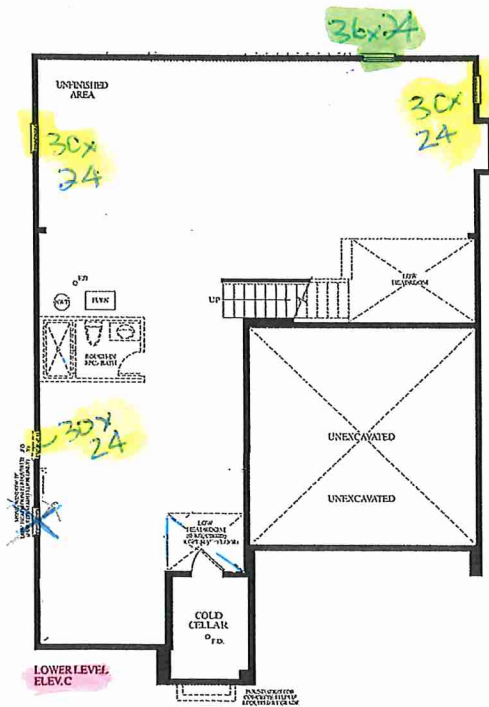

45' LOTS | THE **ELMWOOD** (45-05)
OPTIONAL LAYOUT

ELEVATION C

3290
SQUARE FEET