



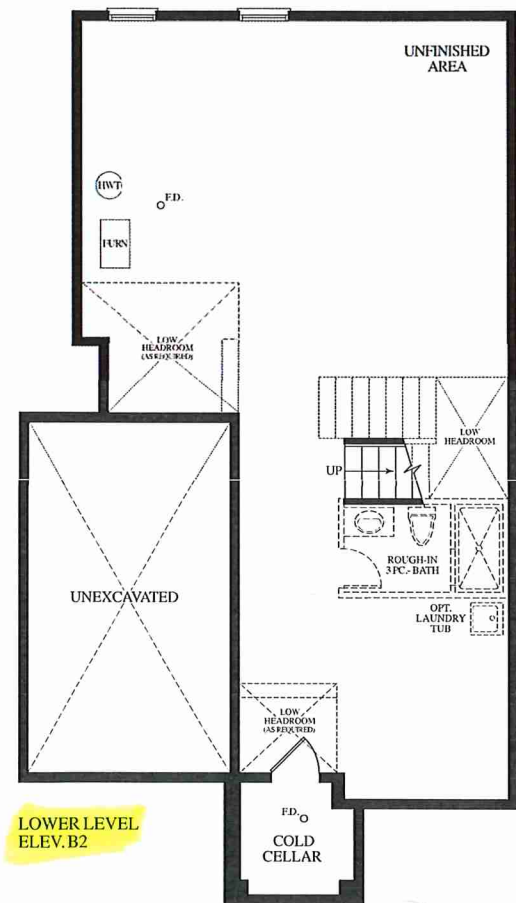

LOWER LEVEL
ELEV. B2

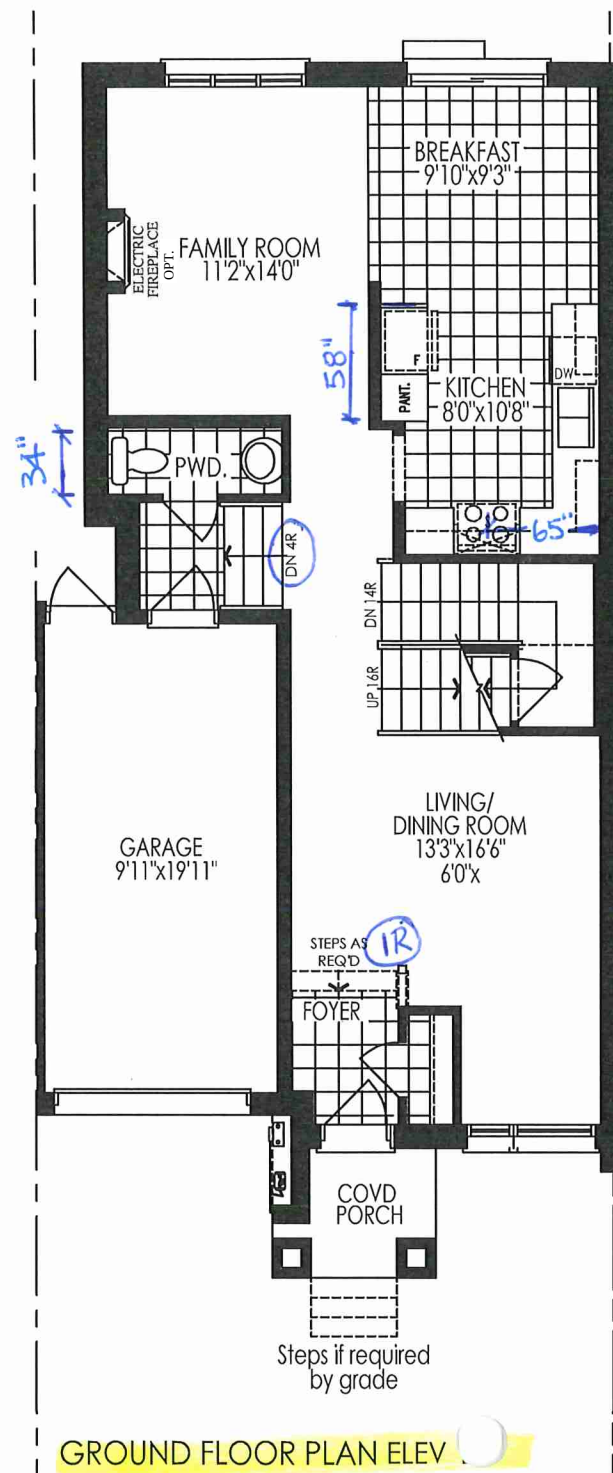

GROUND FLOOR PLAN ELEV

**UPPER LEVEL
ELEV. B2**

PRIMARY BEDROOM
14'6"x14'6"
OPT. COFFERED CEILING

ENSUITE
FREESTANDING TUB

LAUNDRY
OPT. UPERS
D
W
TUB
F.D.
38"

MAIN BATH
52"

BEDROOM 2
10'9"x10'7" (11'9")
RAISED CEILING

BEDROOM 3
9'11" (8'11")x12'0"

WALK-IN CLOSET

WALK-IN CLOSET

FLAT ROOF

DN
RAILING LING

LINEV

UPPER LEVEL
ELEV. B2

INVENTORY LOT #15

BLOCK 291 - TH.15 25-01 DESERT ROSE EL. B2 3 BEDROOM 1875 SQ. FT.



Artist concept

ELEV. B2