


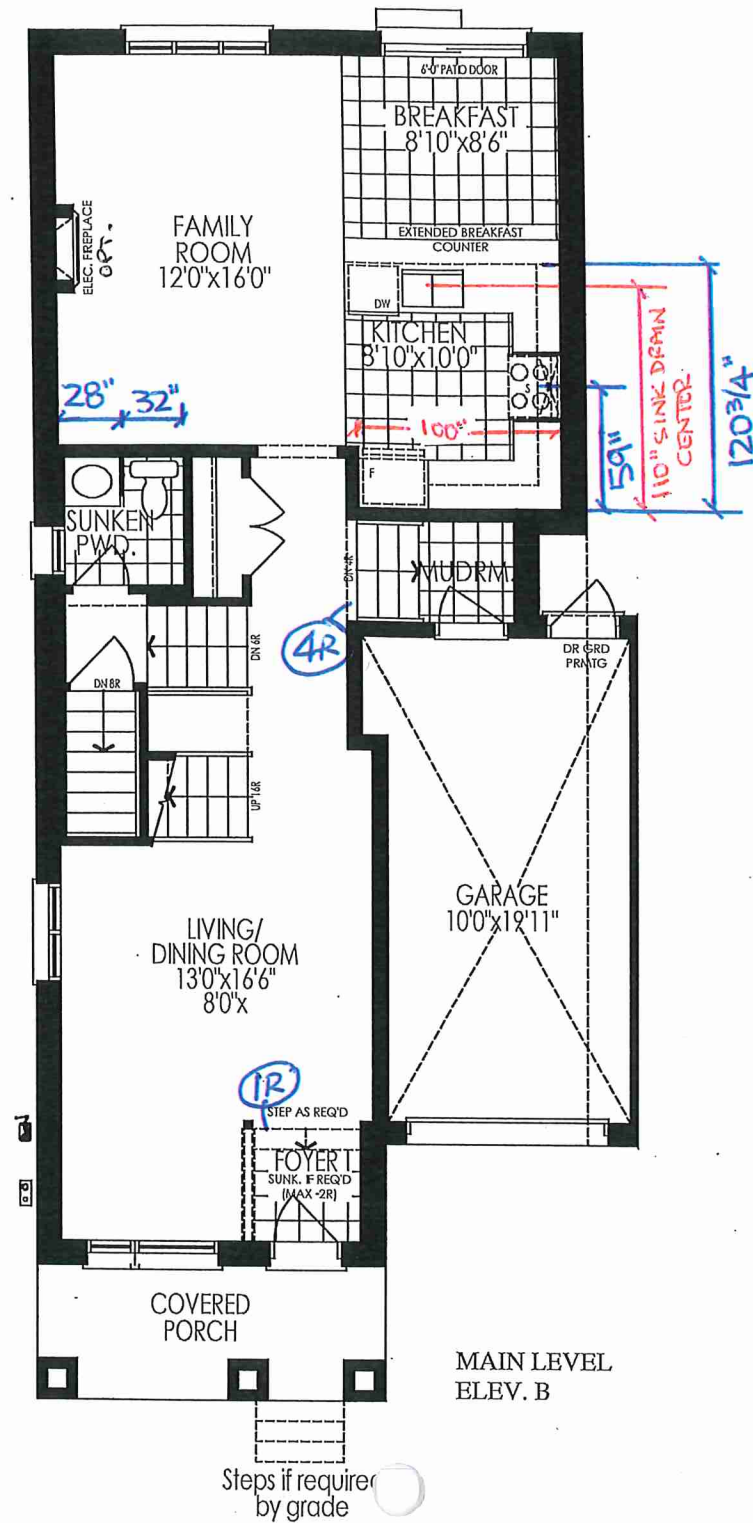


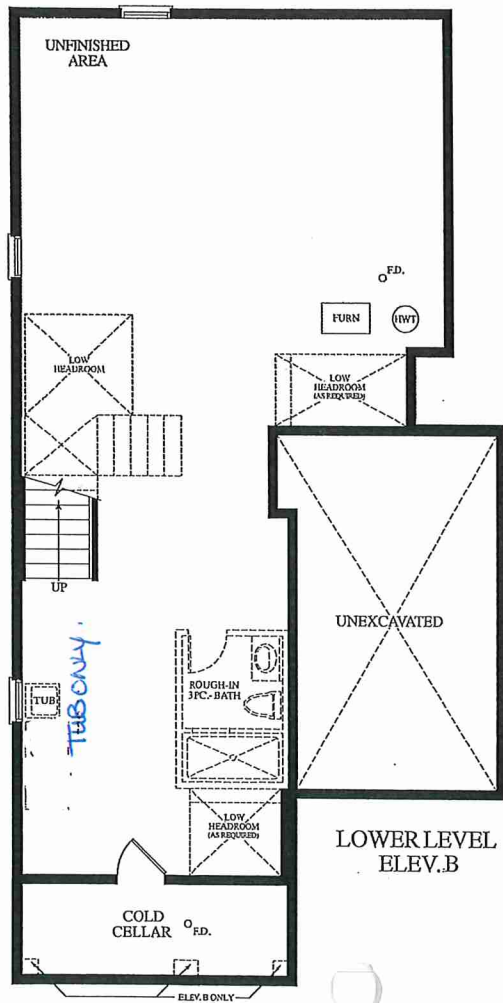

Materials, specifications and floor plans are subject to change without notice. All renderings are artist's concept. All floor plans are approximate dimensions. Actual usable floor space may vary from the stated floor area, E.&O.E.

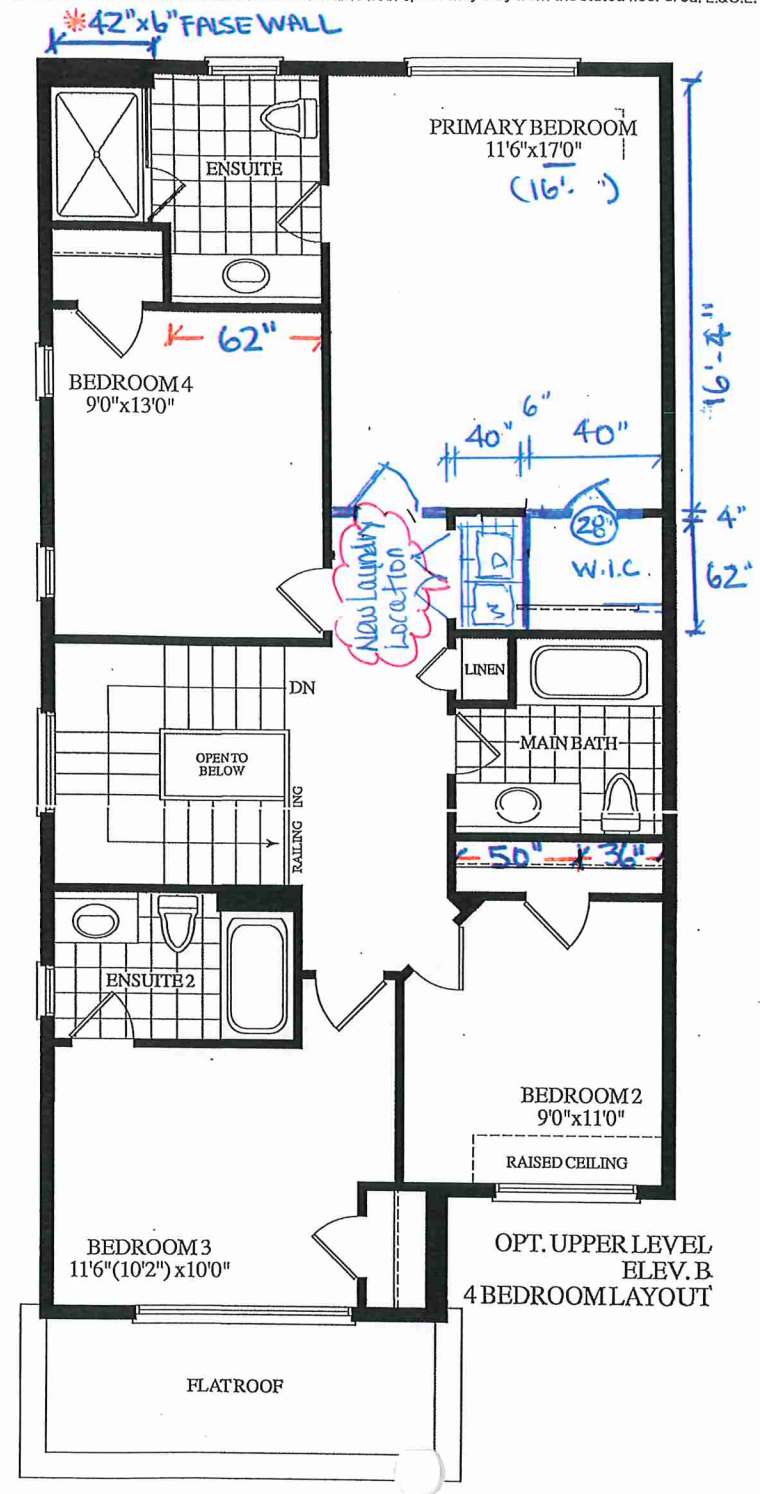

BLOCK 291 - TH. 20 25-04 END FRENCH ROSE EL. B 4 BEDROOM 2385 SQ. FT.

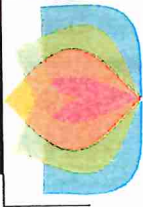

MAYFIELD
VILLAGE

2045
SQUARE FEET

ELEV. B

SCHEDULE "B"

Purchaser	MEHARLEEN, KAUR GAUDH
And	
Vendor	Summer Ridge Estates Inc.
Lot Number	020 BLOCK 291 WATKINS ROAD, Phase 1, Plan as per schedule C in the CITY of BRAMPTON
Date of Offer	June 04, 2023
Offered Required:	November 21, 2024
Model:	FRENCH ROSE (25-04 B 4) ELEV B 4 BEDROOM ()
Description - Vendor to Supply and Install the Following as Per Purchase Price	

- BONUS PACKAGE FOR TOWNS: PURCHASER TO RECEIVE \$10,000.00 (INCLUSIVE OF TAXES) WORTH OF UPGRADES AT DECOR CENTER AT TIME OF COLOUR CHART PLUS FIVE (5) APPLIANCES (FRIDGE, STOVE, DISHWASHER, WASHER AND DRYER) AS PER VENDORS SAMPLES