




BLK. 291-14

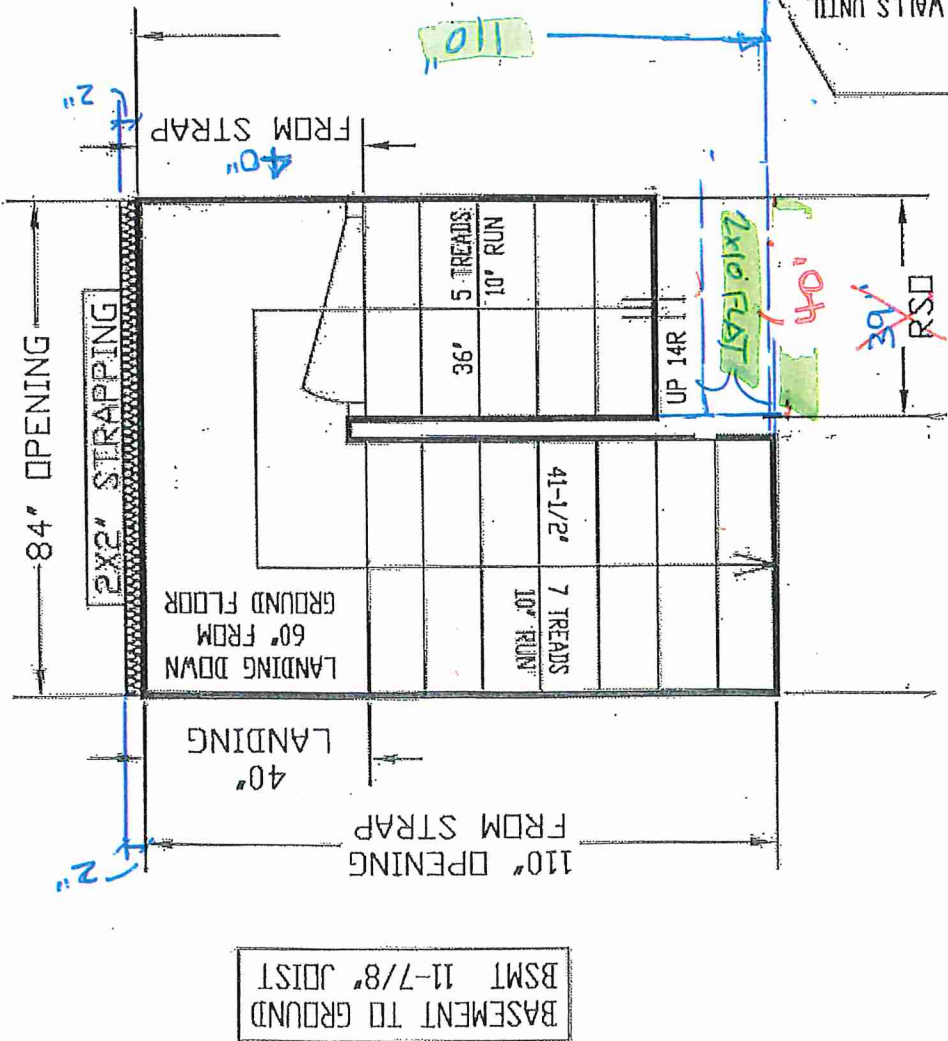

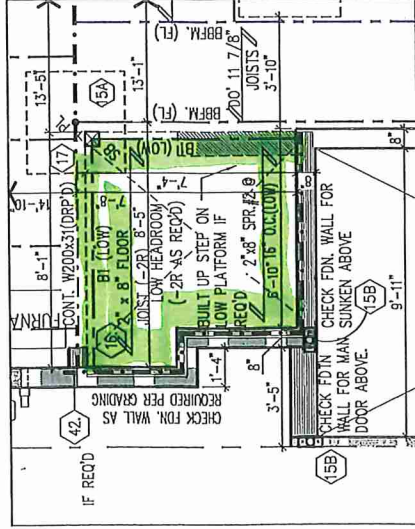

PART. BASEMENT PLAN -
SUNKEN COND. EL. 'A1' (REV)
(EL 'A2', 'B1' & 'B2' SIMILAR)

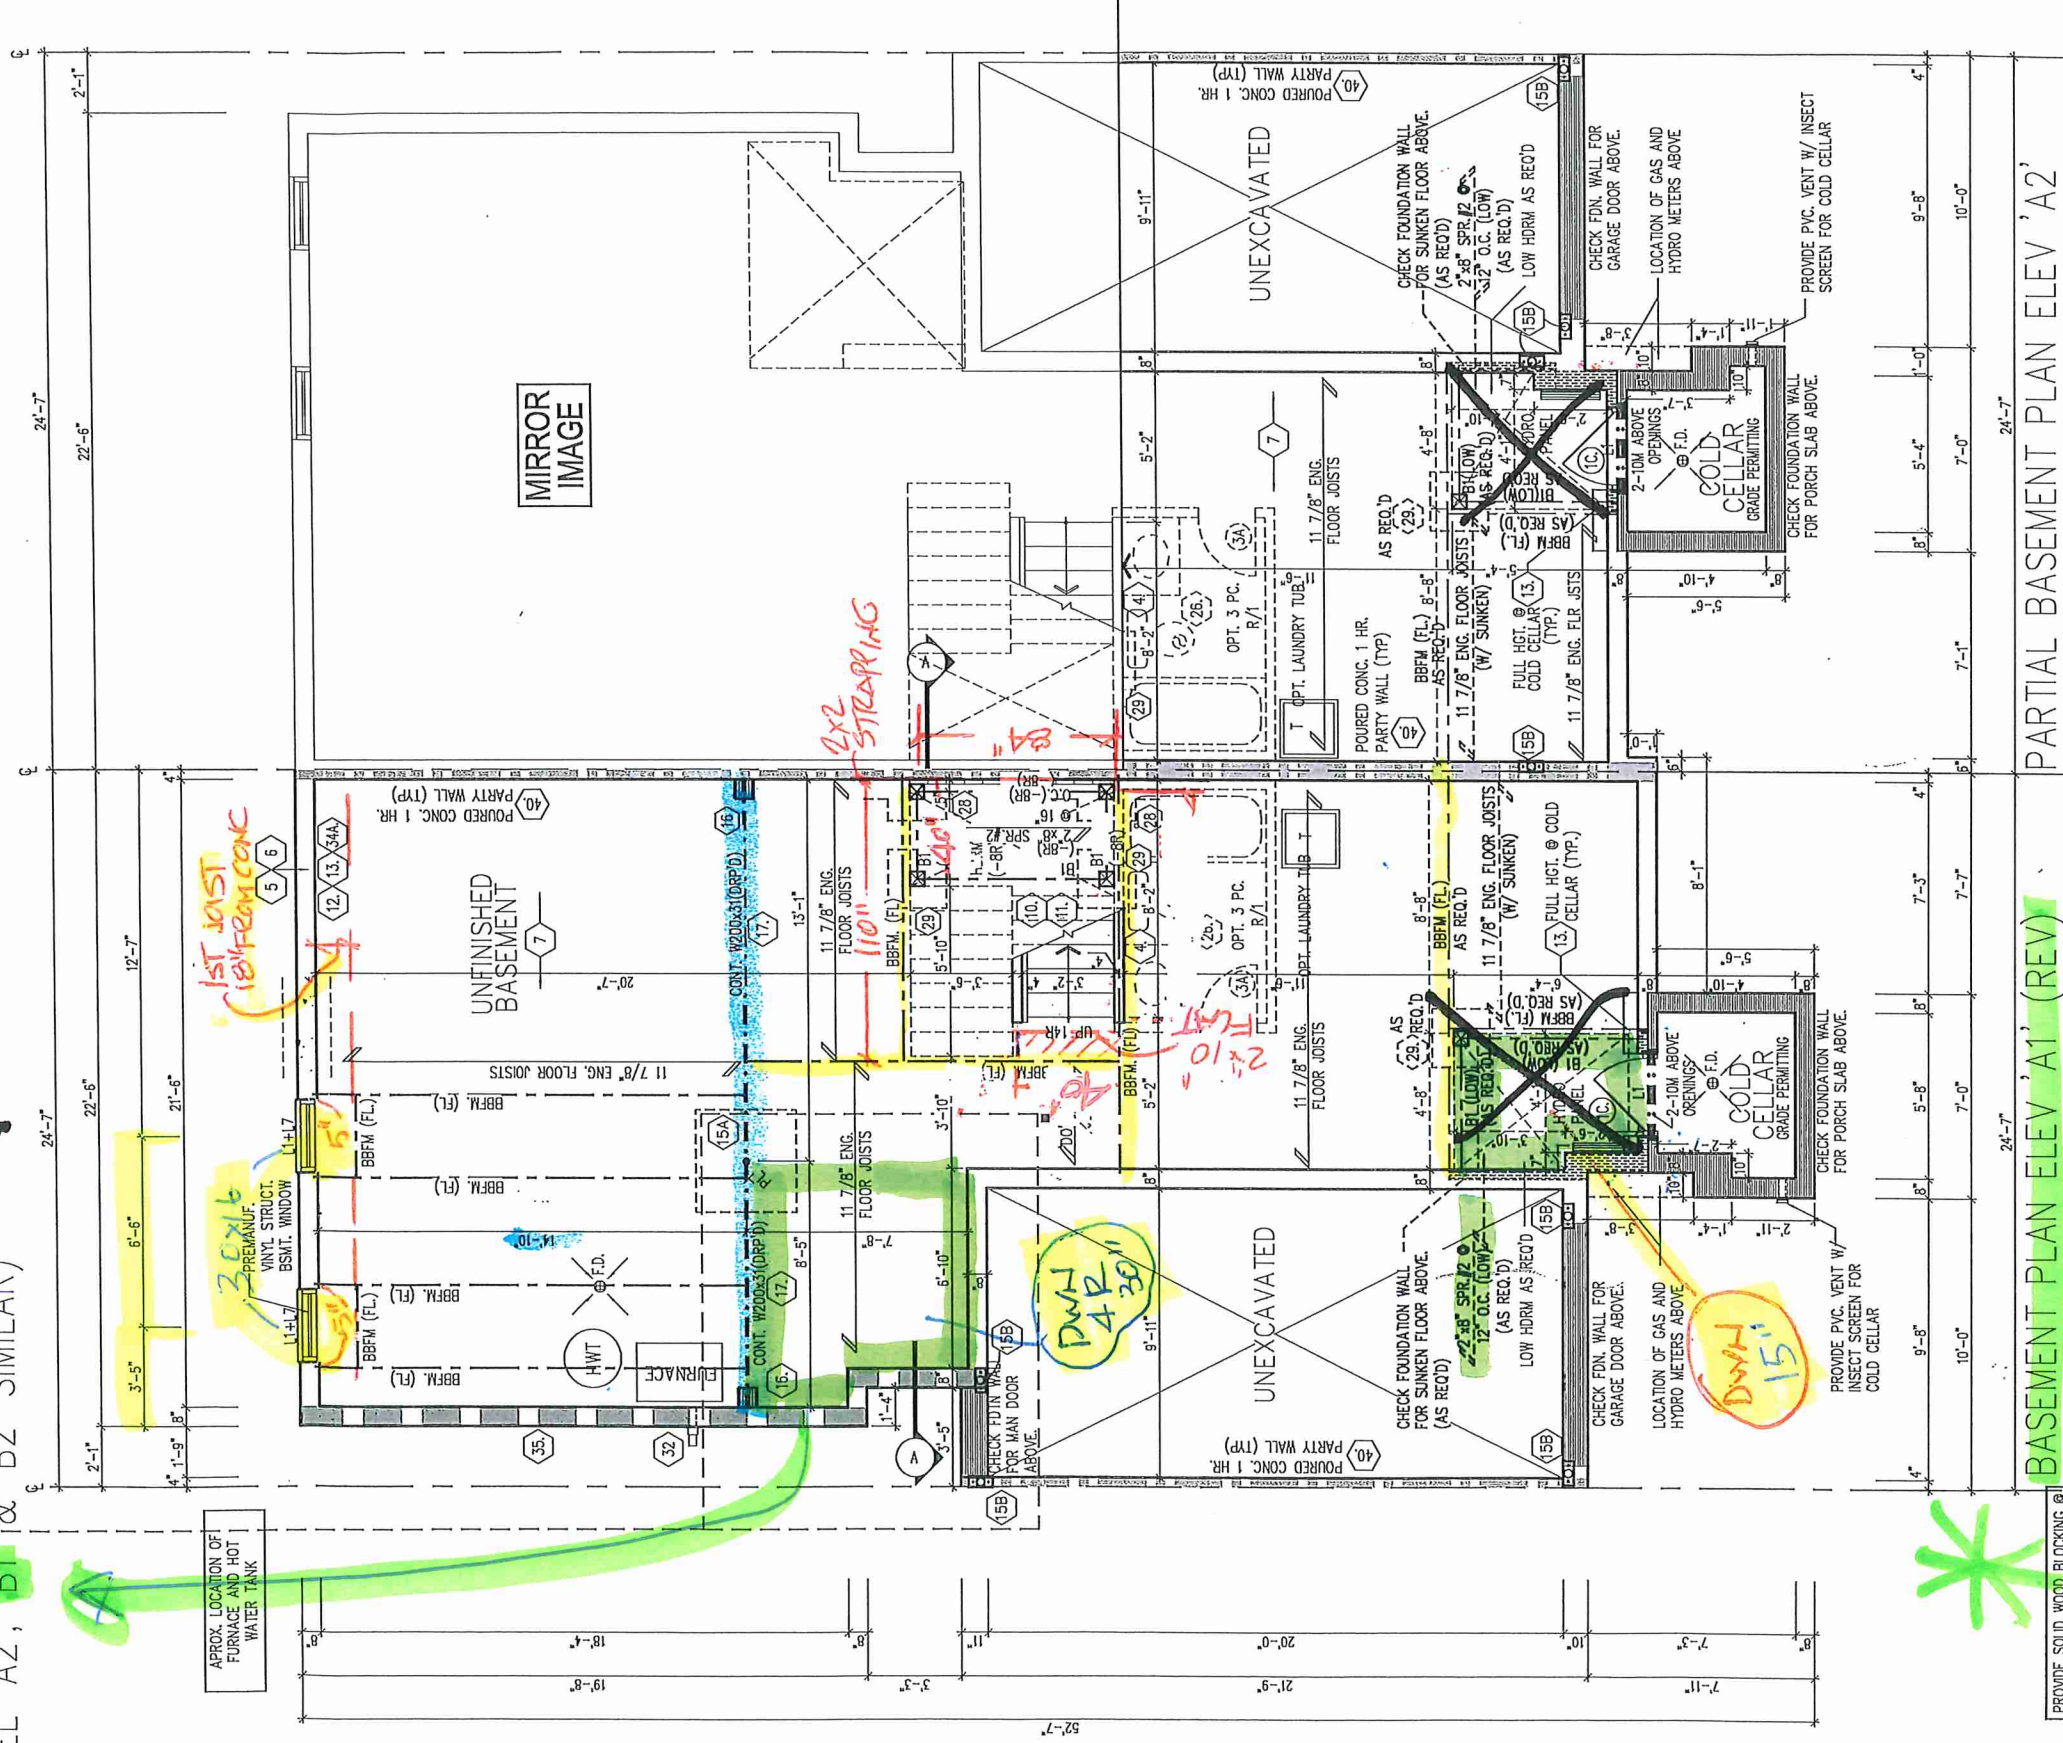

PROVIDE SOLID WOOD BLOCKING @
24\"/>

REFER TO FLOOR JOIST
MANUFACTURER'S DRAWINGS FOR
LAYOUT, SPACING, BLOCKING &
STRAPPING REQUIREMENTS,
INSTALLATION DETAILS AND
HANGER SIZES, & SUBFLOOR
THICKNESS

SPACE ALL FLOOR JOISTS @
12\"/>

* 2x6 PLATE RAMSET TOP
OF BEAM.
* CONFIRM BSMT WINDOWS
CORRECT LOCATION

BASEMENT PLAN ELEV 'A1' (REV)

PARTIAL BASEMENT PLAN ELEV 'A2'


BASEMENT PLAN ELEV 'A1' (REV) / 'A2'



Blk-291-14

Royal Pine Homes/Summer Ridge Estates Inc.-216051 UNIT-2501
"MAYFIELD VILLAGE", BRAMPTON, ON. REV.2024.03.14

Drawn By WD Checked By DS Scale 3/16"=1'-0"
216051WS2501
3550 Langstaff Road, Suite 200 Woodbridge, Ontario, L4L 9G3

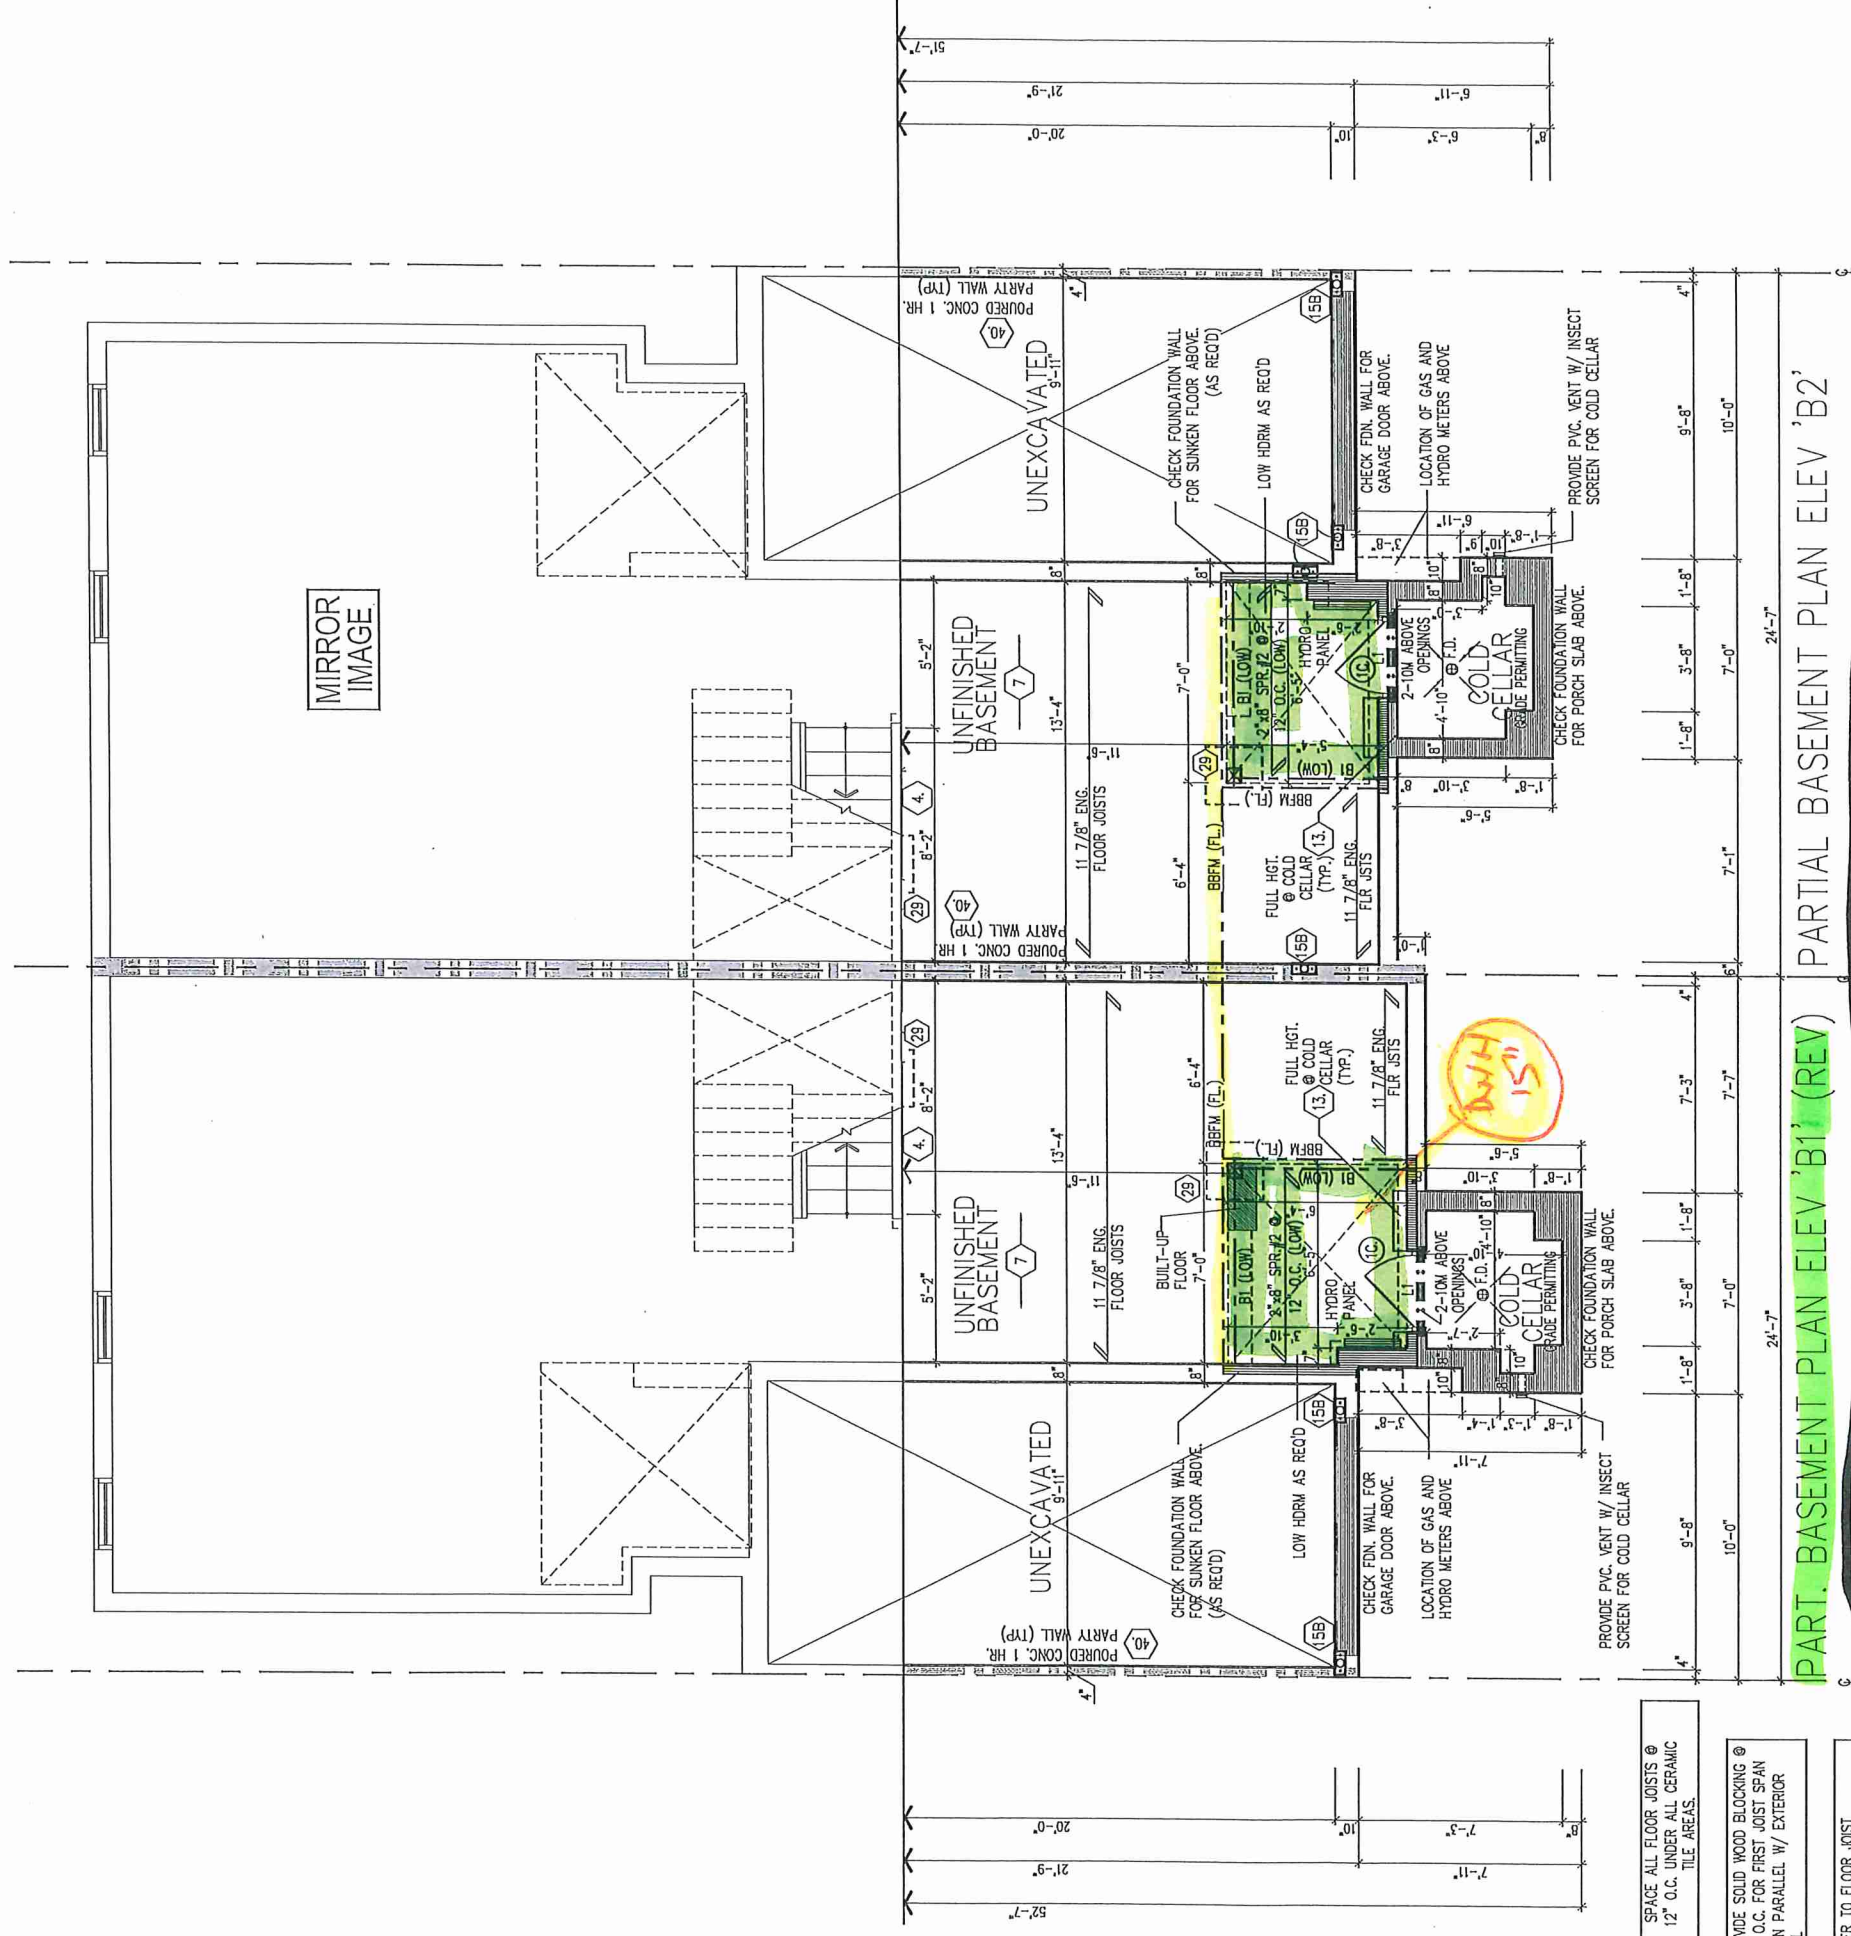

25-01 for BLK. 291 - TH. 14 & TH. 15
SUMMER RIDGE ESTATES INC. Mayfield - Brampton

SPACE ALL FLOOR JOISTS @
12" O.C. UNDER ALL CERAMIC
TILE AREAS.

PROVIDE SOLID WOOD BLOCKING @
24" O.C. FOR FIRST JOIST SPAN
WHEN PARALLEL W/ EXTERIOR
WALL

REFER TO FLOOR JOIST
MANUFACTURER'S DRAWINGS FOR
LAYOUT, SPACING, BLOCKING &
STRAPPING REQUIREMENTS,
INSTALLATION DETAILS AND
HANGER SIZES, & SUBFLOOR
THICKNESS

REFER TO STANDARD FLOOR PLAN FOR
COMPLETE CONSTRUCTION NOTES &
DIMENSIONS

25-01 for BLK. 291 - TH. 14 & TH. 15 PART. BASEMENT PLAN EL. 'B1' (REV.) / 'B2'

BUK-291-14




Royal Pine Homes/Summer Ridge Estates Inc.-216051 UNIT-2501
"MAYFIELD VILLAGE", BRAMPTON, ON. REV 2024.03.14

Drawn By	Checked By	Scale	File Number	Page Number
WD	DS	3/16"=1'-0"	216051WS2501	6a of 143

All drawings specifications related documents and design are the copyright property of Royal PINE Homes. Reproduction of this property in whole or in part is strictly prohibited without R.P.H. written permission. (R.P.H. assumes no responsibility or liability for this property unless it bears the appropriate BCIN number and original signature).

- S.D. WINDOWS 96"
- INT. DOORS 83"
- ARCHES 96"
- FRONT DOOR 95"

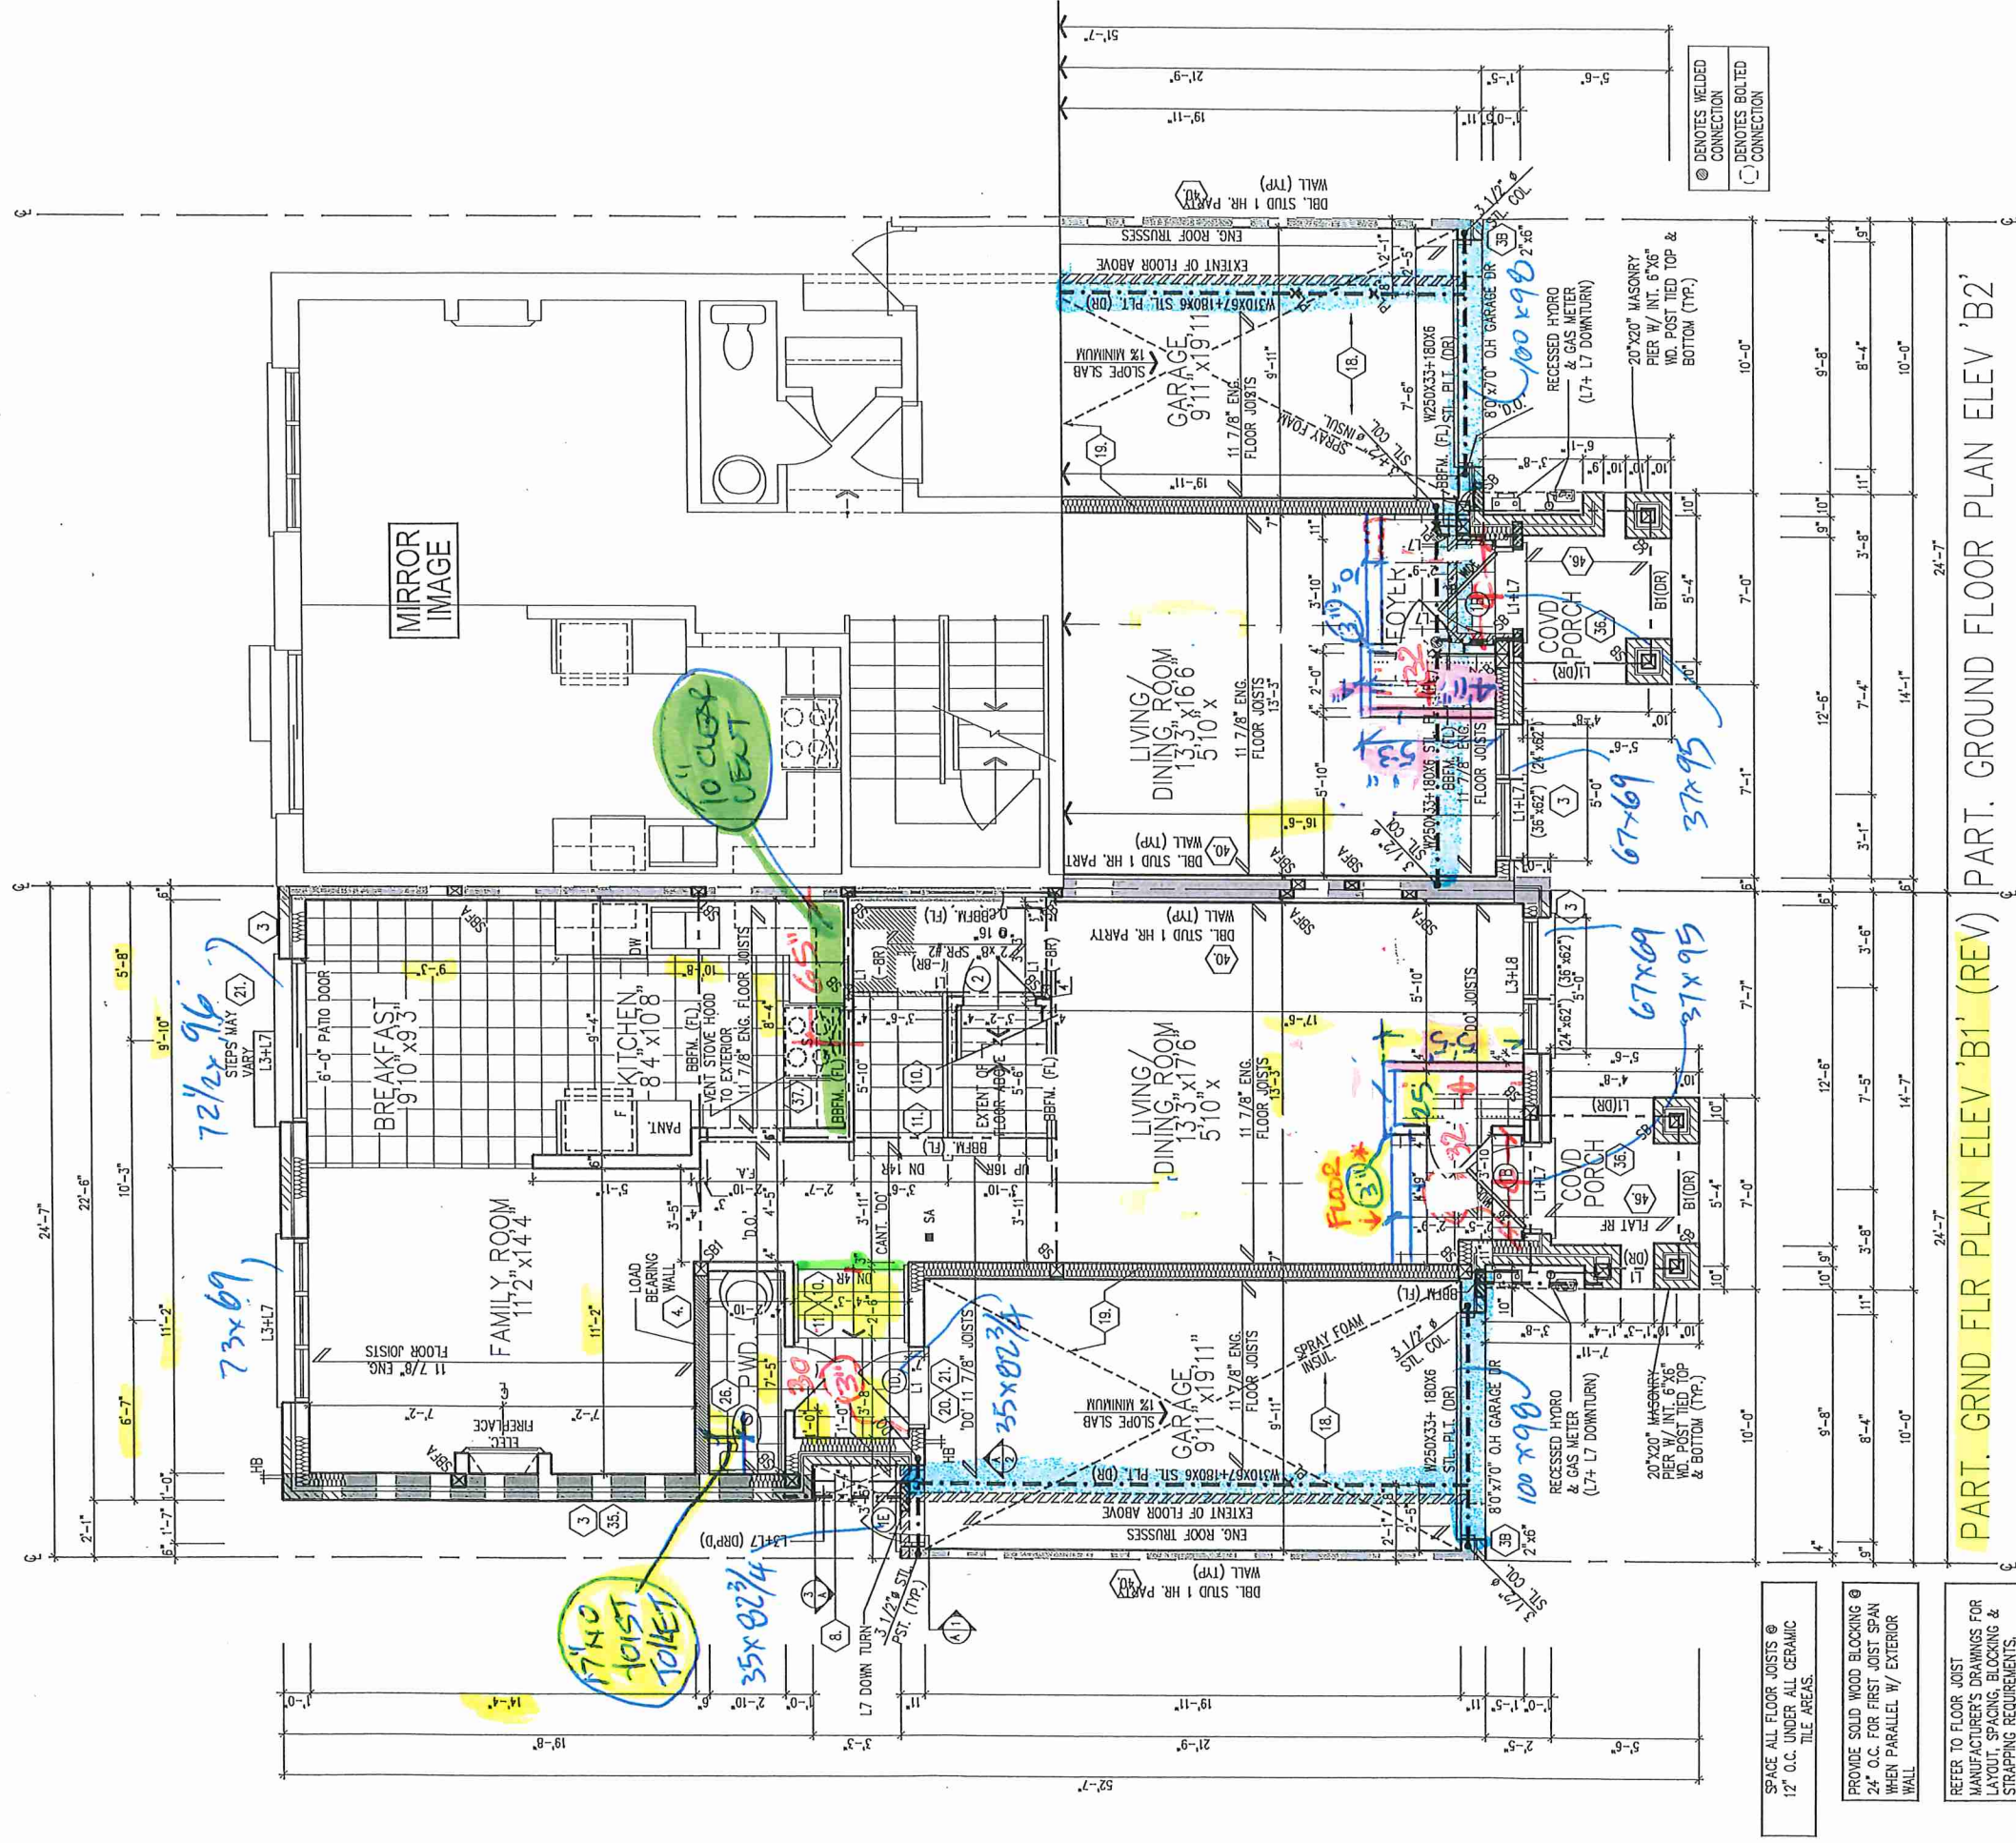

25-01 for BLK. 291 - TH. 14 & TH. 15
SUMMER RIDGE ESTATES INC. Mayfield - Brampton

BLK-291-14


25-01 for BLK. 291 - TH. 14 & TH. 15 PART. GRND. FLR. PLAN 'B1' (REV.) / 'B2'



Royal Pine Homes/Summer Ridge Estates Inc.-216051
"MAYFIELD VILLAGE", BRAMPTON, ON.
REV. 2024.03.14


Drawn By: WD
Checked By: DS
Scale: 3/16"=1'-0"
File Number: 216051WS2501
Page Number: 7a of 14

All drawings specifications related documents and design are the copyright property of Royal Pine Homes. Reproduction of this property in whole or in part is strictly prohibited without R.P.H. written permission (R.P.H. assumes no responsibility or liability for this property unless it bears the appropriate BCIN number and original signature.)

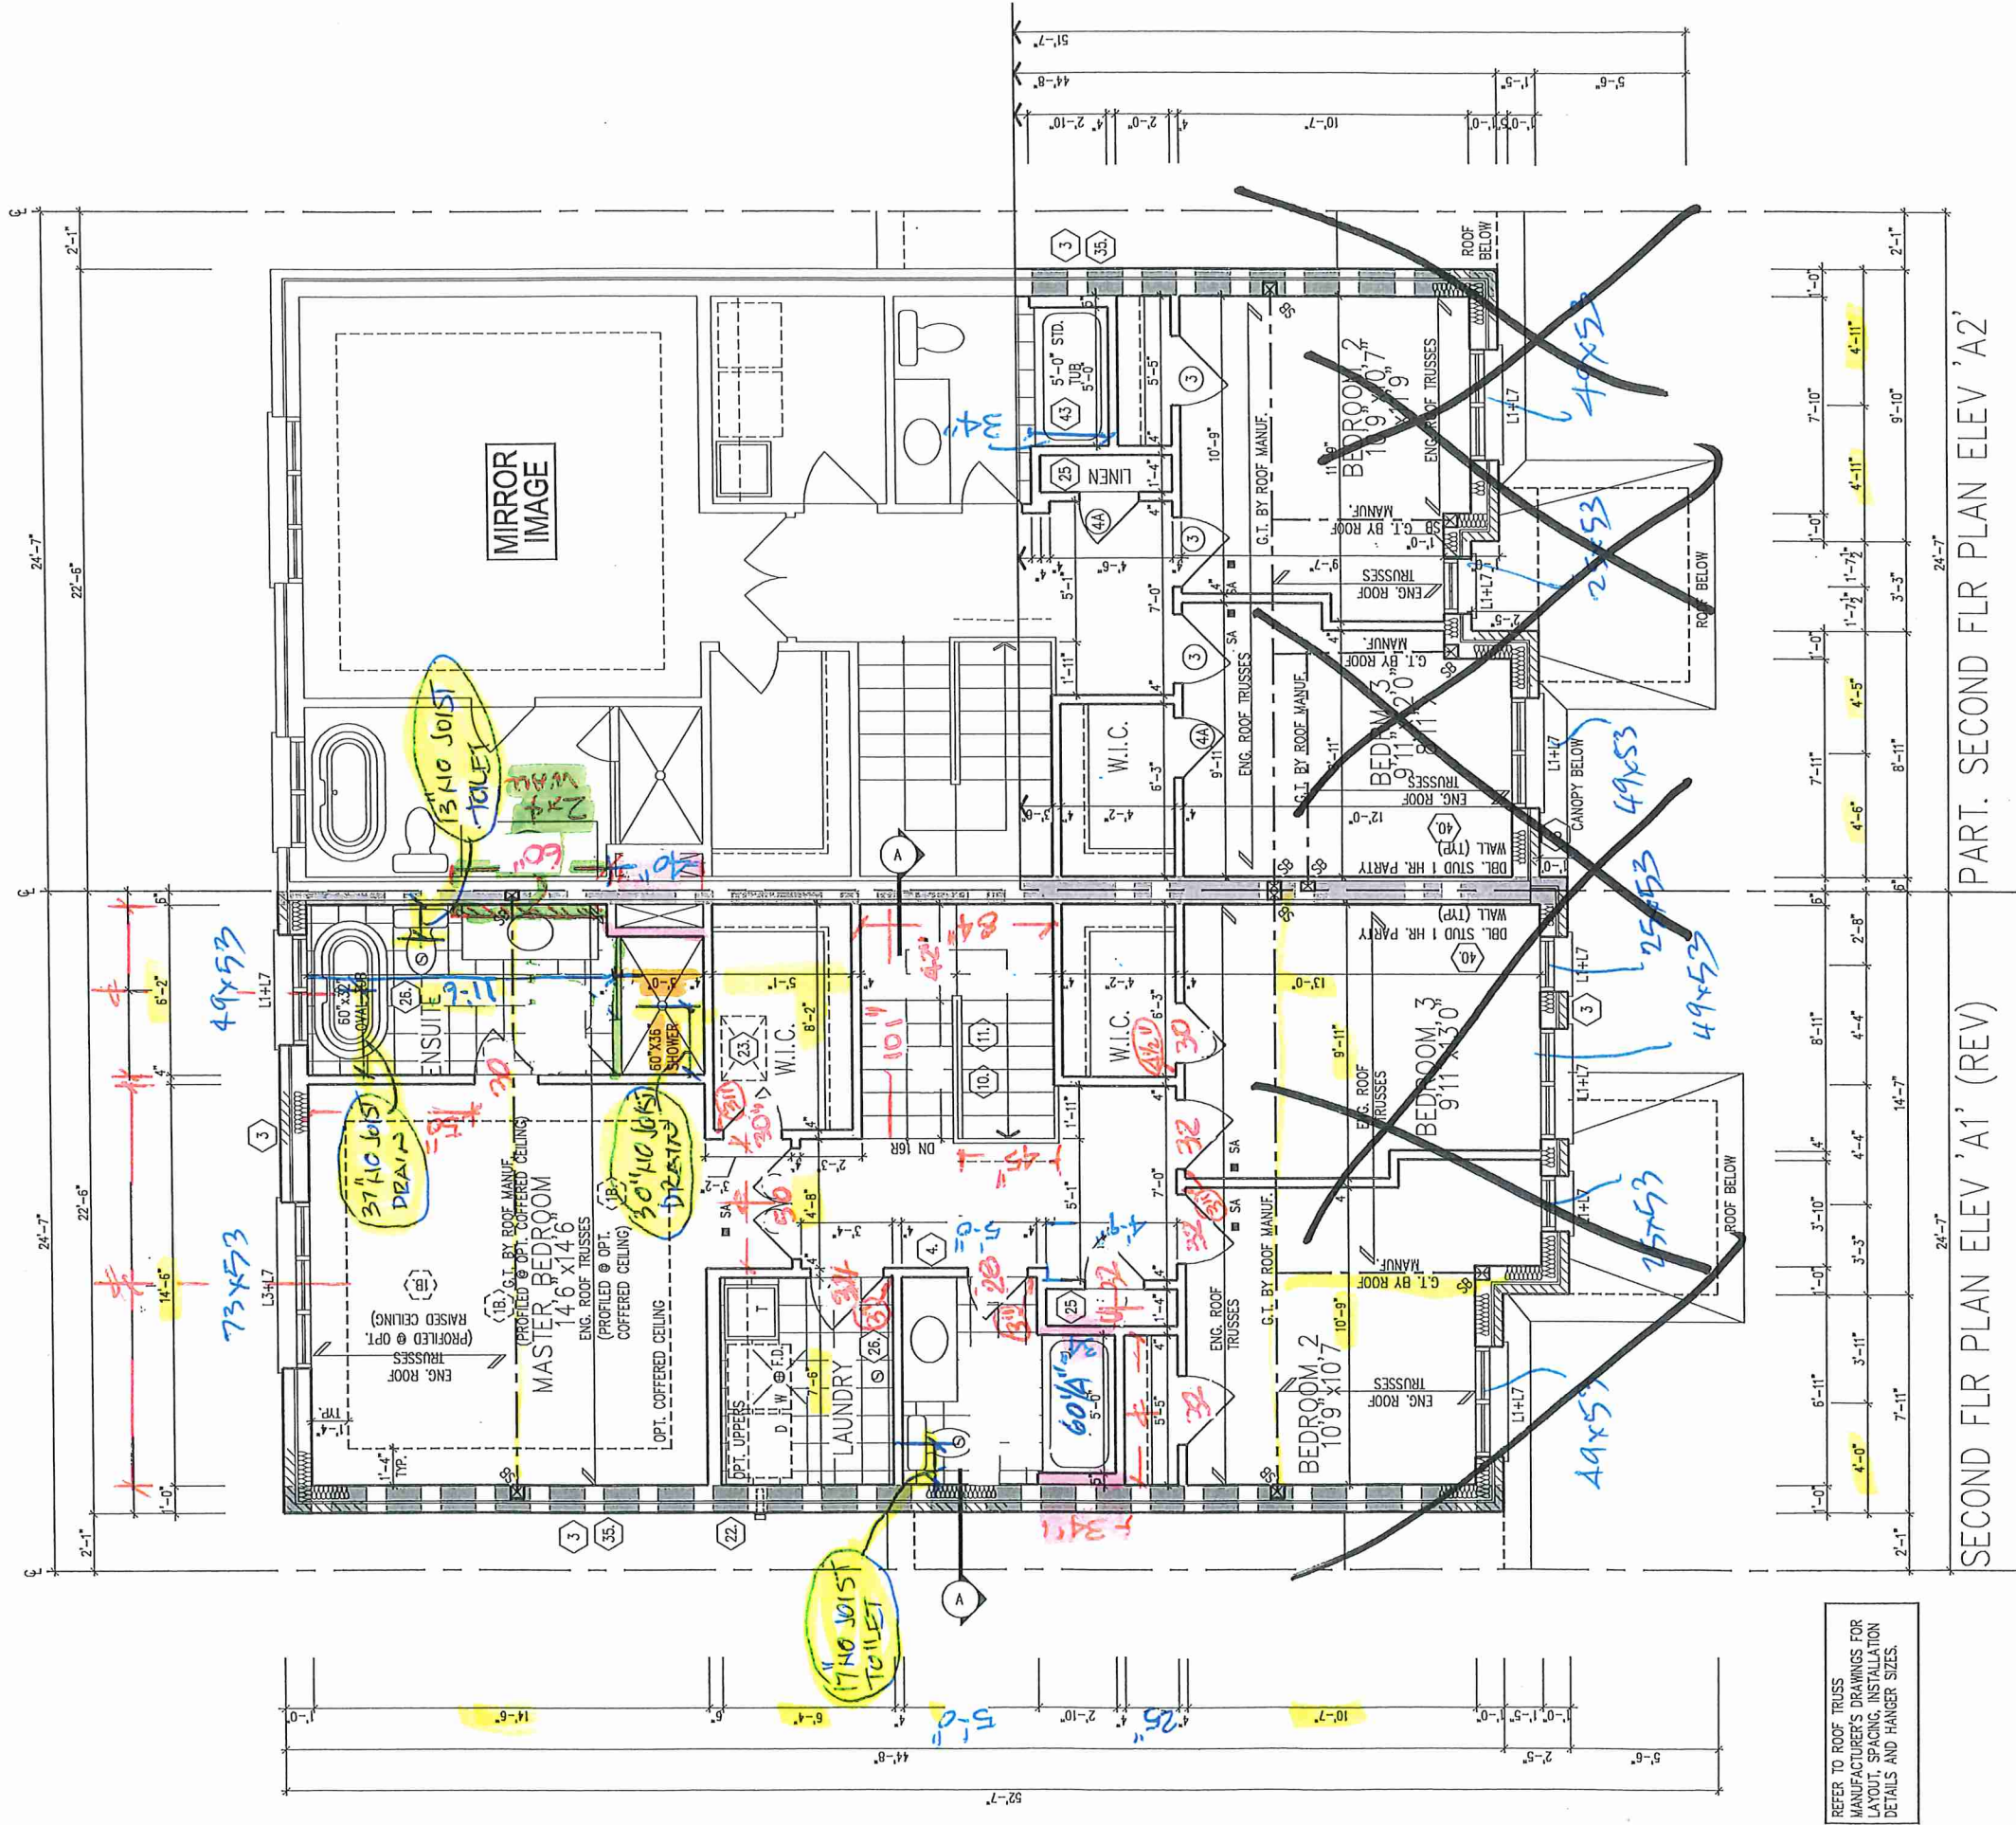

* 12" DOORS 83
* 2x4 L SHAPE BOTTOM 1
CORD CEILING EVERY 8
- WINDOWS SEE ELEV.

SB: MIN. 2/ 2"x6" SPF OR 3/ 2"x4" SPF
SB1: MIN. 3/ 2"x6" SPF OR 4/ 2"x4" SPF
SB2: MIN. 4/ 2"x6" SFE OR 5/ 2"x4" SPF

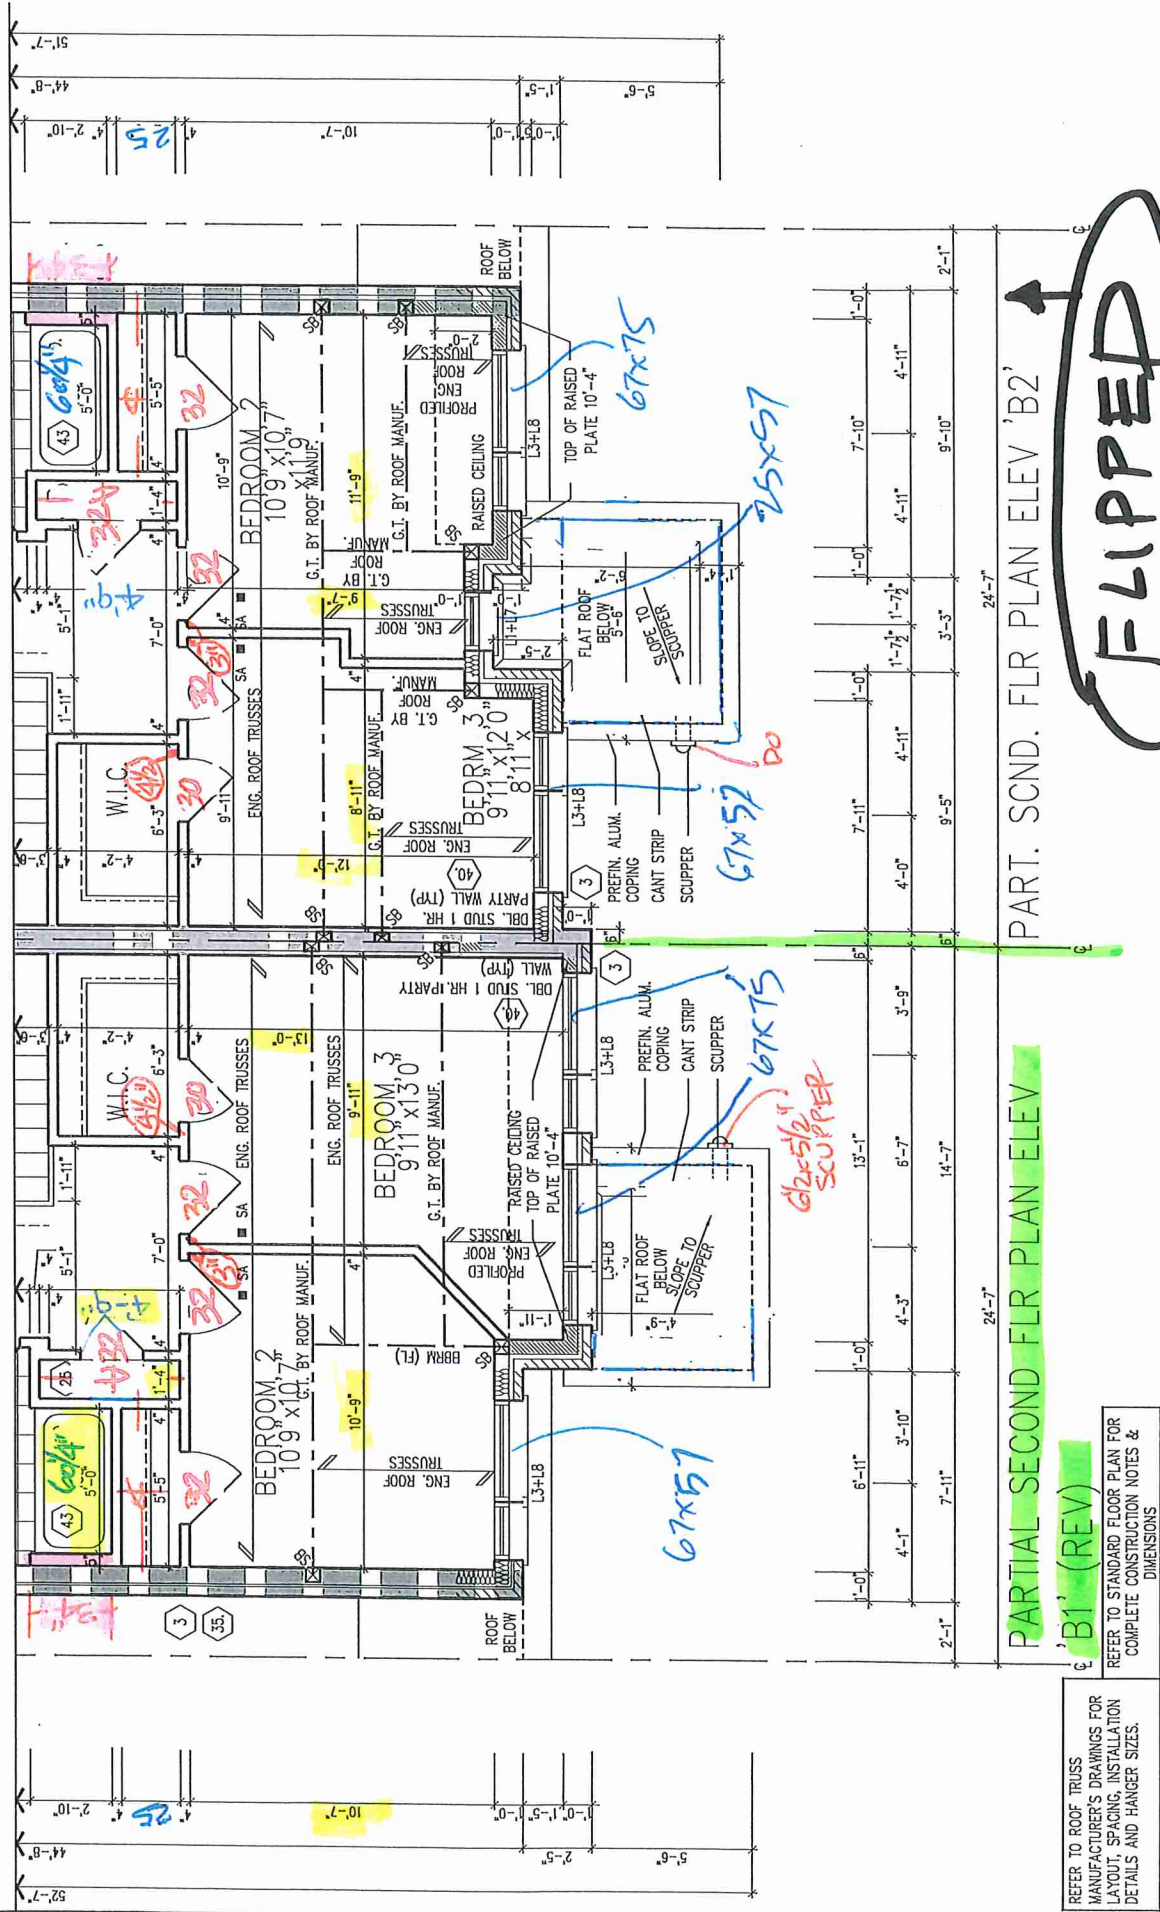


TH #14

SB: MIN. 2/ 2"x6" SPF OR 3/ 2"x4" SPF
SBI: MIN. 3/ 2"x6" SPF OR 4/ 2"x4" SPF
SB2: MIN. 4/ 2"x6" SFE OR 5/ 2"x4" SFE

REFER TO ROOF TRUSS MANUFACTURER'S DRAWINGS FOR LAYOUT, SPACING, INSTALLATION DETAILS AND HANGER SIZES.	6' B1' (REV)	REFER TO STANDARD FLOOR PLAN FOR COMPLETE CONSTRUCTION NOTES & DIMENSIONS
---	--------------	---



BK-291-14

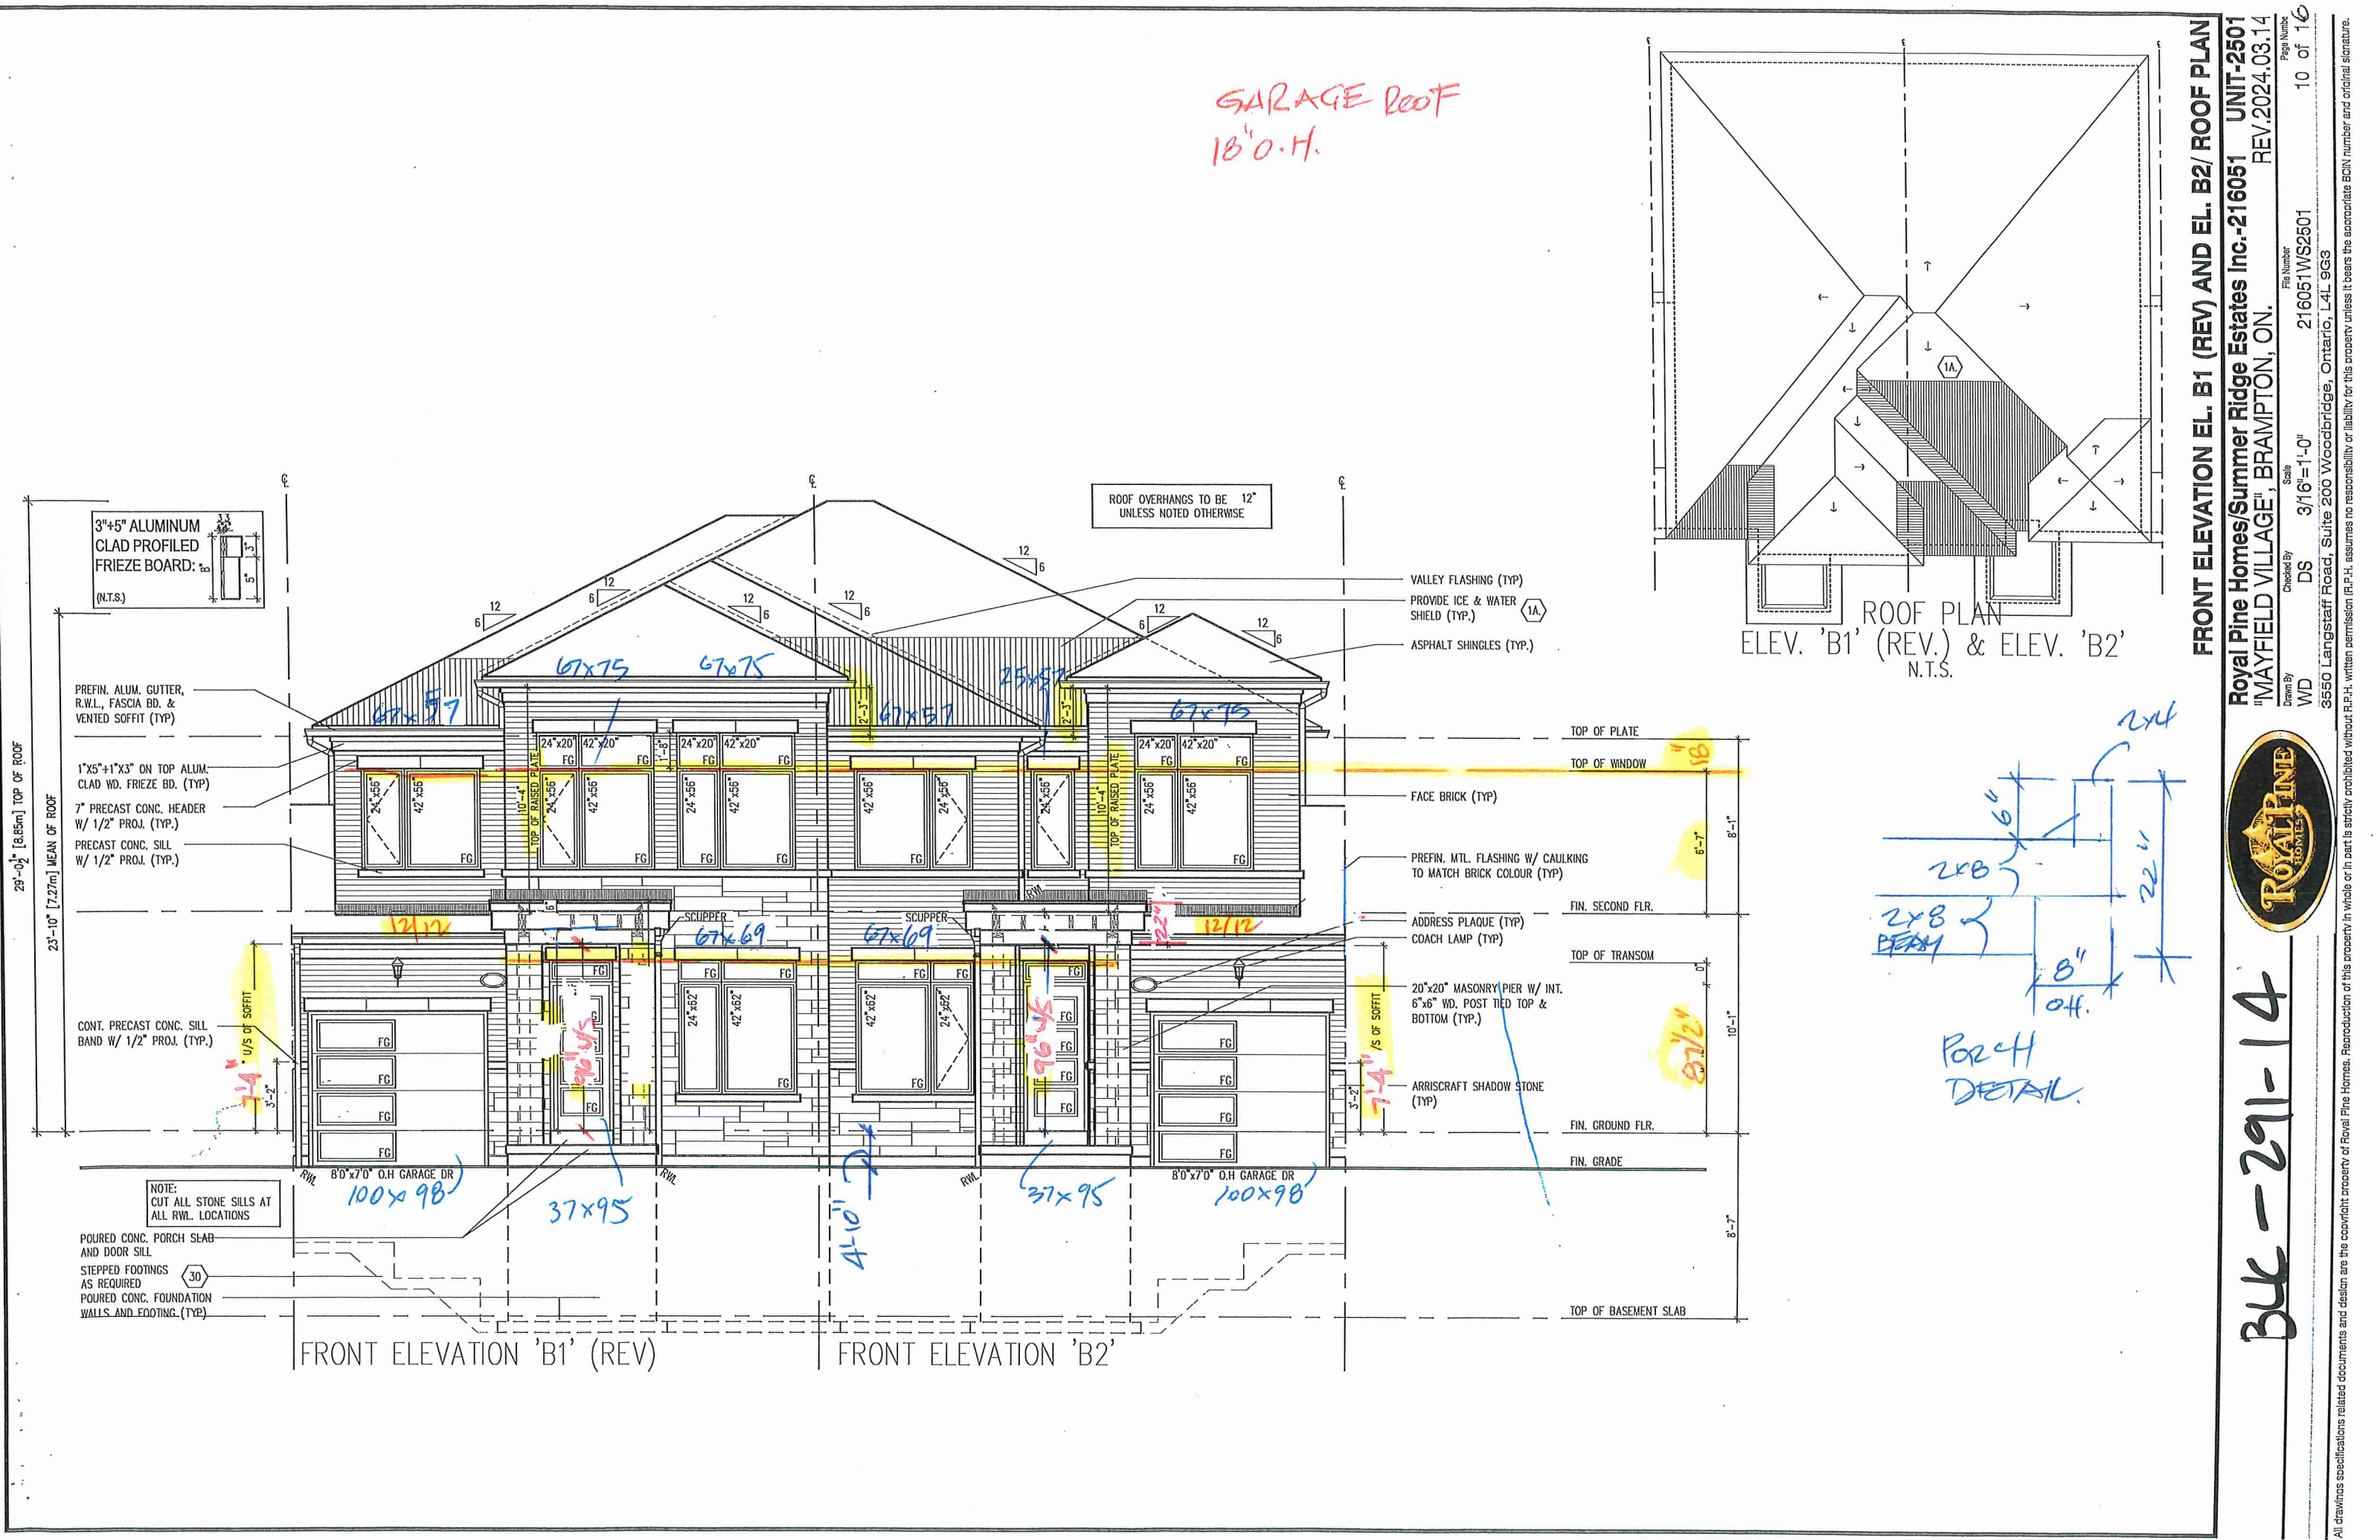


GARAGE ROOF
18" O.H.

ROOF OVERHANGS TO BE 12"
UNLESS NOTED OTHERWISE

VALLEY FLASHING (TYP.)
PROVIDE ICE & WATER
SHIELD (TYP.)
ASPHALT SHINGLES (TYP.)

ROOF PLAN
ELEV. 'B1' (REV.) & ELEV. 'B2'
N.T.S.

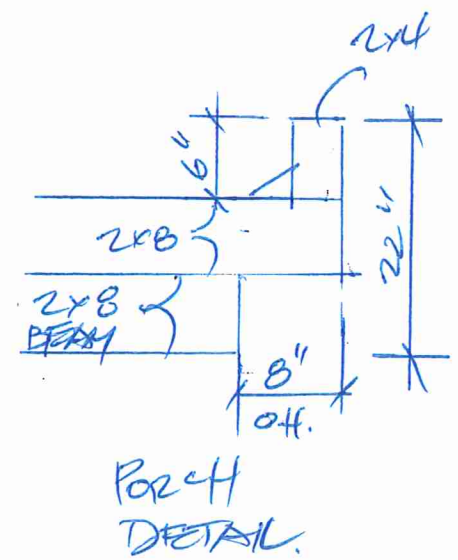

FRONT ELEVATION EL. B1 (REV) AND EL. B2/ ROOF PLAN

Royal Pine Homes/Summer Ridge Estates Inc.-216051 UNIT-2501
"MAYFIELD VILLAGE", BRAMPTON, ON.
REV. 2024.03.14


Drawn By: WD
Checked By: DS
Scale: 3/16"=1'-0"
File Number: 216051WS2501
Page Number: 10 of 16



344-291-14


All drawings specifications related documents and design are the copyright property of Royal Pine Homes. Reproduction of this property in whole or in part is strictly prohibited without R.P.H. written permission (R.P.H. assumes no responsibility or liability for this property unless it bears the appropriate BCIN number and original signature).



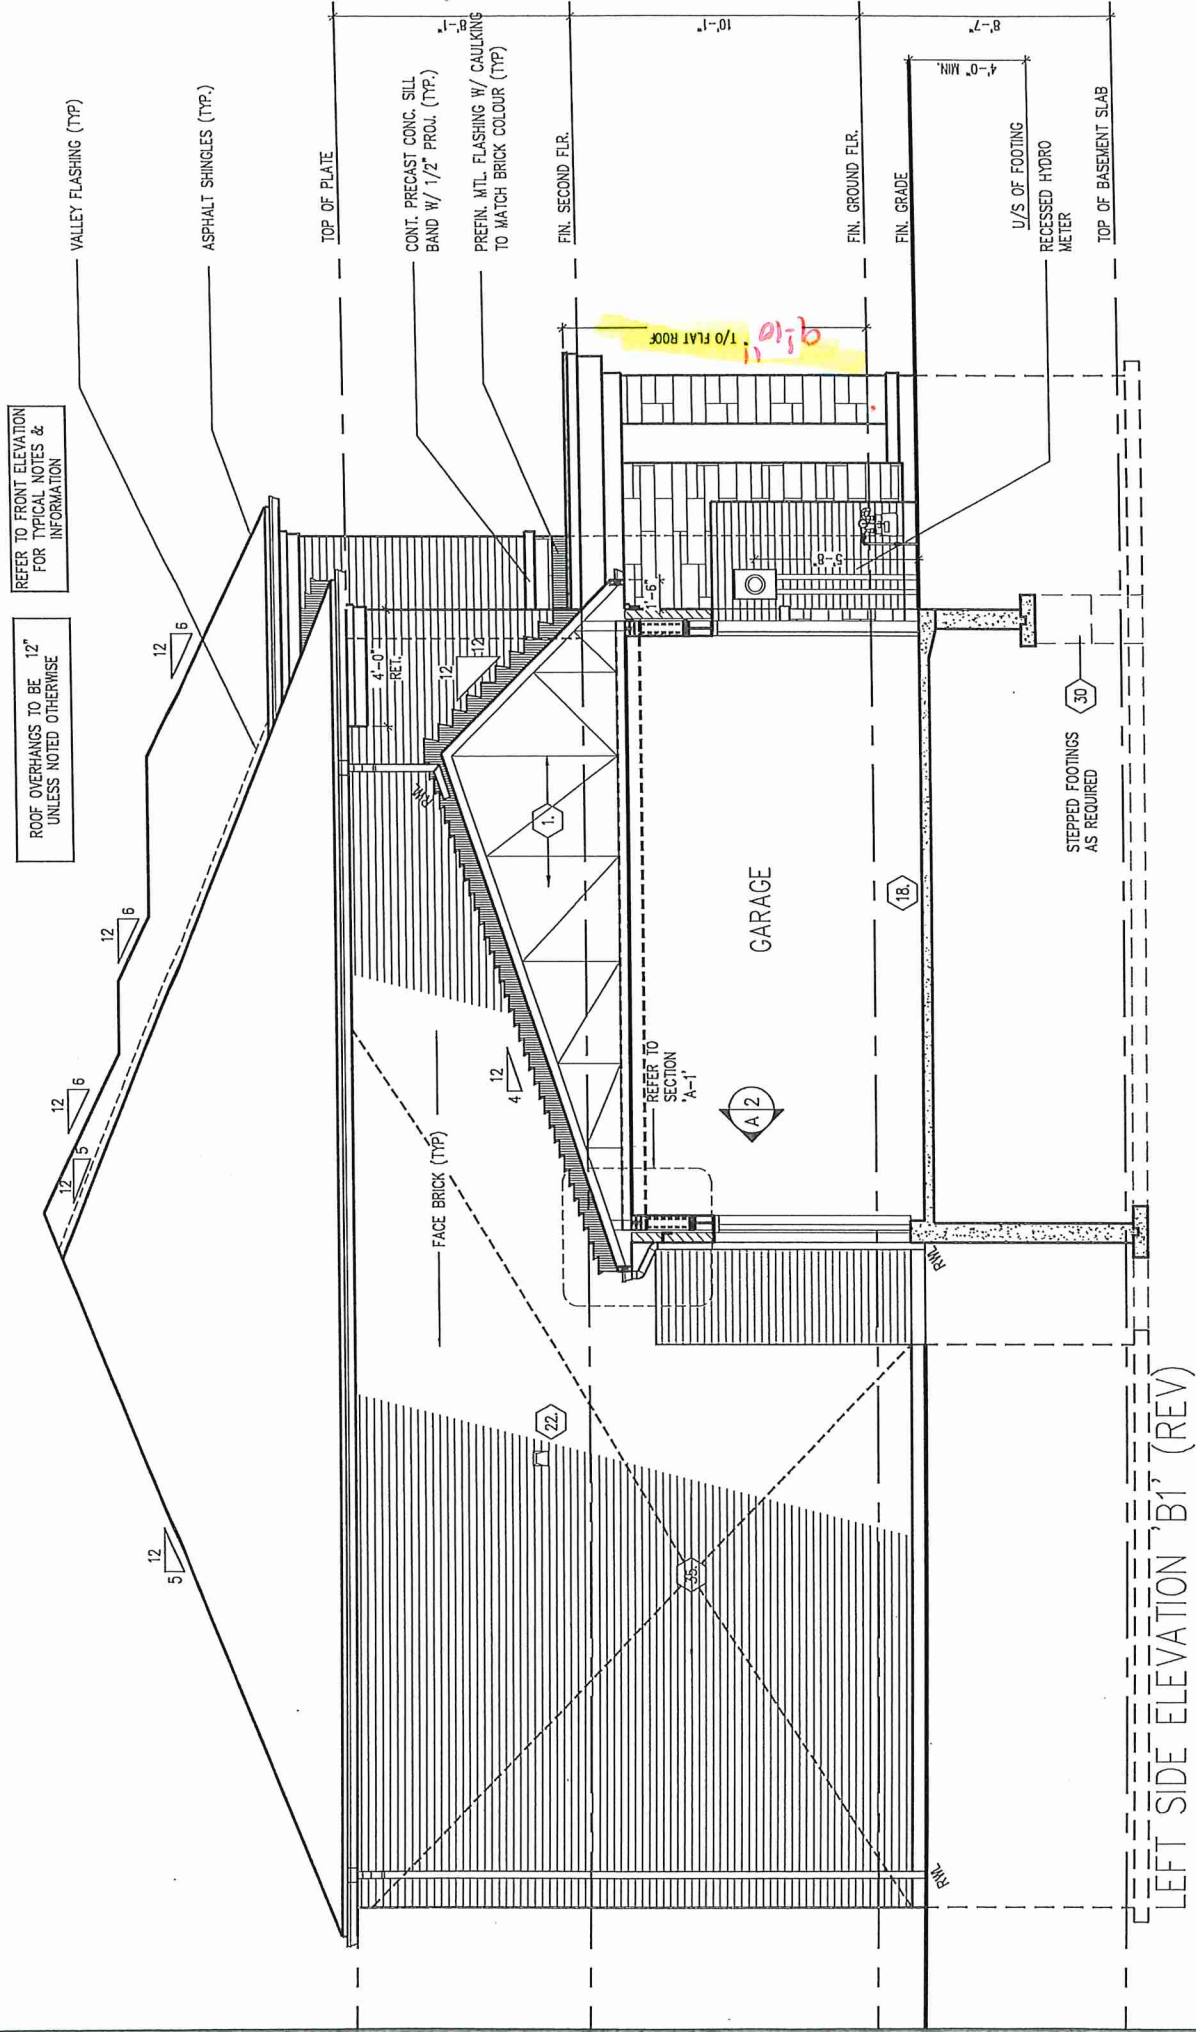

REFER TO FRONT ELEVATION
FOR TYPICAL NOTES &
INFORMATION

ROOF OVERHANGS TO BE 12"
UNLESS NOTED OTHERWISE

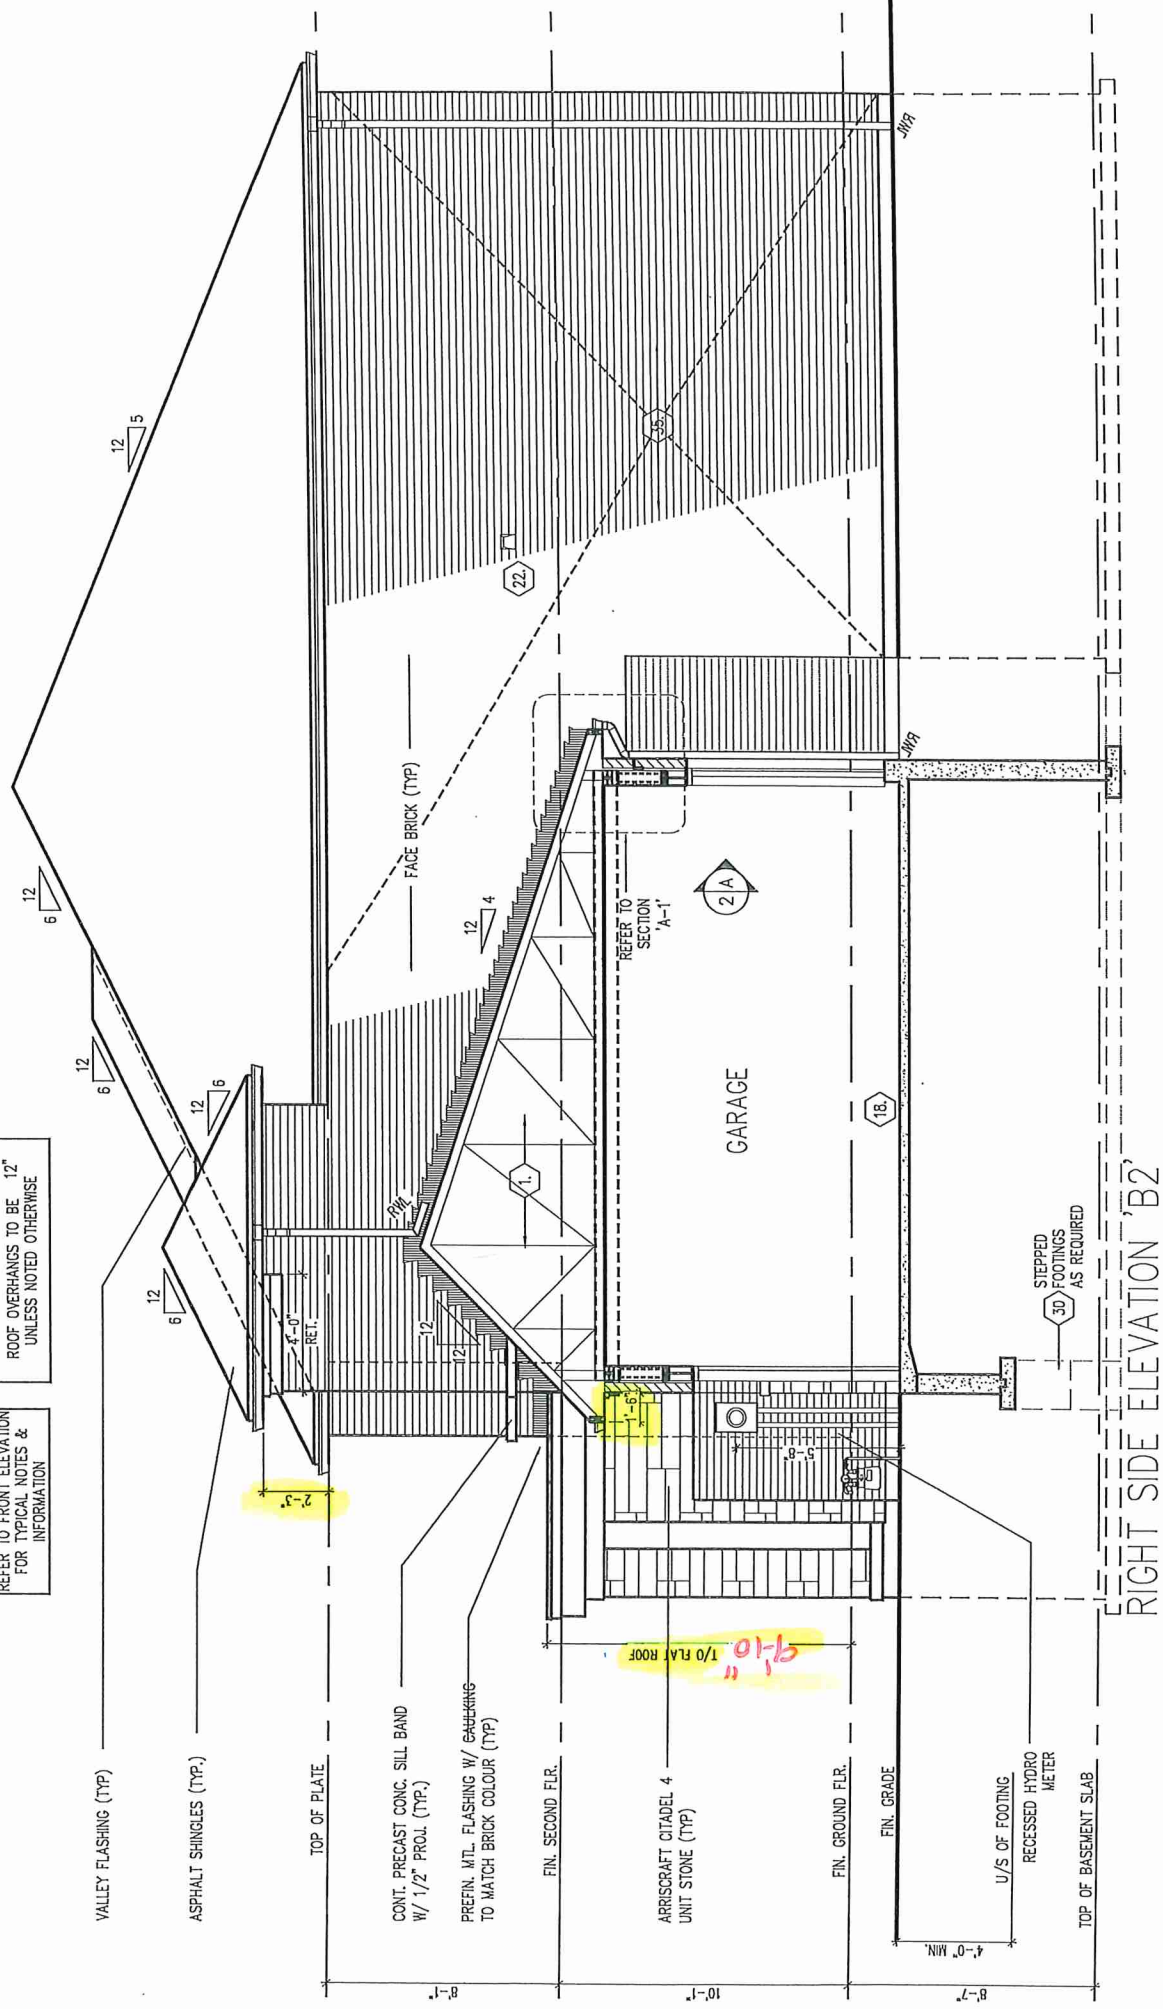


BLK-291-14



Royal Pine Homes/Summer Ridge Estates Inc.-216051 UNIT-2501
"MAYFIELD VILLAGE", BRAMPTON, ON.
REV.2024.03.14

Drawn By: WD
Checked By: DS
Scale: 3/16"=1'-0"
File Number: 216051WS2501
Page Number: 13 of 16

All drawings specifications related documents and design are the copyright property of Royal Pine Homes. Reproduction of this property in whole or in part is strictly prohibited without R.P.H. written permission (R.P.H. assumes no responsibility or liability for this property unless it bears the appropriate BCIN number and original signature.

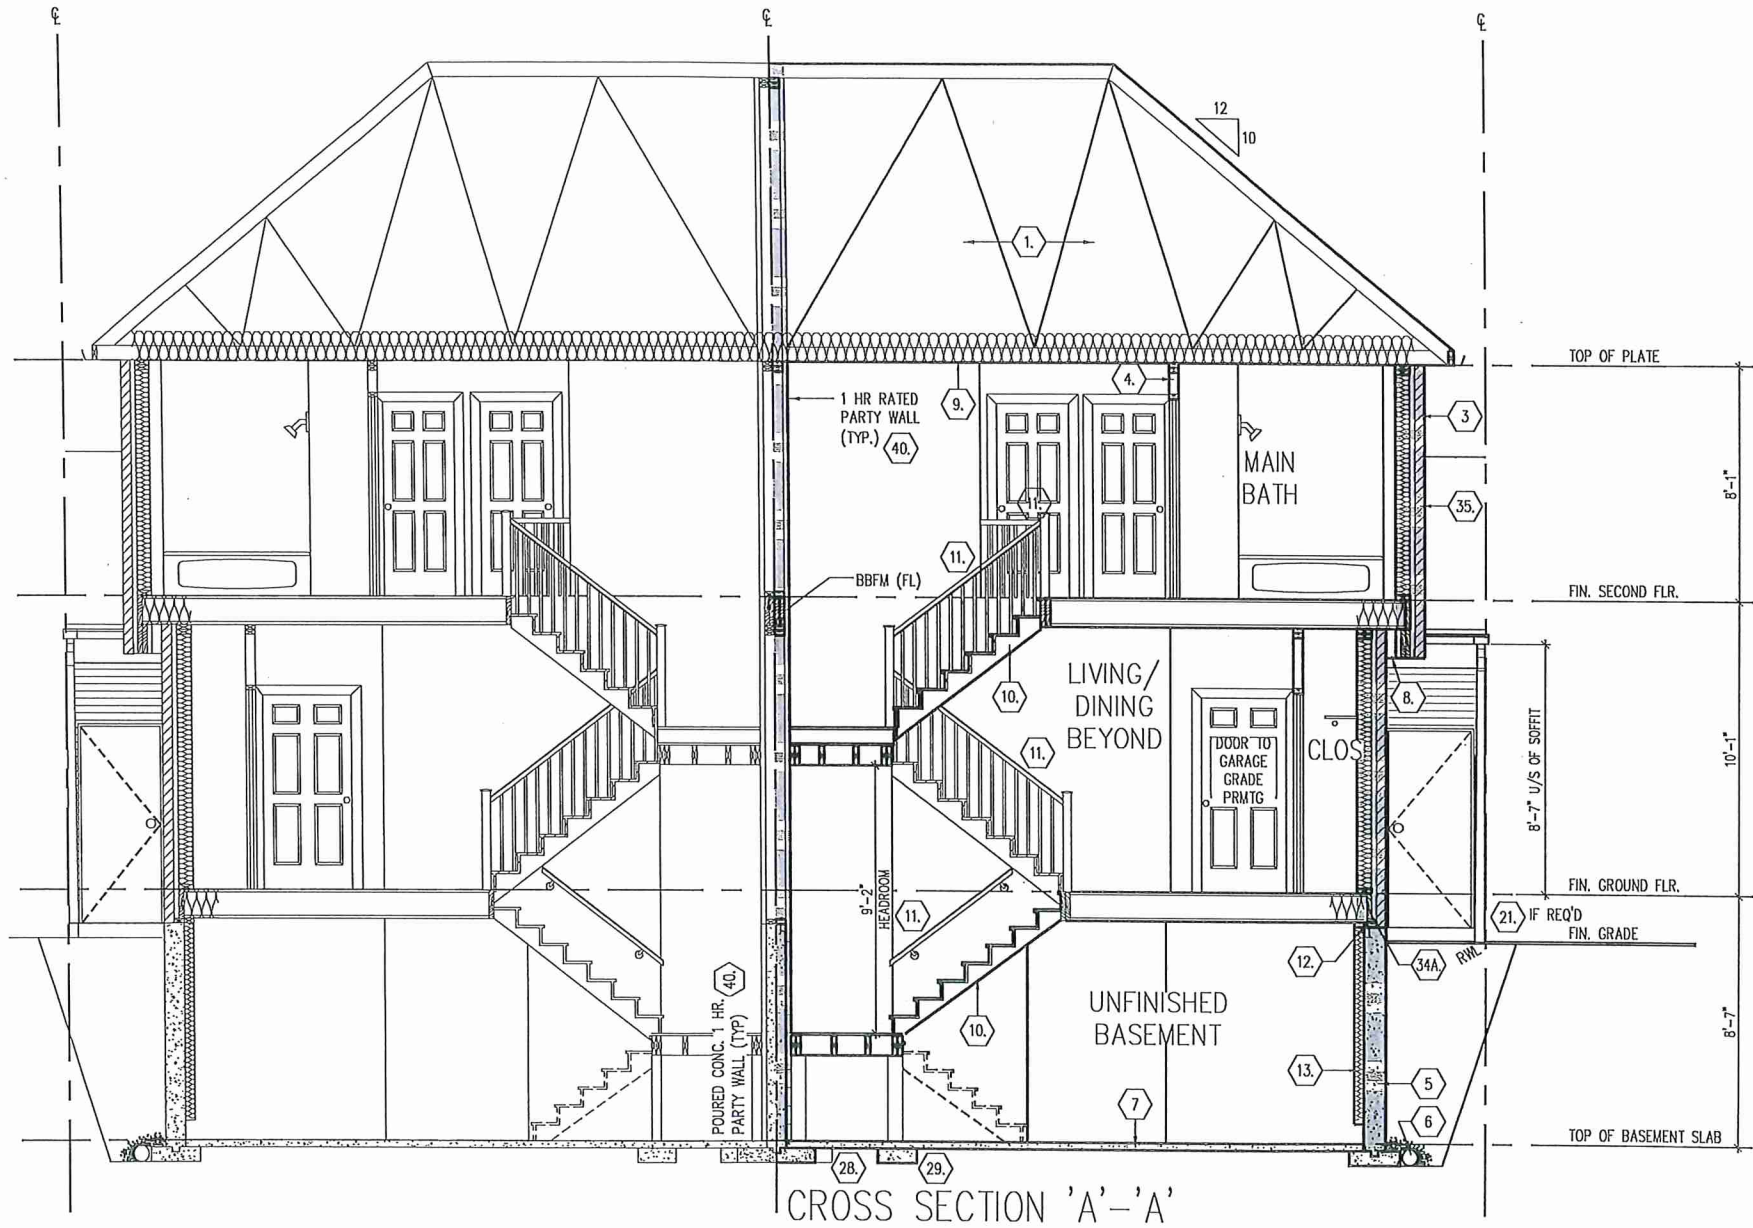

CROSS SECTION 'A'-A'

Royal Pine Homes/Summer Ridge Estates Inc.-216051 UNIT-2501
 "MAYFIELD VILLAGE", BRAMPTON, ON.
 REV.2024.03.14



BK-291-14

Drawn By: WD
 Checked By: DS
 Scale: 3/16"=1'-0"
 File Number: 216051WS2501
 Page Number: 14 of 16

SECTION 1.0. CONSTRUCTION NOTES

- 1

ROOF CONSTRUCTION (9.19, 9.23.13, 9.23.15.)
NO. 210 (10.25 KG/M2) ASPHALT SHINGLES @ 24" (610) O.C. MAX. APPROVED
WITH "H" CLIPS. APPROVED WOOD TRUSSES @ 24" (610) O.C. MAX. FASTENED
EAVES PROTECTION TO EXTEND 2'-11" (600) FROM EDGE OF ROOF AND MIN.
12" (305) BEDDING UNDER EAVE OF EXTERIOR WALL. 2x4# (38x89) TRUSS
BRACING @ 8'-0" (1800) O.C. AT BOTTOM JOIST. PREFIN. ALUM.
EAVESTRUGH, FASCIA, RVL & VENTED SOFT. ATTIC VENTILATION 1:300 OF
INSULATED CEILING AREA WITH MIN. 25% OF REQUIRED OPENINGS LOCATED AT
ATTOP OF SPACE & MIN. 25% OF REQUIRED OPENINGS LOCATED AT BOTTOM
OF SPACE. EAVESTRUGH TO BE 4" MIN. WITH RVL DISCHARGING ONTO
CONCRETE SPLASH PADS OR PER MUNICIPAL REQUIREMENTS. TOWNHOUSES
TO HAVE 5" MIN. EAVESTRUGH WITH ELEC. TRACED HEATER CABLE ALONG
EAVESTRUGH AND DOWN RVL.
- 1A

ICE AND WATER SHIELD
PROVIDE ICE AND WATER SHIELD IN THE AREAS INDICATED. THE ICE AND WATER
SHIELD SHALL BE A SELF ADHERING AND SELF SEALING MEMBRANE. SIDE LAPS
MUST BE A MINIMUM 3 1/2" (90) AND END LAPS A MINIMUM 6" (152). AND TO
EXTEND UP DORMER WALLS A MINIMUM 12" (305).

- 1B

PROFILED ROOF TRUSSES
ROOF TRUSSES SHALL BE PROFILED AND/OR STEPPED AT RAISED COFFERTRAY
CEILINGS. ANGLED TRAY CEILINGS WILL BE SHEATHED W/ 3/8" (9.5) PLYWOOD.

- 2

SIDING WALL CONSTRUCTION (2x6#)
SIDING MATERIAL AS PER ELEVATION ATTACHED TO FRAMING MEMBERS.
FURRING MEMBERS OR BLOCKING BETWEEN THE FRAMING MEMBERS ON
APPROVED SHEATHING PAPER ON 3/8" (9.5) EXT. GRADE SHEATHING ON STUDS
CONFORMING TO O.B.C (9.23.10.1.) & SECTION 1.1. INSULATION, APPROVED 6 MIL
POLYETHYLENE ARJAPOLAR BARRIER, ON 1/2" (12.7) GYPSUM WALLBOARD INT. FIN.
(GYPSUM SHEATHING, RIGID INSULATION, AND FIBERBOARD SHALL NOT BE USED
FOR THE ATTACHMENT OF SIDING (9.23.16.3.1.1)) (REFER TO 35 NOTE AS REQ.)

- 2A

SIDING WALL CONSTRUCTION (2x6#) W/ CONTIN. INSULATION
SIDING MATERIAL AS PER ELEVATION ATTACHED TO FURRING MEMBERS ON
APPROVED ARJWATER BARRIER AS PER O.B.C. 9.27.3. ON EXTERIOR TYPE RIGID
INSULATION (JOINTS UNTAPED) MECHANICALLY FASTENED AS PER
MANUFACTURERS SPECIFICATIONS ON 3/8" (9.5) EXT. GRADE SHEATHING ON
STUDS CONFORMING TO O.B.C (9.23.10.1.) & SECTION 1.1. INSULATION, APPROVED
6 MIL POLYETHYLENE ARJAPOLAR BARRIER, ON 1/2" (12.7) GYPSUM WALLBOARD
INT. FIN. (GYPSUM SHEATHING, RIGID INSULATION, AND FIBERBOARD SHALL NOT BE
USED FOR THE ATTACHMENT OF SIDING (9.23.16.3.1.1)) (REFER TO 35 NOTE AS REQ.)

- 2B

SIDING WALL @ GARAGE CONSTRUCTION
SIDING MATERIAL AS PER ELEVATION ATTACHED TO FRAMING MEMBERS.
FURRING MEMBERS OR BLOCKING BETWEEN THE FRAMING MEMBERS ON
APPROVED SHEATHING PAPER ON 3/8" (9.5) EXTERIOR TYPE SHEATHING ON
STUDS CONFORMING TO O.B.C (9.23.10.1.) & SECTION 1.1. 1/2" (12.7) GYPSUM
WALLBOARD INTERIOR FINISH. (GYPSUM SHEATHING, RIGID INSULATION AND
FIBERBOARD SHALL NOT BE USED FOR THE ATTACHMENT OF SIDING
(9.23.16.3.1.1)) (REFER TO 35 NOTE AS REQ.)

- 3

BRICK VENEER WALL CONSTRUCTION (2x6#)
3 1/2" (90) BRICK VENEER 1" (25) AIR SPACE. 7/8"x7'-0.03" (22x180x0.76) GALV. METAL
TIES @ 16" (400) O.C. HORIZ. 2x4" (600) O.C. VERT. BONDING AND FASTENING FOR
TIES TO CONFORM WITH 9.20.9. ON APPROVED SHEATHING PAPER. 3/8" (9.5) EXTERIOR TYPE
SHEATHING. STUDS CONFORMING TO O.B.C (9.23.10.1.) & SECTION 1.1. INSULATION
AND 6 MIL POLYETHYLENE VAPOUR BARRIER WITH APPROVED CONTIN. AIR BARRIER.
1/2" (12.7) GYPSUM WALLBOARD INTERIOR FINISH. PROVIDE WEEP HOLES @ 32" (800) O.C.
BOTTOM COURSE AND OVER OPENINGS. PROVIDE BASE FLASHING UP MIN. 6" (152)
BEHIND BUILDING PAPER (9.20.13.6.) (REFER TO 35 NOTE AS REQUIRED)

- 3A

BRICK VENEER WALL CONSTRUCTION (2x6#) W/ CONTIN. INSULATION
3 1/2" (90) BRICK VENEER 1" (25) AIR SPACE. 7/8"x7'-0.03" (22x180x0.76) GALV. METAL
TIES @ 16" (400) O.C. HORIZ. 2x4" (600) O.C. VERT. BONDING AND FASTENING FOR
TIES TO CONFORM WITH 9.20.9. ON APPROVED ARJWATER BARRIER AS PER O.B.C.
9.27.3. ON EXTERIOR TYPE RIGID INSULATION (JOINTS UNTAPED) MECHANICALLY
FASTENED AS PER MANUFACTURERS SPECIFICATIONS. ON 3/8" (9.5) EXTERIOR TYPE
SHEATHING. STUDS CONFORMING TO O.B.C (9.23.10.1.) & SECTION 1.1. INSULATION
AND 6 MIL POLYETHYLENE VAPOUR BARRIER WITH APPROVED CONTIN. AIR BARRIER.
1/2" (12.7) GYPSUM WALLBOARD INTERIOR FINISH. PROVIDE WEEP HOLES @ 32" (800)
O.C. BOTTOM COURSE AND OVER OPENINGS. PROVIDE BASE FLASHING UP MIN. 6"
(152) OVER RIGID INSULATION (9.20.13.6.) (REFER TO 35 NOTE AS REQUIRED)

- 3B

BRICK VENEER WALL @ GARAGE CONSTRUCTION
3 1/2" (90) BRICK VENEER 1" (25) AIR SPACE. 7/8"x7'-0.03" (22x180x0.76) GALV.
METAL TIES @ 16" (400) O.C. HORIZ. 2x4" (600) O.C. VERT. BONDING AND FASTENING
FOR TIES TO CONFORM WITH 9.20.9. ON APPROVED SHEATHING PAPER. 3/8" (9.5)
EXTERIOR TYPE SHEATHING WITH 6.02.9. ON APPROVED SHEATHING PAPER. 3/8" (9.5)
SECTION 1.1. 1/2" (12.7) GYPSUM WALLBOARD INTERIOR FINISH. PROVIDE WEEP
HOLES @ 32" (800) O.C. AT BOTTOM COURSE AND OVER OPENINGS. PROVIDE
BASE FLASHING UP 6" (150) MIN. BEHIND BUILDING PAPER (9.20.13.6.) (REFER TO
35 NOTE AS REQ.)

- 4

INTERIOR STUD PARTITIONS (9.23.9.8., 9.23.10)
BEARING PARTITIONS SHALL BE A MINIMUM 2x4# (38x89) @ 16" (406) O.C. FOR 2
STOREY AND 12" (305) O.C. FOR 3 STOREY. NON-BEARING PARTITIONS 2x4# (38x89)
@ 24" (610) O.C. HORIZ. 2x4" (600) O.C. VERT. BONDING AND FASTENING FOR
TIES TO CONFORM WITH 9.20.9. ON APPROVED ARJWATER BARRIER AS PER O.B.C.
9.27.3. ON EXTERIOR TYPE RIGID INSULATION (JOINTS UNTAPED) MECHANICALLY
FASTENED AS PER MANUFACTURERS SPECIFICATIONS. ON 3/8" (9.5) EXTERIOR TYPE
SHEATHING. STUDS CONFORMING TO O.B.C (9.23.10.1.) & SECTION 1.1. INSULATION
AND 6 MIL POLYETHYLENE VAPOUR BARRIER WITH APPROVED CONTIN. AIR BARRIER.
1/2" (12.7) GYPSUM WALLBOARD INTERIOR FINISH. PROVIDE WEEP HOLES @ 32" (800)
O.C. BOTTOM COURSE AND OVER OPENINGS. PROVIDE BASE FLASHING UP MIN. 6"
(152) OVER RIGID INSULATION (9.20.13.6.) (REFER TO 35 NOTE AS REQUIRED)

- 4A

EXT. LOFT WALL CONSTRUCTION (2x6#) - NO CLADDING
3/8" (9.5) EXTERIOR TYPE SHEATHING. STUDS CONFORMING TO O.B.C (9.23.10.1.) &
SECTION 1.1. INSULATION AND 6 MIL POLYETHYLENE VAPOUR BARRIER WITH
APPROVED CONT. AIR BARRIER. 1/2" (12.7) GYPSUM WALLBOARD INT. FINISH. (9.23.)

- 4B

EXT. LOFT WALL CONSTRUCTION (2x6#)
APPROVED ARJWATER BARRIER AS PER O.B.C. 9.27.3. ON EXTERIOR TYPE RIGID
INSULATION (JOINTS UNTAPED) MECHANICALLY FASTENED AS PER
MANUFACTURERS SPECIFICATIONS. ON 3/8" (9.5) EXTERIOR TYPE SHEATHING,
STUDS CONFORMING TO O.B.C (9.23.10.1.) & SECTION 1.1. INSULATION AND 6
MIL POLYETHYLENE VAPOUR BARRIER WITH APPROVED CONT. AIR BARRIER. 1/2"
(12.7) GYPSUM WALLBOARD INT. FINISH. (9.23.)

- 5

FOUNDATION WALL/FOOTINGS
POURED CONC. FOUNDATION WALL AS PER CHART BELOW ON CONTINUOUS
KEYED CONCRETE FOOTING. FOUNDATION WALLS SHALL EXTEND NOT LESS
THAN 6" (150) ABOVE FINISHED GRADE. THE OUTSIDE OF THE FOUNDATION
SHALL BE DAMPROOFED FROM THE TOP OF THE FOOTING TO FINISHED GRADE
AND BRUSH COAT FROM THE TOP TO 2" BELOW GRADE. PROVIDE A DRAINAGE
LAYER ON THE OUTSIDE OF THE FOUNDATION WALL. SEAL THE DRAINAGE LAYER
AT THE TOP. THE TOP OF THE CONC. FOOTING SHALL BE DAMPROOFED.
CONCRETE FOOTINGS SUPPORTING JOIST SPANS GREATER THAN 19'-1" (4900)
SHALL BE SIZED IN ACCORDANCE WITH 9.15.4.1. (2) ON THE O.B.C. (REFER TO
CHART BELOW FOR RESPECTIVE SIZES). BRACE FOUNDATION WALL PRIOR TO
BACKFILLING. ALL FOOTINGS SHALL REST ON NATURAL UNDISTURBED SOIL OF
750KPa OR COMPACTED ENGINEERED FILL WITH MIN. BEARING CAPACITY OF
150KPa IF SOIL BEARING DOES NOT MEET MINIMUM CAPACITY. ENGINEERED
FOOTINGS ARE REQUIRED. ACTUAL SOIL BEARING CAPACITY TO BE VERIFIED
WITH SOIL ENGINEERING REPORT.
REFER TO CONSTRUCTION DRAWINGS AND DETAILS FOR FOUNDATION
WALL STRENGTH AND THICKNESS AND 9.15.4.
FOUNDATION WALLS SHALL NOT EXCEED 9'-10" (3.0m) IN UNSUPPORTED
HEIGHT UNLESS OTHERWISE NOTED. [9.15.4.2.1.1]

MINIMUM STRIP FOOTING SIZES (9.15.3)	UNREINFORCED SOLID CONCRETE FOUNDATION WALLS (9.15.4.2)	
	UNSUPPORTED	SUPPORTED
MIN. HEIGHT FROM FIN. SLAB TO GRADE	MAX. HEIGHT FROM FIN. SLAB TO GRADE	MAX. HEIGHT FROM FIN. SLAB TO GRADE
4'-0"	≤2.5m	≤2.5m & ≤2.75m
4'-0"	3'-11" (1.20m)	7'-0" (2.15m)
4'-0"	4'-7" (1.40m)	7'-6" (2.30m)
4'-0"	4'-11" (1.50m)	8'-0" (2.60m)
4'-0"	5'-1" (1.50m)	8'-6" (2.60m)
4'-0"	5'-5" (1.60m)	9'-0" (2.70m)
4'-0"	5'-9" (1.70m)	9'-6" (2.80m)
4'-0"	6'-3" (1.90m)	10'-0" (3.00m)
4'-0"	6'-7" (2.00m)	10'-6" (3.20m)
4'-0"	7'-1" (2.10m)	11'-0" (3.30m)
4'-0"	7'-5" (2.30m)	11'-6" (3.50m)
4'-0"	7'-9" (2.40m)	12'-0" (3.60m)
4'-0"	8'-3" (2.50m)	12'-6" (3.80m)
4'-0"	8'-7" (2.60m)	13'-0" (3.90m)
4'-0"	9'-1" (2.70m)	13'-6" (4.10m)
4'-0"	9'-5" (2.80m)	14'-0" (4.20m)
4'-0"	9'-9" (2.90m)	14'-6" (4.40m)
4'-0"	10'-3" (3.10m)	15'-0" (4.50m)
4'-0"	10'-7" (3.20m)	15'-6" (4.70m)
4'-0"	11'-1" (3.40m)	16'-0" (4.80m)
4'-0"	11'-5" (3.50m)	16'-6" (5.00m)
4'-0"	11'-9" (3.60m)	17'-0" (5.10m)
4'-0"	12'-3" (3.80m)	17'-6" (5.30m)
4'-0"	12'-7" (3.90m)	18'-0" (5.40m)
4'-0"	13'-1" (4.10m)	18'-6" (5.60m)
4'-0"	13'-5" (4.20m)	19'-0" (5.70m)
4'-0"	13'-9" (4.30m)	19'-6" (5.90m)
4'-0"	14'-3" (4.50m)	20'-0" (6.10m)
4'-0"	14'-7" (4.60m)	20'-6" (6.30m)
4'-0"	15'-1" (4.70m)	21'-0" (6.40m)
4'-0"	15'-5" (4.80m)	21'-6" (6.60m)
4'-0"	15'-9" (4.90m)	22'-0" (6.70m)
4'-0"	16'-3" (5.10m)	22'-6" (6.90m)
4'-0"	16'-7" (5.20m)	23'-0" (7.00m)
4'-0"	17'-1" (5.40m)	23'-6" (7.20m)
4'-0"	17'-5" (5.50m)	24'-0" (7.30m)
4'-0"	17'-9" (5.60m)	24'-6" (7.50m)
4'-0"	18'-3" (5.80m)	25'-0" (7.60m)
4'-0"	18'-7" (5.90m)	25'-6" (7.80m)
4'-0"	19'-1" (6.10m)	26'-0" (7.90m)
4'-0"	19'-5" (6.20m)	26'-6" (8.10m)
4'-0"	19'-9" (6.30m)	27'-0" (8.20m)
4'-0"	20'-3" (6.50m)	27'-6" (8.40m)
4'-0"	20'-7" (6.60m)	28'-0" (8.50m)
4'-0"	21'-1" (6.70m)	28'-6" (8.70m)
4'-0"	21'-5" (6.80m)	29'-0" (8.80m)
4'-0"	21'-9" (6.90m)	29'-6" (9.00m)
4'-0"	22'-3" (7.10m)	30'-0" (9.10m)
4'-0"	22'-7" (7.20m)	30'-6" (9.30m)
4'-0"	23'-1" (7.30m)	31'-0" (9.40m)
4'-0"	23'-5" (7.40m)	31'-6" (9.60m)
4'-0"	23'-9" (7.50m)	32'-0" (9.70m)
4'-0"	24'-3" (7.70m)	32'-6" (9.90m)
4'-0"	24'-7" (7.80m)	33'-0" (10.00m)
4'-0"	25'-1" (8.00m)	33'-6" (10.20m)
4'-0"	25'-5" (8.10m)	34'-0" (10.40m)
4'-0"	25'-9" (8.20m)	34'-6" (10.60m)
4'-0"	26'-3" (8.40m)	35'-0" (10.70m)
4'-0"	26'-7" (8.50m)	35'-6" (10.90m)
4'-0"	27'-1" (8.60m)	36'-0" (11.00m)
4'-0"	27'-5" (8.70m)	36'-6" (11.20m)
4'-0"	27'-9" (8.80m)	37'-0" (11.30m)
4'-0"	28'-3" (9.00m)	37'-6" (11.50m)
4'-0"	28'-7" (9.10m)	38'-0" (11.60m)
4'-0"	29'-1" (9.20m)	38'-6" (11.80m)
4'-0"	29'-5" (9.30m)	39'-0" (11.90m)
4'-0"	29'-9" (9.40m)	39'-6" (12.10m)
4'-0"	30'-3" (9.50m)	40'-0" (12.20m)
4'-0"	30'-7" (9.60m)	40'-6" (12.40m)
4'-0"	31'-1" (9.70m)	41'-0" (12.50m)
4'-0"	31'-5" (9.80m)	41'-6" (12.70m)
4'-0"	31'-9" (9.90m)	42'-0" (12.80m)
4'-0"	32'-3" (10.10m)	42'-6" (13.00m)
4'-0"	32'-7" (10.20m)	43'-0" (13.10m)
4'-0"	33'-1" (10.30m)	43'-6" (13.30m)
4'-0"	33'-5" (10.40m)	44'-0" (13.40m)
4'-0"	33'-9" (10.50m)	44'-6" (13.60m)
4'-0"	34'-3" (10.70m)	45'-0" (13.70m)
4'-0"	34'-7" (10.80m)	45'-6" (13.90m)
4'-0"	35'-1" (10.90m)	46'-0" (14.00m)
4'-0"	35'-5" (11.00m)	46'-6" (14.20m)
4'-0"	35'-9" (11.10m)	47'-0" (14.30m)
4'-0"	36'-3" (11.30m)	47'-6" (14.50m)
4'-0"	36'-7" (11.40m)	48'-0" (14.60m)
4'-0"	37'-1" (11.50m)	48'-6" (14.80m)
4'-0"	37'-5" (11.60m)	49'-0" (14.90m)
4'-0"	37'-9" (11.70m)	49'-6" (15.10m)
4'-0"	38'-3" (11.80m)	50'-0" (15.20m)
4'-0"	38'-7" (11.90m)	50'-6" (15.40m)
4'-0"	39'-1" (12.00m)	51'-0" (15.50m)
4'-0"	39'-5" (12.10m)	51'-6" (15.70m)
4'-0"	39'-9" (12.20m)	52'-0" (15.80m)
4'-0"	40'-3" (12.30m)	52'-6" (16.00m)
4'-0"	40'-7" (12.40m)	53'-0" (16.10m)
4'-0"	41'-1" (12.50m)	53'-6" (16.30m)
4'-0"	41'-5" (12.60m)	54'-0" (16.40m)
4'-0"	41'-9" (12.70m)	54'-6" (16.60m)
4'-0"	42'-3" (12.80m)	55'-0" (16.70m)
4'-0"	42'-7" (12.90m)	55'-6" (16.90m)
4'-0"	43'-1" (13.00m)	56'-0" (17.00m)
4'-0"	43'-5" (13.10m)	56'-6" (17.20m)
4'-0"	43'-9" (13.20m)	57'-0" (17.30m)
4'-0"	44'-3" (13.30m)	57'-6" (17.50m)
4'-0"	44'-7" (13.40m)	58'-0" (17.60m)
4'-0"	45'-1" (13.50m)	58'-6" (17.80m)
4'-0"	45'-5" (13.60m)	59'-0" (17.90m)
4'-0"	45'-9" (13.70m)	59'-6" (18.10m)
4'-0"	46'-3" (13.80m)	60'-0" (18.20m)
4'-0"	46'-7" (13.90m)	60'-6" (18.40m)
4'-0"	47'-1" (14.00m)	61'-0" (18.50m)
4'-0"	47'-5" (14.10m)	61'-6" (18.70m)
4'-0"	47'-9" (14.20m)	62'-0" (18.80m)
4'-0"	48'-3" (14.30m)	62'-6" (19.00m)
4'-0"	48'-7" (14.40m)	63'-0" (19.10m)
4'-0"	49'-1" (14.50m)	63'-6" (19.30m)
4'-0"	49'-5" (14.60m)	64'-0" (19.40m)
4'-0"	49'-9" (14.70m)	64'-6" (19.60m)
4'-0"	50'-3" (14.80m)	65'-0" (19.70m)
4'-0"	50'-7" (14.90m)	65'-6" (19.90m)
4'-0"	51'-1" (15.00m)	66'-0" (20.00m)
4'-0"	51'-5" (15.10m)	66'-6" (20.20m)
4'-0"	51'-9" (15.20m)	67'-0" (20.30m)
4'-0"	52'-3" (15.30m)	67'-6" (20.50m)
4'-0"	52'-7" (15.40m)	68'-0" (20.60m)
4'-0"	53'-1" (15.50m)	68'-6" (20.80m)
4'-0"	53'-5" (15.60m)	69'-0" (20.90m)
4'-0"	53'-9" (15.70m)	69'-6" (21.10m)
4'-0"	54'-3" (15.80m)	70'-0" (21.20m)
4'-0"	54'-7" (15.90m)	70'-6" (21.40m)
4'-0"	55'-1" (16.00m)	71'-0" (21.50m)
4'-0"	55'-5" (16.10m)	71'-6" (21.70m)
4'-0"	55'-9" (16.20m)	72'-0" (21.80m)
4'-0"	56'-3" (16.30m)	72'-6" (22.00m)
4'-0"	56'-7" (16.40m)	73'-0" (22.10m)
4'-0"	57'-1" (16.50m)	73'-6" (22.30m)
4'-0"	57'-5" (16.60m)	74'-0" (22.40m)
4'-0"	57'-9" (16.70m)	74'-6" (22.60m)
4'-0"	58'-3" (16.80m)	75'-0" (22.70m)
4'-0"	58'-7" (16.90m)	75'-6" (22.90m)
4'-0"	59'-1" (17.00m)	76'-0" (23.00m)
4'-0"	59'-5" (17.10m)	76'-6" (23.20m)
4'-0"	59'-9" (17.20m)	77'-0" (23.30m)
4'-0"	60'-3" (17.30m)	77'-6" (23.50m)
4'-0"	60'-7" (17.40m)	78'-0" (23.60m)
4'-0"	61'-1" (17.50m)	78'-6" (23.80m)
4'-0"	61'-5" (17.60m)	79'-0" (23.90m)
4'-0"	61'-9" (17.70m)	79'-6" (24.10m)
4'-0"	62'-3" (17.80m)	80'-0" (24.20m)
4'-0"	62'-7" (17.90m)	80'-6" (24.40m)
4'-0"	63'-1" (18.00m)	81'-0" (24.50m)
4'-0"	63'-5" (18.10m)	81'-6" (24.70m)
4'-0"	63'-9" (18.20m)	82'-0" (24.80m)
4'-0"	64'-3" (18.30m)	82'-6" (25.00m)
4'-0"	64'-7" (18.40m)	83'-0" (25.10m)
4'-0"	65'-1" (18.50m)	83'-6" (25.30m)
4'-0"	65'-5" (18.60m)	84'-0" (25.40m)
4'-0"	65'-9" (18.70m)	84'-6" (25.60m)
4'-0"	66'-3" (18.80m)	85'-0" (25.70m)
4'-0"	66'-7" (18.90m)	85'-6" (25.90m)
4'-0"	67'-1" (19.00m)	86'-0" (26.00m)
4'-0"	67'-5" (19.10m)	86'-6" (26.20m)
4'-0"	67'-9" (19.20m)	87'-0" (26.30m)
4'-0"	68'-3" (19.30m)	87'-6" (26.50m)
4'-0"	68'-7" (19.40m)	88'-0" (26.60m)
4'-0"	69'-1" (19.50m)	88'-6" (26.80m)
4'-0"	69'-5" (19.60m)	89'-0" (26.90m)
4'-0"	69'-9" (19.70m)	89'-6" (27.10m)
4'-0"	70'-3" (19.80m)	90'-0" (27.20m)
4'-0"	70'-7" (19.90m)	90'-6" (27.40m)
4'-0"	71'-1" (20.00m)	91'-0" (27.50m)
4'-0"	71'-5" (20.10m)	91'-6" (27.70m)
4'-0"	71'-9" (20.20m)	92'-0" (27.80m)
4'-0"	72'-3" (20.30m)	92'-6" (28.00m)
4'-0"	72'-7" (20.40m)	93'-0" (28.10m)
4'-0"	73'-1" (20.50m)	93'-6" (28.30m)
4'-0"	73'-5" (20.60m)	94'-0" (28.40m)
4'-0"	73'-9" (20.70m)	94'-6" (28.60m)
4'-0"	74'-3" (20.80m)	95'-0" (28.70m)
4'-0"	74'-7" (20.90m)	95'-6" (28.90m)
4'-0"	75'-1" (21.00m)	96'-0" (29.00m)
4'-0"	75'-5" (21.10m)	96'-6" (29.20m)
4'-0"	75'-9" (21.20m)	97'-0" (29.30m)
4'-0"	76'-3" (21.30m)	97'-6" (29.50m)
4'-0"	76'-7" (21.40m)	98'-0" (29.6

