



CONSTRUCTION SUMMARY

Summer Ridge Estates Inc.

PURCHASER: BENITO CONSIGLIO

TEL: RES.: 416-992-2257

LOT NUMBER	PHASE	HOUSE TYPE	CLOSING DATE
003 BLOCK 289	1	ROSE GARDEN (25-02-A2) ELEV A2	30-Mar-26

Date Added: 27-May-25

Invoice Number: 8805

2 - BASEMENT - WINDOWS - Enlarge TWO (2) Basement Windows from Standard 30 IN (W) x 16 IN (H) TO LARGER SIZE of 30 IN (W) x 24 IN (H) (with Possible Window Wells) (See Sketch)
Note: Priced Approved as per Fonzie C.

1 - Install Standard Cable Rough-Ins (x2) and Install Standard Telephone Rough-Ins (x2) (See Sketch)
Note:

1 - FAMILY ROOM - Purchaser has requested that Standard Cable Rough-In be installed APPROX 56" AFF (above finished floor) at family room (See Sketch)
Note:

1 - PRIMARY BEDROOM - Purchaser has requested that Standard Cable Rough-In be installed APPROX 56" AFF (above finished floor) at primary bedroom (See Sketch)
Note:

1 - CLARIFICATION;
EXTERIOR - GARAGE DOOR - Install STANDARD Exterior Handle with Lock on Garage Door
Note:

1 - MAIN FLOOR & 2ND FLOOR - BASEBOARD & CASING - Install UPGRADE #1 Baseboard & Casing - 3 1/2" Step Bevel Casing with 5 1/4" Step Bevel Baseboard - To be installed throughout main floor and 2nd floor, where applicable (See Sketch)
Note:

1 - MAIN FLOOR & UPPER HALL- HARDWOOD - Install prefinished 3 1/4" x 3/4" VINTAGE RED OAK BAJA (Character Pearl) in lieu of standard prefinished 3 1/4" x 3/4" Vintage Red Oak Natural - To be installed throughout main floor and upper hall, where applicable
Note: To Include; Main Hall, LivingRoom/DiningRoom, Family Room, Upper Hall and Applicable Landings (See Sketch)

1 - 2ND FLOOR BEDROOMS - HARDWOOD - Install prefinished 3 1/4" x 3/4" VINTAGE RED OAK TITANIUM (Character Pearl) in lieu of standard broadloom - To be installed throughout 2nd floor bedrooms, where applicable.
Note: To Include; Primary Bedroom, Bedroom #2 and Bedroom #3 (See Sketch)

1 - STAIRCASE - Stain Oak Staircase from Main Floor to Second Floor, where applicable. To be Stained - Vintage Red Oak BAJA - To Include; Treads, Risers, Handrail and Post, where applicable (See Sketch)
Note:

1 - STAIRCASE VS FLOORING
STAINING DIFFERENCE:
STAIRCASE - The purchaser was advised and therefore accepts and acknowledges that the stain of the staircase and flooring chosen do not match. This difference might result in an undesirable colour variance.
Note: The purchaser agrees that the vendor is to be exempt from any and all claims by the purchaser regarding this colour variance.

1 - KITCHEN & BATHROOMS - Purchaser has DECLINED All Upgrades offered during decor appointment at the decor centre for kitchen & bathroom cabinetry. Standard Kitchen Layout & Standard Bathroom Vanities to be installed as per standard plan. (See Sketch)
Note:

1 - APPLIANCES – INSTALL STANDARD APPLIANCE PACKAGE (See Attached)
Note:

1 - KITCHEN - COUNTERTOP - Install Builders Standard Stone Countertop – EVEREST MAPLE WHITE with STANDARD " A " EDGE PROFILE - To be installed throughout kitchen, where applicable (does not include stone backsplash) (See Sketch)
Note:

1 - DISCLAIMER - STONE COUNTERTOP;
KITCHEN - Due to the many variables that can affect the pattern, colour and/or design and "pitting" of stone products, stone installed will not be identical to the samples displayed
Note: Every effort is made to provide stone countertops as close as possible but the vendor is not responsible for results which differ from the sample displayed. All countertop surfaces may have seams, and product pattern and shade can change in areas containing seams.



CONSTRUCTION SUMMARY
Summer Ridge Estates Inc.

PURCHASER: BENITO CONSIGLIO

TEL: RES.: 416-992-2257

LOT NUMBER	PHASE	HOUSE TYPE	CLOSING DATE
003 BLOCK 289	1	ROSE GARDEN (25-02-A2) ELEV A2	30-Mar-26

Date Added: 27-May-25

Invoice Number: 8805

1 - KITCHEN - KITCHEN SINK - Install Builders Standard Undermount Sink – Blanco Essential U2 Undermount Sink – Model #400008 Note:
1 - KITCHEN - KITCHEN FAUCET - Install Builders Standard Faucet - MOEN Method Single Handle Pull-Out (Single Hole) Kitchen Faucet - Model # 7585 – Chrome Note:
1 - CLARIFICATION - PLUMBING FIXTURES & PLUMBING FAUCETS: ALL BATHROOMS - Install Builders Standard Plumbing Faucets and Install Builders Standard Plumbing Fixtures throughout all bathrooms, where applicable. Note: To Include; Powder Room, Primary Ensuite and Main Bath (See Sketch)
1 - PRIMARY ENSUITE - Purchaser has DECLINED Upgrade to Install tiles on Primary Ensuite shower stall ceiling. Purchaser accepts and acknowledges NO TILES will be installed on primary ensuite shower ceiling. Note:
1 - MAIN BATH - Purchaser has DECLINED Upgrade to Install tiles on Main Bath tub/shower stall ceiling. Purchaser accepts and acknowledges NO TILES will be installed on main bath tub/shower ceiling. Note:
1 - Purchaser to Recieve Discount of \$1,023.20(Before HST) To be Applied to Upgrades Completed at the Decor Centre - Approved as per Steve C. Note:
1 - BONUS PACKAGE - PURCHASER HAS APPLIED \$21,968.10 (Incudes Taxes) WORTH OF UPGRADE PROMOTIONAL PACKAGE TOWARDS THE PURCHASE OF STRUCTURAL UPGRADES COMPLETED AT THE DECOR CENTRE Note:
1 - PURCHASER HAS ATTENDED A DECOR APPOINTMENT AT THE DESIGN STUDIO AND HAS DECLINED ANY ADDITIONAL UPGRADES. Purchaser accepts and acknowledges that there will be no further changes/additions/deletions to be made upon signing on MAY 27,2025 Note:
1 - PURCHASER AWARE AND ACCEPTS THAT ANY CHANGES MADE TO UPGRADES AFTER SIGNING THIS PURCHASERS EXTRA FORM ARE SUBJECT TO A MINIMUM ADMINISTRATION FEE OF \$1,000 Note:

This Document is Extremely Time Sensitive - Printed 27 May 25 at 16:49



Purchaser

BENITO CONSIGLIO

Decor Consultant

Melissa Di Marino

Model and Elevation

ROSE GARDEN (25-02-A2) ELEV A2

Telephone Res. / Bus

(416) 992-2257 /

Project

Summer Ridge Estates Inc.

Closing Date

30/03/2026

Property

003 BLOCK 289

* INTERIOR COLOUR SCHEME *

Page 2 of 3

Primary Ensuite

Main Bath

Laundry (2nd Floor)

Powder Room

Mud Room

Kitchen/Breakfast

Foyer

Main Hall

Family Room

Living Room

Dining Room

Upper Hall

Primary Bedroom

Bedroom 2

Bedroom 3

Interior Paint	Cabinet	Countertop	Counter Edge	Handle / Knob
Description	Style			
STANDARD - SILVER BIRCH	CATEGORY 1 - LP LAMINATE - WILLOW GREY (SM) QTS 1022 (STD)	7735-58 PORTICO MARBLE (STD)	STANDARD	DH00015
STANDARD - SILVER BIRCH	CATEGORY 1 - LP LAMINATE CANVAS (TX) QTS 1022 (STD)	7735-58 PORTICO MARBLE (STD)	STANDARD	DH00015
STANDARD - SILVER BIRCH	NONE	NONE	NONE	NONE
STANDARD - SILVER BIRCH	CATEGORY 1 - LP LAMINATE - TUNDRA (TX) QTS 1022 (STD)	3690-58 BASALT SLATE (STD)	STANDARD	DH00015
STANDARD - SILVER BIRCH	N/A	N/A	N/A	N/A
STANDARD - SILVER BIRCH	CATEGORY 1 - LP LAMINATE - DORATO GREY (TX) QTS 1022 (STD)	EVEREST MAPLE WHITE (STD)	* A * EDGE (STD)	DH00010
STANDARD - SILVER BIRCH				
STANDARD - SILVER BIRCH				

Appliance Opening/Dimension

Fridge Size

See Attached QTK Layout

Range

See Attached QTK Layout

Built-Ins

None

Microwave

None

Hood Fan

See Attached QTK Layout

Exhaust Opening

☒ 6" ☐ 8"

Dishwasher Cabinet

See Attached QTK Layout

Notes

**Kitchen Sink - Install Standard Undermount Sink - Blanco Essential U2 Undermount Sink - Model #400008 **Kitchen Faucet - Install Standard Faucet - MOEN Method Single Handle Pull-Out (Single Hole) Kitchen Faucet - Model # 7585 - Chrome **APPLIANCES - STANDARD APPLIANCE PACKAGE (See Attached)

Fireplace

Fireplace	N/A	Fireplace	N/A
Location Flooring	N/A	Location Flooring	N/A
Style	N/A	Style	N/A
Finish	N/A	Finish	N/A
Marble	N/A	Marble	N/A
Hearth	N/A	Hearth	N/A

Page 2 of 3

Decor Consultant:

Melissa Di Marino

Purchaser:

Signed by:
Benito Consiglio
E427ACF1C29B46B...

BENITO CONSIGLIO


Vendor:

Summer Ridge Estates Inc.


Printed May 27, 2025 11:58 am




cable - (C)
Telephone - (T)
Conduit (x1)

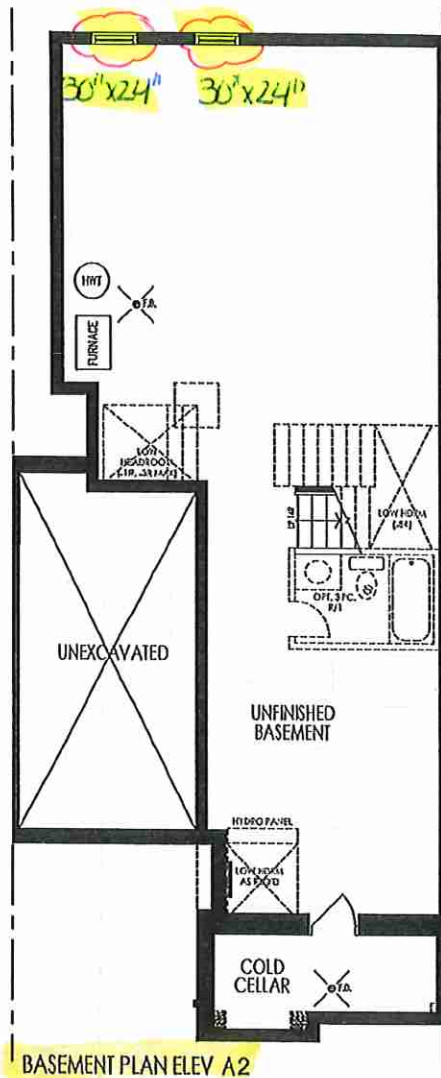

BASEMENT PLAN ELEV A2

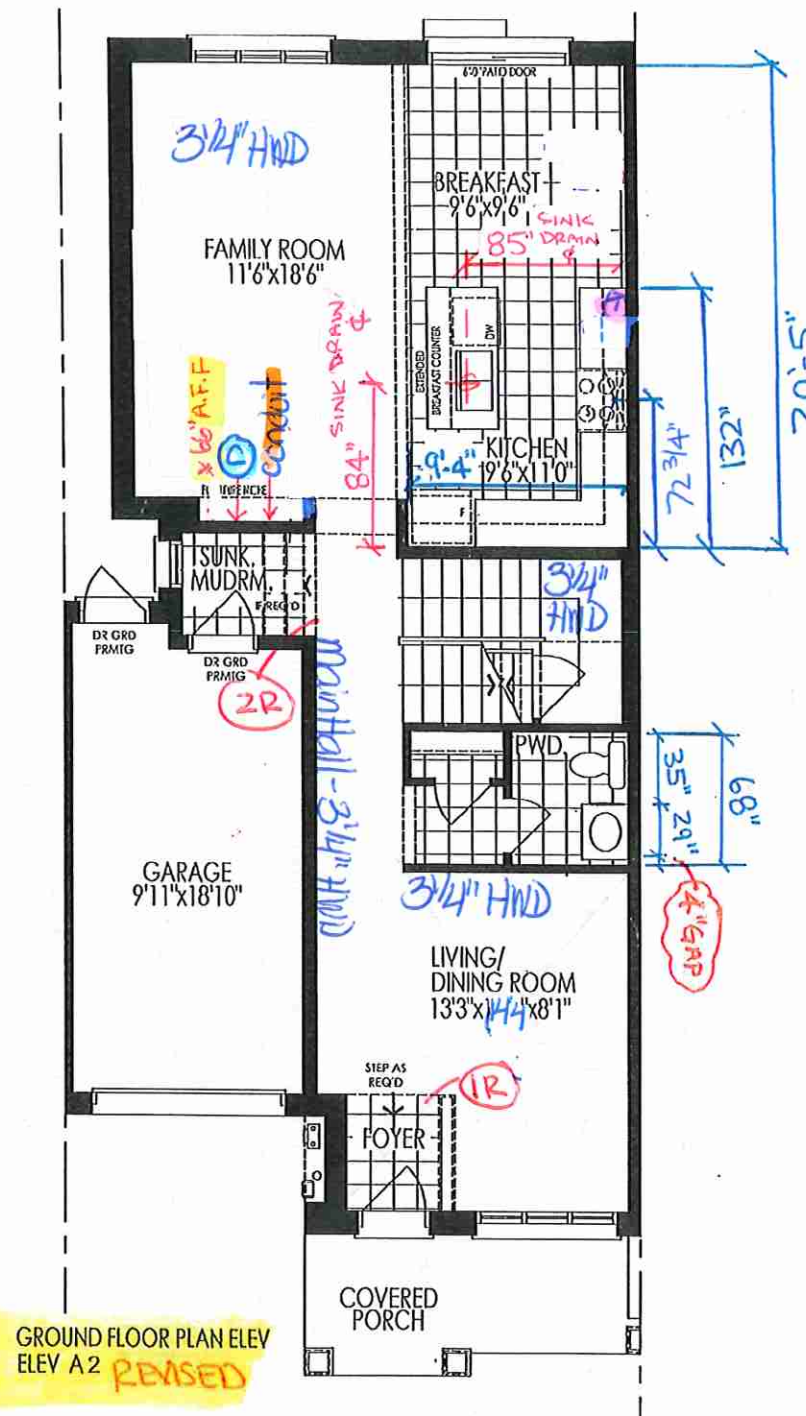

GROUND FLOOR PLAN ELEV
ELEV A2 REISED

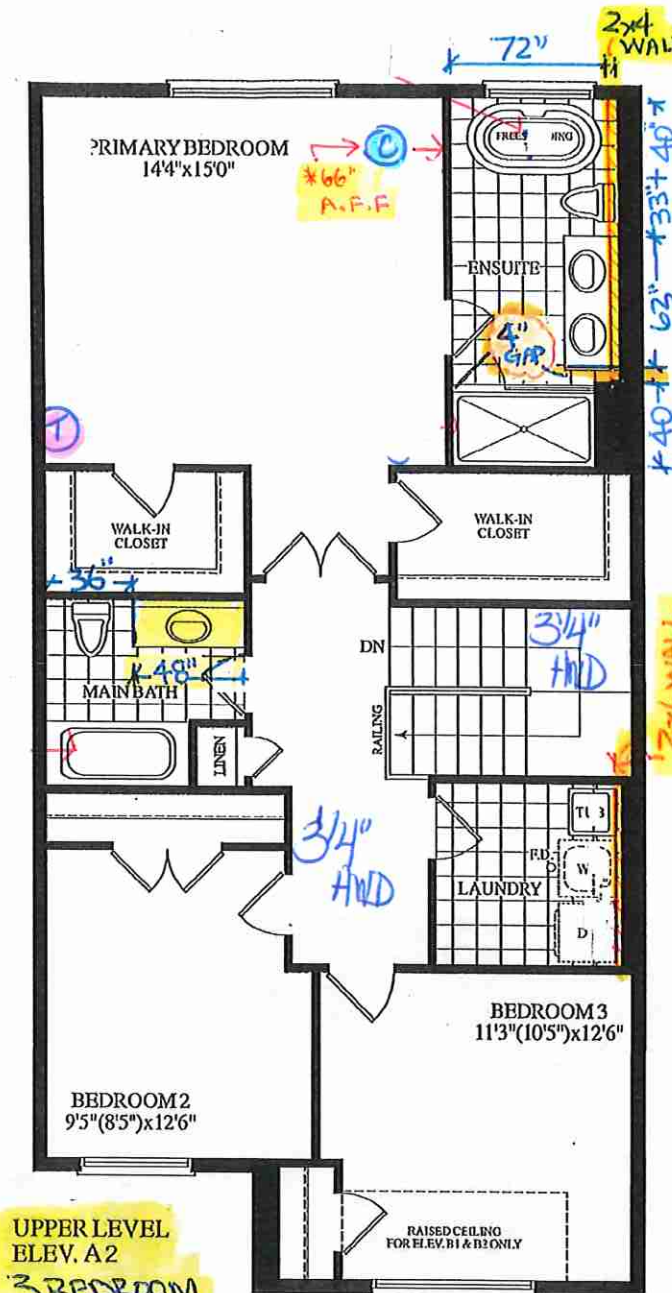

UPPER LEVEL
ELEV. A2
3 BEDROOM

TH#3 - PERSONALITY

BLOCK 289 - TH. 3 25-02 ROSE GARDEN EL. A2 1940 SQ. FT.

Materials, specifications and floor plans are subject to change without notice. All renderings are artist's concept. All floor plans are approximate dimensions. Actual usable floor space may vary from the stated floor area. E.O.E.

Lot 3 / BIK 289

Initial
BL




50 Sante Drive, Vaughan, ON L4K 3C4
T 416.746.1811 F 905.701.5901
www.QTK.ca info@qtk.ca


CLIENT: ROYAL PINE HOMES	JOB NAME: 25-02 STD	ROOM: KITCHEN	DRAWN BY: MD / PS
SITE: SUMMER RIDGE	DOOR STYLE: —	DOOR HANDLE: —	SCALE: 3/8" = 1'-0"
PHONE: —	FINISH: —	DRW HANDLE: —	DATE: MARCH 06, 2025
EMAIL: —	SPECIES: —	TOP: —	PAGE: 1 OF 1
COMMENTS:	CUSTOMER INITIALS: _____		

Customer Agrees and Accepts the following conditions: 1. The Drawing is a representation only and the installed cabinetry may vary slightly in product size, measurements, handle appearance and location and other details. Although Quality Tops & Kitchens Ltd. (QTK) does its best to manufacture exactly what is shown here outside factors may prevent that and some variance is to be expected and accepted by the customer. 2. These drawings represent the intellectual property of QTK and as such the customer understands and accepts that all deposits given by the customer to QTK are non-refundable after QTK has supplied drawings (either physically or electronically) to the customer. If the customer decides to cancel the order after QTK has submitted drawings to the customer, the deposit will then be considered a design fee and no money will be returned to the customer. Door/drawer fronts with inner profiles may receive slab fronts due to rail size restrictions based on width/height of the panels or site conditions.

FRIDGE WALL ELEVATION

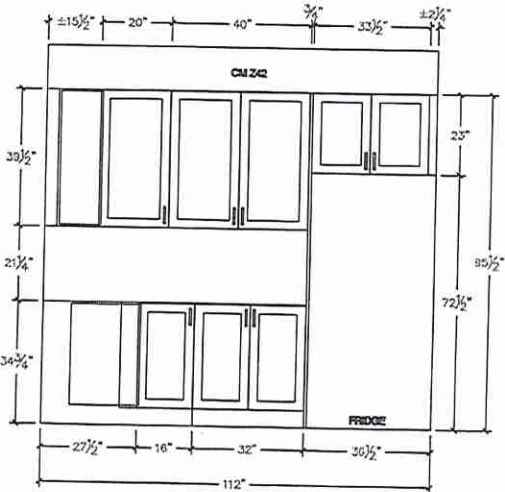

STOVE WALL ELEVATION

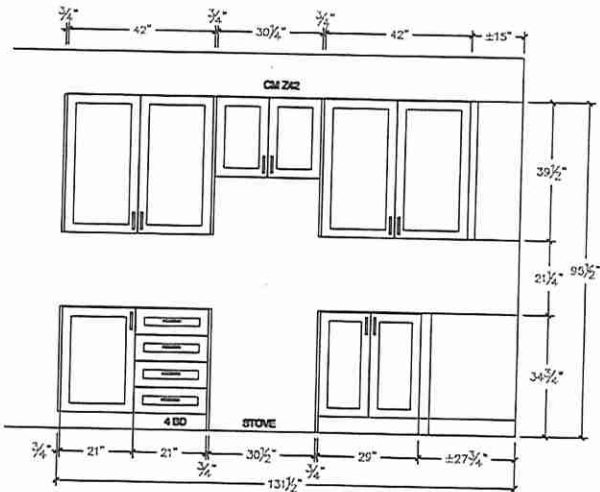

Lot 3/ BIK 289

Initial
BL




Your kitchen, your terms.

80 Sante Drive, Vaughan, ON L4K 3C4
T 416.746.1811 F 905.761.5901
www.QTK.ca info@qtk.ca


CLIENT: ROYAL PINE HOMES	JOB NAME: 5402 STD	ROOM:	DRAWN BY: MD / PS
SITE: SUMMER RIDGE	DOOR STYLE: —	DOOR HANDLE: —	SCALE: 1/2" = 1'-0"
PHONE: —	FINISH: —	DRW HANDLE: —	DATE: MARCH 06, 2005
EMAIL: —	SPECIES: —	TOP: —	PAGE: 1 OF 1
COMMENTS:	CUSTOMER INITIALS:		

Customer Agrees and Accepts the following conditions: 1. The Drawing is a representation only and the installed cabinetry may vary slightly in product size, measurements, handle appearance and location and other details. Although Quality Tops & Kitchens Ltd. (QTK) does it's best to manufacture exactly what is shown here outside factors may prevent that and some variance is to be expected and accepted by the customer. 2. These drawings represent the intellectual property of QTK and as such the customer understands and accepts that all deposits given by the customer to QTK are non-refundable after QTK has supplied drawings (either physically or electronically) to the customer. If the customer decides to cancel the order after QTK has submitted drawings to the customer, the deposit will then be considered a design fee and no money will be returned to the customer. Door/drawer fronts with linear profiles may involve slab fronts due to rail size restrictions based on width/height of the panels or the conditions.


ISLAND REAR ELEVATION

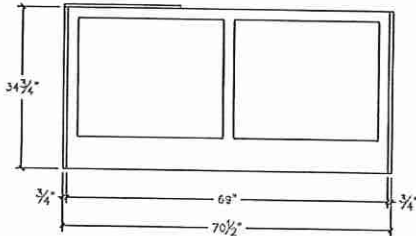

ISLAND FRONT ELEVATION

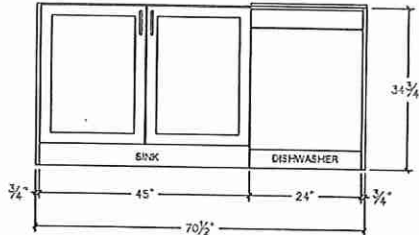

ISLAND SIDE ELEVATION

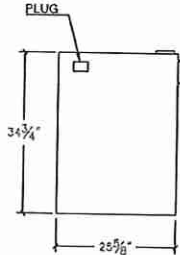

Lot 3/BIK 289




your kitchen, our job.

80 Sante Drive, Vaughan, ON L4K 3C4
T 416.746.1811 F 905.761.5901
www.QTK.ca info@qtk.ca

CLIENT: ROYAL PINE HOMES	JOB NAME: 25-02 STD	ROOM:	DRAWN BY: MD / PS
SITE: SUMMER RIDGE	DOOR STYLE: —	DOOR HANDLE: —	SCALE: 1/2" = 1'-0"
PHONE: —	FINISH: —	DRW HANDLE: —	DATE: MARCH 05, 2025
EMAIL: —	SPECIES: —	TOP: —	PAGE: 1 OF 1
COMMENTS:	CUSTOMER INITIALS:		

Customer Agrees and Accepts the following conditions: 1. The Drawing is a representation only and the installed cabinetry may vary slightly in product size, measurements, handle appearance and location and other details. Although Quality Tops & Kitchens Ltd. (QTK) does it's best to manufacture exactly what is shown here outside factors may prevent that and some variance is to be expected and accepted by the customer. 2. These drawings represent the Intellectual Property of QTK and as such the customer understands and accepts that all deposits given by the customer to QTK are non-refundable after QTK has supplied drawings (either physically or electronically) to the customer. If the customer decides to cancel the order after QTK has submitted drawings to the customer, the deposit will then be considered a design fee and no money will be returned to the customer. Door/drawer fronts with inner profiles may receive sub fronts due to roll size restrictions based on width/height of the panels or site conditions.

3D VIEW

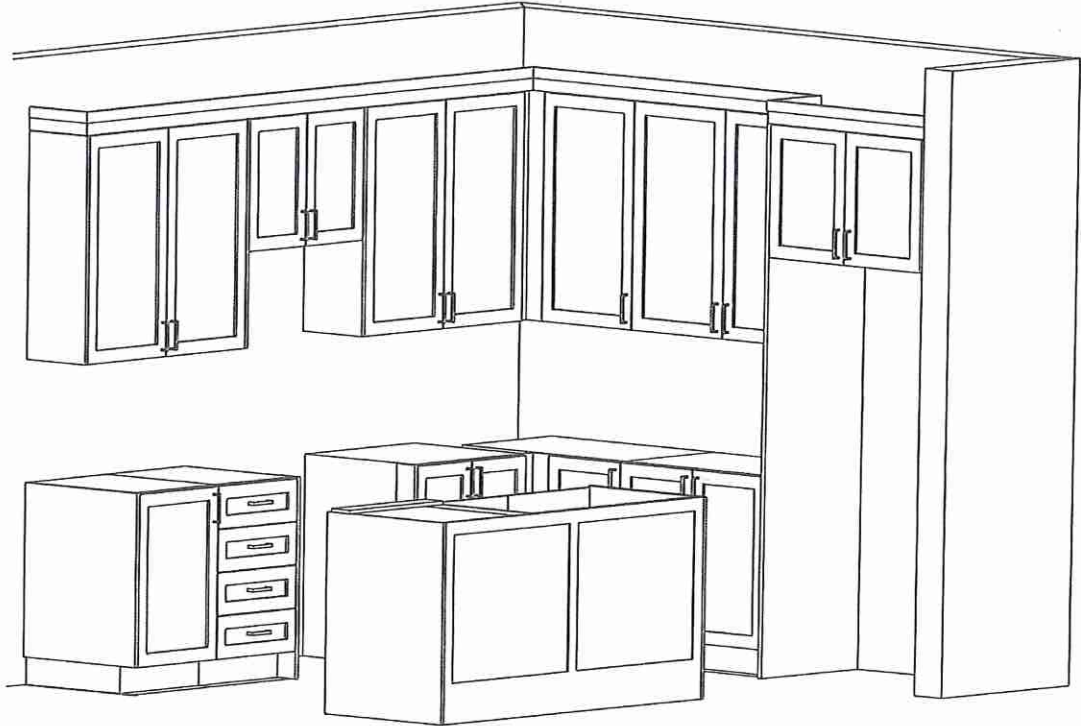

Lot 3/BIK289

Initial
BL




80 Sante Drive, Vaughan, ON L4K 3C4
T 416.746.1811 F 905.761.5901
www.QTK.ca info@qtk.ca

your kitchen, your style


CLIENT: ROYAL PINE HOMES	JOB NAME: 35-42 STD	ROOM: KITCHEN	DRAWN BY: JLD/PS
SITE: SUMMER RIDGE	DOOR STYLE: —	DOOR HANDLE: —	SCALE: 1/2" = 1'-0"
PHONE: —	FINISH: —	DRW HANDLE: —	DATE: 24 FEB 2025
EMAIL: —	SPECIES: —	TOP: —	PAGE: 1 OF 1
COMMENTS:	CUSTOMER INITIALS:		

Customer agrees and accepts the following conditions: 1. The Drawing is a representation only and the installed cabinetry may vary slightly in product size, measurements, handle appearance and location and other details. Although Quality Tops & Kitchens Ltd. (QTK) does its best to manufacture exactly what is shown here outside factors may prevent that and some variance is to be expected and accepted by the customer. 2. These drawings represent the intellectual property of QTK and as such the customer understands and accepts that all deposits given by the customer to QTK are non-refundable after QTK has supplied drawings (either physically or electronically) to the customer. The customer agrees to cancel the order after QTK has submitted drawings to the customer, the deposit will then be considered a design fee and no money will be returned to the customer. Door/drawer fronts with linear profiles may receive slab fronts due to roll size restrictions based on width/height of the panels or site conditions.


MASTER ENSUITE PLAN

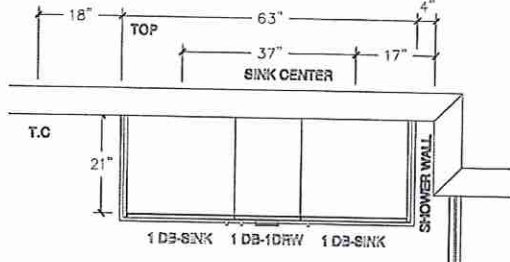


MASTER ENSUITE ELEVATION

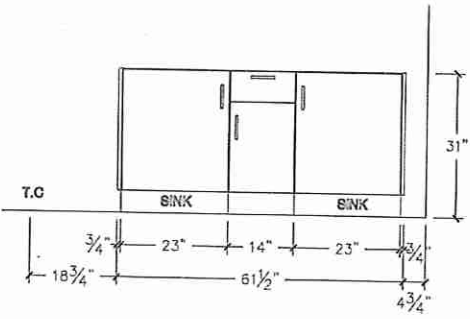

MASTER ENSUITE PLAN (w/ OPT. SECOND FLOOR PLAN)

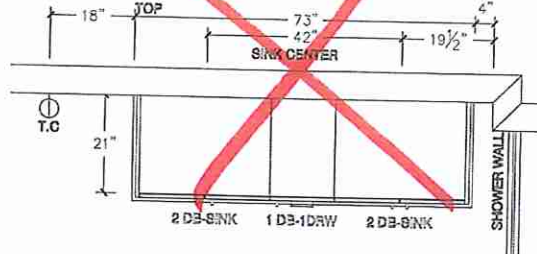

MASTER ENSUITE ELEVATION (w/ OPT. SECOND FLOOR PLAN)

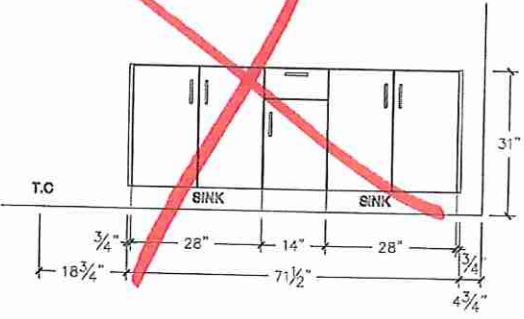

6

Lot 3 / Blk 289

Initial
BL




80 Sante Drive, Vaughan, ON L4K 3C4
T 416.746.1811 F 905.761.5901
www.QTK.ca info@qtk.ca


CLIENT: ROYAL PINE HOMES	JOB NAME: 25-02 STD	ROOMS:	VANITIES	DRAWN BY: MD / PS
SITE: SUMMER RIDGE	DOOR STYLE: —	DOOR HANDLE: —	SCALE: 1/2" = 1'-0"	
PHONE: —	FINISH: —	DRY HANDLE: —	DATE: FEB 07 2025	
EMAIL: —	SPECIES: —	TOP: —	PAGE: 1 OF 1	
COMMENTS:	CUSTOMER INITIALS:			

Customer Agrees and Accepts the following conditions: 1. The Drawing is a representation only and the installed cabinetry may vary slightly in product, size, requirements, handle appearance and location and other details. Although Quality Tops & Kitchens Ltd. (QTK) does it's best to manufacture exactly what is shown here outside for customer prevent that and some variance is to be expected and accepted by the customer. 2. These drawings represent the intellectual property of QTK and as such the customer understands and accepts that all deposits given by the customer to QTK are non-refundable after QTK has supplied drawings (either physically or electronically) to the customer. If the customer decides to cancel the order after QTK has submitted drawings to the customer, the deposit will then be considered a design fee and no money will be returned to the customer. Door/drawer fronts with linear profiles may receive slab fronts due to mill size restrictions based on width/height of the panels or site conditions.


MAIN BATH PLAN

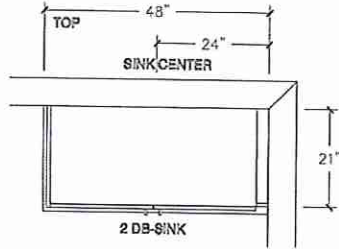


POWDER ROOM PLAN

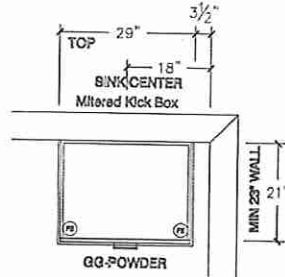


~~OPT BASEMENT BATH PLAN~~

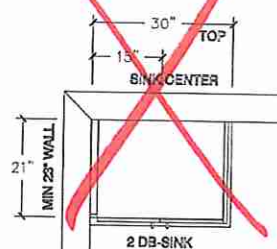


MAIN BATH ELEVATION

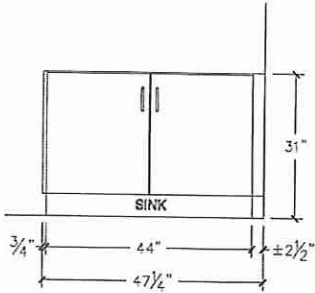

POWDER ROOM ELEVATION

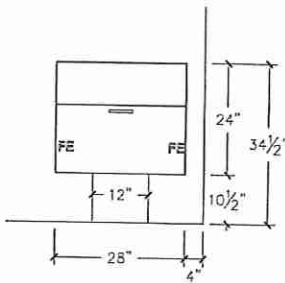

~~OPT BASEMENT BATH ELEVATION~~

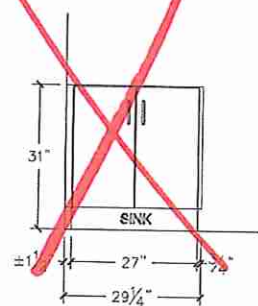

67