


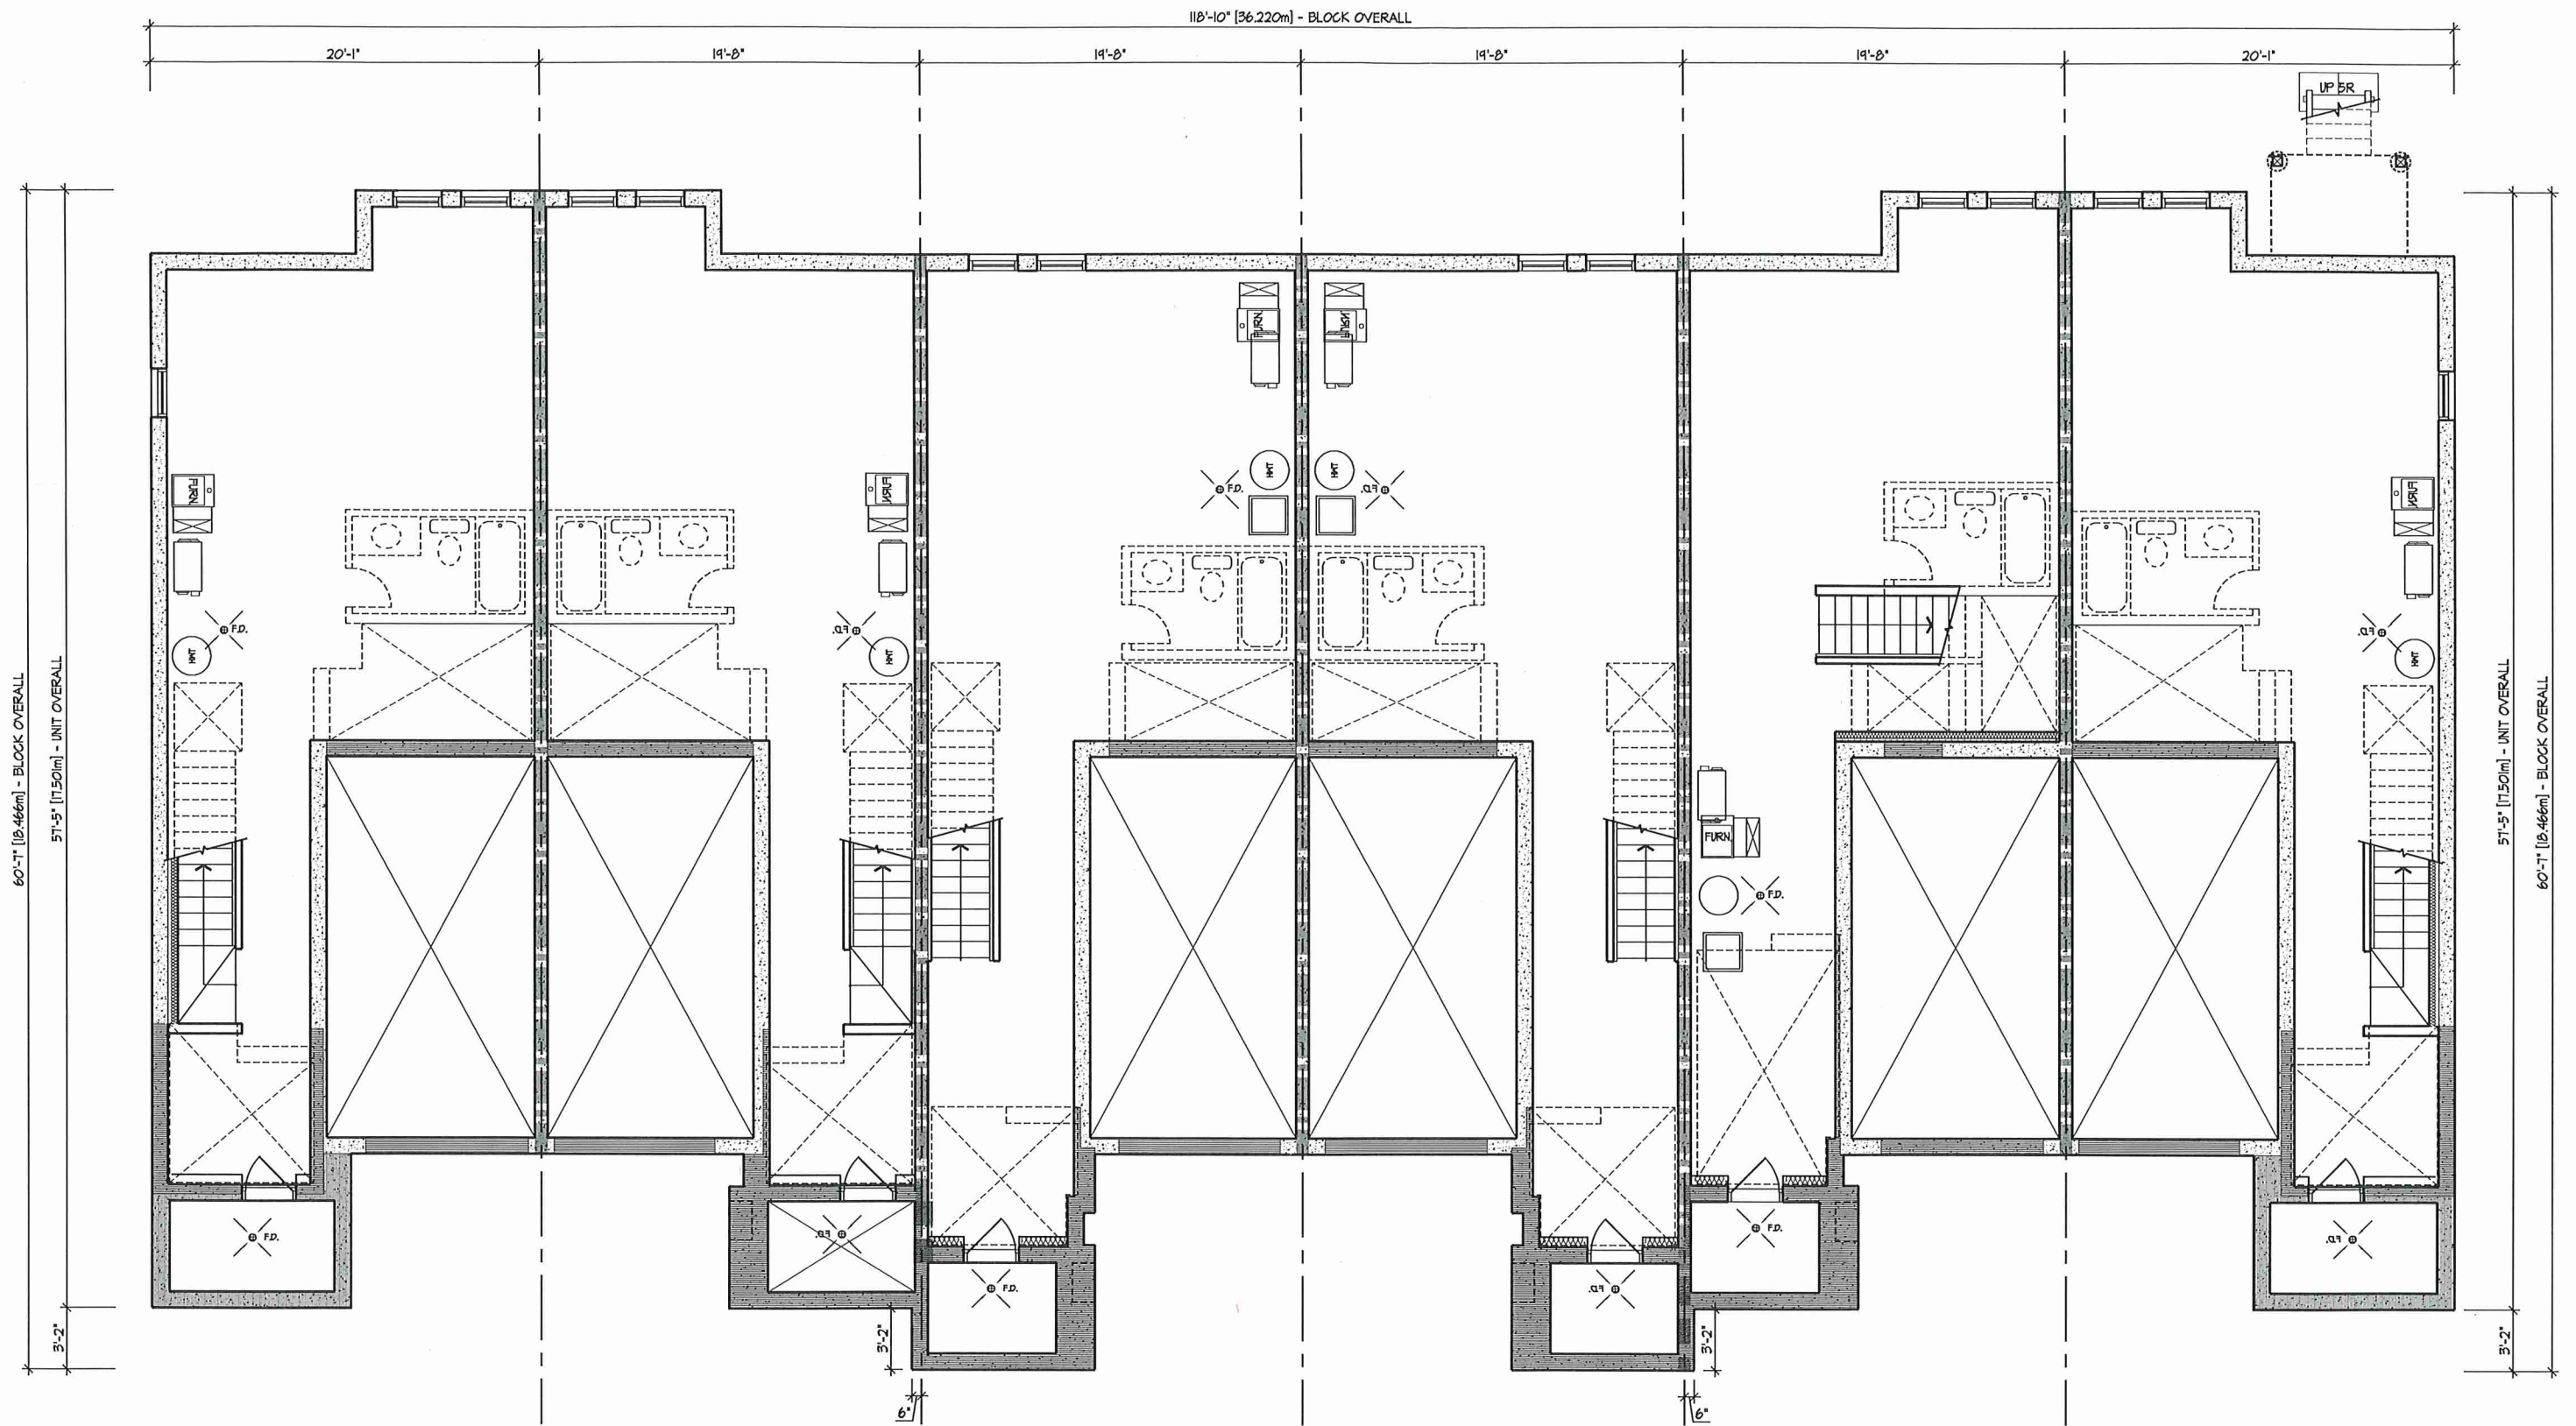

62 2009-END
234 EL. 'B'

63 2009
234 EL. 'B' (REV)


64 2008
234 EL. 'B'

65 2008
234 EL. 'B' (REV)

66 2007
234 EL. 'B'

67 2009-END
234 EL. 'B' (REV)

BASEMENT PLAN

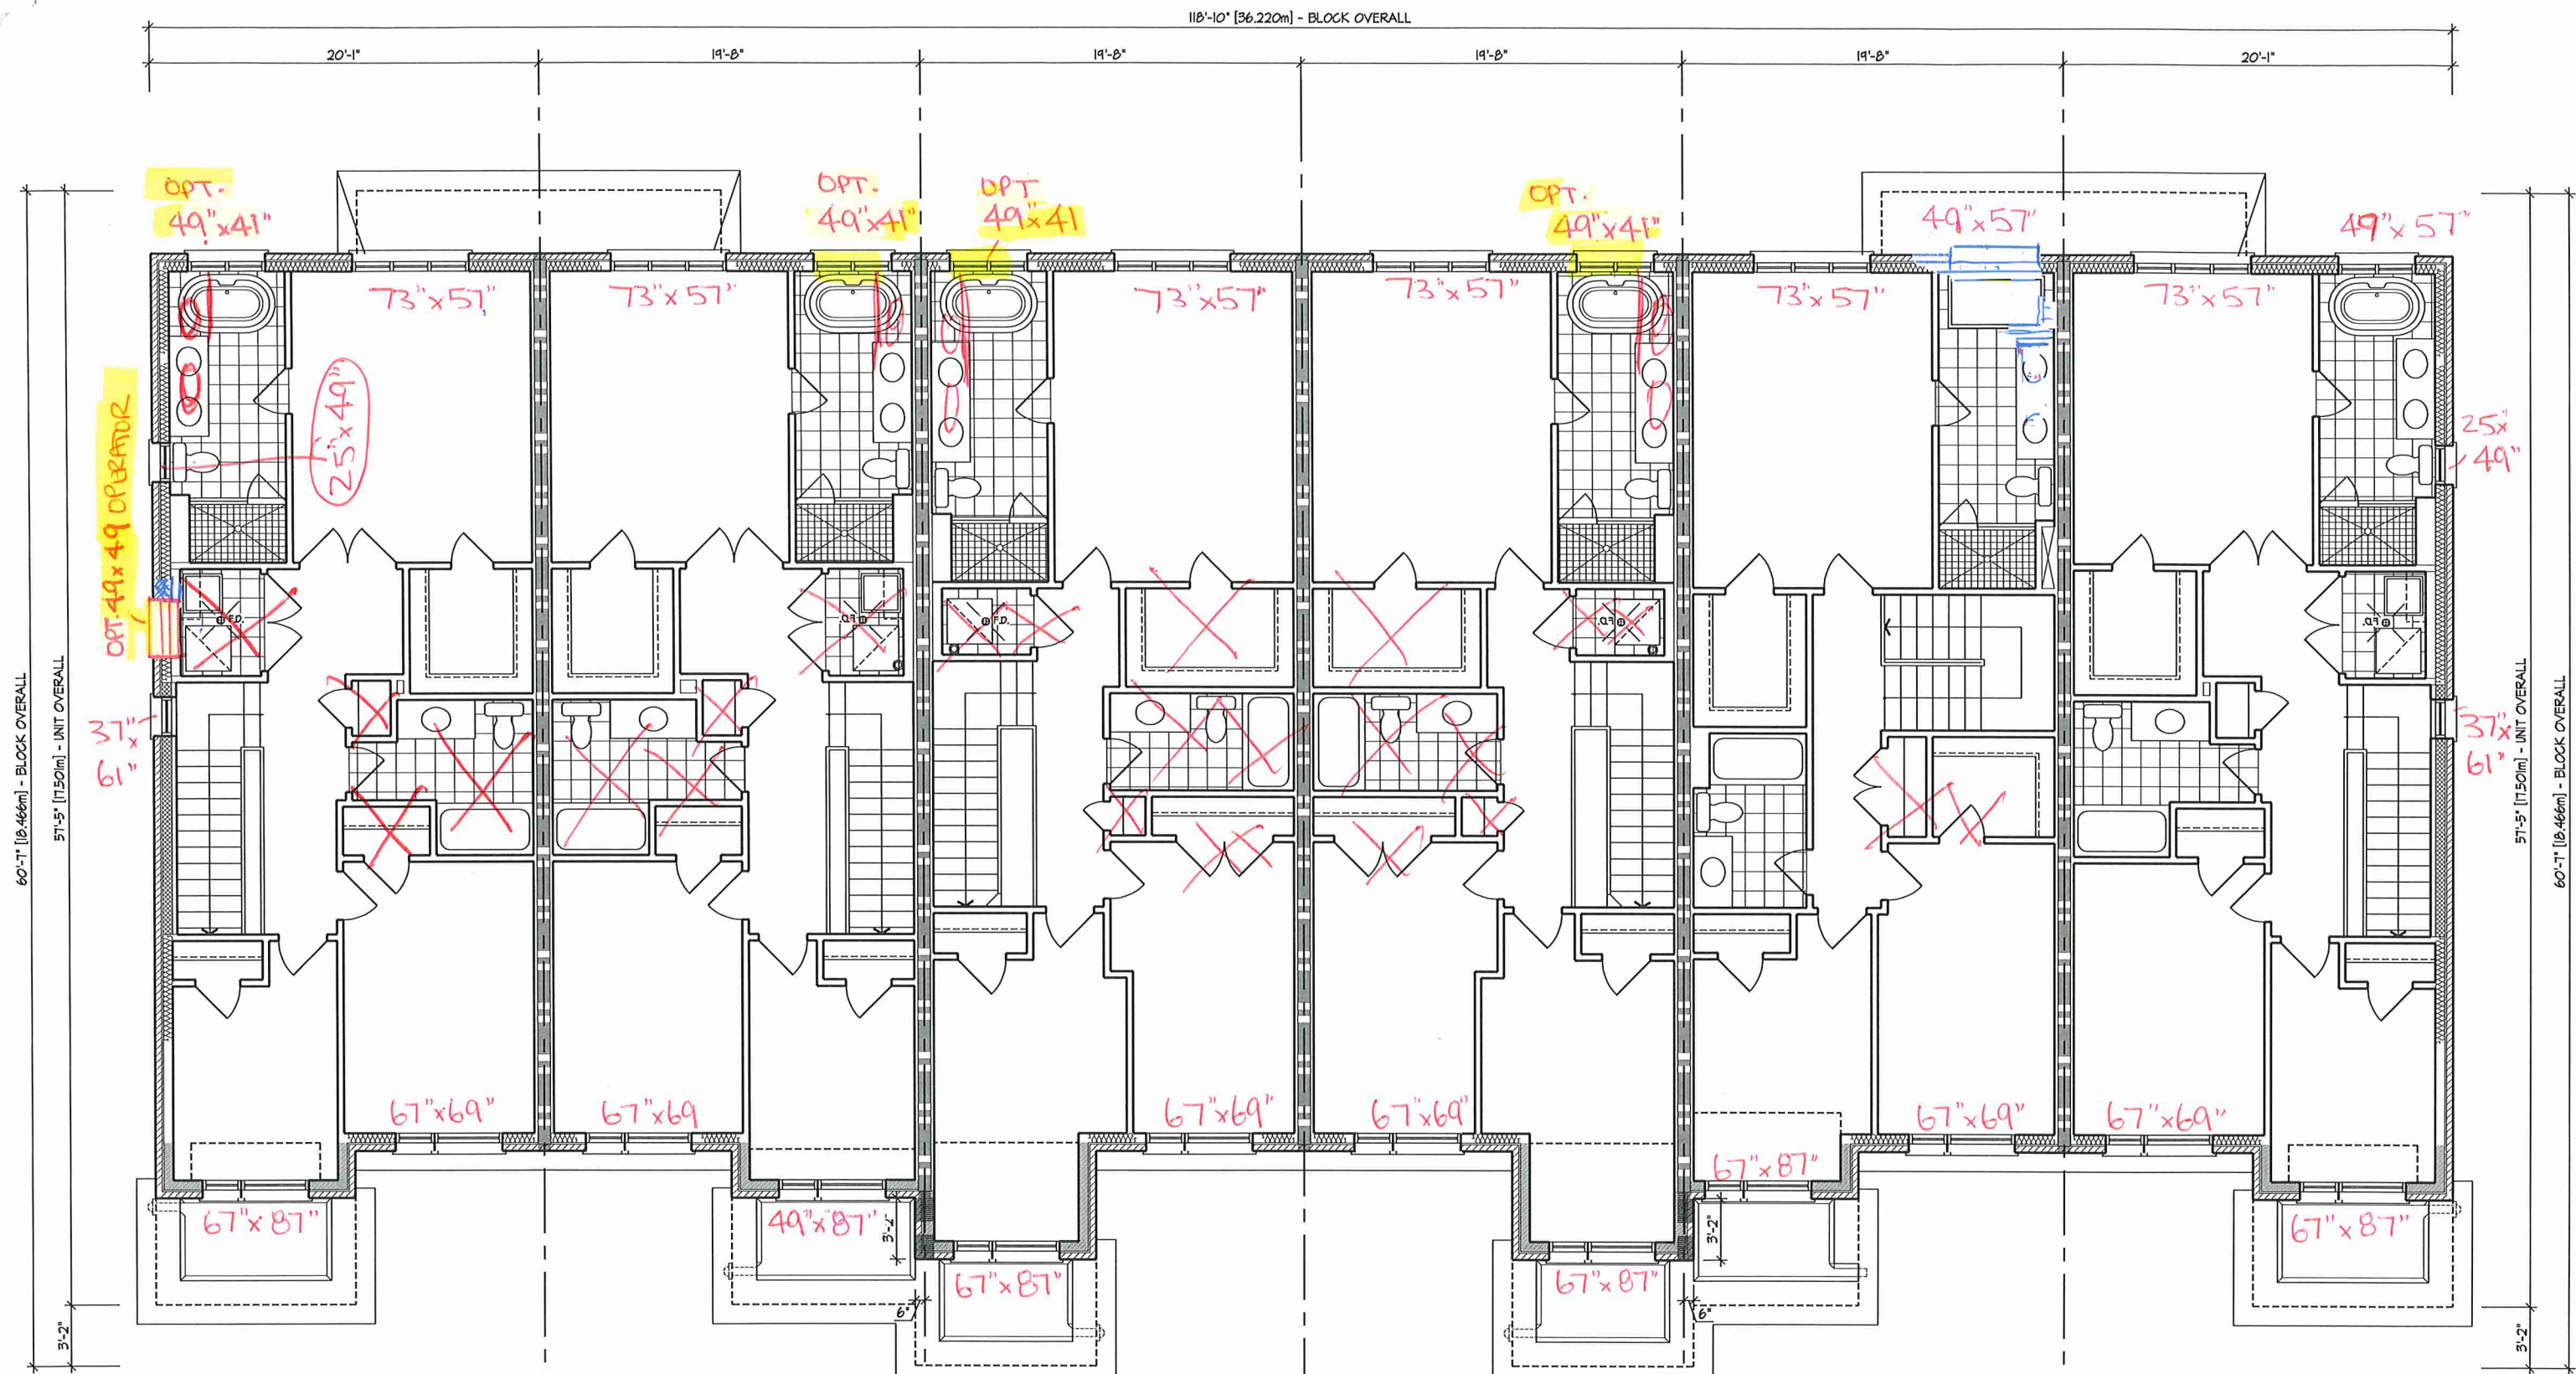

* OPT. 2ND FLOOR PLAN
OFFICE/FLEX ROOM LAYOUT

* OPT 2ND FLOOR
OFFICE/FLEX

* OPT 2ND FLOOR
OFFICE/FLEX

* OPT 2ND FLOOR
OFFICE/FLEX

VOK

62 2009-END
234 EL. 'B'

63 2009
234 EL. 'B' (REV)

64 2008
234 EL. 'B'

65 2008
234 EL. 'B' (REV)

66 2007
234 EL. 'B2'


67 2009-END
234 EL. 'B' (REV)

SECOND FLOOR PLAN





REAR ELEVATION

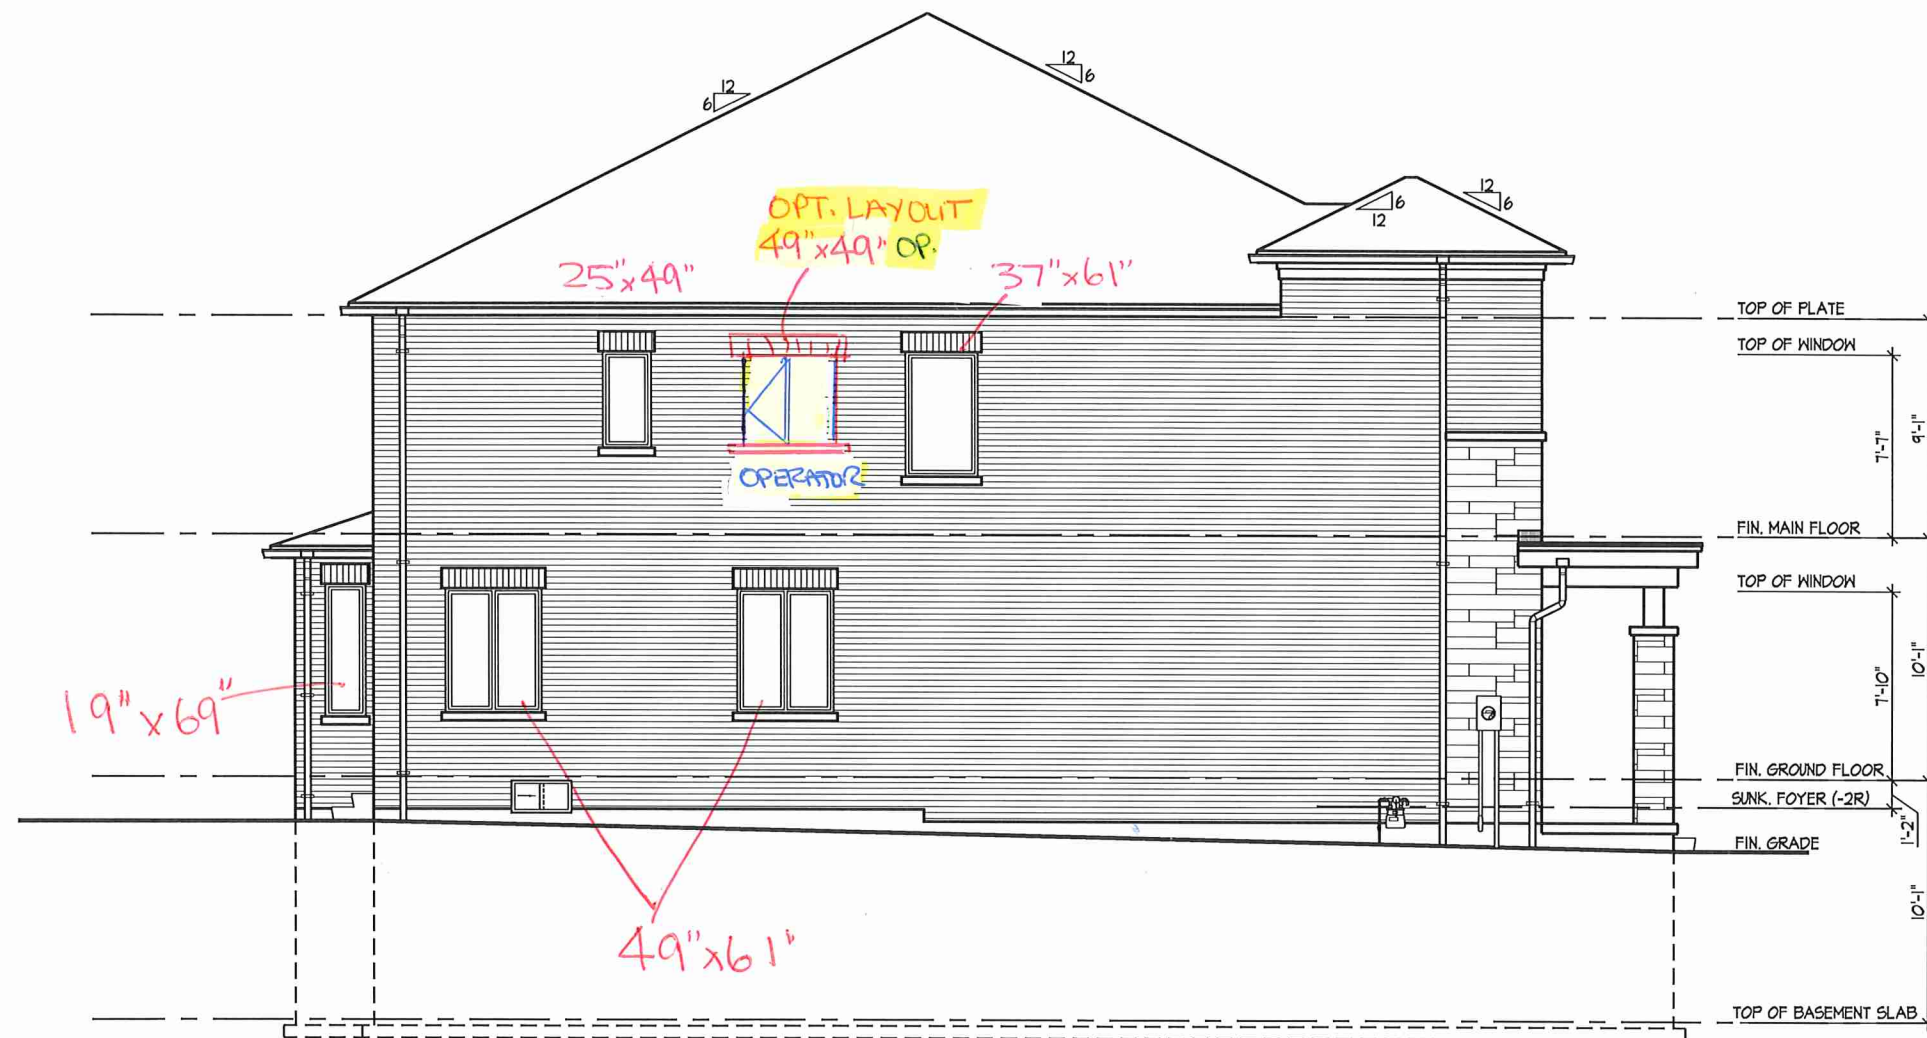


62 2009-END
234 EL. 'B'

LEFT SIDE ELEVATION



67 2009-END
234 EL. 'B' (REV)

RIGHT SIDE ELEVATION

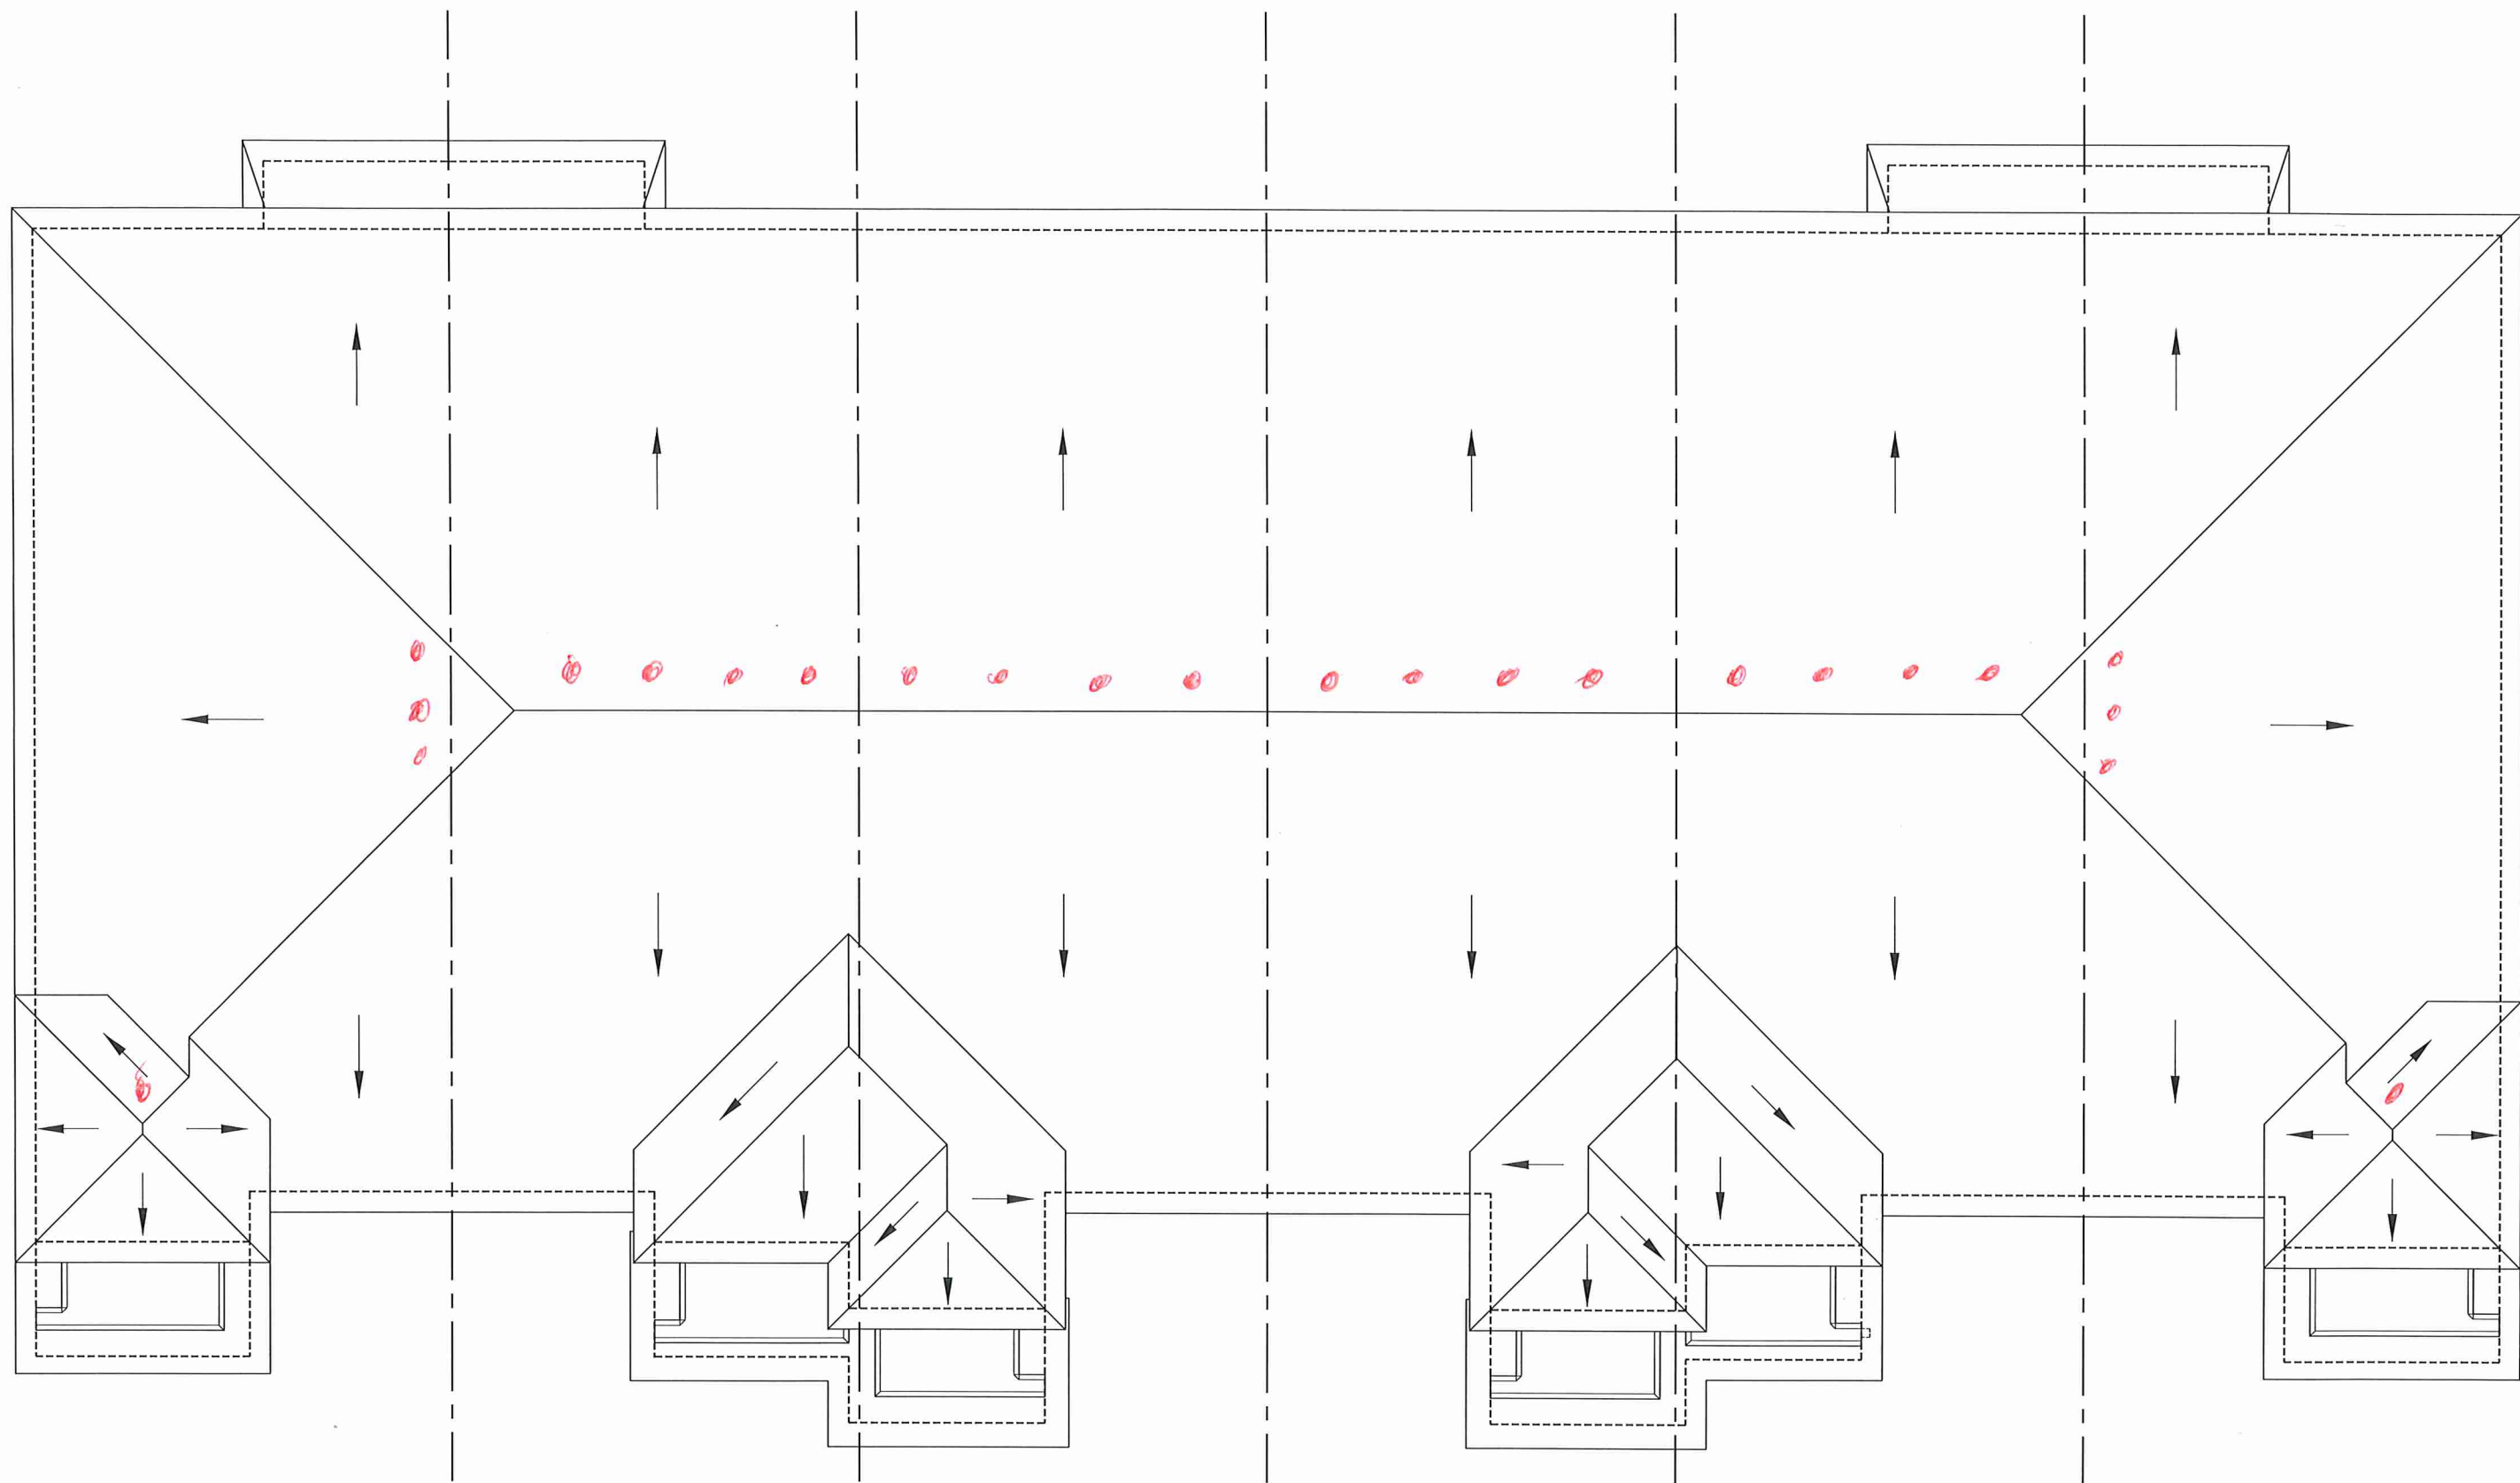

62 2009-END
234 EL. 'B'

63 2009
234 EL. 'B' (REV)

64 2008
234 EL. 'B'

65 2008
234 EL. 'B' (REV)

66 2007
234 EL. 'B2'

67 2009-END
234 EL. 'B' (REV)

ROOF PLAN