


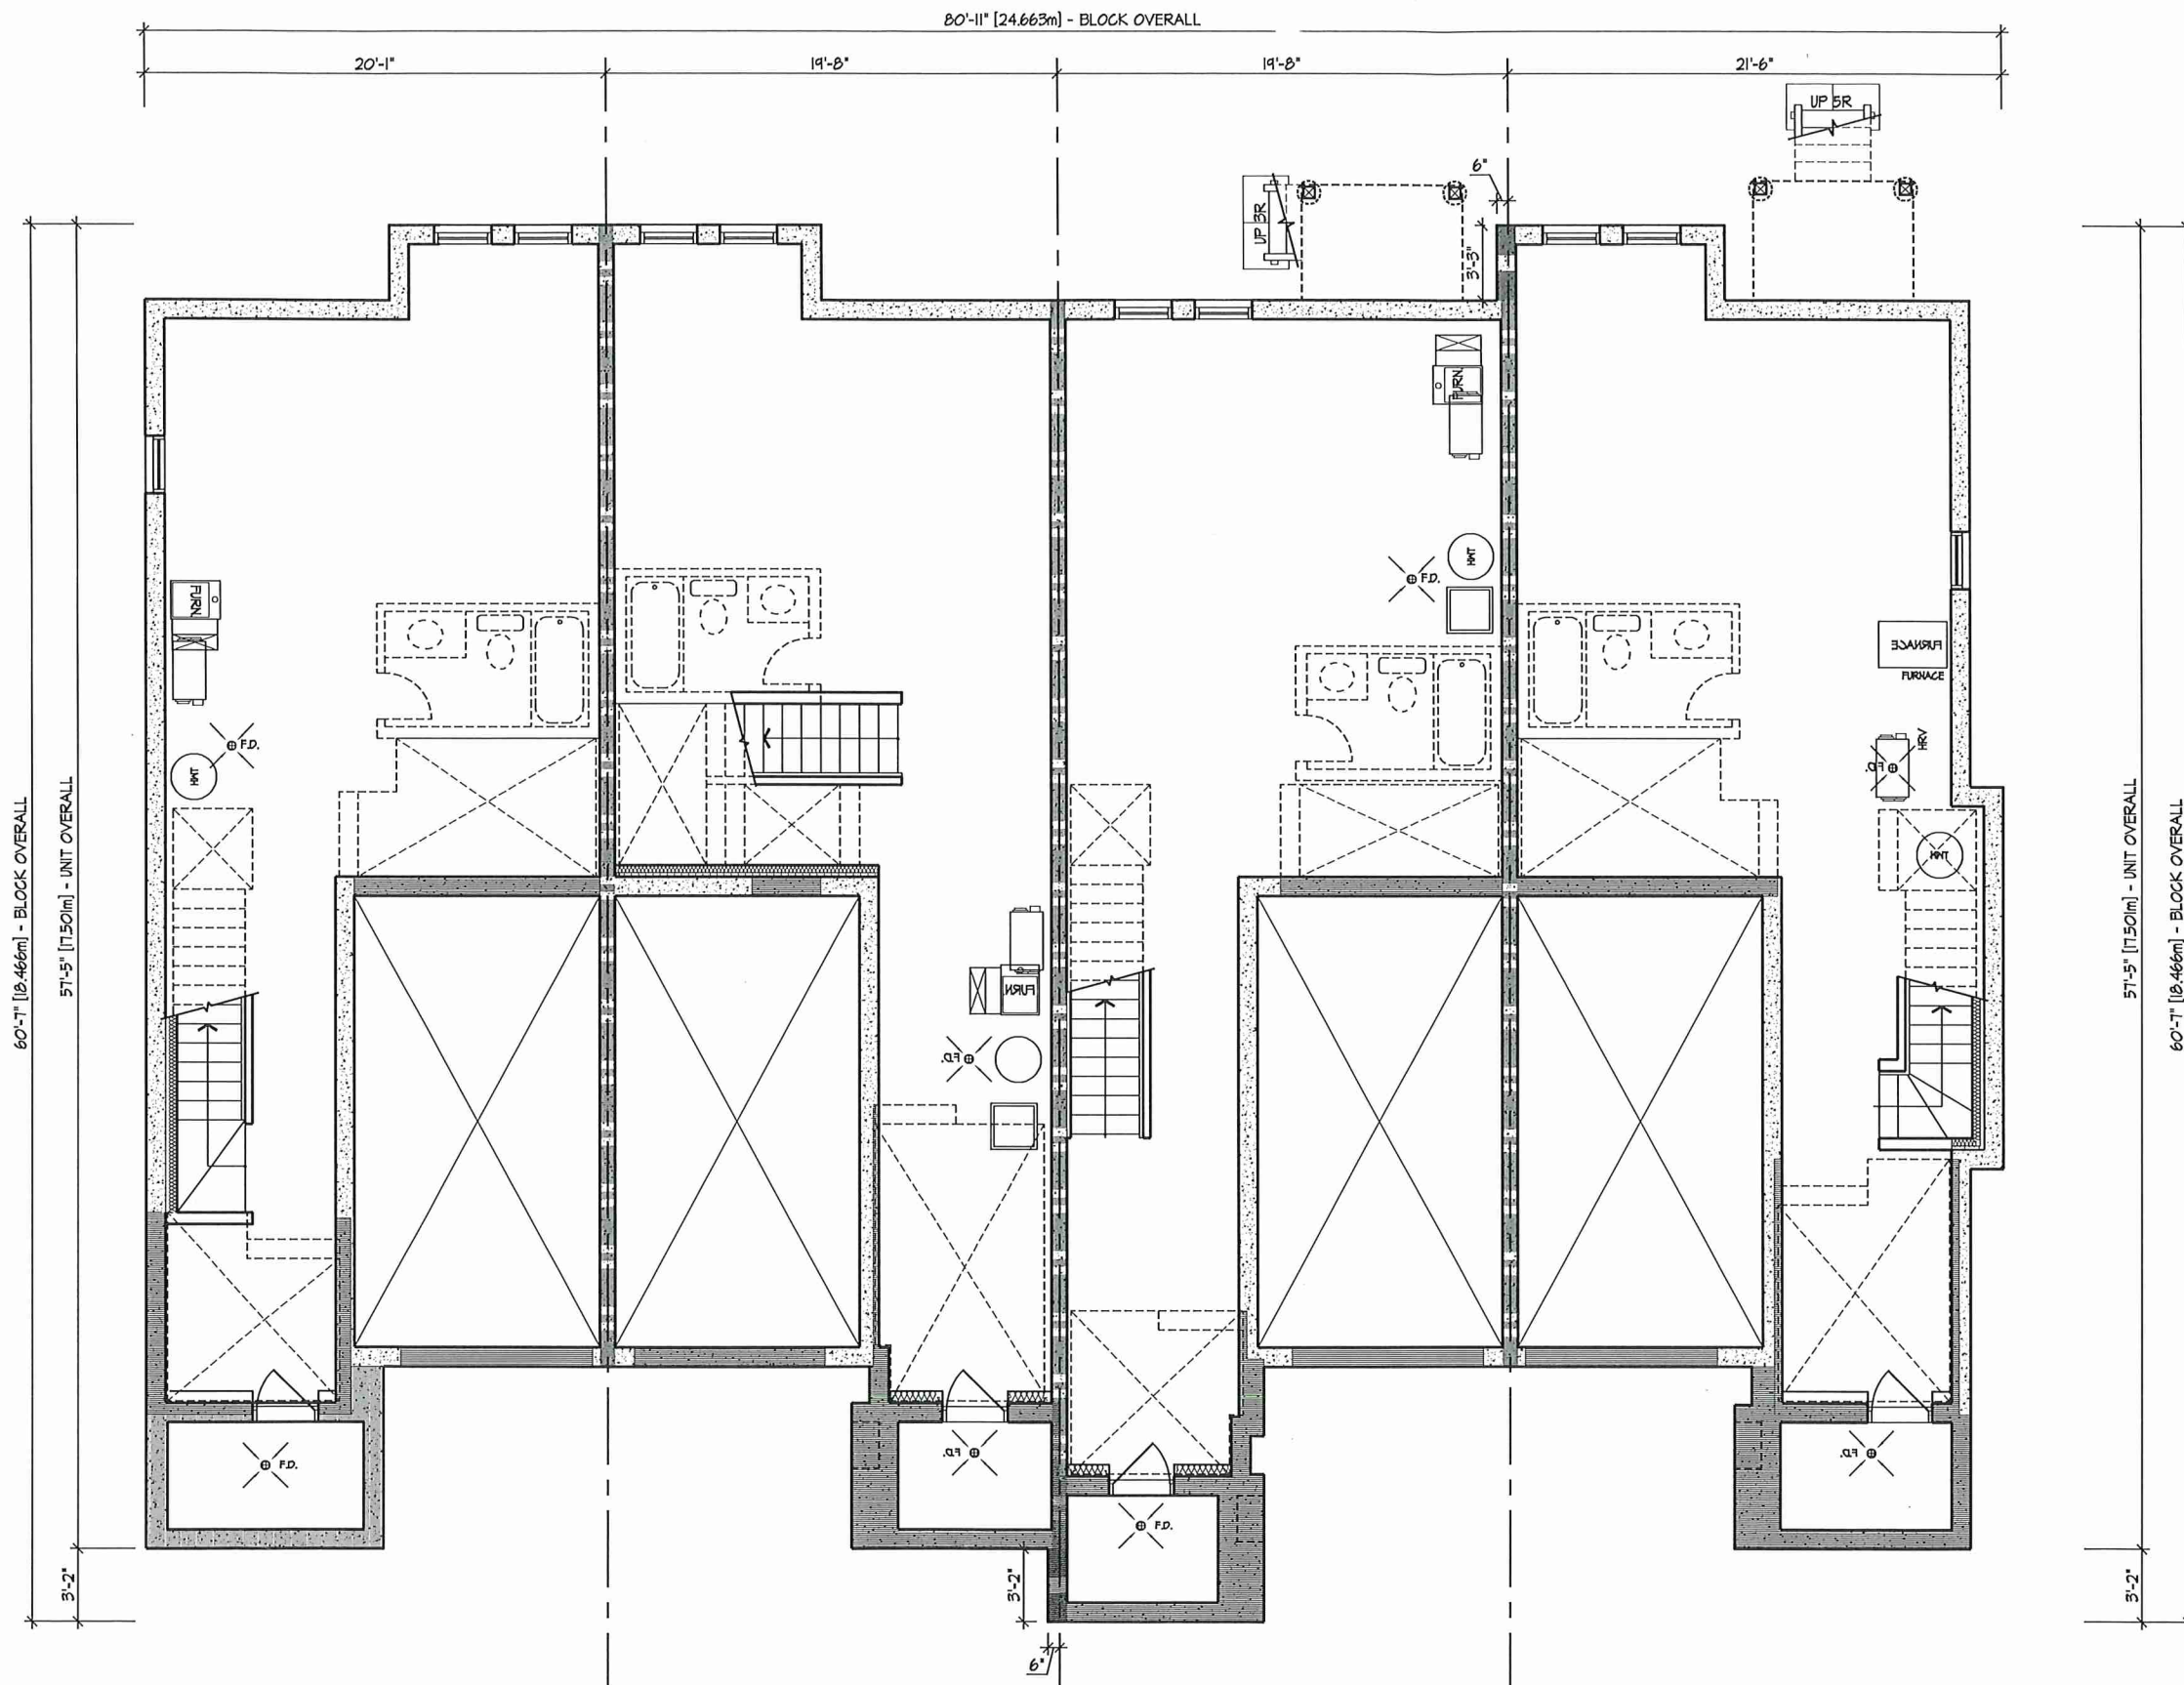

58 2009-END
232 EL. 'B'


57 2007
232 EL. 'B1' (REV)

56 2008
232 EL. 'B'

55 2010-FLANKAGE
232 EL. 'B' (REV)

BASEMENT PLAN

Buk 232 - office copy

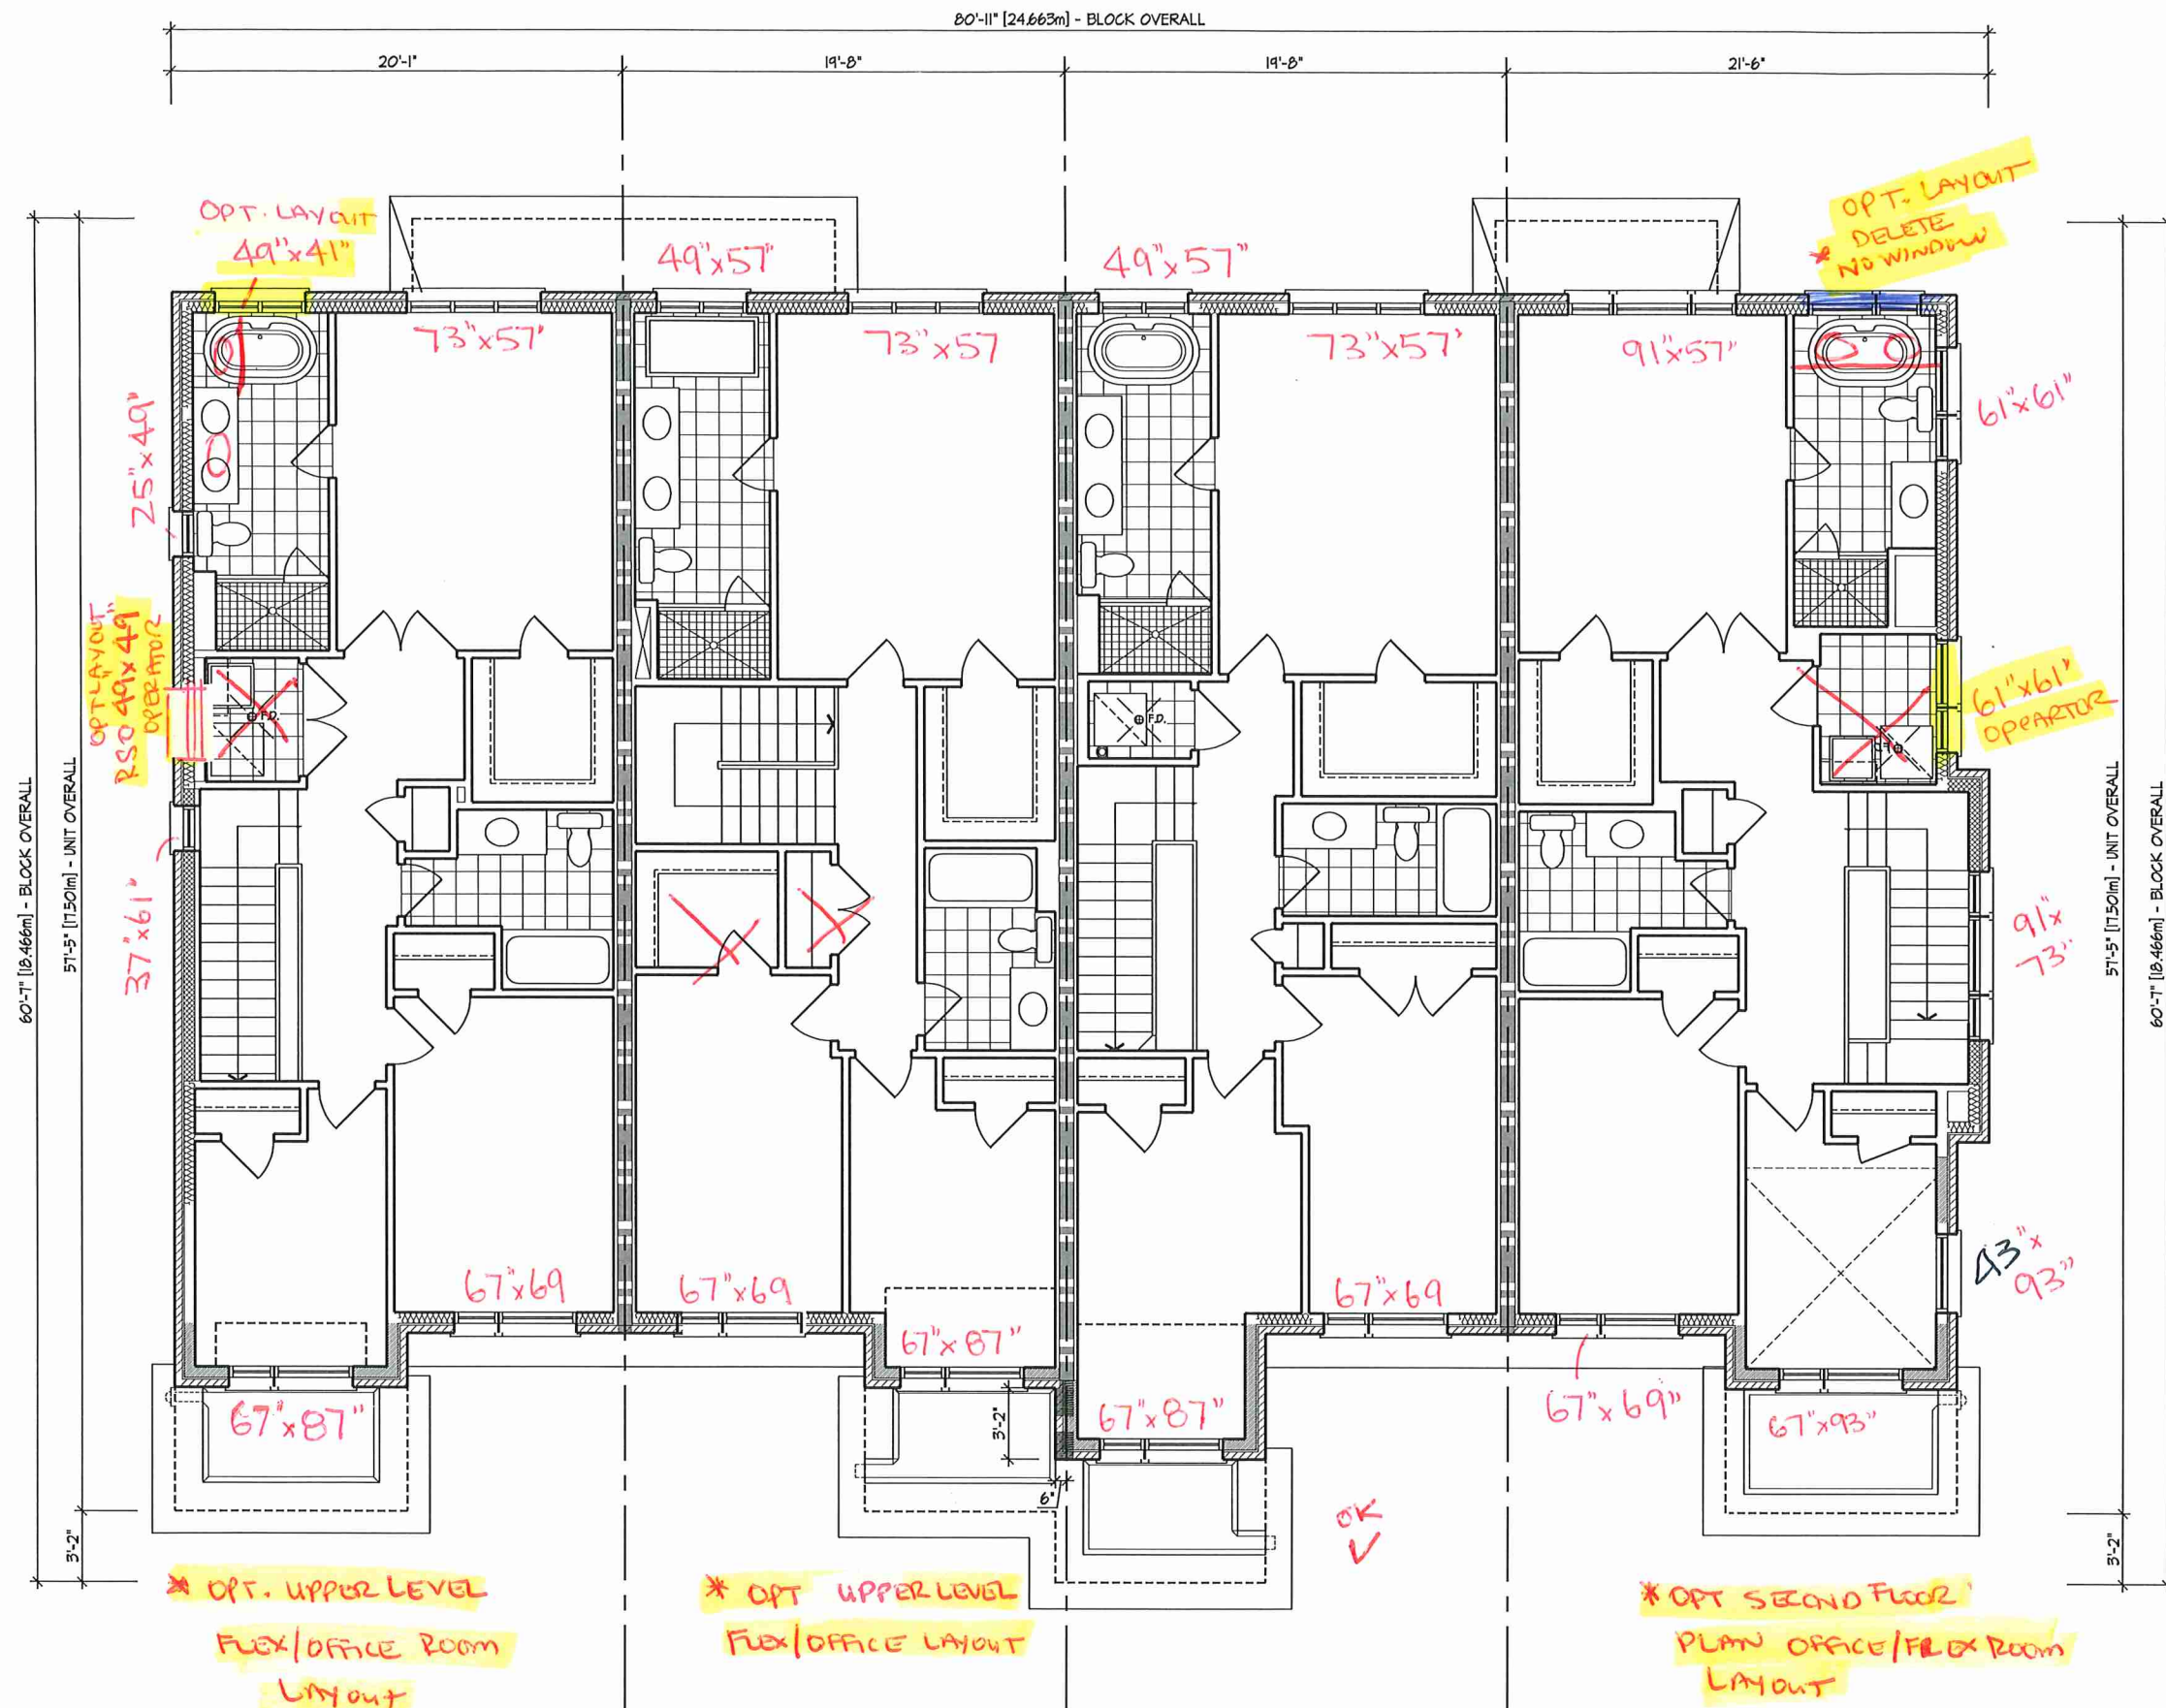

58 2009-END
232 EL. 'B'

57 2007
232 EL. 'B' (REV)

56 2008
232 EL. 'B'

55 2010-FLANKAGE
232 EL. 'B' (REV)

SECOND FLOOR PLAN








58 2009-END WITH OPT 2ND FLOOR OFFICE FLEX ROOM
232 EL. 'B'

LEFT SIDE ELEVATION



55 2010-FLANKAGE
232 EL. 'B' (REV)

FLANKAGE ELEVATION

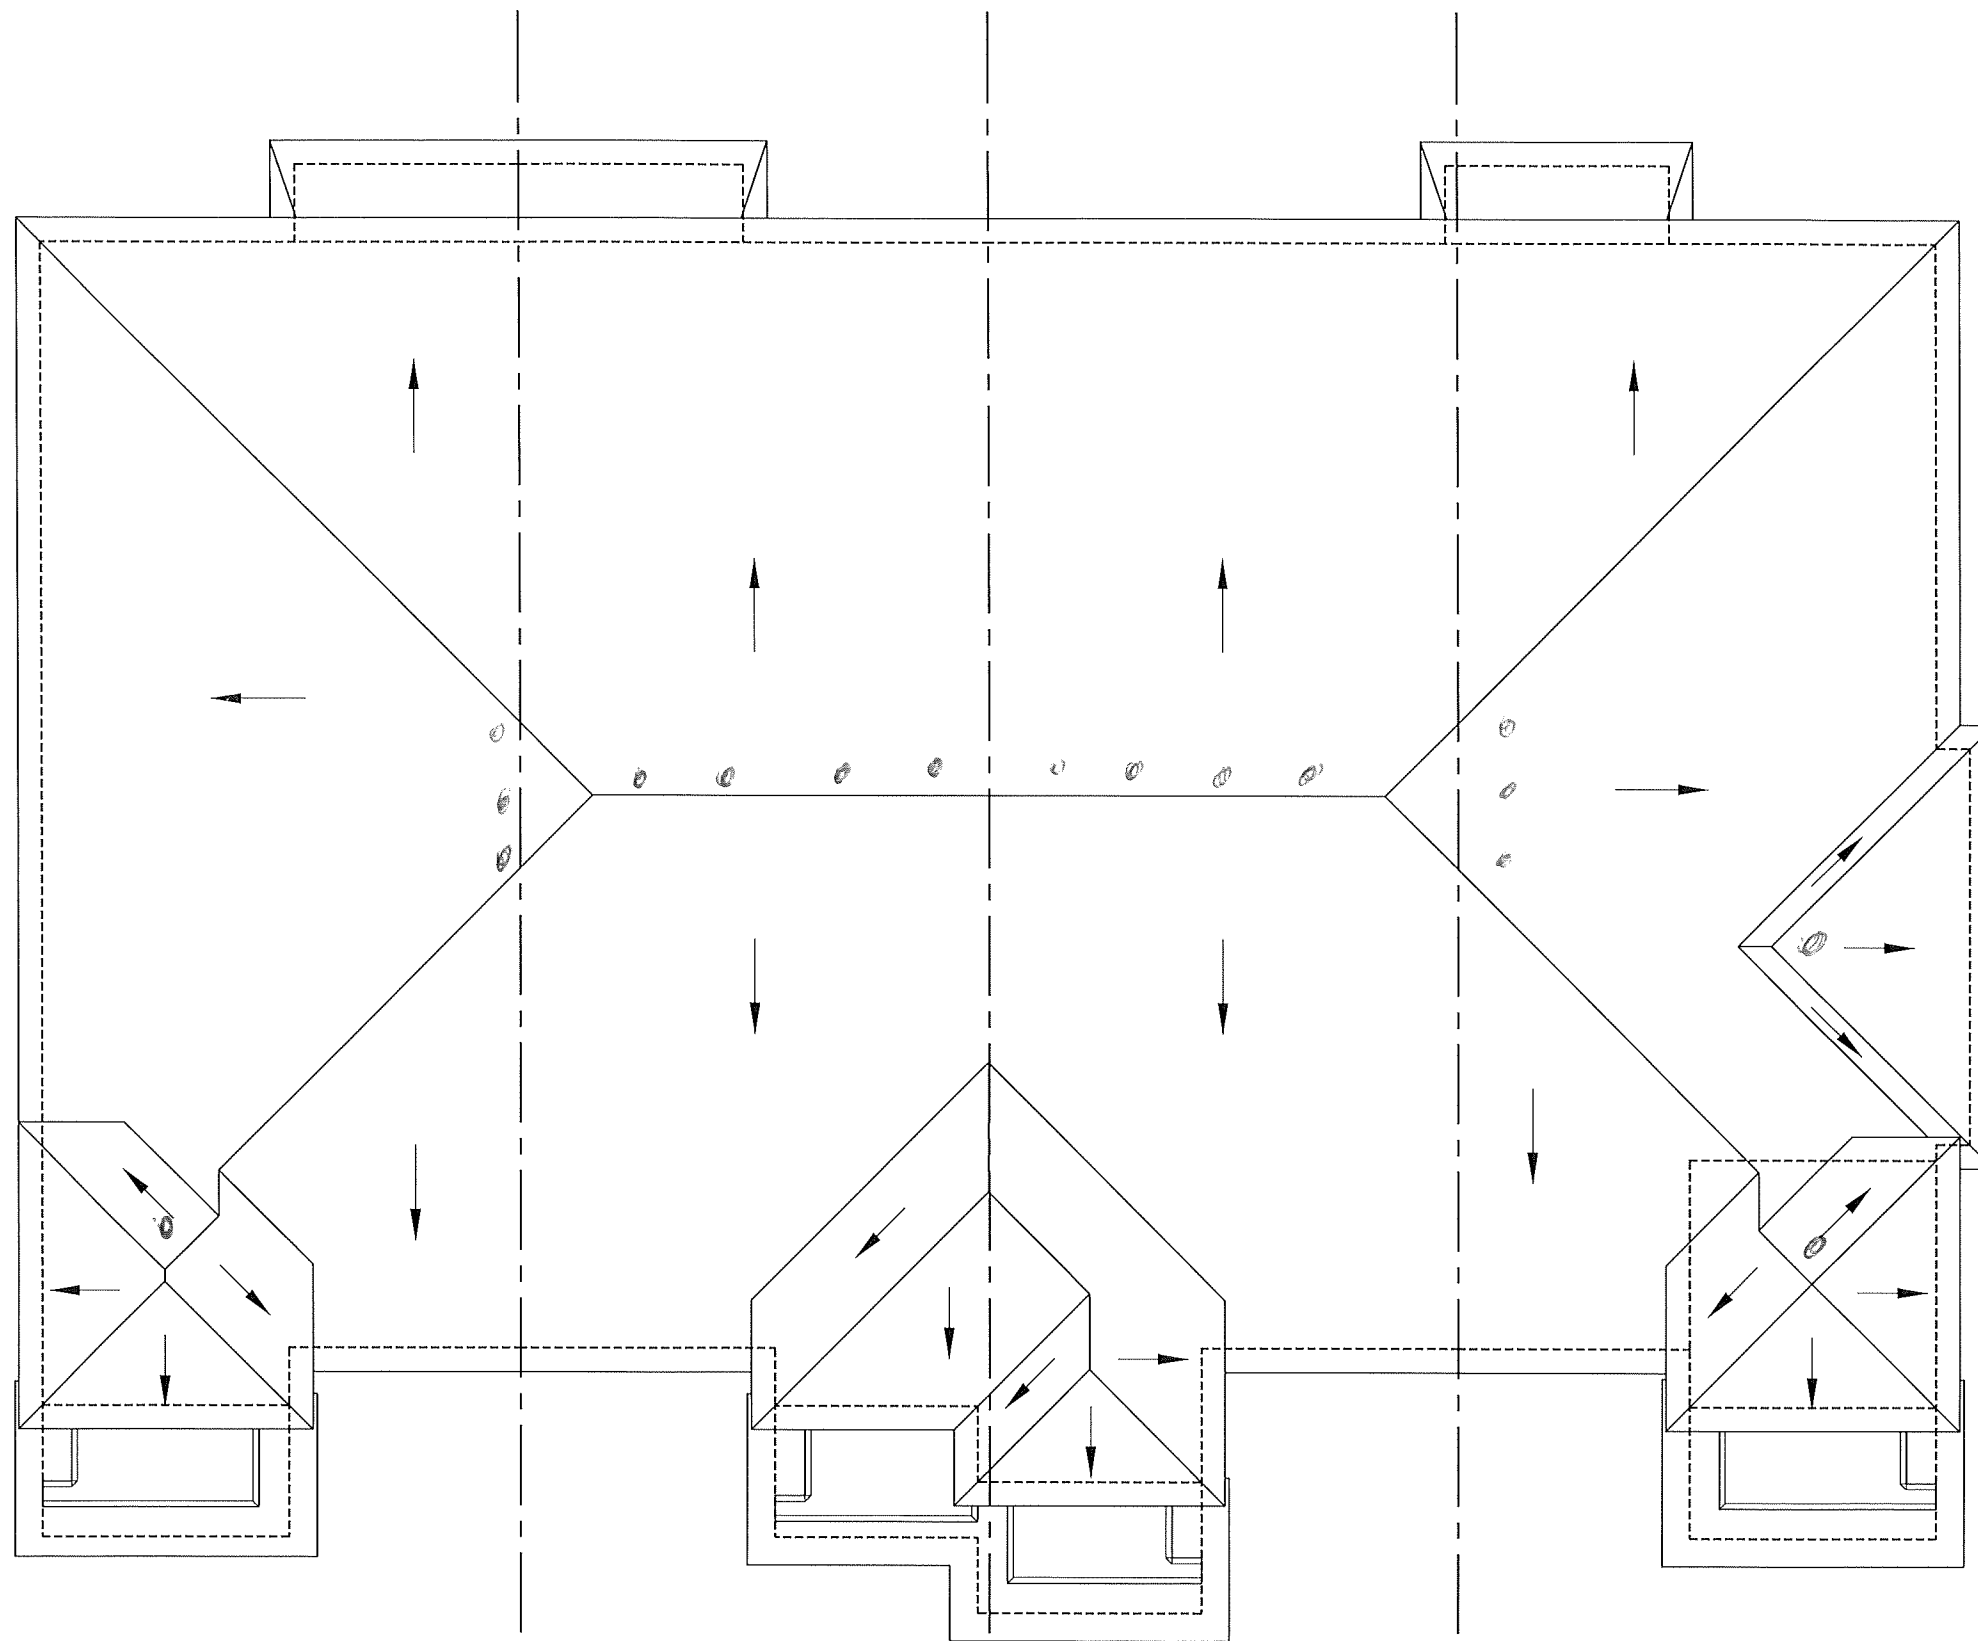

58 2009-END
232 EL. 'B'

57 2007
232 EL. 'B1' (REV)

56 2008
232 EL. 'B'

55 2010-FLANKAGE
232 EL. 'B' (REV)

ROOF PLAN