


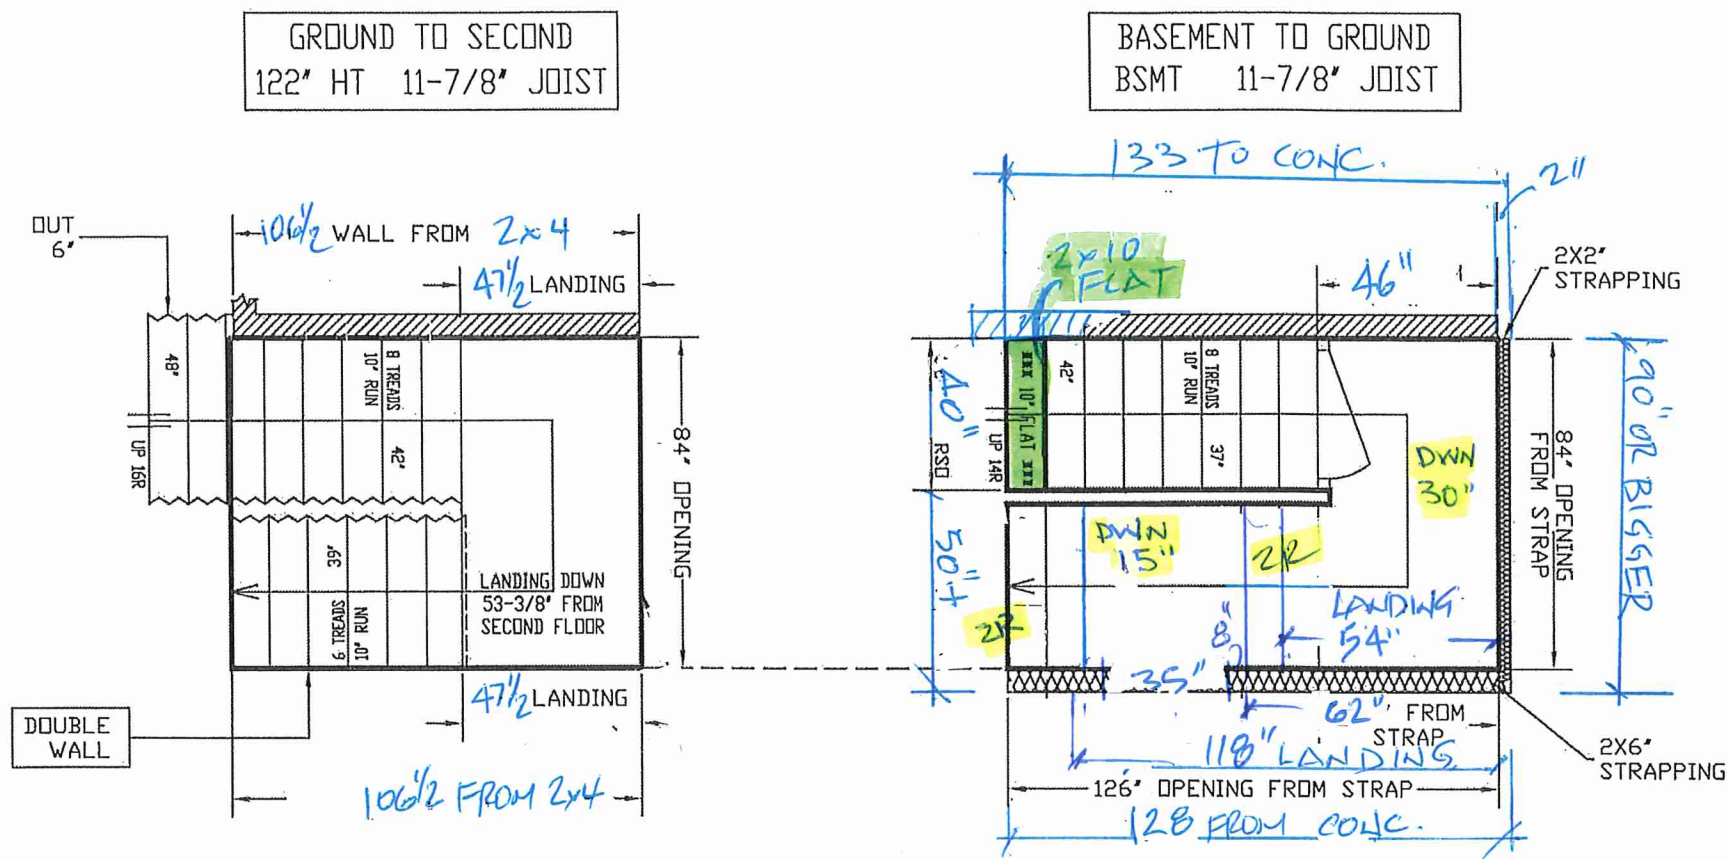

STAIRS LINE UP BY
PARTY WALL & GARAGE
WALL

ALL OPENINGS ARE ALLOWED
FOR 1 LAYER OF DRY WALL.
ANY ADDITIONAL LAYERS MUST
BE ALLOWED BY CARPENTERS

ASK FOR A SPECIFIC
RSD IN CASE THE
GRADE CONDITION DIFFERS
FROM THIS DRAWING

2" CONC. LEDGE
IN GARAGE



GARAGE RIGHT >

ALPHA STAIRS AND RAILINGS INC. Quality To Step Up To	ALL LANDINGS TO BE SUPPLIED AND SUPPORTED BY OTHERS UNLESS SPECIFIED ABOVE ANY STRAPPING ALLOWANCES TO BE COMPENSATED BY CARPENTERS ALL STAIR DIMENSIONS MAY BE MODIFIED FROM ORIGINAL BLUE PRINTS OR SPECS AS SUPPLIED TO ALPHA STAIRS AND RAILINGS INC. MEASUREMENTS SHOWN ON LAYOUTS ARE REQUIRED TO INSTALL OUR STAIRS. ANY PROBLEM WITH HEADROOM OR STRAPPING ALLOWANCES, ALPHA STAIRS AND RAILINGS INC. WILL NOT BE RESPONSIBLE. STAIR LAYOUTS SHOULD BE CHECKED BY CARPENTERS OR SITE SUPERS TO MAKE SURE THERE ARE NO DISCREPANCIES BEFORE PROCEEDING WITH CONSTRUCTION				SITE CENTREFIELD	DRAWN BY NAME PARAMJEET	DATE APRIL 9, 2025
	ALPHA STAIRS AND RAILINGS INC. 3770 NASHUA DRIVE, UNIT 3 MISSISSAUGA, ONTARIO L4V 1M6 TEL: (905) 694-9556 www.alpastairs.com		LOT #	Model 20-7 (W/FIN. BSMT)	CLIENT ROYAL PINE HOMES		LAYOUT #
					SCALE: 1/35		

200
CU 2096


BLK 232 TH # 57 PORTAL

L1 = 2x2x8
L3 = 2x2x10
L5 = 2x2x12
B1 = 3x2x8
B2 = 4x2x8
B3 = 3x2x10
B4 = 4x2x10
B5 = 3x2x12

REFER TO FLOOR JOIST MANUFACTURER'S DRAWINGS FOR LAYOUT, SPACING, BLOCKING & STRAPPING REQUIREMENTS, INSTALLATION DETAILS AND HANGER SIZES, & SUBFLOOR THICKNESS	APPROX. LOCATION OF FURNACE AND HOT WATER TANK
	PROVIDE SOLID WOOD BLOCKING @ 24" O.C. FOR FIRST JOIST SPAN WHEN PARALLEL W/ EXTERIOR WALL

BK 232-57

BASEMENT PLAN,
EL. 'A' & 'B'

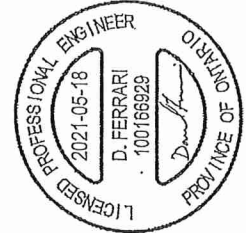

FOR STRUCTURAL ONLY
NOT INCLUDING ENGINEERED
FLOOR OR ROOF SYSTEM


BASEMENT PLAN, ELEV. 'A' & 'B'



ROYAL PINE HOMES - 216102
'CENTREFIELD', WEST GORMLEY, RICHMOND HILL, ON. UNIT 2007

Drawn By: KM
Checked By: DS
Scale: 3/16" = 1'-0"
File Number: 216102WT2007
Page Number: 2 of 16

HE UNDERSIGNED HAS REVIEWED AND TAKES RESPONSIBILITY FOR THIS DESIGN AND HAS THE QUALIFICATIONS AND MEETS THE REQUIREMENTS SET OUT IN THE ONTARIO BUILDING CODE TO BE A DESIGNER.
JEROME R. SANTOS
SIGNATURE
37308
BON
19685
HUNT DESIGN ASSOCIATES INC.
All drawings specifications related documents and design are the copyright property of Hunt Design Associates (H.D.A.). Reproduction of this property in whole or in part is strictly prohibited without H.D.A.'s written permission (H.D.A. assumes no responsibility or liability for this property unless it bears the appropriate BCK number and original signature.)

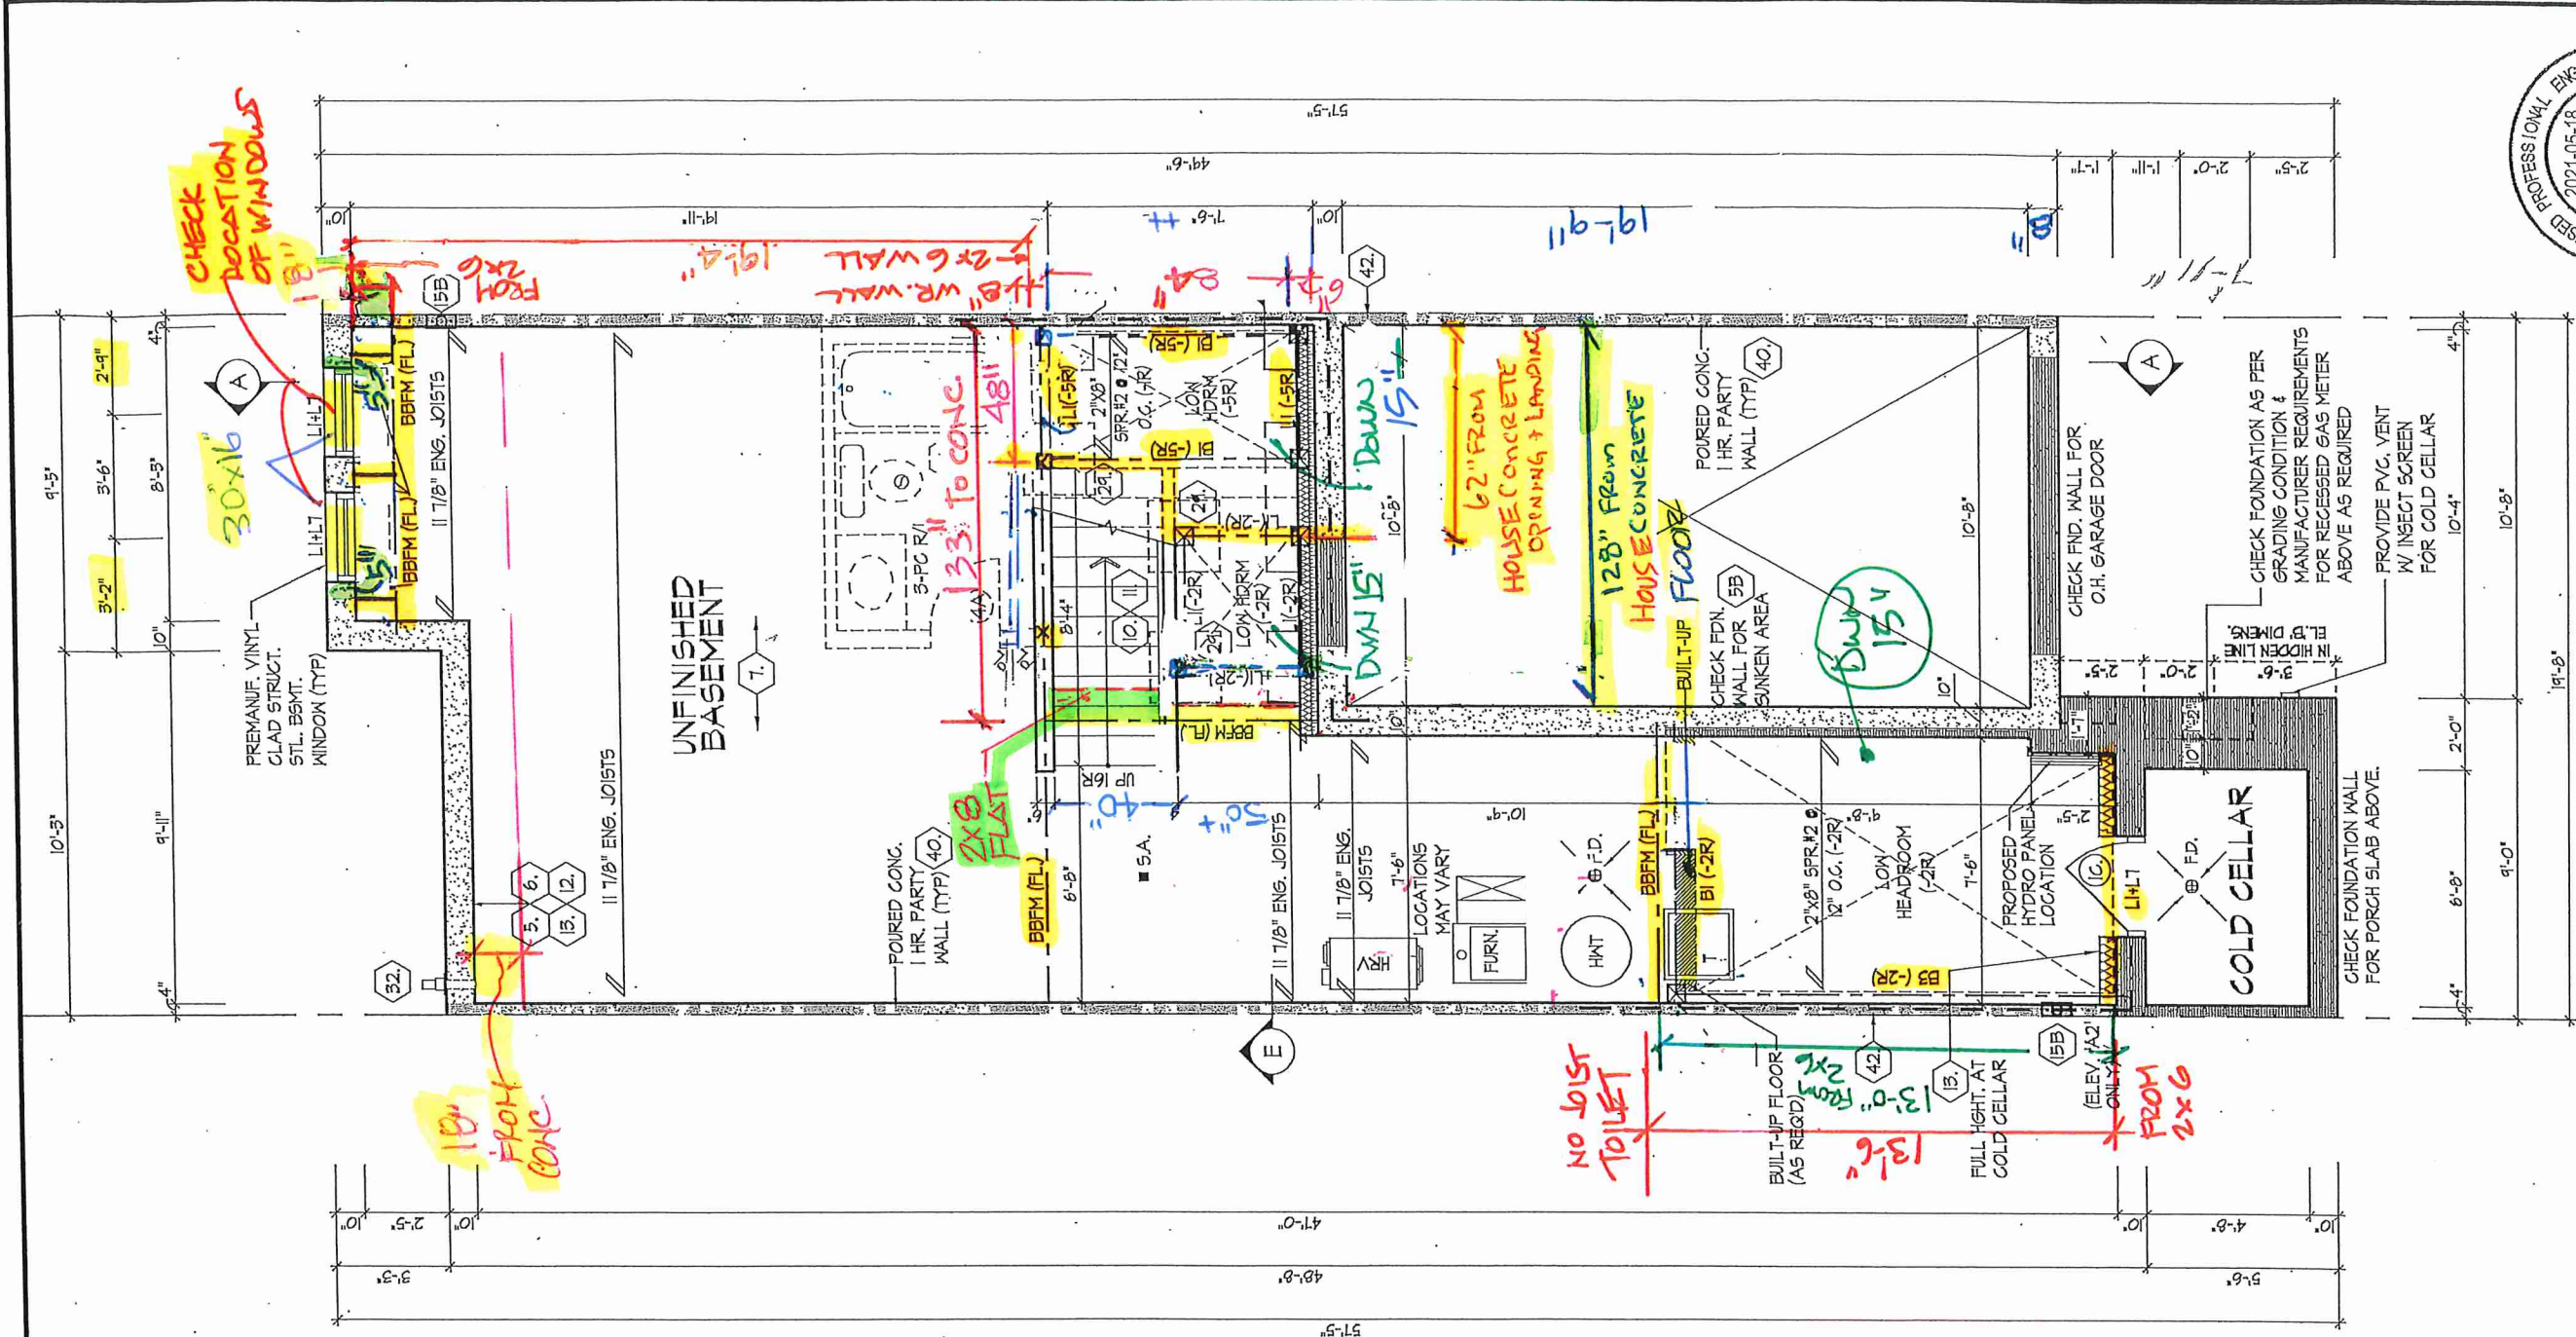


BASEMENT PLAN,
EL. 'A' & 'B'

BASEMENT PLAN, ELEV. 'A' & 'B'

ROYAL PINE HOMES - 216102
'CENTREFIELD', WEST GORMLEY, RICHMOND HILL, ON. UNIT 2007

Drawn By: KM
Checked By: DS
Scale: 3/16" = 1'-0"
File Number: 216102WT2007
Page Number: 2 of 16

HE UNDERSIGNED HAS REVIEWED AND TAKES RESPONSIBILITY FOR THIS DESIGN AND HAS THE QUALIFICATIONS AND MEETS THE REQUIREMENTS SET OUT IN THE ONTARIO BUILDING CODE TO BE A DESIGNER.
JEROME R. SANTOS
SIGNATURE
37308
BON
19685
HUNT DESIGN ASSOCIATES INC.
All drawings specifications related documents and design are the copyright property of Hunt Design Associates (H.D.A.). Reproduction of this property in whole or in part is strictly prohibited without H.D.A.'s written permission (H.D.A. assumes no responsibility or liability for this property unless it bears the appropriate BCK number and original signature.)

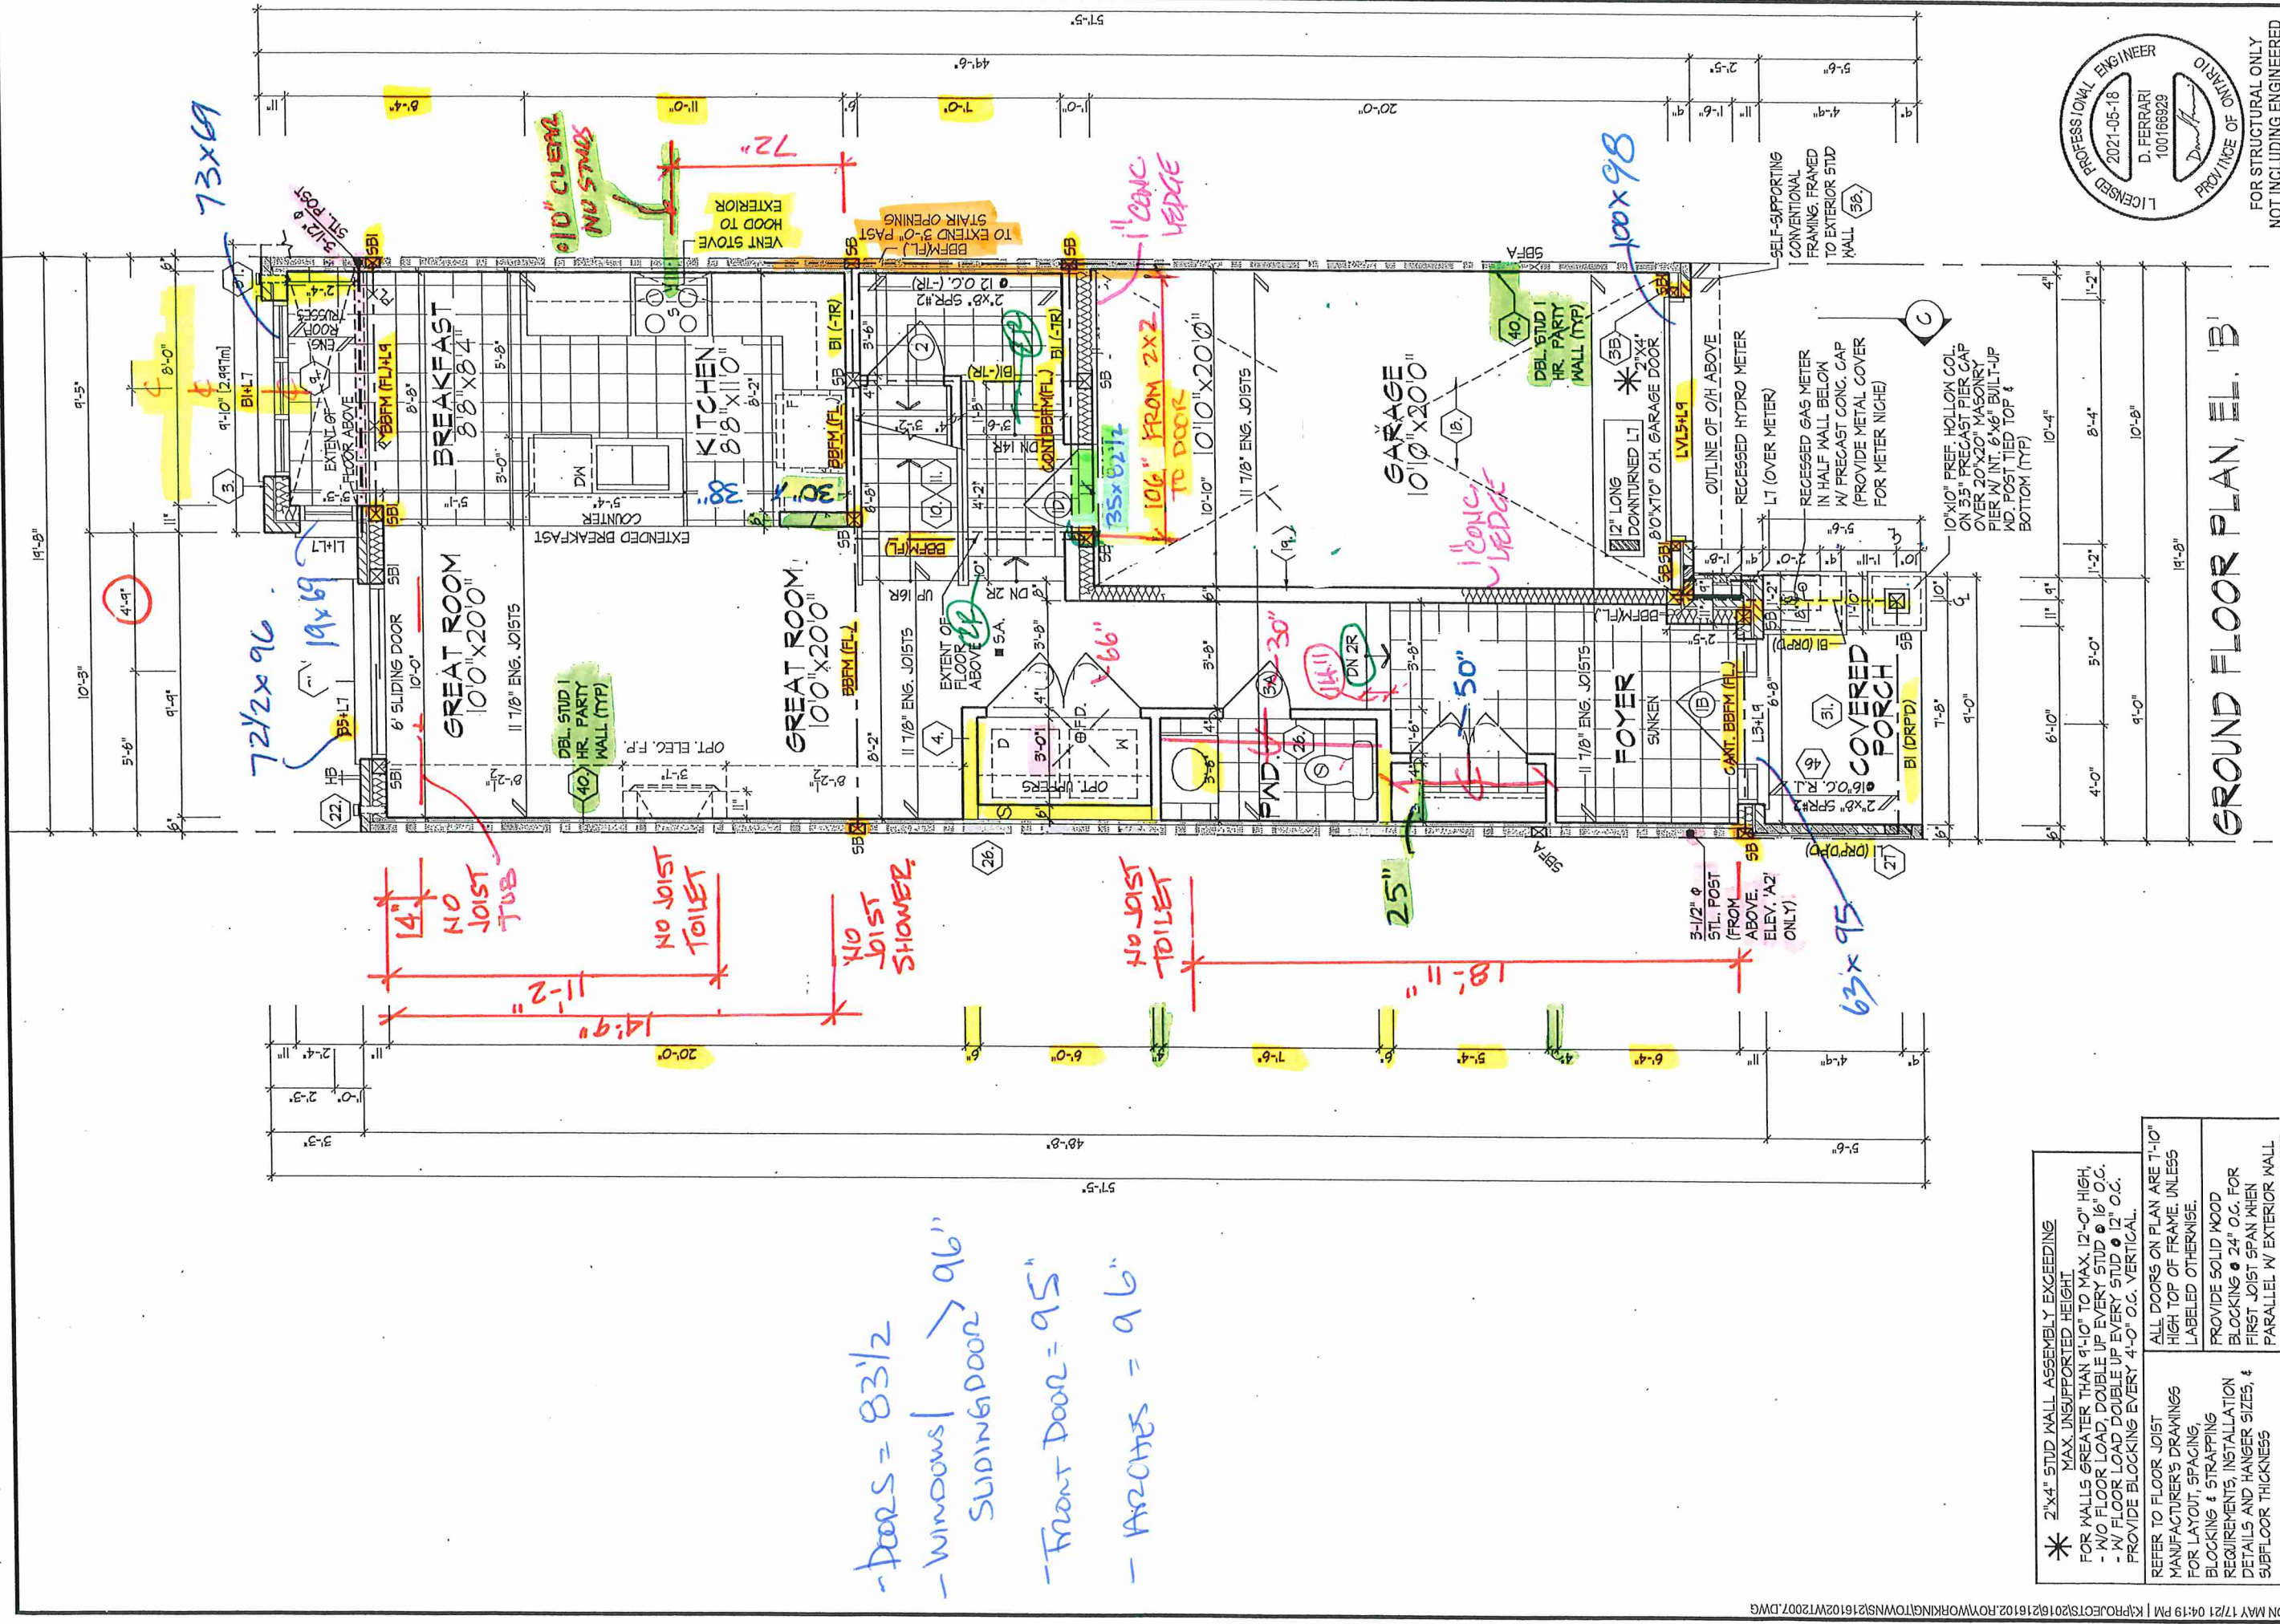

BLK 232-57

GROUND FLOOR PLAN, EL. 'B'

GROUND FLOOR PLAN, EL. 'B'


ROYAL PINE HOMES - 216102
'CENTREFIELD', WEST GORMLEY, RICHMOND HILL, ON. REV.2021.05.11

HUNT
DESIGN ASSOCIATES INC.

THE UNDERSIGNED HAS REVIEWED AND TAKES RESPONSIBILITY FOR THIS DESIGN AND HAS THE QUALIFICATIONS AND MEETS THE REQUIREMENTS SET OUT IN THE ONTARIO BUILDING CODE TO BE A DESIGNER.
Derek R. Santos

REGISTRATION INFORMATION
NAME: Derek R. Santos
SIGNATURE: [Signature]
37308
BOB
19895
www.huntassociates.ca

All drawings specifications related documents and design are the copyright property of Hunt Design Associates (H.D.A.). Reproduction of this property in whole or in part is strictly prohibited without H.D.A.'s written permission (H.D.A. assumes no responsibility or liability for this property unless it bears the appropriate BOB number and original signature).

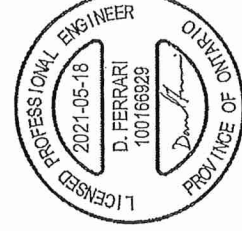

FOR STRUCTURAL ONLY
NOT INCLUDING ENGINEERED
FLOOR OR ROOF SYSTEM

UNIT 2007
REV.2021.05.11

File Number
216102WT2007
Page Number
7 of 16

THE UNDERSIGNED HAS REVIEWED AND TAKES RESPONSIBILITY FOR THIS DESIGN AND HAS THE QUALIFICATIONS AND MEETS THE REQUIREMENTS SET OUT IN THE ONTARIO BUILDING CODE TO BE A DESIGNER.

QUALIFICATION INFORMATION
Derek R. Santos

NAME
REGISTRATION INFORMATION
SIGNATURE
BCN
37308

HUNT DESIGN ASSOCIATES INC.
19695

All drawings specifications related documents and design are the copyright property of Hunt Design Associates H.D.A. Reproduction of this property in whole or in part is strictly prohibited without H.D.A.'s written permission (H.D.A. assumes no responsibility or liability for this property unless it bears the appropriate BCN number and original signature).

ROYAL PINE HOMES - 216102
'CENTREFIELD', WEST GORMLEY, RICHMOND HILL, ON. REV.2021.06.07

File Number
216102WT2007

Page Number
5b of 1c

Scale
3/16"=1'-0"

Drawn By
KM

Checked By
DS

905.737.5133 F 905.737.7526




www.huntdesign.ca

BLK 232-57

20-07 THE LAWRENCE




SECOND FLOOR PLAN, EL.'B1'
OFFICE / FLEX SPACE LAYOUT
ELEVATION 'B2' SIMILAR

REFER TO ROOF TRUSS
MANUFACTURER'S DRAWINGS
FOR LAYOUT, SPACING,
INSTALLATION DETAILS AND
HANGER SIZES.

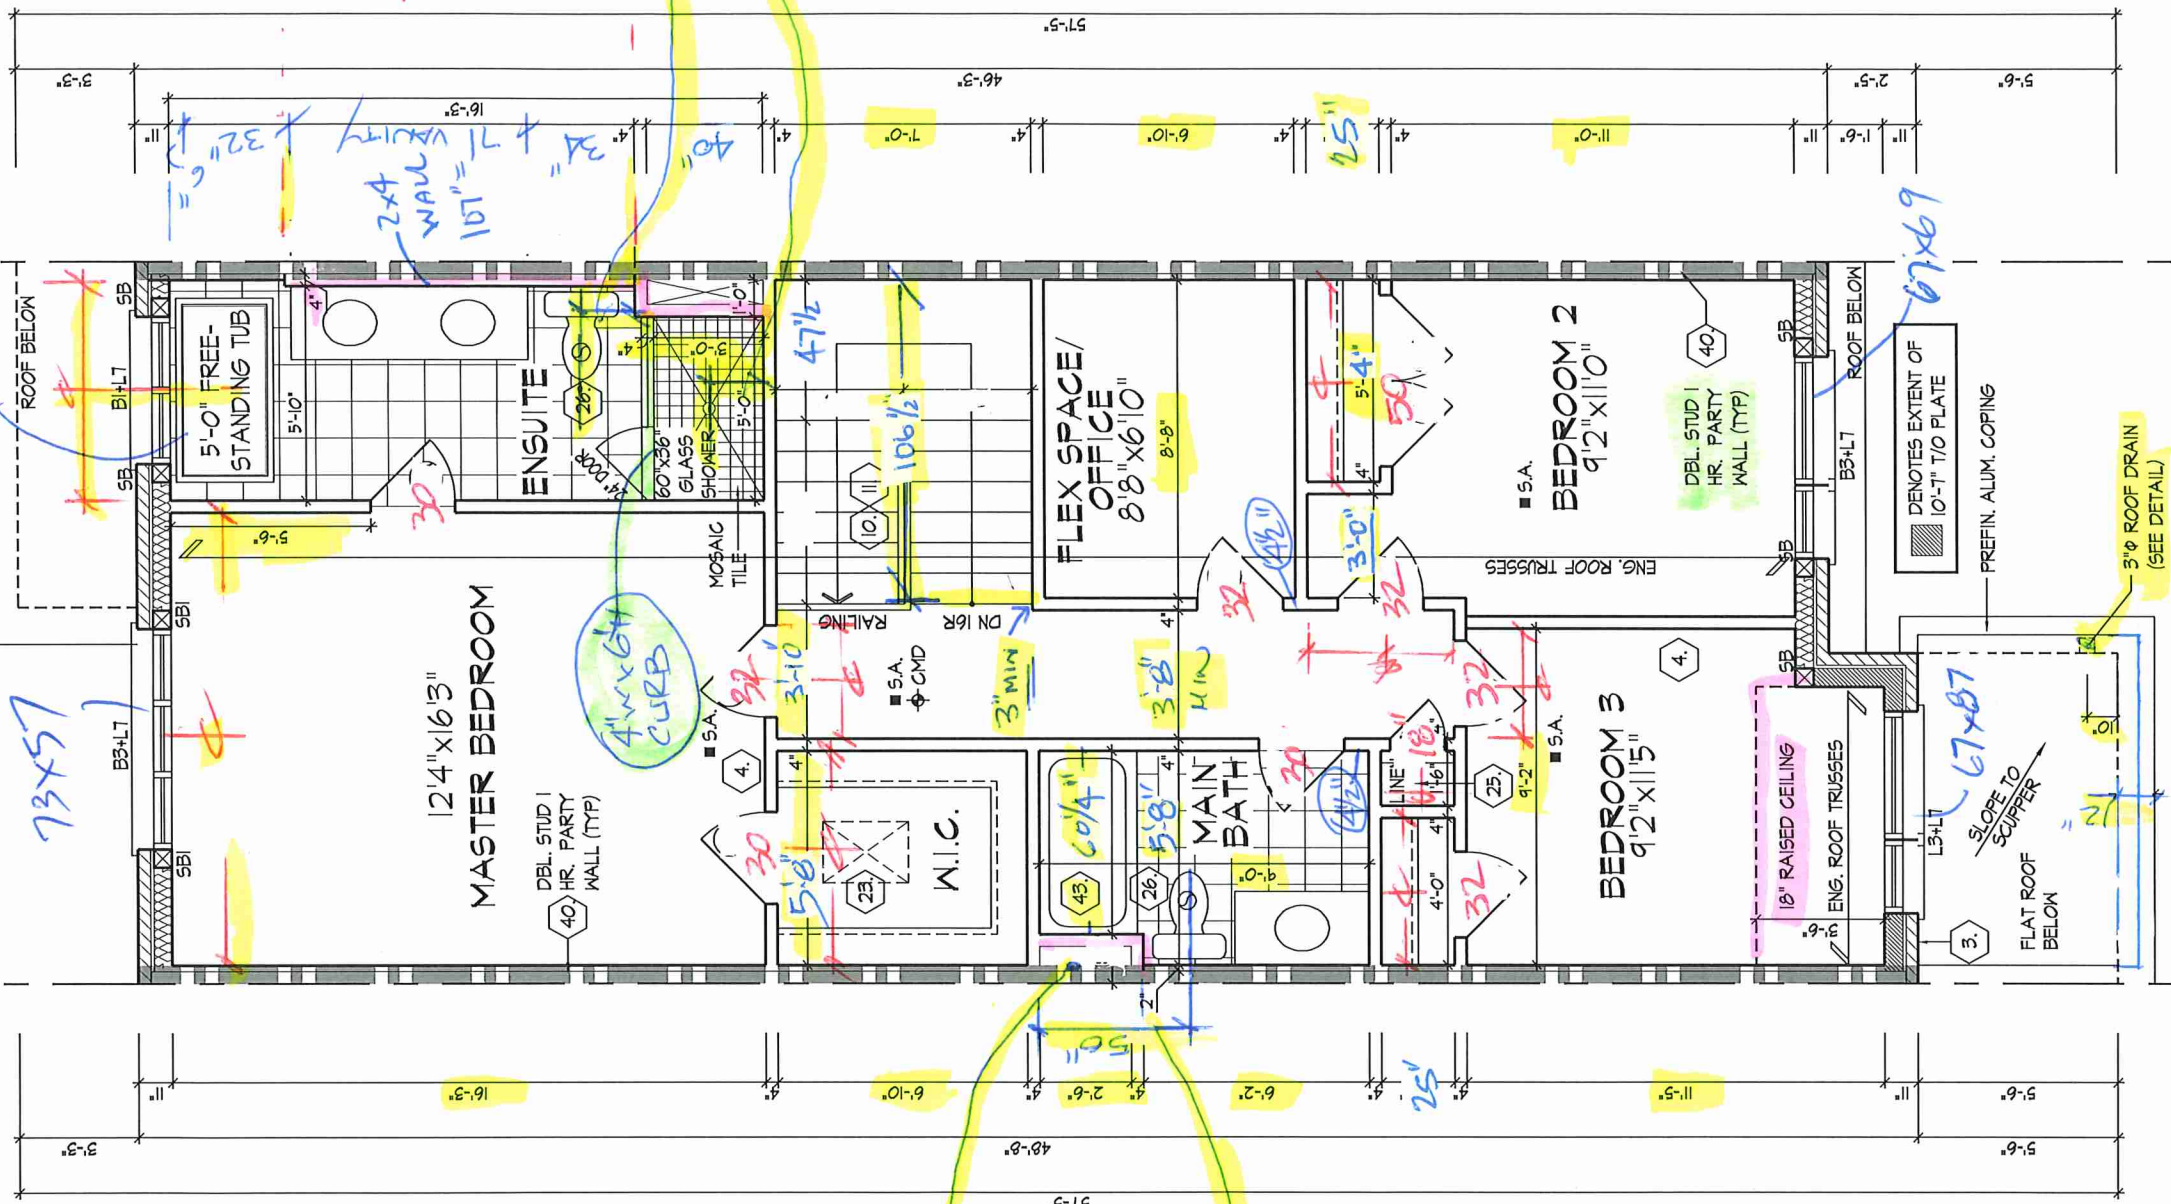


DOORS 83
WINDOW - SEE PLAN

opt. SECOND FLOOR PLAN, EL. 'B1'

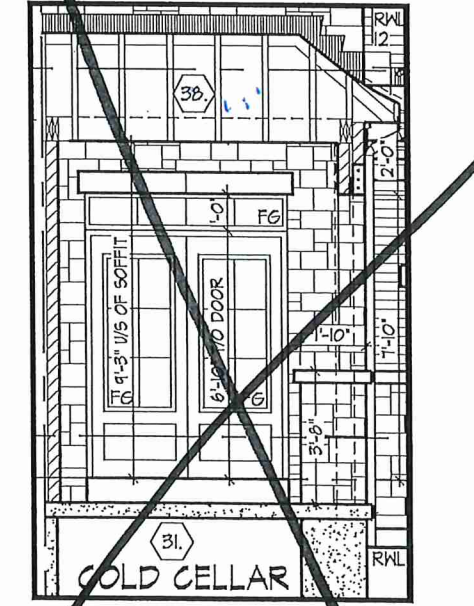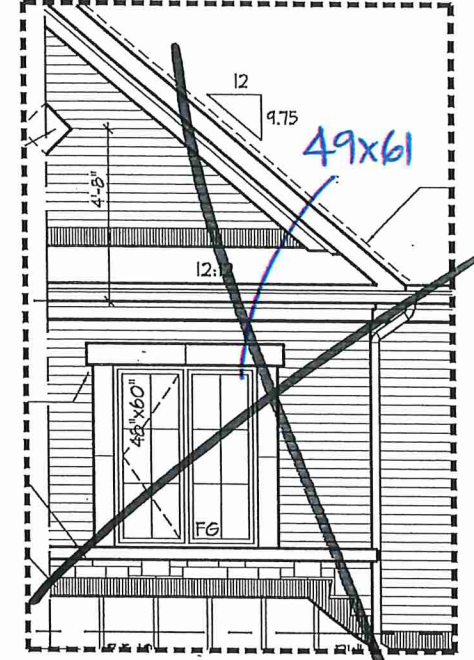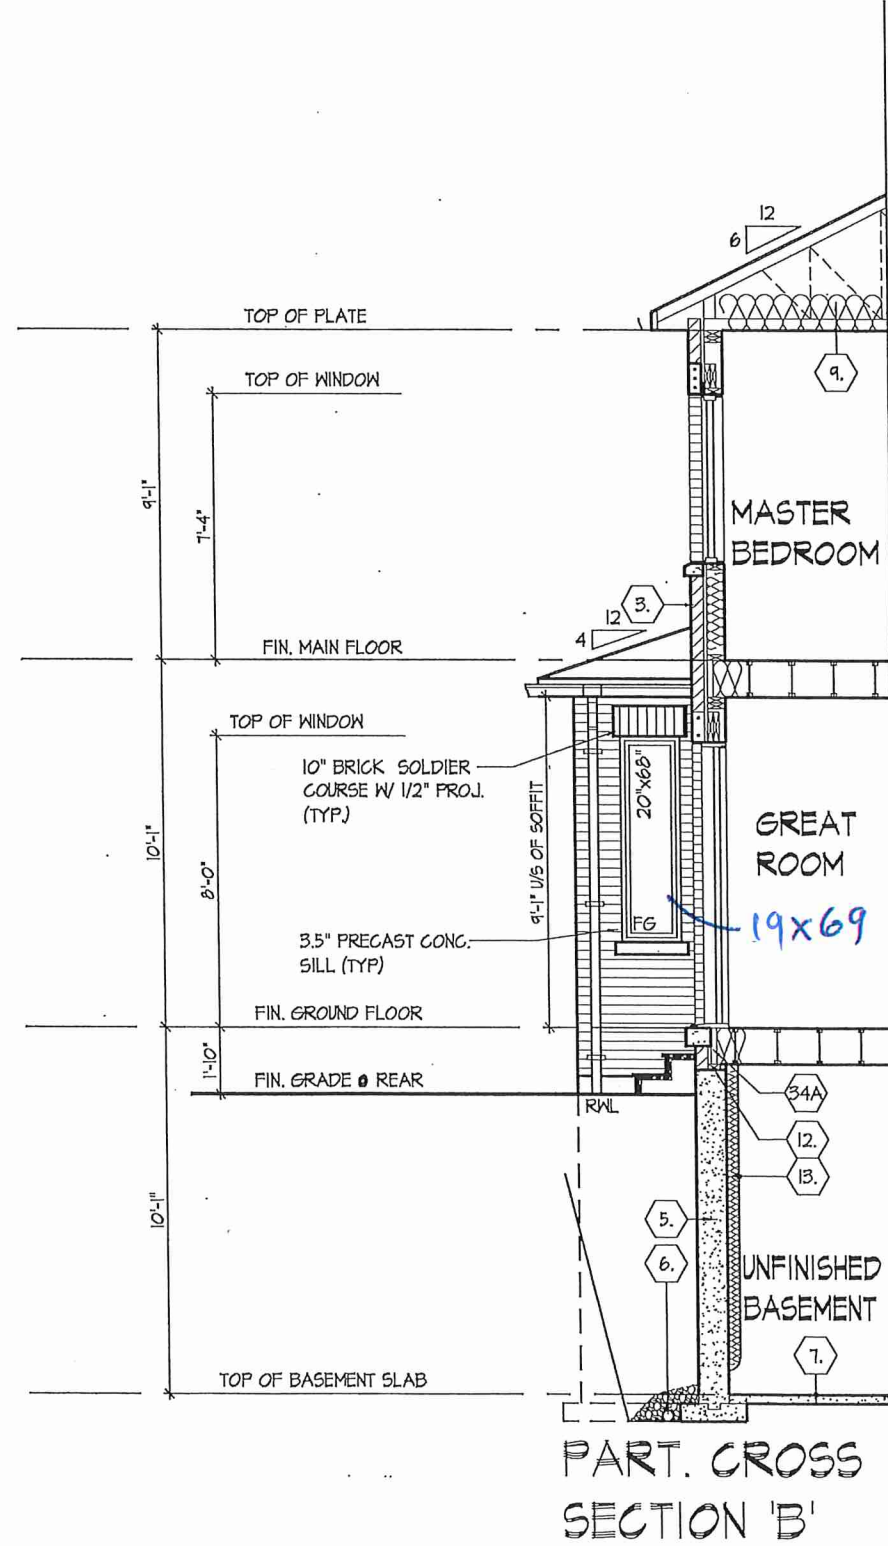

ROOF OVERHANGS TO BE 12"
UNLESS NOTED OTHERWISE

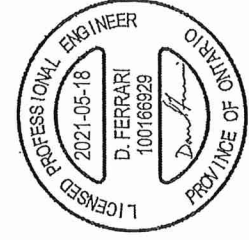

W Architect Inc.
DESIGN CONTROL REVIEW

MAY 31, 2021

FINAL BY: *ACE*

This stamp is only for the purposes of design control and carries no other professional obligations.

PART. ELEVATIONS, EL. 'A' & 'A2' & PART CROSS SECTION 'B'

ROYAL PINE HOMES - 216102

'CENTREFIELD', WEST GORMLEY, RICHMOND HILL, ON. REV. 2021.05.11

Drawn By: KM DS 3/16"=1'-0" 216102WT2007 10 of 16

8866 Woodbine Ave, Markham, ON L3R 0J7 T 905.737.5133 F 905.737.7326

File Number: 216102WT2007

Page Number: 10 of 16

HUNT
DESIGN ASSOCIATES INC.
www.huntdesign.ca

NAME: Derek R. Santos
SIGNATURE: *Derek R. Santos*
REGISTRATION INFORMATION: 37308 BCIN
HUNT DESIGN ASSOCIATES INC. 19695



THE UNDERSIGNED HAS REVIEWED AND TAKES RESPONSIBILITY FOR THIS DESIGN. THE UNDERSIGNED HAS THE QUALIFICATIONS AND MEETS THE REQUIREMENTS SET OUT IN THE ONTARIO BUILDING CODE TO BE A DESIGNER.

QUALIFICATION INFORMATION

19695

Reproduction of this property in whole or in part is strictly prohibited without H.D.A.'s written permission (H.D.A. assumes no responsibility or liability for this property unless it bears the appropriate BCIN number and original signature).

BK 232-57

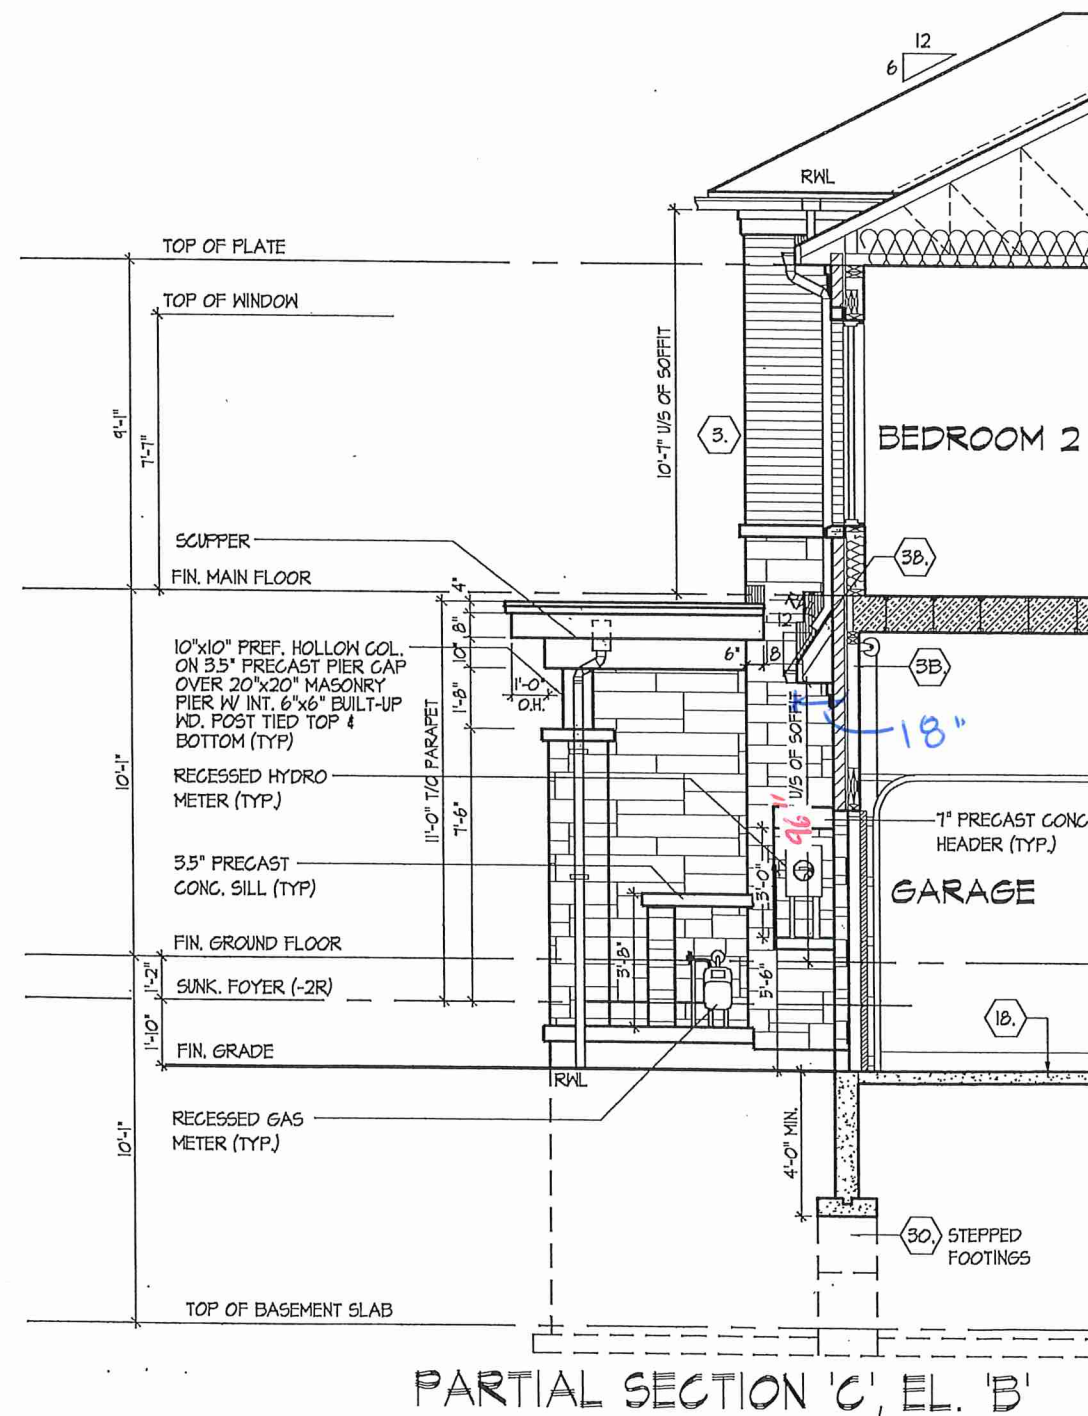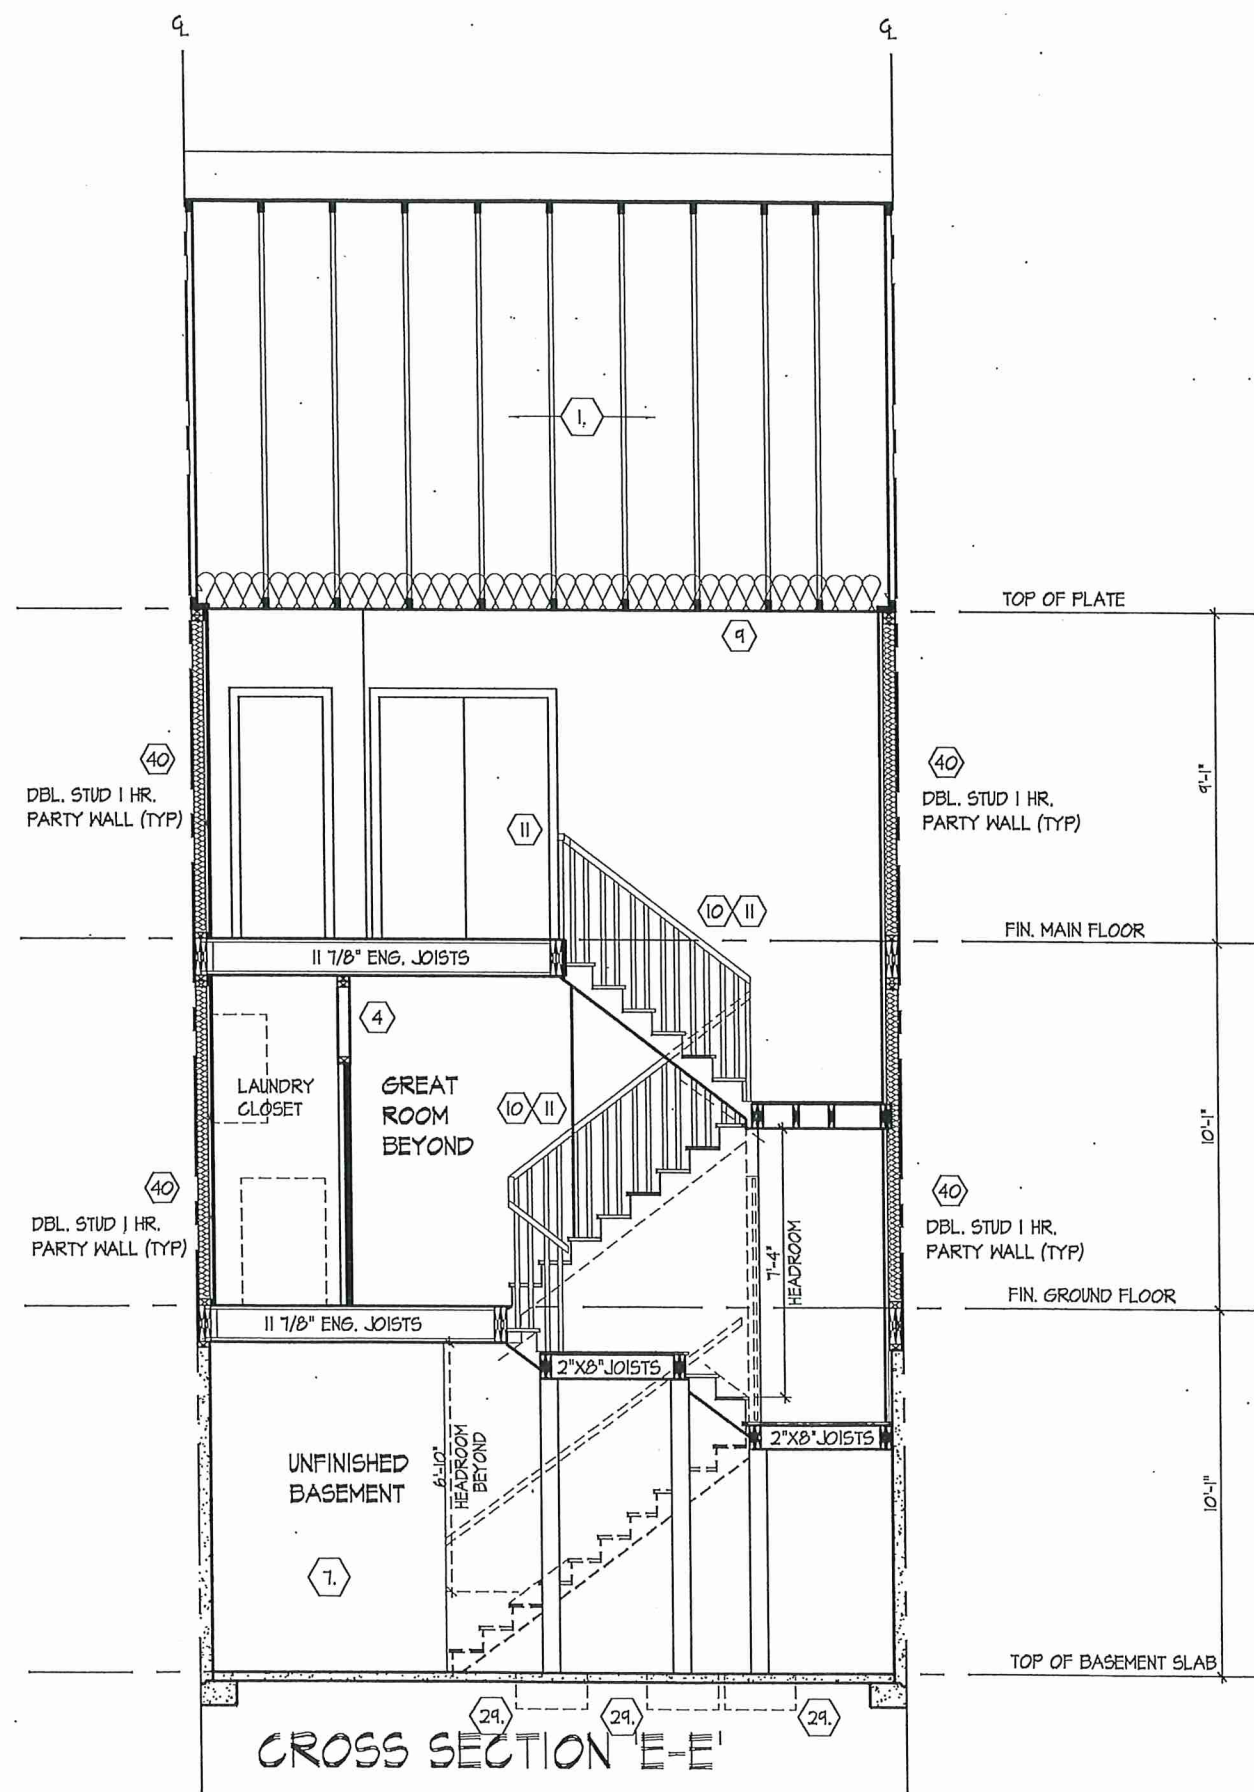

W Architect Inc.
DESIGN CONTROL REVIEW

MAY 31, 2021

FINAL BY: AE

This stamp is only for the purposes of design control and carries no other professional obligations.



**FOR STRUCTURAL ONLY
NOT INCLUDING ENGINEERED
FLOOR OR ROOF SYSTEM**

BLK 232-57

CROSS SECTION 'E-E' & PART, CROSS SECTION 'C', EL. 'B'

ROYAL PINE HOMES - 216102

ROYAL FINE HOMES - 21012
CENTREFIELD, WEST GORMLEY, RICHMOND HILL, ON.

Drawn By	Checked By	Scale	File Number	Page Number
KM	DS	3/16"=1'-0"	216102WT2007	12 of 16

HUNT
DESIGN ASSOCIATES INC.
www.huntdesign.ca

THE UNDERSIGNED HAS REVIEWED AND TAKES RESPONSIBILITY FOR THIS
DESIGN AND THE QUALIFICATIONS AND MEETS THE REQUIREMENTS SET
OUT IN THE ONTARIO BUILDING CODE TO BE A DESIGNER.

QUALIFICATION INFORMATION

Derek R. Santos

3730/8

BCIN

19695

HUNT DESIGN ASSOCIATES INC.

HUNT DESIGN ASSOCIATES INC.
16995
WWW.HUNTDG.COM
8908 WOODBINE AVE, MIAMI, FL 33156 | 305.767.1922


W Architect Inc.
DESIGN CONTROL REVIEW

MAY 31, 2021

FINAL

BY: *ALL*

This stamp is only for the purposes of design control and carries no other professional obligations.

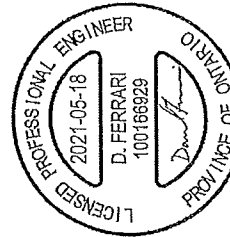

FOR STRUCTURAL ONLY
NOT INCLUDING ENGINEERED
FLOOR OR ROOF SYSTEM

BK 232-57

CROSS SECTION 'A-A'

UNIT 2007


ROYAL PINE HOMES - 216102
CENTREFIELD, WEST GORMLEY, RICHMOND HILL, ON.

DESIGN ASSOCIATES INC.
www.huntassociates.ca

THE UNDERSIGNED HAS REVIEWED AND TAKES RESPONSIBILITY FOR THIS DESIGN AND HAS THE QUALIFICATIONS AND MEETS THE REQUIREMENTS SET OUT IN THE ONTARIO BUILDING CODE TO BE A DESIGNER.
QUALIFICATION INFORMATION
NAME: Derek R. Santos
REGISTRATION INFORMATION
HUNT DESIGN ASSOCIATES INC.
19685
37308 BGN

Checked By: DS
Drawn By: KM
Scale: 3/16"=1'-0"
File Number: 216102WT2007
Page Number: 13 of 16

All drawings specifications related documents and design are the copyright property of Hunt Design Associates (H.D.A.). Reproduction of this property in whole or in part is strictly prohibited without H.D.A.'s written permission (H.D.A. assumes no responsibility or liability for this property unless it bears the appropriate SCN number and original signature).

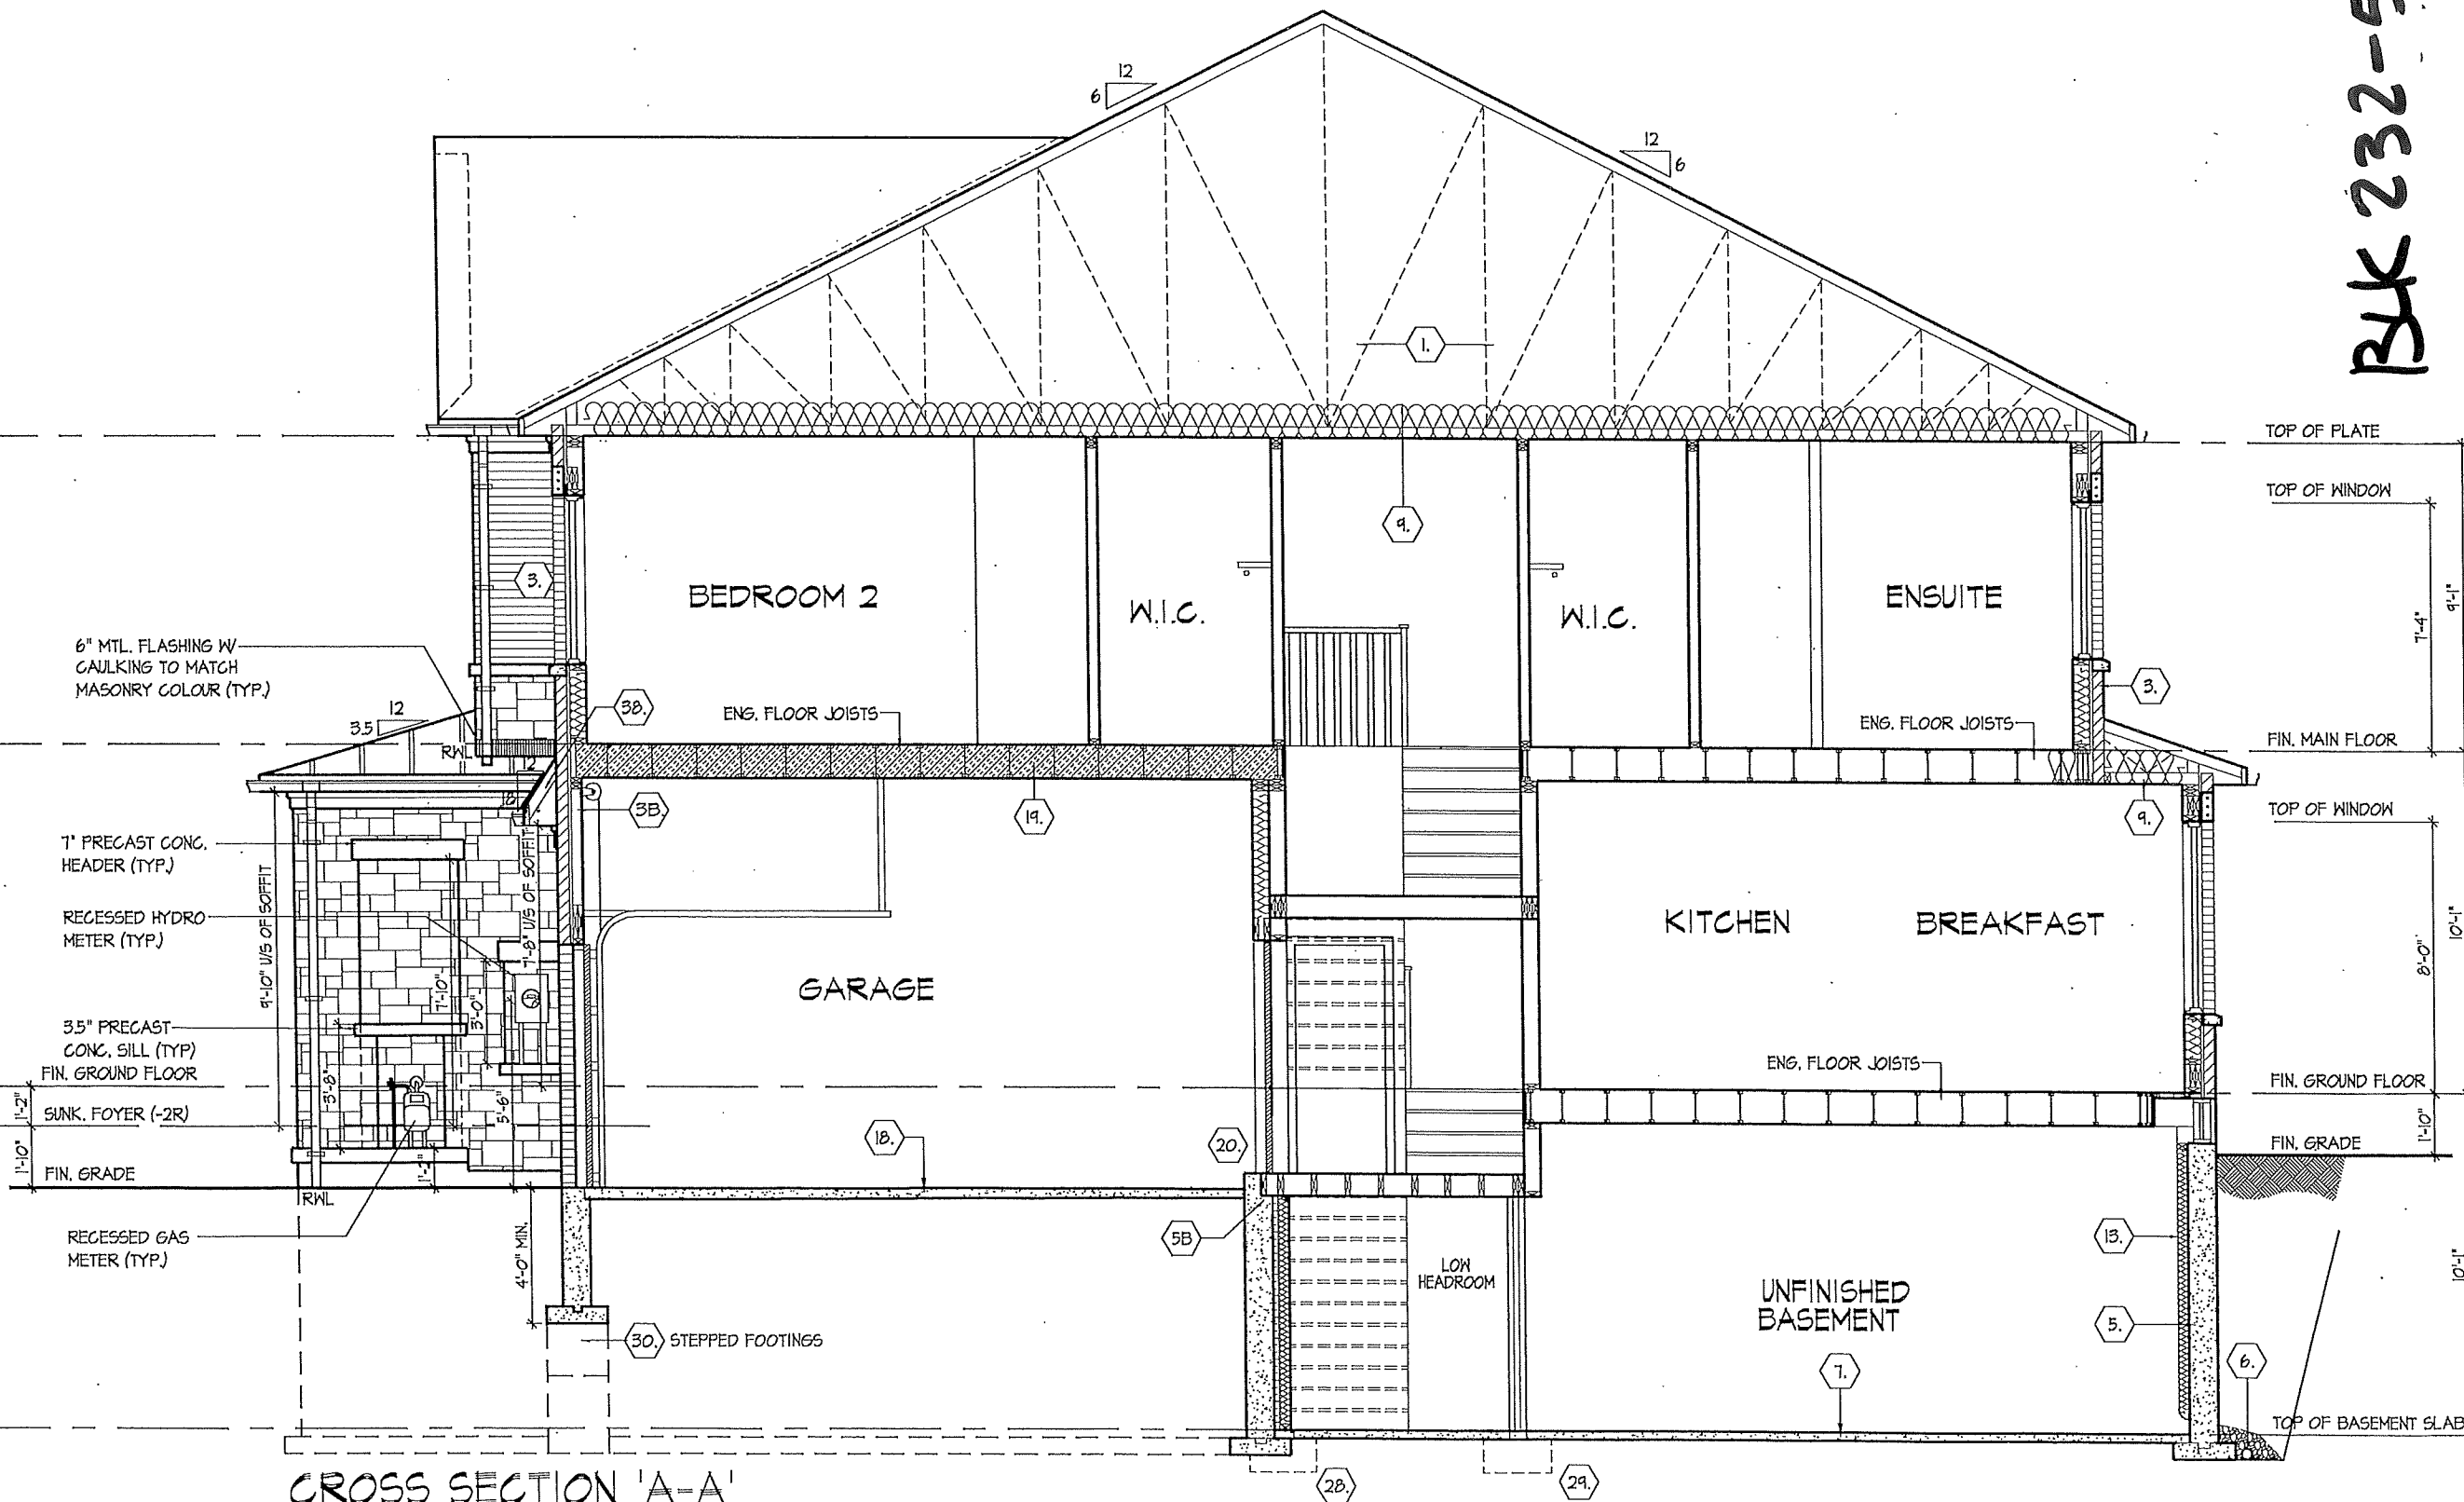

CROSS SECTION 'A-A'

cont. SECTION 1.0. CONSTRUCTION NOTES

- 40

1 HR. PARTY WALL (CONC. BLOCK) (SB-3) WALL TYPE B6a & B1b)
1/2" (12.7) GYPSUM SHEATHING ON EACH SIDE ON 2"x2" (38x38) VERTICAL WD. STRAPPING @ 24" (610) O.C. ON 8" (200) CONC. BLOCK FILL STRAPPING CAVITY EACH SIDE WITH AT LEAST 90% OF ABSORPTIVE MATERIAL PROCESSED FROM ROCK, SLAG OR GLASS. TAPE, FILL & SAND ALL GYPSUM JOINTS. EXPOSED BLOCK MUST BE SEALED W/ 2 COATS OF PAINT OR FURRED WITH 2"x2" (38x38) WD. STRAPPING & 1/2" (12.7) GYPSUM SHEATHING.
- 40

1 HR. PARTY WALL (DOUBLE STUD) (SB-3) WALL TYPE W13c)
5/8" (15.9) TYPE 'X' GYPSUM SHEATHING ON EXTERIOR SIDE OF 2 ROWS OF 2"x4" (38x48) STUDS @ 16" (406) O.C. MIN. 1" (25) APART ON SEPARATE 2"x4" (38x48) SILL PLATES. (2"x6" (38x140) AS REQUIRED) FILL ONE SIDE OF STUD CAVITY WITH AT LEAST 90% OF ABSORPTIVE MATERIAL PROCESSED FROM ROCK, SLAG OR GLASS. TAPE FILL AND SAND ALL GYPSUM JOINTS.
- 40A

2 HR. FIREWALL (SB-3) WALL TYPE B6a & B1b)
1/2" (12.7) GYPSUM SHEATHING ON EACH SIDE ON 2"x2" (38x38) VERTICAL WOOD STRAPPING @ 24" (610) O.C. ON 8" (200) CONC. BLOCK 75% SOLID. FILL STRAPPING CAVITY EACH SIDE WITH AT LEAST 90% OF ABSORPTIVE MATERIAL PROCESSED FROM ROCK, SLAG OR GLASS. TAPE, FILL & SAND ALL GYPSUM JOINTS. AT UNFINISHED AREAS, EXTERIOR FACE OF CONC. BLOCK TO BE SEALED WITH 2 COATS OF PAINT. GYPSUM SHEATHING TO BE ATTACHED TO CONC. BLOCK. (REFER TO DETAILS)
- 41

STUCCO WALL CONSTRUCTION (2"x6")
STUCCO FINISH CONFORMING TO O.B.C. SECTION 9.28. AND APPLIED PER MANUFACTURERS SPECIFICATIONS OVER 1/2" (38) EIF-S. (MINIMUM) ON APPROVED DRAINAGE MAT ON 1/2" (12.7) DENSGLASS GOLD GYPSUM BOARD ON STUDS CONFORMING TO O.B.C (9.23.10.1) & SECTION 1.1. INSULATION, APPROVED 6 MIL POLYETHYLENE VAPOUR BARRIER, 1/2" (12.7) GYPSUM WALLBOARD INT. FINISH. (REFER TO 35 NOTE AS REQUIRED)
- 41A

STUCCO WALL CONSTRUCTION (2"x6") W/ CONTIN. INSUL.
STUCCO FINISH CONFORMING TO O.B.C. SECTION 9.28. AND APPLIED PER MANUFACTURERS SPECIFICATIONS OVER 1/2" (38) EIF-S. (MINIMUM) ON APPROVED DRAINAGE MAT ON APPROVED AIRWATER BARRIER AS PER O.B.C. 9.27.3. ON EXTERIOR TYPE RIGID INSULATION (JOINTS UNTAPED) MECHANICALLY FASTENED AS PER MANUFACTURERS SPECIFICATIONS. ON 7/16" EXTERIOR TYPE SHEATHING ON STUDS CONFORMING TO O.B.C (9.23.10.1) & SECTION 1.1. INSULATION, APPROVED 6 MIL POLYETHYLENE VAPOUR BARRIER, 1/2" (12.7) GYPSUM WALLBOARD INT. FINISH. (REFER TO 35 NOTE AS REQUIRED)
- 41B

STUCCO WALL @ GARAGE CONST.
STUCCO FINISH CONFORMING TO O.B.C. SECTION 9.28. AND APPLIED PER MANUFACTURERS SPECIFICATIONS OVER 1/2" (38) EIF-S. (MINIMUM) ON APPROVED DRAINAGE MAT ON 1/2" (12.7) DENSGLASS GOLD GYPSUM BRD. ON STUDS CONFORMING TO O.B.C (9.23.10.1) & SECTION 1.1. 1/2" (12.7) GYPSUM WALLBOARD INT. FINISH. (REFER TO 35 NOTE AS REQ.)
- 42

UNSUPPORTED FOUNDATION WALLS (9.15.4.2)
REINFORCING AT STAIRS AND SUNKEN FLOOR AREAS
2-20M BARS IN TOP PORTION OF WALL (UP TO 8'-0" OPENING)
3-20M BARS IN TOP PORTION OF WALL (8'-0" TO 10'-0" OPENING)
4-20M BARS IN TOP PORTION OF WALL (10'-0" TO 15'-0" OPENING)
- BARS STACKED VERTICALLY AT INTERIOR FACE OF WALL
- REINFORCING AT BASEMENT WINDOWS
- 42

REINFORCING AT BASEMENT WINDOWS
2-15M HORIZ. REINFORCING ON THE INSIDE AND OUTSIDE FACE OF THE FOUNDATION WALL BELOW THE WIN. SILL. EXTEND BARS 24" (610) BEYOND THE OPENING. 2-15M VERTICAL REINFORCING ON THE INSIDE AND OUTSIDE FACE OF THE FOUNDATION WALL ON EACH SIDE OF THE WINDOW OPENING.
- BARS TO HAVE MIN. 1" (25) CONC. COVER
- BARS TO EXTEND 2'-0" (610) BEYOND BOTH SIDES OF OPENING
- 43

STUD WALL REINFORCEMENT
PROVIDE STUD WALL REINFORCEMENT IN MAIN BATHROOM CONFORMING TO O.B.C. (9.5.2.3.(1) AND 3.8.3.8.(3)) (REFER TO DETAILS)
- 44

WINDOW WELLS
WHERE A WINDOW OPENS INTO A WINDOW WELL, A CLEARANCE OF NOT LESS THAN 21 5/8" (556) SHALL BE PROVIDED IN FRONT OF THE WINDOW. EVERY WINDOW WELL SHALL BE DRAINED TO THE FOOTING LEVEL OR OTHER SUITABLE LOCATION WITH A 4" (100) WEEPING TILE C/W A FILTER CLOTH WRAP AND FILLED WITH CRUSHED STONE. (9.9.10.1.(6), 9.14.6.3.)
- 45

SLOPED CEILING CONSTRUCTION (SB-12) 2.1.1.7., 9.23.4.2)
2"x12" (38x286) ROOF JOISTS @ 16" (406) O.C. MAX. (UNLESS OTHERWISE NOTED) W/ 2"x2" (38x38) PURLINS @ 16" (406) O.C. PERPENDICULAR TO ROOF JOIST. PURLINS NOT REQ. W/ SPRAY FOAM. W/ INSULATION BETWEEN JOIST. 6 MIL POLYETHYLENE VAPOUR BARRIER, 1/2" (12.7) GYPSUM WALLBOARD INT. FINISH OR APPROVED EQ. INSULATION VALUE DIRECTLY ABOVE THE INNER SURFACE OF EXTERIOR WALLS SHALL NOT BE LESS THAN R20 (3.52 RS).
FLAT ROOF/BALCONY CONSTRUCTION
- 46

FLAT ROOF/BALCONY CONSTRUCTION
WATERPROOFING MEMBRANE (9.26.11, 9.26.15, 9.26.16) FULLY ADHERED TO 5/8" (15.9) T&G EXTERIOR GRADE PLYWOOD SHEATHING ON 2"x2" (38x38) PURLINS ANGLED TOWARDS SCUPPER @ 2% MINIMUM LAID PERPENDICULAR TO 2"x8" (38x184) FLOOR JOISTS @ 16" (406) O.C. (UNLESS OTHERWISE NOTED). BUILT UP CURB TO BE 4" (100) MIN. ABOVE FINISHED BALCONY FLOOR. CONTINUOUS 'L' TRIM DRIP EDGE TO BE PROVIDED ON OUTSIDE FACE OF CURB. SCUPPER DRAIN TO BE LOCATED 24" (610) MIN. AWAY FROM HOUSE. PREFINISHED ALUMINUM OR PANEL FOR UNDERSIDE OF SOFFIT. (9.23.2.3). REMOVE CURB WHERE REQ.
BALCONY CONDITION
SEE FLAT ROOF/BALCONY CONSTRUCTION NOTE. INCLUDE 2"x4" (38x89) PT. DECKING W/ 1/4" (6.4) GAPS LAID FLAT PARALLEL TO JOISTS ON 2"x4" (38x89) PT. SLEEPERS @ 12" (305) O.C. LAID FLAT PERPENDICULAR TO JOISTS
BALCONY OVER HEATED SPACE CONDITION
SEE FLAT ROOF/BALCONY CONSTRUCTION NOTE FOR ASSEMBLY. REFER TO PLANS FOR FLOOR JOIST SIZE & REFER TO HEX NOTE 9 FOR INSULATION AND INTERIOR FINISH
- 47

BARREL VAULT CONSTRUCTION
CANTILEVERED 2"x4" (38x89) SPACERS LAID FLAT ON 2"x10" (38x235) SPR. #2 ROOF JOIST NAILED TO BUILT UP 3-3/4" (19) PLYWOOD HEADER PROFILED FOR BARREL. SPRAY FOAM INSULATION BETWEEN JOISTS W/ GYPSUM BOARD. (REFER TO DETAILS)

REFER TO SB-12 ENERGY EFFICIENCY DESIGN MATRIX ON THE TITLE PAGE FOR ALL VALUES AS REQUIRED PER 3.1.1., 3.1.2., 3.1.3. OF THE OBC.

SECTION 1.1. WALL STUDS

- REFER TO THIS CHART FOR STUD SIZE & SPACING AS REQUIRED FOR EXTERIOR WALLS ONLY. REFER TO SITING & GRADING PLAN OF THIS UNIT FOR CONFIRMATION OF TOP OF FOUNDATION WALL AND ADDITIONAL INFORMATION.
- IF STUD WALL HEIGHT EXCEEDS MAX. UNSUPPORTED HEIGHT, WALL NEEDS TO BE REINFORCED AND APPROVED BY ENGINEER.

SIZE & SPACING OF STUDS: OBC REFERENCE - TABLE 9.23.10.1.)	
SUPPORTED LOADS (EXTERIOR)	
MIN. STUD SIZE	ROOF W/ OR W/O ATTIC & 1 FLOOR ATTIC & 2 FLOOR ATTIC & 3 FLOOR
in (mm)	MAX. STUD SPACING, in. (mm) O.C.
2"x4" (38x89)	24" (610) 16" (406) 12" (305)
2"x6" (38x140)	24" (610) 16" (406) 12" (305)
	9'-10" (3.0) 11'-10" (3.6) 5'-11" (1.8)

SECTION 2.0. GENERAL NOTES

2.1. WINDOWS
1) EXCEPT WHERE A DOOR ON THE SAME FLOOR LEVEL AS THE BEDROOM PROVIDES DIRECT ACCESS TO THE EXTERIOR, EVERY FLOOR LEVEL CONTAINING A BEDROOM IS TO HAVE AT LEAST ONE OUTSIDE WINDOW W/ MIN. 0.36m² UNOBSTRUCTED OPEN PORTION W/ NO DIMENSION LESS THAN 1'-3" (380), CAPABLE OF MAINTAINING THE OPENING WITHOUT THE NEED FOR ADDITIONAL SUPPORT. CONFORMING TO 9.9.10.
2) WINDOW GUARDS: A GUARD OR A WINDOW WITH A MAXIMUM RESTRICTED OPENING WIDTH OF 4" (100) IS REQUIRED WHERE THE TOP OF THE WINDOW SILL IS LOCATED LESS THAN 1'-7" (480) ABOVE FIN. FLOOR AND THE DISTANCE FROM THE FINISHED FLOOR TO THE ADJACENT GRADE IS GREATER THAN 5'-11" (1800). (9.8.8.1.)
3) WINDOWS IN EXT. STAIRWAYS THAT EXTEND TO LESS THAN 2'-11" (900) (3'-8" (1070) FOR ALL OTHER BUILDINGS) SHALL BE PROTECTED BY GUARDS IN ACCORDANCE WITH NOTE #2 (ABOVE). OF THE WINDOW SHALL BE NON-OPERABLE AND DESIGNED TO WITHSTAND THE SPECIFIED LOADS FOR BALCONY GUARDS AS PROVIDED IN 4.1.5.15 OR 9.8.8.2
4) REFER TO TITLE PAGE FOR MAX. U-VALUE REQUIREMENTS

2.2. CEILING HEIGHTS	
THE CEILING HEIGHTS OF ROOMS AND SPACES SHALL CONFORM TO TABLE 9.5.3.1.	
ROOM OR SPACE	MINIMUM HEIGHTS
LIVING ROOM, DINING ROOM AND KITCHEN	7'-7" OVER 75% OF REQUIRED FLOOR AREA WITH A CLEAR HEIGHT OF 6'-11" AT ANY POINT
BEDROOM	7'-7" OVER 50% OF REQUIRED FLOOR AREA OR 6'-11" OVER ALL OF THE REQUIRED FLOOR AREA.
BASEMENT	6'-11" OVER AT LEAST 75% OF THE BASEMENT AREA EXCEPT THAT UNDER BEAMS AND DUCTS THE CLEARANCE IS PERMITTED TO BE REDUCED TO 6'-5".
BATHROOM, LAUNDRY AREA ABOVE GARAGE	6'-11" IN ANY AREA WHERE A PERSON WOULD NORMALLY BE STANDING
FINISHED ROOM NOT MENTIONED ABOVE	6'-11"
MEZZANINES	6'-11" ABOVE & BELOW FLOOR ASSEMBLY (9.5.3.2)
STORAGE GARAGE	6'-7" (9.5.3.3)

2.3. MECHANICAL / PLUMBING
1) MECHANICAL VENTILATION IS REQUIRED TO PROVIDE 0.7 AIR CHANGE PER HOUR IF NOT AIR CONDITIONED 1 PER HOUR IF AIR CONDITIONED AVERAGED OVER 24 HOURS. WHEN A VENTILATION FAN (PRINCIPAL EXHAUST) IS REQUIRED, CONFORM TO OBC 9.32.3.4. WHEN A HRV IS REQUIRED, CONFORM TO 9.32.3.11. REFER TO MECHANICAL DRAWINGS.
2) REFER TO HOT WATER TANK MANUFACTURER SPECS. CONFORM TO OBC 9.31.6.

3) REFER TO TITLE PAGE FOR SPACE HEATING EQUIPMENT, HRV AND DOMESTIC HOT WATER HEATER MINIMUM EFFICIENCIES.
4) DRAIN WATER HEAT RECOVERY UNIT(S) WILL BE INSTALLED CONFORMING TO THE REQUIREMENTS OF 3.1.1.12. OF THE O.B.C.

2.4. LUMBER
1) ALL LUMBER SHALL BE SPRUCE No.2 GRADE OR BETTER, UNLESS NOTED OTHERWISE.
2) STUDS SHALL BE STUD GRADE SPRUCE, UNLESS NOTED OTHERWISE.
3) LUMBER EXPOSED TO THE EXTERIOR TO BE SPRUCE No. 2 GRADE PRESSURE TREATED OR CEDAR, UNLESS NOTED OTHERWISE.

4) ALL LAMINATED VENEER LUMBER (LVL) BEAMS, GIRDER TRUSSES, AND METAL HANGER CONNECTIONS SUPPORTING ROOF FRAMING TO BE DESIGNED & CERTIFIED BY FLOOR AND ROOF TRUSS MANUFACTURER.
5) JOIST HANGERS: PROVIDE APPROVED METAL HANGERS FOR ALL JOISTS AND BUILT-UP WOOD MEMBERS INTERSECTING WITH FLUSH BUILT-UP WOOD MEMBERS.
6) WOOD FRAMING NOT TREATED WITH A WOOD PRESERVATIVE, IN CONTACT WITH CONCRETE, SHALL BE SEPARATED FROM THE CONC. BY AT LEAST 2 mil POLYETHYLENE FILM, No.50 (45lb) ROLL ROOFING OR OTHER DAMPROOFING MATERIAL, EXCEPT WHERE THE WOOD MEMBER IS AT LEAST 6" (152) ABOVE THE GROUND.

2.5. STEEL (9.23.4.3)
1) STRUCTURAL STEEL SHALL CONFORM TO CAN/CSA-G40-21 GRADE 300W. HOLLOW STRUCT. SECTIONS SHALL CONFORM TO CAN/CSA-G40-21 GRADE 350W CLASS 'H'.
2) REINFORCING STEEL SHALL CONFORM TO CSA-G30-18M GRADE 400R.

2.6. FLAT ARCHES
1) FOR 8'-0" (2440) CEILINGS, FLAT ARCHES SHALL BE 6'-10" (2080) A.F.F.
2) FOR 9'-0" (2740) CEILINGS, FLAT ARCHES SHALL BE 7'-10" (2400) A.F.F.
3) FOR 10'-0" (3040) CEILINGS, FLAT ARCHES SHALL BE 8'-6" (2600) A.F.F.

2.7. ROOF OVERHANGS
1) ALL ROOF OVERHANGS SHALL BE 1'-0" (305), UNLESS NOTED OTHERWISE.
2.8. FLASHING (9.20.13., 9.26.4., 9.27.3.)
1) FLASHING MATERIALS & INSTALLATION SHALL CONFORM TO O.B.C.

2.9. GRADING
1) THE BUILDING SHALL BE LOCATED OR THE BUILDING SITE GRADED SO THE WATER WILL NOT ACCUMULATE AT OR NEAR THE BUILDING AND WILL NOT ADVERSELY AFFECT ADJACENT PROPERTIES. CONFORM TO 9.14.6.
2.10. ULC SPECIFIED ASSEMBLIES
ALL REQUIRED INDIVIDUAL COMPONENTS THAT FORM PART OF ANY 'ULC LISTED ASSEMBLY', SPECIFIED WITHIN THESE DRAWINGS, CANNOT BE ALTERED OR SUBSTITUTED FOR ANY OTHER MATERIAL/PRODUCT OR SPECIFIED MANUFACTURER THAT IS IDENTIFIED IN THAT SPECIFIED 'ULC LISTING'. THERE SHALL BE NO DEVIATIONS UNDER ANY CIRCUMSTANCES IN ANY ULC LISTED ASSEMBLY IDENTIFIED IN THESE DRAWINGS.

SECTION 3.0. LEGEND

3.1. WOOD LITELS AND BUILT-UP WOOD (DIVISION B PART 9, TABLE A8 TO A10 AND A12, A15 & A16) FORMING PART OF SENTENCE 9.23.4.2.(6), 9.23.4.2.(4), 9.23.12.3.(1), (3), 9.23.13.8.(2), 9.37.3.1.(1)					
2"x8" SPRUCE #2	2"x10" SPRUCE #2	2"x12" SPRUCE #2	2"x12" SPRUCE #2	2"x12" SPRUCE #2	2"x12" SPRUCE #2
L1	2 1/2"x8" (2/38x184)	L3	2 1/2"x10" (2/38x235)	L5	2 1/2"x12" (2/38x286)
B1	3 1/2"x8" (3/38x184)	B3	3 1/2"x10" (3/38x235)	B5	3 1/2"x12" (3/38x286)
B2	4 1/2"x8" (4/38x184)	B4	4 1/2"x10" (4/38x235)	B6	4 1/2"x12" (4/38x286)
B7	5 1/2"x8" (5/38x184)	B8	5 1/2"x10" (5/38x235)	B9	5 1/2"x12" (5/38x286)

ENGINEERED LUMBER SCHEDULE			
1	3/4" x 9 1/2" LVL	1	3/4" x 11 7/8" LVL
LVL2	1-1 3/4"x9 1/2"	LVL3	1-1 3/4"x11 7/8"
LVL4	2-1 3/4"x9 1/2"	LVL6	2-1 3/4"x11 7/8"
LVL5	3-1 3/4"x9 1/2"	LVL7	3-1 3/4"x11 7/8"
LVL8	4-1 3/4"x9 1/2"	LVL9	4-1 3/4"x11 7/8"

3.2. STEEL LITELS SUPPORTING MASONRY VENEER (DIVISION B PART 9, TABLE 9.20.5.2.B.) FORMING PART OF SENTENCE 9.20.5.2.(2) & 9.20.5.2.(3)		
CODE	SIZE	STONE
L7	3 1/2" x 3 1/2" x 1 1/4" (89 x 89 x 6.4)	8'-1" (2.47m)
L8	4" x 3 1/2" x 1 1/4" (102 x 89 x 6.4)	8'-6" (2.68m)
L9	4 7/8" x 3 1/2" x 5/16" (127 x 89 x 7.9)	10'-10" (3.31m)
L10	4 7/8" x 3 1/2" x 3/8" (127 x 89 x 11)	11'-5" (3.48m)
L11	5 7/8" x 3 1/2" x 3/8" (152 x 89 x 11)	12'-6" (3.82m)
L12	7 1/8" x 4" x 3/8" (178 x 102 x 11)	14'-1" (4.30m)

3.3. DOOR SCHEDULE

CONFORMING TO SECTIONS 9.5.11, 9.6., 9.7.2.1, 9.7.5.2, & 9.10.13.10	
1	EXTERIOR 2'-6" x 6'-8" x 1-3/4" (815 x 2030 x 45) INSULATED MIN. R4 (RSI 0.7)
1A	EXTERIOR 2'-10" x 6'-8" x 1-3/4" (665 x 2030 x 45) INSULATED MIN. R4 (RSI 0.7)
1B	EXTERIOR 3'-0" x 6'-8" x 1-3/4" (915 x 2030 x 45) INSULATED MIN. R4 (RSI 0.7)
1C	EXTERIOR 2'-6" x 6'-8" x 1-3/4" (760 x 2030 x 45) INSULATED MIN. R4 (RSI 0.7)
1D	EXTERIOR 2'-8" x 6'-8" x 1-3/4" (815 x 2030 x 45) INS. MIN. R4 (RSI 0.7) (SEE HEX NOTE 20)
1E	EXTERIOR 3'-0" x 8'-0" x 1-3/4" (915 x 2440 x 45) INSULATED MIN. R4 (RSI 0.7)
1F	EXTERIOR 2'-8" x 8'-0" x 1-3/4" (815 x 2440 x 45) INSULATED MIN. R4 (RSI 0.7)
2A	EXTERIOR 2'-8" x 6'-8" x 1-3/4" (815 x 2030 x 45) 20 MIN. F.R.R. DOORFRAME WITH APP. SELF-CLOSING DEVICE
2	INTERIOR 2'-8" x 6'-8" x 1-3/8" (815 x 2030 x 35)
3	INTERIOR 2'-6" x 6'-8" x 1-3/8" (760 x 2030 x 35)
3A	INTERIOR 2'-4" x 6'-8" x 1-3/8" (710 x 2030 x 35)
4	INTERIOR 2'-0" x 6'-8" x 1-3/8" (610 x 2030 x 35)
4A	INTERIOR 2'-2" x 6'-8" x 1-3/8" (660 x 2030 x 35)
5	INTERIOR 1'-6" x 6'-8" x 1-3/8" (460 x 2030 x 35)

3.4. ACRONYMS	
AFF	ABOVE FINISHED FLOOR
BBFM	BEAM BY FLOOR MANUFACTURER
BG	FIXED GLASS W/ BLACK BACKING
BM	BEAM
BBRM	BEAM BY ROOF MANUFACTURER
CRF	CONVENTIONAL ROOF FRAMING
CW	COMPLETE WITH
DJ/TJ	DOUBLE JOIST/ TRIPLE JOIST
DO	DO OVER
DRP	DROPPED
ENG	ENGINEERED
EST	ESTIMATED
FA	FLAT ARCH
FD	FLOOR DRAIN
FG	FIXED GLASS
FL	FLUSH
FLR	FLOOR
GT	GIRDER TRUSS
HB	HOSE BIB
HRV	HEAT RETURN VENTILATION UNIT
HWT	HOT WATER TANK
DRP	DROPPED
ENG	ENGINEERED
EST	ESTIMATED
FA	FLAT ARCH
FD	FLOOR DRAIN
FG	FIXED GLASS
FL	FLUSH
FLR	FLOOR
GT	GIRDER TRUSS
WD	WOOD
WIC	WALK IN CLOSET
WP	WEATHER PROOF

3.5. SYMBOLS	
ALL ELECTRICAL FACILITIES SHALL BE INSTALLED IN ACCORDANCE WITH SECTION 9.34.	
CLASS 'B' VENT	EXHAUST VENT
DUPLEX OUTLET (12" HIGH)	DUPLEX OUTLET (HEIGHT AS NOTED A.F.F.)
HEAVY DUTY OUTLET	SWITCH (2/3/4 WAY)
POT LIGHT	LIGHT FIXTURE (CEILING MOUNTED)
LIGHT FIXTURE (PULL CHAIN)	LIGHT FIXTURE (WALL MOUNTED)
CABLE T.V. JACK	TELEPHONE JACK
CENTRAL VACUUM OUTLET	CHANDELIER (CEILING MOUNTED)
SA SMOKE ALARM (9.10.19)	

PROVIDE ONE PER FLOOR, NEAR THE STAIRS CONNECTING THE FLOOR LEVEL, ALARMS ARE TO BE INSTALLED IN EACH SLEEPING ROOM AND IN A LOCATION BETWEEN SLEEPING ROOMS AND CONNECTING HALLWAYS AND WIRED TO BE INTERCONNECTED TO ACTIVATE ALL ALARMS IF ONE SOUNDS. ALARMS ARE TO BE CONNECTED TO AN ELECTRICAL CIRCUIT AND WITH A BATTERY BACKUP. ALARM SIGNAL SHALL MEET TEMPORAL SOUND PATTERNS MIN. ALARMS SHALL HAVE A VISUAL SIGNALING COMPONENT AS PER THE NATIONAL FIRE ALARM AND SIGNALING CODE 72.
CMD CARBON MONOXIDE ALARM (9.33.4.)
CHECK LOCAL BY-LAWS FOR REQUIREMENTS ** A CARBON MONOXIDE ALARM(S) CONFORMING TO CAN/CGA-6.19 SHALL BE INSTALLED ON OR NEAR THE CEILING IN EACH SLEEPING UNIT ADJACENT TO EACH SLEEPING AREA. CARBON MONOXIDE ALARM(S) SHALL BE PERMANENTLY WIRED WITH NO DISCONNECT SWITCH, WITH AN ALARM THAT IS AUDIBLE WITHIN SLEEPING ROOMS WHEN THE INTERVENING DOORS ARE CLOSED.

SB SOLID BEARING (BUILT-UP WOOD COLUMNS AND STUD POSTS)
THE WIDTH OF A WOOD COLUMN SHALL NOT BE LESS THAN THE WIDTH OF THE SUPPORTED MEMBER. BUILT-UP WOOD COLUMNS SHALL BE NAILED TOGETHER WITH NOT LESS THAN 3" (76) NAILS SPACED NOT MORE THAN 11 3/4" (300) O.C. THE NUMBER OF STUDS IN A WALL DIRECTLY BELOW A GIRDER TRUSS OR ROOF BEAM SHALL CONFORM TO TABLES A-34 TO A-37. (9.17.4., 9.23.10.7.)


TWO STOREY VOLUME SPACE. SEE CONSTRUCTION NOTE 39.
VARYING PLATES, BUILT-OUT FLOORS, BEARING WALLS, ICE & WATER SHIELD
EXPOSED BUILDING FACE - O.B.C. 9.10.14, OR 9.10.15.
REFER TO HEX NOTE 35. & DETAILS FOR TYPE AND SPECIFICATIONS.

1 HR. PARTY WALL REFER TO HEX NOTE 40.	2 HR. FIREWALL REFER TO HEX NOTE 40A.
---	--

SECTION 4.0. CLIMATIC DATA

DESIGN SNOW LOAD (9.4.2.2.):	1.23 kPa
WIND LOAD (q50) (SB-1.2.):	0.44 kPa

STAMP

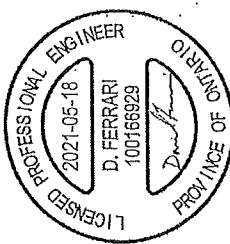


FOR STRUCTURAL ONLY
NOT INCLUDING ENGINEERED
FLOOR OR ROOF SYSTEM

CONSTRUCTION NOTES 2

FIRE RATINGS - PARTY WALL TRUSS SPACE (OBC REF. - SB-2.3)		
COMPONENT	FIRE RATING	CODE REFERENCE
5/8" (15.9mm) TYPE X GYPSUM WALL BOARD	40 min.	O.B.C. SB-2.3.4.(2) (TABLE 2.3.4.A)
WOOD TRUSSES	NO RATING ASSIGNED	
5/8" (15.9mm) TYPE X GYPSUM WALL BOARD	40 min.	O.B.C. SB-2.3.4.(2) (TABLE 2.3.4.A)
TOTAL FIRE RATING	80 min.	O.B.C. SB-2.3.4.(1)

FIRE & SOUND RATINGS - PARTY WALL			
WIBC	WALL TYPE	CODE REFERENCE	RATING
		O.B.C. SB-3	54 STC 10 IIR FRR

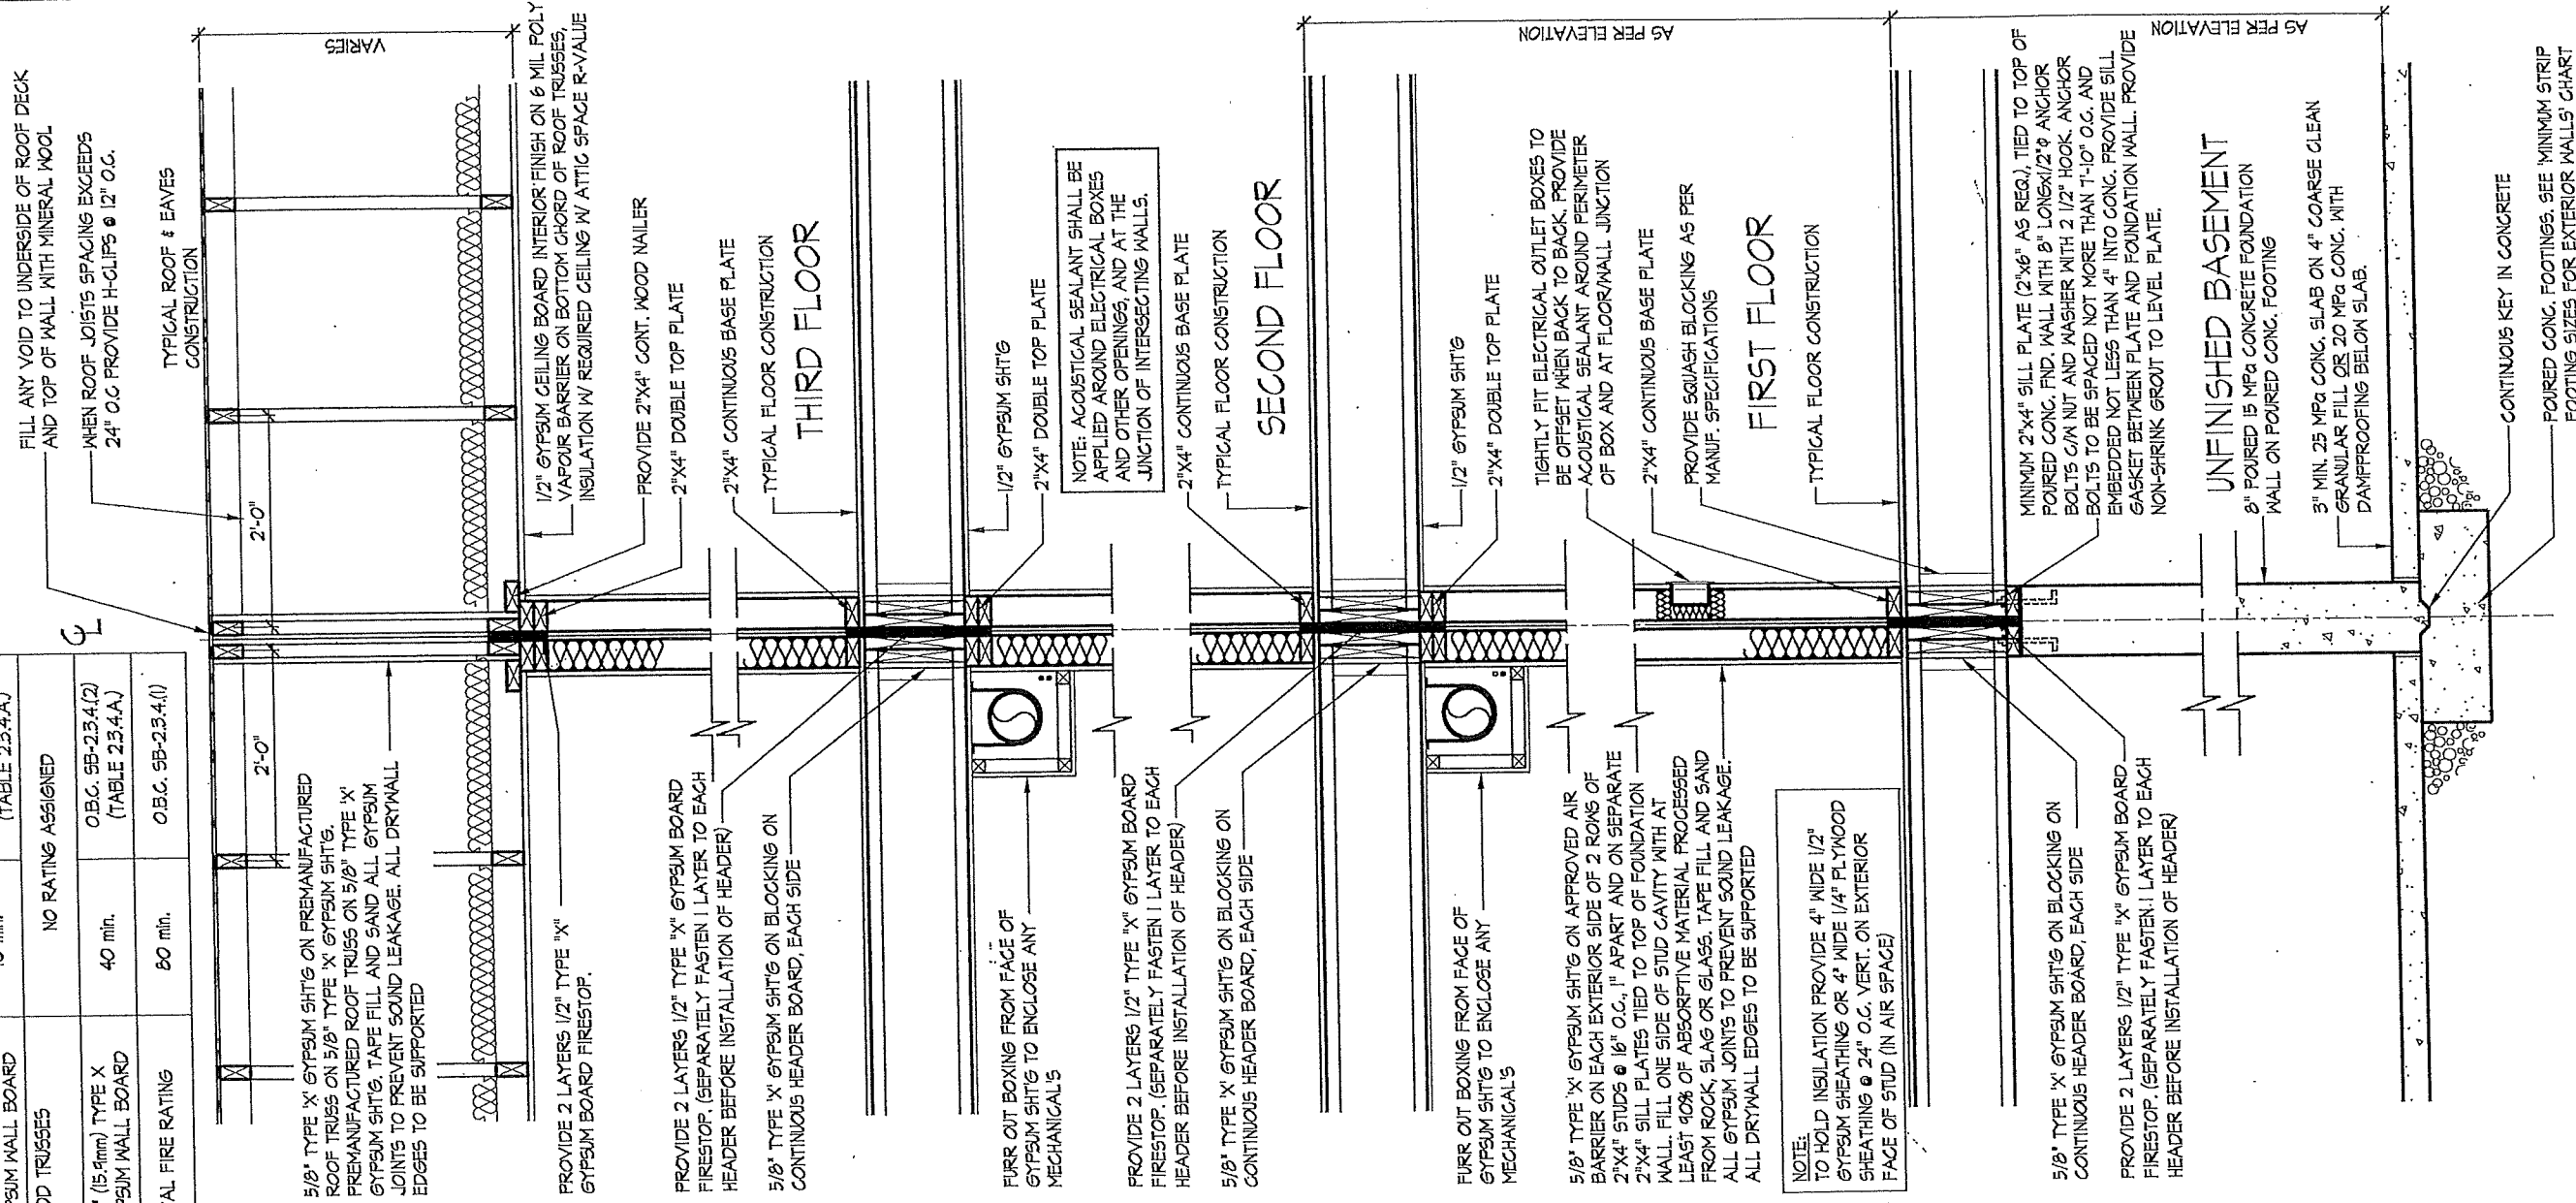

NOTE: POURED CONC. FOOTING ON NATURAL UNDISTURBED SOIL OF 15MPa OR COMPACTED ENGINEERED FILL WITH MIN. BEARING CAPACITY OF 150KPa. FOOTING SIZE SHOWN FOR 16'-0" (4.9m) MAXIMUM JOIST SPAN ONLY. JOIST SPAN EXCEEDING 16'-0" (4.9m) SHALL BE ENGINEERED. IF SOIL BEARING DOES NOT MEET MINIMUM CAPACITY, ENGINEERED FOOTINGS ARE REQUIRED. ACTUAL SOIL BEARING CAPACITY TO BE VERIFIED WITH SOIL ENGINEERING REPORT.

MINIMUM STRIP FOOTING SIZES (A15.3)			
NUMBER FLOORS SUPPORTED	SUPPORTING INT. LOAD BEARING MASONRY WALL	SUPPORTING EXTERIOR PARTY WALL	SUPPORTING PARTY WALL
1	16" W x 8" D	16" W x 8" D	16" W x 8" D
2	24" W x 8" D	20" W x 8" D	24" W x 8" D
3	36" W x 14" D	26" W x 9" D	36" W x 14" D

NOTE: FOOTING SIZE SUBJECT TO CERTIFICATION BY A SOIL CONSULTANT

TYPICAL 1 HR PARTY WALL SECTION, PARALLEL ROOF TRUSSES, 2"x4" DOUBLE STUDS - 3 STOREY

02 1/2" = 1'-0"

SB-12 E

PRESCRIPTIVE COM

PARTY WALL

BUILDING COMPO

INSULATION PSI

CEILING W/ ATTIC

CEILING W/O ATTIC

EXPOSED FLOOR

WALLS ABOVE GRA

BASEMENT WALLS

* PROPOSED VAL

BELOW GRADE SL

EDGE OF BELOW C

HEATED SLAB OR

WINDOWS & DOOR

WINDOWS/SLIDING

SKYLIGHTS (MAX. I

APPLIANCE EFFICI

SPACE HEATING E

HRV EFFICIENCY (

DHW HEATER (EF

AREA CALCULATION

GROUND FLOOR AREA

MAIN FLOOR AREA

THIRD FLOOR AREA

SUBTOTAL

DEDUCT ALL OPEN ARE

TOTAL NET AREA

COVERAGE

W/OUT PORCH

COVERAGE

W/ PORCH

WINDOW / WALL AREA


CALCULATIONS

GROSS WALL AREA

GROSS WINDOW ARE

(INCL. GLASS DOORS & SKYLIG

TOTAL WINDOW %

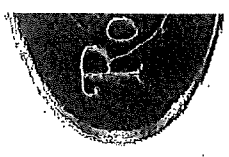

THE UNDERSIGNED HAS REVIEWED