


GROUND TO SECOND
122" HT 11-7/8" JOIST

BASEMENT TO GROUND
BSMT 11-7/8" JOIST

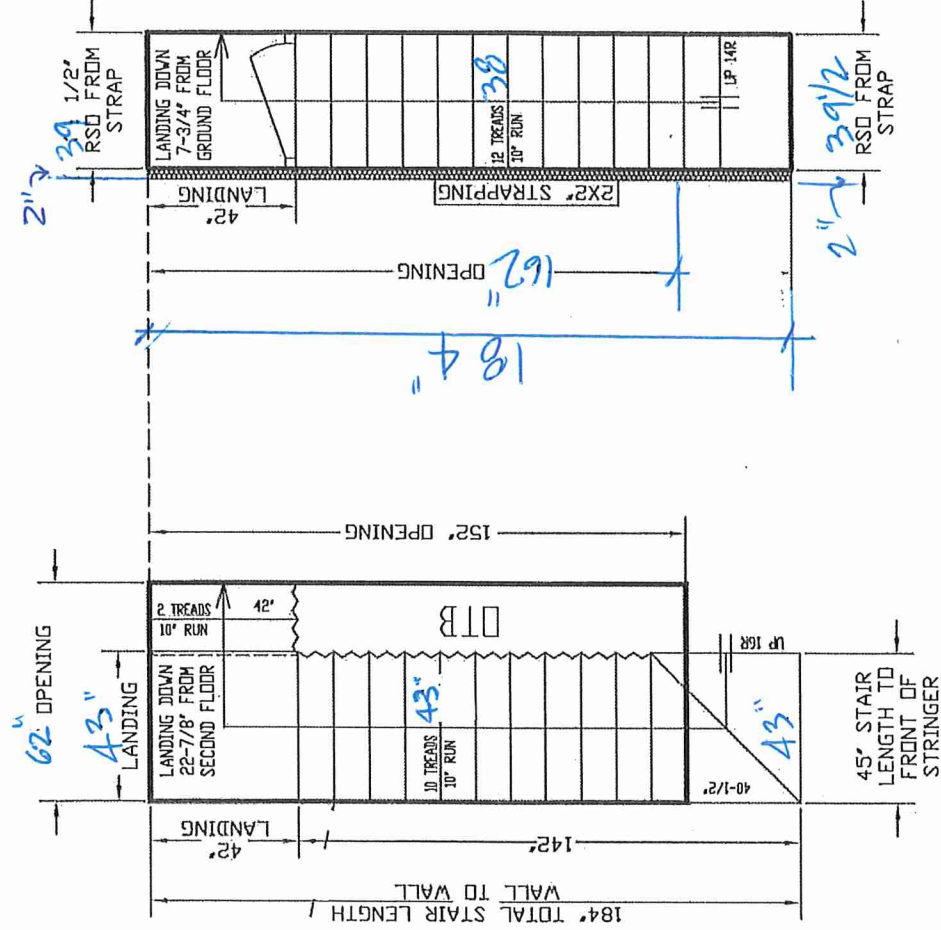

STAIRS LINE UP BY
PARTY WALL

ALL OPENINGS ARE ALLOWED
FOR 1 LAYER OF DRY WALL
ANY ADDITIONAL LAYERS MUST
BE ALLOWED BY CARPENTERS

NO WALLS UNTIL
STAIRS INSTALLED

GARAGE RIGHT >



Quality On Step Up On

ALL LANDINGS TO BE SUPPLIED AND SUPPORTED BY OTHERS UNLESS SPECIFIED ABOVE
ANY STAIRS OR RAILINGS TO BE COMPLETED BY CARPENTERS
ALL STAIR DIMENSIONS MAY BE MODIFIED FROM ORIGINAL SELLER'S SPECIFICATIONS AS SUPPLIED
TO ALPHA STAIRS AND RAILINGS INC. FOR CONSTRUCTION OF STAIRS AND RAILINGS
STAIRS AND RAILINGS INC. WILL NOT BE RESPONSIBLE FOR ANY DISCREPANCIES BETWEEN
CARPENTERS OR SITE OFFICERS TO MAKE SURE THERE ARE NO DISCREPANCIES BEFORE PROCEEDING
WITH CONSTRUCTION

ALPHA STAIRS AND RAILINGS INC.
3770 WASHURA DRIVE, UNIT 3 MISSISSAUGA, ONTARIO L4V 1H6
TEL: (905) 694-9556 | www.alphastairs.com



SITE

CENTREFIELD

CLIENT

ROYAL PINE HOMES



LAYOUT #

SCALE: 1/8" = 1'-0"

DATE

APRIL 9, 2025

PORTAL COPY 747 70

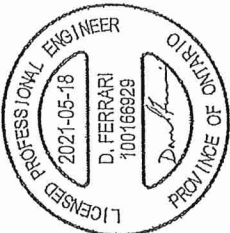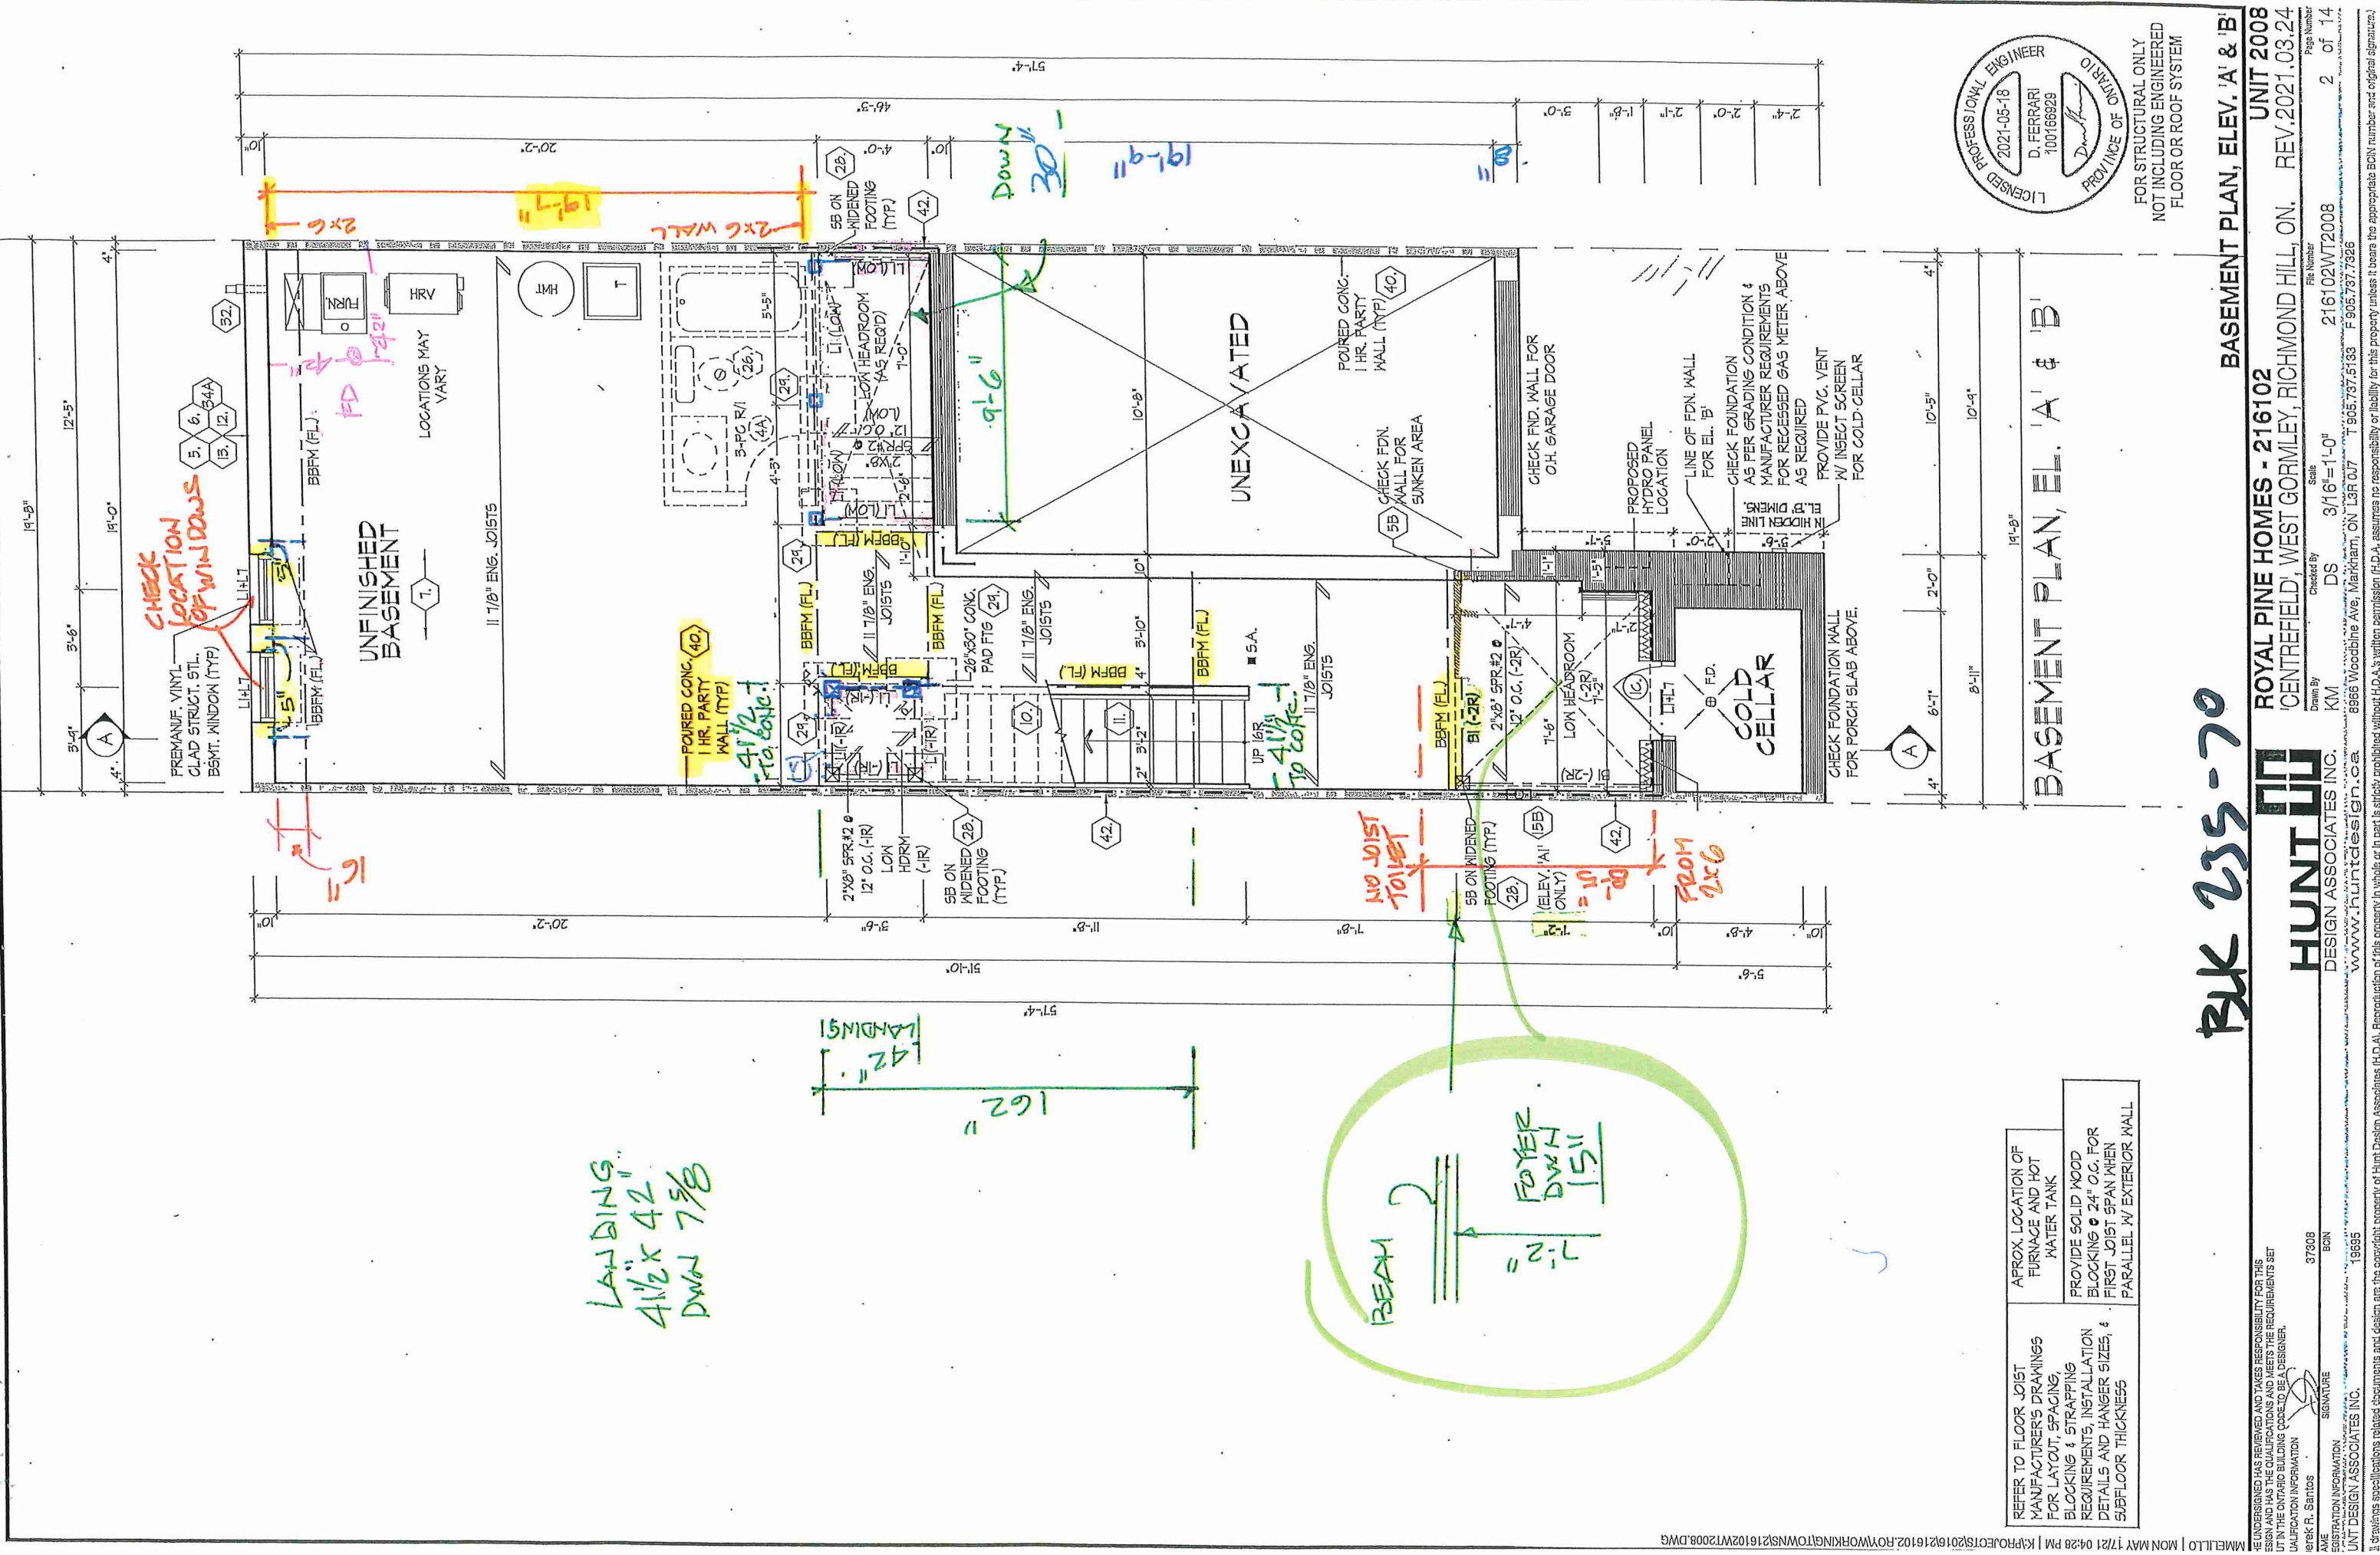

FOR STRUCTURAL ONLY
NOT INCLUDING ENGINEERED
FLOOR OR ROOF SYSTEM

BASEMENT PLAN, EL. 'A' & 'B'

BK 235-70

BASEMENT PLAN, ELEV. 'A' & 'B'


ROYAL PINE HOMES - 216102
'CENTREFIELD', WEST GORMLEY, RICHMOND HILL, ON. REV. 2021.03.24

HUNT
DESIGN ASSOCIATES INC.
www.hunt-design.ca




37308
BON
19695
Signature of Derek R. Santos

1. Drawings are the copyright property of Hunt Design Associates (H.D.A.). Reproduction of this property in whole or in part is strictly prohibited without H.D.A.'s written permission. (H.D.A. assumes no responsibility or liability for this property unless it bears the appropriate BDN number and original signature.)

- WINDOWS + SLIDING DOOR = 96
- ARCHES = 95 1/2
- FRONT DOOR 95"
- DOORS = 83 1/2"

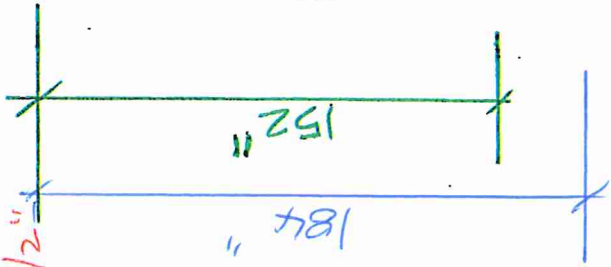

MASONRY WALL	SOLID MASONRY WALL W/ 10'-10" VERT. REBARS (LAP 1'-6" GROUTED INTO BRICK JOINT)
	2"x6" SILL PLATE TOP ANCHORED TO SOLID MASONRY WALL W/ 1/2" x 12" BOLTS 24" O.C. STAGGERED
	MASONRY VENEER TIED TO MASONRY VENEER WITH GALV. METAL TIES 16" O.C. AND 24" VERTICAL. FILL VOID BETWEEN MASONRY VENEER WITHES SOLID W/ MORTAR
	* 2"x4" STUD WALL ASSEMBLY EXCEEDING MAX. UNSUPPORTED HEIGHT FOR WALLS GREATER THAN 9'-10" TO MAX. 12'-0" HIGH, - W/O FLOOR LOAD, DOUBLE UP EVERY 5TH STUD 16" O.C. - W/ FLOOR LOAD DOUBLE UP EVERY 5TH STUD 12" O.C. PROVIDE BLOCKING EVERY 4'-0" O.C. VERTICAL.
	REFER TO FLOOR JOIST MANUFACTURER'S DRAWINGS FOR LAYOUT, SPACING, BLOCKING & STRAPPING REQUIREMENTS, INSTALLATION DETAILS AND HANGER SIZES, & SUBFLOOR THICKNESS
	ALL DOORS ON PLAN ARE 1'-10" HIGH TOP OF FRAME, UNLESS LABELED OTHERWISE.
	PROVIDE SOLID WOOD BLOCKING 24" O.C. FOR FIRST JOIST SPAN WHEN PARALLEL W/ EXTERIOR WALL

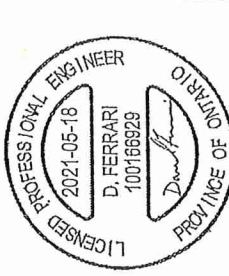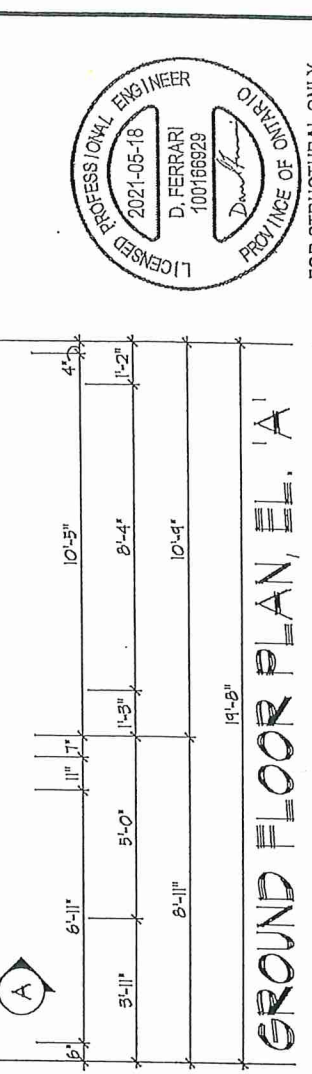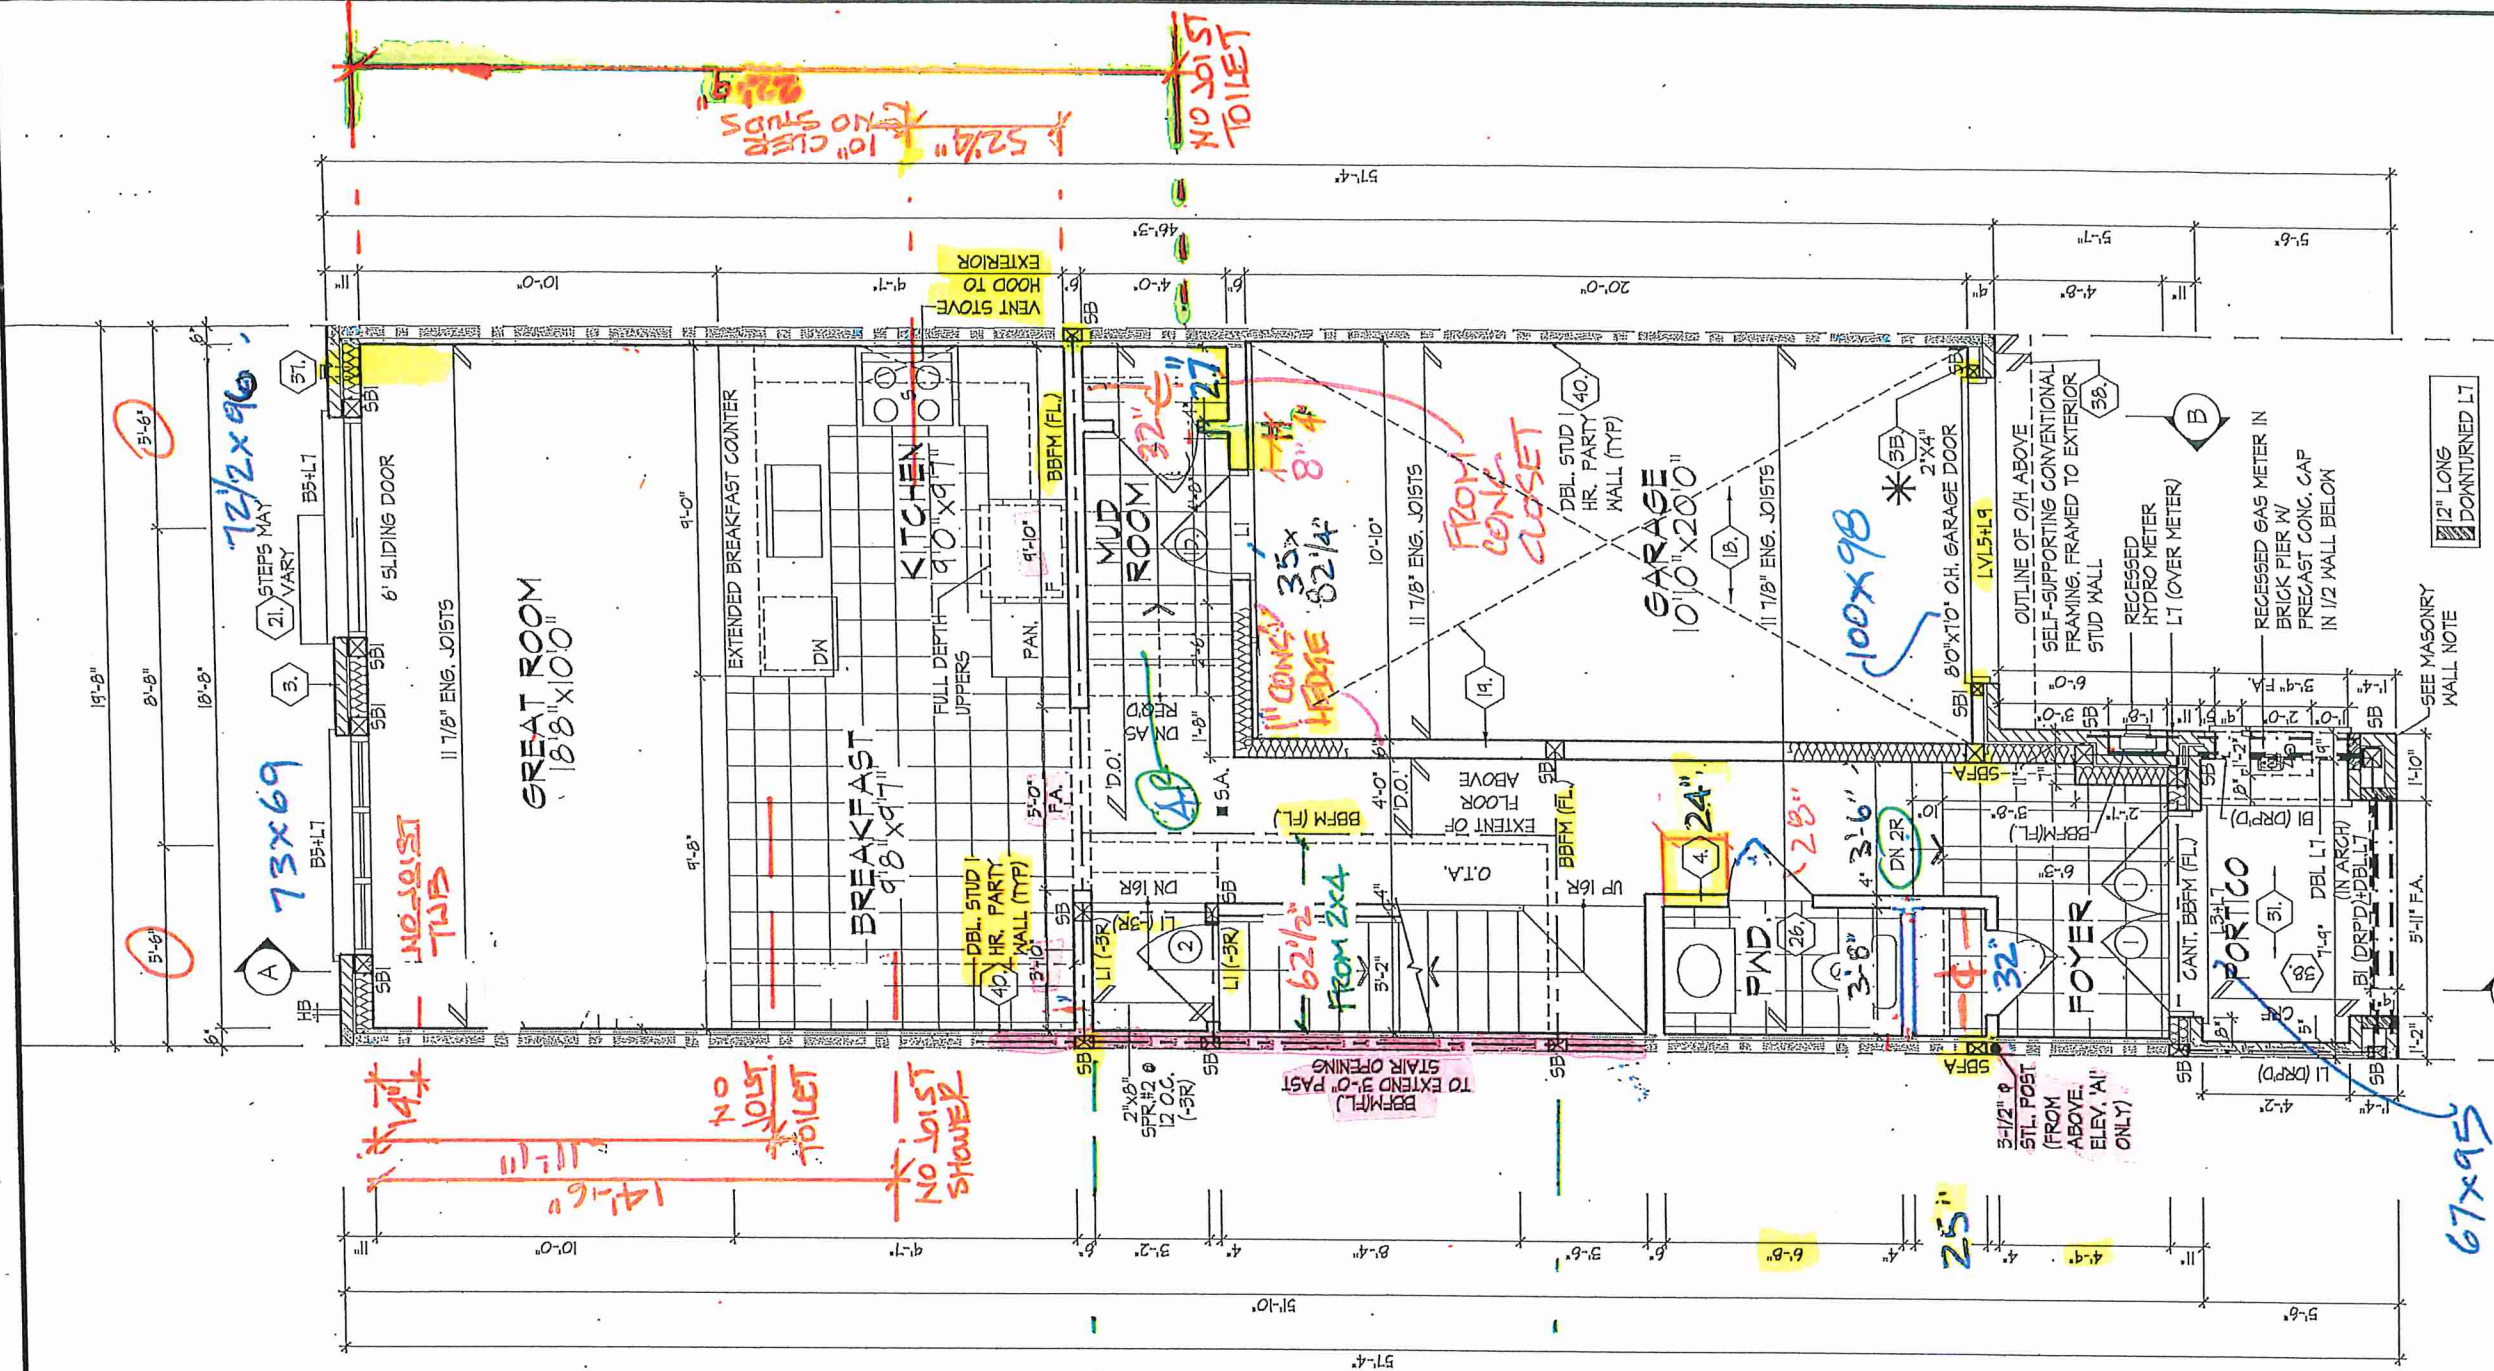


FOR STRUCTURAL ONLY
NOT INCLUDING ENGINEERED
FLOOR OR ROOF SYSTEM

GROUND FLOOR PLAN, EL. 'A'

BK 235-70

GROUND FLOOR PLAN, EL. 'A'

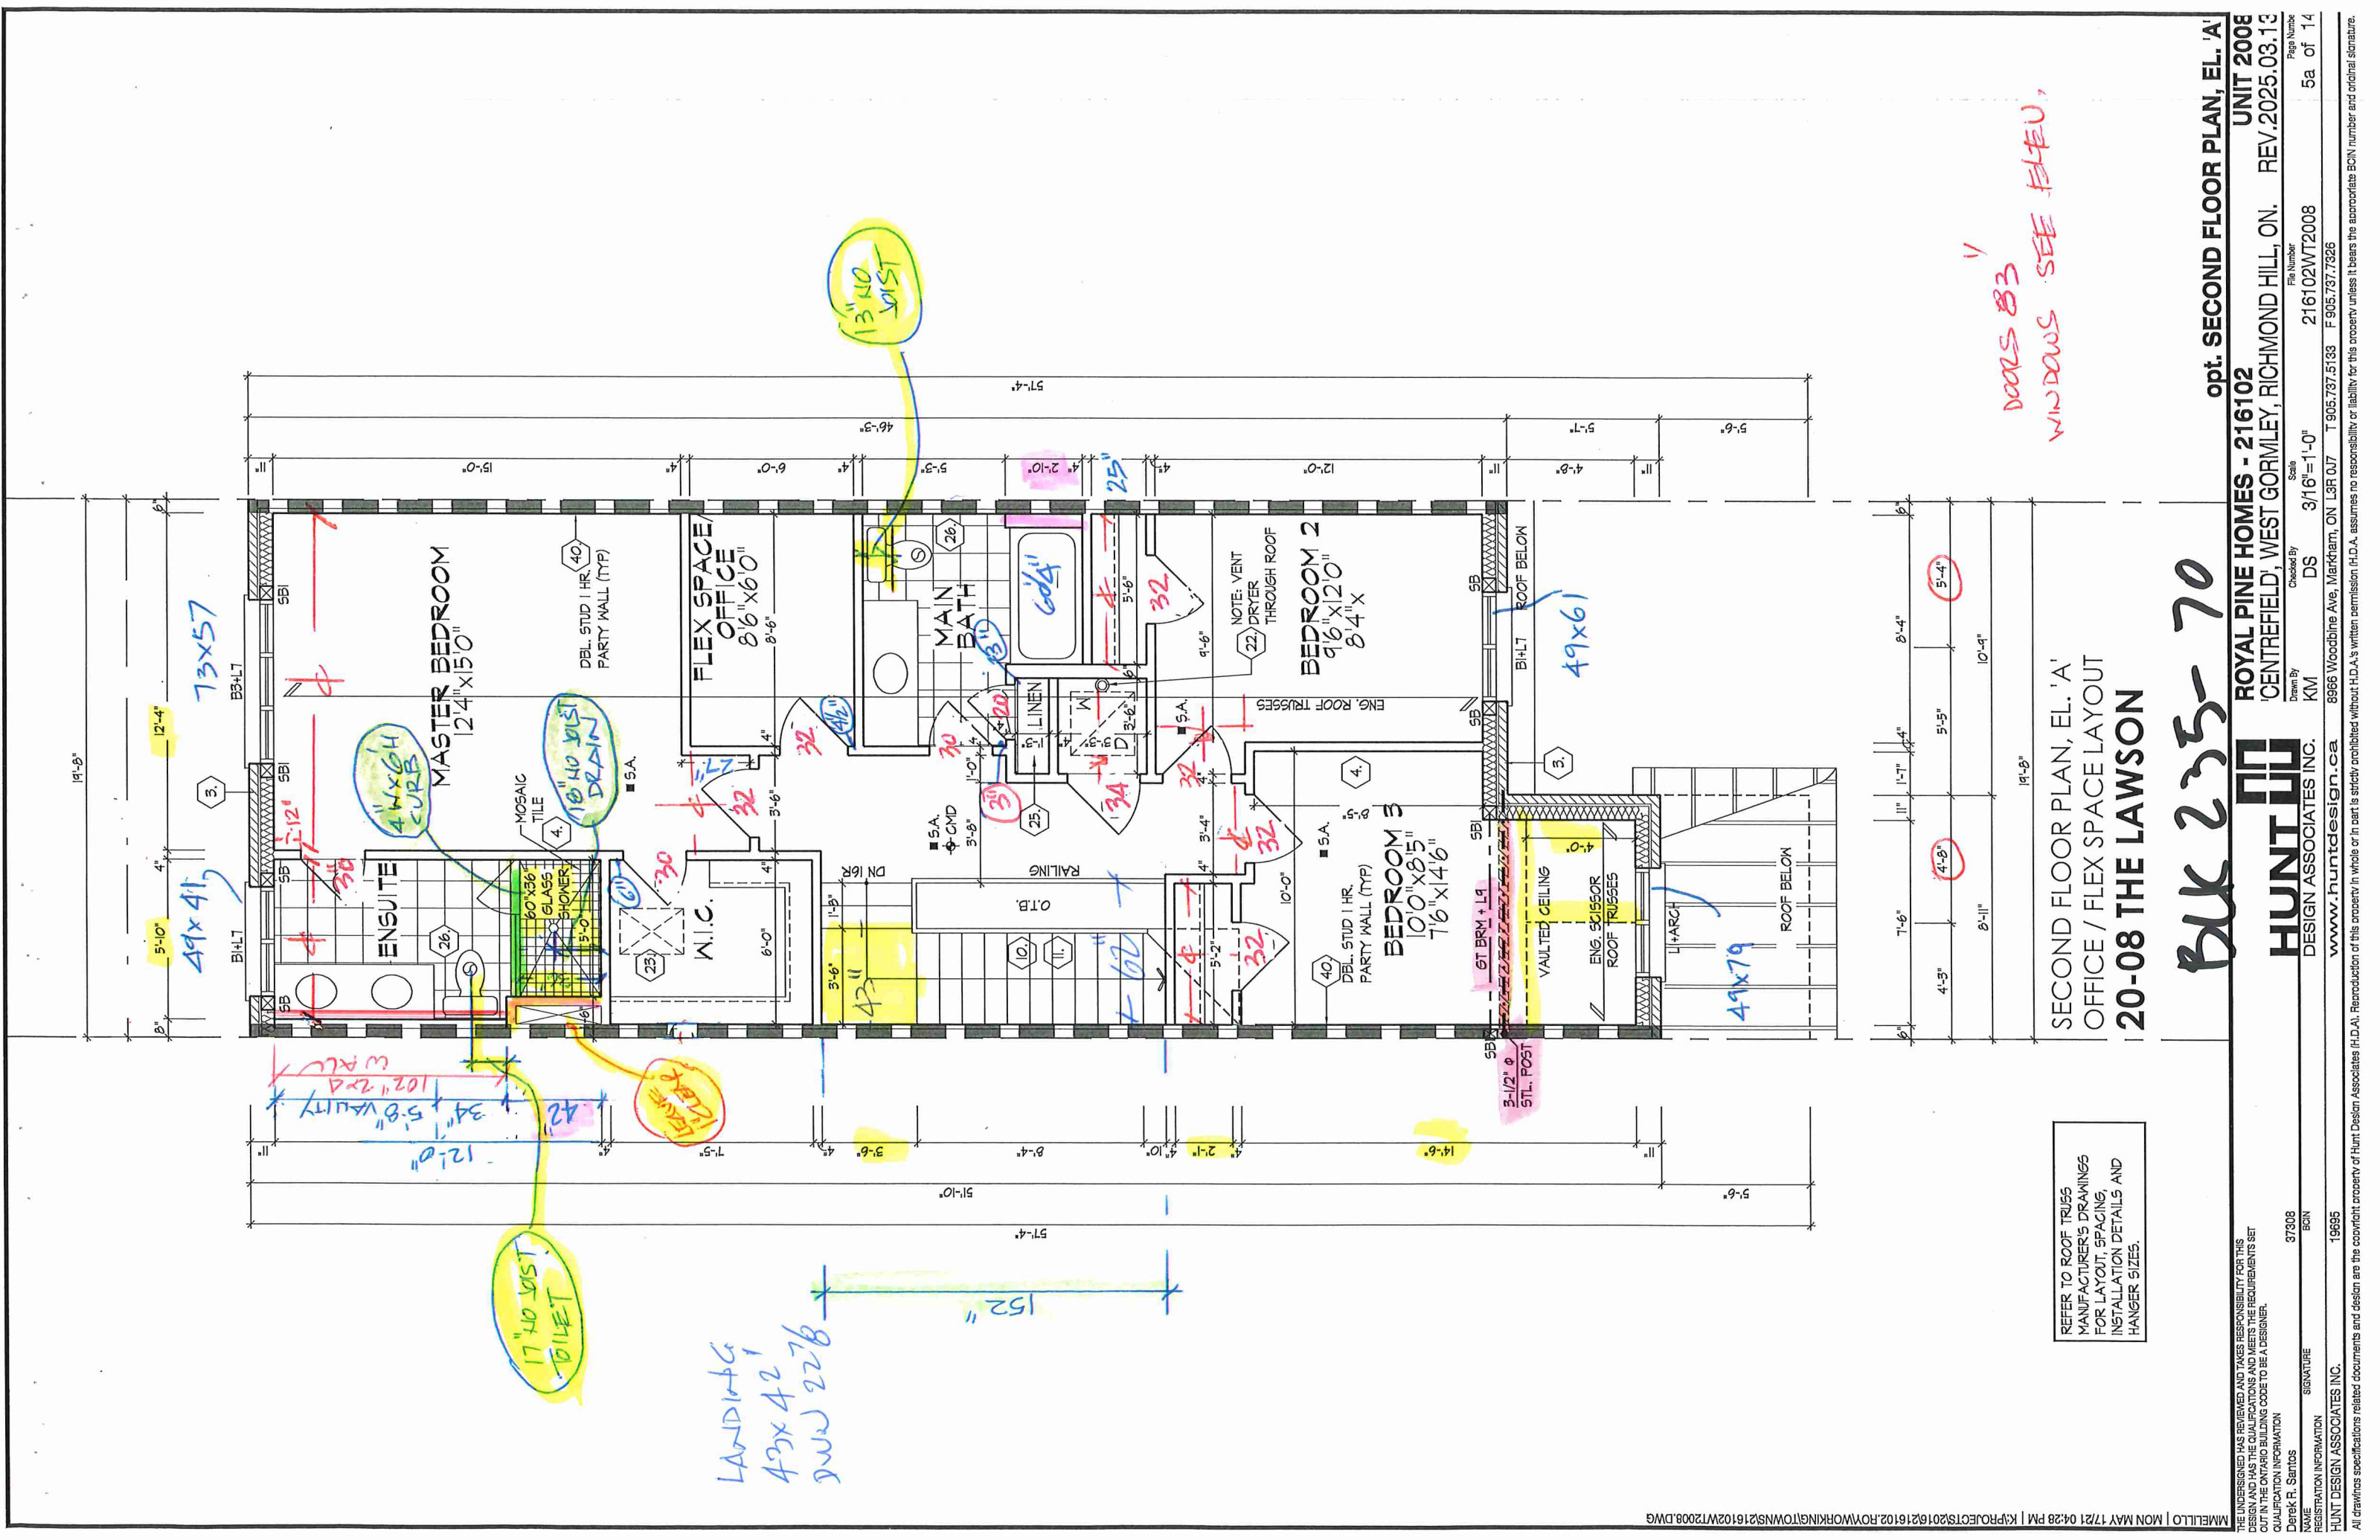

REFER TO ROOF TRUSS
MANUFACTURER'S DRAWINGS
FOR LAYOUT, SPACING,
INSTALLATION DETAILS AND
HANGER SIZES.

SECOND FLOOR PLAN, EL. 'A'
OFFICE / FLEX SPACE LAYOUT
20-08 THE LAWSON

DOORS 83
WINDOWS SEE FLEU,

BK 235-70

opt. SECOND FLOOR PLAN, EL. 'A'

ROYAL PINE HOMES - 216102
'CENTREFIELD', WEST GORMLEY, RICHMOND HILL, ON. REV.2025.03.13




THE UNDERSIGNED HAS REVIEWED AND TAKES RESPONSIBILITY FOR THIS
DESIGN AND HAS THE QUALIFICATIONS AND MEETS THE REQUIREMENTS SET
OUT IN THE ONTARIO BUILDING CODE TO BE A DESIGNER.

NAME	Derek R. Santos	37308	BCIN	19695
REGISTRATION INFORMATION	SIGNATURE			
HUNT DESIGN ASSOCIATES INC.				
Drawn By	DS	3/16"=1'-0"	216102WT2008	5a of 14
Checked By	DS			
Scale				
File Number				
Page Number				

www.huntdesign.ca 8966 Woodbine Ave, Markham, ON L3R 0J7 T 905.737.5133 F 905.737.7826
Reproduction of this property in whole or in part is strictly prohibited without H.D.A.'s written permission (H.D.A. assumes no responsibility or liability for this property unless it bears the appropriate BCIN number and original signature).

Architectural drawing of a building facade showing a double door and a window. The door is labeled "6'-0" T/O DOOR" and "FG". The window is labeled "41-5 1/8" O/F SOFFIT" and "FG". The drawing includes dimensions and a section line "RWL".

W Architect Inc.
DESIGN CONTROL REVIEW
MAY 31, 2021
FINAL BY: Allen
This stamp is only for the purposes of design control and carries no other professional obligations

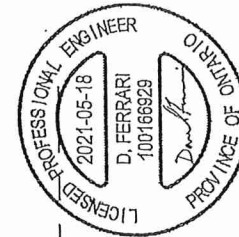

FOR STRUCTURAL ONLY
NOT INCLUDING ENGINEERED
FLOOR OR ROOF SYSTEM

PK 235-70

FRONT ELEVATION 'A' & REAR ELEV. 'A' & 'B'
ES - 216102 UNIT 2008

ROYAL PINE HOMES - 216102



HUNT
DESIGN ASSOCIATES INC.

THE UNDERSIGNED HAS REVIEWED AND TAKES RESPONSIBILITY FOR THIS DESIGN AND HAS THE QUALIFICATIONS AND MEETS THE REQUIREMENTS SET OUT IN THE ONTARIO BUILDING ACT AND REGULATION.	3730
	BC
NAME	SIGNATURE
Derek R. Santos	
REGISTRATION INFORMATION	QUALIFICATION INFORMATION

[illegible]

PART. FRONT
ELEVATION 'A2'

FRONT ELEVATION 'A'

REAR ELEVATION 'A' & 'B'

GARAGE ROOF
18" O.H + 18/12 PITCH

 73×57 49×41

72 1/2 x	
96	

 73×69

STEPS MAY VARY

8'0" x 7'0" O.H. GARAGE DOOR

 67×95

100×98

—STEPPED FOOTINGS $\sqrt{30}$

21. STEPS
MAY VAR

6" POURED CONC.
DOOR SILL

TOP OF BASEMENT SLAB

TOP OF PLATE

TOP OF WINDOW

FIN. MAIN FLO

TOP OF WINDOW/DOOR

FIN. GROUND FLOOR

FIN. GRADE @ REAR

Derek R. Santos

NAME
REGISTRATION INFORMATION

HUNT DESIGN AS

All drawings specific

THE UNDERSIGNED HAS REVIEWED AND TAKES RESPONSIBILITY FOR THIS DESIGN AND HAS THE QUALIFICATIONS AND MEETS THE REQUIREMENTS SET OUT IN THE ONTARIO BUILDING CODE TO BE A DESIGNER.

QUALIFICATION INFORMATION

Derek R. Santos

NAME

REGISTRATION INFORMATION

HUNT DESIGN ASSOCIATES INC.

SIGNATURE

37308

BCIN

19695

At drawings specifications related documents and design are the copyright property of Hunt Design Associates (H.D.A.). Reproduction of this property in whole or in part is strictly prohibited without H.D.A.'s written permission (H.D.A. assumes no responsibility or liability for this property unless it bears the appropriate BCIN number and original signature.)

HUNT
DESIGN ASSOCIATES INC.
www.huntdesign.ca

ROYAL PINE HOMES - 216102
'CENTREFIELD', WEST GORMLEY, RICHMOND HILL, ON.

UNIT 2008
REV. 2021.03.24

Drawn By
KM

Checked By
DS


Scale
3/16"=1'-0"

File Number
216102WT2008


Page Number
11 of 14

PART. SECTIONS 'B'


FOR STRUCTURAL ONLY
NOT INCLUDING ENGINEERED
FLOOR OR ROOF SYSTEM

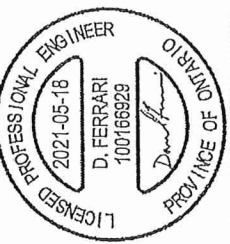


W Architect Inc.
DESIGN CONTROL REVIEW
MAY 31, 2021
FINAL BY: *AE*
This stamp is only for the purposes of design control and carries no other professional obligations.

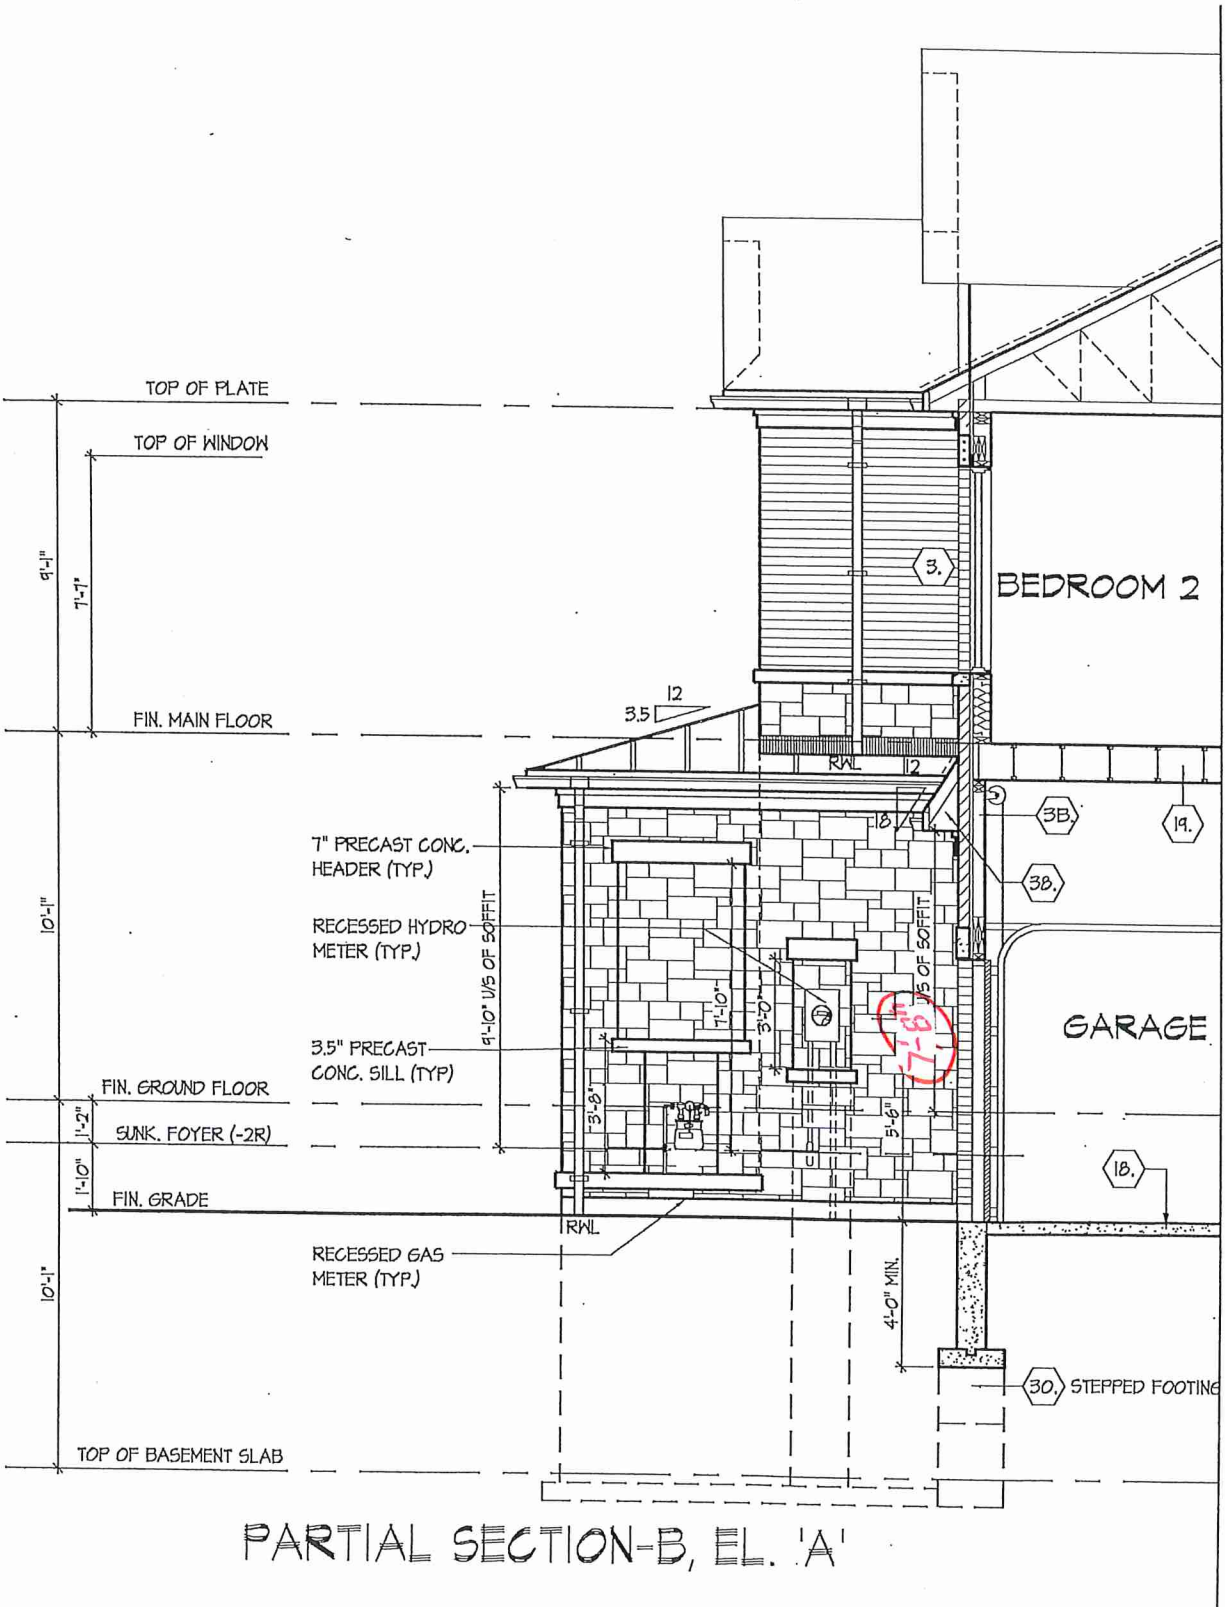

RK 23570

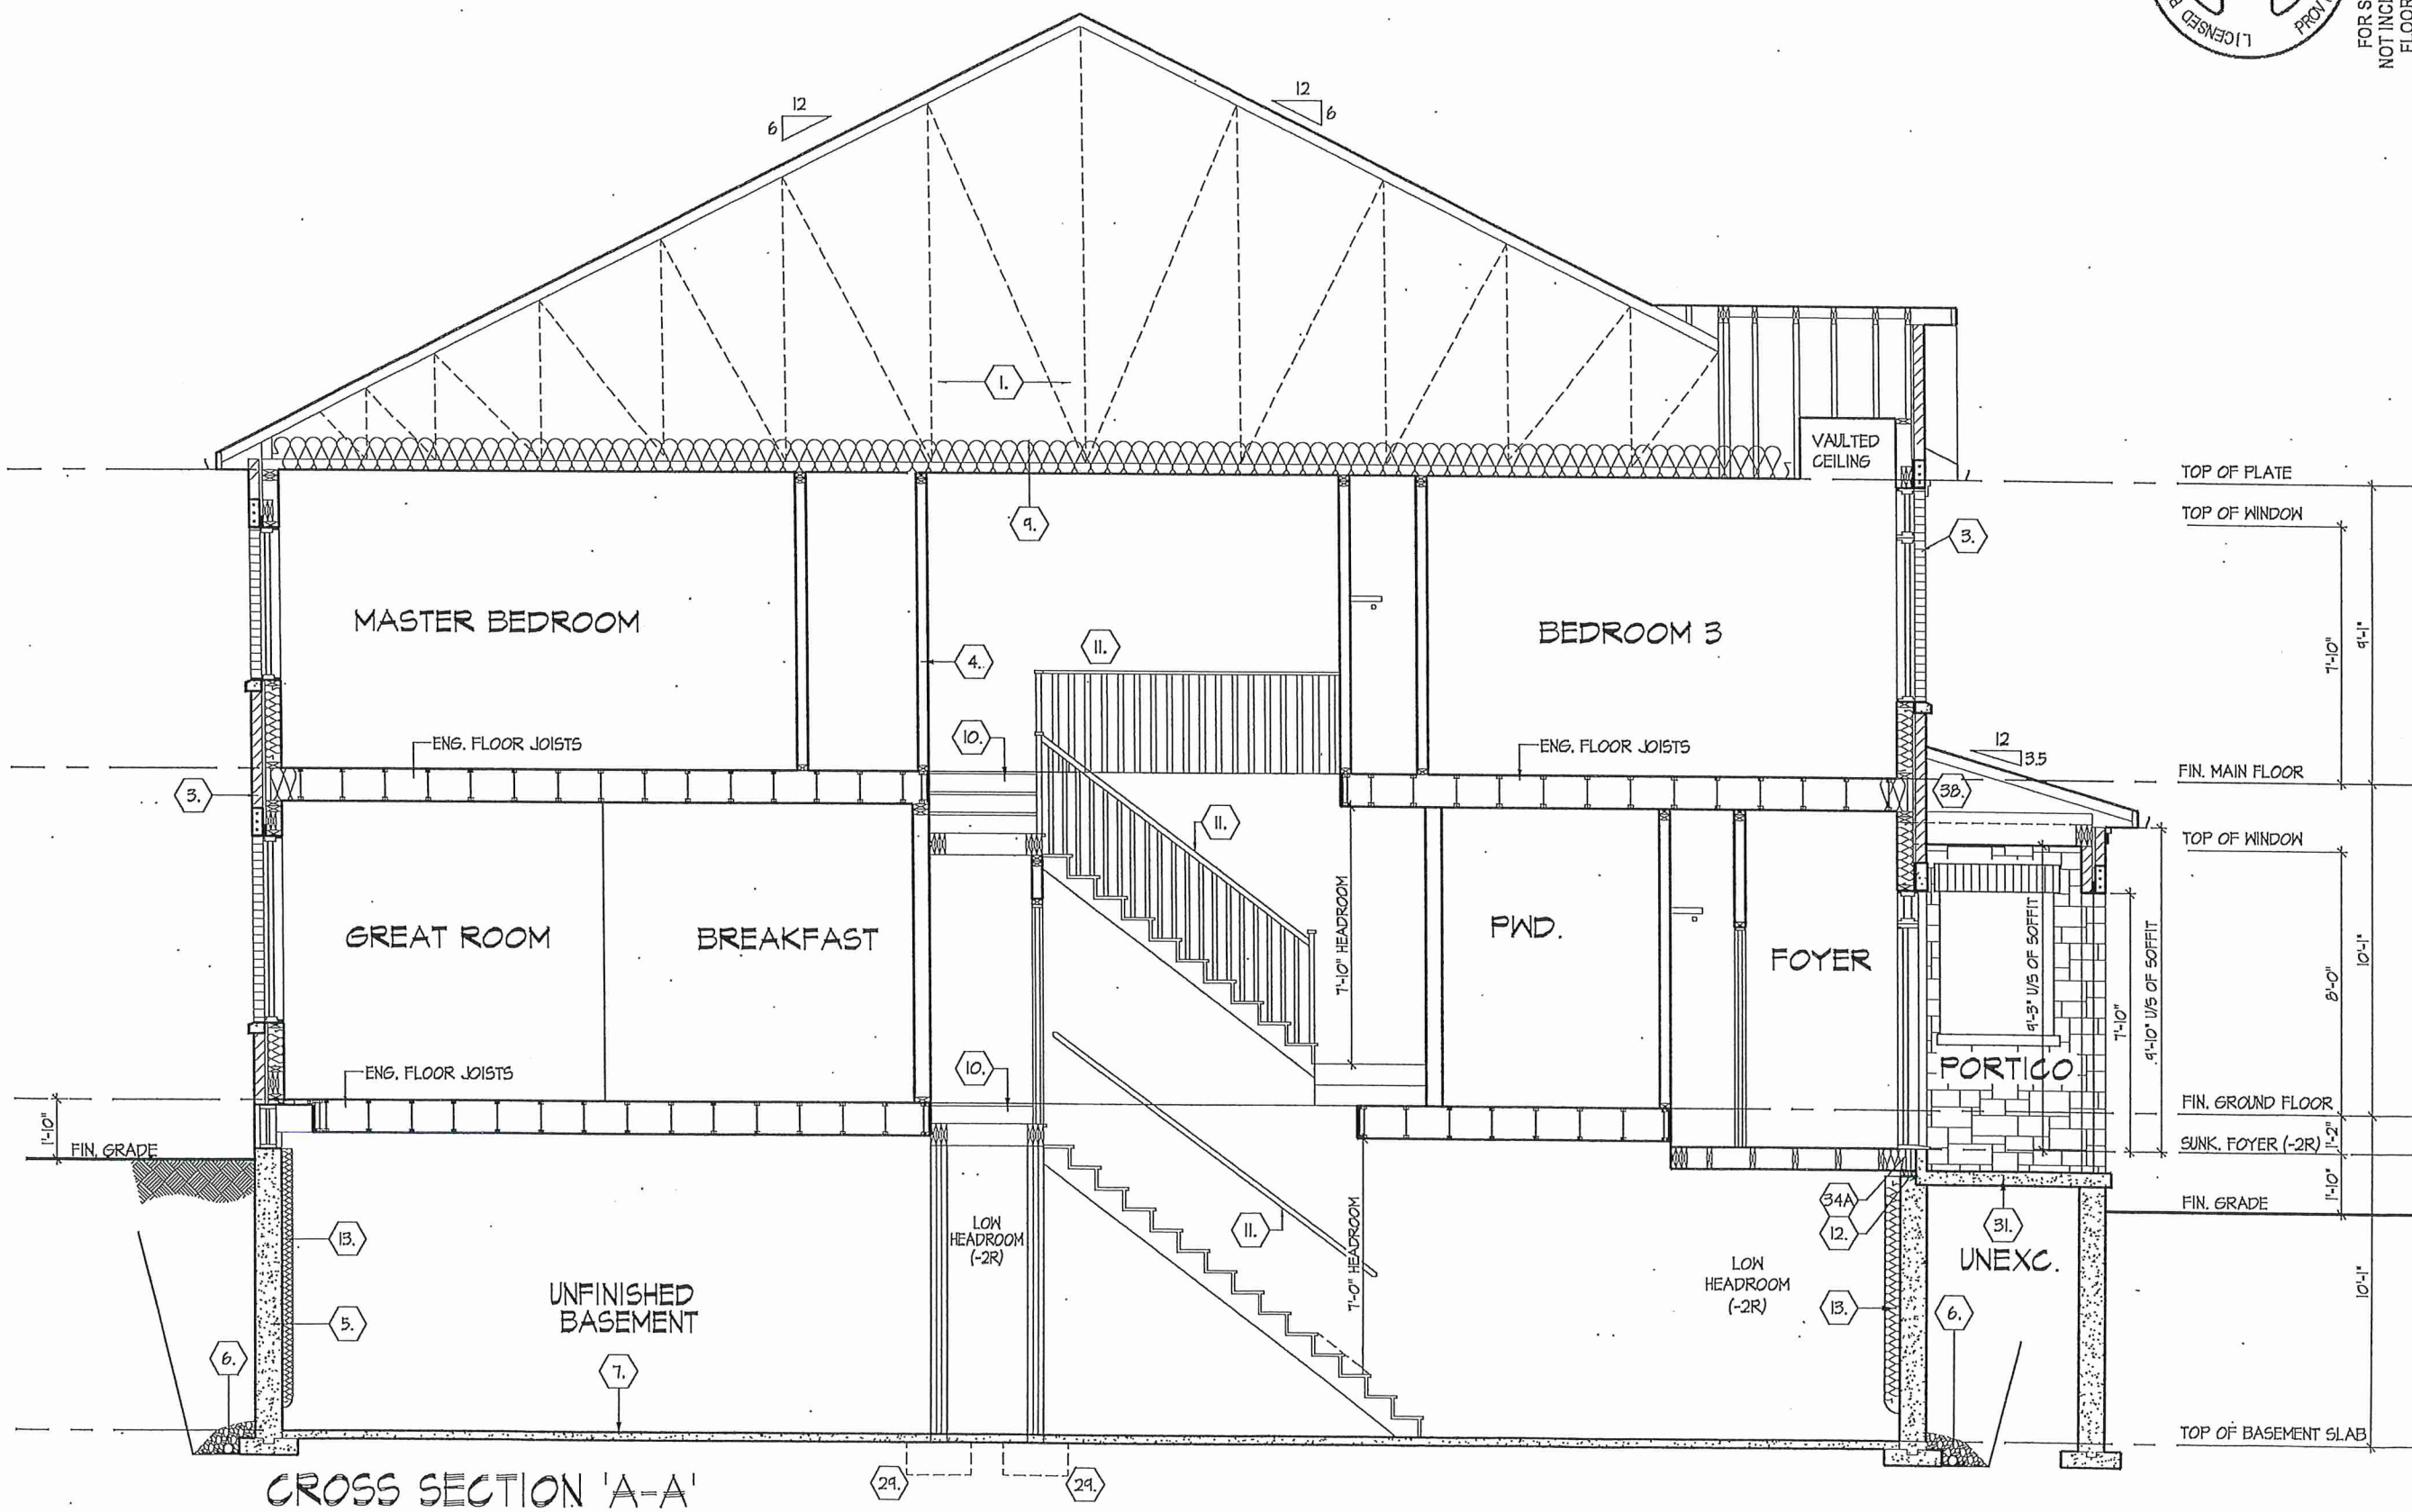

CROSS SECTION 'A-A'

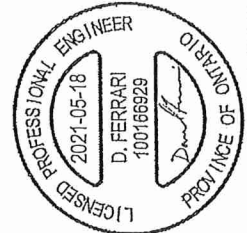

FOR STRUCTURAL ONLY
NOT INCLUDING ENGINEERED
FLOOR OR ROOF SYSTEM

CROSS SECTION 'A-A'

UNIT 2008

ROYAL PINE HOMES - 216102
'CENTREFIELD', WEST GORMLEY, RICHMOND HILL, ON. REV. 2021.03.24

Drawn By: DS
Checked By: DS
Scale: 3/16"=1'-0"
File Number: 216102WT2008
Page Number: 10 of 14



THE UNDERSIGNED HAS REVIEWED AND TAKES RESPONSIBILITY FOR THIS DESIGN AND HAS THE QUALIFICATIONS AND MEETS THE REQUIREMENTS SET OUT IN THE ONTARIO BUILDING CODE TO BE A DESIGNER.
Derek R. Santos
REGISTRATION INFORMATION
HUNT DESIGN ASSOCIATES INC.
37308 BCN 19895

All drawings specifications related documents and design are the copyright property of Hunt Design Associates (H.D.A.). Reproduction of this property in whole or in part is strictly prohibited without H.D.A.'s written permission (H.D.A. assumes no responsibility or liability for this property unless it bears the appropriate BCN number and original signature.)

cont. SECTION 1.0. CONSTRUCTION NOTES

- 40

1 HR. PARTY WALL (CONC. BLOCK). (SB-3) WALL TYPE B&B & B1b)
1/2" (12.7) GYPSUM SHEATHING ON EACH SIDE ON 2"x2" (38x38) VERTICAL WD. STRAPPING @ 24" (610) O.C. ON 8" (203) CONC. BLOCK FILL STRAPPING CAVITY EACH SIDE WITH AT LEAST 80% OF ABSORPTIVE MATERIAL PROCESSED FROM ROCK, SLAG OR GLASS. TAPE, FILL & SAND ALL GYPSUM JOINTS. EXPOSED BLOCK MUST BE SEALED W/ 2 COATS OF PAINT OR FURRED WITH 2"x2" (38x38) WD. STRAPPING & 1/2" (12.7) GYPSUM SHEATHING.
- 40

1 HR. PARTY WALL (DOUBLE STUD). (SB-3) WALL TYPE W19b)
5/8" (15.9) TYPE X GYPSUM SHEATHING ON EXTERIOR SIDE OF 2 ROWS OF 2"x4" (38x89) STUDS @ 16" (408) O.C. MIN. 1" (25) APART ON SEPARATE 2"x4" (38x89) SILL PLATES. (2"x8" (38x140) AS REQUIRED) FILL ONE SIDE OF STUD CAVITY WITH AT LEAST 80% OF ABSORPTIVE MATERIAL PROCESSED FROM ROCK, SLAG OR GLASS. TAPE FILL AND SAND ALL GYPSUM JOINTS.
- 40A

2 HR. FIREWALL (SB-3) WALL TYPE B&B & B1b)
1/2" (12.7) GYPSUM SHEATHING ON EACH SIDE ON 2"x2" (38x38) VERTICAL WD. STRAPPING @ 24" (610) O.C. ON 8" (203) CONC. BLOCK 75% SOLID. FILL STRAPPING CAVITY EACH SIDE WITH AT LEAST 80% OF ABSORPTIVE MATERIAL PROCESSED FROM ROCK, SLAG OR GLASS. TAPE, FILL & SAND ALL GYPSUM JOINTS. AT UNFINISHED AREAS, EXTERIOR FACE OF CONC. BLOCK TO BE SEALED WITH 2 COATS OF PAINT. GYPSUM SHEATHING TO BE ATTACHED TO CONC. BLOCK. (REFER TO DETAILS)
- 41

STUCCO WALL CONSTRUCTION (2"x6")
STUCCO FINISH CONFORMING TO O.B.C. SECTION 9.2B. AND APPLIED PER MANUFACTURERS SPECIFICATIONS OVER 1/2" (38) E.F.S. (MINIMUM) ON APPROVED DRAINAGE MAT ON 1/2" (12.7) DENIGLASS GOLD GYPSUM BOARD ON STUDS CONFORMING TO O.B.C. (2.3.10.1.) & SECTION 1.1. INSULATION APPROVED 8 MIL. POLYETHYLENE VAPOUR BARRIER. 1/2" (12.7) GYPSUM WALLBOARD INT. FINISH. (REFER TO 35 NOTE AS REQUIRED)
- 41A

STUCCO WALL CONSTRUCTION (2"x6") W/ CONTIN. INSUL-
STUCCO FINISH CONFORMING TO O.B.C. SECTION 9.2B. AND APPLIED PER MANUFACTURERS SPECIFICATIONS OVER 1/2" (38) E.F.S. (MINIMUM) ON APPROVED DRAINAGE MAT ON APPROVED AIRWATER BARRIER AS PER O.B.C. 9.27.3. ON EXTERIOR TYPE RIGID INSULATION (JOINTS UNTAPED) MECHANICALLY FASTENED AS PER MANUFACTURERS SPECIFICATIONS. ON 7/16" EXTERIOR TYPE SHEATHING ON STUDS CONFORMING TO O.B.C. (2.3.10.1.) & SECTION 1.1. INSULATION APPROVED 8 MIL. POLYETHYLENE VAPOUR BARRIER. 1/2" (12.7) GYPSUM WALLBOARD INT. FINISH. (REFER TO 35 NOTE AS REQUIRED)
- 41B

STUCCO WALL @ GARAGE CONST.
STUCCO FINISH CONFORMING TO O.B.C. SECTION 9.2B. AND APPLIED PER MANUFACTURERS SPECIFICATIONS OVER 1/2" (38) E.F.S. (MINIMUM) ON APPROVED DRAINAGE MAT ON 1/2" (12.7) DENIGLASS GOLD GYPSUM BRD. ON STUDS CONFORMING TO O.B.C. (2.3.10.1.) & SECTION 1.1. 1/2" (12.7) GYPSUM WALLBOARD INT. FINISH. (REFER TO 35 NOTE AS REQ.)
- 42

UNSUPPORTED FOUNDATION WALLS (9.15.4.2.)
REINFORCING AT STAIRS AND SUNKEN FLOOR AREAS
2-20M BARS IN TOP PORTION OF WALL (UP TO 8'-0" OPENING)
3-20M BARS IN TOP PORTION OF WALL (8'-0" TO 10'-0" OPENING)
4-20M BARS IN TOP PORTION OF WALL (10'-0" TO 15'-0" OPENING)
- BARS STACKED VERTICALLY AT INTERIOR FACE OF WALL
REINFORCING AT BASEMENT WINDOWS
2-15M HORIZ. REINFORCING ON THE INSIDE AND OUTSIDE FACE OF THE FOUNDATION WALL BELOW THE WIN. SILL. EXTEND BARS 24" (610) BEYOND THE OPENING. 2-15M VERTICAL REINFORCING ON THE INSIDE AND OUTSIDE FACE OF THE FOUNDATION WALL ON EACH SIDE OF THE WINDOW OPENING.
- BARS TO HAVE MIN. 4" (25) CONC. COVER.
- BARS TO EXTEND 2'-0" (610) BEYOND BOTH SIDES OF OPENING
- 43

STUD WALL REINFORCEMENT
PROVIDE STUD WALL REINFORCEMENT IN MAIN BATHROOM CONFORMING TO O.B.C. (9.5.2.3.(1) AND 3.8.3.5.(8)) (REFER TO DETAILS)
- 44

WINDOW WELLS
WHERE A WINDOW OPENS INTO A WINDOW WELL, A CLEARANCE OF NOT LESS THAN 21 5/8" (550) SHALL BE PROVIDED IN FRONT OF THE WINDOW. EVERY WINDOW WELL SHALL BE DRAINED TO THE FOOTING LEVEL OR OTHER SUITABLE LOCATION WITH A 4" (103) WEEPING TILE C/W A FILTER CLOTH WRAP AND FILLED WITH CRUSHED STONE. (9.9.10.1.(5), 9.14.5.3.)
- 45

SLOPED CEILING CONSTRUCTION (9B-12) 2.1.1.7., 9.23.4.2.)
2X12" (38x89) ROOF-JOISTS @ 16" (408) O.C. MAX. (UNLESS OTHERWISE NOTED) W/ 2"x2" (38x38) PURLINS @ 16" (408) O.C. PERPENDICULAR TO ROOF JOIST (PURLINS NOT REQ. W/ SPRAY FOAM). W/ INSULATION BETWEEN JOIST. 6 MIL POLYETHYLENE VAPOUR BARRIER. 1/2" (12.7) GYPSUM WALLBOARD INT. FINISH OR APPROVED EQ. INSULATION VALUE DIRECTLY ABOVE THE INNER SURFACE OF EXTERIOR WALLS SHALL NOT BE LESS THAN P20 (9.52 PSI).
- 46

FLAT ROOF/BALCONY CONSTRUCTION
WATERPROOFING MEMBRANE (9.26.1.1, 9.26.1.5, 9.26.1.6) FULLY ADHERED TO 5/8" (15.9) T&G EXTERIOR GRADE PLYWOOD SHEATHING ON 2X2" (38x38) PURLING ANGLED TOWARDS SCUPPER @ 2% MINIMUM LAID PERPENDICULAR TO 2X6" (38x138) FLOOR-JOISTS @ 16" (408) O.C. (UNLESS OTHERWISE NOTED). BUILT UP CURB TO BE 4" (103) MIN. ABOVE FINISHED BALCONY FLOOR. CONTINUOUS 1" THIN DRIP EDGE TO BE PROVIDED ON OUTSIDE FACE OF CURB. SCUPPER DRAIN TO BE LOCATED 24" (610) MIN. AWAY FROM HOUSE. PREFINISHED ALUMINUM OR PANEL FOR UNDERSIDE OF SOFFIT (9.23.2.3). REMOVE CURB WHERE REQ. BALCONY CONDITION
SEE FLAT ROOF/BALCONY CONSTRUCTION NOTE. INCLUDE 2X4" (38x89) PT. DECKING W/ 1/4" (6.4) GAPS LAID FLAT PARALLEL TO JOISTS ON 2X4" (38x89) PT. SLEEPERS @ 12" (305) O.C. LAID FLAT PERPENDICULAR TO JOISTS
BALCONY OVER HEATED SPACE CONDITION
SEE FLAT ROOF/BALCONY CONSTRUCTION NOTE FOR ASSEMBLY. REFER TO PLANS FOR FLOOR JOIST SIZE & REFER TO HEX NOTE 9 FOR INSULATION AND INTERIOR FINISH.
- 47

BARREL VAULT CONSTRUCTION
CANTILVERED 2X4" (38x89) SPACERS LAID FLAT ON 2X12" (38x235) SPR. #2 ROOF JOIST NAILED TO BUILT-UP 8-3/4" (19) PLYWOOD HEADER PROFILED FOR BARREL. SPRAY FOAM INSULATION BETWEEN JOISTS W/ GYPSUM BOARD. INTERIOR FIN. (REFER TO DETAILS)

SECTION 1.1. WALL STUDS

- REFER TO THIS CHART FOR STUD SIZE & SPACING AS REQUIRED FOR EXTERIOR WALLS ONLY. REFER TO SITING & GRADING PLAN OF THIS UNIT FOR CONFIRMATION OF TOP OF FOUNDATION WALL AND ADDITIONAL INFORMATION.
- IF STUD WALL HEIGHT EXCEEDS MAX. UNSUPPORTED HEIGHT, WALL NEEDS TO BE REVIEWED AND APPROVED BY ENGINEER.

SIZE & SPACING OF STUDS: (OBC REFERENCE - TABLE 9.23.10.1.)			
SUPPORTED LOADS (EXTERIOR)			
MIN. STUD SIZE	ROOF w/ OR w/o ATTIC	ROOF w/ OR w/o ATTIC & 1 FLOOR	ROOF w/ OR w/o ATTIC & 2 FLOOR
IN (mm)	W/6 ATTIC	ATTIC & 1 FLOOR	ATTIC & 2 FLOOR
MAX. STUD SPACING, IN (mm) O.C.			
MAX. UNSUPPORTED HGT., ft-in (m)			
2"x4" (38x89)	24" (610)	18" (458)	12" (305)
2"x6" (38x140)	9'-10" (3.0)	9'-10" (3.0)	9'-10" (3.0)
	-	24" (610)	18" (458)
	-	9'-10" (3.0)	11'-10" (3.6)

SECTION 2.0. GENERAL NOTES

2.1. WINDOWS
1) EXCEPT WHERE A DOOR ON THE SAME FLOOR LEVEL AS THE BEDROOM PROVIDES DIRECT ACCESS TO THE EXTERIOR, EVERY FLOOR LEVEL CONTAINING A BEDROOM IS TO HAVE AT LEAST ONE OUTSIDE WINDOW W/ MIN. 0.36m² UNSUBSTRUCTED OPEN PORTION W/ NO DIMENSION LESS THAN 1'-3" (380), CAPABLE OF MAINTAINING THE OPENING WITHOUT THE NEED FOR ADDITIONAL SUPPORT, CONFORMING TO 9.9.10.
2) WINDOW GUARDS: A GUARD OR A WINDOW WITH A MAXIMUM RESTRICTED OPENING WIDTH OF 4" (103) IS REQUIRED WHERE THE TOP OF THE WINDOW SILL IS LOCATED LESS THAN 1'-7" (480) ABOVE FIN. FLOOR AND THE DISTANCE FROM THE FINISHED FLOOR TO THE ADJACENT GRADE IS GREATER THAN 6'-11" (1800). (9.5.6.1.1)
3) WINDOWS IN EXT. STAIRWAYS THAT EXTEND TO LESS THAN 2'-11" (600) (3'-6" (1070) FOR ALL OTHER BUILDINGS) SHALL BE PROTECTED BY GUARDS IN ACCORDANCE WITH NOTE #2 (ABOVE). OR THE WINDOW SHALL BE NON-OPERABLE AND DESIGNED TO WITHSTAND THE SPECIFIED LOADS FOR BALCONY GUARDS AS PROVIDED IN 4.1.15.15 OR 9.8.6.2
4) REFER TO TITLE PAGE FOR MAX. U-VALUE REQUIREMENTS

2.2. CEILING HEIGHTS
THE CEILING HEIGHTS OF ROOMS AND SPACES SHALL CONFORM TO TABLE 9.5.3.1.

ROOM OR SPACE	MINIMUM HEIGHTS
LIVING ROOM, DINING ROOM, AND KITCHEN	7'-7" OVER 75% OF REQUIRED FLOOR AREA WITH A CLEAR HEIGHT OF 6'-11" AT ANY POINT
BEDROOM	7'-7" OVER 50% OF REQUIRED FLOOR AREA OR 6'-11" OVER ALL OF THE REQUIRED FLOOR AREA.
BASEMENT	6'-11" OVER AT LEAST 75% OF THE BASEMENT AREA EXCEPT THAT UNDER BEAMS AND PILTS THE CLEARANCE IS PERMITTED TO BE REDUCED TO 6'-5".
BATHROOM, LAUNDRY AREA ABOVE GRADE	6'-11" IN ANY AREA WHERE A PERSON WOULD NORMALLY BE STANDING
FINISHED ROOM NOT MENTIONED ABOVE	6'-11"
MEZZANINES	6'-11" ABOVE & BELOW FLOOR ASSEMBLY (9.5.3.2.)
STORAGE GARAGE	6'-7" (9.5.3.3)

2.3. MECHANICAL / PLUMBING
1) MECHANICAL VENTILATION IS REQUIRED TO PROVIDE 0.7 AIR CHANGE PER HOUR IF NOT AIR CONDITIONED 1 PER HOUR IF AIR CONDITIONED AVERAGED OVER 24 HOURS. WHEN A VENTILATION FAN (PRINCIPAL EXHAUST) IS REQUIRED, CONFORM TO O.B.C. 9.32.3.4. WHEN A HRV IS REQUIRED, CONFORM TO 9.32.3.11. REFER TO MECHANICAL DRAWINGS.
2) REFER TO HOT WATER TANK MANUFACTURER SPECS. CONFORM TO O.B.C. 9.51.6.

3) REFER TO TITLE PAGE FOR SPACE HEATING EQUIPMENT, HRV AND DOMESTIC HOT WATER HEATER MINIMUM EFFICIENCIES.
4) DRAIN WATER HEAT RECOVERY UNIT(S) WILL BE INSTALLED CONFORMING TO THE REQUIREMENTS OF 3.1.1.12. OF THE O.B.C.

2.4. LUMBER
1) ALL LUMBER SHALL BE SPRUOE No.2 GRADE OR BETTER, UNLESS NOTED OTHERWISE.
2) STUDS SHALL BE STUD GRADE SPRUCE, UNLESS NOTED OTHERWISE.
3) LUMBER EXPOSED TO THE EXTERIOR TO BE SPRUCE No. 2 GRADE PRESSURE TREATED OR CEDAR, UNLESS NOTED OTHERWISE.
4) ALL LAMINATED VENEER LUMBER (LVL) BEAMS, GIRDER TRUSSES, AND METAL HANGER CONNECTIONS SUPPORTING ROOF FRAMING TO BE DESIGNED & CERTIFIED BY FLOOR AND ROOF TRUSS MANUFACTURER.
5) JOIST HANGERS: PROVIDE APPROVED METAL HANGERS FOR ALL JOISTS AND BUILT-UP WOOD MEMBERS INTERSECTING WITH FLUSH BUILT-UP WOOD MEMBERS.
6) WOOD FRAMING NOT TREATED WITH A WOOD PRESERVATIVE, IN CONTACT WITH CONCRETE, SHALL BE SEPARATED FROM THE CONC. BY AT LEAST 2 IN POLYETHYLENE FILM. No.50 (450S) ROLL ROOFING OR OTHER DAMP-PROOFING MATERIAL, EXCEPT WHERE THE WOOD MEMBER IS AT LEAST 6" (152) ABOVE THE GROUND.

2.5. STEEL (9.23.4.3.)
1) STRUCTURAL STEEL SHALL CONFORM TO CAN/CSA-S40-21 GRADE 300W. HOLLOW STRUCT. SECTIONS SHALL CONFORM TO CAN/CSA-G40-21 GRADE 350W CLASS "H".
2) REINFORCING STEEL SHALL CONFORM TO CSA-680-18M GRADE 400R.
2.6. FLAT ARCHES
1) FOR 8'-0" (2440) CEILINGS; FLAT ARCHES SHALL BE 6'-10" (2080) A.F.F.
2) FOR 9'-0" (2740) CEILINGS; FLAT ARCHES SHALL BE 7'-10" (2400) A.F.F.
3) FOR 10'-0" (3040) CEILINGS; FLAT ARCHES SHALL BE 8'-6" (2600) A.F.F.
2.7. ROOF OVERHANGS
1) ALL ROOF OVERHANGS SHALL BE 1'-0" (305), UNLESS NOTED OTHERWISE.
2.8. FLASHING (9.20.13, 9.26.4, 9.27.3.)
1) FLASHING MATERIALS & INSTALLATION SHALL CONFORM TO O.B.C.

2.9. GRADING
1) THE BUILDING SHALL BE LOCATED ON THE BUILDING SITE GRADED SO THE WATER WILL NOT ACCUMULATE AT OR NEAR THE BUILDING AND WILL NOT ADVERSELY AFFECT ADJACENT PROPERTIES. CONFORM TO 9.14.6.
2.10. U.L.C. SPECIFIED ASSEMBLIES
ALL REQUIRED INDIVIDUAL COMPONENTS THAT FORM PART OF ANY U.L.C. LISTED ASSEMBLY, SPECIFIED WITHIN THESE DRAWINGS, CANNOT BE ALTERED OR SUBSTITUTED FOR ANY OTHER MATERIAL/PRODUCT OF SPECIFIED MANUFACTURER THAT IS IDENTIFIED IN THAT SPECIFIED U.L.C. LISTING. THERE SHALL BE NO DEVIATIONS UNDER ANY CIRCUMSTANCES IN ANY U.L.C. LISTED ASSEMBLY IDENTIFIED IN THESE DRAWINGS.

SECTION 3.0. LEGEND

3.1. WOOD LINTELS AND BUILT-UP WOOD
(DIVISION B PART 9. TABLES A8 TO A10 AND A12, A15 & A16)
FORMING PART OF SENTENCE 9.23.4.2.(3), 9.23.4.2.(4), 9.23.4.2.(5), 9.23.4.2.(6), 9.23.4.2.(7)

2"x8" SPRUCE #2	2"x10" SPRUCE #2	2"x12" SPRUCE #2
L1 2/2"x8" (208x184)	L3 2/2"x10" (208x235)	L5 2/2"x12" (208x286)
B1 3/2"x8" (308x184)	B3 3/2"x10" (308x235)	B5 3/2"x12" (308x286)
B2 4/2"x8" (408x184)	B4 4/2"x10" (408x235)	B6 4/2"x12" (408x286)
B7 5/2"x8" (508x184)	B8 5/2"x10" (508x235)	B9 5/2"x12" (508x286)

ENGINEERED LUMBER SCHEDULE		
1 3/4" x 9 1/2" LVL	1 3/4" x 11 7/8" LVL	1 3/4" x 14" LVL
LVL2 1-1 3/4"x9 1/2"	LVL3 1-1 3/4"x11 7/8"	LVL10 1-1 3/4"x14"
LVL4 2-1 3/4"x9 1/2"	LVL6 2-1 3/4"x11 7/8"	LVL11 2-1 3/4"x14"
LVL5 3-1 3/4"x9 1/2"	LVL7 3-1 3/4"x11 7/8"	LVL12 3-1 3/4"x14"
LVL8 4-1 3/4"x9 1/2"	LVL9 4-1 3/4"x11 7/8"	LVL13 4-1 3/4"x14"

3.2. STEEL LINTELS SUPPORTING MASONRY VENEER (DIVISION B PART 9. TABLE 9.20.5.2.B.) FORMING PART OF SENTENCE 9.20.5.2.(2) & 9.20.5.2.(3)		
CODE	SIZE	STONE

L7	3 1/2" x 3 1/2" x 1/4" (89 x 89 x 6.4)	BRICK	8'-1" (2.47m)	7'-6" (2.30m)
L8	4" x 3 1/2" x 1/4" (102 x 89 x 6.4)	BRICK	9'-0" (2.65m)	8'-1" (2.48m)
L9	4 7/8" x 3 1/2" x 5/16" (127 x 89 x 7.9)	BRICK	10'-0" (3.05m)	10'-1" (3.09m)
L10	4 7/8" x 3 1/2" x 3/8" (127 x 89 x 11)	BRICK	11'-5" (3.48m)	10'-7" (3.24m)
L11	5 7/8" x 3 1/2" x 3/8" (152 x 89 x 11)	BRICK	12'-0" (3.66m)	11'-7" (3.54m)
L12	7 1/8" x 4" x 3/8" (178 x 102 x 11)	BRICK	14'-1" (4.30m)	13'-1" (3.99m)

CONFORMING TO SECTIONS 9.5.1.1, 9.6, 9.7.2.1, 9.7.5.2, & 9.10.13.10

1	EXTERIOR	2'-8" x 6'-8" x 1-3/4" (815 x 2030 x 45)	INS. MIN. R4 (RSI 0.7)
1A	EXTERIOR	2'-10" x 6'-8" x 1-3/4" (865 x 2030 x 45)	INSULATED MIN. R4 (RSI 0.7)
1B	EXTERIOR	3'-0" x 6'-8" x 1-3/4" (915 x 2030 x 45)	INSULATED MIN. R4 (RSI 0.7)
1C	EXTERIOR	2'-8" x 6'-8" x 1-3/4" (815 x 2030 x 45)	INSULATED MIN. R4 (RSI 0.7)
1D	EXTERIOR	2'-8" x 6'-8" x 1-3/4" (815 x 2030 x 45)	INS. MIN. R4 (RSI 0.7) (SEE HEX NOTE 20)
1E	EXTERIOR	3'-0" x 6'-8" x 1-3/4" (915 x 2440 x 45)	INSULATED MIN. R4 (RSI 0.7)
1F	EXTERIOR	2'-8" x 8'-0" x 1-3/4" (815 x 2440 x 45)	INSULATED MIN. R4 (RSI 0.7)
2A	EXTERIOR	2'-8" x 6'-8" x 1-3/4" (815 x 2030 x 45)	20 MIN. F.B.R. DOORFRAME WITH APP. SELF-CLOSING DEVICE
2	INTERIOR	2'-8" x 6'-8" x 1-3/8" (815 x 2080 x 35)	
3	INTERIOR	2'-8" x 6'-8" x 1-3/8" (815 x 2030 x 35)	
3A	INTERIOR	2'-4" x 6'-8" x 1-3/8" (710 x 2030 x 35)	
4	INTERIOR	2'-0" x 6'-8" x 1-3/8" (610 x 2030 x 35)	
4A	INTERIOR	2'-0" x 6'-8" x 1-3/8" (680 x 2030 x 35)	
5	INTERIOR	1'-6" x 6'-8" x 1-3/8" (460 x 2030 x 35)	

3.4. ACRONYMS	
AF	ABOVE FINISHED FLOOR
BFM	BEAM BY FLOOR MANUFACTURER
BG	FIXED GLASS W/ BLACK BACKING
BM	BEAM
BBM	BEAM BY ROOF MANUFACTURER
CH	CONVENTIONAL ROOF FRAMING
C/W	COMPLETE WITH
DJ/T	DOUBLE JOIST/ TRIPLE JOIST
DO	DO OVER
DRP	DROPPED
ENG	ENGINEERED
EST	ESTIMATED
FA	FLAT ARCH
FD	FLOOR DRAIN
FG	FIXED GLASS
FL	FLUSH
FLR	FLOOR
GT	GIRDER TRUSS
HB	HOSE BIB
HRV	HEAT RETURN VENTILATION UNIT
HWT	HOT WATER TANK
ENG	ENGINEERED
EST	ESTIMATED
FA	FLAT ARCH
FD	FLOOR DRAIN
FG	FIXED GLASS
FL	FLUSH
FLR	FLOOR
GT	GIRDER TRUSS
WD	WOOD
WIC	WALK IN CLOSET
WP	WEATHER PROOF

ALL ELECTRICAL FACILITIES SHALL BE INSTALLED IN ACCORDANCE WITH SECTION 9.84.

CLASS B VENT	EXHAUST VENT
DUPLEX OUTLET (12" HIGH)	DUPLEX OUTLET (HEIGHT AS NOTED A.F.F.)
HEAVY DUTY OUTLET	SWITCH (2/3/4 WAY)
POT LIGHT	LIGHT FIXTURE (CEILING MOUNTED)
LIGHT FIXTURE (PULL CHAIN)	LIGHT FIXTURE (WALL MOUNTED)
CABLE T.V. JACK	TELEPHONE JACK
CENTRAL VACUUM OUTLET	CHANDLER (CEILING MOUNTED)

SA SMOKE ALARM (9.10.19)
PROVIDE ONE PER FLOOR, NEAR THE STAIRS CONNECTING THE FLOOR LEVEL. ALARMS ARE TO BE INSTALLED IN EACH SLEEPING ROOM AND IN A LOCATION BETWEEN SLEEPING ROOMS AND CONNECTING HALLWAYS AND WIRED TO BE INTERCONNECTED TO ACTIVATE ALL ALARMS IF ONE SOUNDS. ALARMS ARE TO BE CONNECTED TO AN ELECTRICAL CIRCUIT WITH A BATTERY BACKUP. ALARM SIGNAL SHALL MEET TEMPORAL SOUND PATTERNS MIN. ALARMS SHALL HAVE A VISUAL SIGNALING COMPONENT AS PER THE NATIONAL FIRE ALARM AND SIGNALING CODE 72.
CND CARBON MONOXIDE ALARM (9.38.4)
** CHECK LOCAL BY-LAWS FOR REQUIREMENTS ** A CARBON MONOXIDE ALARM(S) CONFORMING TO CAN/CGA-6.18 SHALL BE INSTALLED ON OR NEAR THE CEILING IN EACH DWELLING UNIT ADJACENT TO EACH SLEEPING AREA. CARBON MONOXIDE ALARM(S) SHALL BE PERMANENTLY WIRED WITH NO DISCONNECT SWITCH, WITH AN ALARM THAT IS AUDIBLE WITHIN SLEEPING ROOMS WHEN THE INTERVENING DOORS ARE CLOSED.

SB SOLID BEARING (BUILT-UP WOOD COLUMNS AND STUD POSTS)
THE WIDTH OF A WOOD COLUMN SHALL NOT BE LESS THAN THE WIDTH OF SUPPORTED MEMBER. BUILT-UP WOOD COLUMNS SHALL BE NAILED TOGETHER WITH NOT LESS THAN 8" (76) NAILS SPACED NOT MORE THAN 11 3/4" (300) O.C. THE NUMBER OF STUDS IN A WALL DIRECTLY BELOW A GIRDER TRUSS OR ROOF BEAM SHALL CONFORM TO TABLE A-84 TO A-87. (9.17.4., 9.23.10.7.)
TWO STOREY VOLUME SPACE. SEE CONSTRUCTION NOTE 39.
VARYING PLATES, BUILT-OUT FLOORS, BEARING WALLS, ICE & WATER SHIELD
EXPOSED BUILDING FACE - O.B.C. 9.10.14, OR 9.10.15
REFER TO HEX NOTE 35 & DETAILS FOR TYPE AND SPECIFICATIONS.
1 HR. PARTY WALL
REFER TO HEX NOTE 40.
2 HR. FIREWALL
REFER TO HEX NOTE 40A.


SECTION 4.0. CLIMATIC DATA

DESIGN SNOW LOAD (9.4.2.2.):	1.23 kPa
WIND LOAD (q50) (SB-1.2.):	0.44 kPa

1 HR. PARTY WALL	2 HR. FIREWALL
REFER TO HEX NOTE 40.	REFER TO HEX NOTE 40A.

SECTION 4.0. CLIMATIC DATA
DESIGN SNOW LOAD (9.4.2.2.): 1.23 kPa
WIND LOAD (q50) (SB-1.2.): 0.44 kPa

STAMP

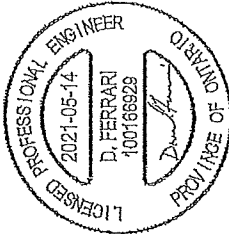

FOR STRUCTURAL ONLY
NOT INCLUDING ENGINEERED
FLOOR OR ROOF SYSTEM

CONTRACTOR MUST VERIFY ALL DIMENSIONS ON THE JOB, REPORT ANY DISCREPANCIES TO HUNT DESIGN ASSOCIATES INC. (H.D.A.) BEFORE PROCEEDING WITH THE WORK. ALL THE DRAWINGS & SPECIFICATIONS ARE THE INSTRUMENTS OF SERVICE AND ARE THE PROPERTY OF H.D.A. ALL CONSTRUCTION TO ADHERE TO THESE PLANS AND SPECIFICATIONS AND TO CONFORM TO THE ONTARIO BUILDING CODE AND ALL OTHER APPLICABLE CODES AND AUTHORITIES HAVING JURISDICTION. THESE REQUIREMENTS ARE TO BE TAKEN AS MINIMUM SPECIFICATIONS. ONT. REG. 38272.

CONSTRUCTION NOTE REVISION DATE: MAY 9, 2019
CONSTRUCTION NOTES 2

ROYAL PINE HOMES - 216102
CENTREFIELD, WEST GORMLEY, RICHMOND HILL, ON.
UNIT 2009-END
REV. 2021.05.11

Drawn By: KM
Checked By: DS
Scale: 3/16"=1'-0"
File Number: 216102WT2009-END
Page Number: 18 of 18
T 905.737.5133 F 905.737.9326

DESIGN ASSOCIATES INC.
8966 Woodbine Ave, Markham, ON L3R 0J7
I, the undersigned, certify that I am a duly qualified Professional Engineer in the Province of Ontario, and that I am the author of the design and drawings herein, and that I am not aware of any fraud or deception in connection with the same.



DESIGN ASSOCIATES INC.
www.hunt-design.ca

19995

Signature of Derek R. Santos

Signature of Derek R. Santos

