





BASEMENT TO GROUND
BSMT 11-7/8" JOIST

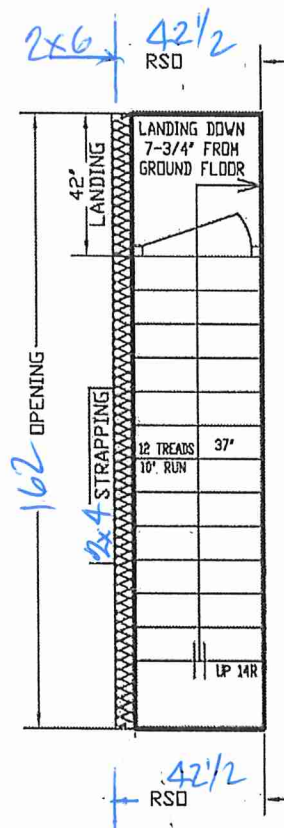




ALL OPENINGS ARE ALLOWED
FOR 1 LAYER OF DRY WALL
ANY ADDITIONAL LAYERS MUST
BE ALLOWED BY CARPENTERS

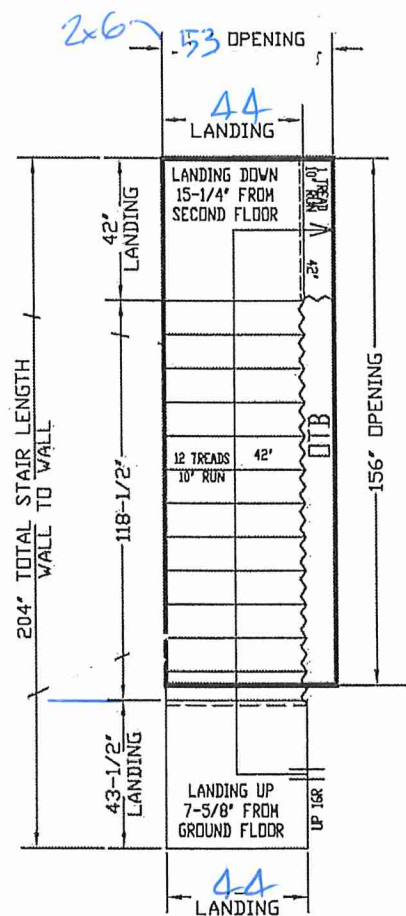

  GARAGE RIGHT >

 ALPHA STAIRS AND RAILINGS INC. <i>Quality To Step Up To</i>	ALL LANDINGS TO BE SUPPLIED AND SUPPORTED BY OTHERS UNLESS SPECIFIED ABOVE ANY STRAPPING ALLOWANCES TO BE CONFIRMED BY CARPENTERS ALL STAIR DIMENSIONS MAY BE ADJUSTED FROM ORIGINAL BLUE PRINTS IF AS SUPPLIED TO ALPHA STAIRS, AND RAILINGS INC. MEASUREMENTS SHOWN ON LANDINGS ARE REQUIRED TO INSTALL OUR STAIRS, ANY PROBLEMS WITH REARDED OR STRAPPING ALLOWANCES ALPHA STAIRS AND RAILINGS INC. WILL BE RESPONSIBLE. STAIRS AND RAILINGS SUPPLIED BY CARPENTERS OR SITE SUPPLIERS TO MAKE SURE THERE ARE NO DISCREPANCIES BEFORE PROCEEDING WITH CONSTRUCTION		SITE: CENTREFIELD	DRAWN BY: PARAMJEET DATE: APRIL 7, 2025
	ALPHA STAIRS AND RAILINGS INC. 3770 NASHUA DRIVE, UNIT 3 MISSISSAUGA, ONTARIO L4V 1H6 TEL: (905) 694-9556 www.alpastofors.com		LIT: ☐ Model: 20-9 END W/UNFIN. & UNFIN. BSMT	CLIENT: ROYAL PINE HOMES LAYOUT: ☐ SCALE: 1:35

Jan 22 /25
* CC
TELEPHONE (X2)
(X10) POTS.

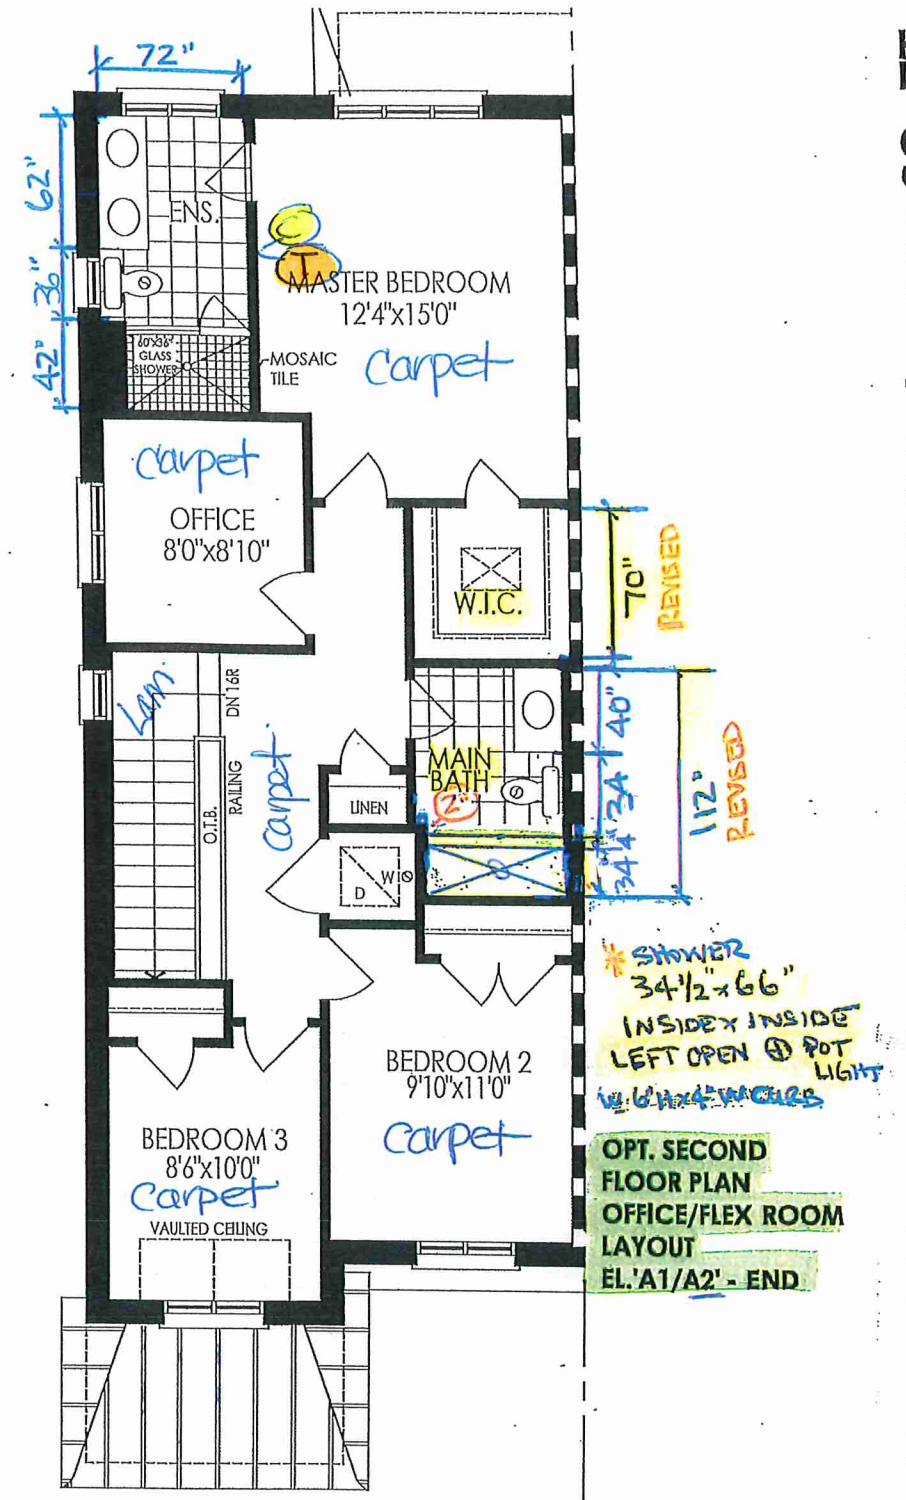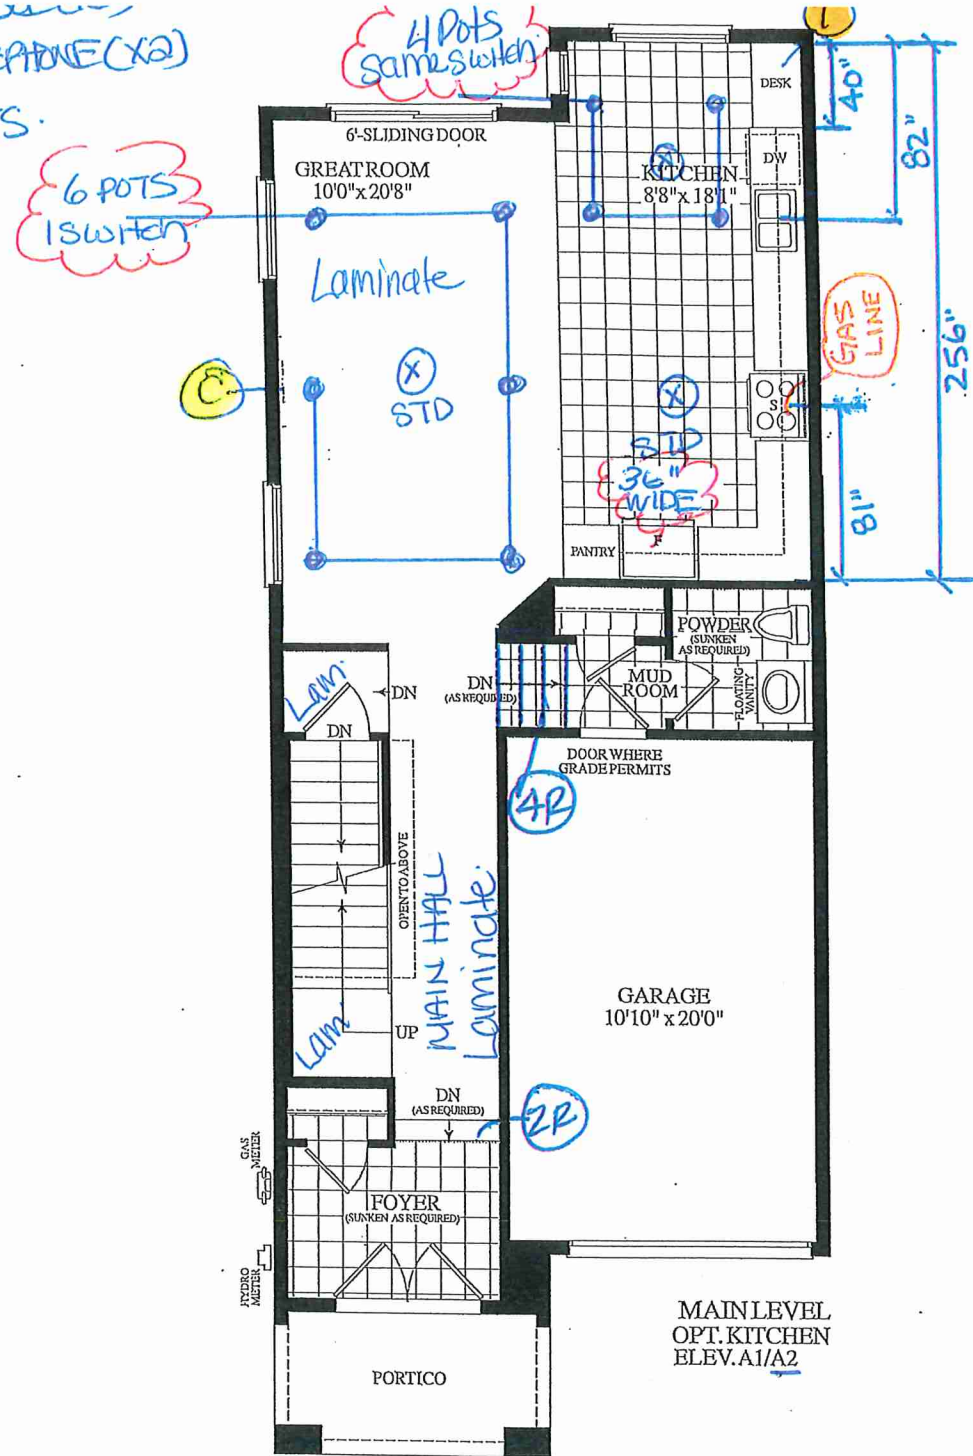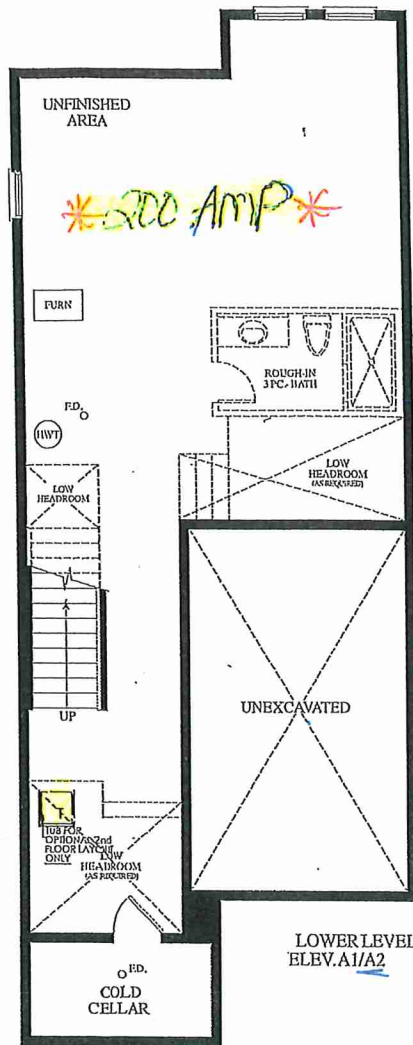

CAMBRIDGE
MEADOWS

BLK. 235 TH. 72 20-09 THE MACKENZIE EL. A2 1710 SQ. FT.

A hand-drawn diagram of a rectangular frame. It consists of two horizontal lines and two vertical lines. The top horizontal line is labeled "156" with a double quote symbol. The right vertical line is labeled "204" with a double quote symbol. The lines are drawn in blue ink on a white background.

LANDING
44" x 43 1/2"
UP 75/8

SOLID MASONRY WALL W/ 10'-10M VERT. REBARS (LAP 1'-6" GROUTED INTO BRICK JOINT)	2"x6" SILL PLATE @ TOP ANCHORED TO SOLID MASONRY WALL W/ 1/2" @ x 12" BOLTS @ 24" O.C. STAGGERED	MASONRY VENEER TIED TO MASONRY VENEER WITH GALV. METAL TIES @ 16" O.C. AND 24" VERTICAL. FILL VOID BETWEEN MASONRY VENEER WITHES SOLID W/ MORTAR
---	--	--

* MAX. UNSUPPORTED HEIGHT

REFER TO FLOOR JOIST MANUFACTURER'S DRAWINGS FOR LAYOUT, SPACING, BLOCKING & STRAPPING REQUIREMENTS, INSTALLATION DETAILS AND HANGER SIZES, & SUBFLOOR THICKNESS	ALL DOORS ON PLAN ARE 7'-0" HIGH TOP OF FRAME. UNLESS LABELED OTHERWISE, PROVIDE SOLID WOOD BLOCKING @ 24" O.C. FOR FIRST JOIST SPAN WHEN PARALLEL TO EXTERIOR WALL
--	---

QUALIFICATION INFORMATION
Derek R. Santos
NAME SIGNATURE

all drawings, specifications related elements and design are the copyright of the client. Design Associates Inc.

ROYAL PINE HOMES - 216102

ROYAL PINE HOMES - 216102
CENTREEEE D' WEST GORRIEY RICHMOND HILL ON: REV.2021.05.11
UNIT 2009-END

www.huntdesign.ca

ALL RIGHTS RESERVED. NO PART OF THIS PUBLICATION MAY BE REPRODUCED OR TRANSMITED IN ANY FORM OR BY ANY MEANS, ELECTRONIC OR MECHANICAL, INCLUDING PHOTOCOPYING, RECORDING, OR BY ANY INFORMATION STORAGE AND RETRIEVAL SYSTEM, WITHOUT PERMISSION IN WRITING FROM HUNTDATA ASSOCIATES, INC.


FOR STRUCTURAL ONLY
NOT INCLUDING ENGINEERED
FLOOR OR ROOF SYSTEM

GROUND FLOOR PLAN, ELEV. 'A'

ROYAL PINE HOMES - 216102
CENTREEEE D' WEST GORRIEY RICHMOND HILL ON: REV.2021.05.11
UNIT 2009-END

Drawn By	Checked By	Scale	File Number	Page Number
KM	DS	3/16"=1'-0"	216102WT2009-END	4 of 18

REGISTRATION INFORMATION
HUNT DESIGN ASSOCIATES INC. 19865
www.huntdesign.ca 8666 Woodbine Ave, Markham, ON L3R 0J7 F 905.737.7326
HUNT DESIGN ASSOCIATES INC. 19865
www.huntdesign.ca 8666 Woodbine Ave, Markham, ON L3R 0J7 F 905.737.7326

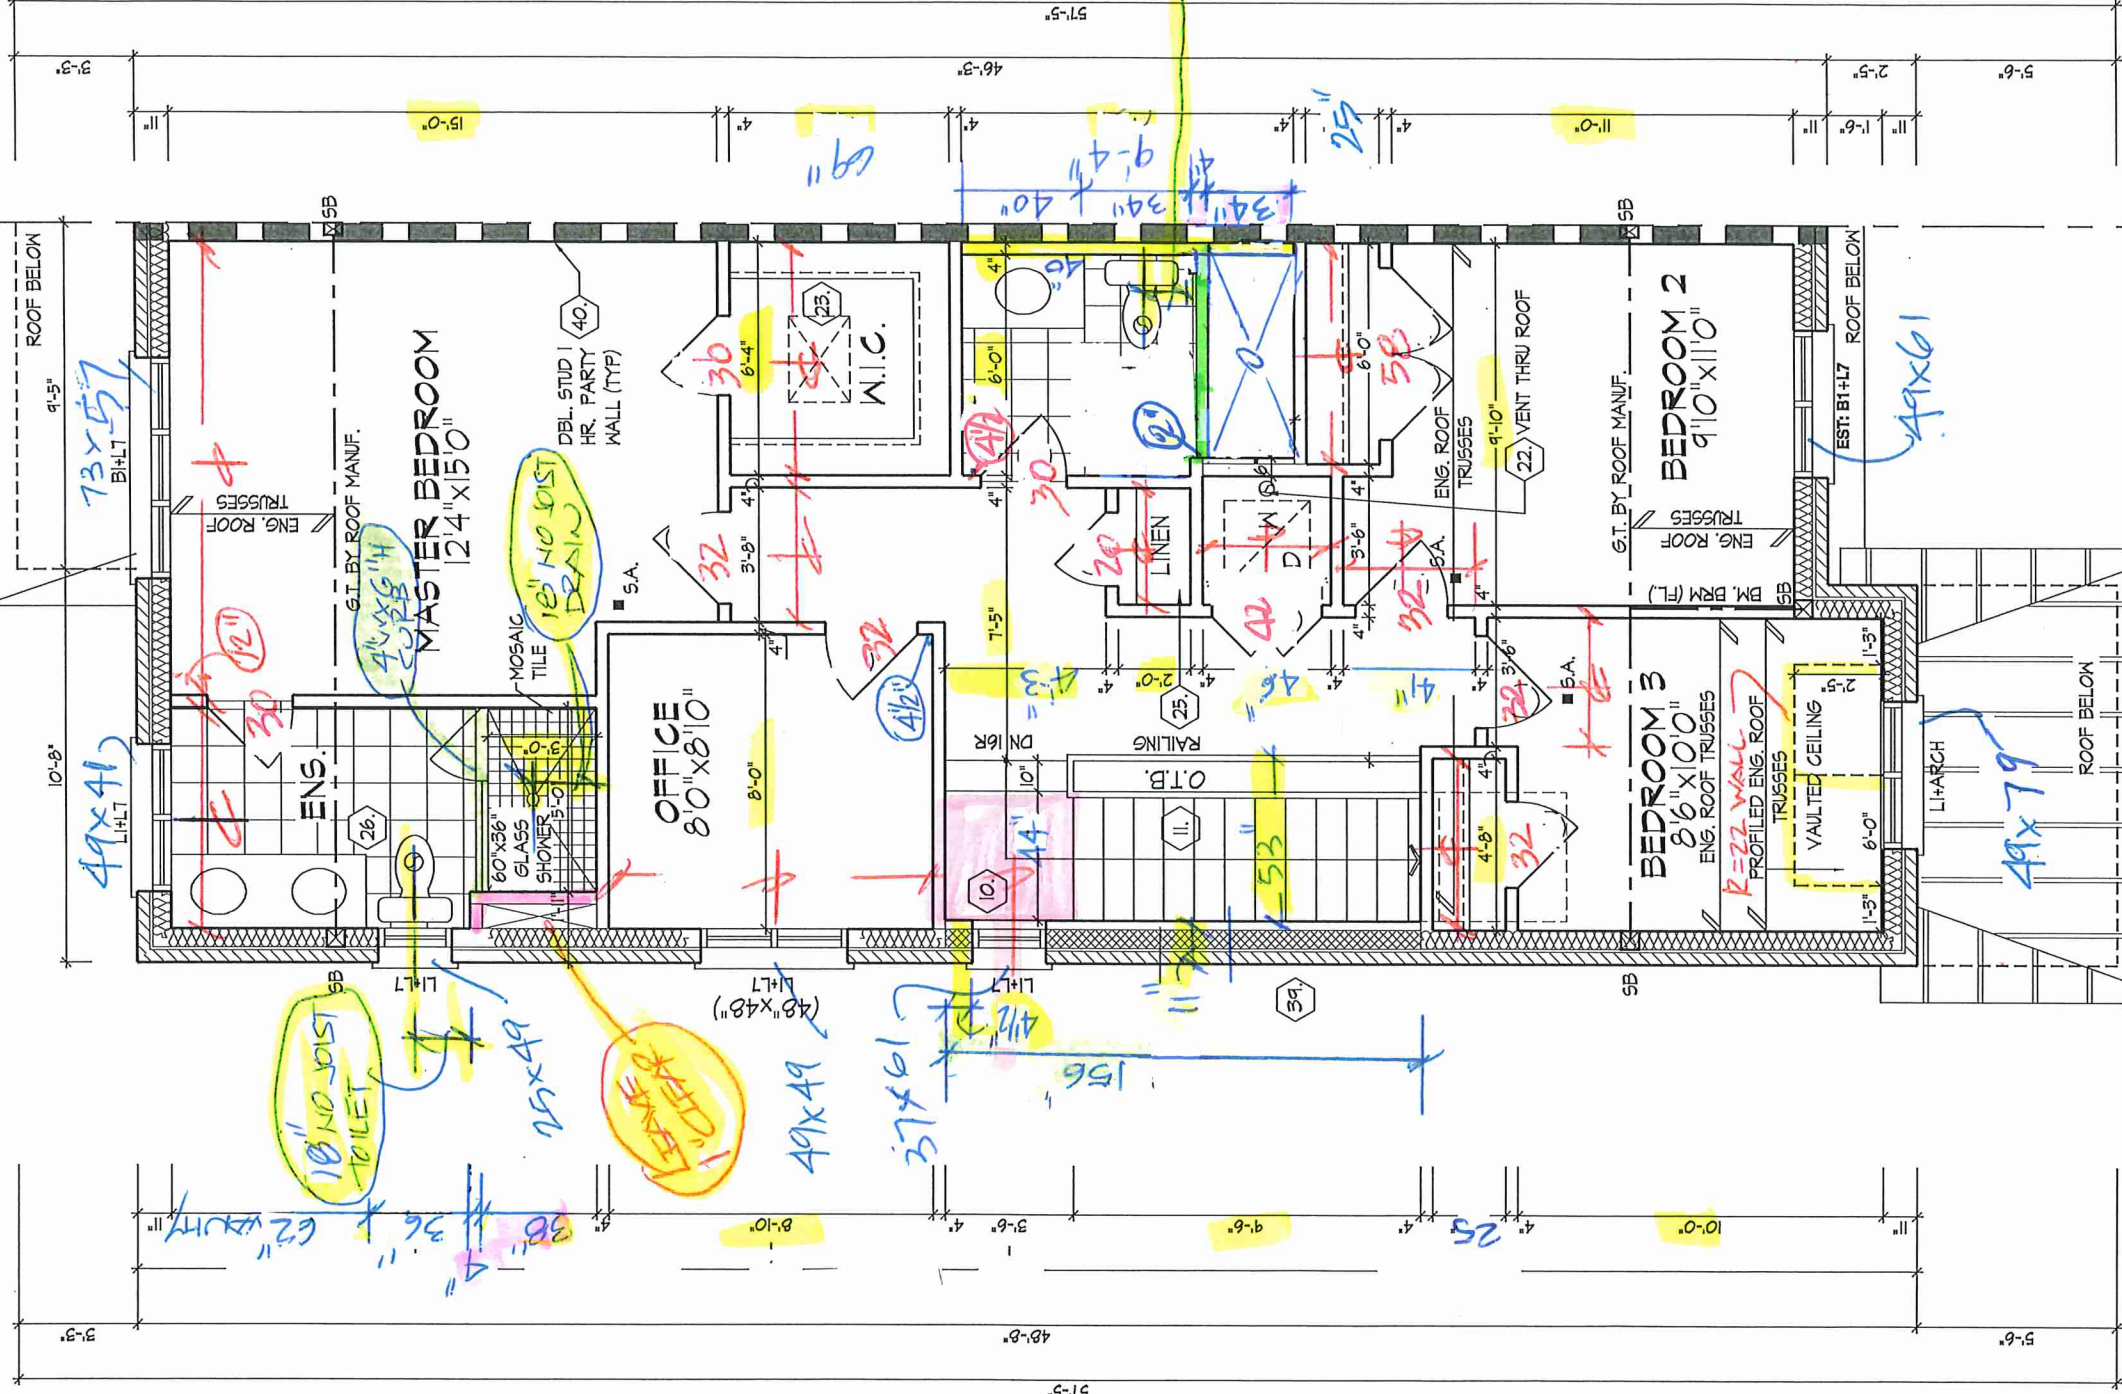

REFER TO ROOF TRUSS MANUFACTURER'S DRAWINGS FOR LAYOUT, SPACING, INSTALLATION DETAILS AND HANGER SIZES.

DOORS 83" WINDOWS SEE ELEC.

OPT. SECOND FLOOR PLAN, EL. 'A1'/'A2'
OFFICE / FLEX SPACE LAYOUT

20-09 END THE MACKENZIE

PK 235-72
opt. SECOND FLOOR PLAN, ELEV. 'A1/A2'

THE UNDERSIGNED HAS REVIEWED AND TAKES RESPONSIBILITY FOR THIS DESIGN AND HAS THE QUALIFICATIONS AND MEETS THE REQUIREMENTS SET OUT IN THE ONTARIO BUILDING CODE TO BE A DESIGNER.

NAME: Derek R. Santos
SIGNATURE: [Signature]
REGISTRATION INFORMATION: 8-1-0" CEILING 37308

HUNT
DESIGN ASSOCIATES INC.


www.huntdesign.ca 19995

ROYAL PINE HOMES - 216102
'CENTREFIELD', WEST GORMLEY, RICHMOND HILL, ON. REV. 2025.03.13

Drawn By: KM
Checked By: DS
Scale: 3/16"=1'-0"
File Number: 216102WT2009-END
Page Number: 6a of 18

GARAGE ROOF
18" O.H. + 18/12 PITCH

ROOF OVERHANGS TO BE 12"
UNLESS NOTED OTHERWISE

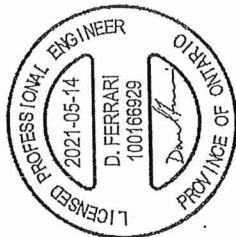

W Architect Inc.
DESIGN CONTROL REVIEW
JUNE 01, 2021
FINAL BY: *ALB*
This stamp is only for the purposes of design control and carries no other professional obligations.

FRONT & REAR ELEVATION 'A1'

UNIT 2009-END
REV. 2021.05.11

ROYAL PINE HOMES - 216102
'CENTREFIELD', WEST GORMLEY, RICHMOND HILL, ON.

HUNT ASSOCIATES INC.
DESIGN ASSOCIATES INC.
www.huntassociates.ca
8966 Woodbine Ave, Markham, ON L3R 0J7
T 905.737.5133 F 905.737.7326
Drawn By: DS
Checked By: KM
Scale: 3/16" = 1'-0"

Page Number
9 of 18

THE UNDERSIGNED HAS REVIEWED AND TAKES RESPONSIBILITY FOR THIS DESIGN AND HAS THE QUALIFICATIONS AND MEETS THE REQUIREMENTS SET OUT IN THE ONTARIO BUILDING CODE TO BE A DESIGNER.
QUALIFICATION INFORMATION
Derek R. Santos
HUNT DESIGN ASSOCIATES INC.
All drawings specifications related documents and design are the copyright property of Hunt Design Associates (H.D.A.). Reproduction of this property in whole or in part is strictly prohibited without H.D.A.'s written permission (H.D.A. assumes no responsibility or liability for this property unless it bears the appropriate H.D.A. number and original signature).

OUTLINE OF VAULTED
CEILING BEYOND

7" SELF SUPPORTING PRECAST
CONC. ARCH & KEYSTONE ON 7"
PRECAST CONC. SURROUND W 1/2"
PROJ. (TYP)

FACE BRICK (TYP)

PREFIN. MTL. FLASHING W/
CAULKING TO MATCH
MASONRY COLOUR (TYP)

PREFIN. SEALED
METAL ROOF (TYP)

7" PRECAST CONC. HEADER
& KEYSTONE (TYP)

STONE VENEER (TYP)

FIN. GROUND FLOOR

SUNK. FOYER (-2R)

POURED CONC. DOOR SILL &
PORCH SLAB (TYP)

POURED CONC. FOUNDATION
WALLS & FOOTINGS (TYP)

TOP OF BASEMENT SLAB

ASPHALT SHINGLES (TYP)

VALLEY FLASHING (TYP)

PREFIN. ALUM. GUTTER,
R.W.L., FASCIA BD. &
VENTED SOFFIT (TYP)

2"x4" ALUMINIUM CLAD
PROFIED FRIEZE BOARD (TYP)

7" PRECAST CONC. HEADER ON 7"
PRECAST CONC. SURROUND (TYP)

3.5" PRECAST CONC.
SILL (TYP)

2"x4" ALUMINIUM CLAD
PROFIED FRIEZE BOARD (TYP)

COACH LAMP (TYP)

ADDRESS PLAQUE (TYP)

7" PRECAST CONC.
HEADER (TYP)

CONT. 3.5" PRECAST
CONC. BAND (TYP)


FIN. GRADE @ FRON.

STEPPED FOOTINGS (30)


FRONT ELEVATION 'A1' - END

REAR ELEVATION 'A' - END


UTRABALLO | TUE MAY 11/21 03:03 PM | C:\USERS\UTRABALLO\DESKTOP\216102\WT2009-END.DWG

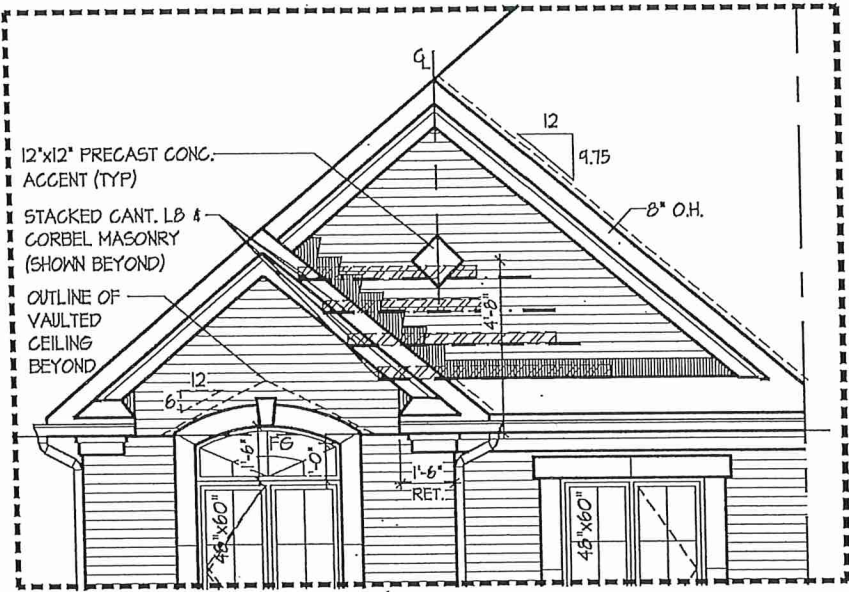

PART. FRONT
ELEVATION 'A2'

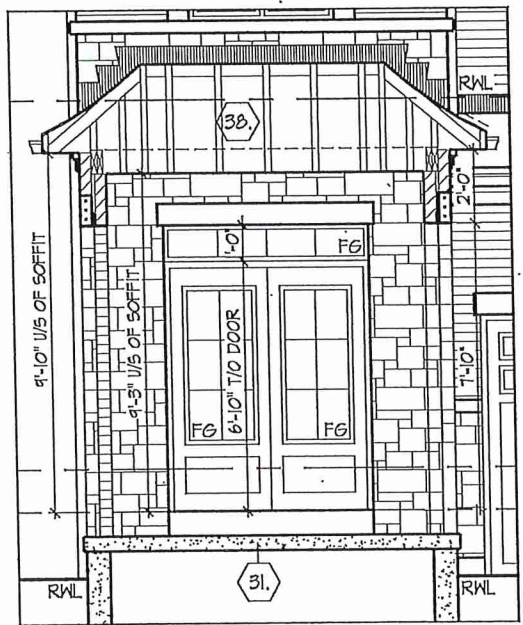


INTERIOR PORTICO
ELEVATION 'A'

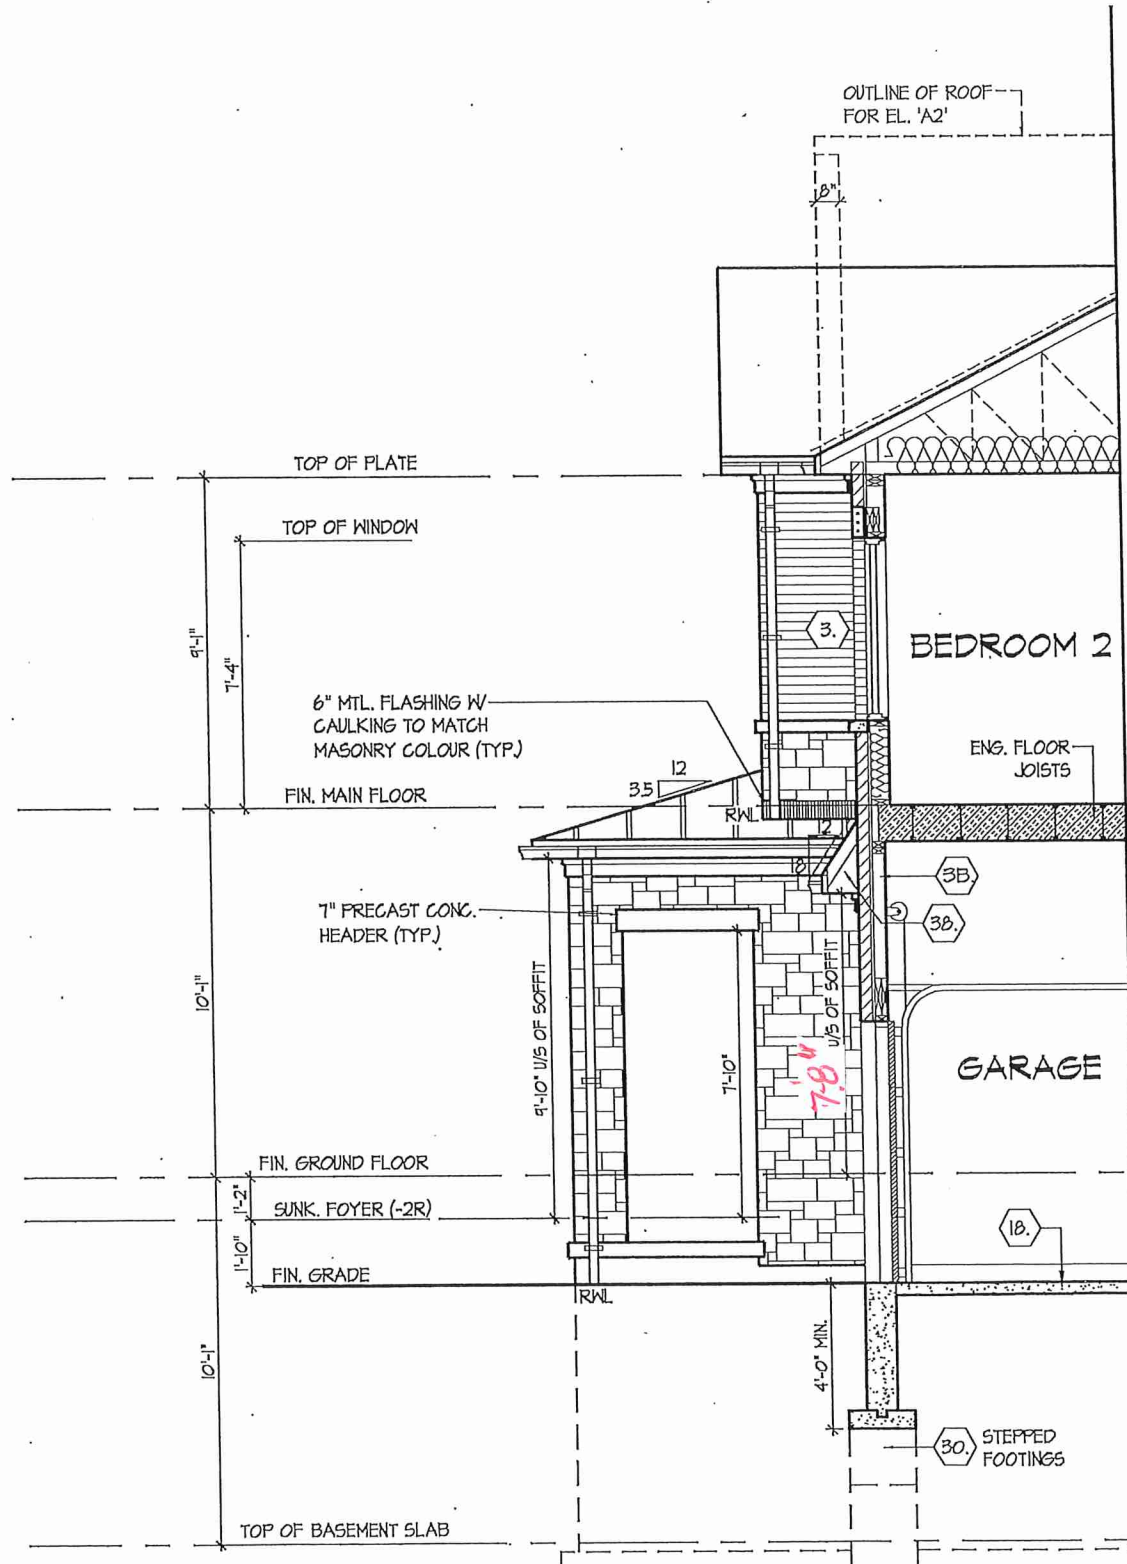

PARTIAL SECTION 'B', EL. 'A'

W Architect Inc.
DESIGN CONTROL REVIEW
JUNE 01, 2021
FINAL BY: *ALL*
This stamp is only for the purposes of design control and carries no other professional obligations.

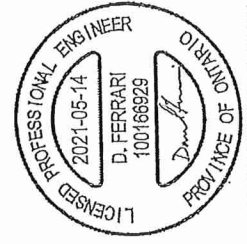

FOR STRUCTURAL ONLY
NOT INCLUDING ENGINEERED
FLOOR OR ROOF SYSTEM

PART. FRONT ELEVATION 'A2' & SECTION 'B'

ROYAL PINE HOMES - 216102
'CENTREFIELD', WEST GORMLEY, RICHMOND HILL, ON. REV. 2021.05.11

Drawn By: KM
Checked By: DS
Scale: 3/16" = 1'-0"
File Number: 216102WT2009-END
Page Number: 10 of 18

HUNT
DESIGN ASSOCIATES INC.
www.huntdesign.ca

REGISTRATION INFORMATION
NAME: Derek R. Santos
BCIN: 37308
19695
HUNT DESIGN ASSOCIATES INC.
All drawings specifications related documents and design are the copyright property of Hunt Design Associates (H.D.A.). Reproduction of this property in whole or in part is strictly prohibited without H.D.A.'s written permission (H.D.A. assumes no responsibility or liability for this property unless it bears the appropriate H.D.A. number and original signature.)

BLK 235-72

SPATIAL CALCULATION			
PER O.B.C. TABLE 9.10.15.4			
LEFT SIDE ELEVATION A			
EXPOSING BUILDING	1086.55	S.F.	
FACE AREA	100.94	S.M.	
PORTION WALL AREA	1086.55	S.F.	
	100.94	S.M.	
LIMITING DISTANCE	1.5 m		
MAX. % OPENINGS	7	%	
QUAN.	WIDTH	DEPTH	WINDOW / DOOR FRAME SIZE (S.F.)
1	36"	62"	12.89
2	48"	62"	35.44
1	20"	68"	7.11
1	30"	16"	2.17
1	24"	48"	6.11
OPENINGS ALLOWED	76.06	S.F.	
OPENINGS PROVIDED	63.72	S.F.	
ADDITIONAL NOTES			
GLAZED AREA CALCULATED W/ FRAME SIZE MINUS 2" AROUND ENTIRE PERIMETER			

REFER TO FRONT ELEVATION FOR TYPICAL NOTES & INFORMATION

ROOF OVERHANGS TO BE 12" UNLESS NOTED OTHERWISE

W Architect Inc.

DESIGN CONTROL REVIEW

JUNE 01, 2021

FINAL

BY: *Ally*

This stamp is only for the purposes of design control and carries no other professional obligations.



FOR STRUCTURAL ONLY

NOT INCLUDING ENGINEERED FLOOR OR ROOF SYSTEM

LEFT SIDE ELEVATION 'A1/A2'

UNIT 2009-END

ROYAL PINE HOMES - 216102

'CENTREFIELD', WEST GORMLEY, RICHMOND HILL, ON.

REV. 2021.05.11

HUNT

DESIGN ASSOCIATES INC.

www.huntdesign.ca

THE UNDERSIGNED HAS REVIEWED AND TAKES RESPONSIBILITY FOR THIS DESIGN AND HAS THE QUALIFICATIONS AND MEETS THE REQUIREMENTS SET OUT IN THE ONTARIO BUILDING CODE TO BE A DESIGNER.

QUALIFICATION INFORMATION

Derek R. Santos

37308

BCN

19695

HUNT DESIGN ASSOCIATES INC.

All drawings specifications related documents and design are the copyright property of Hunt Design Associates (H.D.A.). Reproduction of this property in whole or in part is strictly prohibited without H.D.A.'s written permission (H.D.A. assumes no responsibility or liability for this property unless it bears the appropriate BCN number and original signature.)

Scale

3/16" = 1'-0"

Checked By

DS

Down By

KM

8666 Woodbine Ave, Markham, ON L3R 0J7

T 905.737.5133


F 905.737.7326


File Number

216102W72009-END


Page Number

11 of 18

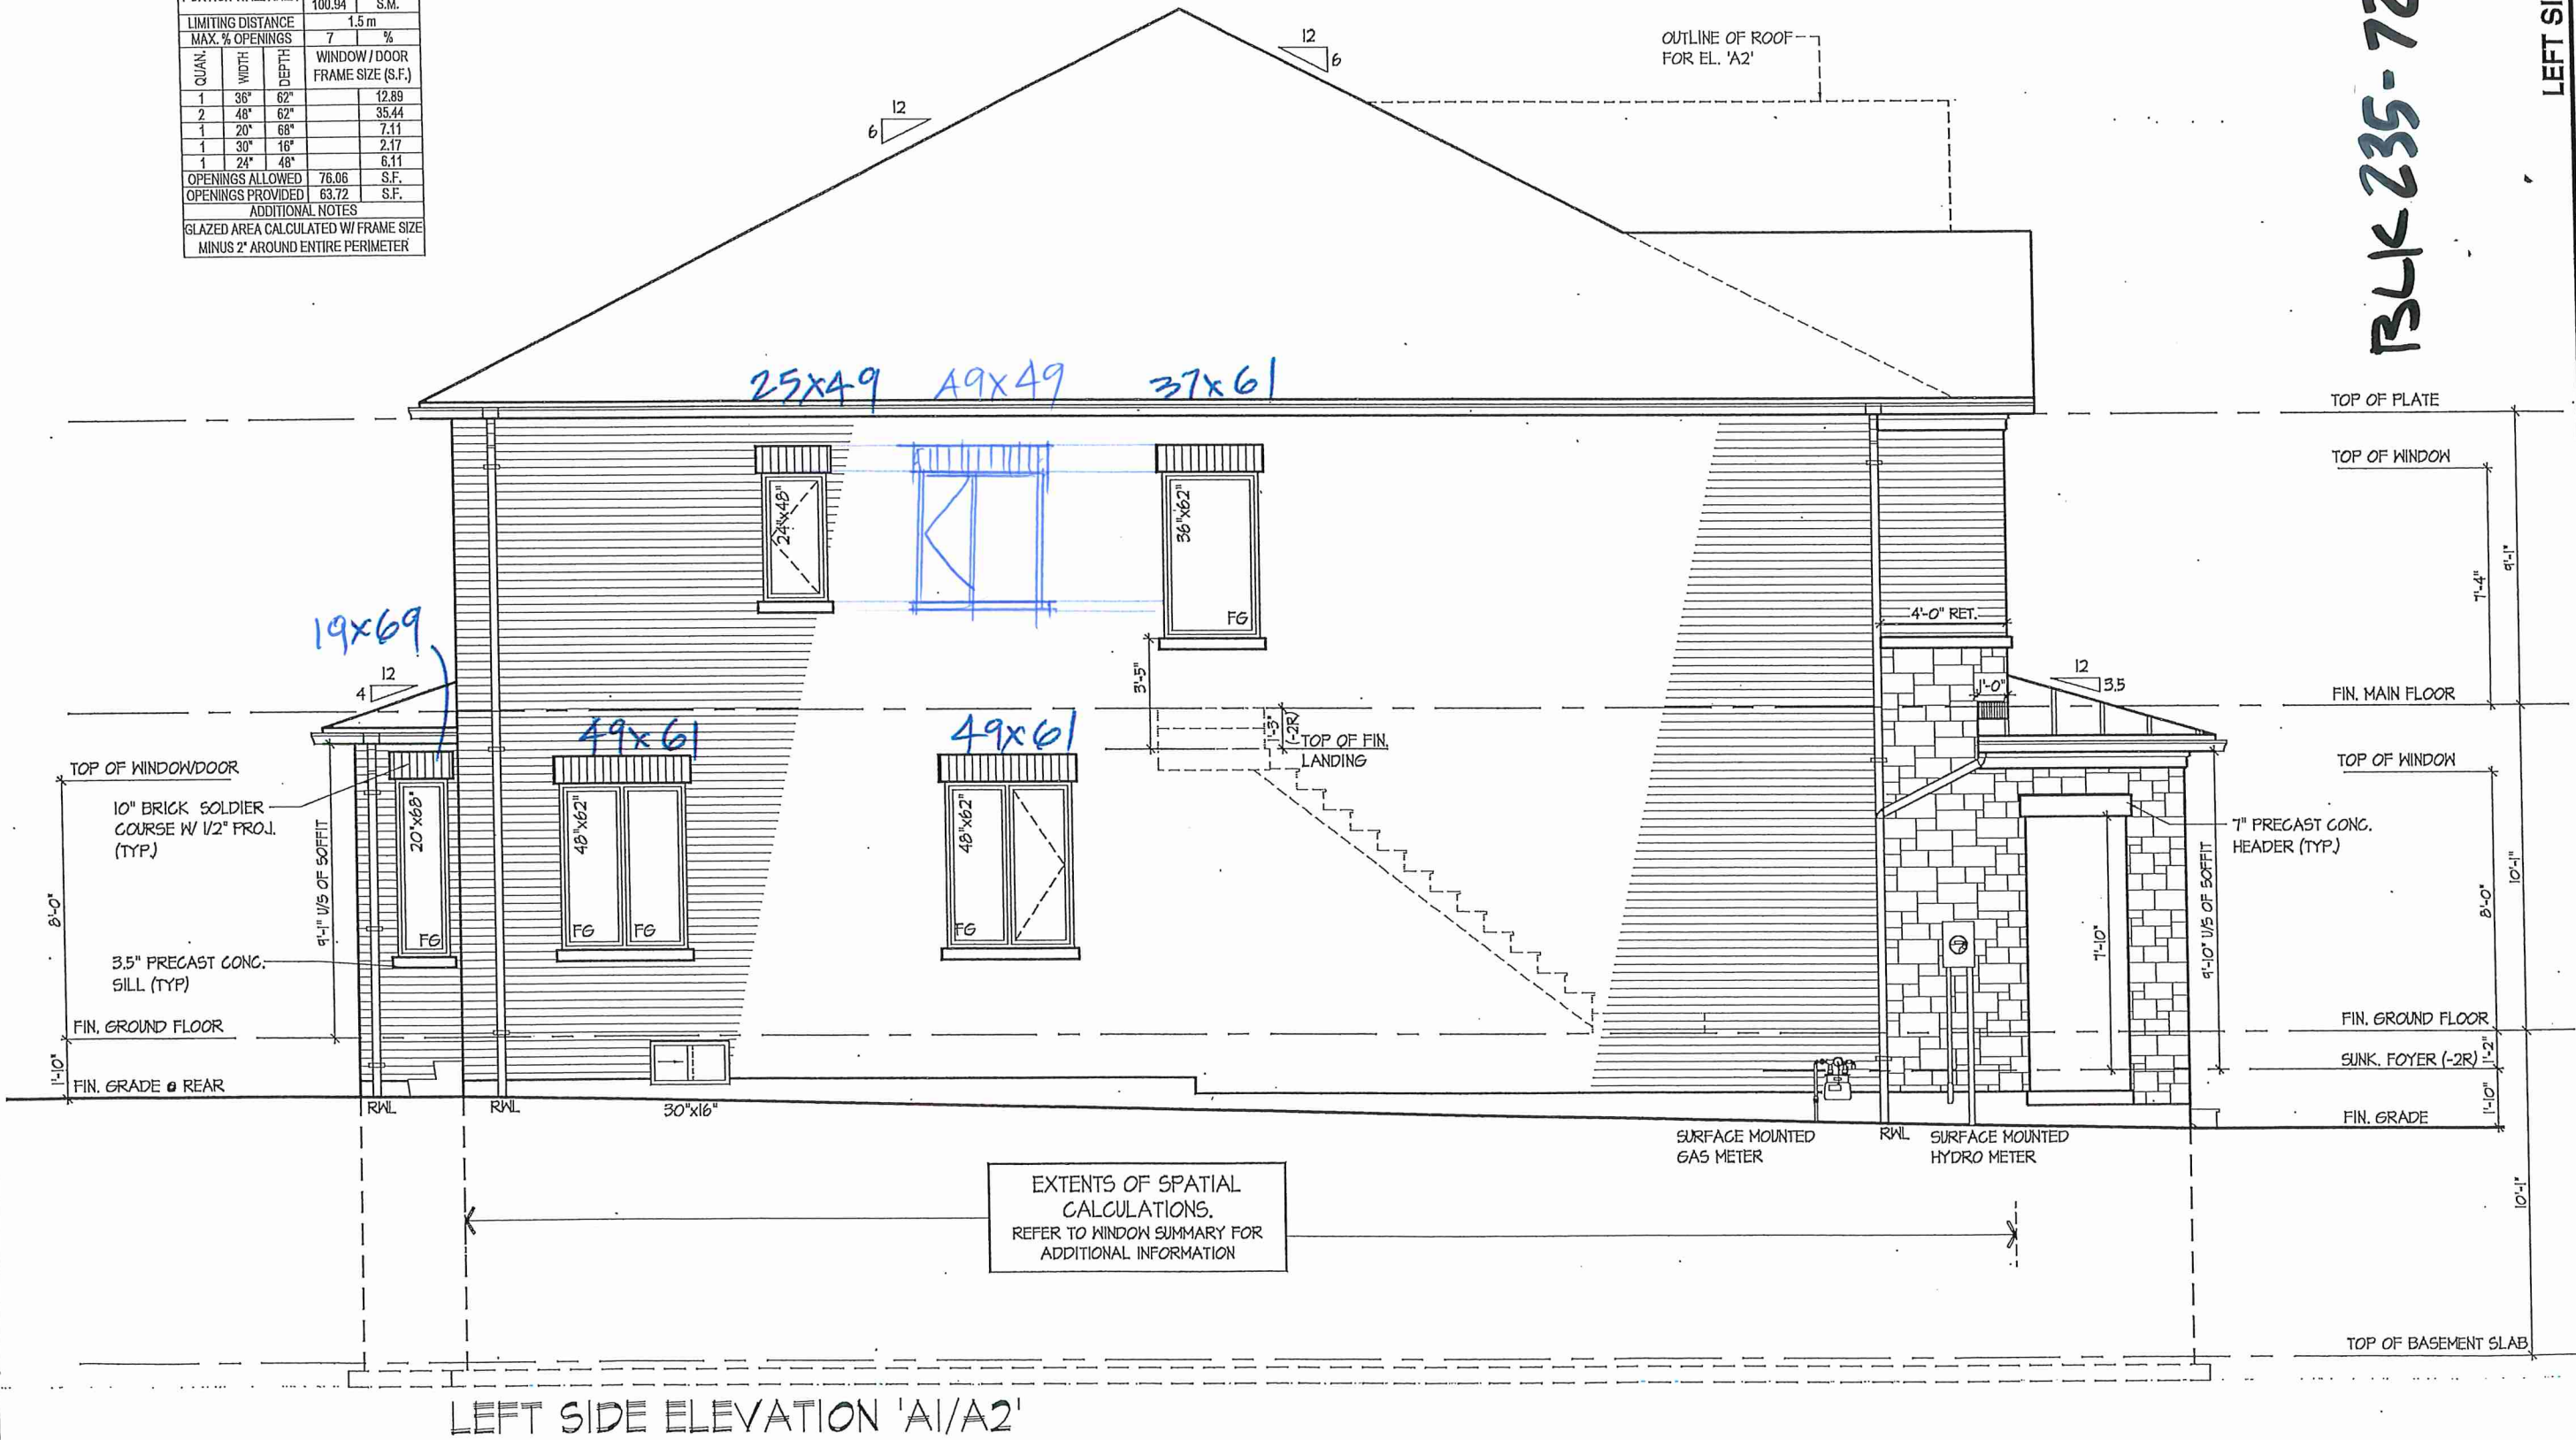

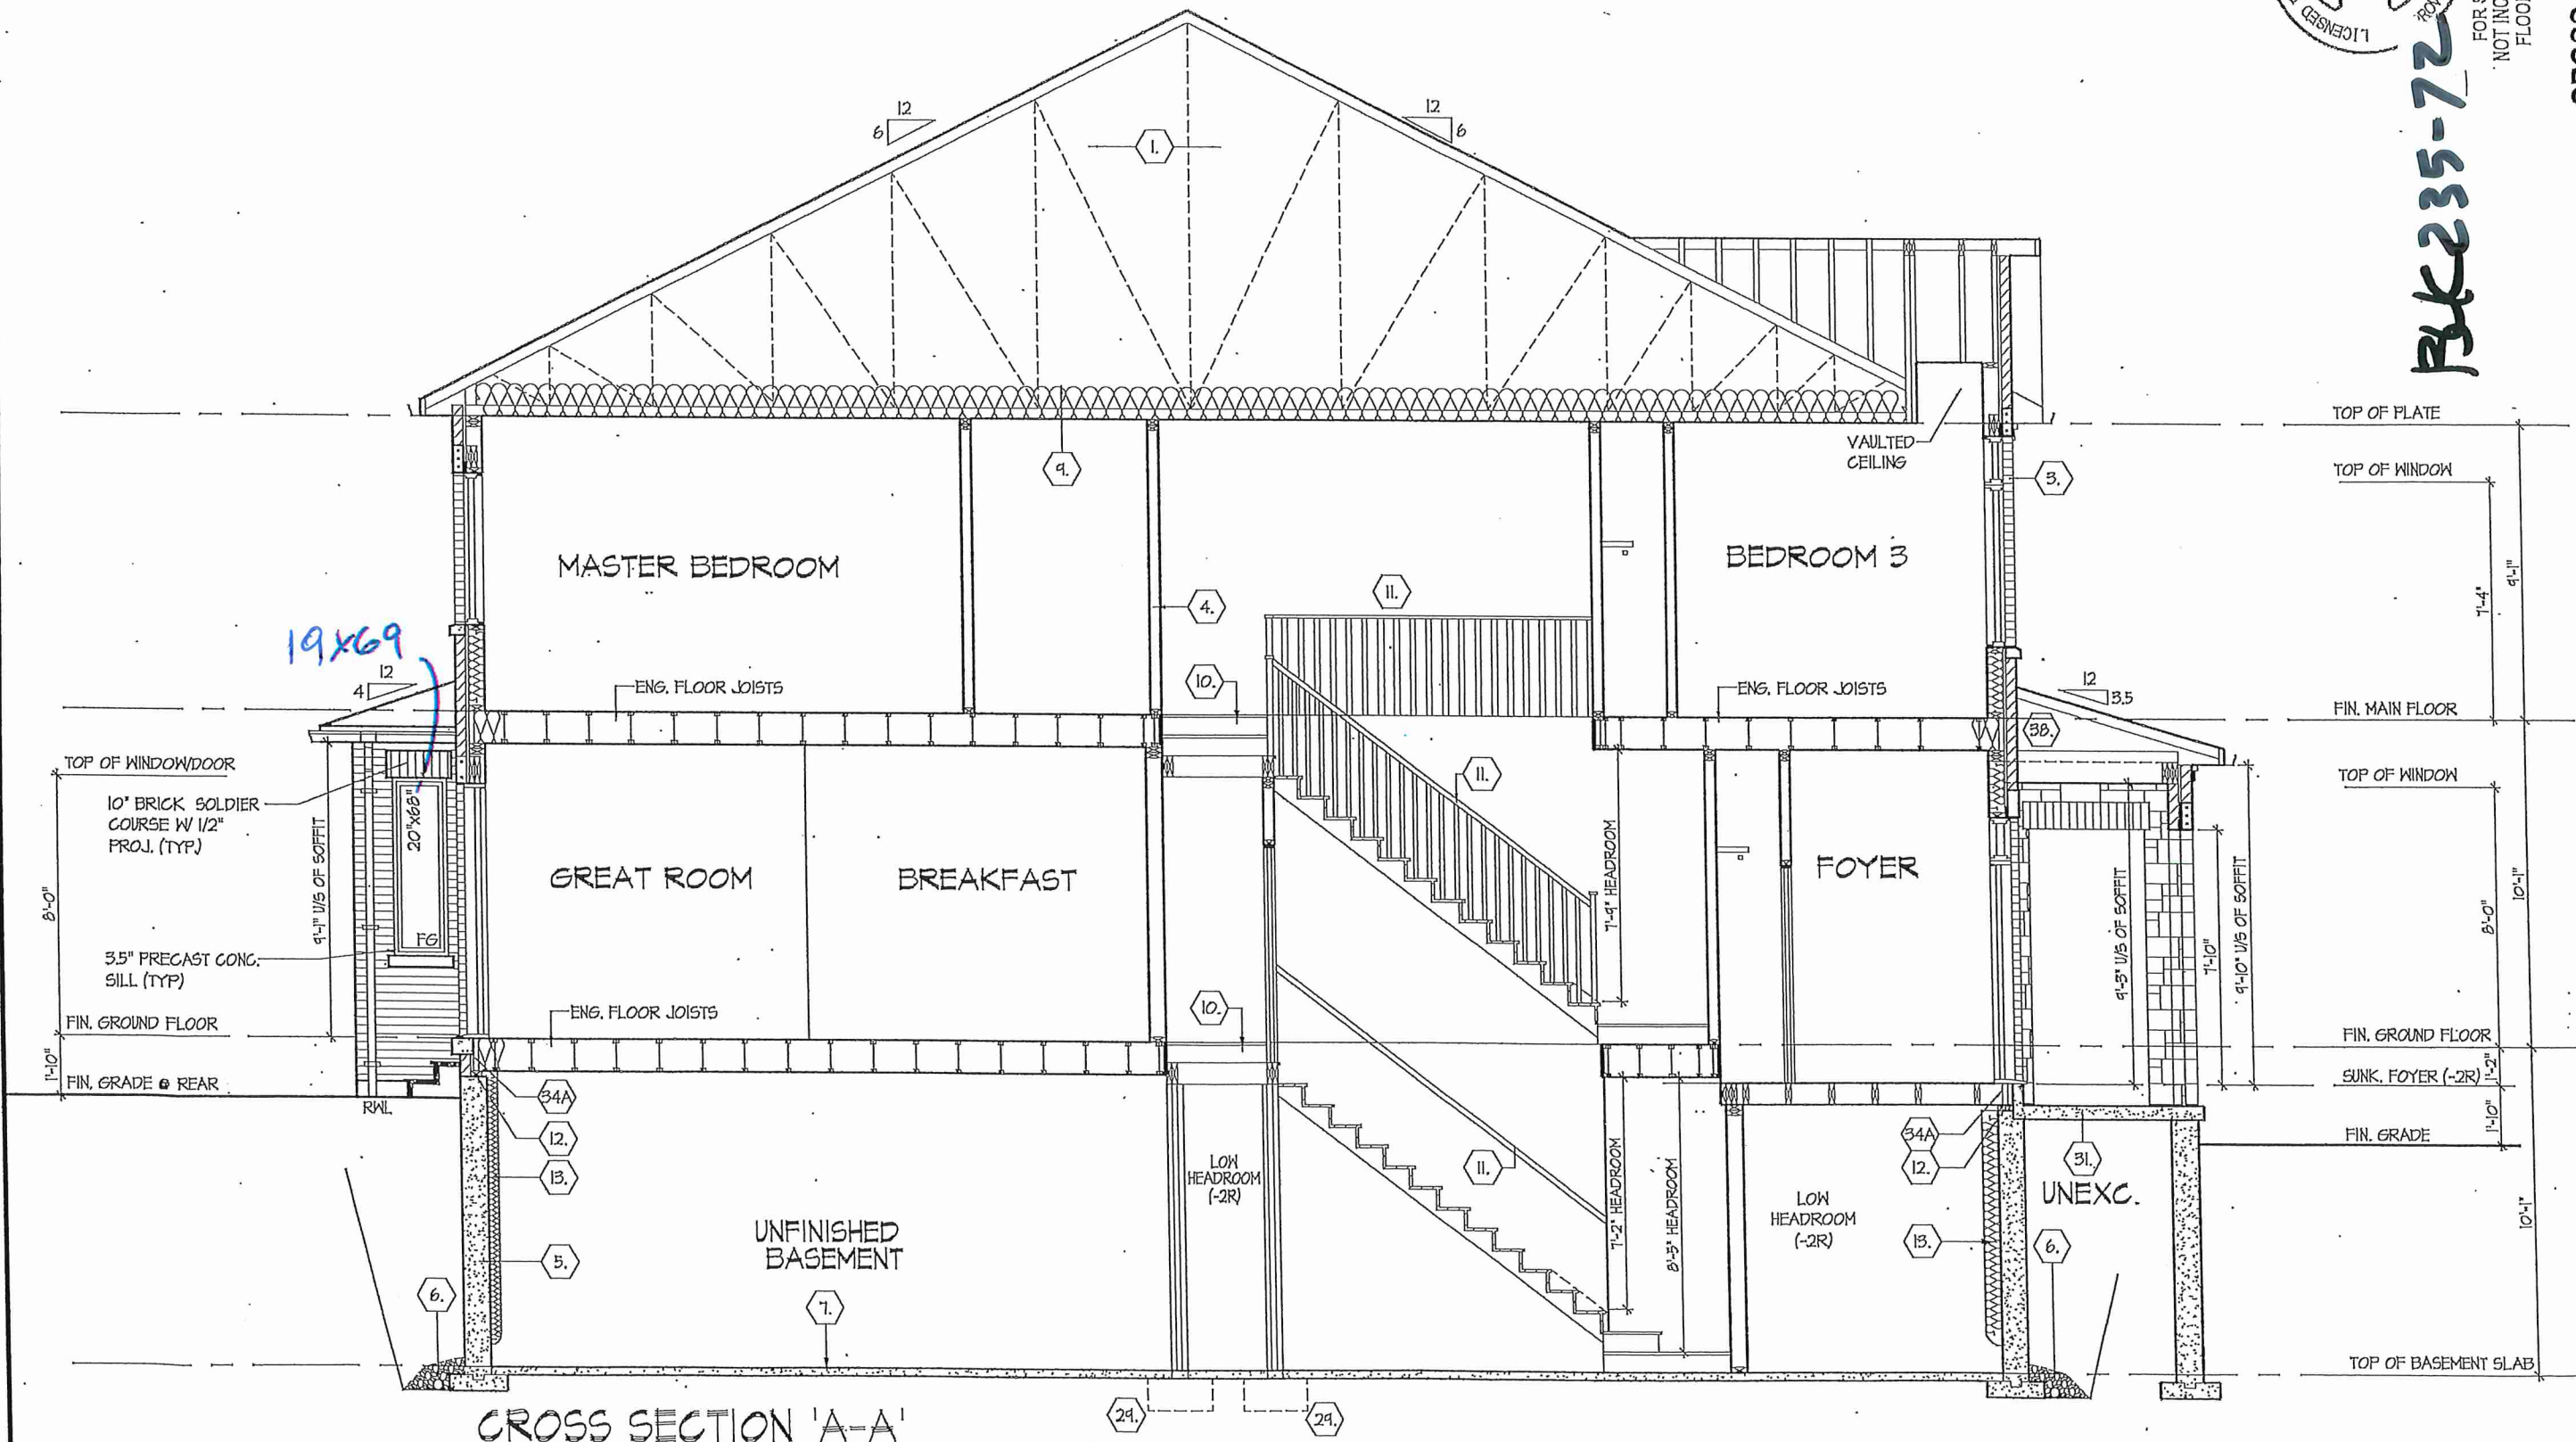

CROSS SECTION 'A-A'

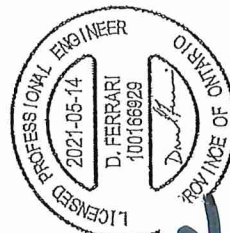

BK235-72

FOR STRUCTURAL ONLY
NOT INCLUDING ENGINEERED
FLOOR OR ROOF SYSTEM

CROSS SECTION 'A-A'

UNIT 2009-END

ROYAL PINE HOMES - 216102
'CENTREFIELD', WEST GORMLEY, RICHMOND HILL, ON. REV.2021.05.11

HUNT
DESIGN ASSOCIATES INC.
www.huntassociates.ca

THE UNDERSIGNED HAS REVIEWED AND TAKES RESPONSIBILITY FOR THIS
DESIGN AND HAS THE QUALIFICATIONS AND MEETS THE REQUIREMENTS SET
OUT IN THE ONTARIO BUILDING CODE TO BE A DESIGNER.

QUALIFICATION INFORMATION
Derek R. Santos
REGISTRATION INFORMATION
37308 BCN
SIGNATURE

HUNT DESIGN ASSOCIATES INC.
1965
31. Amending, expiring/renewing related documents and design are the copyright property of Hunt Design Associates (H.D.A.). Reproduction of this property in whole or in part is strictly prohibited without H.D.A.'s written permission (H.D.A. assumes no responsibility or liability for this property unless it bears the appropriate BCN number and original signature.)

Drawn By: KM
Checked By: DS
Scale: 3/16"=1'-0"
File Number: 216102WT2009-END
Page Number: 15 of 18

SECTION 1.0. CONSTRUCTION NOTES

- 1 ROOF CONSTRUCTION (9.19, 9.23.13, 9.23.15)
NO. 210 10.25 KG/M2 ASPHALT SHINGLES, 3/8" (9.5) PLYWOOD SHEATHING WITH 1" CLIPS. APPROVED WOOD TRUSSES @ 24" (610) O.C. MAX. APPROVED EAVES PROTECTION TO EXTEND 2'-11" (600) FROM EDGE OF ROOF AND MIN. 12" (305) BEYOND INNER FACE OF EXTERIOR WALL. 2"x4" (50x89) TRUSS BRACING @ 8'-0" (1830) O.C. AT BOTTOM CHORD. PREFIN. ALUM. EAVESTROUGH, FASCIA, RVL & VENTED SOFFIT. ATTIC VENTILATION 1:300 OF INSULATED CEILING AREA WITH MIN. 25% OF REQUIRED OPENINGS LOCATED AT TOP OF SPACE & MIN. 25% OF REQUIRED OPENINGS LOCATED AT BOTTOM OF SPACE. EAVESTROUGH TO BE 4" MIN. WITH RVL DISCHARGING ONTO CONCRETE SPLASH PADS OR PER MUNICIPAL REQUIREMENTS. TOWNHOUSES TO HAVE 5" MIN. EAVESTROUGH WITH ELEC. TRACED HEATER CABLE ALONG EAVESTROUGH AND DOWN RVL.
- 1A ICE AND WATER SHIELD
PROVIDE ICE AND WATER SHIELD IN THE AREAS INDICATED. THE ICE AND WATER SHIELD SHALL BE A SELF ADHERING AND SELF SEALING MEMBRANE. SIDE LAPS MUST BE A MINIMUM 3' (90) AND END LAPS A MINIMUM 6" (152), AND TO EXTEND UP DORMER WALLS A MINIMUM 12" (305).

1B PROFILED ROOF TRUSSES

ROOF TRUSSES SHALL BE PROFILED AND/OR STEPPED AT RAISED COFFER/TRAY CEILINGS. ANGLED TRAY CEILINGS WILL BE SHEATHED W/ 3/8" (9.5) PLYWOOD.

2 SIDING WALL CONSTRUCTION (2"x6")

SIDING MATERIAL AS PER ELEVATION ATTACHED TO FRAMING MEMBERS, FURRING MEMBERS OR BLOCKING BETWEEN THE FRAMING MEMBERS ON APPROVED SHEATHING PAPER ON 3/8" (9.5) EXT. GRADE SHEATHING ON STUDS CONFORMING TO O.B.C (9.23.10.1.) & SECTION 1.1., INSULATION, APPROVED 6 MIL. POLYETHYLENE AIRVAPOUR BARRIER, ON 1/2" (12.7) GYPSUM WALLBOARD INT. FIN. (GYPSUM SHEATHING, RIGID INSULATION, AND FIBERBOARD SHALL NOT BE USED FOR THE ATTACHMENT OF SIDING (9.23.16.3.(1.1)) (REFER TO 35 NOTE AS REQ.)

2A SIDING WALL CONSTRUCTION (2"x6") W/ CONTIN. INSULATION

SIDING MATERIAL AS PER ELEVATION ATTACHED TO FURRING MEMBERS ON APPROVED AIRWATER BARRIER AS PER O.B.C. 9.27.3. ON EXTERIOR TYPE RIGID INSULATION (JOINTS UNTAPED) MECHANICALLY FASTENED AS PER MANUFACTURERS SPECIFICATIONS ON 3/8" (9.5) EXT. GRADE SHEATHING ON STUDS CONFORMING TO O.B.C (9.23.10.1.) & SECTION 1.1., INSULATION, APPROVED 6 MIL. POLYETHYLENE AIRVAPOUR BARRIER, ON 1/2" (12.7) GYPSUM WALLBOARD INT. FIN. (GYPSUM SHEATHING, RIGID INSULATION, AND FIBERBOARD SHALL NOT BE USED FOR THE ATTACHMENT OF SIDING (9.23.16.3.(1.1)) (REFER TO 35 NOTE AS REQ.)

2B SIDING WALL @ GARAGE CONSTRUCTION

SIDING MATERIAL AS PER ELEVATION ATTACHED TO FRAMING MEMBERS, FURRING MEMBERS OR BLOCKING BETWEEN THE FRAMING MEMBERS ON APPROVED SHEATHING PAPER ON 3/8" (9.5) EXTERIOR TYPE SHEATHING ON STUDS CONFORMING TO O.B.C (9.23.10.1.) & SECTION 1.1., INSULATION, APPROVED 6 MIL. POLYETHYLENE AIRVAPOUR BARRIER, ON 1/2" (12.7) GYPSUM WALLBOARD INTERIOR FINISH. (GYPSUM SHEATHING, RIGID INSULATION AND FIBERBOARD SHALL NOT BE USED FOR THE ATTACHMENT OF SIDING (9.23.16.3.(1.1)) (REFER TO 35 NOTE AS REQ.)

3 BRICK VENEER WALL CONSTRUCTION (2"x6")

3 1/2" (90) BRICK VENEER 1" (25) AIR SPACE 7/8"x7"x0.03" (22x180x0.78) GALV. METAL TIES @ 16" (400) O.C. HORIZ. 24" (600) O.C. VERT. BONDING AND FASTENING FOR TIES TO CONFORM WITH 9.20.9. ON APPROVED SHEATHING PAPER, 3/8" (9.5) EXTERIOR TYPE SHEATHING, STUDS CONFORMING TO O.B.C (9.23.10.1.) & SECTION 1.1., INSULATION, APPROVED 6 MIL. POLYETHYLENE AIRVAPOUR BARRIER WITH APPROVED CONTIN. AIR BARRIER, 1/2" (12.7) GYPSUM WALLBOARD INTERIOR FINISH. PROVIDE WEEP HOLES @ 32" (800) O.C. AT BOTTOM COURSE AND OVER OPENINGS. PROVIDE BASE FLASHING UP MIN. 6" (150) BEHIND BUILDING PAPER (9.20.13.6.) (REFER TO 35 NOTE AS REQUIRED)

3A BRICK VENEER WALL CONSTRUCTION (2"x6") W/ CONTIN. INSULATION

3 1/2" (90) BRICK VENEER 1" (25) AIR SPACE 7/8"x7"x0.03" (22x180x0.78) GALV. METAL TIES @ 16" (400) O.C. HORIZ. 24" (600) O.C. VERT. BONDING AND FASTENING FOR TIES TO CONFORM WITH 9.20.9. ON APPROVED AIRWATER BARRIER AS PER O.B.C. 9.27.3. ON EXTERIOR TYPE RIGID INSULATION (JOINTS UNTAPED) MECHANICALLY FASTENED AS PER MANUFACTURERS SPECIFICATIONS, ON 3/8" (9.5) EXTERIOR TYPE SHEATHING, STUDS CONFORMING TO O.B.C (9.23.10.1.) & SECTION 1.1., INSULATION, APPROVED 6 MIL. POLYETHYLENE AIRVAPOUR BARRIER WITH APPROVED CONTIN. AIR BARRIER, 1/2" (12.7) GYPSUM WALLBOARD INTERIOR FINISH. PROVIDE WEEP HOLES @ 32" (800) O.C. AT BOTTOM COURSE AND OVER OPENINGS. PROVIDE BASE FLASHING UP MIN. 6" (150) BEHIND BUILDING PAPER (9.20.13.6.) (REFER TO 35 NOTE AS REQUIRED)

3B BRICK VENEER WALL @ GARAGE CONSTRUCTION

3 1/2" (90) BRICK VENEER, MIN. 1" (25) AIR SPACE, 7/8"x7"x0.03" (22x180x0.78) GALV. METAL TIES @ 16" (400) O.C. HORIZ. 24" (600) O.C. VERT. BONDING AND FASTENING FOR TIES TO CONFORM WITH 9.20.9. ON APPROVED SHEATHING PAPER, 3/8" (9.5) EXTERIOR TYPE SHEATHING ON STUDS CONFORMING TO O.B.C (9.23.10.1.) & SECTION 1.1., INSULATION, APPROVED 6 MIL. POLYETHYLENE AIRVAPOUR BARRIER WITH APPROVED CONT. AIR BARRIER, 1/2" (12.7) GYPSUM WALLBOARD INTERIOR FINISH. PROVIDE 2"x4" (50x89) WOOD BLOCKING ON FLAT @ 3'-11" (1194) O.C. MAX. BETWEEN FLOOR JOISTS. (REFER TO 35 NOTE AS REQ.)

4 INTERIOR STUD PARTITIONS (9.23.9.8, 9.23.10)

BEARING PARTITIONS SHALL BE A MINIMUM 2"x4" (50x89) @ 16" (408) O.C. FOR 2 STOREY AND 12" (305) O.C. FOR 3 STOREY, NON-BEARING PARTITIONS 2"x4" (50x89) @ 24" (610) O.C. PROVIDE 2"x4" (50x89) BOTTOM PLATE AND 2"x24" (12x36x89) TOP PLATE, 1/2" (12.7) INT. DRYWALL, BOTH SIDES OF STUDS, PROVIDE 2"x6" (50x140) STUDS WHERE NOTED, PROVIDE 2"x4" (50x89) @ 24" (610) O.C. LADDER FRAMING WHERE WALLS INTERSECT PERPENDICULAR TO ONE ANOTHER. PROVIDE 2"x4" (50x89) WOOD BLOCKING ON FLAT @ 3'-11" (1194) O.C. MAX. BETWEEN FLOOR JOISTS. (REFER TO 35 NOTE AS REQUIRED)

4A EXT. LOFT WALL CONSTRUCTION (2"x6") - NO CLADDING
3/8" (9.5) EXTERIOR TYPE SHEATHING, STUDS CONFORMING TO O.B.C (9.23.10.1.) & SECTION 1.1., INSULATION AND 6 mil POLYETHYLENE VAPOUR BARRIER WITH APPROVED CONT. AIR BARRIER, 1/2" (12.7) GYPSUM WALLBOARD INT. FINISH. (9.23)

4B EXT. LOFT WALL CONSTRUCTION (2"x6")

APPROVED AIRWATER BARRIER AS PER O.B.C. 9.27.3. ON EXTERIOR TYPE RIGID INSULATION (JOINTS UNTAPED) MECHANICALLY FASTENED AS PER MANUFACTURERS SPECIFICATIONS, ON 3/8" (9.5) EXTERIOR TYPE SHEATHING, STUDS CONFORMING TO O.B.C (9.23.10.1.) & SECTION 1.1., INSULATION AND 6 mil POLYETHYLENE VAPOUR BARRIER WITH APPROVED CONT. AIR BARRIER, 1/2" (12.7) GYPSUM WALLBOARD INT. FINISH. (9.23)

5 FOUNDATION WALL/FOOTINGS

POURED CONC. FOUNDATION WALL AS PER CHART BELOW ON CONTINUOUS KEYED CONCRETE FOOTING. FOUNDATION WALLS SHALL EXTEND NOT LESS THAN 6" (150) ABOVE FINISHED GRADE. THE OUTSIDE OF THE FOUNDATION SHALL BE DAMPROOFED FROM THE TOP OF THE FOOTING TO FINISHED GRADE AND BRUSH COAT FROM THE TOP TO 2' BELOW GRADE. PROVIDE A DRAINAGE LAYER ON THE OUTSIDE OF THE FOUNDATION WALL. SEAL THE DRAINAGE LAYER AT THE TOP. THE TOP OF THE CONC. FOOTING SHALL BE DAMPROOFED. CONCRETE FOOTINGS SUPPORTING JOIST SPANS GREATER THAN 16'-11" (4800) SHALL BE SIZED IN ACCORDANCE WITH 9.15.3.4.1 (2) OF THE O.B.C. (REFER TO CHART BELOW FOR RESPECTIVE SIZES), BRACE FOUNDATION WALL PRIOR TO BACKFILLING. ALL FOOTINGS SHALL REST ON NATURAL UNDISTURBED SOIL OF 150kPa. IF SOIL BEARING DOES NOT MEET MINIMUM CAPACITY, ENGINEERED FOOTINGS ARE REQUIRED. ACTUAL SOIL BEARING CAPACITY TO BE VERIFIED WITH SOIL ENGINEERING REPORT.

REFER TO CONSTRUCTION DRAWINGS AND DETAILS FOR FOUNDATION WALL STRENGTH AND THICKNESS 9.15.4.

FOUNDATION WALLS SHALL NOT EXCEED 9'-10" (3.0m) IN UNSUPPORTED HEIGHT UNLESS OTHERWISE NOTED. (9.15.4.2.(1.))

MINIMUM STRIP FOOTING SIZES (9.15.3.)	UNSUPPORTED		SUPPORTED AT TOP	
	SS	CS	SS	CS
1	3'-11" (1.20m)	7'-0" (2.15m)	2'-5.5m & ±2.75m	>2.75m & ±3.0m
2	4'-7" (1.40m)	7'-6" (2.30m)	8'-5" (2.60m)	9'-2" (2.80m)
3	4'-11" (1.50m)	7'-8" (2.30m)	8'-5" (2.60m)	9'-3" (2.85m)
4	4'-7" (1.40m)	7'-6" (2.30m)	8'-5" (2.60m)	9'-3" (2.85m)
5	4'-11" (1.50m)	7'-8" (2.30m)	8'-5" (2.60m)	9'-3" (2.85m)

*9" MIN. THICK FOUNDATION WALL IS REQUIRED FOR MASONRY VENEER FINISHED EXTERIOR WALLS WITH CONTINUOUS INSULATION CONDITION, TO PROVIDE MIN. BEARING FOR SILL PLATES, BEAMS AND FLOOR JOIST AS PER 9.23.7.2., 9.23.8.1., & 9.23.9.1. OF THE O.B.C.

NUMBER FLOORS SUPPORTED	SUPPORTING EXTERIOR MASONRY WALLS	SUPPORTING PARTIAL WALL
1	16" WIDE x 8" THICK	16" WIDE x 8" THICK
2	24" WIDE x 8" THICK	24" WIDE x 8" THICK
3	36" WIDE x 14" THICK	26" WIDE x 9" THICK (36" WIDE x 14" THICK)

THE UNDERSIGNED HAS REVIEWED AND TAKES RESPONSIBILITY FOR THIS DESIGN AND HAS THE QUALIFICATIONS AND MEETS THE REQUIREMENTS SET OUT IN THE ONTARIO BUILDING CODE TO BE A DESIGNER.

Derek R. Santos
SIGNATURE

37308
BON

19855

HUNT DESIGN ASSOCIATES INC.,

351 Janeville street-mississauga related documents and design are the copyright property of Hunt Design Associates (H.D.A.). Reproduction of this property in whole or in part is strictly prohibited without H.D.A.'s written permission (H.D.A. assumes no responsibility or liability for this property unless it bears the appropriate BOM number and original signature).

5A FOUNDATION REDUCTION IN THICKNESS FOR MASONRY
WHERE THE TOP OF THE FOUNDATION WALL IS REDUCED IN THICKNESS TO PERMIT THE INSTALLATION OF MASONRY EXTERIOR FACING, THE REDUCED SECTION SHALL BE NOT LESS THAN 3' (90) THICK. THE BRICK VENEER SHALL BE TIED TO THE FOUNDATION WALL WITH CORROSION RESISTANT METAL TIES @ 7' (210) VERTICAL AND 2'-11" (549) HORIZONTAL. FILL VOID WITH MORTAR BETWEEN WALL AND BRICK VENEER (9.15.4.72(3) & 9.20.9.4(9))

5B FOUNDATION REDUCTION IN THICKNESS FOR JOISTS
WHERE THE TOP OF THE FOUNDATION WALL IS REDUCED IN THICKNESS TO PERMIT THE INSTALLATION OF FLOOR JOISTS, THE REDUCED SECTION SHALL BE NOT MORE THAN 13' (390) HIGH & NOT LESS THAN 3' (90) THICK (9.15.4.7(1))

6 WEEPING TILE (9.14.3)

4" (100) Ø WEEPING TILE W/ FILTER CLOTH WRAP & 6" (152) CRUSHED STONE COVER

7 BASEMENT SLAB OR SLAB ON GRADE (9.15.4.3)

3" (60) MIN. 25MPa (3600psi) CONC. SLAB ON 4" (100) COARSE GRANULAR FILL, OR 20MPa (2900psi) CONC. WITH DAMPROOFING BELOW SLAB. PROVIDE 1/2" (12.7) IMPERVIOUS BOARD FOR BOND BREAK AT EDGE. (9.13.) WHERE A BASEMENT SLAB IS WITHIN 24" (610) OF THE EXTERIOR GRADE PROVIDE RIGID INSUL. AROUND THE PERIMETER EXTENDING MIN. 24" (610) BELOW GRADE. FOR SLAB ON GRADE CONDITIONS RIGID INSULATION SHALL BE APPLIED TO THE UNDERSIDE OF THE ENTIRE SLAB. (9.8-12) 3.1.1.7.(5) & (6)

8 EXPOSED FLOOR TO EXTERIOR (9.10.17.10, & CANULC-S705.2)

PROVIDE SPRAY FOAM INSULATION BETWEEN CANT. JOIST AND INSTALL FIN. SOFFIT OR CLADDING AS PER ELEVATION TO U/S OF EXPOSED CANT. JOIST.

9 EXPOSED CEILING TO EXTERIOR W/ ATTIC (9.25.2.4)

INSULATION, 6 mil POLYETHYLENE VAPOUR BARRIER, 1/2" (12.7) GYPSUM BOARD INTERIOR FINISH OR APPROVED EQ.

10 EXPOSED CEILING TO EXTERIOR w/o ATTIC

JOISTS/TRUSSES AS PER PLANS W/ 2"x2" (50x38) PURLINS @ 16" (408) O.C. PERPENDICULAR TO JOISTS (PURLINS NOT REQ. W/ SPRAY FOAM) OR ROOF TRUSSES) W/ INSULATION BETWEEN JOIST, 6 mil POLYETHYLENE VAPOUR BARRIER, 1/2" (12.7) GYPSUM BOARD INT. FINISH OR APPROVED EQ. (CANULC-S705.2, 9.19.1, 9.10.17.1.)

ALL STAIRS/EXTERIOR STAIRS (9.8.1.2, 9.8.2, 9.8.4.)

	MAX. RISE	MIN. RISE	MAX. RUN	MIN. RUN	MAX. TREAD	MIN. TREAD
PRIVATE 7'7" (200)	5" (125)	14" (355)	8' 1/4" (210)	14" (355)	9 1/4" (235)	
PUBLIC 7' (180)	5" (125)	NO LIMIT	11" (280)	NO LIMIT	11" (280)	
	MIN. STAIR WIDTH	CURVED STAIRS		ALL STAIRS		
PRIVATE	2'-0" (600)	MIN. RUN	5' 7/8" (150)	MAX. NOSING	1" (25)	
PUBLIC	2'-11" (600)	MIN. AVG. RUN	7' 7/8" (200)			

** HEIGHT OVER STAIRS (HEADROOM) IS MEASURED VERTICALLY ACROSS WIDTH OF STAIRS FROM A STRAIGHT LINE TO THE TREAD & LANDING NOSING TO LOWEST POINT ABOVE AND NOT LESS THAN 6'-5" (1960) FOR SINGLE DWELLING UNIT & 6'-8 3/4" (2050) FOR EVERYTHING ELSE. (9.8.2.2)

REQUIRED LANDING IN GARAGE - O.B.C. 9.8.6.2.(8).

FOR AN EXTERIOR STAIR SERVING A GARAGE W/ MORE THAN 3 RISERS, GUARDS, HANDRAILS & STEPS AS PER CONSTRUCTION HEX NOTE 10 & 11.

11 GUARDS/RAILINGS (9.8.7, 9.8.8.)

GUARDS TO BE DESIGNED NOT TO FACILITATE CLIMBING AND PROVIDING MAX. OPENING CONFORMING TO O.B.C. 9.8.8.5, 9.8.8.6. AND BE ABLE TO RESIST LOADS AS PER TABLE 9.8.8.2.

GUARD HEIGHTS - O.B.C. 9.8.8.

INTERIOR GUARDS: 2'-11" (600) MIN. LESS THAN 5'-11" (1800) TO GRADE) EXTERIOR GUARDS: 2'-11" (600) MIN. MORE THAN 5'-11" (1800) TO GRADE) 9'-6" (1070) MIN. (MORE THAN 5'-11" (1800) TO GRADE)

GUARDS FOR EXIT STAIRS: 3'-0" (920) MIN.

GUARDS FOR LANDINGS @ EXIT STAIRS: 3'-6" (1070) MIN.

GUARDS FOR FLOORS & RAMPS IN GARAGES (SERVICE STAIRS)

FLOOR OR RAMP W/O EXTERIOR WALLS THAT IS 23 5/8" (600) OR MORE ABOVE ADJACENT SURFACE REQUIRES CONT. CURB MIN. 6" (150) HIGH, AND GUARD MIN. 3'-6" (1070) HIGH.

REQUIRED GUARDS

BEHIND WALKING SURFACE & ADJACENT SURFACE WITH A DIFFERENCE IN ELEVATION MORE THAN 23 5/8" (600) OR ADJACENT SURFACE WITHIN 3'-11" (1200) & WALKING SURFACE W/ A SLOPE MORE THAN 1 IN 12 SHALL BE PROTECTED WITH GUARDS PER CONSTRUCTION HEX NOTE 11.

HANDRAIL HEIGHTS - O.B.C. 9.8.7 - REQUIRED AS PER 9.8.7.1.(2)

MIN. HEIGHT AT STAIRS OR RAMP: 2'-0" (600)

MAX. HEIGHT AT STAIRS OR RAMP: 3'-2" (965)

MAX. HEIGHT AT LANDING: 3'-6" (1070)

STAIRS OR RAMP MIN. 7'-3" (2200) WIDE: 2'-9" (865) MIN. HEIGHT

12 SILL PLATES

2"x4" (50x89) SILL PLATE WITH 1/2" (12.7) Ø ANCHOR BOLTS 8" (200) LONG, EMBEDDED MIN. 4" (100) INTO CONC. @ 7'-0" (2380) O.C., CALCULG OR GASKET BETWEEN PLATE AND TOP OF FOUNDATION. FIELD USE NON-SHRINK GROUT TO LEVEL SILL PLATE WHEN REQUIRED (9.23.7)

13 BASEMENT INSULATION (9.8-12) 3.1.1.7)

PROVIDE CONTINUOUS BLANKET INSULATION W/ BUILT IN 6 mil POLYETHYLENE VAPOUR BARRIER. INSULATION TO EXTEND NO MORE THAN 6" (200) ABOVE FINISHED BASEMENT FLOOR. DAMPROOFED WITH BUILDING PAPER BETWEEN THE FOUNDATION WALL AND INSULATION UP TO GRADE LEVEL.

14 BEARING STUD PARTITION (9.8-12) 3.1.1.7)

2"x4" (50x89) STUDS @ 16" (408) O.C., 2"x4" (50x89) SILL PLATE (2"x6" (50x140) AS REQUIRED) ON DAMPROOFING MATERIAL OR 2 mil POLYETHYLENE FILM, 1/2" (12.7) Ø ANCHOR BOLTS 8" (200) LONG, EMBEDDED 4" (100) MIN. INTO CONC. @ 7'-0" (2380) O.C. (1) HIGH CONC. CURB ON CONC. FOOTING. FOR SIZE REFER TO HEX NOTE 5. ADD HORIZ. BLOCKING AT MID-HEIGHT IF WALL IS UNFINISHED.

15 ADJUSTABLE STEEL BASEMENT COLUMN (9.15.3.4)

9'-0" (3000) MAX. SPAN BETWEEN COLUMNS, 3 1/2" (90) SINGLE TUBE ADJUSTABLE STEEL COLUMN CONFORMING TO CAN/C6387-2M, AND WITH 6"x6"x3/8" (152x152x9.5) STEEL PLATE TOP & BOTTOM. FIELD WELD BASEMENT COLUMN CONNECTION. POURED CONCRETE FOOTING ON NATURAL UNDISTURBED SOIL OF 75kPa OR COMPACTED ENGINEERED FILL WITH MIN. BEARING CAPACITY OF 150kPa AS PER SOILS REPORT.

SUPPORTING 2 STOREY FLR. LOAD PROVIDE 42"x42"x16" (1070x1070x460) CONC. FOOTING

SUPPORTING 3 STOREY FLR. LOAD PROVIDE 48"x48"x18" (1080x1080x480) CONC. FOOTING

15A NON-ADJUSTABLE STL. COLUMN AT FOUNDATION WALL

3 1/2" (90) x 0.188" (4.78) NON-ADJUSTABLE STEEL COLUMN WITH 6"x6"x3/8" (152x152x9.5) STEEL TOP PLATE & 6"x4"x3/8" (152x100x9.5) BOTTOM PLATE. BASE PLATE 4'-12"x10"x1/2" (120x250x12.7) WITH 2- 1/2"x2 x 12" LONG x 2" HOOK ANCHORS (2- 12x70x300x506), FIELD WELD COLUMN TO BASE PLATE & STEEL BM.

SUPPORTING 2 STOREY FLR. LOAD PROVIDE 42"x42"x16" (1070x1070x460) CONC. FOOTING

SUPPORTING 3 STOREY FLR. LOAD PROVIDE 48"x48"x18" (1200x1220x610) CONC. FOOTING

NON-ADJUSTABLE STL. COLUMN AT FOUNDATION WALL
3 1/2" (90) x 0.188" (4.78) NON-ADJUSTABLE STEEL COLUMN WITH 6"x6"x3/8" (152x152x9.5) STEEL TOP PLATE & 6"x4"x3/8" (152x100x9.5) BOTTOM PLATE. BASE PLATE 4'-12"x10"x1/2" (120x250x12.7) WITH 2- 1/2"x2 x 12" LONG x 2" HOOK ANCHORS (2- 12x70x300x506), FIELD WELD COLUMN TO BASE PLATE & STEEL BM.

STEEL BEAM BEARING AT FOUNDATION WALL (9.23.8.1)
BEAM POCKET OR 8"x8" (200x200) POURED CONC. NIB WALLS MIN. BEARING 3 1/2" (90). CONC. NIB WALLS TO HAVE EXTENDED FOOTINGS

16 WOOD STRAPPING AT STEEL BEAMS (9.23.4.3.(8), 9.23.9.3.)

1"x3" (19x64) CONTIN. WOOD STRAPPING BOTH SIDES OF STEEL BEAM.

17 GARAGE SLAB (9.16, 9.35)

4" (100) 32MPa (4640psi) CONC. SLAB WITH 5-8% AIR ENTRAINMENT ON OPT. 4" (100) COARSE GRANULAR FILL WITH COMPACTED SUB-BASE OR COMPACTED NATIVE FILL SLOPE TO FRONT @ 1% MIN.

18 GARAGE TO HOUSE WALLS/CEILING (9.10.8.1.6)

1/2" (12.7) GYPSUM BOARD ON WALL AND CEILING BETWEEN HOUSE AND GARAGE, PLUS REQUIRED INSULATION IN WALLS AND SPRAY FOAM FOR CEILINGS. TAPE AND SEAL ALL JOINTS GAS TIGHT. (9.10.17.10, CANULC-S705.2)

GARAGE TO HOUSE WALLS/CEILING W/ CONTIN. INSULATION
1/2" (12.7) GYPSUM BOARD ON CEILING AND ON WALLS INSTALLED OVER EXTERIOR TYPE RIGID INSULATION (JOINTS UNTAPED) MECHANICALLY FASTENED AS PER MANUFACTURERS SPECIFICATIONS ON 3/8" EXTERIOR GRADE SHEATHING ON STUDS BETWEEN HOUSE AND GARAGE, PLUS REQUIRED INSULATION IN WALLS & SPRAY FOAM FOR CEILINGS. TAPE AND SEAL ALL JOINTS GAS TIGHT. (9.10.8.1.6, 9.10.17.10, CANULC-S705.2)

20 GARAGE DOOR TO HOUSE (9.10.8.1.6, 9.10.13.10, 9.10.13.15)

GAS-PROOF DOOR AND FRAME. DOOR EQUIPPED WITH SELF CLOSING DEVICE AND WEATHER STRIPPING.

21 EXTERIOR AND GARAGE STEPS

PRECAST CONC. STEP OR WOOD STEP WHERE NOT EXPOSED TO WEATHER. MAX RISE 7' (210) MIN. TREAD 9' (265). FOR THE REQUIRED NUMBER OF STEPS REFER TO SIZING AND GRADING DRAWINGS. EXTERIOR CONCRETE STAIRS WITH MORE THAN 2 RISERS AND 2 TREADS SHALL BE PROVIDED WITH FOUNDATION AS REQUIRED BY ARTICLE 9.8.9.2. OR SHALL BE CANTILEVERED AS PER SUBSECTION 9.8.10.

22 DRYER EXHAUST

CAPPED DRYER EXHAUST VENTED TO EXT. CONFORMING TO PART 6, OBC 9.32.

23 ATTIC ACCESS (9.19.2.1.)

ATTIC ACCESS HATCH WITH MIN. AREA OF 0.32m² AND NO DIM. LESS THAN 21 1/2" (545) WITH WEATHER STRIPPING. HATCHWAYS TO THE ATTIC OR ROOF SPACE WILL BE FITTED WITH DOORS OR COVERS AND WILL BE INSULATED WITH MIN. R20 (RSI 3.52) (9.8-12) 3.1.1.8.(1)

24 FIREPLACE CHIMNEYS (9.21)

TOP OF FIREPLACE CHIMNEY SHALL BE 2'-11" (549) ABOVE THE HIGHEST POINT AT WHICH IT COMES IN CONTACT WITH THE ROOF AND 2'-0" (610) ABOVE THE ROOF SURFACE WITHIN A HORIZ. DISTANCE OF 10'-0" (3048) FROM THE CHIMNEY.

25 LINEN CLOSET

PROVIDE 4 SHELVES MIN. 14" (355) DEEP.

26 MECHANICAL VENTILATION (9.32.1.3.)

MECHANICAL EXHAUST FAN, VENTED TO EXTERIOR, TO PROVIDE AT LEAST ONE AIR CHANGE PER HOUR. SEE GENERAL NOTE 2.3.

27 PARTY WALL BEARING (9.23.8)

12"x12"x5/8" (305x305x15.9) STEEL PLATE FOR STEEL BEAMS AND 12"x12"x1/2" (305x305x12.7) STEEL PLATE FOR WOOD BEAMS BEARING (MIN. 3'-1/2" (89)) ON CONC. BLOCK PARTY WALL, ANCHORED WITH 2-3/4" (2-19) x 2" (200) LONG GALV. ANCHORS WITHIN SOLID BLOCK COURSE LEVEL W/ NON-SHRINK GROUT. REFER TO NOTE SOLID BEARING (SECTION 5.0) FOR WD. STRUT PARTY WALL.

WOOD FRAMING IN CONTACT TO CONCRETE

WOOD BEARING WALLS, THE UNDERSIDE OF BUILT-UP WOOD POSTS AND SILLS SHALL BE WRAPPED WITH 2 mil POLY. STRIP FOOTINGS SUPPORTING THE FOUNDATION WALL SHALL BE WRAPPED 6" (152) BELOW THE BEARING WALL AND/OR WOOD POST. (9.17.4.3)

28 BUILT-UP WOOD POST AND FOOTING (9.17.4.1, 9.15.8.7.)

3-2"x6" (8-38x140) BUILT-UP WOOD POST (UNLESS OTHERWISE NOTED) ON METAL BASE SHOE ANCHORED TO CONC. WITH 1/2" (12.7) Ø BOLT, 2-5/8"x1/2" (10x610x305) CONC. FOOTING OR AS PROVIDED ON PLAN. REFER TO NOTE 28

29 STEP FOOTINGS (9.15.3.9.)

MIN. HORIZ. STEP = 23 5/8" (600). MAX. VERT. STEP = 23 5/8" (600).

30 CONC. PORCH SLAB (9.16.4.)

MIN. 4" (100) CONCRETE SLAB ON GRADE ON 4" (100) COARSE GRANULAR FILL, REINFORCED WITH 68xM2.9XW2.9 MESH PLACED NEAR MID-DEPTH OF SLAB. CONC. STRENGTH 32MPa (4640psi) WITH 5-8% AIR ENTRAINMENT ON COMPACTED SUB-GRADE.

32 FURNACE VENTING (9.32)

DIRECT VENT FURNACE TERMINAL MIN. 3'-0" (916) FROM A GAS REGULATOR. MIN. 12" (305) ABOVE FIN. GRADE, FROM ALL OPENINGS, EXHAUST AND INTAKE VENTS. HRV INTAKE TO BE A MIN. OF 8'-0" (1830) FROM ALL EXHAUST TERMINALS. REFER TO GAS UTILIZATION CODE.

33 FIREPLACE VENTING (9.32.3)


DIRECT VENT GAS FIREPLACE VENT TO BE A MIN. 12" (305) FROM ANY OPENING AND ABOVE FIN. GRADE. REFER TO GAS UTILIZATION CODE.

34 FLOOR FRAMING (9.23.8.4, 9.23.9.4, 9.23.14)

T&G SUBFLOOR ON WOOD FLOOR JOISTS. FOR CERAMIC TILE APPLICATION SEE O.B.C. 9.30.6. ALL JOISTS WHERE REQUIRED TO BE BRIDGED WITH 2"x2" (50x89) CROSS BRACING OR SOLID BLOCKING @ 6'-11" (2108) O.C. MAX. ALL JOISTS TO BE STRAPPED WITH 1"x3" (19x64) @ 6'-11" (2108) O.C. UNLESS A PANEL TYPE CEILING FINISH IS APPLIED.

FIRE RATINGS - PARTY WALL TRUSS SPACE (OBC REF. - SB-2.3)		
COMPONENT	FIRE RATING	CODE REFERENCE
5/8" (15.9mm) TYPE X GYPSUM WALL BOARD	40 min.	O.B.C. SB-2.3.4.(2) (TABLE 2.3.4.A)
WOOD TRUSSES	NO RATING ASSIGNED	
5/8" (15.9mm) TYPE X GYPSUM WALL BOARD	40 min.	O.B.C. SB-2.3.4.(2) (TABLE 2.3.4.A)
TOTAL FIRE RATING	80 min.	O.B.C. SB-2.3.4.(1)

FIRE & SOUND RATINGS - PARTY WALL			
WALL TYPE	CODE REFERENCE	RATING	
W1B3	O.B.C. SB-3	54 STC 10 HR FR	

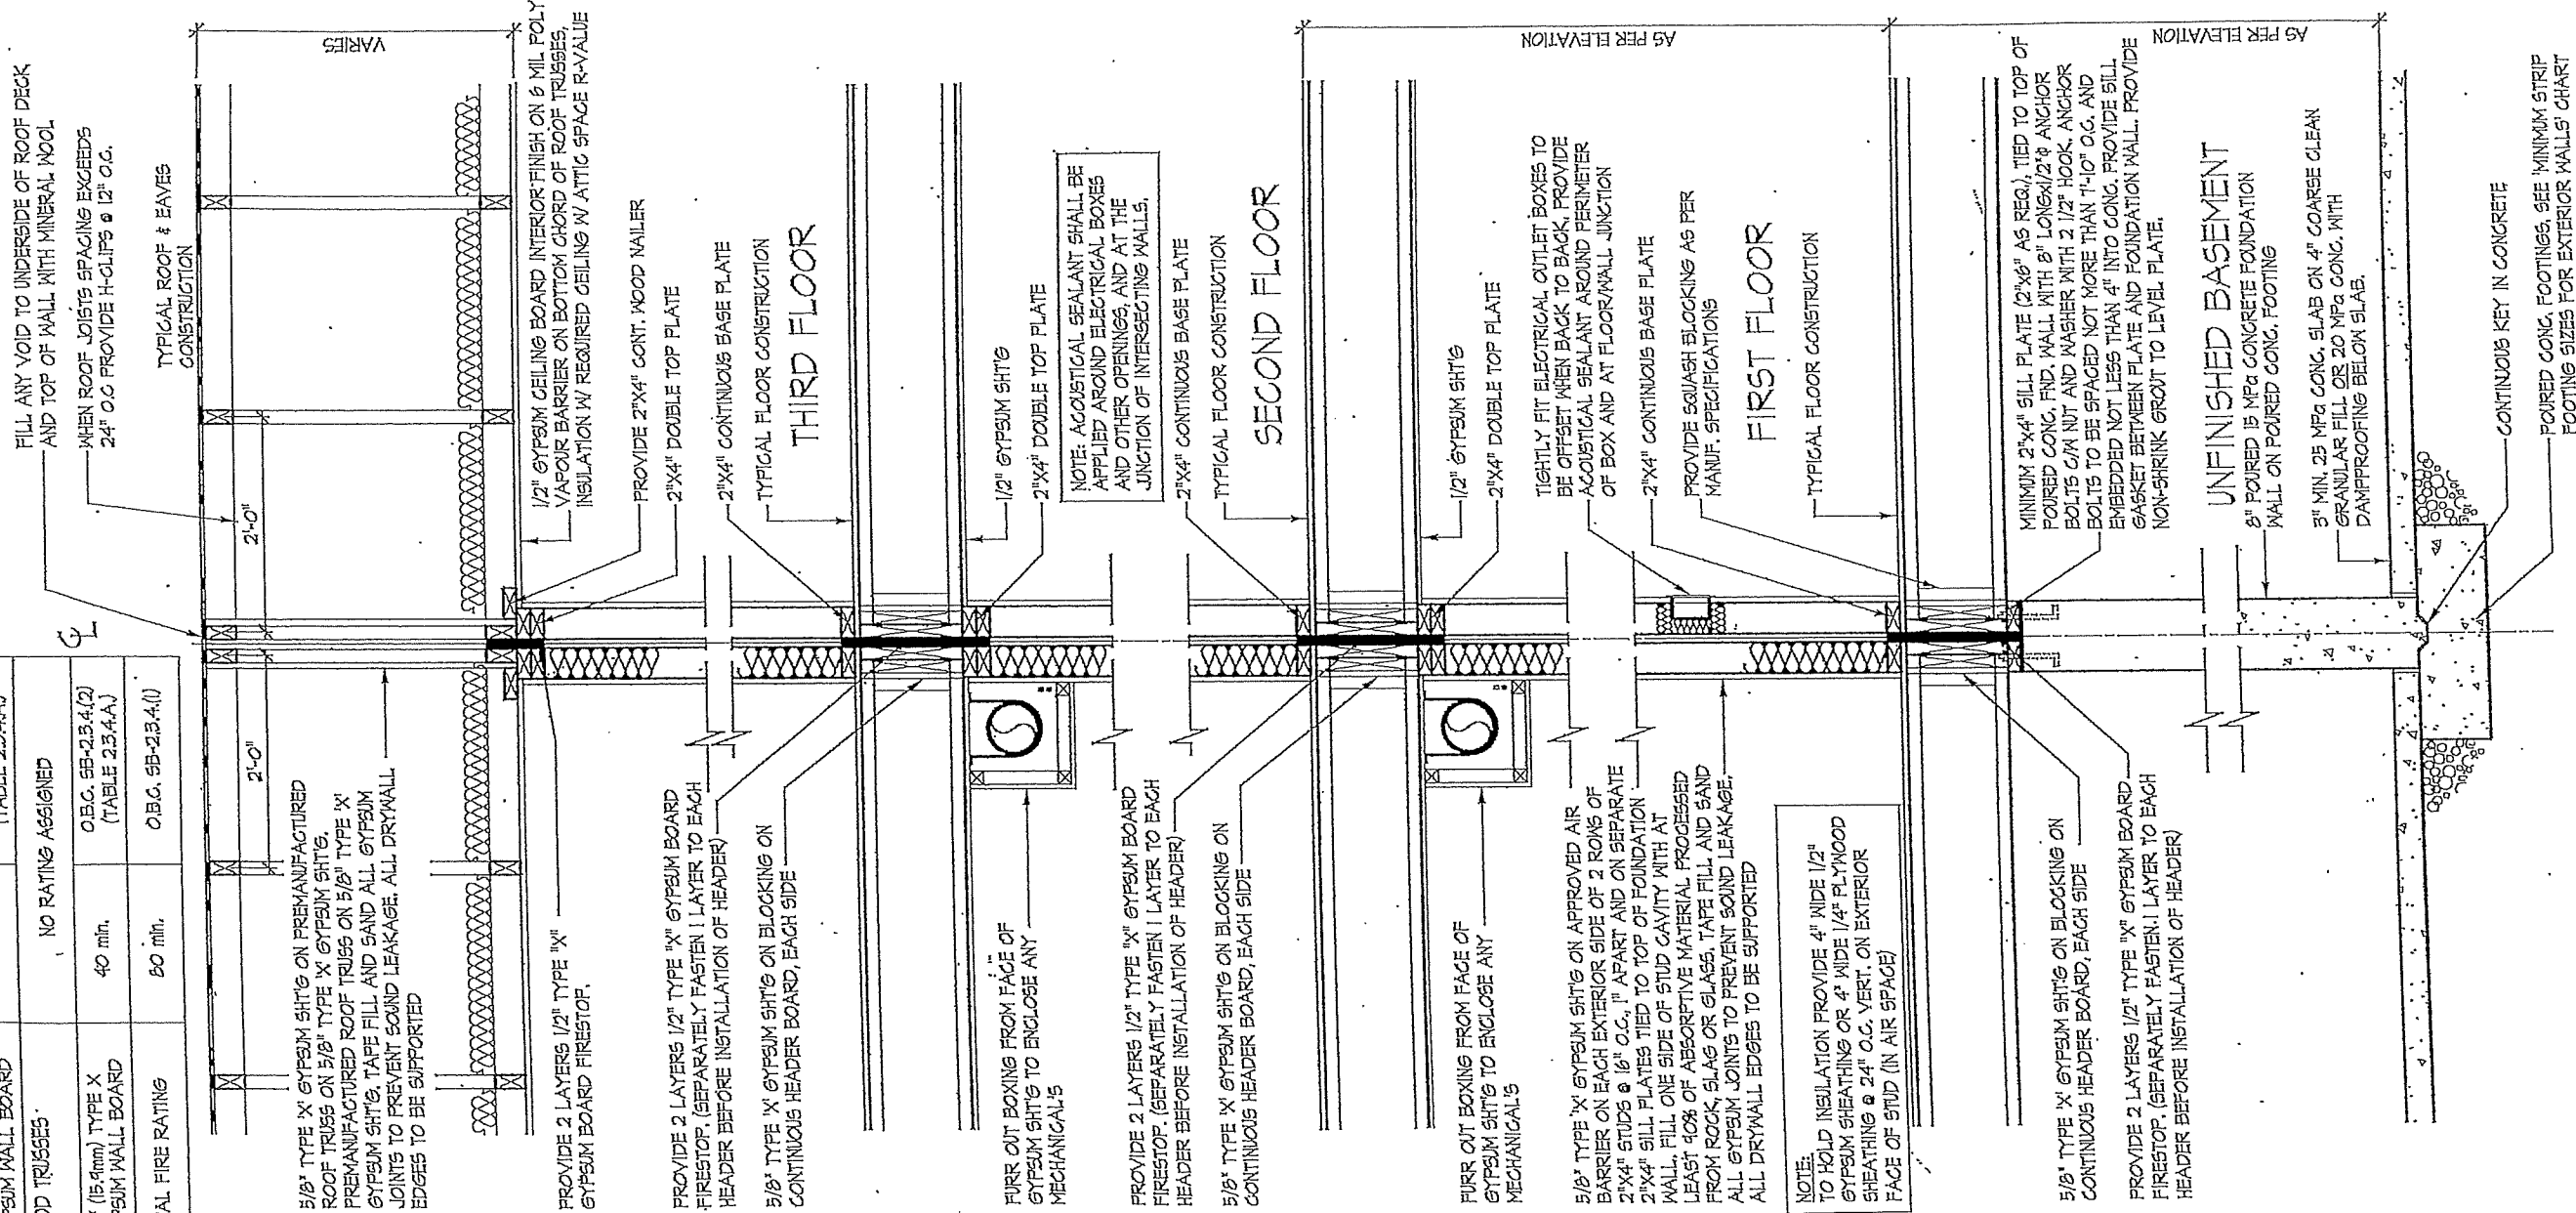

NOTE: POURED CONC. FOOTING ON NATURAL UNDISTURBED SOIL OF 15KPa OR COMPACTED ENGINEERED FILL WITH MIN. BEARING CAPACITY OF 150KPa. FOOTING SIZE SHOWN FOR 16'-0" (4.9m) MAXIMUM JOIST SPAN ONLY. JOIST SPAN EXCEEDING 16'-0" (4.9m) SHALL BE ENGINEERED. IF SOIL BEARING DOES NOT MEET MINIMUM CAPACITY, ENGINEERED FOOTINGS ARE REQUIRED. ACTUAL SOIL BEARING CAPACITY TO BE VERIFIED WITH SOIL ENGINEERING REPORT.

MINIMUM STRIP FOOTING SIZES (K15.3)			
NUMBER FLOORS SUPPORTED	SUPPORTING INT. LOAD BEARING MASONRY WALL	SUPPORTING EXTERIOR PARTY WALL	SUPPORTING PARTY WALL
1	16" W x 8" D	16" W x 8" D	16" W x 8" D
2	24" W x 8" D	20" W x 8" D	24" W x 8" D
3	36" W x 8" D	28" W x 8" D	36" W x 14" D

NOTE: FOOTING SIZE SUBJECT TO CERTIFICATION BY A SOIL CONSULTANT

TYPICAL 1 HR PARTY WALL SECTION, PARALLEL ROOF TRUSSES, 2"x4" DOUBLE STUDS - 3 STOREY

SB-12 E

PRESCRIPTIVE CON

PARTY WALL

BUILDING COMPO

CEILING W/ ATTIC

CEILING W/O ATTIC

EXPOSED FLOOR

WALLS ABOVE GRA

BASEMENT WALLS

* PROPOSED WALL

BELOW GRADE SL

EDGE OF BELOW C

HEATED SLAB OR

WINDOWS/SLIDING

SKYLIGHTS (MAX. I

SPACE HEATING E

HRV EFFICIENCY (%)

DHW HEATER (EF)

AREA CALCULATION

GROUND FLOOR AREA

MAIN FLOOR AREA

THIRD FLOOR AREA

SUBTOTAL

DEDUCT ALL OPEN AREA

TOTAL NET AREA

COVERAGE W/OUT PORCH

COVERAGE W/ PORCH

WINDOW / WALL AREA CALCULATIONS


GROSS WALL AREA

GROSS WINDOW AREA (INCL. GLASS DOORS & SKYLIGHTS)

TOTAL WINDOW %

10 DEL BSM +
209 END

2009 END UNIT . BSM +

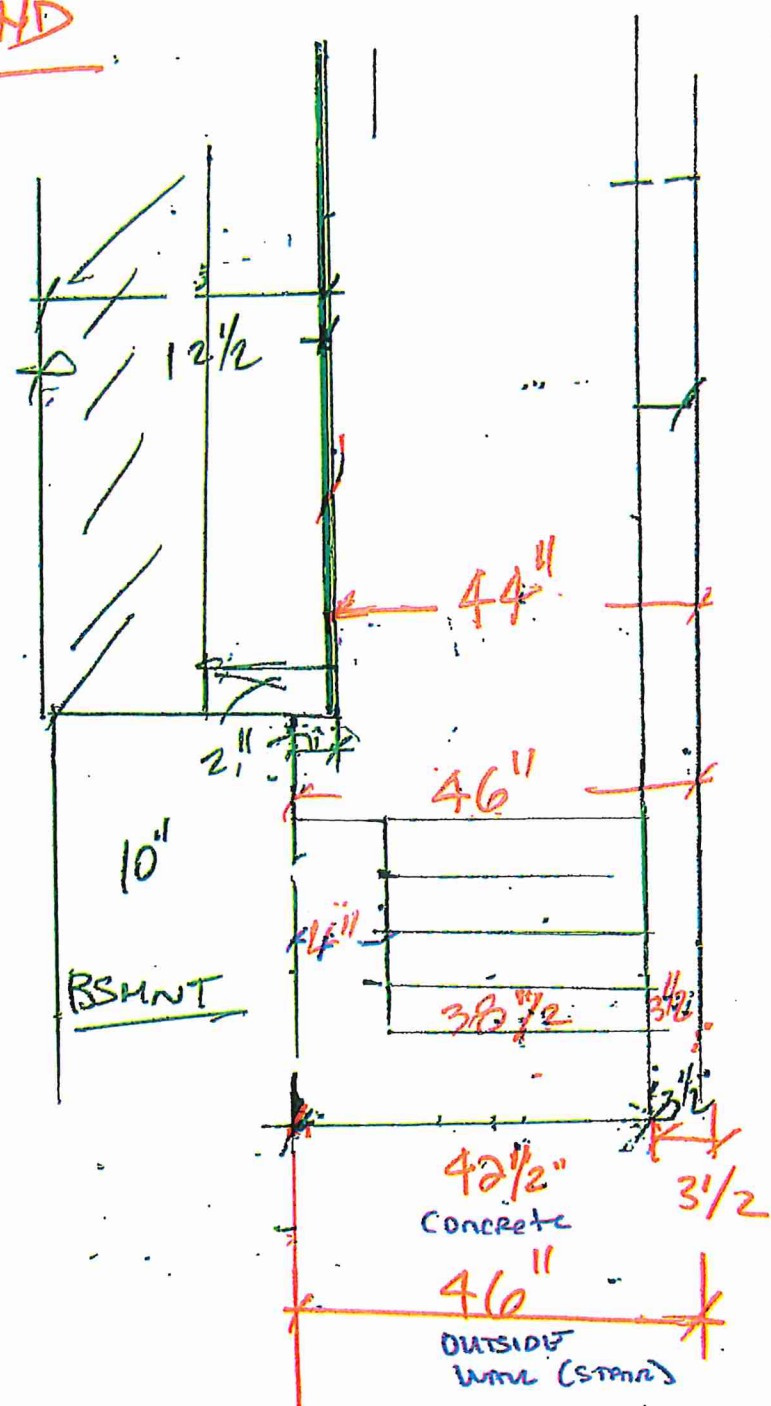

BK 235-72