
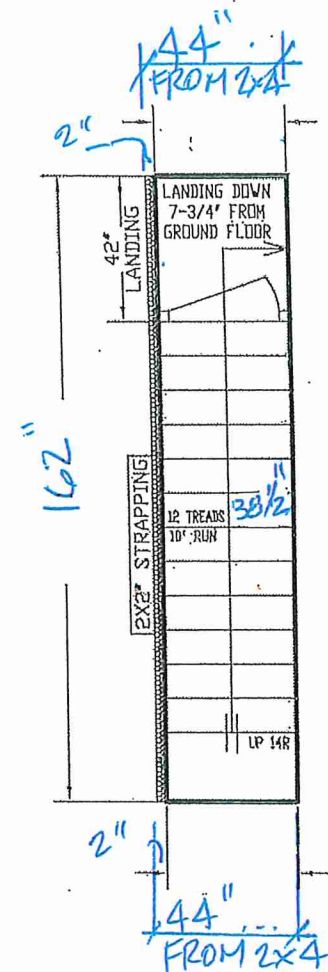


BASEMENT TO GROUND
BSMT 11-7/8" JOIST

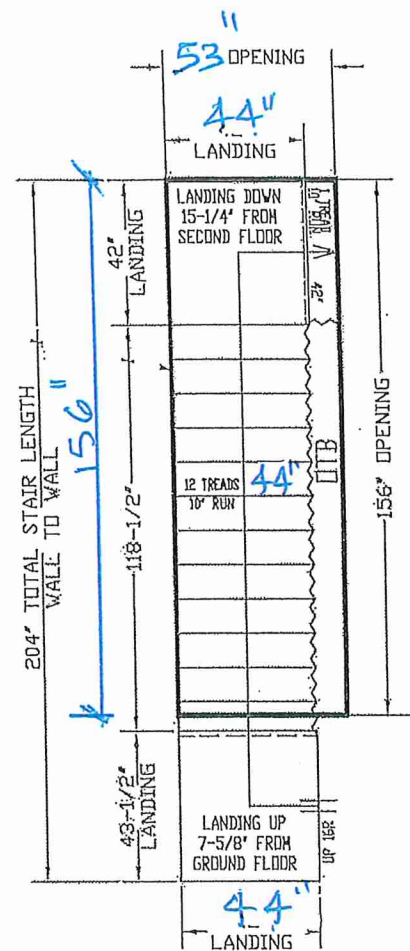 


STAIRS LINE UP BY
PARTY WALL

ALL OPENINGS ARE ALLOWED
FOR 1 LAYER OF DRY WALL
ANY ADDITIONAL LAYERS MUST
BE ALLOWED BY CARPENTERS

NO WALLS UNTIL
STAIRS INSTALLED


GARAGE RIGHT >

 ALPHA STAIRS AND RAILINGS INC. Quality To Step Up To	ALL LOADINGS TO BE SUPPLIED AND SUPPORTED BY OTHERS UNLESS SPECIFIED ABOVE ANY STRAPPING, ALLOWANCES TO BE EXPRESSED BY CARPENTERS ALL STAIR DIMENSIONS MAY BE MODIFIED FROM ORIGINAL. TO BE SUPPLIED TO ALPHA STAIRS AND RAILINGS INC. NEAREST COST SHOWN ON LOADINGS ARE REQUIRED TO INSTALL THE STAIRS. ANY PROBLEM WITH HANDRAIL OR STRAPPING ALLOWANCES, ALPHA STAIRS AND RAILINGS INC. WILL BE RESPONSIBLE. ST. CANTILEVER SHALL BE CHECKED BY CARPENTERS OR SITE SUPERS TO MAKE SURE THERE ARE NO DISCREPANCIES BEFORE PROCEEDING WITH CONSTRUCTION. ALPHA STAIRS AND RAILINGS INC. 3770 NASHUA DRIVE, UNIT 3 MISSISSAUGA, ONTARIO L4V 1M6 TEL: (905) 694-9556 www.alpastor's.com			SITE CENTREFIELD	NAME PARAMJEET	DATE APRIL 9, 2025
	LOT # Model 20-9 STD W/UNFIN. BSMT	CLIENT ROYAL PINE HOMES		LAYOUT # SCALE 1/32		


UNIT
79

Product 2nd
Ext wgn

PORTAL

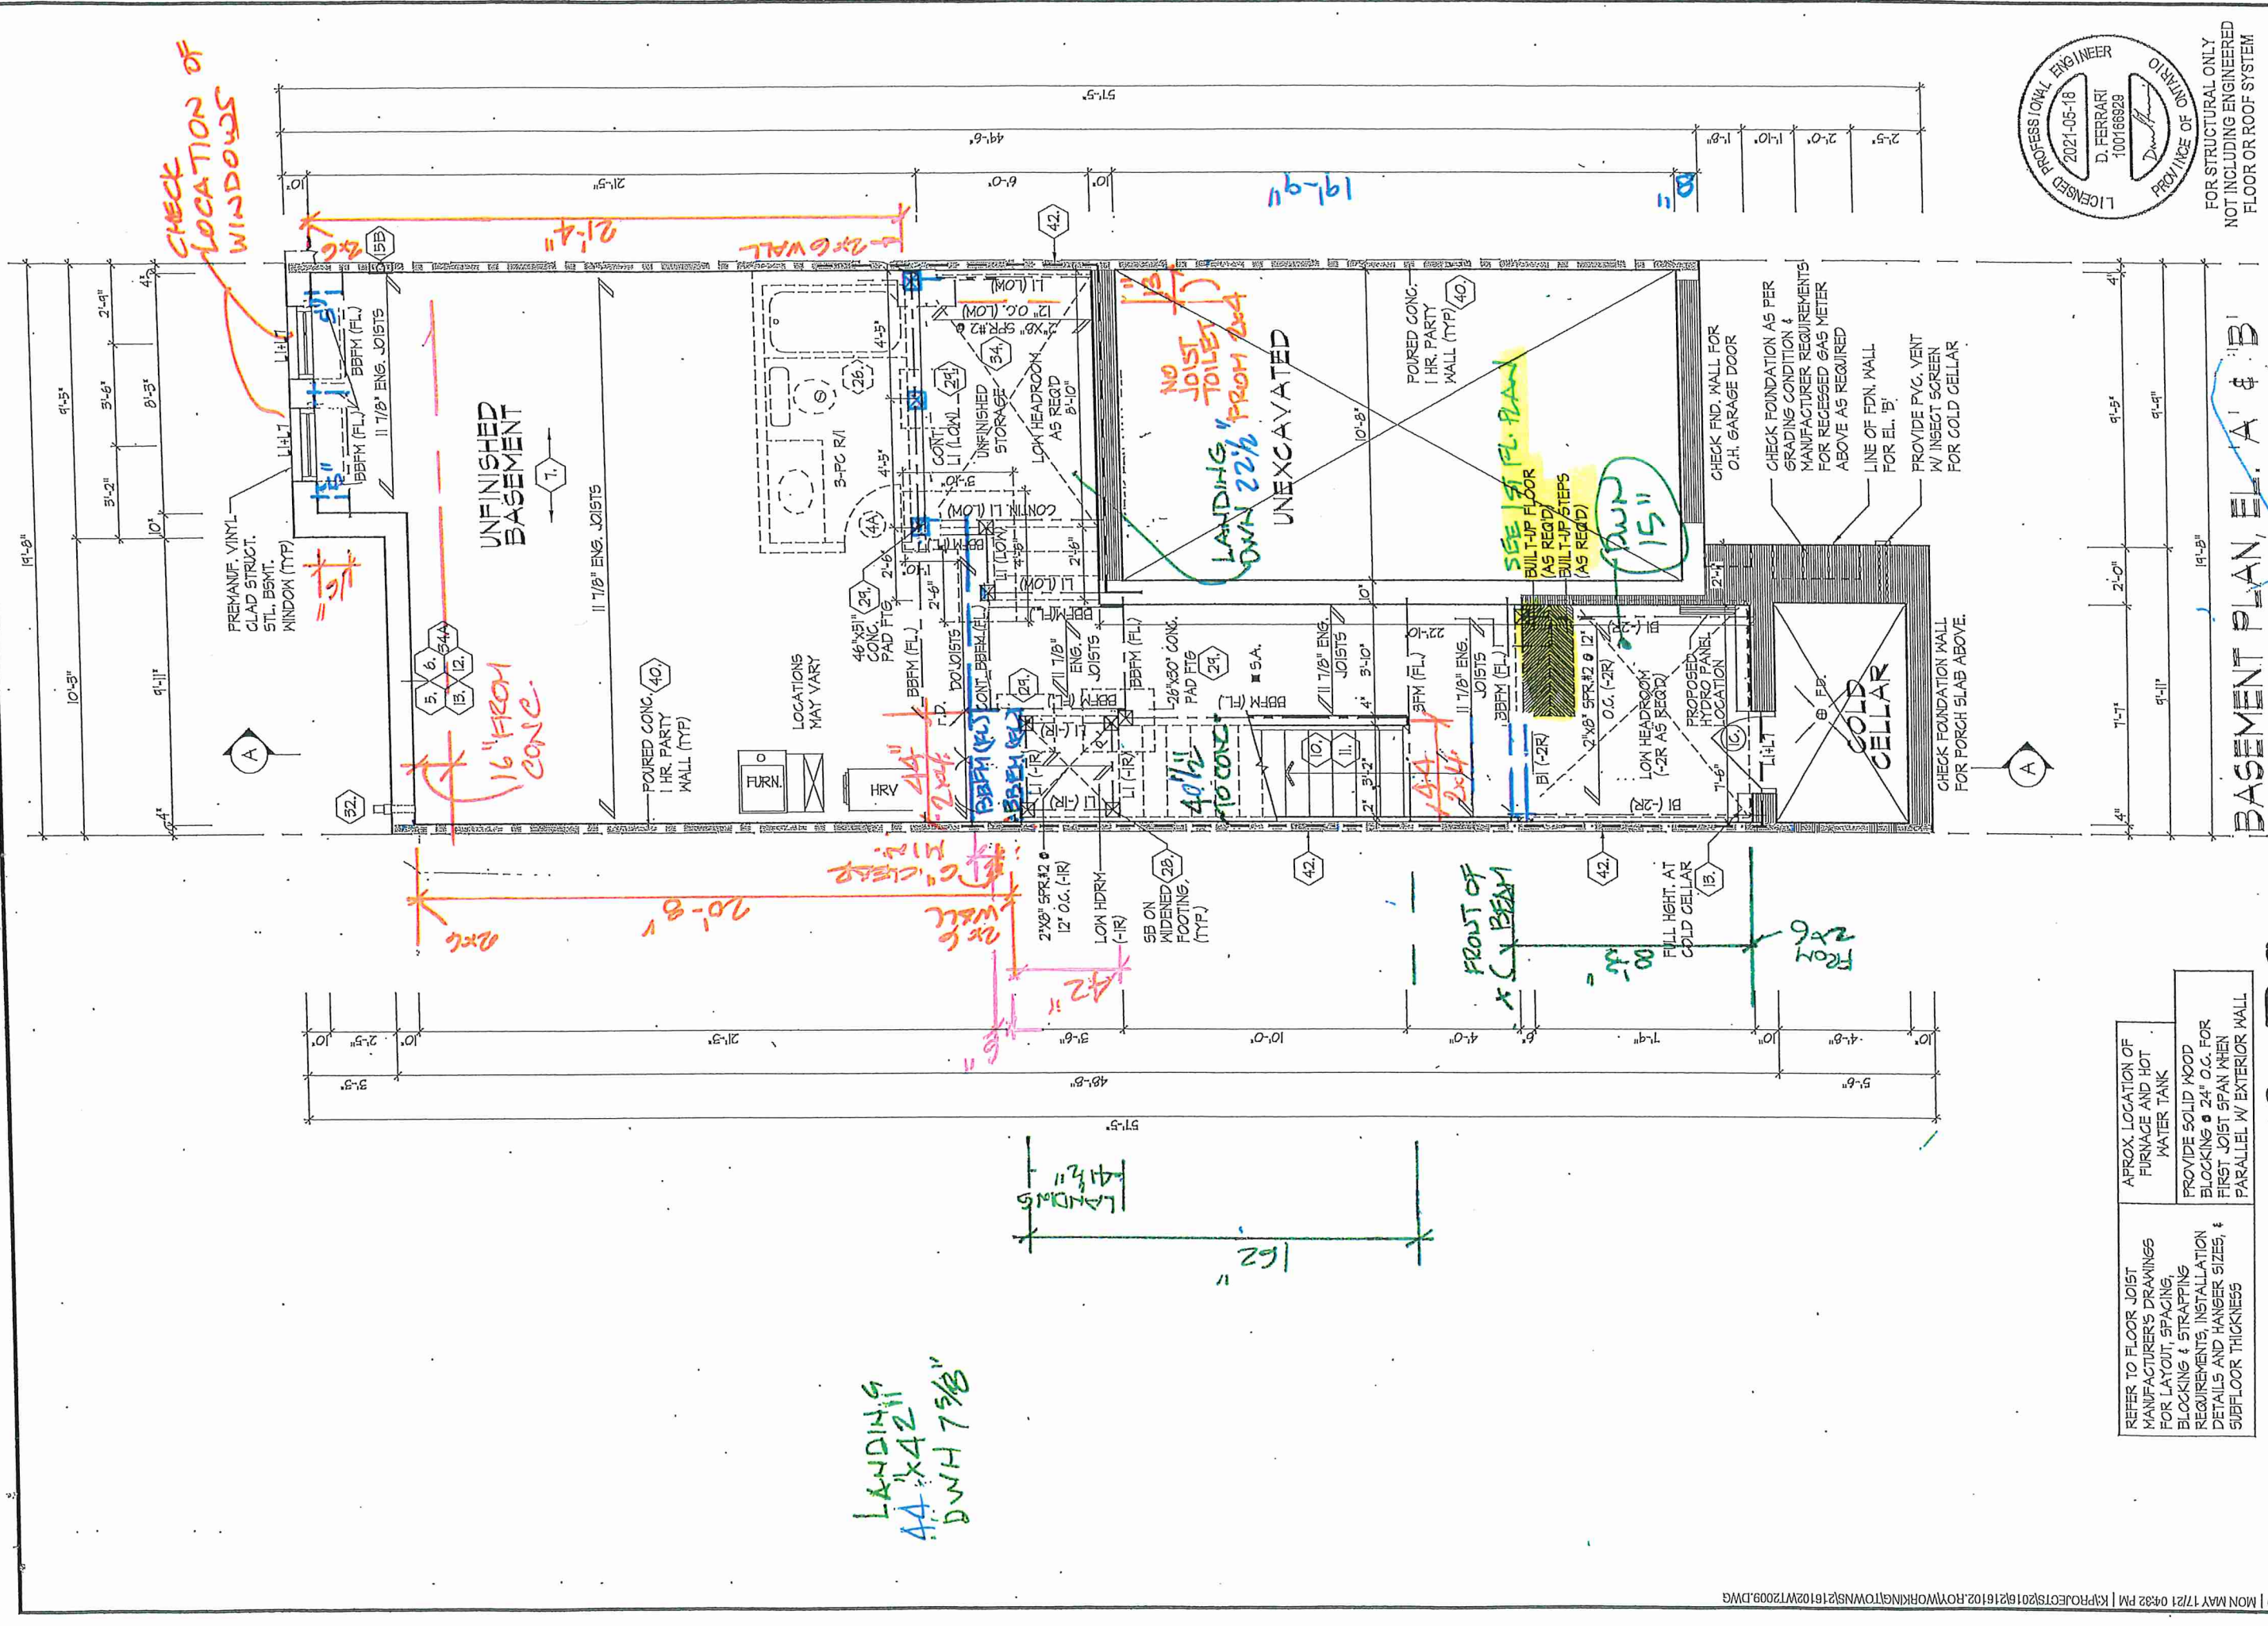

REFER TO FLOOR JOIST MANUFACTURER'S DRAWINGS FOR LAYOUT, SPACING, BLOCKING & STRAPPING REQUIREMENTS. INSTALLATION DETAILS AND HANGER SIZES, & SUBFLOOR THICKNESS	APPROX. LOCATION OF FURNACE AND HOT WATER TANK
PROVIDE SOLID WOOD BLOCKING @ 24\"	

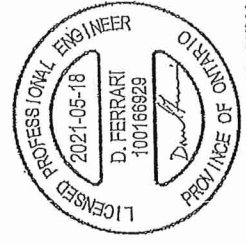

FOR STRUCTURAL ONLY
NOT INCLUDING ENGINEERED
FLOOR OR ROOF SYSTEM

BASEMENT PLAN, ELEV. 'A' & 'B'

BASEMENT PLAN, ELEV. 'A' & 'B'

UNIT 2009

Landing
4'4" x 4'3 1/2"
UP 7 1/2'

MASONRY WALL

- SOLID MASONRY WALL W/ 10'-10M VERT. REBARS (LAP 1'-6") GROUDED INTO BRICK JOINT)
- 2"x6" SILL PLATE • TOP ANCHORED TO SOLID MASONRY WALL W/ 1/2" x 12" BOLTS • 24" O.C. STAGGERED
- MASONRY VENEER TIED TO MASONRY VENEER WITH GALV. METAL TIES • 16" O.C. AND 24" VERTICAL FILL VOID BETWEEN MASONRY VENEER AT THES SOLID W/ MORTAR

* 2"x4" STUD WALL ASSEMBLY EXCEEDING MAX. UNSUPPORTED HEIGHT:
FOR WALLS GREATER THAN 9'-10" TO MAX. 12'-0" HIGH,
- W/O FLOOR LOAD, DOUBLE UP EVERY STUD @ 16" O.C.
- W/ FLOOR LOAD, DOUBLE UP EVERY STUD @ 12" O.C.
PROVIDE BLOCKING EVERY 4'-0" O.C. VERTICAL.

REFER TO FLOOR JOIST MANUFACTURER'S DRAWINGS FOR LAYOUT, SPACING, BLOCKING & STRAPPING REQUIREMENTS, INSTALLATION DETAILS AND HANGER SIZES, & SUBFLOOR THICKNESS

ALL DOORS ON PLAN ARE 1'-10" HIGH TOP OF FRAME, UNLESS LABELED OTHERWISE.
PROVIDE SOLID WOOD BLOCKING @ 24" O.C. FOR FIRST JOIST SPAN WHEN PARALLEL W/ EXTERIOR WALL

GROUND FLOOR PLAN, EL. B'

PREPARED BY
D. FERRARI
100166929
LICENSED PROFESSIONAL ENGINEER
2021-05-18
OFFICE OF THE
STATE ENGINEER

NOT INCLUDING ENGINEERED FLOOR OR ROOF SYSTEM

SOLID MASONRY WALL W/ 10'-0" H VERT. REBARS (LAP 1'-6" GROUTED INTO BRICK JOINT)	2"x8" SILL PLATE @ TOP ANCHORED TO SOLID MASONRY WALL W/ 1/2"Ø x 12" BOLTS @ 24" O.C. STAGGERED	MASONRY VENEER TIED TO MASONRY VENEER WITH GALV. METAL TIES @ 16" O.C. AND 24" VERTICAL. FILL VOID BETWEEN MASONRY VENEER WITHES SOLID W/ MORTAR
SOLID MASONRY WALL W/ 10'-0" H VERT. REBARS (LAP 1'-6" GROUTED INTO BRICK JOINT)	2"x8" SILL PLATE @ TOP ANCHORED TO SOLID MASONRY WALL W/ 1/2"Ø x 12" BOLTS @ 24" O.C. STAGGERED	MASONRY VENEER TIED TO MASONRY VENEER WITH GALV. METAL TIES @ 16" O.C. AND 24" VERTICAL. FILL VOID BETWEEN MASONRY VENEER WITHES SOLID W/ MORTAR
FOR STRUCTURAL ONLY
NOT INCLUDING ENGINEERED
FLOOR OR ROOF SYSTEM

GROUND FLOOR PLAN

GROUND FLOOR PLAN, EL. 'B'


ROYAL PINE HOMES - 216102
'CENTREFIELD', WEST GORMLEY, RICHMOND HILL, ON. REV.2021.05.11
Draw Number: UNIT 2009

HUNT
DESIGN ASSOCIATES INC.
www.hunt-design.com

THE UNDERSIGNED HAS REVIEWED AND TAKES RESPONSIBILITY FOR THIS DESIGN AND HAS THE QUALIFICATION AND MEETS THE REQUIREMENTS SET OUT IN THE ONTARIO BUILDING CODE TO BE A DESIGNER.

QUALIFICATION INFORMATION
Derek R. Santos
NAME
SIGNATURE
REGISTRATION INFORMATION
HUNT DESIGN ASSOCIATES INC.
3730
BC
1963

All drawings, specifications, related documents and design are the copyright property of Hunt Design Associates (H.D.A.). Reproduction of this property in whole or in part is strictly prohibited without H.D.A.'s written permission. H.D.A. assumes no responsibility or liability for this property unless it bears the appropriate Hunt number and original signature.

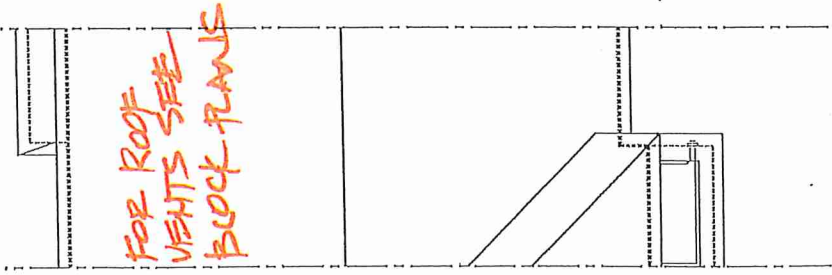


FOR ROOF VENTS SEE BLOCK PLANS

ROOF PLAN
EL. 'B'
N.T.S.


LANDING: 44'x42"
DOWN 1 1/4"

DOORS 83"
WINDOWS SEE ELEV.

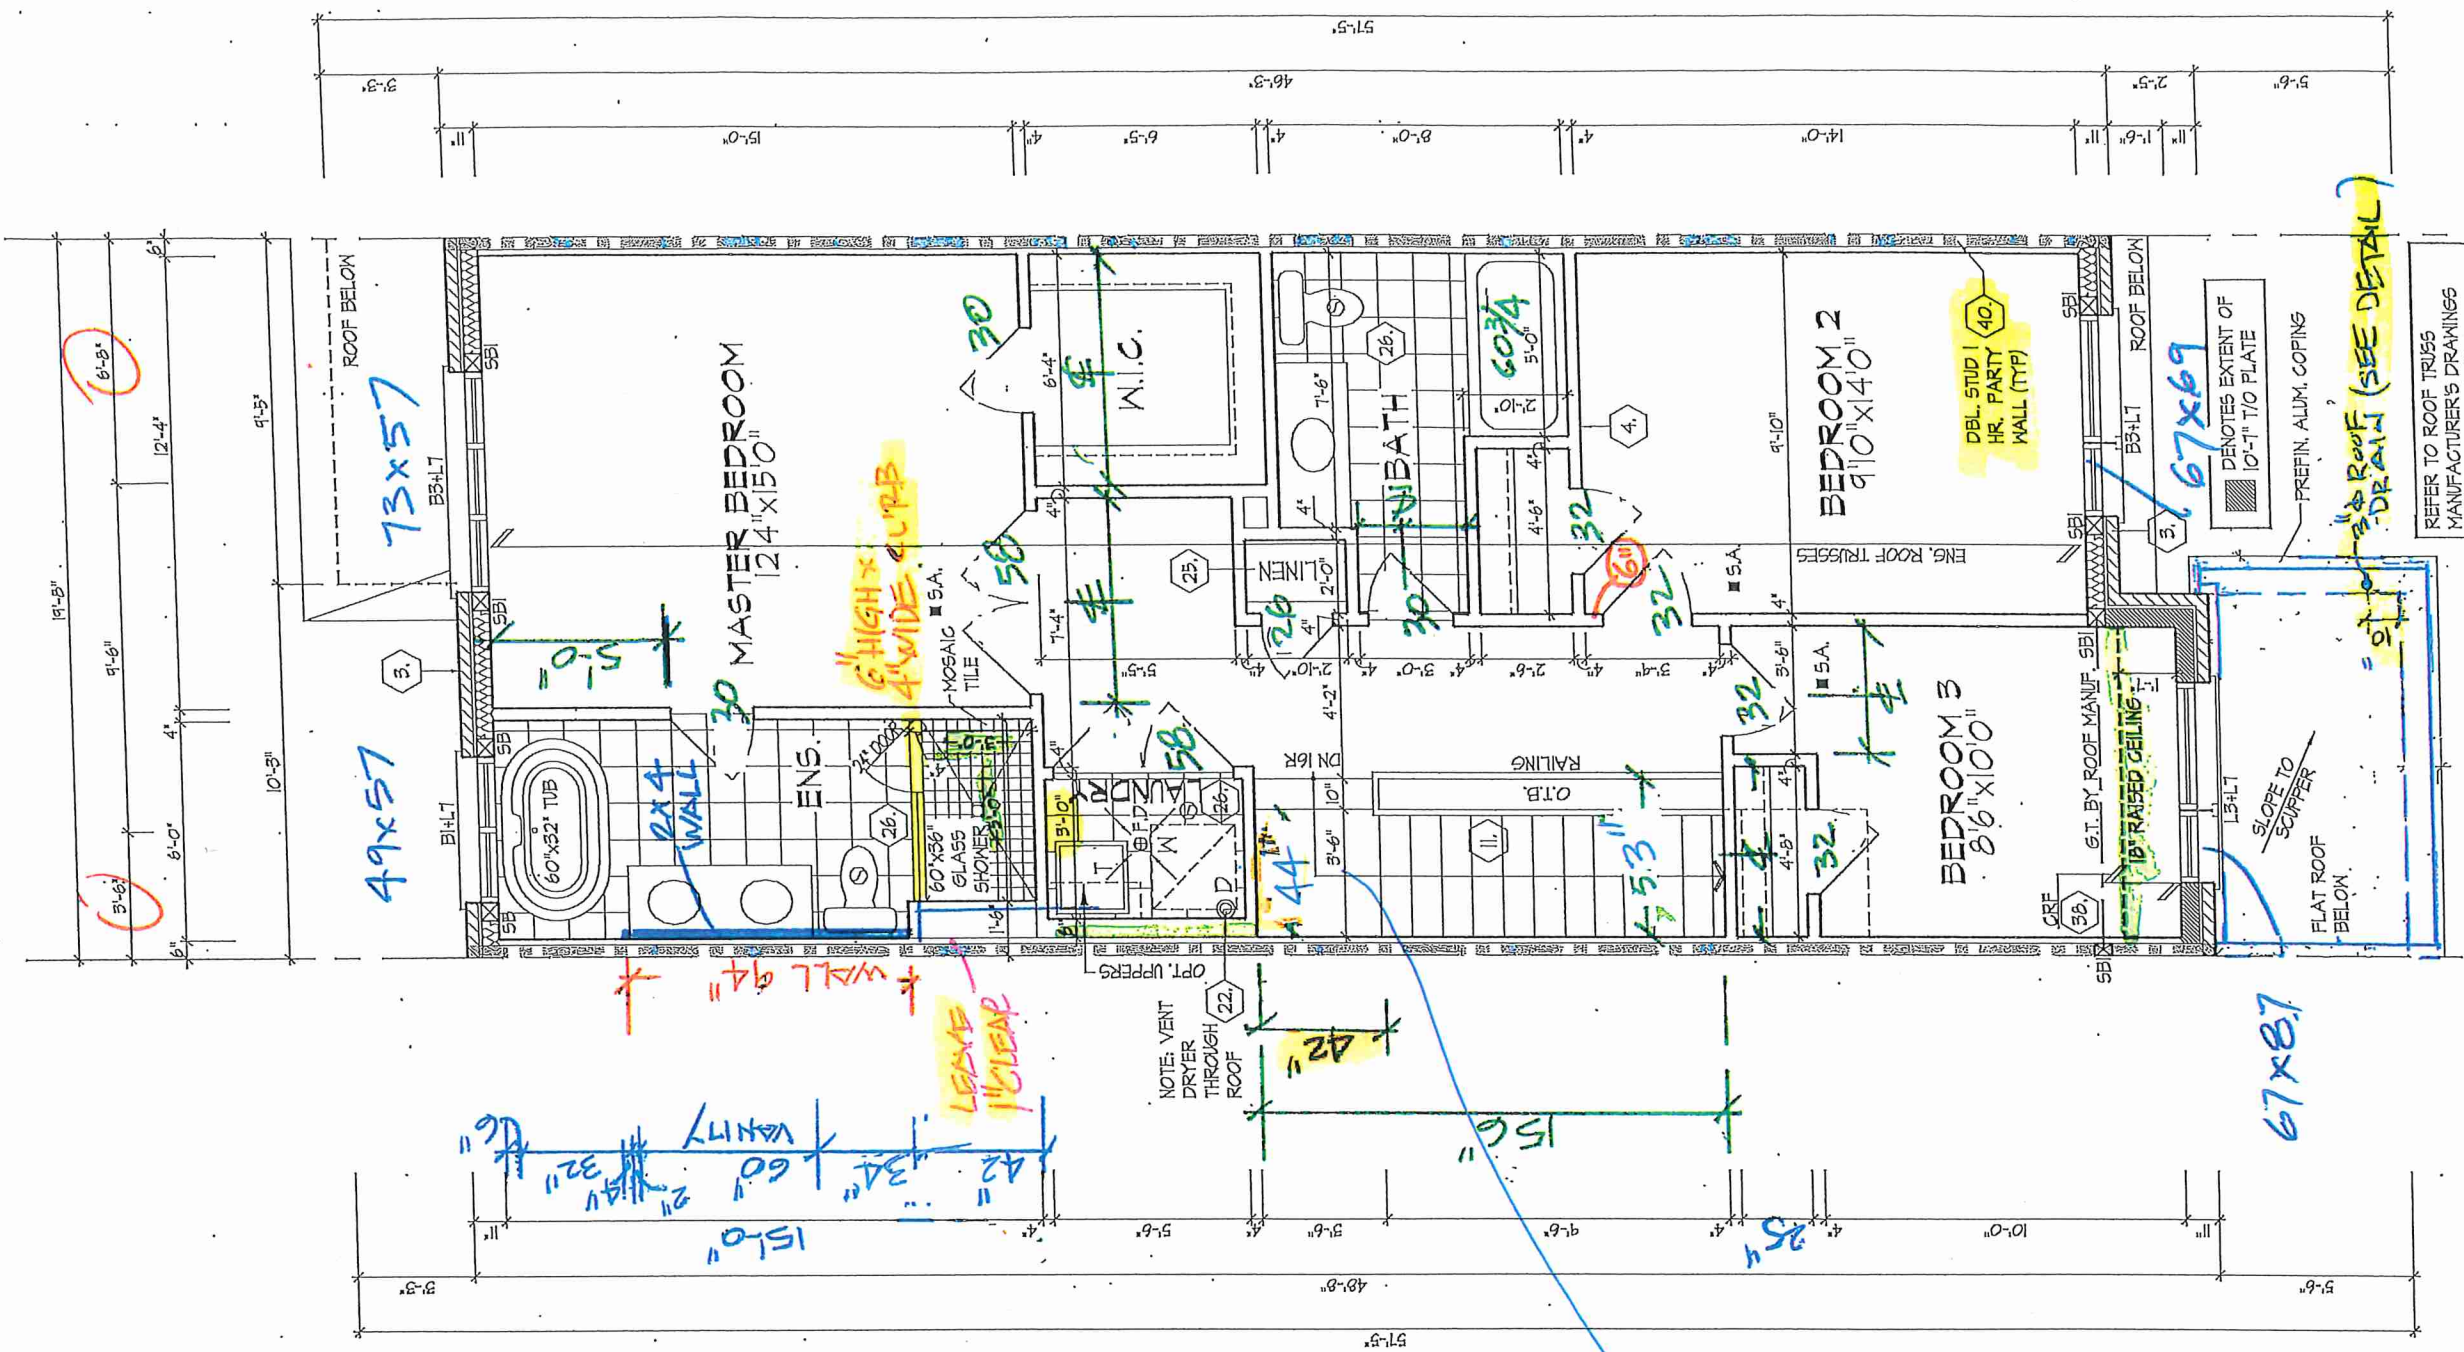

BLK 242-79

OPT. SECOND FLOOR
PLAN EL. 'B'

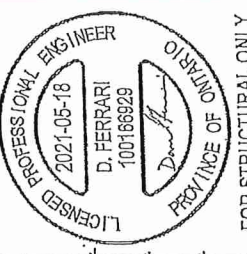

FOR STRUCTURAL ONLY
NOT INCLUDING ENGINEERED
FLOOR OR ROOF SYSTEM


SECOND FLOOR PLAN, EL. 'B'

ROYAL PINE HOMES - 216102
'CENTREFIELD', WEST GORMLEY, RICHMOND HILL, ON. REV. 2021.05.11




DESIGN ASSOCIATES INC.
www.huntassociates.ca
37308
19695

Drawn By: KM
Checked By: DS
Scale: 3/16" = 1'-0"
File Number: 216102WT2009
Page Number: 7 of 14

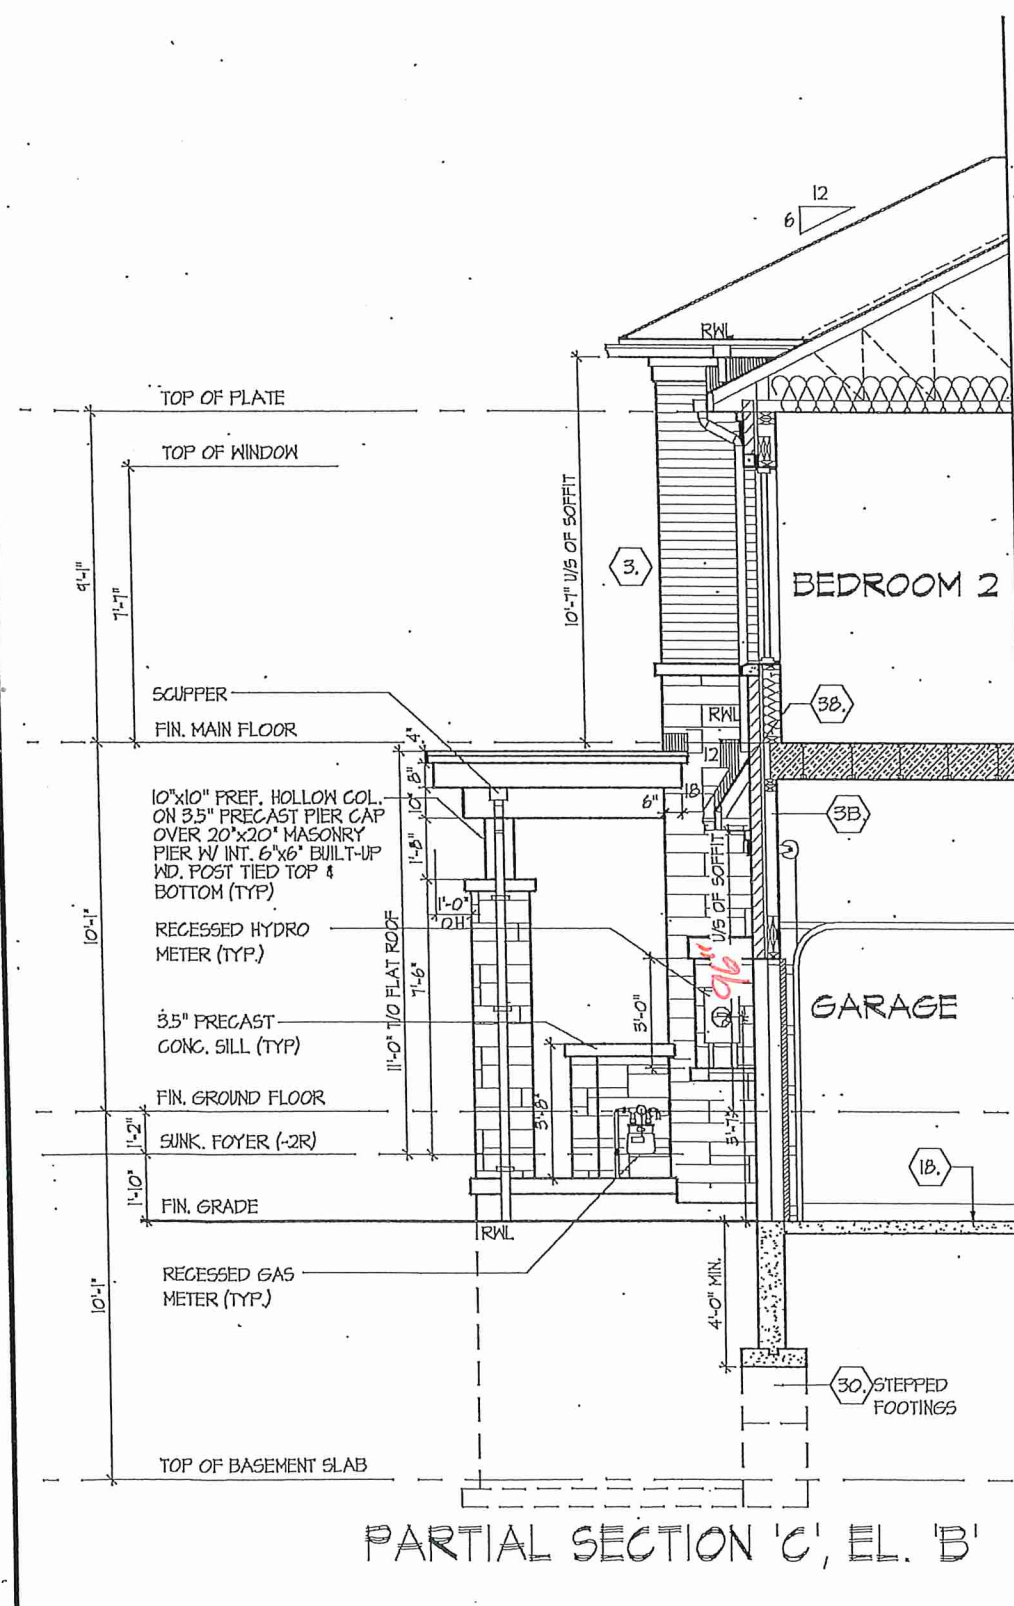

PARTIAL SECTION 'C', EL. 'B'

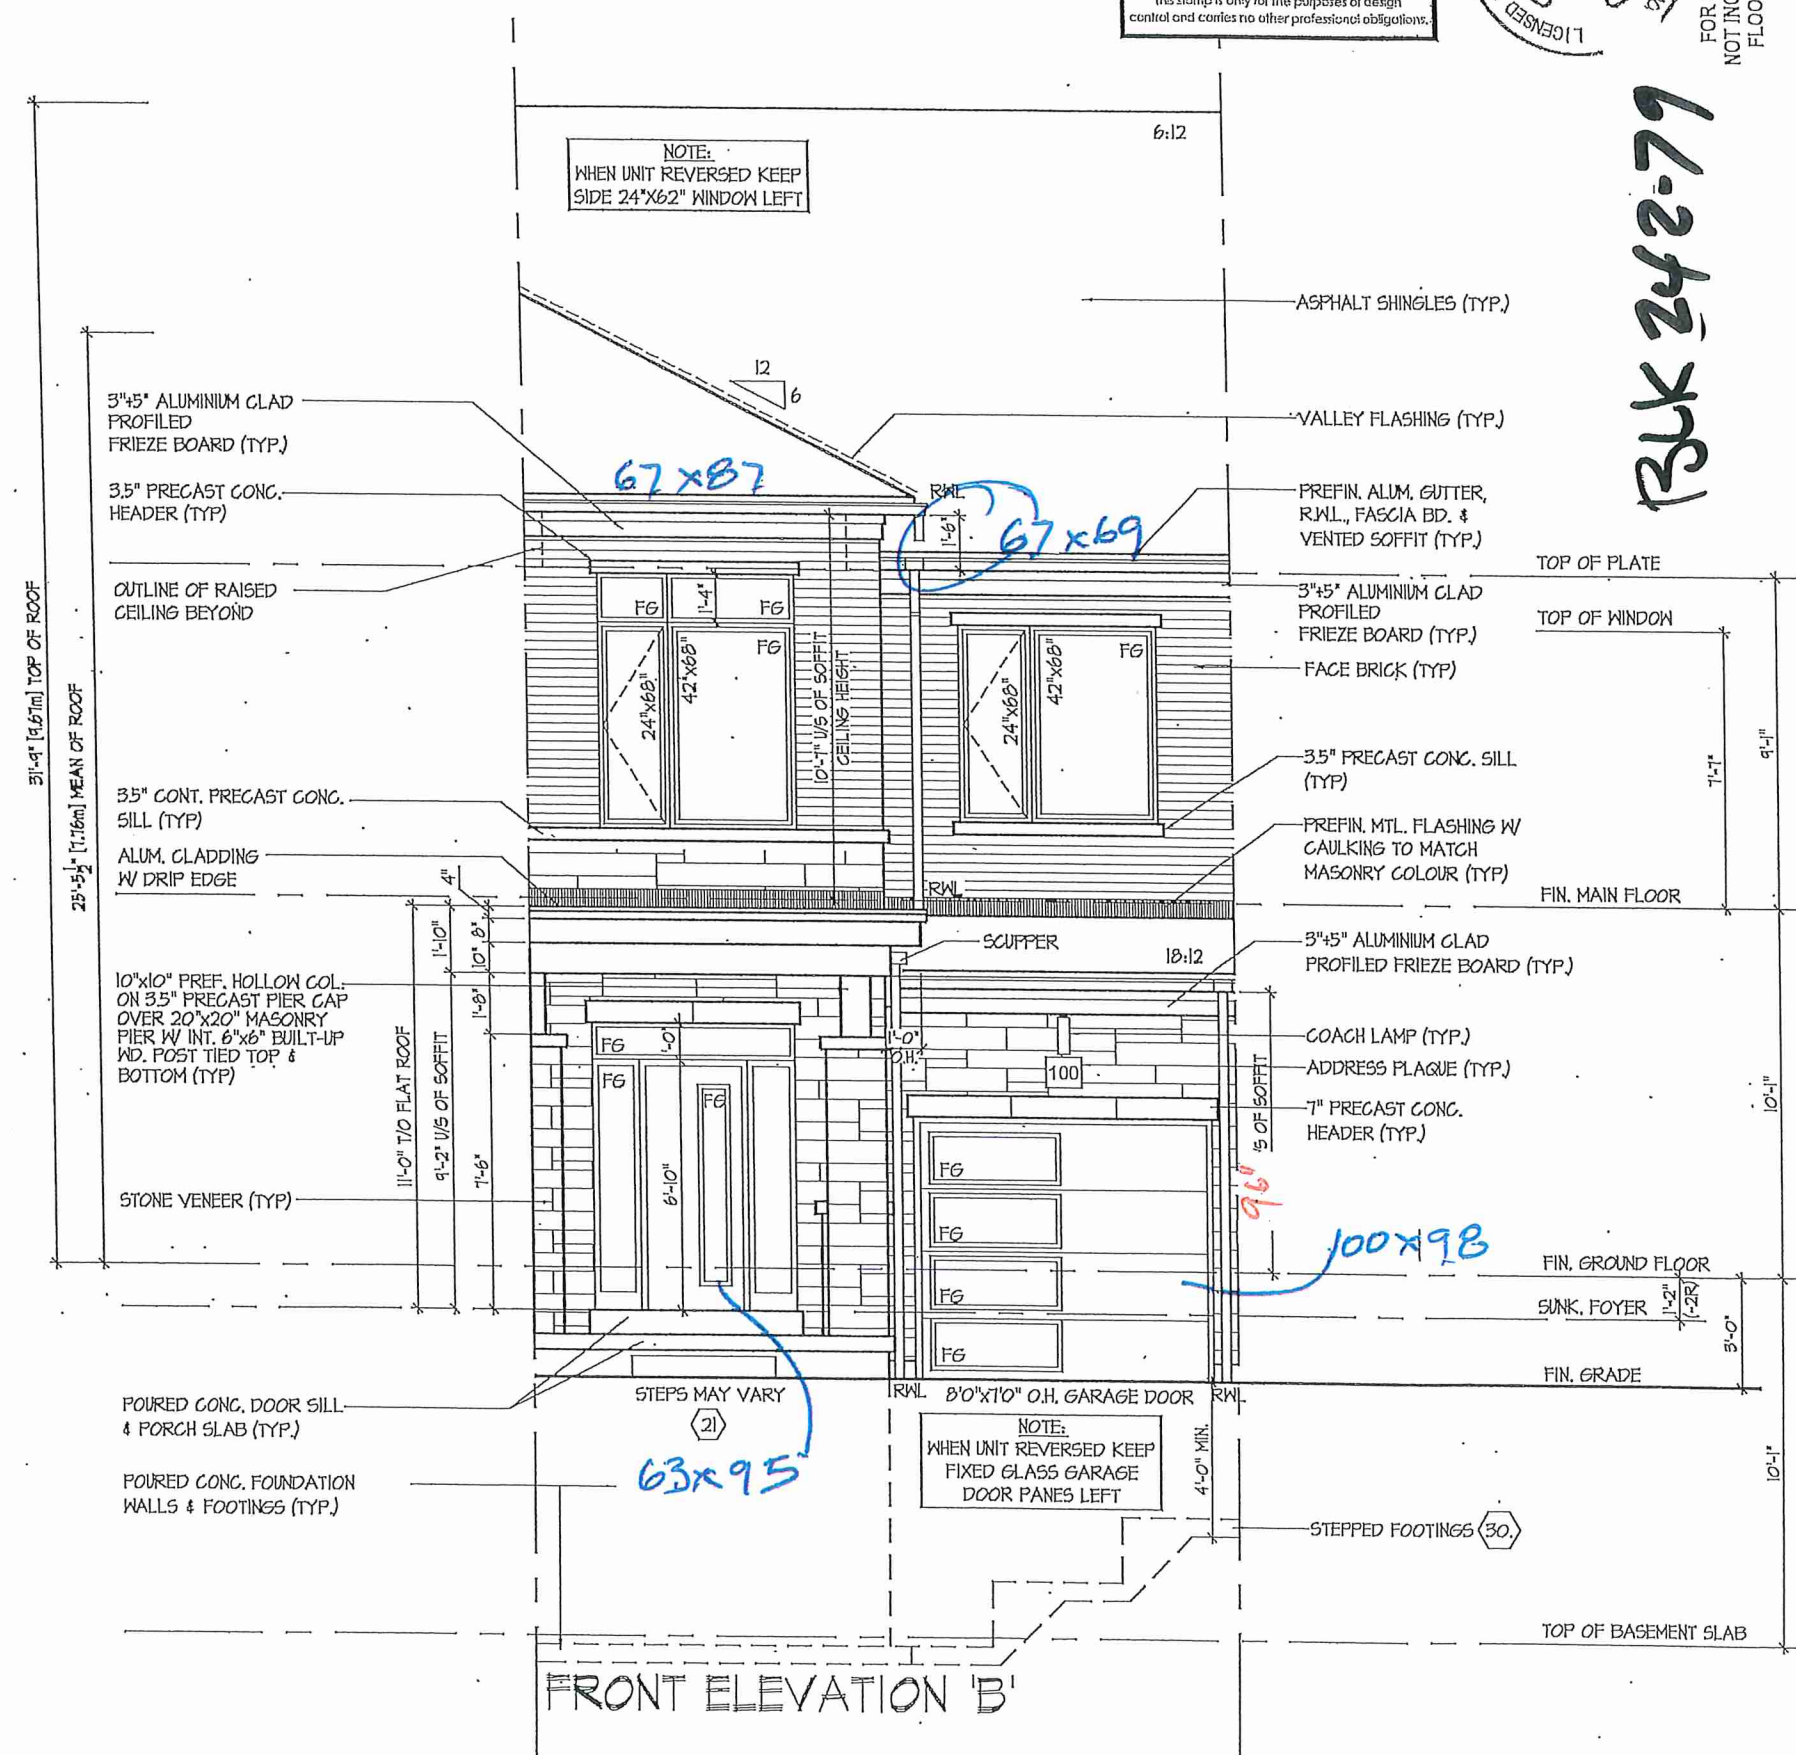


FRONT ELEVATION 'B'

GARAGE ROOF
18'0.11 + 18/12 PITCH


W Architect Inc.
DESIGN CONTROL REVIEW
MAY 31, 2021
FINAL BY: *ALL*
This stamp is only for the purposes of design control and carries no other professional obligations.

LICENSED PROFESSIONAL ENGINEER
2021-05-18
D. FERRARI
100166929
DIVISION OF
NOT FOR STRUCTURAL ONLY
NOT INCLUDING ENGINEERED
FLOOR OR ROOF SYSTEM

BLK 242-79

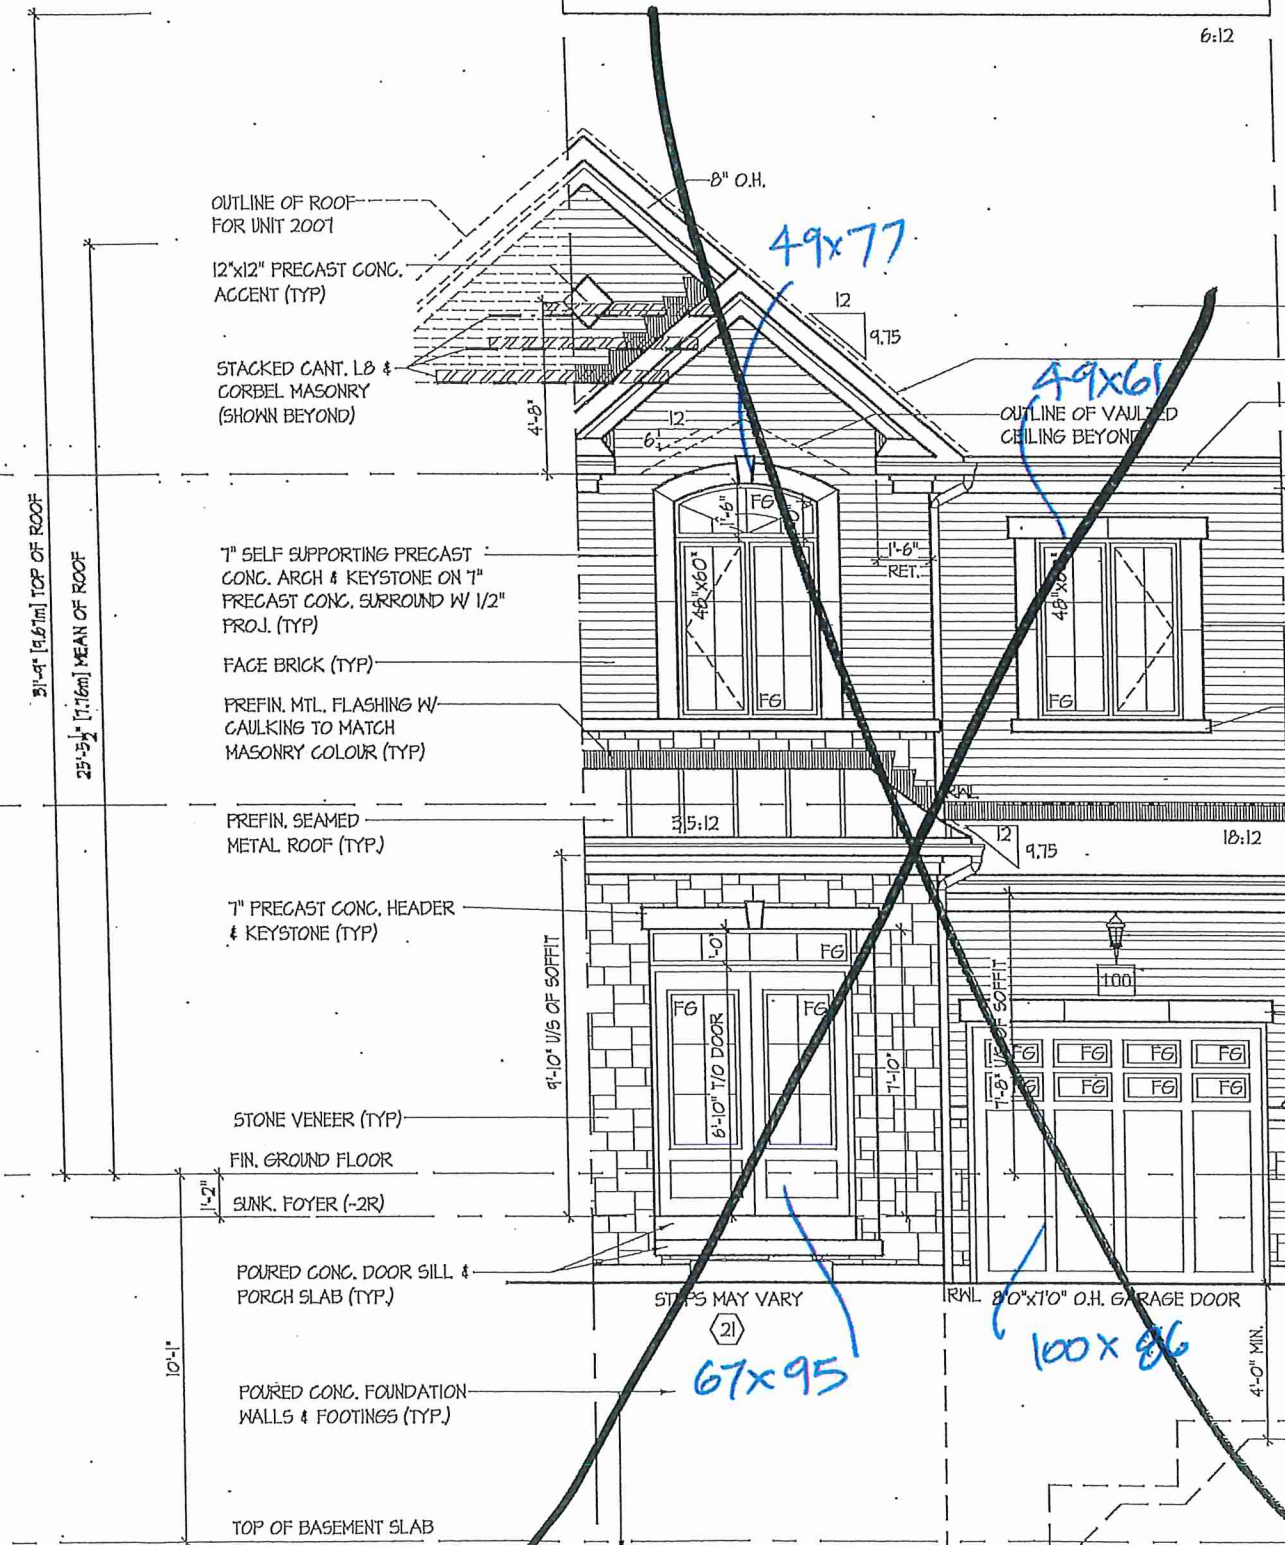

FRONT ELEVATION 'A'

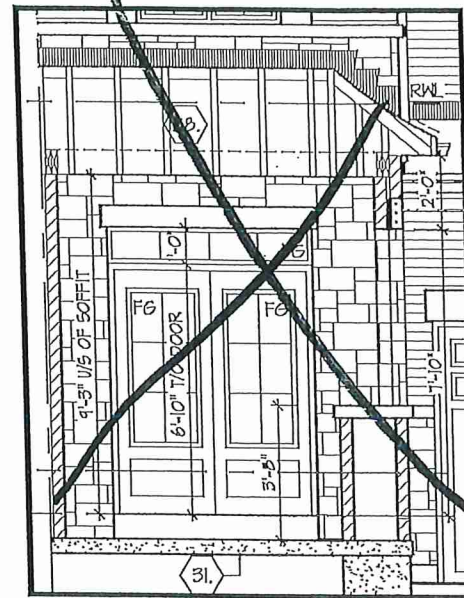


INTERIOR PORCH
SECTION EL. 'A'

ROOF OVERHANGS TO BE 12"
UNLESS NOTED OTHERWISE

W Architect Inc.
DESIGN CONTROL REVIEW
MAY 31, 2021
FINAL BY: *ACE*
This stamp is only for the purposes of design control and carries no other professional obligations.



REAR ELEVATION 'A' & 'B'

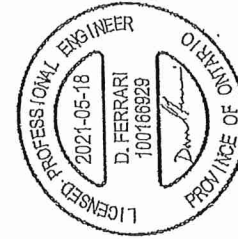

FOR STRUCTURAL ONLY
NOT INCLUDING ENGINEERED
FLOOR OR ROOF SYSTEM

BLK 242-79

FRONT ELEVATION 'A' & REAR ELEV. 'A' & 'B'

UNIT 2009

ROYAL PINE HOMES - 216102



'CENTREFIELD', WEST GORMLEY, RICHMOND HILL, ON. REV. 2021.05.11

HUNT
DESIGN ASSOCIATES INC.
www.hunt-design.ca

THE UNDERSIGNED HAS REVIEWED AND TAKES RESPONSIBILITY FOR THIS
DESIGN AND CHARTER REQUIREMENTS AND MEETS THE REQUIREMENTS SET
OUT IN THE HUNT DESIGN ASSOCIATES INC. DESIGN CHARTER.
QUALIFICATION INFORMATION
NAME: Derek R. Santos
REGISTRATION INFORMATION
BOB: 37308
SIGNATURE: *[Signature]*
HUNT DESIGN ASSOCIATES INC.
19995

Drawn By: KM
Checked By: DS
Scale: 3/16"=1'-0"
File Number: 216102WT2009
Page Number: 8 of 14

8866 Woodbine Ave, Markham, ON L3R 0J7 T 905.737.5133 F 905.737.7926
All drawings specifications related documents and design are the copyright property of Hunt Design Associates (H.D.A.). Reproduction of this property in whole or in part is strictly prohibited without H.D.A.'s written permission (H.D.A. assumes no responsibility or liability for this property unless it bears the appropriate SON number and original signature.)

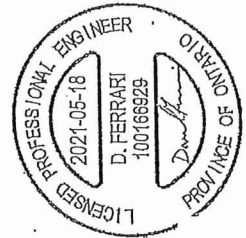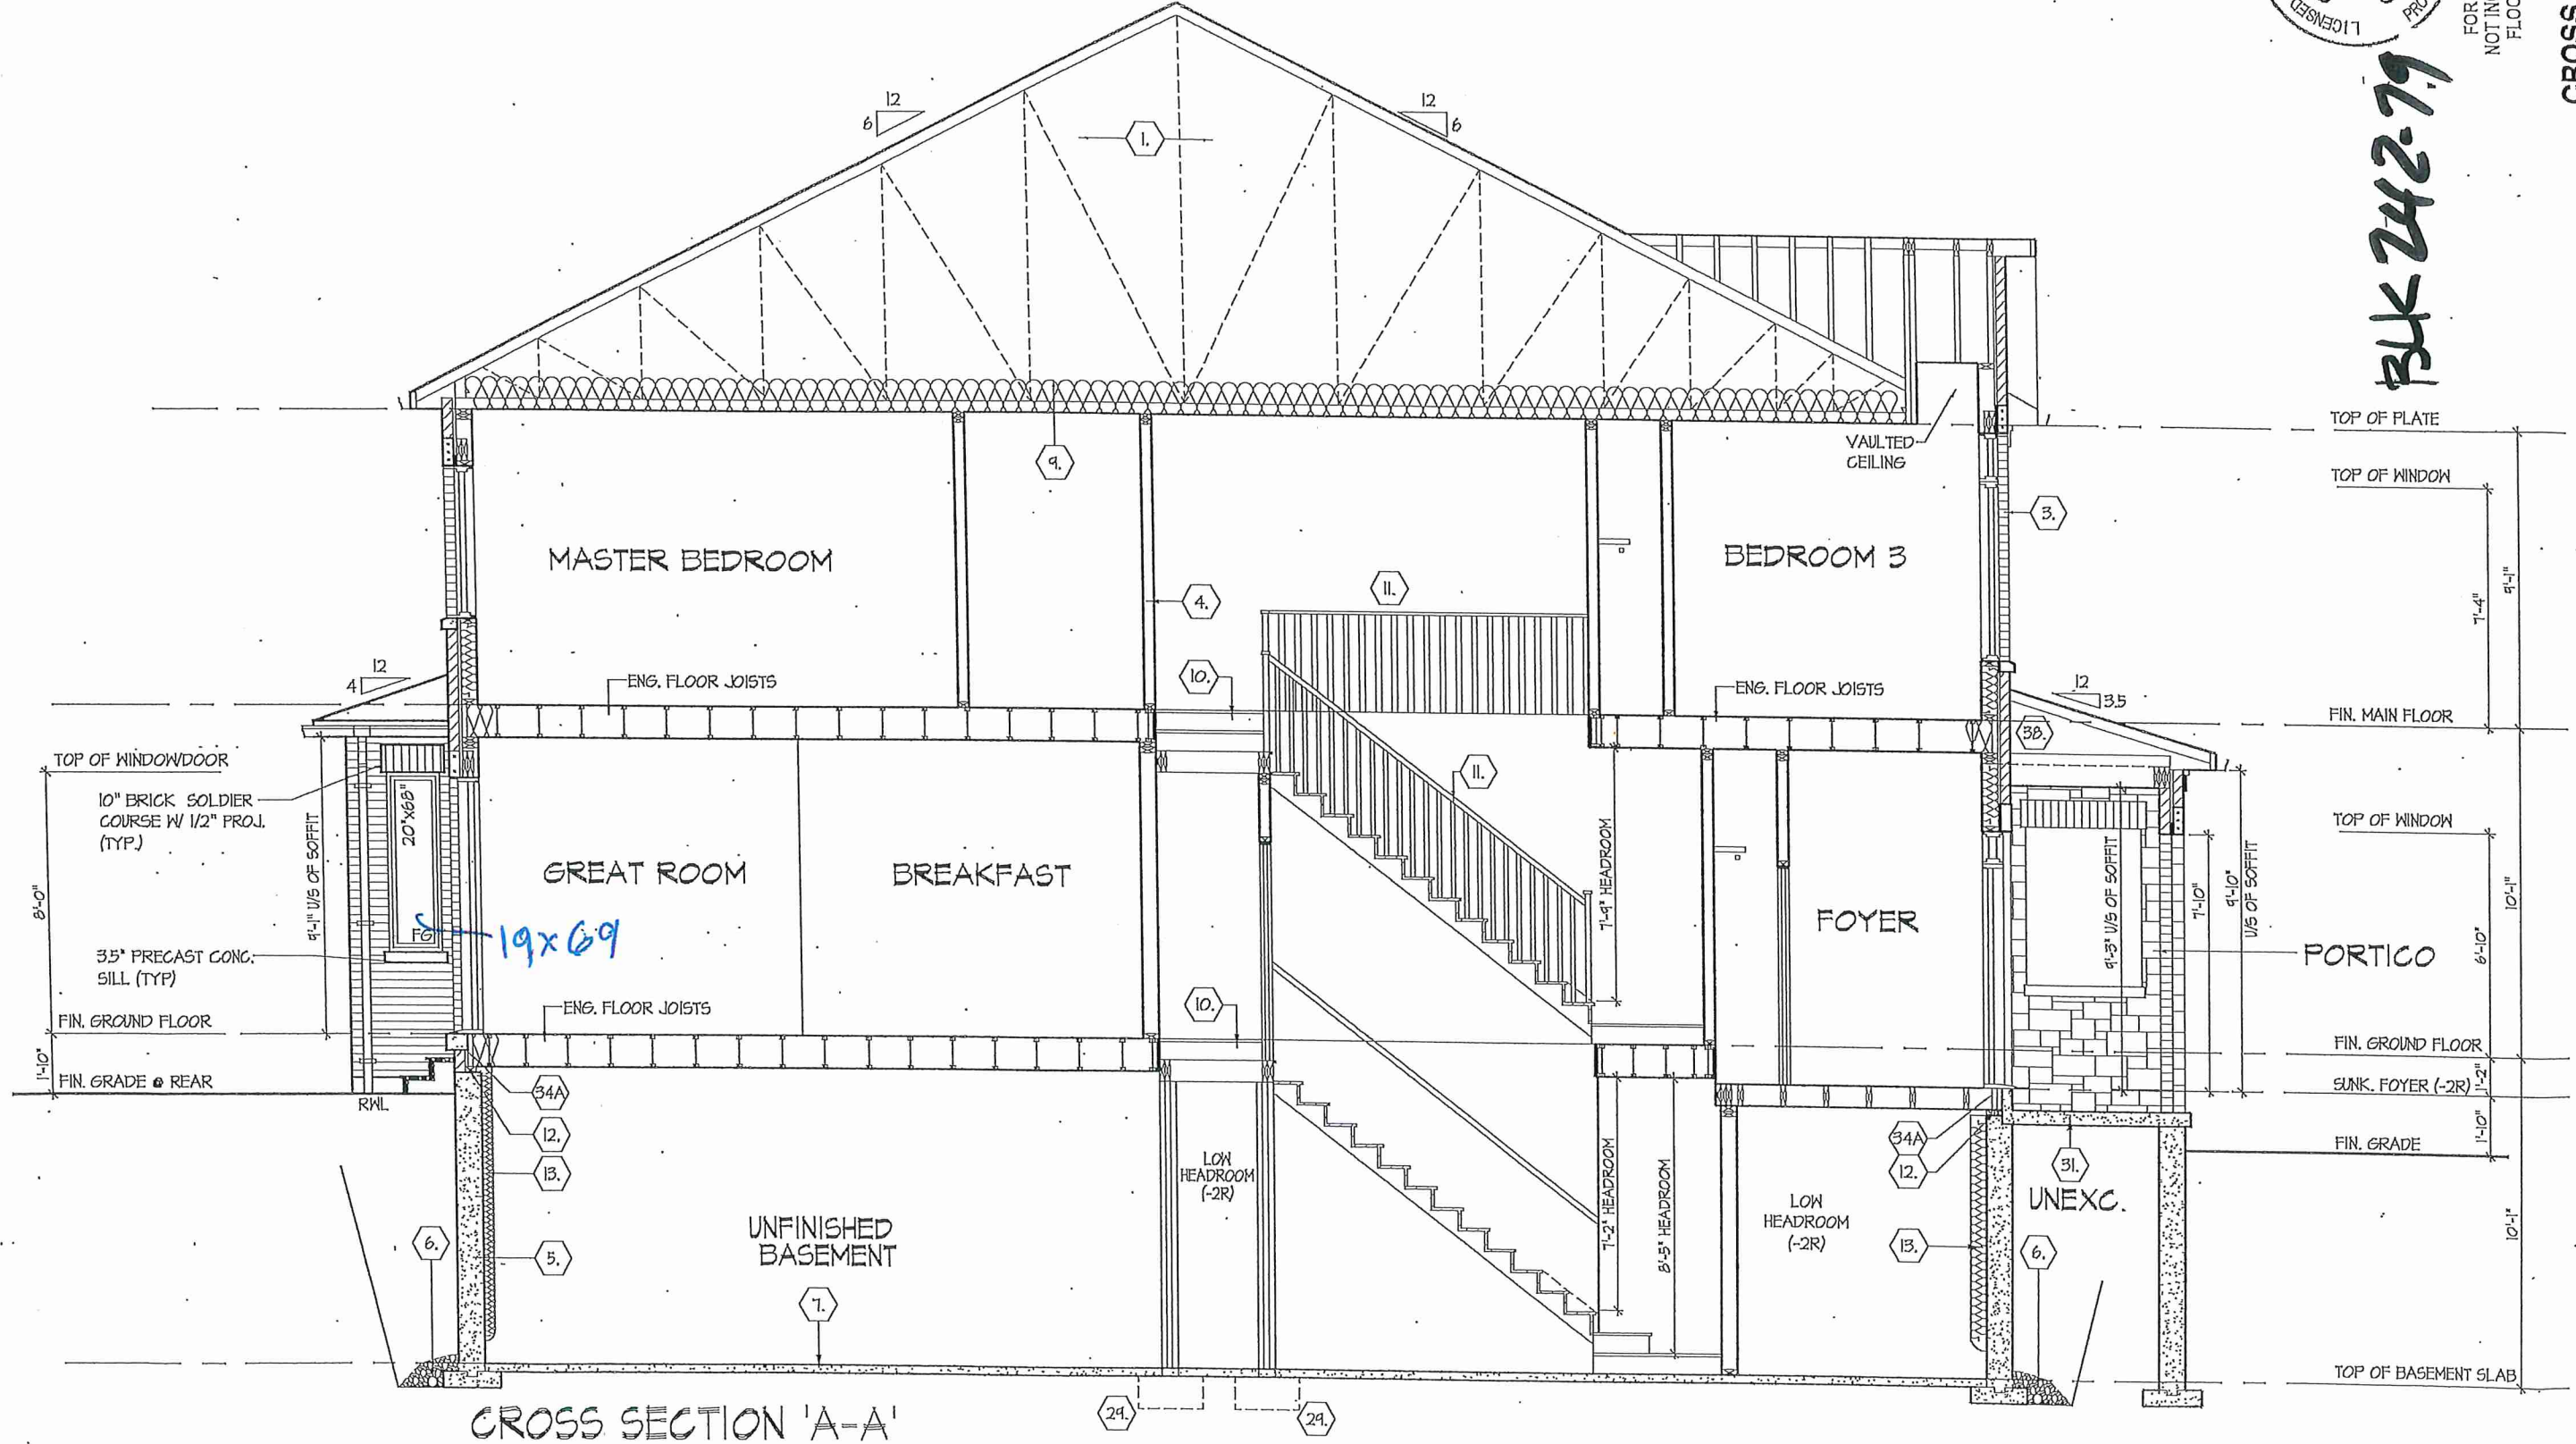

BLK 242-79

FOR STRUCTURAL ONLY
NOT INCLUDING ENGINEERED
FLOOR OR ROOF SYSTEM

CROSS SECTION 'A-A'

ROYAL PINE HOMES - 216102
'CENTREFIELD', WEST GORMLEY, RICHMOND HILL, ON. REV. 2021.05.11



THE UNDERSIGNED HAS REVIEWED AND TAKES RESPONSIBILITY FOR THIS DESIGN AND HAS THE QUALIFICATIONS AND MEETS THE REQUIREMENTS SET OUT IN THE ONTARIO BUILDING CODE TO BE A DESIGNER.
Derek R. Santos
REGISTRATION INFORMATION
NAME: HUNT DESIGN ASSOCIATES INC.
SIGNATURE: [Signature]
37308 BCN 19855

Drawn By: KM
Checked By: DS
Scale: 3/16"=1'-0"
File Number: 216102WT2009
Page Number: 10 of 14

All drawings specifications related documents and design are the copyright property of Hunt Design Associates (H.D.A.). Reproduction of this property in whole or in part is strictly prohibited without H.D.A.'s written permission. H.D.A. assumes no responsibility or liability for this property unless it bears the appropriate BCN number and original signature.