

PURCHASER'S EXTRAS QUOTATION

Bayview Heights - Phase 1

PURCHASERS: JASON TAM and DIANE ELAYNE YUTI ONG

TEL: RES.: 416-568-5553

LOT NUMBER	PHASE	HOUSE TYPE
060 BLOCK 009	1	THE KATHERINE(END)-ELEV B-3 BDRM-2 BATHS

ITEM	EXTRA / CHANGE	QTY	UNIT PRICE	EXTENDED
✓ 236957	1 BASEMENT - Enlarge Basement Window at Rear Elevation from Standard 30 IN (W) x 16 IN (H) to LARGER 48 IN (W) x 24 IN (H) (with Possible Window Well) (See Sketch) *To Accommodate Deck Condition as per Fonzie C.* <i>Purchaser Accepts and Acknowledges Remaining Two (2) Basement Windows will remain Standard Size of 30 IN (W) x 16 IN (H)</i>	1		
✓ 236958	2 CLARIFICATION; COLD CELLAR - Purchaser has DECLINED Upgrade to add basement window to cold cellar. Purchaser accepts & acknowledges NO Window will be installed at cold cellar as per standard plan (See Sketch)	1		
✓ 236956	3 BASEMENT - Install UPGRADE 200 AMP SERVICE in lieu of standard 100 Amp Service (See Sketch)	1		
✓ 236960	4 UPPER HALL - CEILINGS - Install UPGRADE SMOOTH CEILINGS - To be installed throughout 2nd Floor UPPER HALL ONLY, where applicable (See Sketch)	1		
236961	5 BONUS PACKAGE - PURCHASER HAS APPLIED \$10,000.00 (Includes Taxes) WORTH OF UPGRADE PROMOTIONAL PACKAGE TOWARDS THE PURCHASE OF STRUCTURAL UPGRADES COMPLETED AT THE DECOR CENTRE <i>**Remaining Bonus Package of \$5,254.00 (Includes Taxes) will be applied to upgrades completed during decor appointment**</i>	1		
236962	6 PURCHASER HAS ATTENDED A STRUCTURAL APPOINTMENT AT THE DESIGN STUDIO & HAS DECLINED ANY ADDITIONAL UPGRADES. Purchaser accepts & acknowledges that there will be no further structural changes/additions/deletions to be made upon signing on JUNE 17, 2025	1		
236963	7 PURCHASER AWARE AND ACCEPTS THAT ANY CHANGES MADE TO UPGRADES AFTER SIGNING THIS PURCHASERS EXTRA FORM ARE SUBJECT TO A MINIMUM ADMINISTRATION FEE OF \$1,000	1		

Sub Total
HST
Total



1. In the event the work on the house has progressed beyond the point where the items covered by this extra cannot be installed without entailing any unusual expense, then this order is to be cancelled and any deposit paid in connection with the same is to be refunded to the Purchaser.
2. The Vendor will undertake to incorporate the work covered by the sales extra in the construction of the house but will not be liable to the purchaser in any way, if for any reason the work covered by the extra is not carried out. In that event, any monies paid in connection with the same shall be returned to the Purchaser.
3. It is understood and agreed that if for any reason whatsoever the transaction of Purchase and Sale is not completed, the total cost of extras ordered are not refundable to the Purchaser(s).
4. Extras or changes will not be processed unless signed by the Vendor.
5. These extras may not be amended without the written consent of EARLGLEN INVESTMENTS INC..
6. The Purchaser(s) and the Vendor acknowledge and agree that this form shall not be deemed to be part of the Agreement of Purchase and Sale entered into between them, nor an addendum thereto.
7. No Estimates or orders will be accepted once construction has commenced.
8. Prices are estimates only and guaranteed for a period of 5 days only.
9. Any cancellations to this order, providing they can be cancelled, are subject to a \$500 minimum administration charge and a 10% cancellation charge for the total amount being cancelled.
10. For Visa, Mastercard and Debit payments, transactions are identified on you statement as "SHERWAY CONSTRUCTION LTD", an Authorized Visa /Mastercard/Debit Merchant and authorized Royal Pine Homes company.

Initials: SI QL

CONSTRUCTION SCHEDULING APPROVAL

PER: _____

DATE: - -

PREPARED BY: Melissa Di Marino

PRINTED: 17-Jun-25 at 1:23 pm

RoyInvoiceSQL.rpt 07aug20



BAYVIEW HEIGHTS



RICHMOND HILL




ELEVATION B

June 17, 2025

15 94

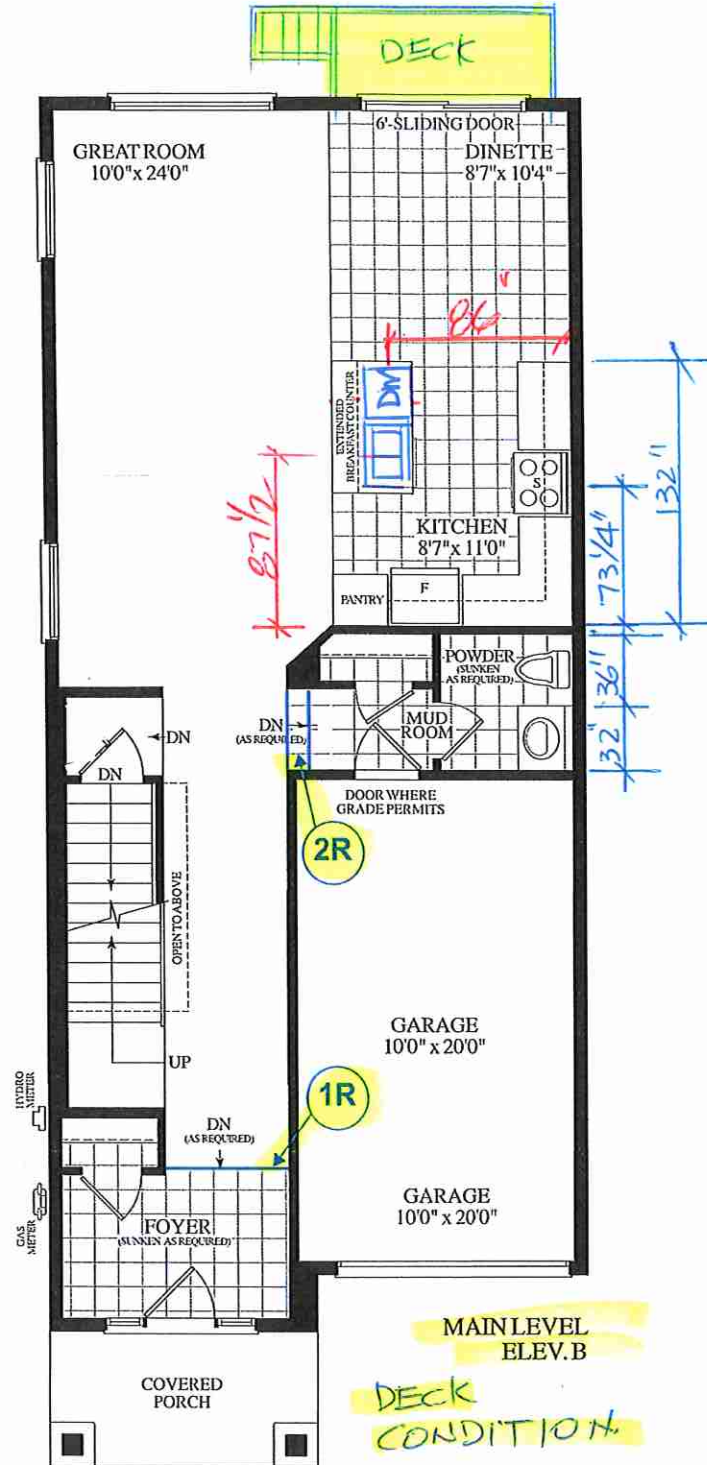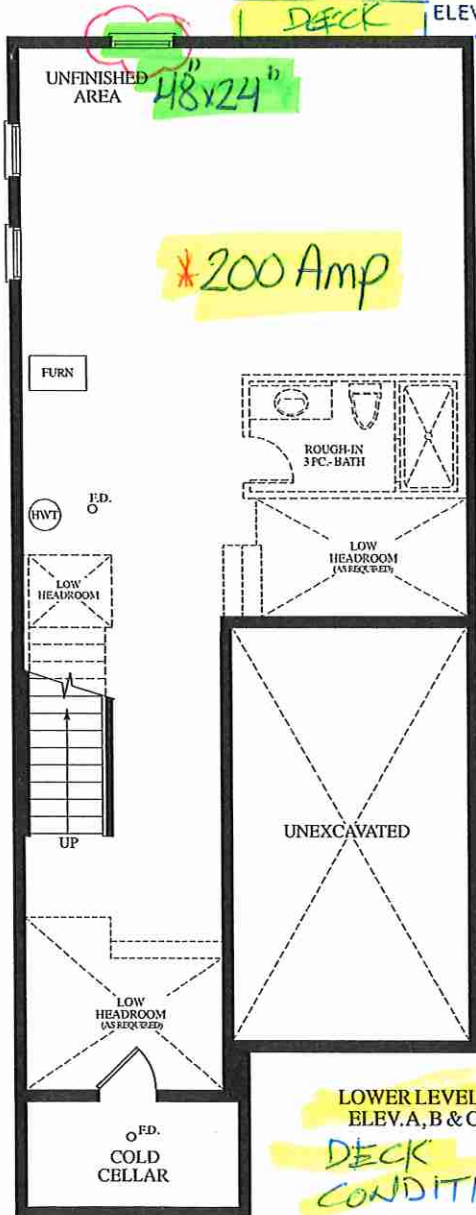

Materials, specifications and floor plans are subject to change without notice. All renderings are artist's concept. All floor plans are approximate dimensions. Actual usable floor space may vary from the stated floor area. E.&O.E.

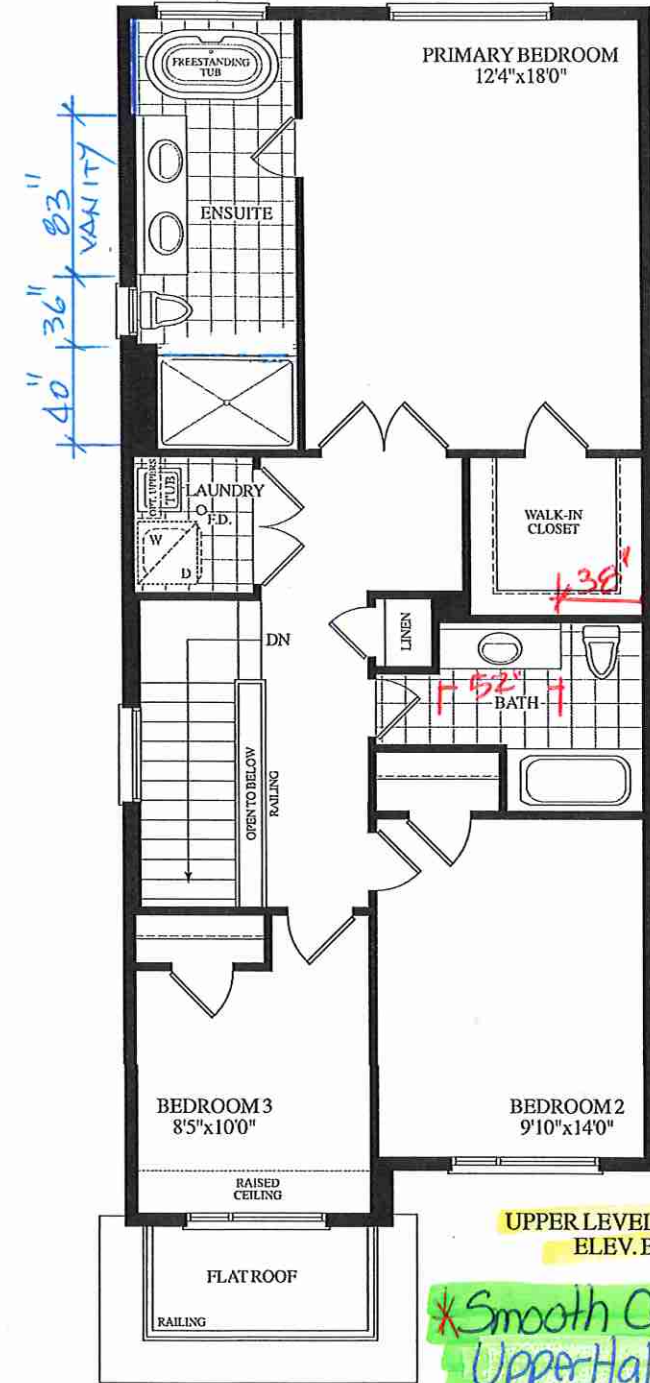

BLK.9 TH. 60 20-18 THE KATHERINE (END) EL. B 3 BDRM 2 BATH 1815 SQ.FT.