

CONSTRUCTION SUMMARY

EARLGLEN INVESTMENTS INC.

PURCHASER: BOEUN PARK

TEL: RES.: 647-609-6550

LOT NUMBER PI	PHASE	HOUSE TYPE	CLOSING DATE	
105 BLOCK 017	1	THE CHARLOTTE-ELEV A-OPT MAIN-3 BDRM-2 BATHS	08-Sep-26	

Offer	BONUS PACKAGE: PURCHASER TO RECEIVE \$10,000 (INCLUSIVE OF TAXES) WORTH OF UPGRADES AT DECOR CENTER AT TIME OF COLOUR CHART.
Worksheet	Note:
Offer	APPLIANCE PACKAGE: PURCHASER TO RECEIVE 5 APPLIANCES TO INCLUDE FRIDGE, STOVE, DISHWASHER WITH STAINLESS STEEL FINISH AND WHITE WASHER & DRYER AS PER VENDORS SAMPLES.
Worksheet	The state of the s
Offer	COMPLETE CENTRAL AIR CONDITIONING SYSTEM, AS PER VENDORS STANDARD SAMPLES.
Worksheet	Note:
	VENDOR AGREES TO SUPPLY AND INSTALL 7 1/2inch LAMINATE FLOORING ON UPPER HALLWAY, AS PER PLAN AND AS PER VENDORS STANDARD SAMPLES.
Worksheet	Note:



CONSTRUCTION SUMMARY EARLGLEN INVESTMENTS INC.

PURCHASER: BOEUN PARK

TEL: RES.: 647-609-6550

LOT NUMBER PHASE HOUSE TYPE CLOSING DATE
105 BLOCK 017 1 THE CHARLOTTE-ELEV A-OPT MAIN-3 BDRM-2 BATHS 08-Sep-26

Date Added: 20-Jun-25 Invoice Number: 8839

1 - BASEMENT - WINDOWS - Delete Two Standard Windows 30 IN (W) x 16 IN (H) Install ONE (1) LARGER WINDOW 36 IN (W) x 24 IN (H) (with Possible Window Well) at Basement (See Sketch)

Note: As per Fonzie C.

1 - CLARIFICATION:

PRIMARY ENSUITE - Purchaser Accepts & Acknowledges revision made to primary ensuite vanity and toilet locations (As per Fonzie C.) (See Sketch)

Note:

1 - BONUS PACKAGE - PURCHASER HAS APPLIED \$10,000.00 (Incudes Taxes) WORTH OF UPGRADE PROMOTIONAL PACKAGE TOWARDS THE PURCHASE OF STRUCTURAL UPGRADES COMPLETED AT THE DECOR CENTRE

Note: **Remaining Bonus Package of \$9,435.00(Includes Taxes) will be applied to upgrades completed during decor appointment**

1 - PURCHASER HAS ATTENDED A STRUCTURAL APPOINTMENT AT THE DESIGN STUDIO AND HAS DECLINED ANY ADDITIONAL UPGRADES. Purchaser accepts and acknowledges that there will be no further structural changes/additions/deletions to be made upon signing on JUNE 20,2025

Note:

 ${f 1}$ - PURCHASER AWARE AND ACCEPTS THAT ANY CHANGES MADE TO UPGRADES AFTER SIGNING THIS PURCHASERS EXTRA FORM ARE SUBJECT TO A MINIMUM ADMINISTRATION FEE OF \$1,000

Note:

Date Added: Invoice Number: 8840

1 - Install Standard Cable Rough-Ins (x2) and Install Standard Telephone Rough-Ins (x2) (See Sketch)

Note:

1 - KITCHEN - In addition to builders standard ceiling light, Install ONE (1) ADDITIONAL CEILING LIGHT with One (1) Seperate Switch - To be installed centred above kitchen island (See Sketch)

Note:

1 - GREAT ROOM - In addition to builders standard ceiling light, Install FOUR (x4) LED POT LIGHTS Controlled by ONE (1) Seperate Switch - To be installed at great room (See Sketch)

Note:

1 - 2ND FLOOR BEDROOMS - FLOORING - Install UPGRADE Laminate Flooring - 1/2" TORLYS RED OAK NAUTRAL EEH-N-240 in lieu of builder standard broadloom. To be installed throughout 2nd floor bedrooms, where applicable.

Note: To Include; Primary Bedroom, Bedroom #2 and Bedroom #3 (See Sketch)

1 - STAIRCASE VS FLOORING

WOOD SPECIES DIFFERENCE:

STAIRCASE - The purchaser was advised and therefore accepts and acknowledges that the wood species of the staircase and flooring chosen do not match. This difference may result in a stain colour variance.

Note: The purchaser agrees that the vendor is to be exempt from any and all claims by the purchaser regarding this colour variance.

1 - KITCHEN & BATHROOMS - Purchaser has DECLINED All Upgrades offered during decor appointment at the decor centre for kitchen & bathroom cabinetry. Standard Kitchen Layout & Standard Bathroom Vanities to be installed as per standard plan. (See Sketch) Note:


1 - APPLIANCES - KITCHEN - Install STANDARD Fridge, Stove, and Diswasher at Kitchen from builders standard appliance package (See Attached)

Note: Install Builders Standard Exhaust Fan at kitchen, above stove

1 - APPLIANCES - LAUNDRY - Install UPGRADE WASHING MACHINE - Whirlpool Front Load Washer - Model # WFW560CHW - White (See Attached)


Note:


StaConstructionSuymmarySQL.rpt 09May22 Page 2 of 4

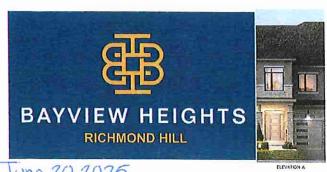

June 20, 2025

Be

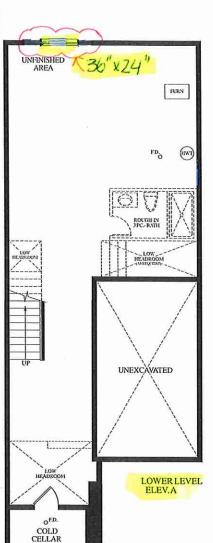

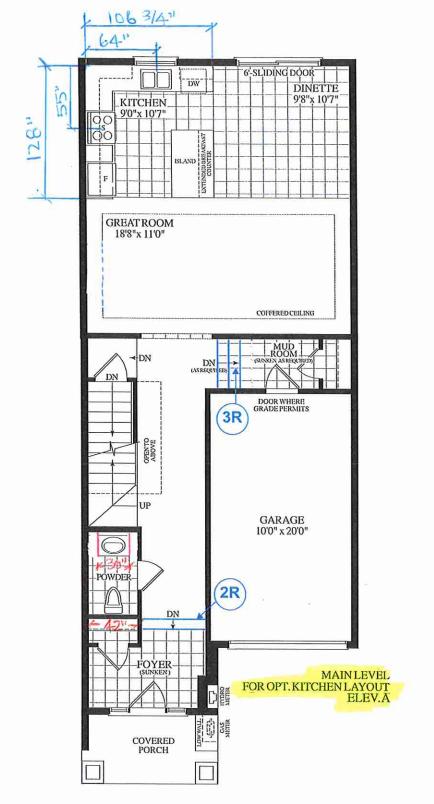

Materials, specifications and floor plans are subject to change without notice. All renderings are artist's concept. All floor plans are approximate dimensions. Actual usable floor space may vary from the stated floor area, E.RO.E.

