



Structural

CONSTRUCTION SUMMARY
EARLGLEN INVESTMENTS INC.

PURCHASER: KAR LING TEO TEL: RES.: 647-975-0755

LOT NUMBER	PHASE	HOUSE TYPE	CLOSING DATE
097 BLOCK 016	1	THE KATHERINE(END)-ELEV C-3 BDRM-3 BATHS	04-Aug-26

Date Added: 24-Jun-25 Invoice Number: 8843

1 - PURCHASER AWARE AND ACCEPTS THAT ANY CHANGES MADE TO UPGRADES AFTER SIGNING THIS PURCHASERS EXTRA FORM ARE SUBJECT TO A MINIMUM ADMINISTRATION FEE OF \$1,000
Note:

1 - PURCHASER HAS ATTENDED A COLOUR CHART APPOINTMENT AT THE DESIGN STUDIO AND HAS DECLINED ANY ADDITIONAL UPGRADES
Note:

1 - BONUS PACKAGE-PURCHASER TO RECEIVE \$7,457.50 (INCLUSIVE OF TAXES) WORTH OF UPGRADES AT THE DESIGN STUDIO AT TIME OF COLOUR CHART
Note:

Date Added: 24-Jun-25 Invoice Number: 8841

1 - BASEMENT-Install 200Amp service in lieu of the builders standard (See Sketch)
Note:


1 - ATTIC/BASEMENT-Install a conduit pipe from the attic to the basement (See Sketch)
Note:

1 - PURCHASER AWARE AND ACCEPTS THAT ANY CHANGES MADE TO UPGRADES AFTER SIGNING THIS PURCHASERS EXTRA FORM ARE SUBJECT TO A MINIMUM ADMINISTRATION FEE OF \$1,000
Note:




1 - PURCHASER HAS ATTENDED A STRUCTURAL CHART APPOINTMENT AT THE DESIGN STUDIO AND HAS DECLINED ANY ADDITIONAL UPGRADES
Note:

1 - BONUS PACKAGE-PURCHASER TO RECEIVE \$10,000 (INCLUSIVE OF TAXES) WORTH OF UPGRADES AT THE DESIGN STUDIO AT TIME OF COLOUR CHART
Note: BONUS PACKAGE-PURCHASER TO A REMAINING BALANCE OF \$7,457.50 (INCLUSIVE OF TAXES) WORTH OF UPGRADES AT THE DESIGN STUDIO AT TIME OF COLOUR CHART

This Document is Extremely Time Sensitive - Printed 25 Jun 25 at 11:53

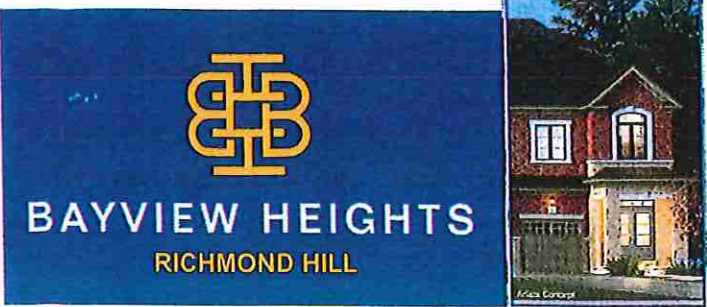

* CONDUIT ATTIC to BSMT *

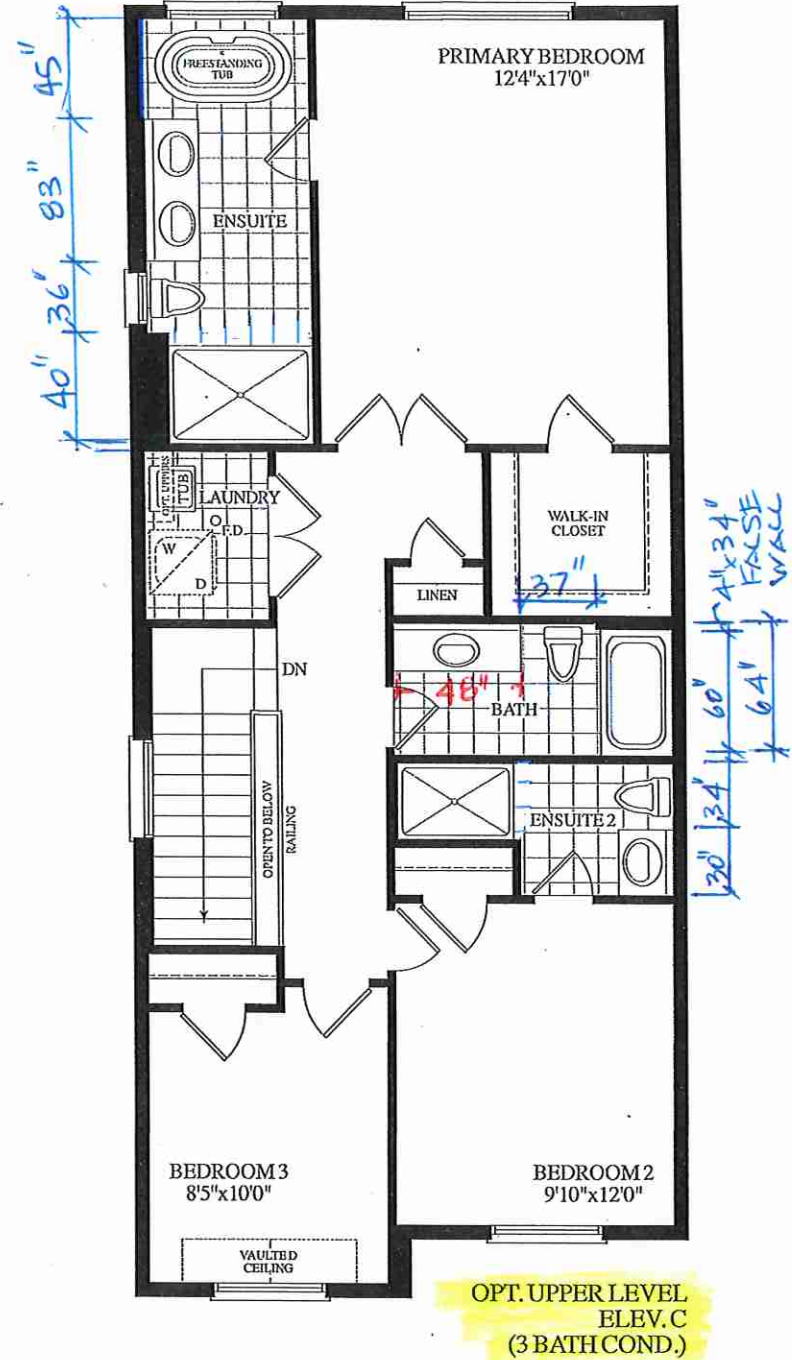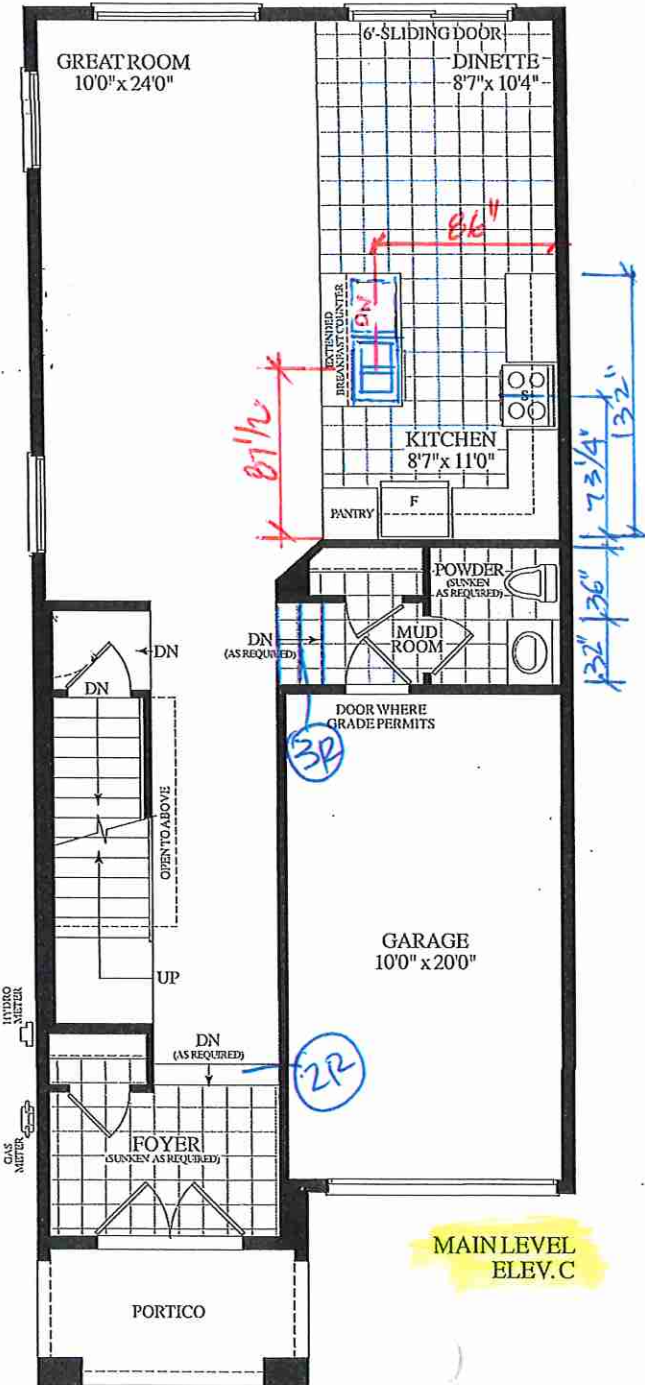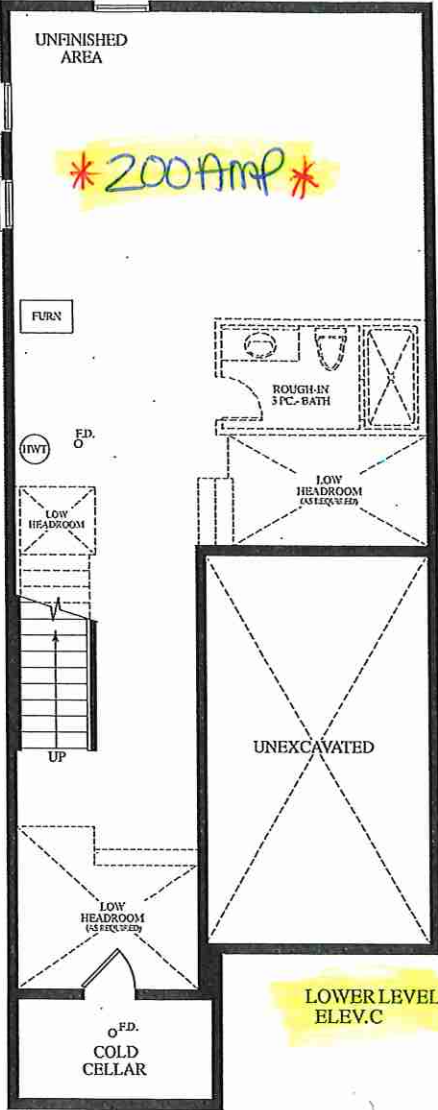

Materials, specifications and floor plans are subject to change without notice. All renderings are artist's concept. All floor plans are approximate dimensions. Actual usable floor space may vary from the stated floor area. E.&O.E.