




Block 19

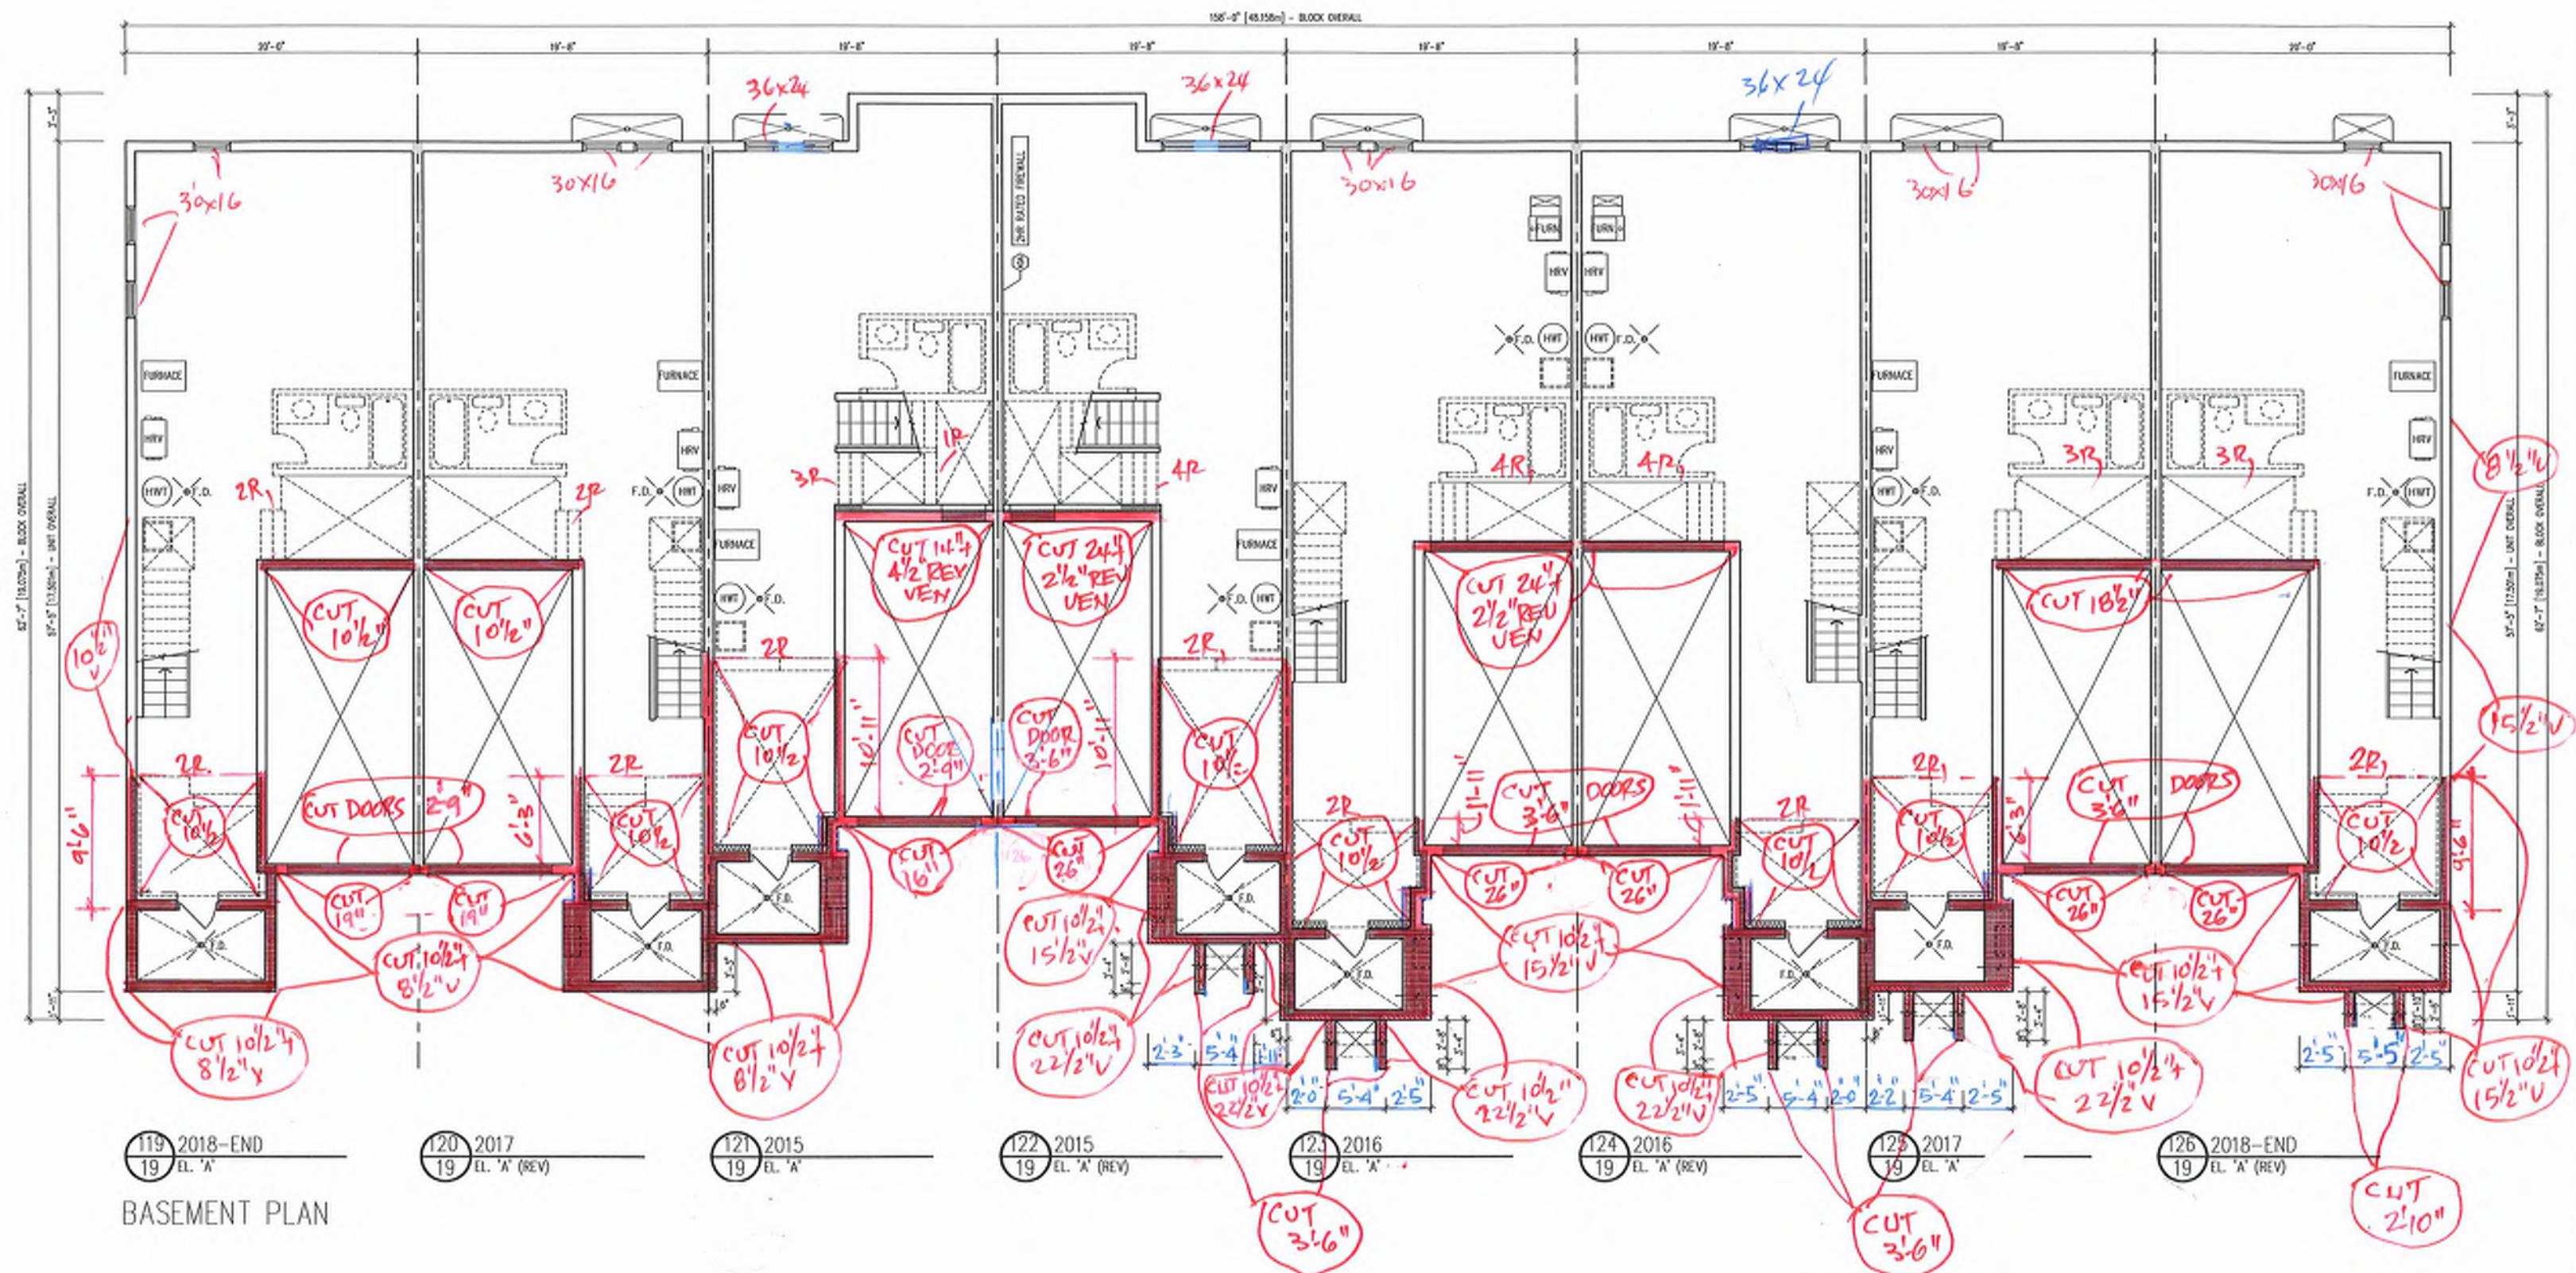


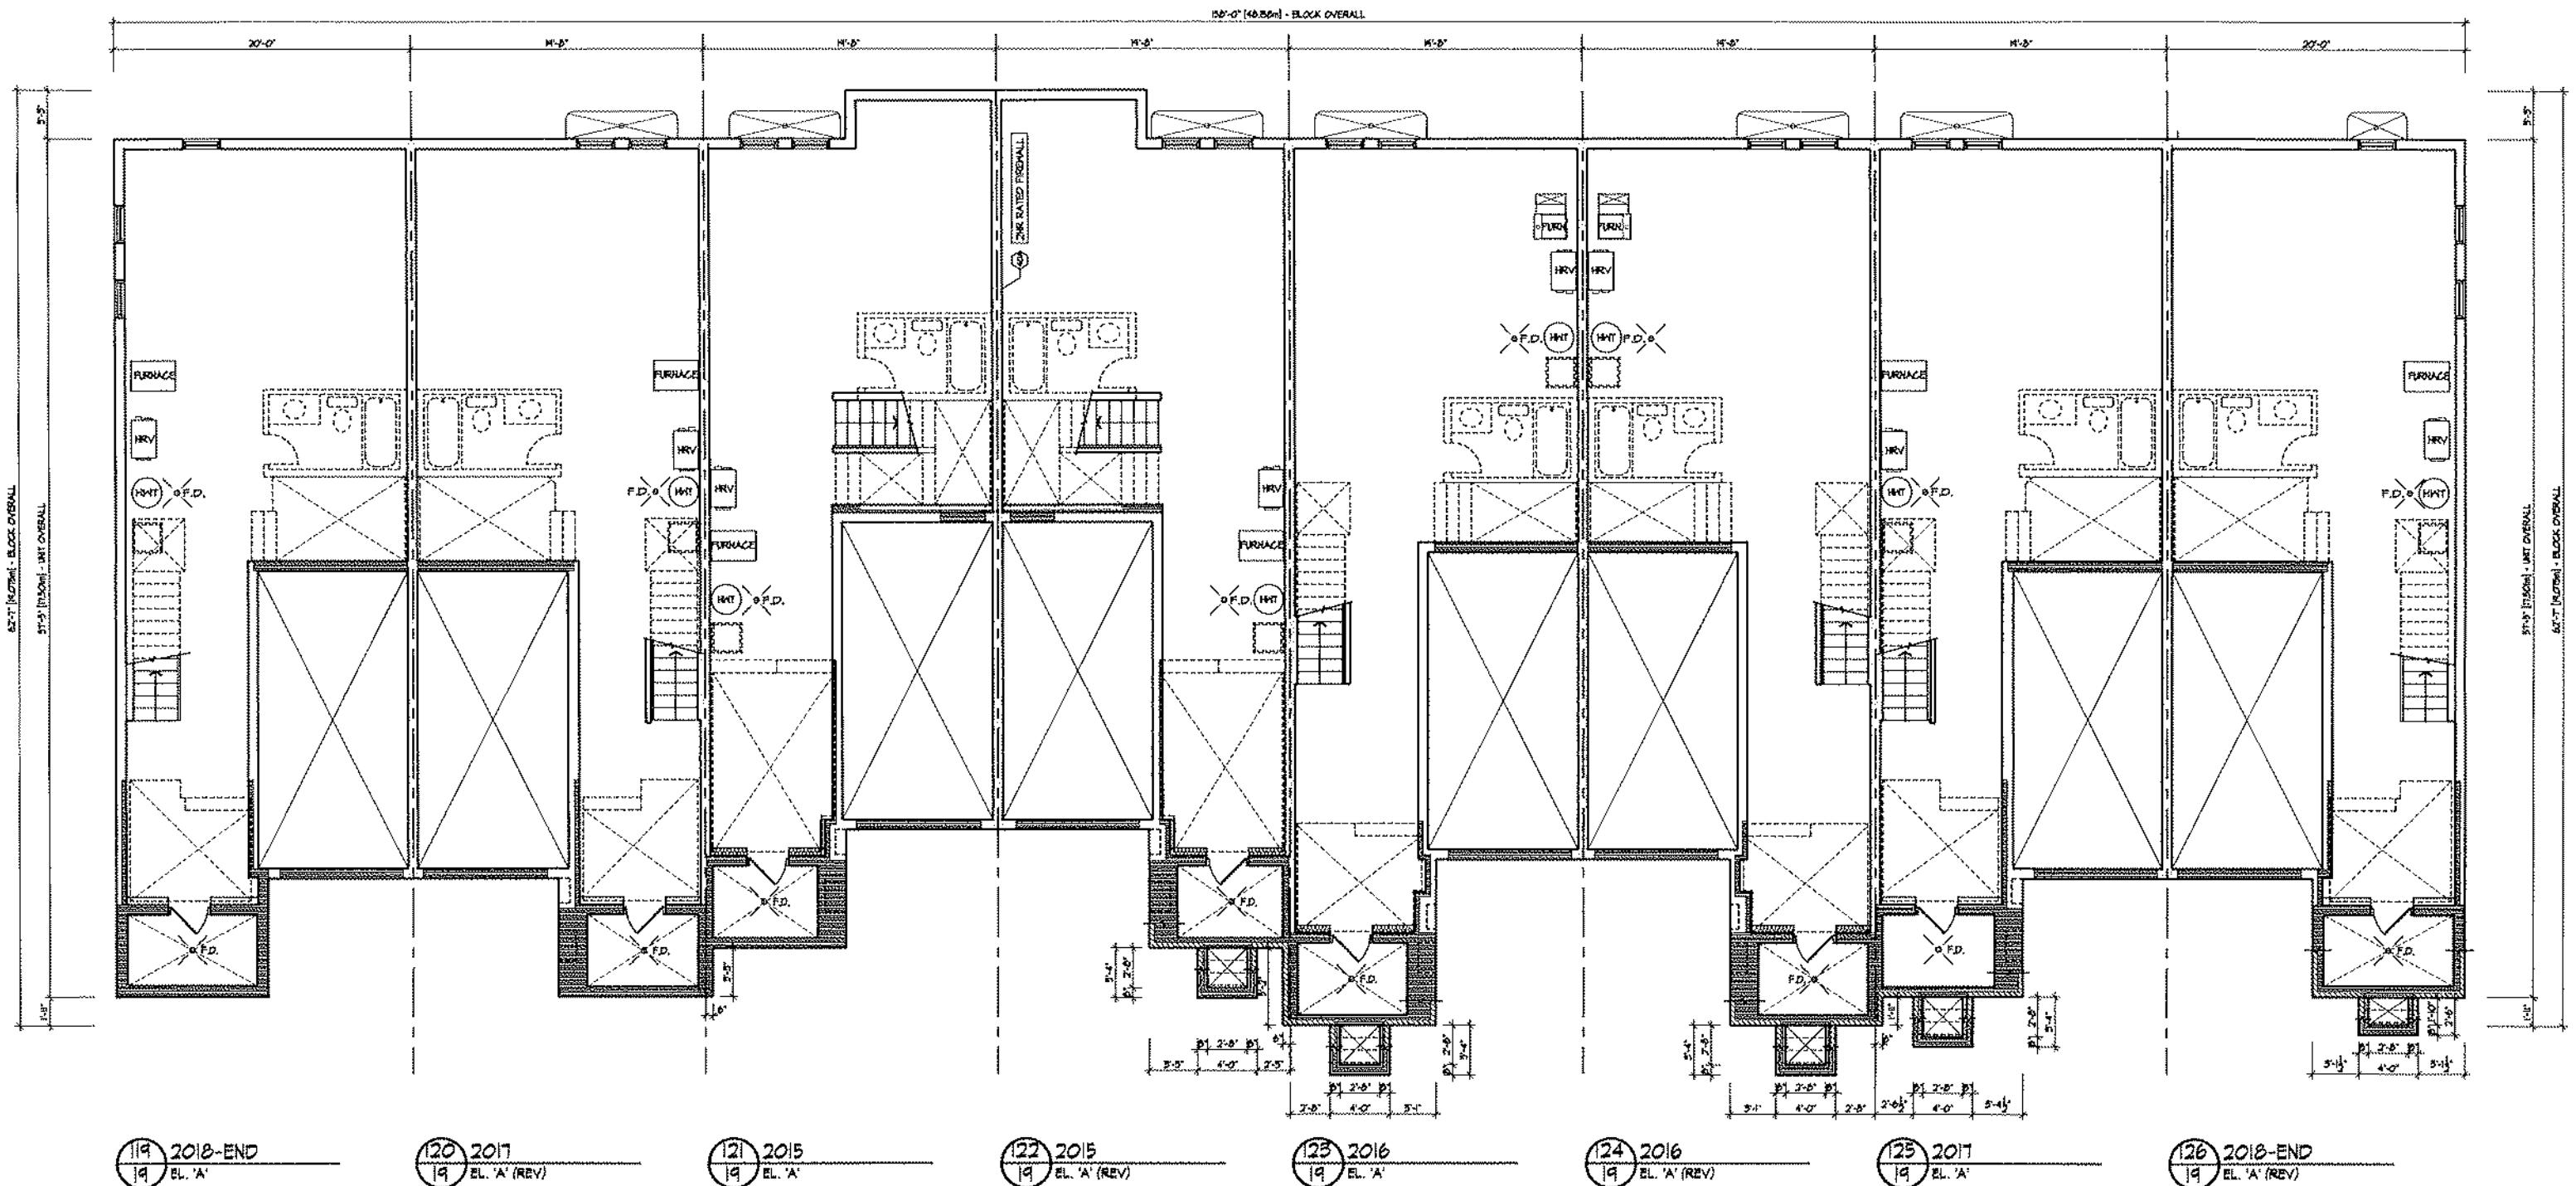

BASEMENT PLAN

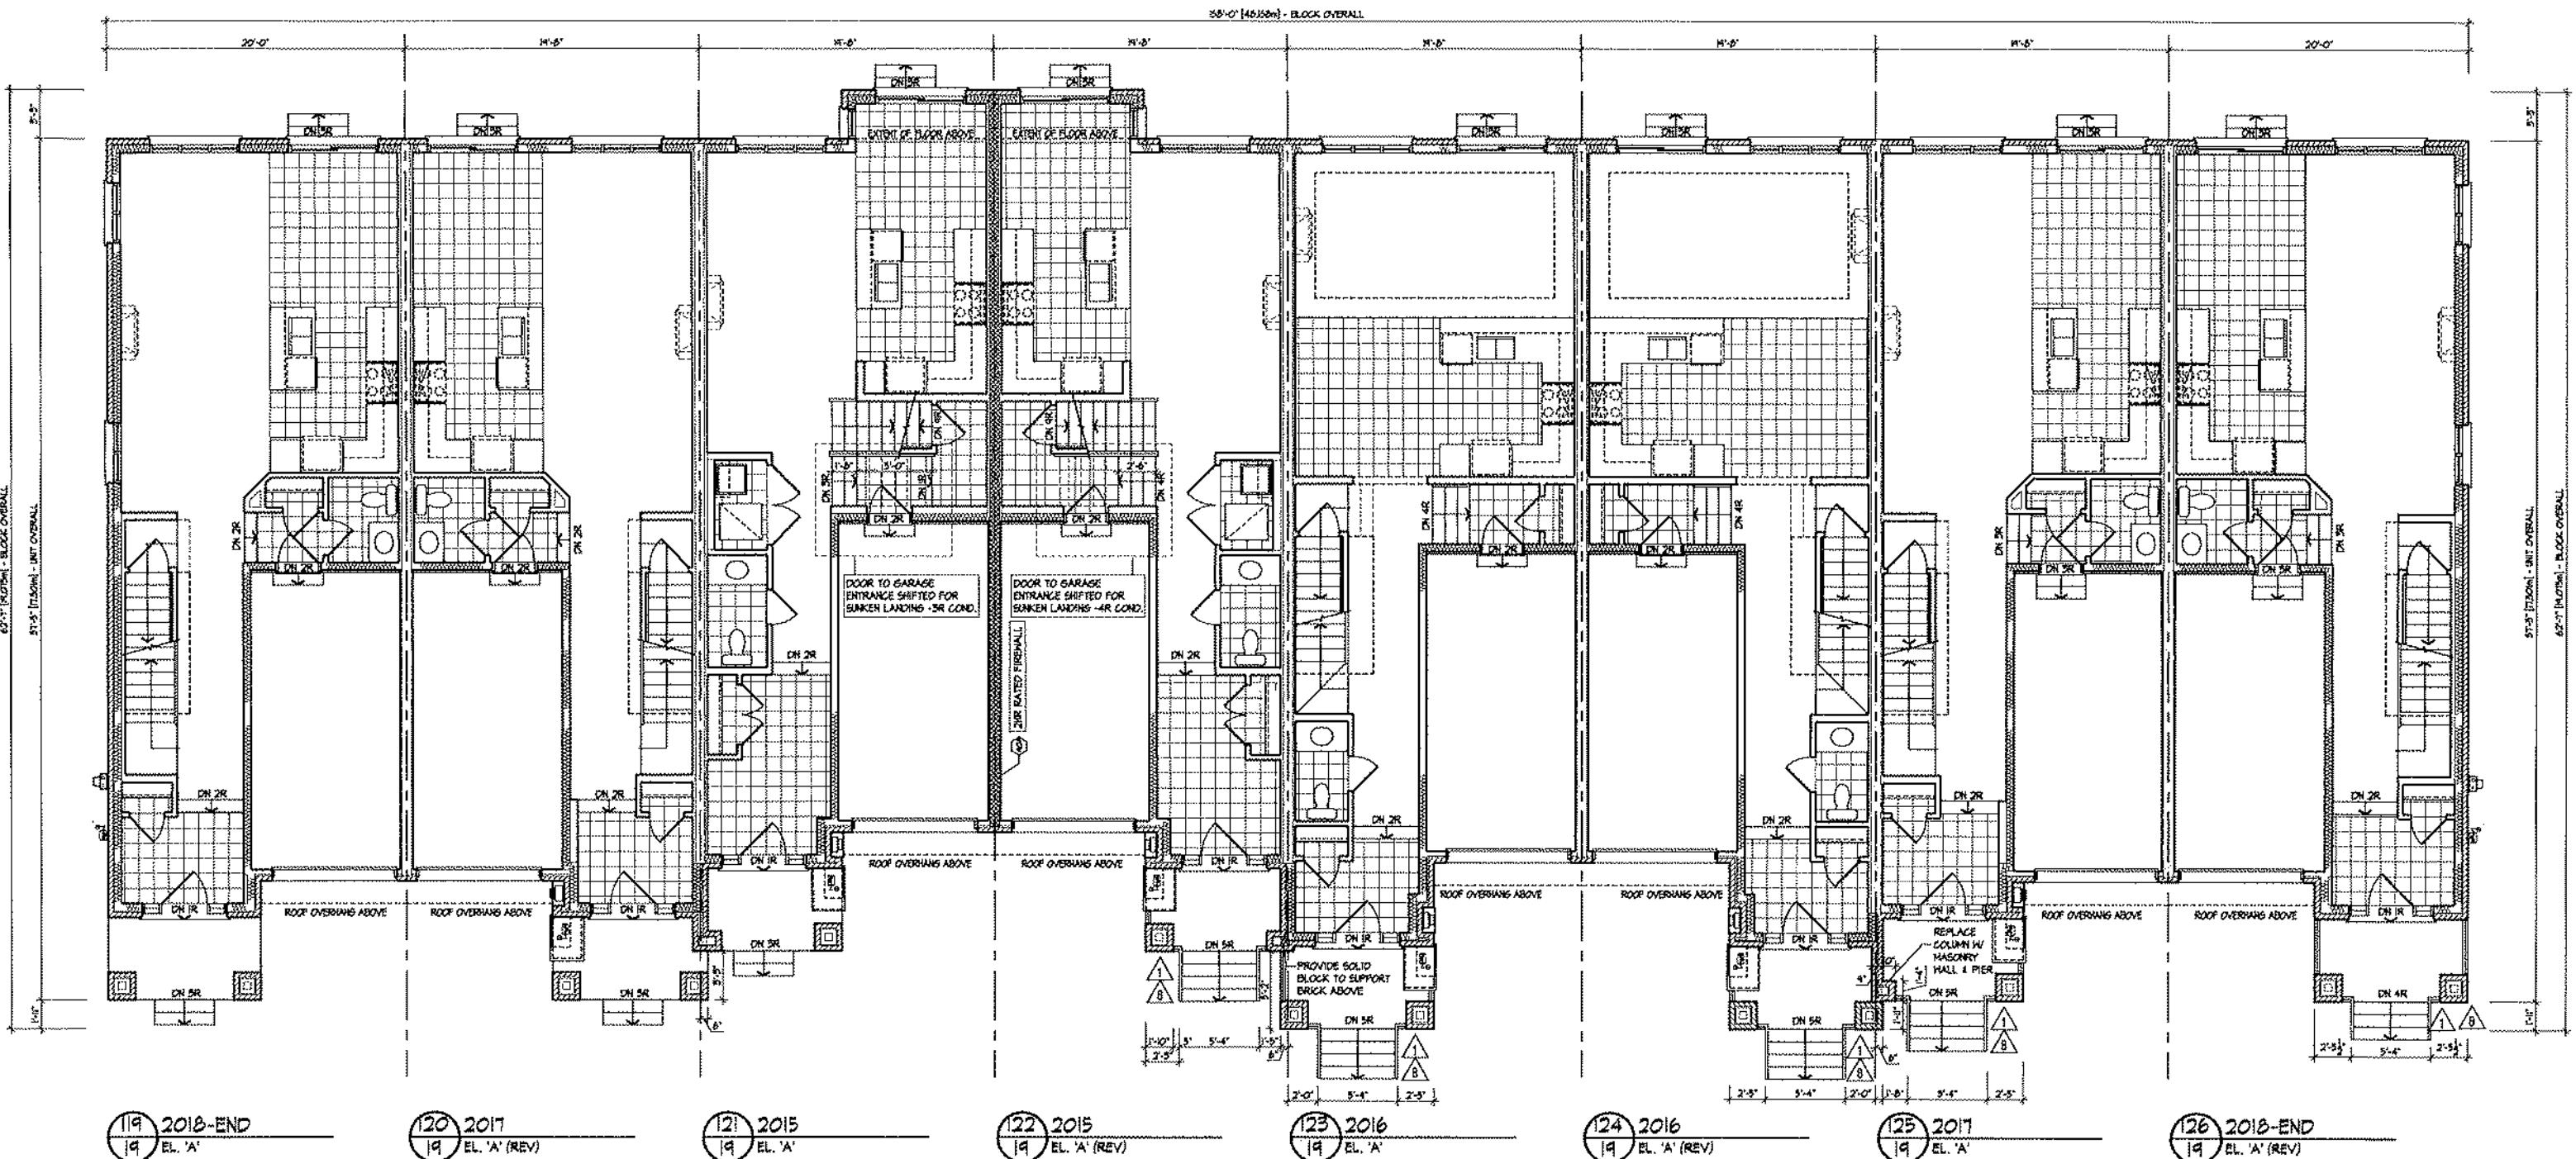

GROUND FLOOR PLAN

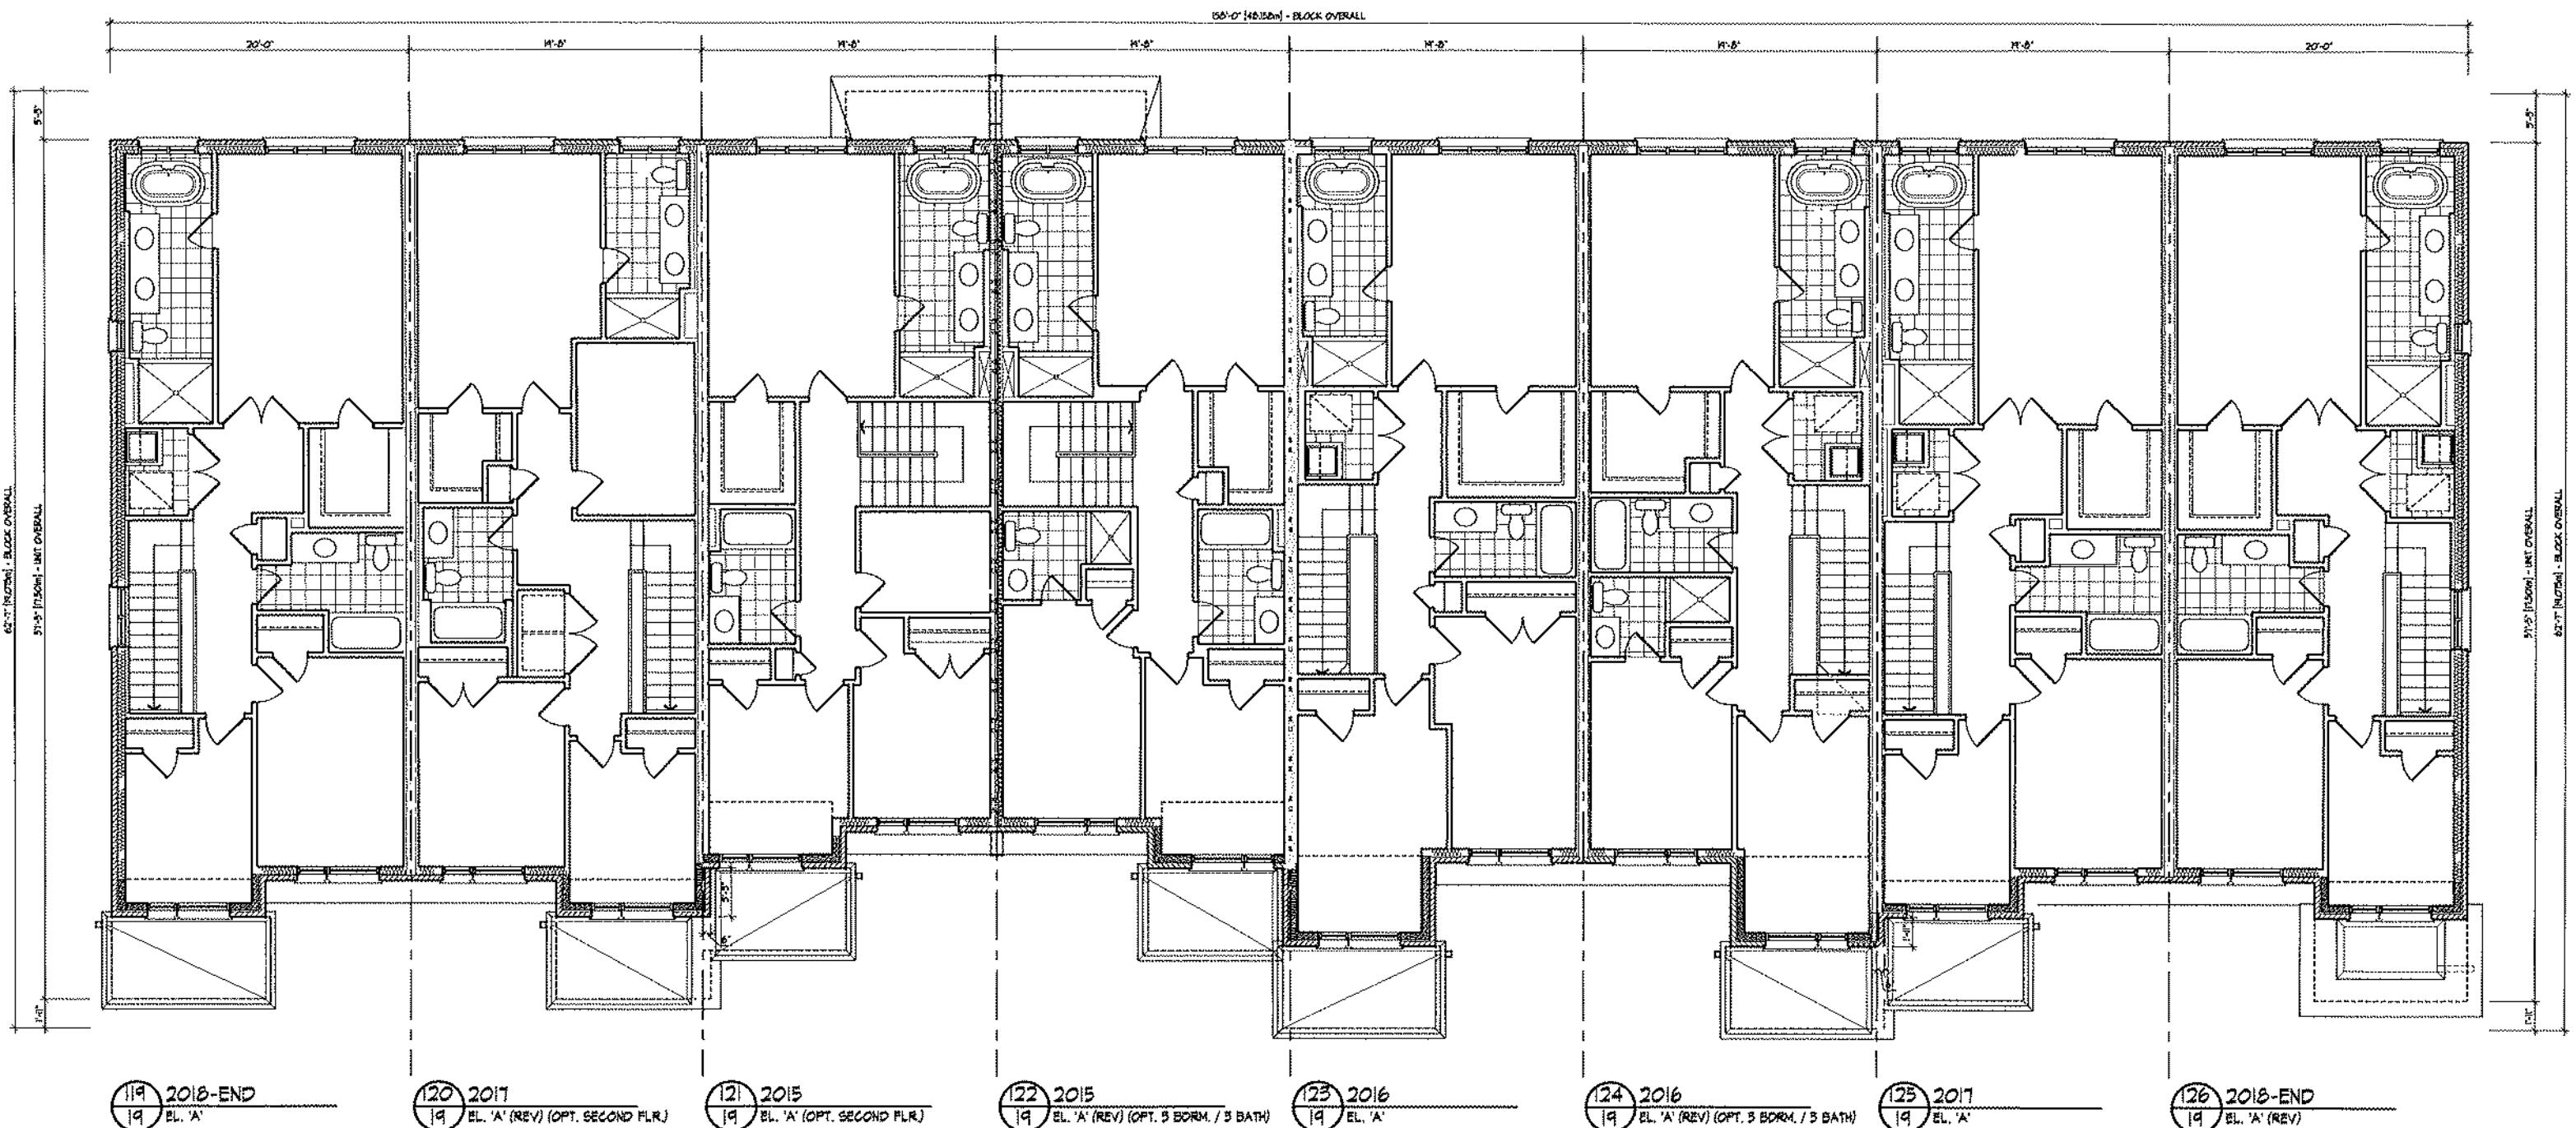

SECOND FLOOR PLAN



119 2018-END
19 EL. 'A'

120 2017
19 EL. 'A' (REV)

121 2015
19 EL. 'A'

122 2015
19 EL. 'A' (REV)

123 2016
19 EL. 'A'

124 2016
19 EL. 'A' (REV)

125 2017
19 EL. 'A'

126 2018-END
19 EL. 'A' (REV)

FRONT ELEVATION



119 2018-END
19 EL. 'A'

120 2017
19 EL. 'A' (REV)

121 2015
19 EL. 'A'

122 2015
19 EL. 'A' (REV)

123
19

FRONT ELEVATION





123 2016
19 EL. 'A'

124 2016
19 EL. 'A' (RE)

125 2017
19 EL. 'A'

26 2018-END
19 EL. 'A' (REV)

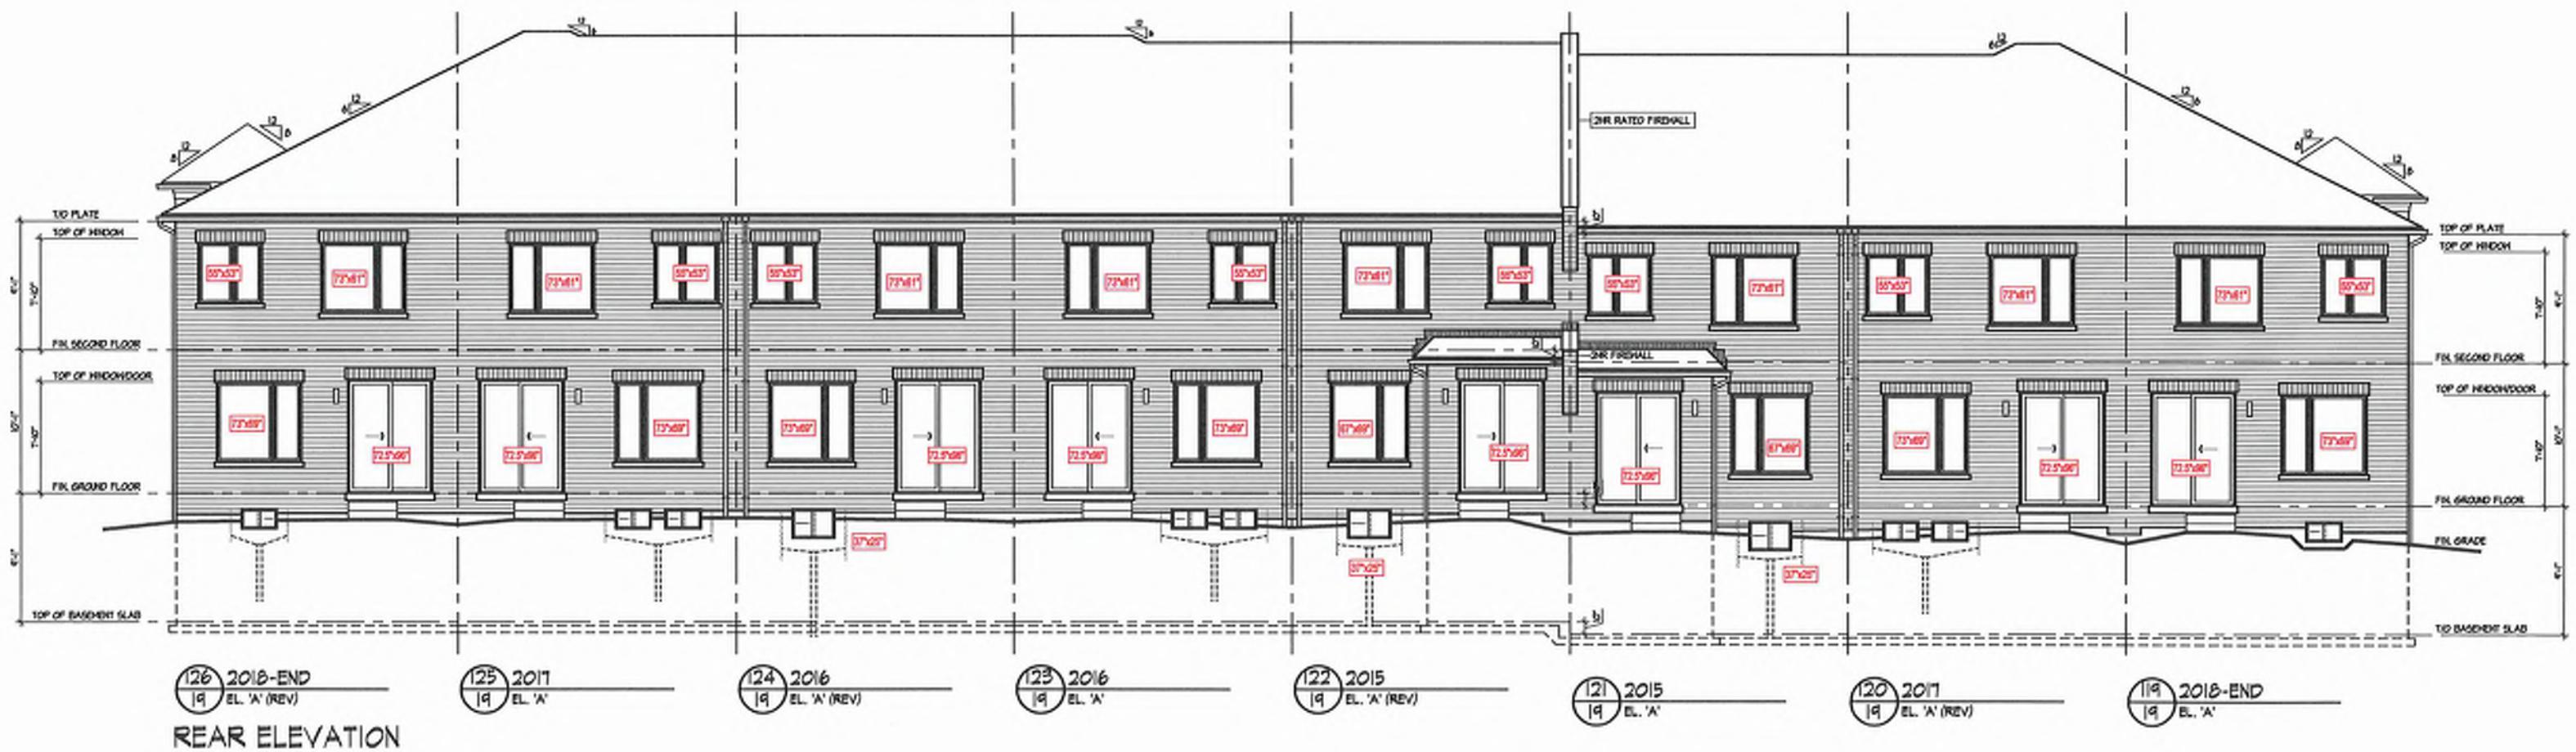

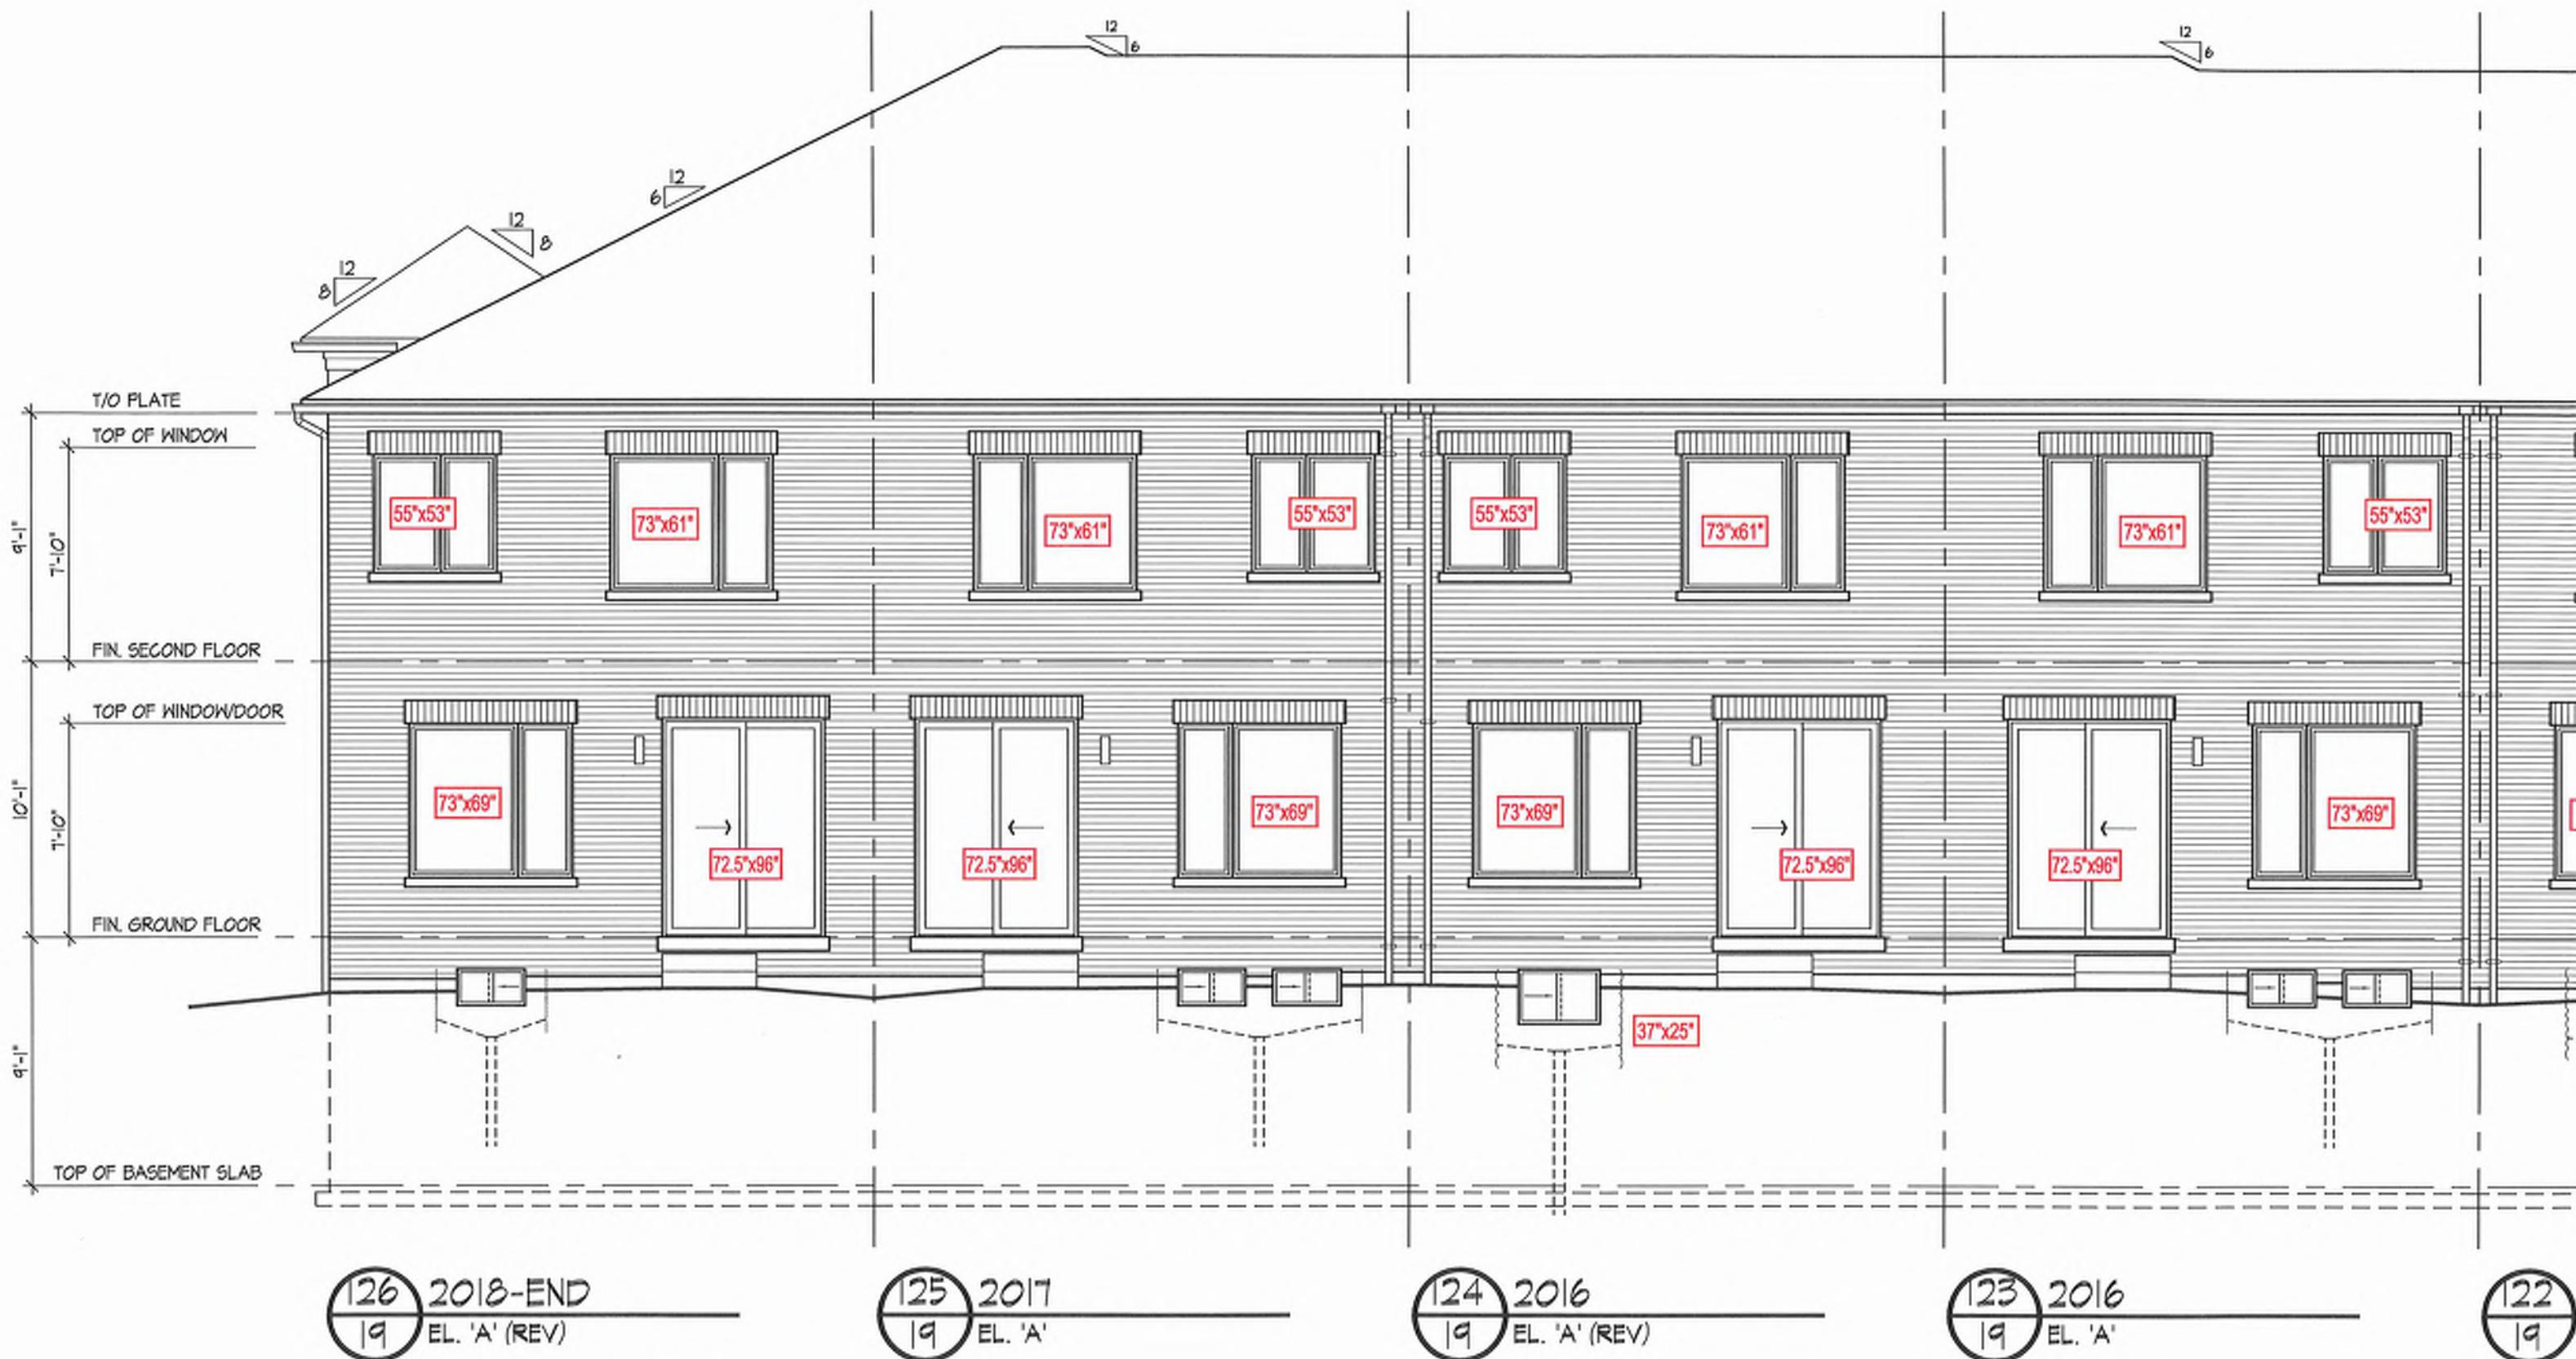

REAR ELEVATION



122 2015
19 EL. 'A' (REV)

121 2015
19 EL. 'A'

120 2017
19 EL. 'A' (REV)

119 2018-END
19 EL. 'A'



119
19

2018-END

EL. 'A'

LEFT SIDE ELEVATION



126 2018-END
19 EL. 'A' (REV)

RIGHT SIDE ELEVATION

ASPHALT SHINGLES
12" FINISH O.H
R.T.M.C
2X6 EXTERIOR WALLS
2X6 FASCIA BOARD

**6/12 PITCHES (TYP.)
UNLESS NOTED**

**UNIT2018 - ENI
ELA- LOT119
443554**

UNIT2017
EL:A(REV)- LO
443555

UNIT2015
ELA-LOT1
443556

2HRS F
"NO" WA
UNIT2015
SL:A(REV)
443557

F122 UNIT201
EL-A-LO
443558

UNIT2016
ELIA(REV)- LOT
443559

**UNIT2017
EL-A-LOT125
443560**

**UNIT2018 - END
ELA(REV)- LOT12
443561**

HARDWARE:
HGUS26-2 -(XX)
LJS26DS -(V)
LUS24 -(O)
H2.5T -(I)

DENOTE:

H-27" HIGHER PLATE


HF-22" HIGHER
FASCIA ONLY

All conventional framing to conform with Part 9 of O.B.C. 2024. Roof rafters that cross over or meet trusses to be min. 2x4 SPF #2 @ 24" o/c with a vertical post to truss at each cross point. Vertical posts longer than 6' to have lateral bracing so if the distance between the post end points and lateral bracing does not exceed 6'

DESIGN CONFORMS WITH OBC 2021
OCCUPANCY: RESIDENTIAL | PART
 $S_e = 31.3 \text{ psf}$ | $S_d = 8.4 \text{ psf}$

DESIGN LOADS:

DENOTES
CONVENTIONAL
FRAMING

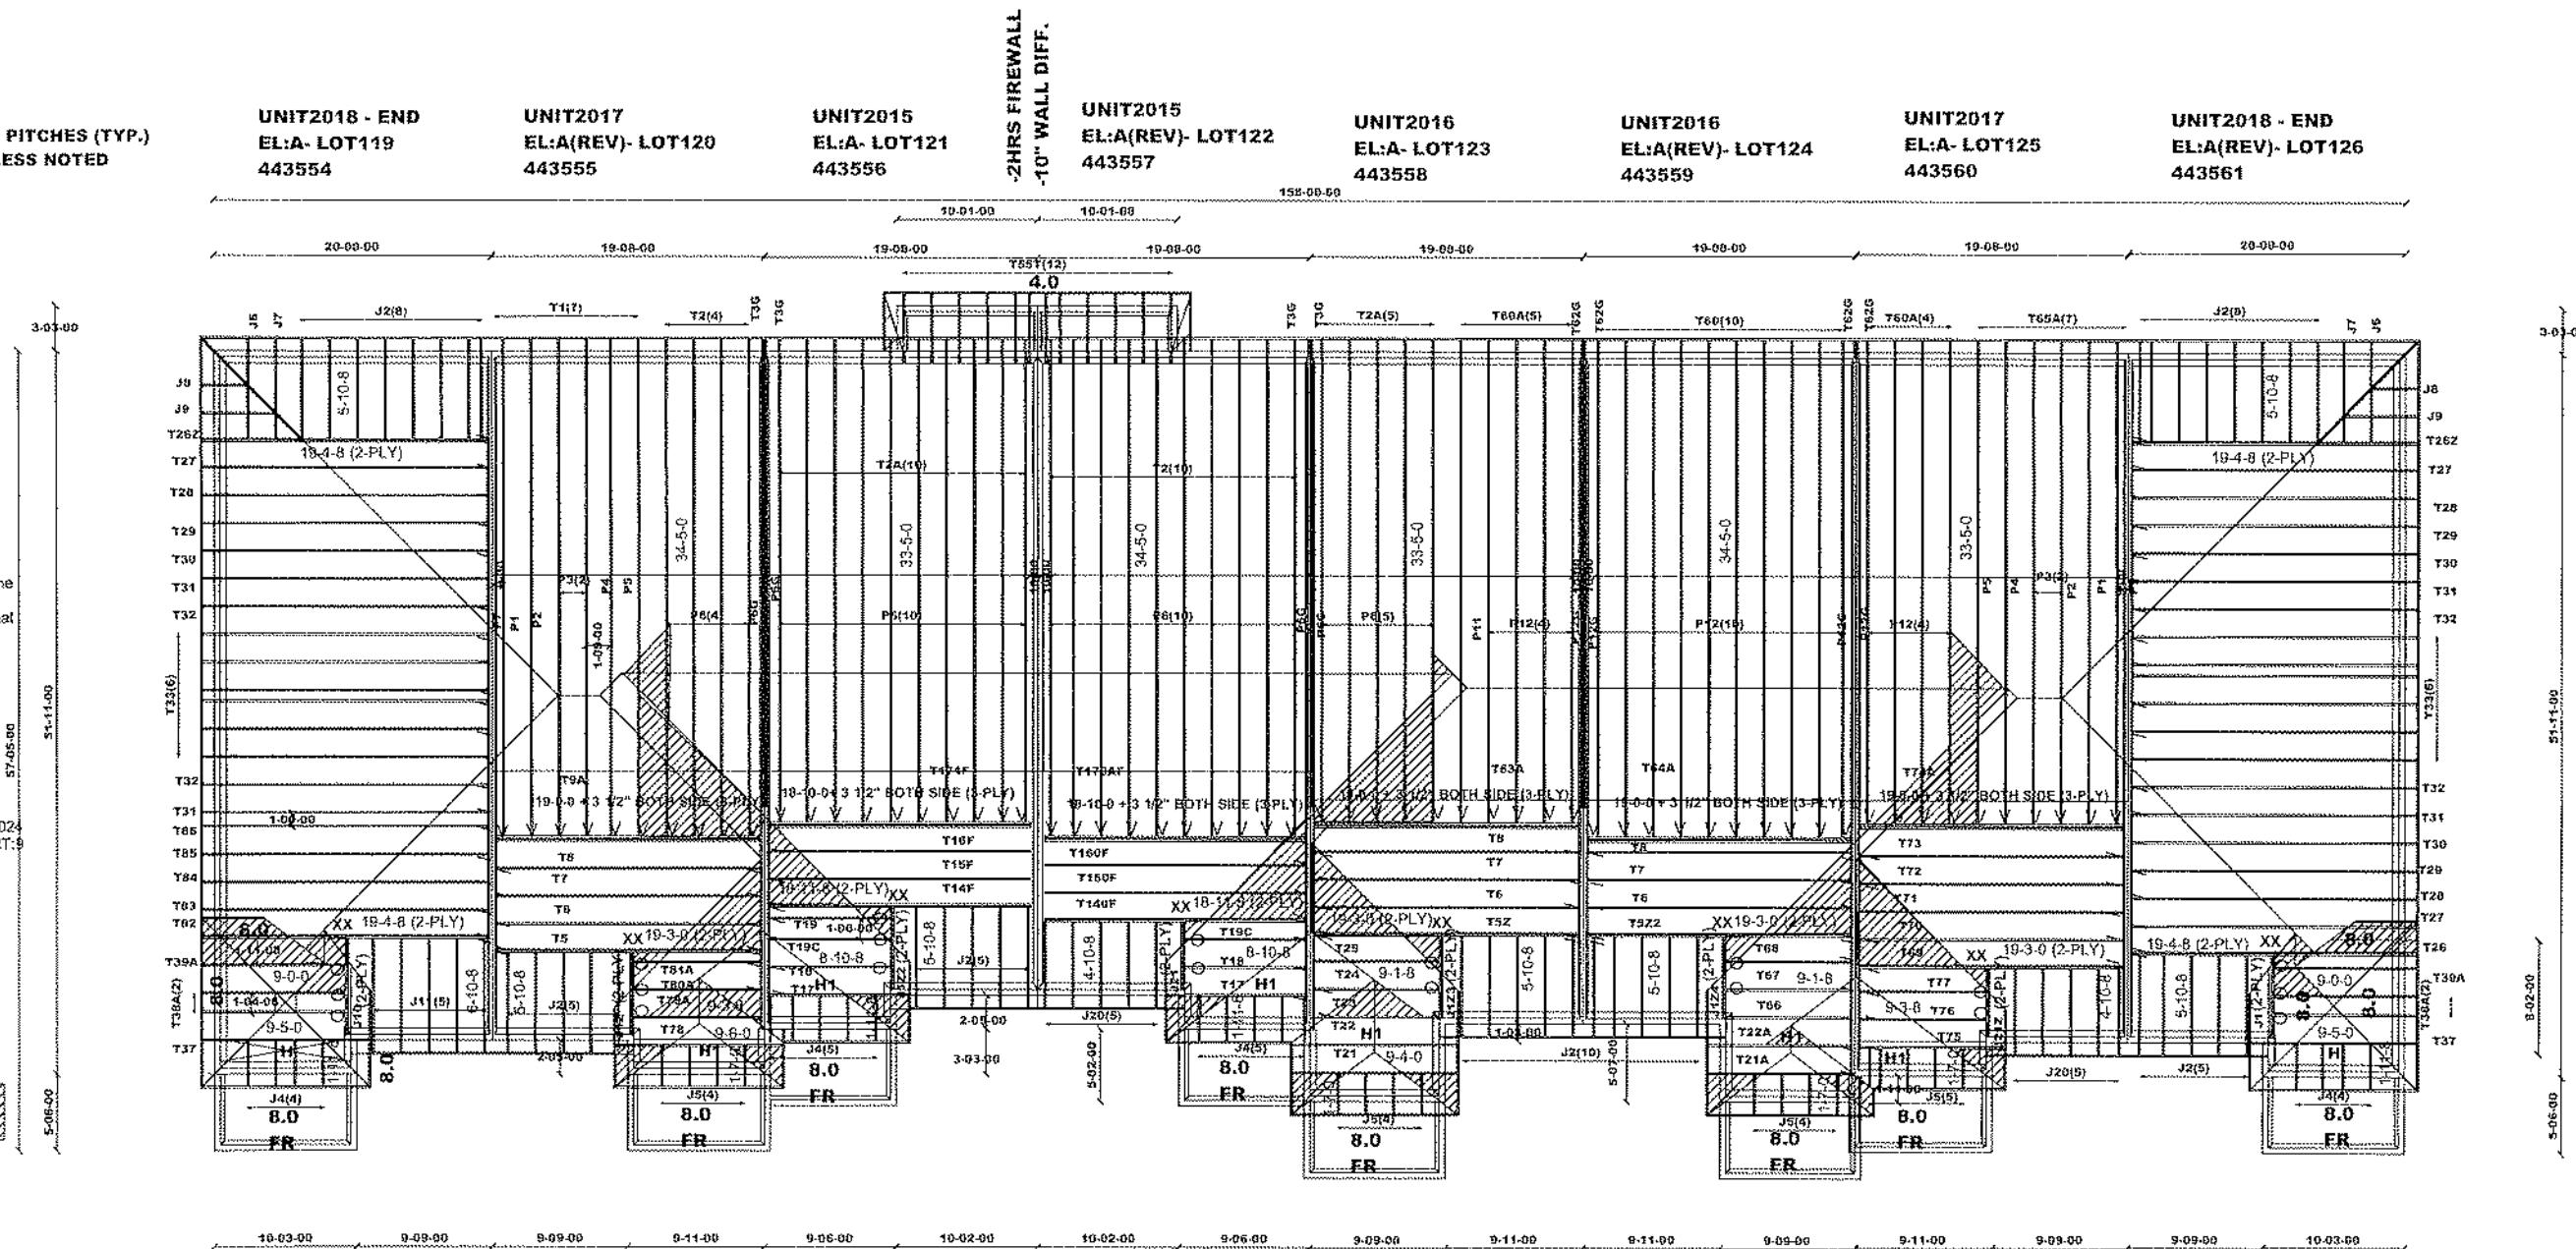

Job Track: **5394**
Plan Log: **2091**
Layout ID: **4435**

ROYAL PINE HOMES / RICHMOND HI


Model / Elevation

BLOCK19-UNITS119-120

Mitek ver 8.8.3.256

Project: FARI GI


THESE DRAWINGS CONSTITUTE THE PROPERTY OF TAMARACK ROOF TRUSSES INC., SHALL NOT BE REPRODUCED, PUBLISHED, OR
REDISTRIBUTED IN ANY MANNER OR UTILIZED FOR ANY PURPOSE OTHER THAN THE MANUFACTURE OF TRUSSES BY

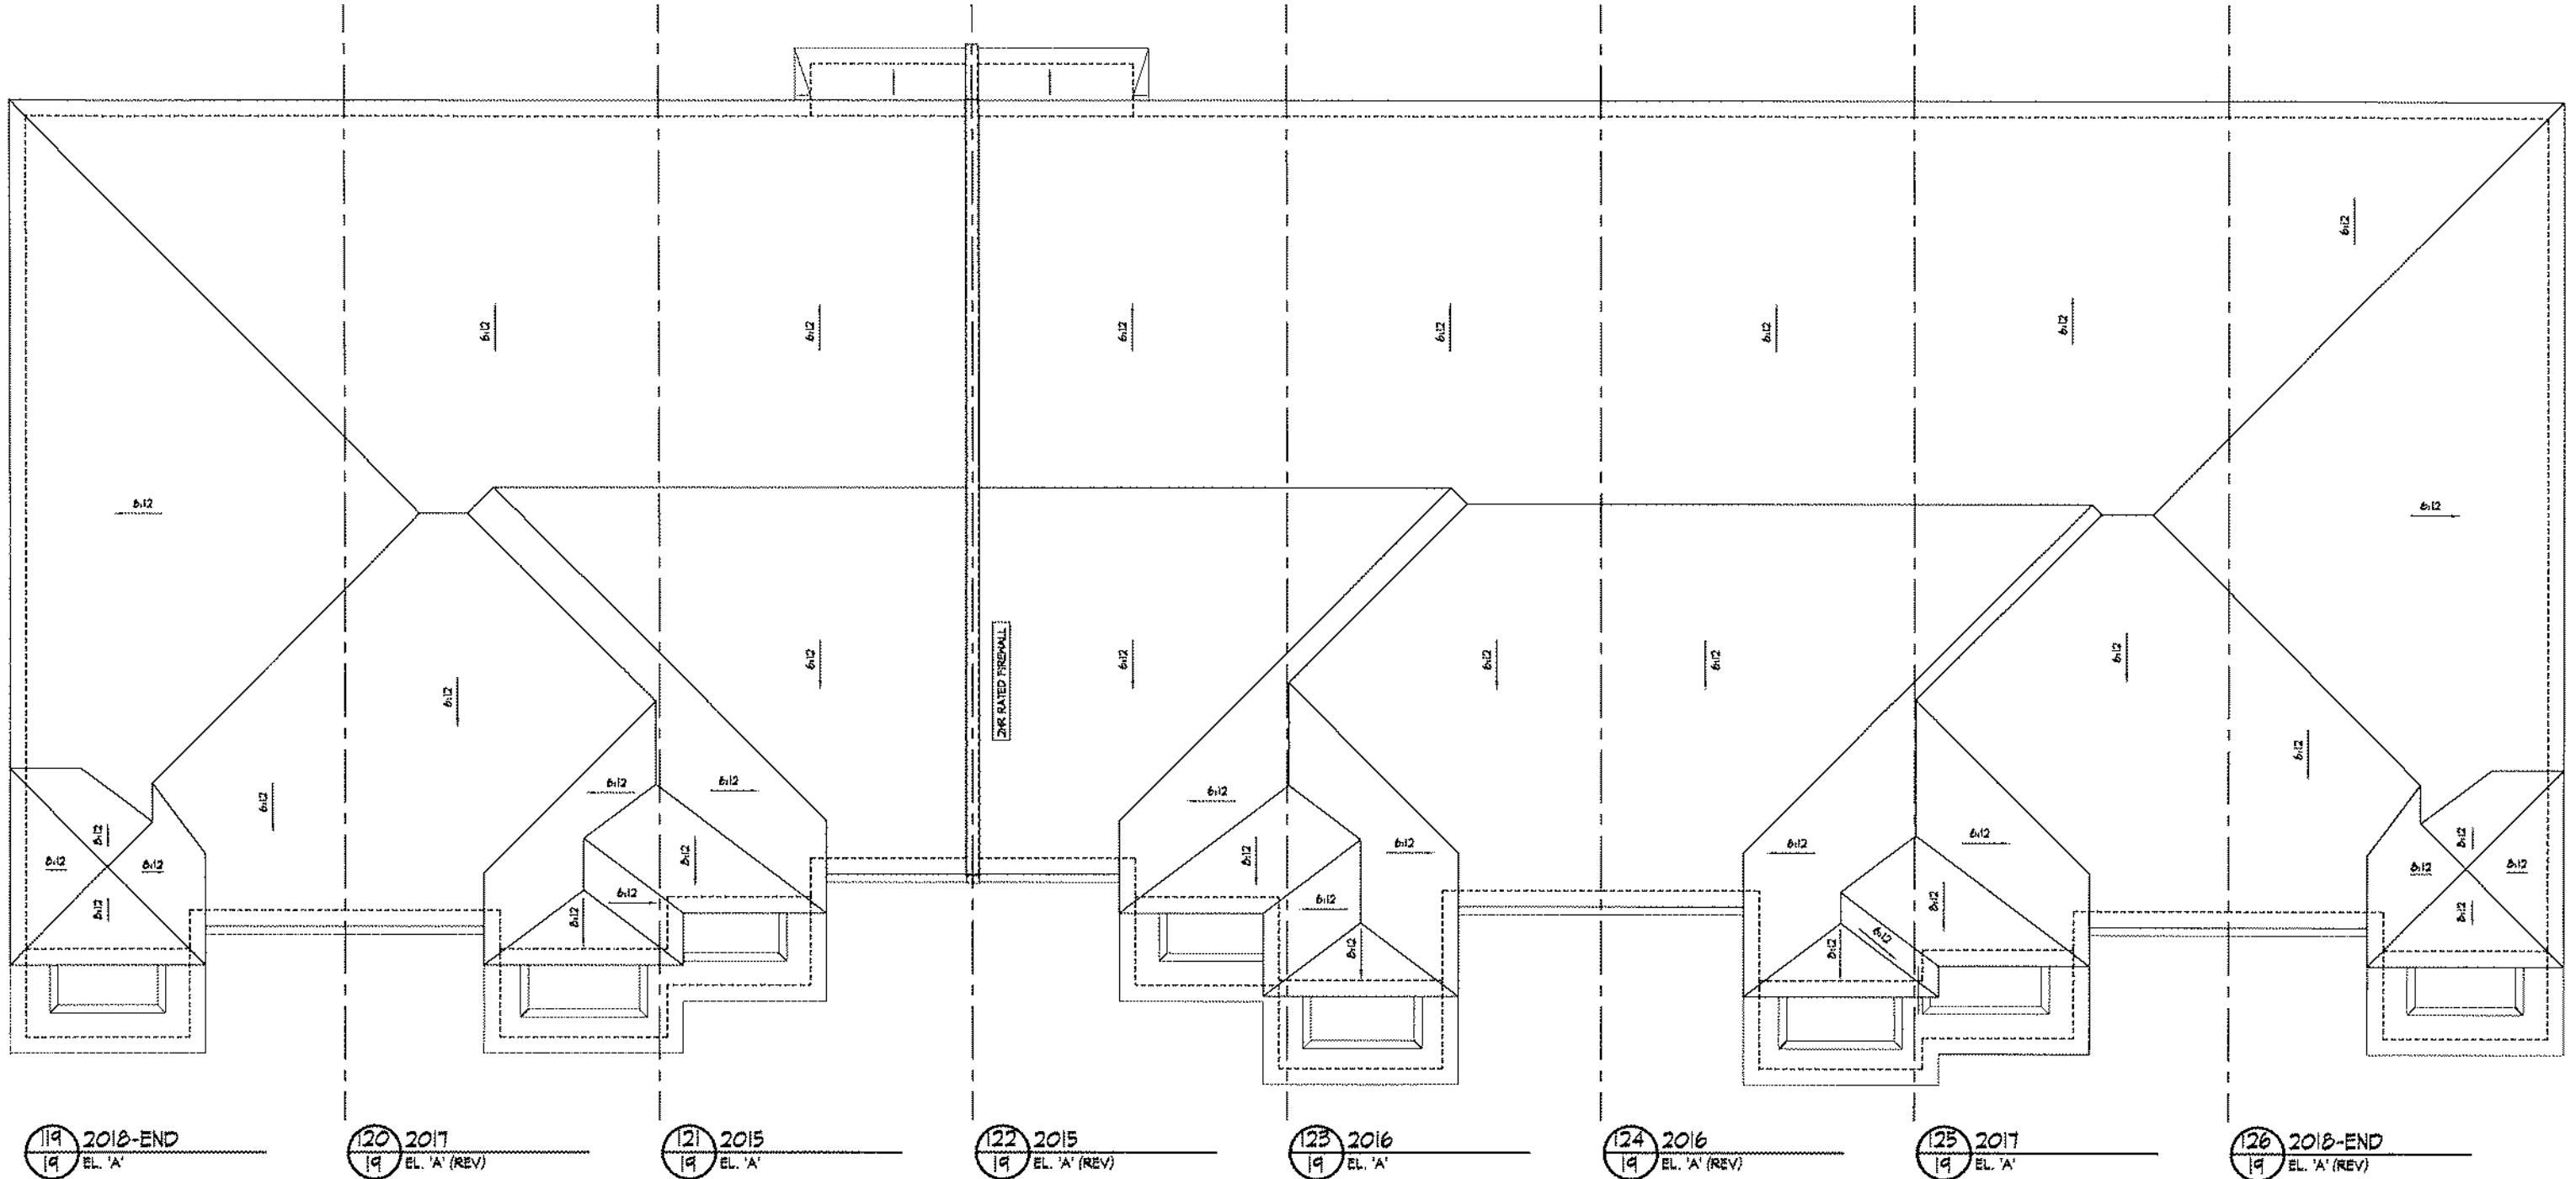



ROOF PLAN



BAYVIEW HEIGHTS RICHMOND HILL

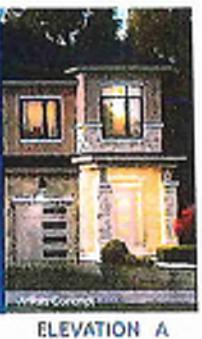

ELEVATION A

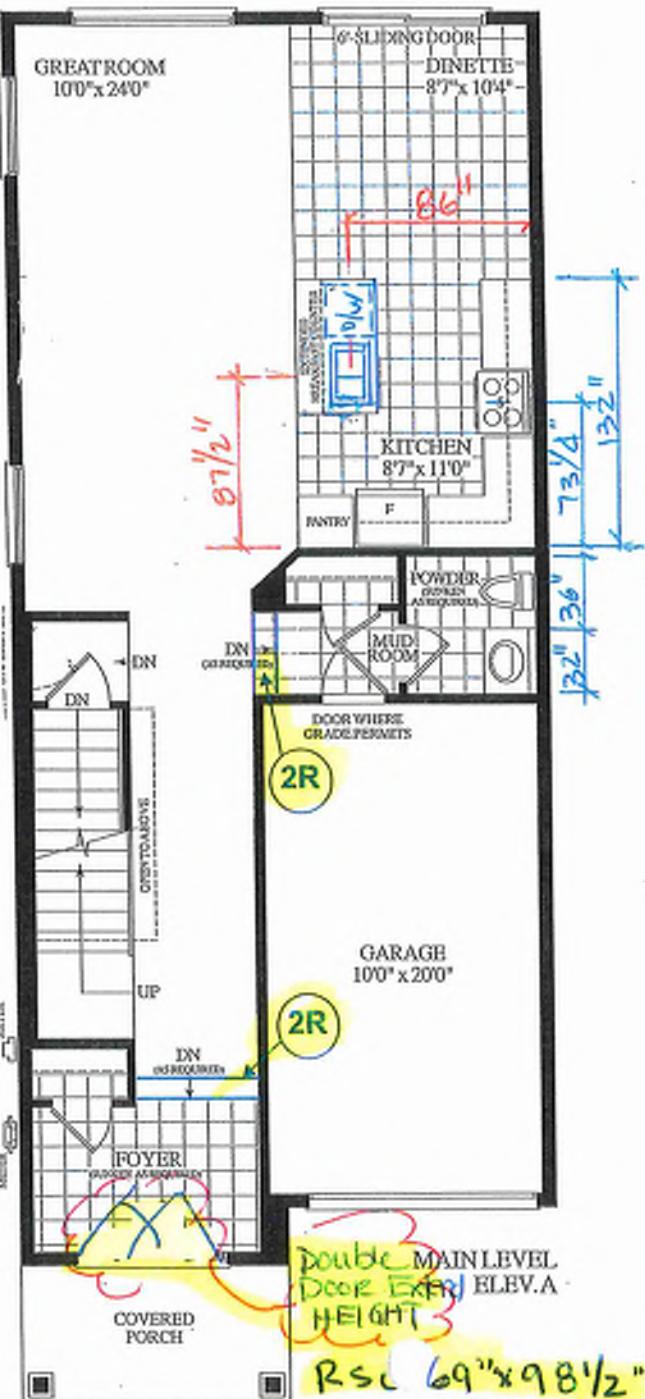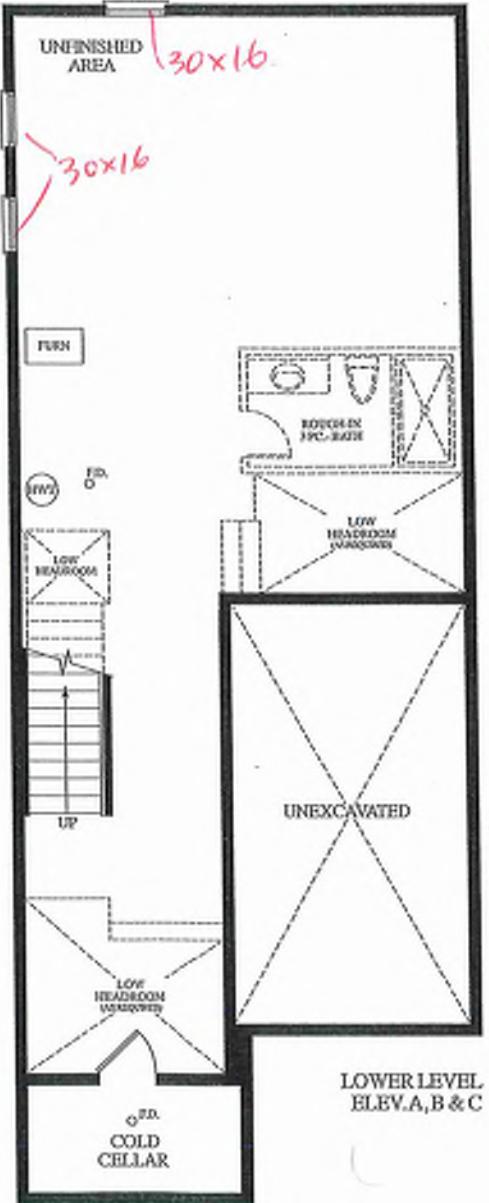


Materials, specifications and floor plans are subject to change without notice. All renderings are artist's concept. All floor plans are approximate dimensions. Actual usable floor space may vary from the stated floor area. E&OE.



BK 19-119

GROUND TO SECOND
122" HT 11-7/8" JOIST

BASEMENT TO GROUND
BSMT 11-7/8" JOIST

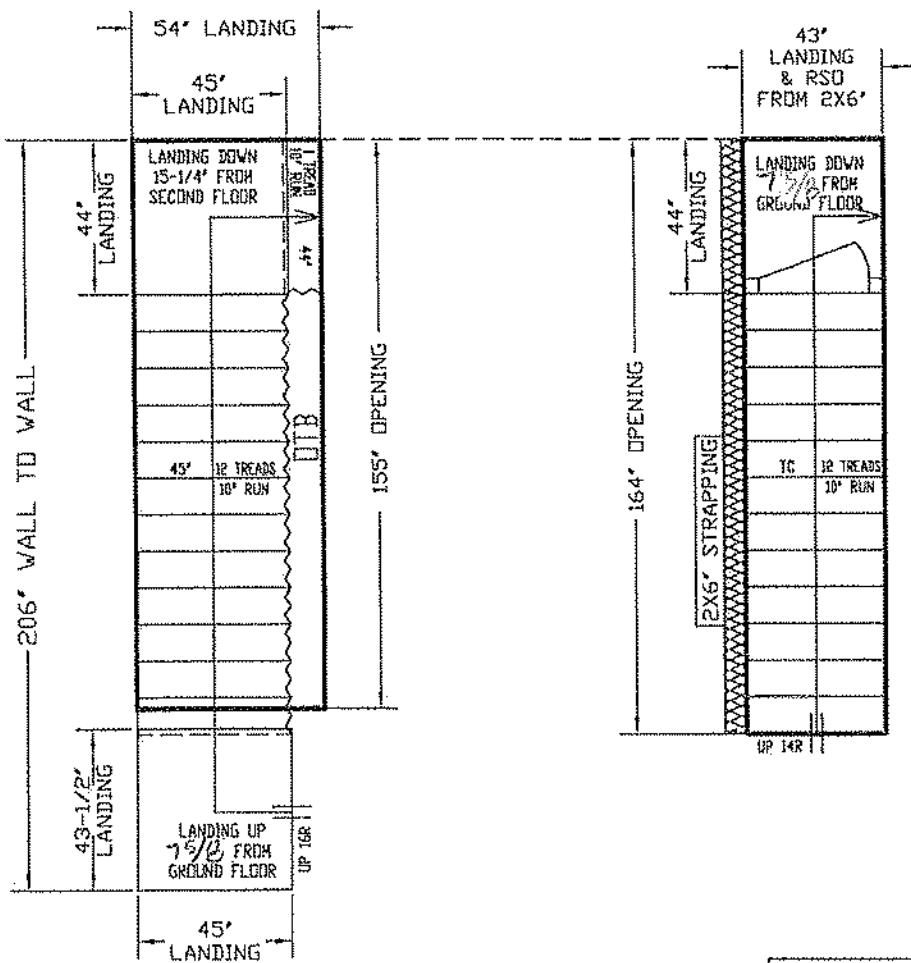

ALL OPENINGS ARE ALLOWED FOR 1 LAYER OF DRY WALL
ANY ADDITIONAL LAYERS MUST BE ALLOWED BY CARPENTERS

STAIRS LINE UP BY
THE EXTERIOR WALL



REVISED
JUNE 4, 2025

GARAGE RIGHT >



ALL LANDINGS TO BE SUPPLIED AND SUPPORTED BY OTHERS UNLESS SPECIFIED ABOVE
ANY STRAPPING ALLOWANCES TO BE COMPENSATED BY CARPENTERS
ALL STAIR DIMENSIONS MAY BE MODIFIED FROM ORIGINAL BLUE PRINTS OR SPECIFICATIONS AS SUPPLIED
TO ALPA STAIRS AND RAILINGS INC. MEASUREMENTS SHOWN ON LAYOUTS ARE REQUIRED TO
INSTALL OUR STAIRS. ANY PROBLEMS WITH DECKING OR STRAPPING ALLOWANCES, ALPA
STAIRS AND RAILINGS INC. WILL NOT BE RESPONSIBLE. STAIR LAYOUTS SHOULD BE CHECKED BY
CARPENTERS OR SITE SUPERVISORS TO MAKE SURE THERE ARE NO DISCREPANCIES BEFORE PROCEEDING
WITH CONSTRUCTION.

ALPA STAIRS AND RAILINGS INC.
3770 NASHUA DRIVE, UNIT 3 MISSISSAUGA, ONTARIO L4V 1H6
TEL: (905) 694-9556 | www.alpastairs.com

SITE		NAME		DATE
BAYVIEW HEIGHTS		DRAWN BY		PARAMEET
		MATERIAL		MAY 23, 2025
LOT #		CLIENT		
		ROYAL PINE HOMES		
Model		LAYOUT #		
UNIT 2018 END		SCALE		1:35

An architectural floor plan of a building section. The plan shows various rooms, walls, and structural elements. A specific area in the center-left is highlighted with dashed lines, indicating a section of "1/2" ENS. JOISTS". Other labels include "1/2" ENS. JOISTS" at the top left, "1/2" ENS. JOISTS" near the center, and "1/2" ENS. JOISTS" at the bottom right. There are also labels for "1/2" ENS. JOISTS" and "1/2" ENS. JOISTS" along the top edge. The plan includes dimensions such as 10'-0", 9'-0", and 8'-0". A circular symbol with "HAT 5" and "F.P.D." is present in the lower-left corner.

PART. BASEMENT
PLAN FOR NOT
SUNKEN MUDROOM
COND.

LADDER

$$\begin{array}{c} \text{LADDER} \\ \text{44"} \\ \text{7 1/2"} \end{array}$$

A hand-drawn technical diagram of a structural frame. The vertical height is labeled "22' 6"". The horizontal distance between columns is labeled "22' 6"". The width of the frame is labeled "22' 6"". The label "Walls" is written vertically on the right side. A vertical dimension line on the left indicates a height of "26'".

Preliminary
NOT FINAL April 22 2025

It is the builder's complete responsibility to ensure that all plans submitted for approval fully comply with the Architectural Guidelines and all applicable regulations and requirements including zoning provisions and any provisions in the subdivision agreement. The Contractor is not responsible in any way for examining or approving site (grading) plans or working drawings when related to any zoning or building code or permit matter or that any house can be properly built or located on the site.

REFER TO FLOOR JOIST MANUFACTURER'S DRAWINGS FOR LAYOUT, SPACING, BLOCKING & STRAPPING REQUIREMENTS. INSTALLATION DETAILS AND HANGER SIZES. SUBFLOOR THICKNESS	APPROX. LOCATION OF FURNACE AND HOT WATER TANK	PROVIDE SOLID WOOD BLOCKS @ 24" O.C. NOR FIRST 12" SPAN WHEN PARALLEL TO EXTERIOR WALL
--	--	---

Digitized by srujanika@gmail.com

四

HUNT II
DESIGN ASSOCIATES INC.

www.huntedesign.com

ROYAL PINE HOMES - 218094

BAYVIEW, RICHMOND HILL, ON.

MNEDS 3/16/10

UNIT 2018-END

HEV: Z030;50;2/


WT2018-END

Preliminary
NOT FINAL April 22 2025

NOT FINAL April 22 2025

100

四
九

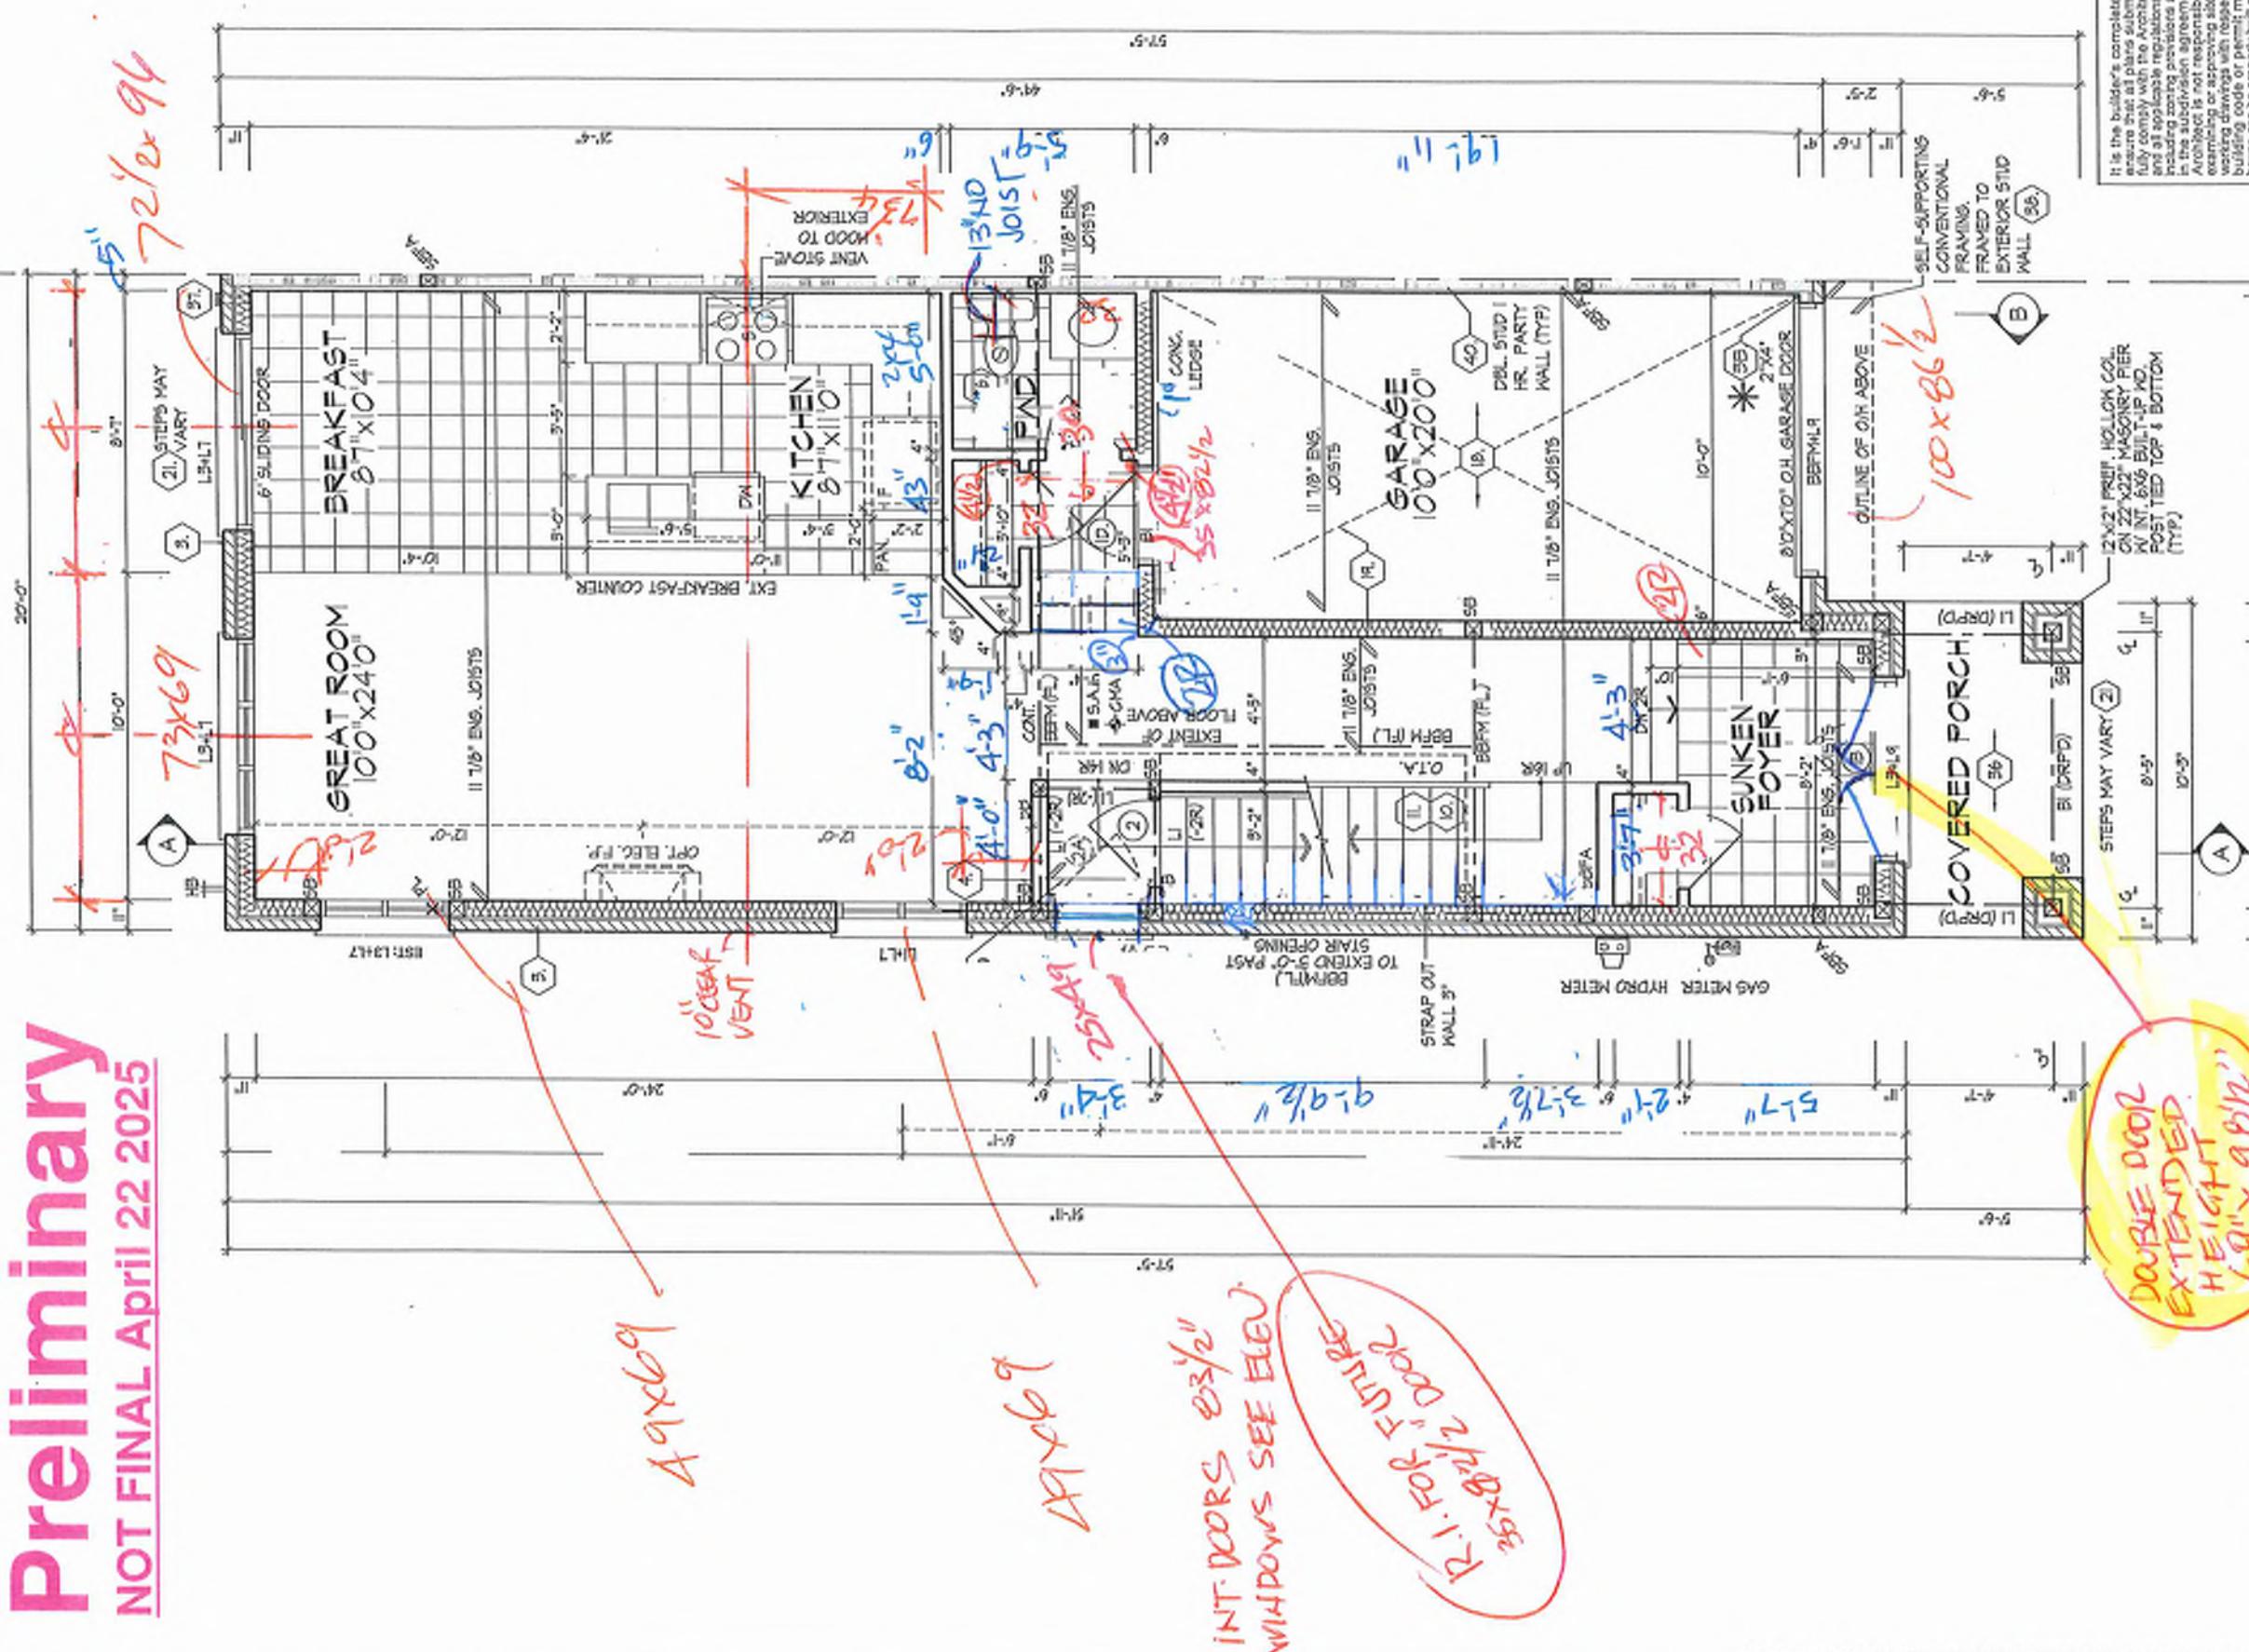

<p>2x4 STUD WALL ASSEMBLY EXC EDITION</p> <p>MAX. UNSUPPORTED HEIGHT:</p> <ul style="list-style-type: none"> - FOR WALLS GREATER THAN 9'-0" TO MAX 12'-0" HIGH, ADD FLOOR LOAD, DOUBLE UP EVERY STUD @ 16" O.C. - IN FLOOR LOAD DOUBLE UP EVERY STUD @ 12" O.C. - PROVIDE BLOCKING EVERY 4'-0" O.C. VERTICAL. 	<p>ALL DOORS ON PLAN ARE 1'-0" HIGH TOP OF FRAME, UNLESS LABELED OTHERWISE.</p>
<p>* MANUFACTURER'S DRAWINGS FOR LAYOUT, SPACINGS, BLOCKING & STRAPPING</p>	<p>PROVIDE SOLID WOOD BLOCKING @ 24" O.C. FOR FIRST JOIST SPAN WHEN PARALLEL W EXTERIOR WALL</p>

This is to certify that these plans comply with the applicable Architectural Design Guidelines approved by the City of RICHMOND HILL.

ROYAL P

HUNT

DESIGN ASSOCIATES INC.
www.huntdesign.ca

REV.2025.03.27

Page Number

卷之三

卷之六

PART. SECTION B ELEVATION 'A'

UNIT 2018-END
REV.2025.03.27


Page Number
17 of 31

Buk 19-119

ROYAL PINE HOMES - 218094
921 BAYVIEW, RICHMOND HILL, ON.


Drawn By
MM/DS 3/16=1'-0"
Checked By
KM/T 216034WT2018-END
File Number
F 905.737.5133 F 905.737.7326

It is the builder's complete responsibility to ensure that all plans submitted for approval fully comply with the Architectural Guidelines and all applicable regulations and requirements including zoning provisions and any provisions in the subdivision agreement. The Control Architect is not responsible in any way for examining or approving site (lot) plans or working drawings with respect to any zoning or building code or permit matter or that any house can be properly built or located on its lot. This is to certify that these plans comply with the applicable Architectural Design Guidelines approved by the City of RICHMOND HILL.

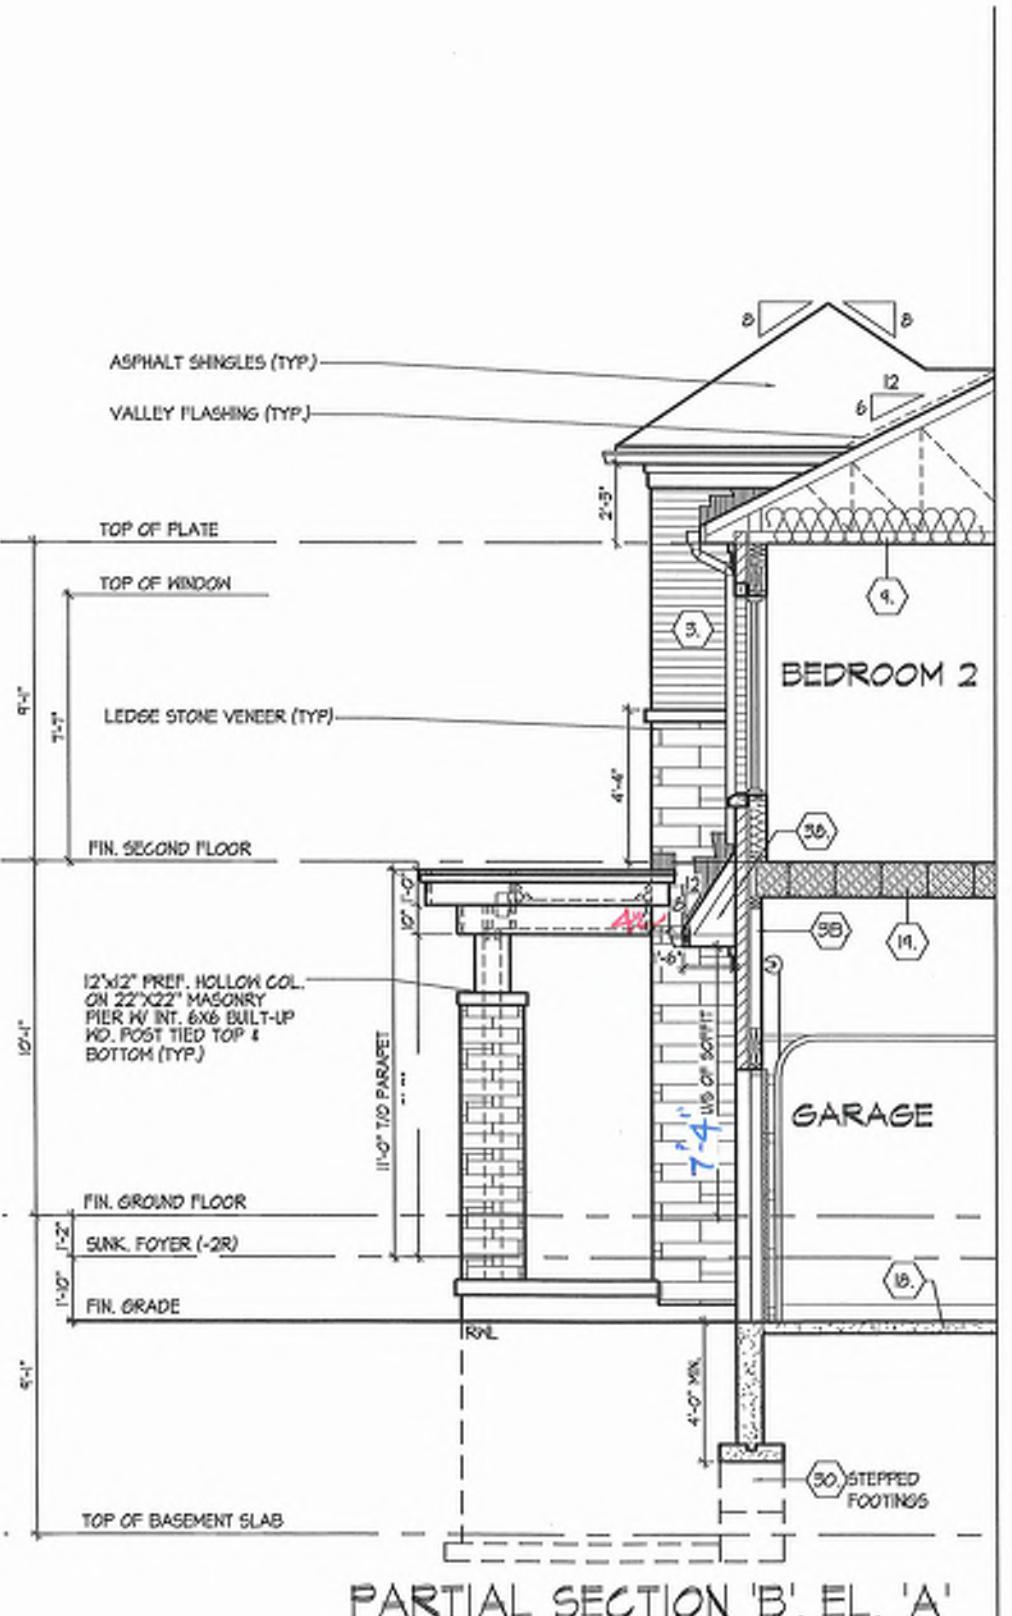

Preliminary
NOT FINAL April 22 2025

NOT FINAL April 22, 2025

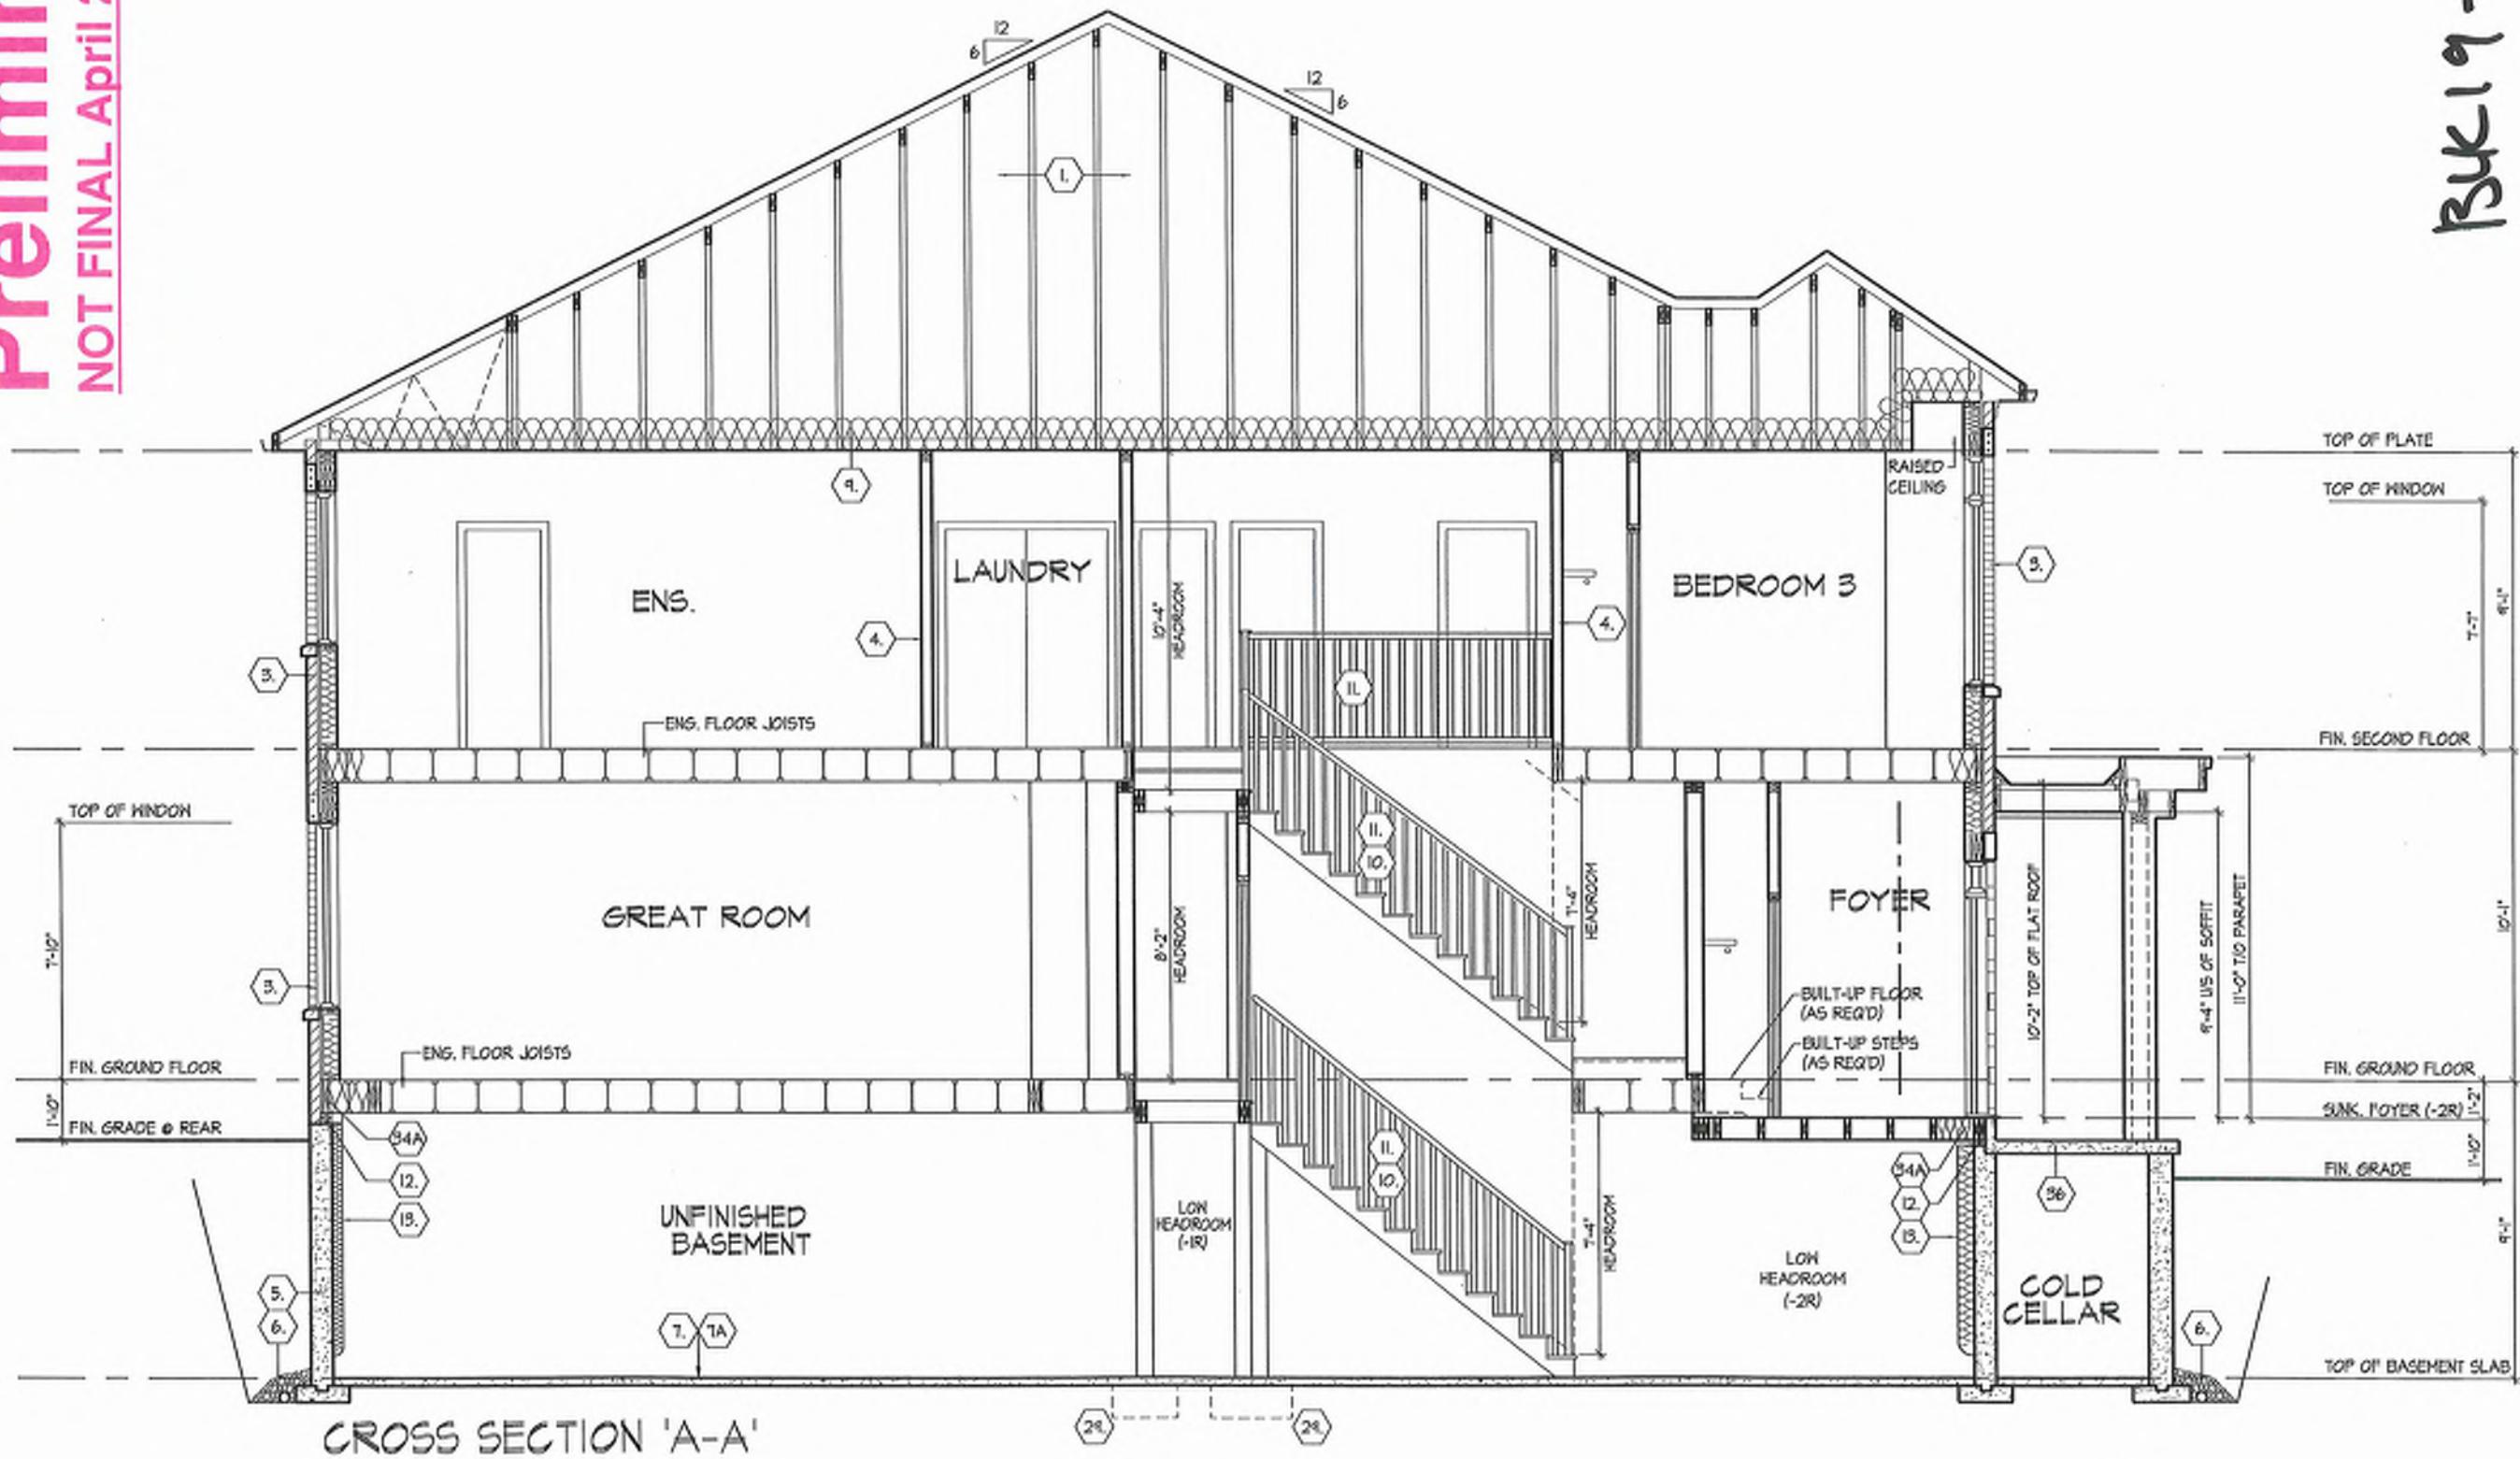

CROSS SECTION A-A		UNIT 2018-END		REV.2025.03.27	
ROYAL PINE HOMES - 218094					
921 BAYVIEW, RICHMOND HILL, ON.					
HUNT		Drawn By	Checked By	Re. Number	Page Number
Dominic Modolo	21274	KM/T	MM/DS	3116*-1-0*	28 of 31
REGISTRATION INFORMATION	904746	DESIGN ASSOCIATES INC.			
HUNT DESIGN ASSOCIATES INC.	19896				
		8866 Woodbine Ave., Markham, ON L3R 0J7		218094/WT2018-END	
		www.hundesign.ca		HUNT DESIGN ASSOCIATES INC. Assumes re. responsibility or liability for this property until it bears the appropriate B.C.R.N. number and original signature.	

SECTION 1.0. CONSTRUCTION NOTES

REFER TO SB-112 ENERGY EFFICIENCY DESIGN MATRIX ON THE TITLE PAGE FOR ALL VALUES AS REQUIRED PER 3.1.1, 3.1.2, 3.1.3, OF THE O.B.C..

ROOF CONSTRUCTION [§ 19, § 23, 14, § 23, 16]

-

THE UNDERSIGNING HAS REVIEWED AND TAKES RESPONSIBILITY FOR THIS DESIGN AND PAS THE QUALIFICATIONS AND MEETS THE REQUIREMENTS SET OUT IN THE CONTRACT DOCUMENTS AND IS FULLY CODED TO BE A PROPOSED



REV.2025.03.27

Page Number
File Number
Page of Page

卷之三



BAYVIEW HEIGHTS
RICHMOND HILL

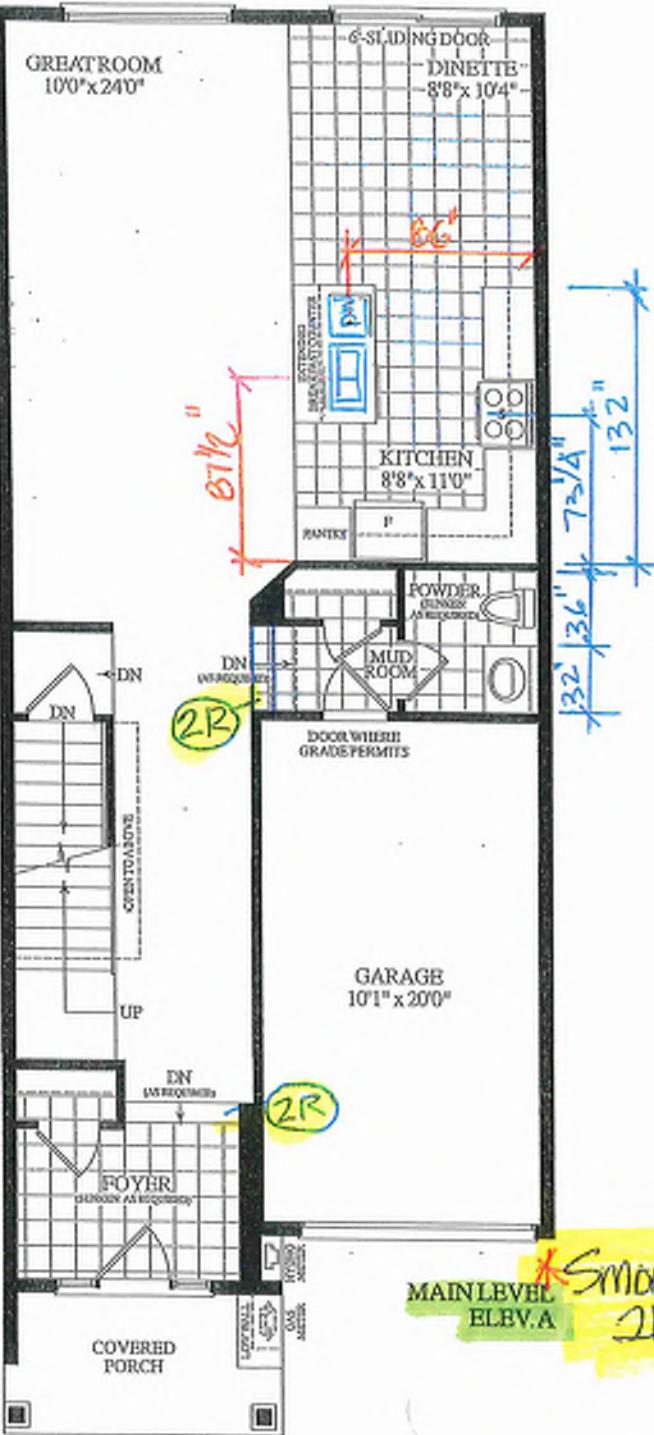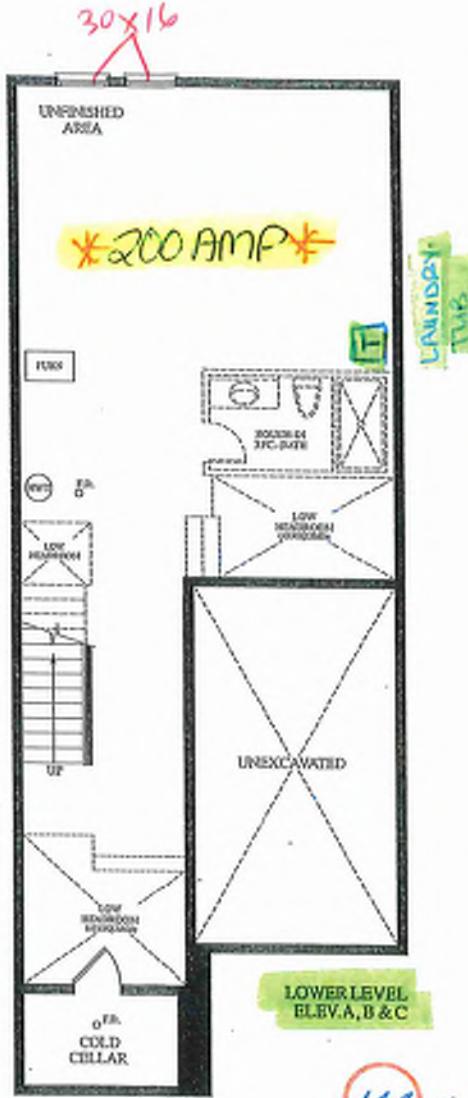



Materials, specifications and floor plans are subject to change without notice. All renderings are artist's concept. All floor plans are approximate dimensions. Actual usable floor space may vary from the stated floor area. E&OE.



BLK.19 TH. 120 20-17 THE DIANA EL. A 4 BDRM. 2 BATH. 1780 SQ.FT.


BK 19-120

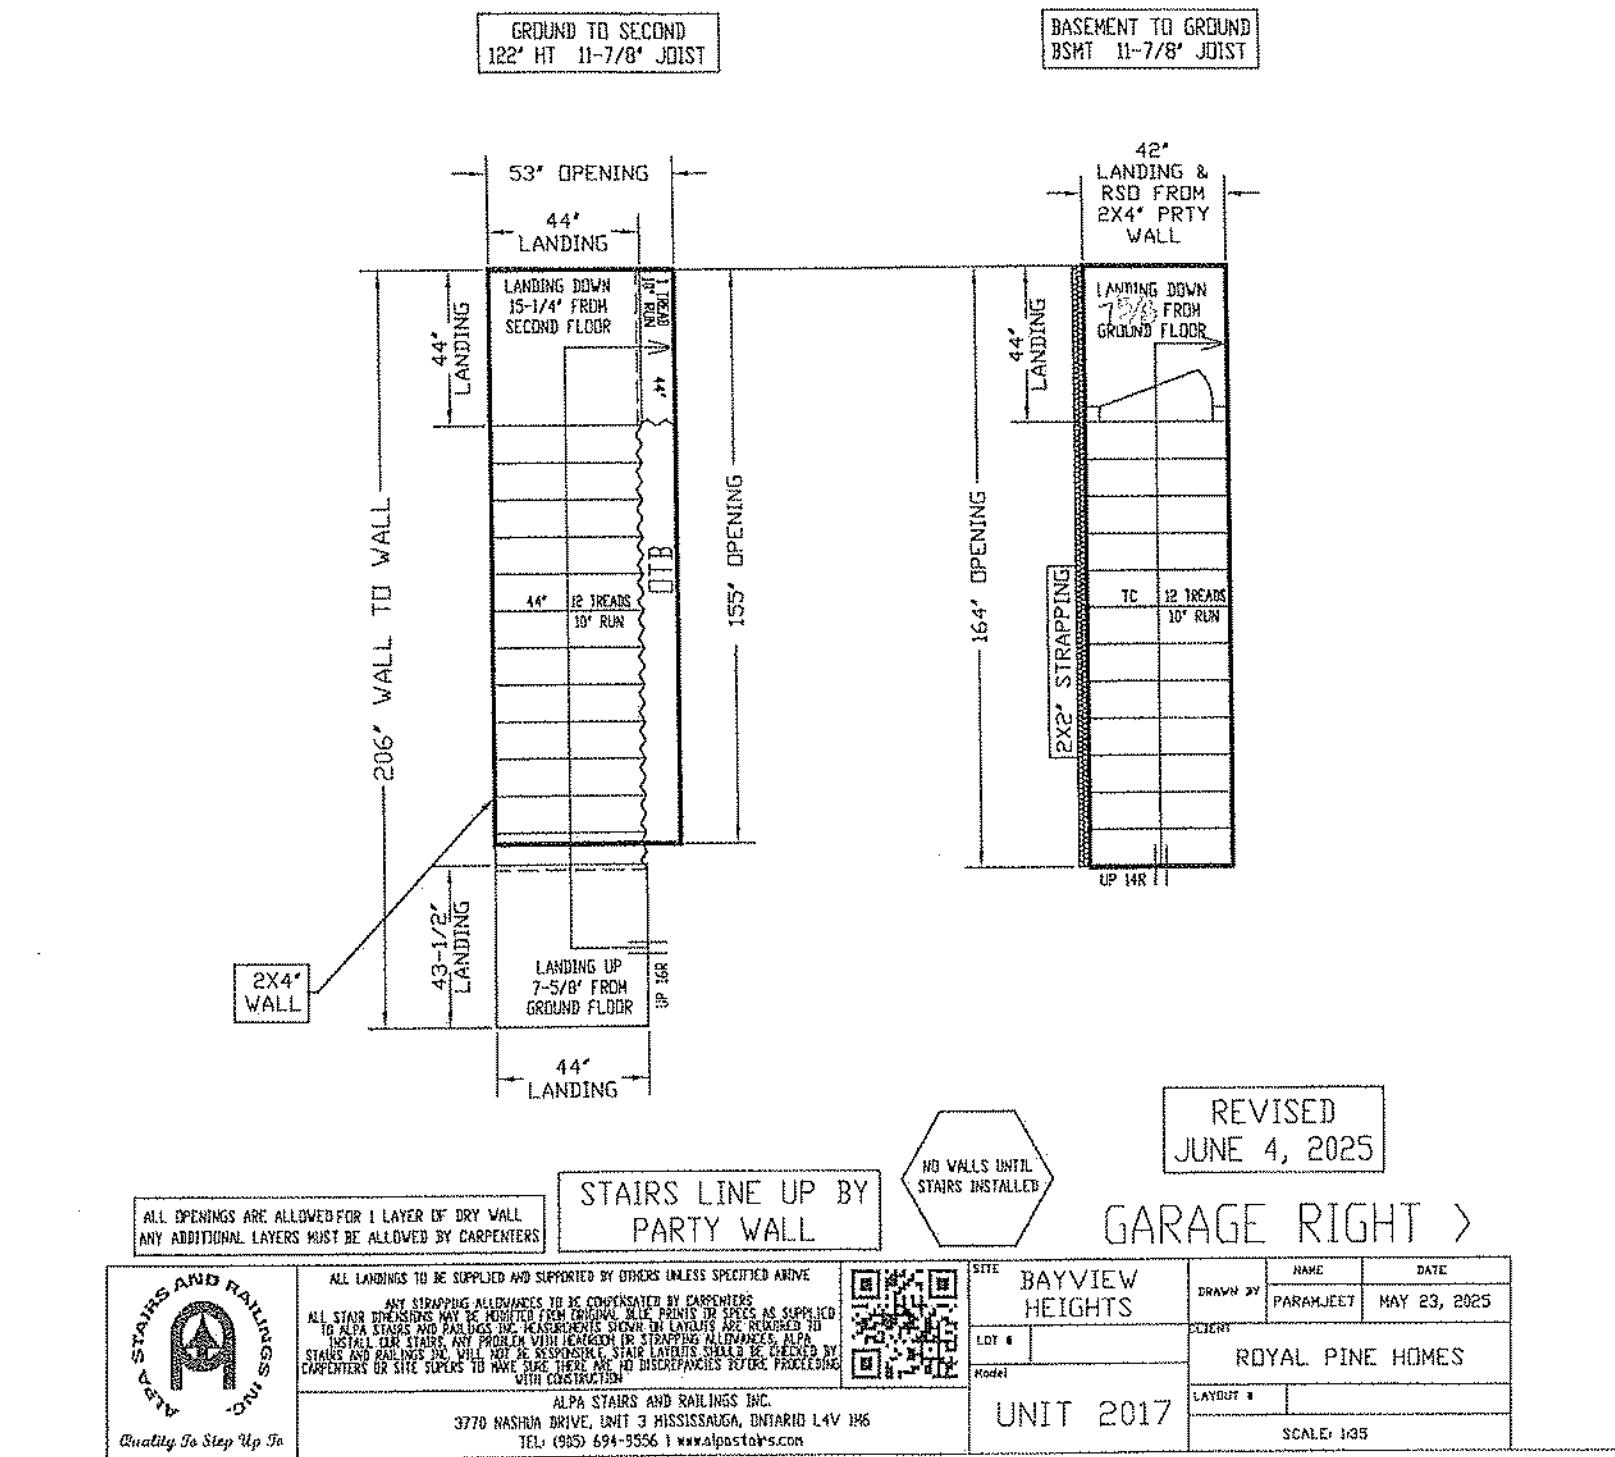

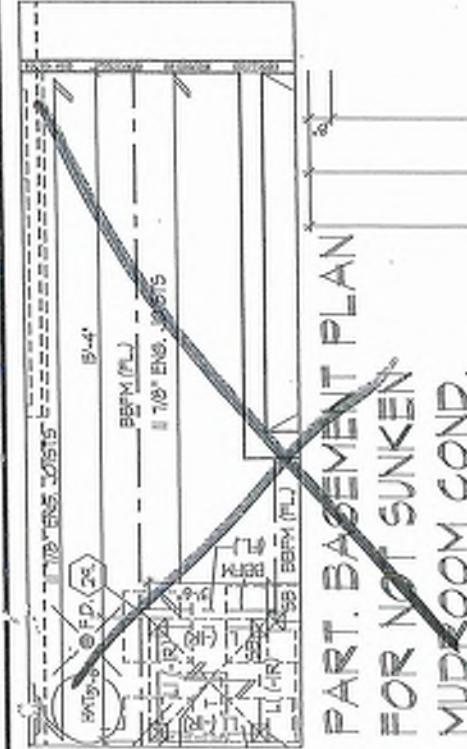

Preliminary

NOT FINAL April 22 2025

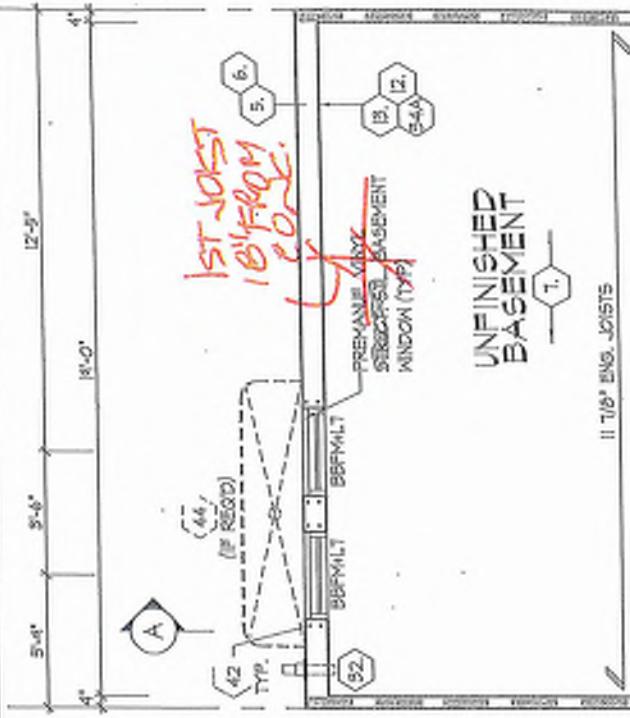

REFER TO FLOOR JOIST MANUFACTURER'S DRAWINGS FOR LAYOUT, SPACING, BLOCKING & STRAPPING REQUIREMENTS, INSTALLATION DETAILS AND HANGER SIZES, 4" SUBFLOOR THICKNESS

APROX. LOCATION OF MURKIN AND HOT WATER TANK
PROVIDE SOLID WOOD BLOCKS @ 24" O.C. FOR FIRST JOIST SPAN WHEN PARALLEL IN EXTERIOR WALL

CHECK FOUNDATION NAIL FOR PORCH SLAB ABOVE.

OUTLINE OF GAS AND HYDRO PANEL LOCATION, WALL FOR OH. GAS METER ABOVE.

PROVIDE PVC, VENT W/NEED SCREEN FOR COLD CELLAR

AS RECD.

It is the builder's complete responsibility to ensure that all plans submitted for approval fully comply with the Architectural Guidelines and all applicable regulations and requirements including zoning provisions and any provisions in the subdivision agreement. The Consultant Architect is not responsible in any way for accuracy or completeness of the (dated) plans or working drawings, specifications, or any building plans or contracts. Any changes or revisions can be proposed by the client on the site.

This is to certify that these plans comply with the applicable Architectural Design Guidelines approved by the City of Richmond Hill.


BUC 19-120

ROYAL PINE HOMES - 218094
921 BAYVIEW, RICHMOND HILL, ON.
DRAWN BY: KMW/T
CHECKED BY: DSMM
APPROVED BY: KMW/T
DATE: 21/09/2017
REV: 2025.03.26

HUNT

DESIGN ASSOCIATES INC.
www.huntassociates.ca

All drawings, specifications, related documents and design are the copyright property of Hunt Design Associates Inc. Reproduction of this property in whole or in part is strictly prohibited without H.D.A.'s written permission. H.D.A. assumes no responsibility or liability for this property unless it bears the original date, SOR number and original signature.

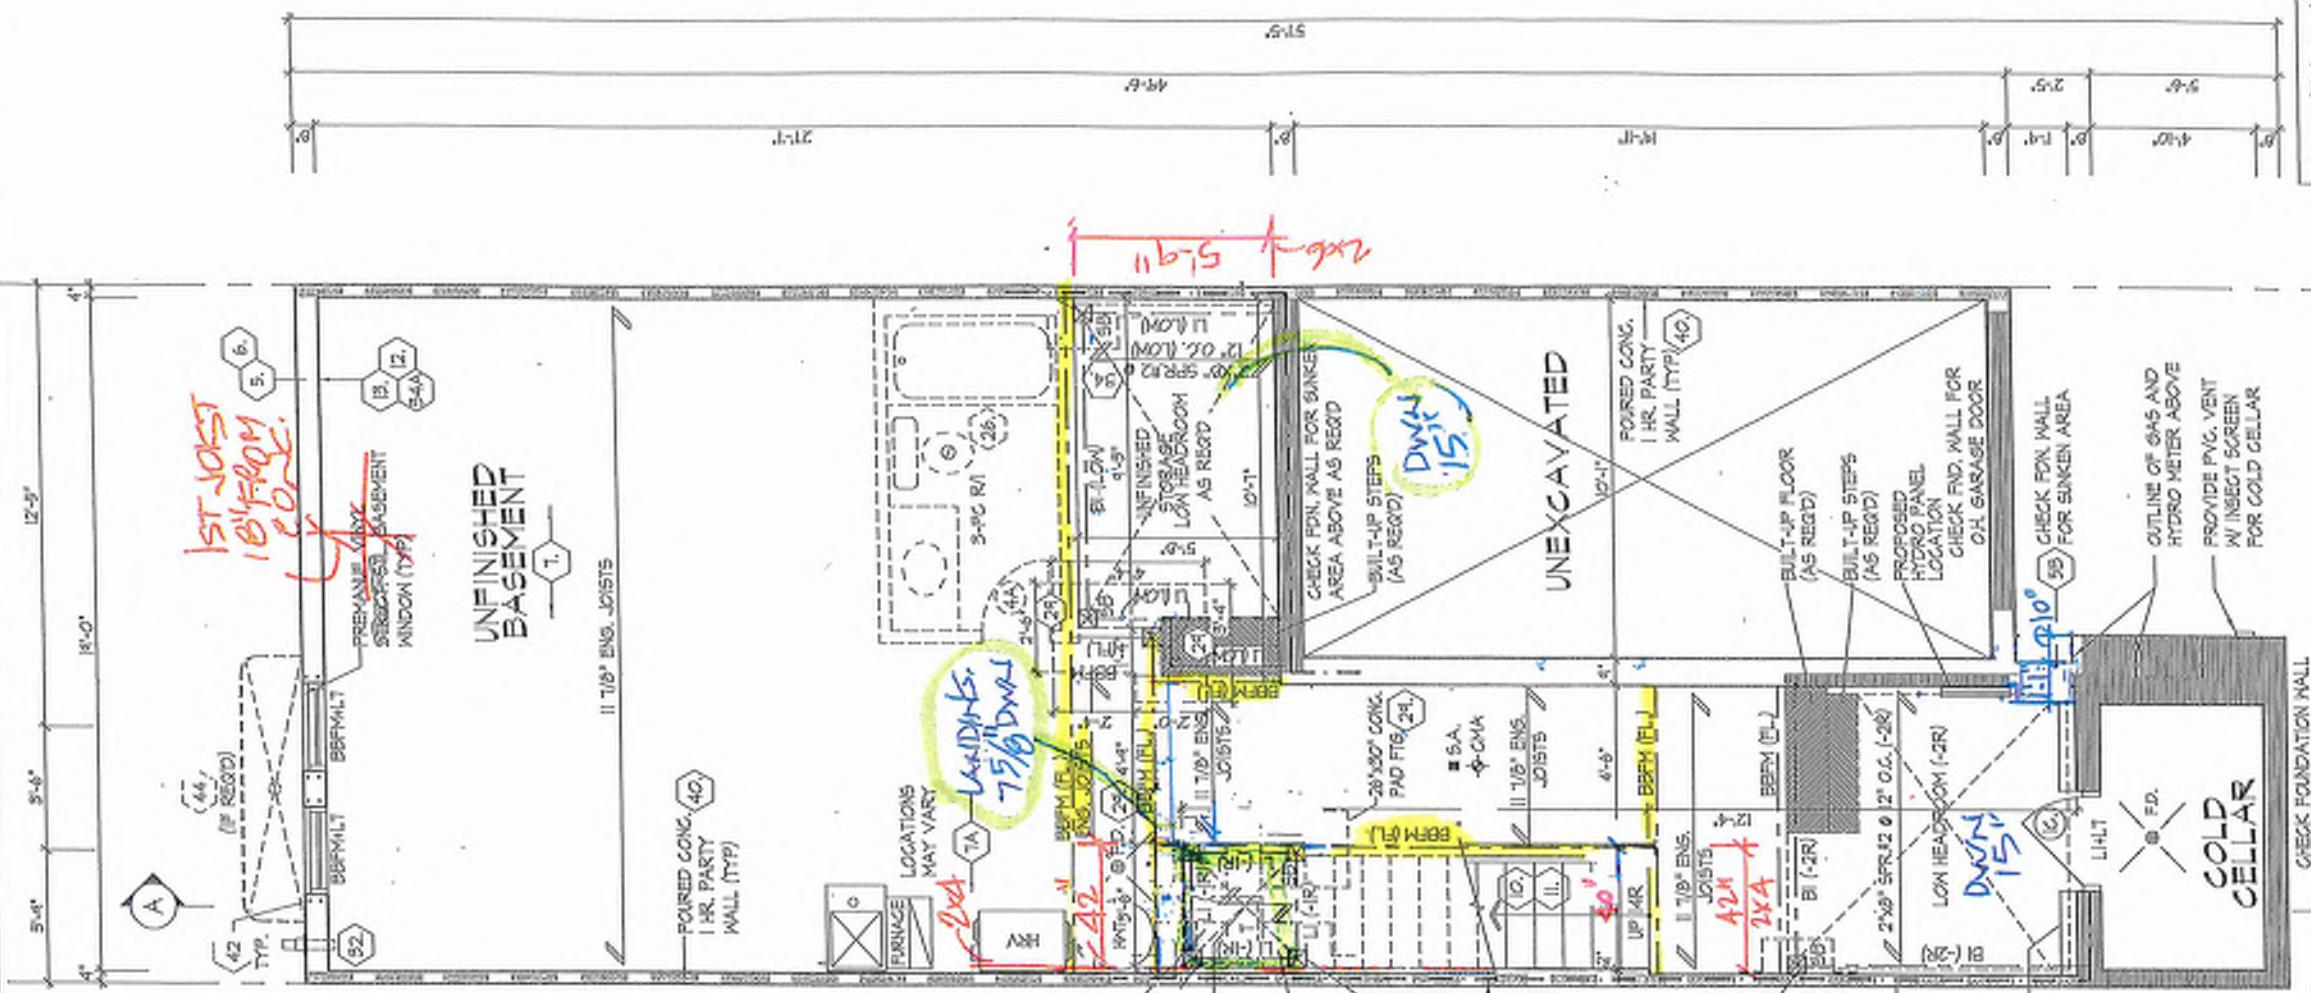


It is the builder's complete responsibility to ensure that all plans submitted for approval fully comply with the Architectural Guidelines and all applicable regulations and requirements including zoning provisions and any provisions in the subdivision agreement. The Consultant Architect is not responsible in any way for accuracy or completeness of the (dated) plans or working drawings, specifications, or any building plans or contracts. Any changes or revisions can be proposed by the client on the site.

This is to certify that these plans comply with the applicable Architectural Design Guidelines approved by the City of Richmond Hill.

BASEMENT PLAN, ELEV. 'A', 'B' & 'C'
UNIT 2017
REV.2025.03.26

Folio Number
2 of 27
File Number
2118094/VT2017

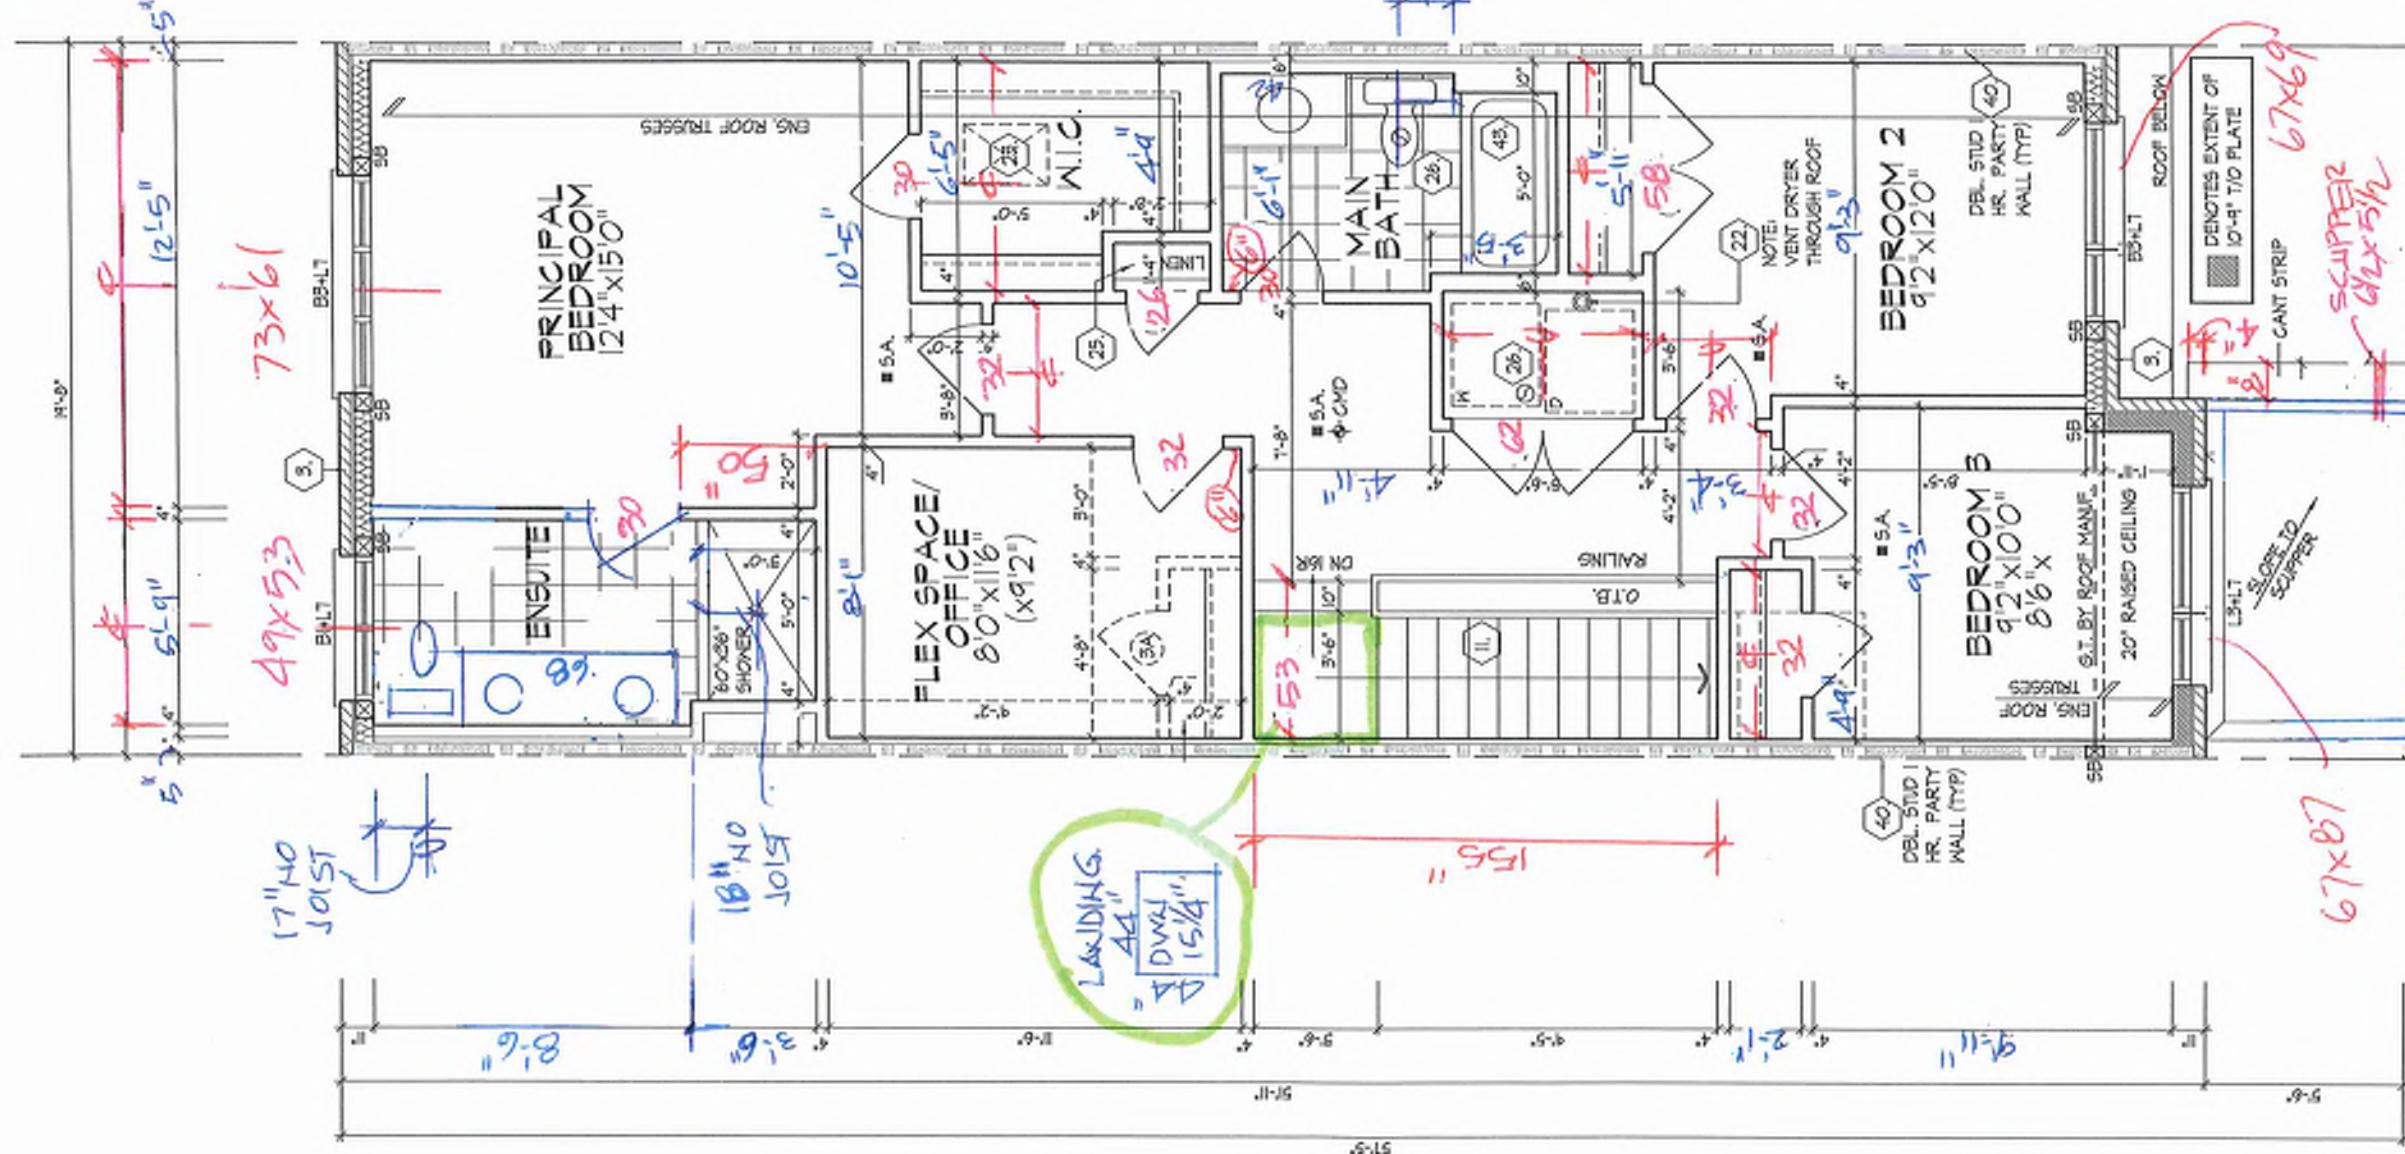

REFER TO ROOF TRUSS
MANUFACTURER'S DRAWINGS
FOR LAYOUT, SPACINGS,
INSTALLATION DETAILS AND
HANGER SIZES.

This is to certify that these plans comply with the Applicable Architectural Design Guidelines approved by the City of RICHMOND HILL.

OPT. SECOND FLOOR PLAN,
EL. 'A' W/ FLEX SPACE

(EL, B) ∈ C(S|M|LAR)

PK 19-120

Preliminary

NOT FINAL April 22 2025

ROOF PLAN EL. 'A' N.T.S.



ROOF OVERHANGS TO BE 12"
UNLESS NOTED OTHERWISE

OUTLINE OF RAISED
CEILING BEYOND

TOP OF PLATE

TOP OF WINDOW

35° PRECAST CONG.
HEADER (TYP)

95° CONT. PRECAST
CONG. SILL (TYP)

ALUM. GLADING
W DRIP EDGE

FIN. SECOND FLOOR

12'x12' PREF. HOLLOW COL. ON
22"x22" MASONRY PIER W INT.
6x6 BUILT-UP WD. POST TIED
TOP & BOTTOM (TYP.)

10" PRECAST

10" TO PARAPET

STONE VENEER (TYP)

FIN. GROUND FLOOR

SUNK FOYER

FIN. GRADE

15'

POURED CONG. DOOR SILL
4 PORCH SLAB (TYP.)

POURED CONC. FOUNDATION
WALLS & FOOTINGS (TYP.)

TOP OF BASEMENT SLAB

NOTE:
WHEN UNIT REVERSED KEEP
FIXED GLASS GARAGE
DOOR PANES LEFT

NOTE:
WHEN UNIT REVERSED KEEP
SIDE 24"x60" WINDOW LEFT

6:12

ASPHALT SHINGLES (TYP.)

VALLEY FLASHING
(TYP.)

PREFIN. ALUM. GUTTER,
RNL, FASCIA BD. &
VENTED SOFFIT (TYP.)

3 1/2" ALUMINUM GLAD
PROFILED
FRIEZE BOARD (TYP.)

FACE BRICK (TYP.)

35° PRECAST
CONG. SILL (TYP.)

PREFIN. MTL. FLASHING
W CAULKING TO MATCH
MASONRY COLOUR (TYP.)

SCUPPER

RNL

18" OVERHANG

18:12

COACH LAMP (TYP.)

ADDRESS PLAQUE (TYP.)

10" PRECAST CONG.
HEADER (TYP.)

7 1/4"

US OF SOFFIT

8"

100

FG

UPGRADED REAR ELEVATION 'A' & PART. SECTION B, EL. 'A'


ROYAL PINE HOMES - 218094
921 BAYVIEW, RICHMOND HILL, ON.


UNIT 2017
REV 2025.03.26

Page Number
15 of 27

File Number
218094WVT2017
F 805.737.5133

This building is constructed in accordance with the Building Act, 2000 and the Building Code of Ontario. It is the responsibility of the builder to ensure that all plans are submitted to the appropriate authority for approval and to comply with the applicable guidelines and requirements including zoning provisions and any provisions in the subdivision agreement. The Contractor is not responsible in any way for examining or approving site (existing) plans or working drawings with respect to any zoning or building code or permit matter or that any house on the property built or located on its lot. This is to verify that these plans comply with the applicable Architectural Design Guidelines approved by the City of RICHMOND HILL.

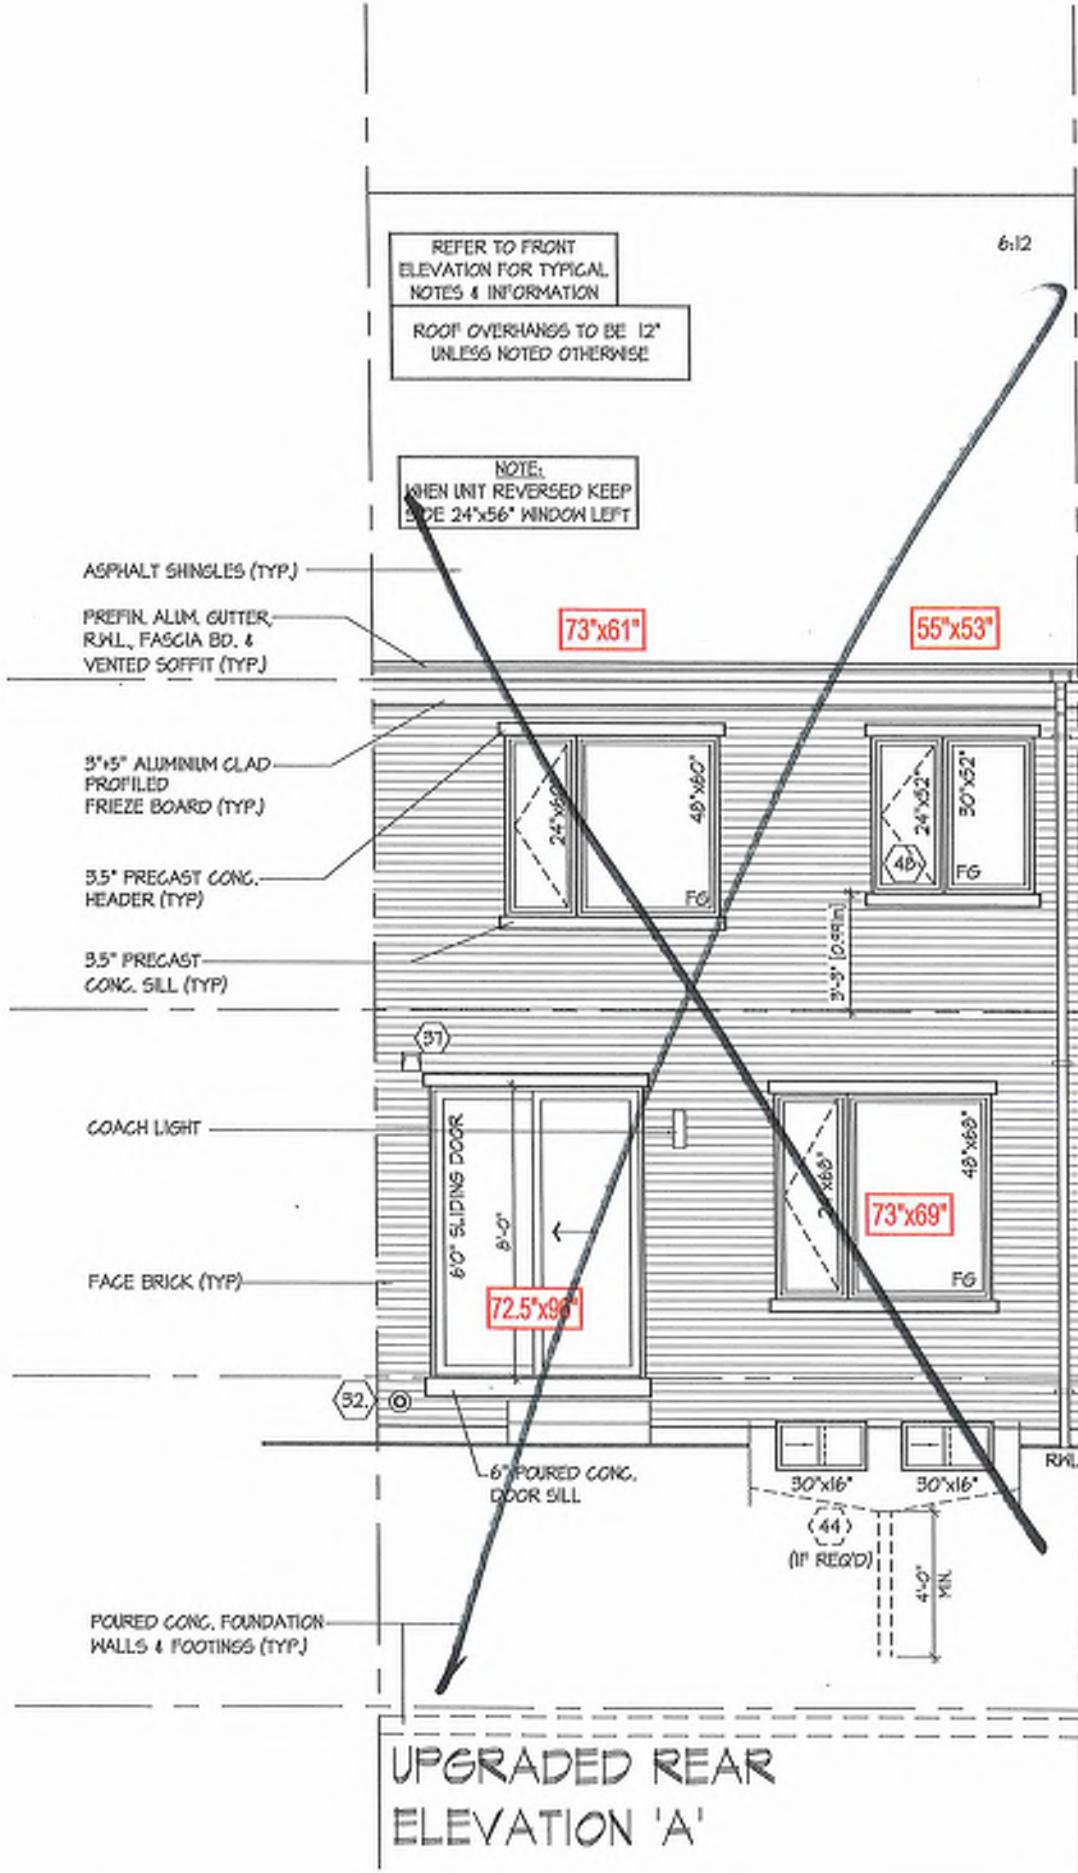


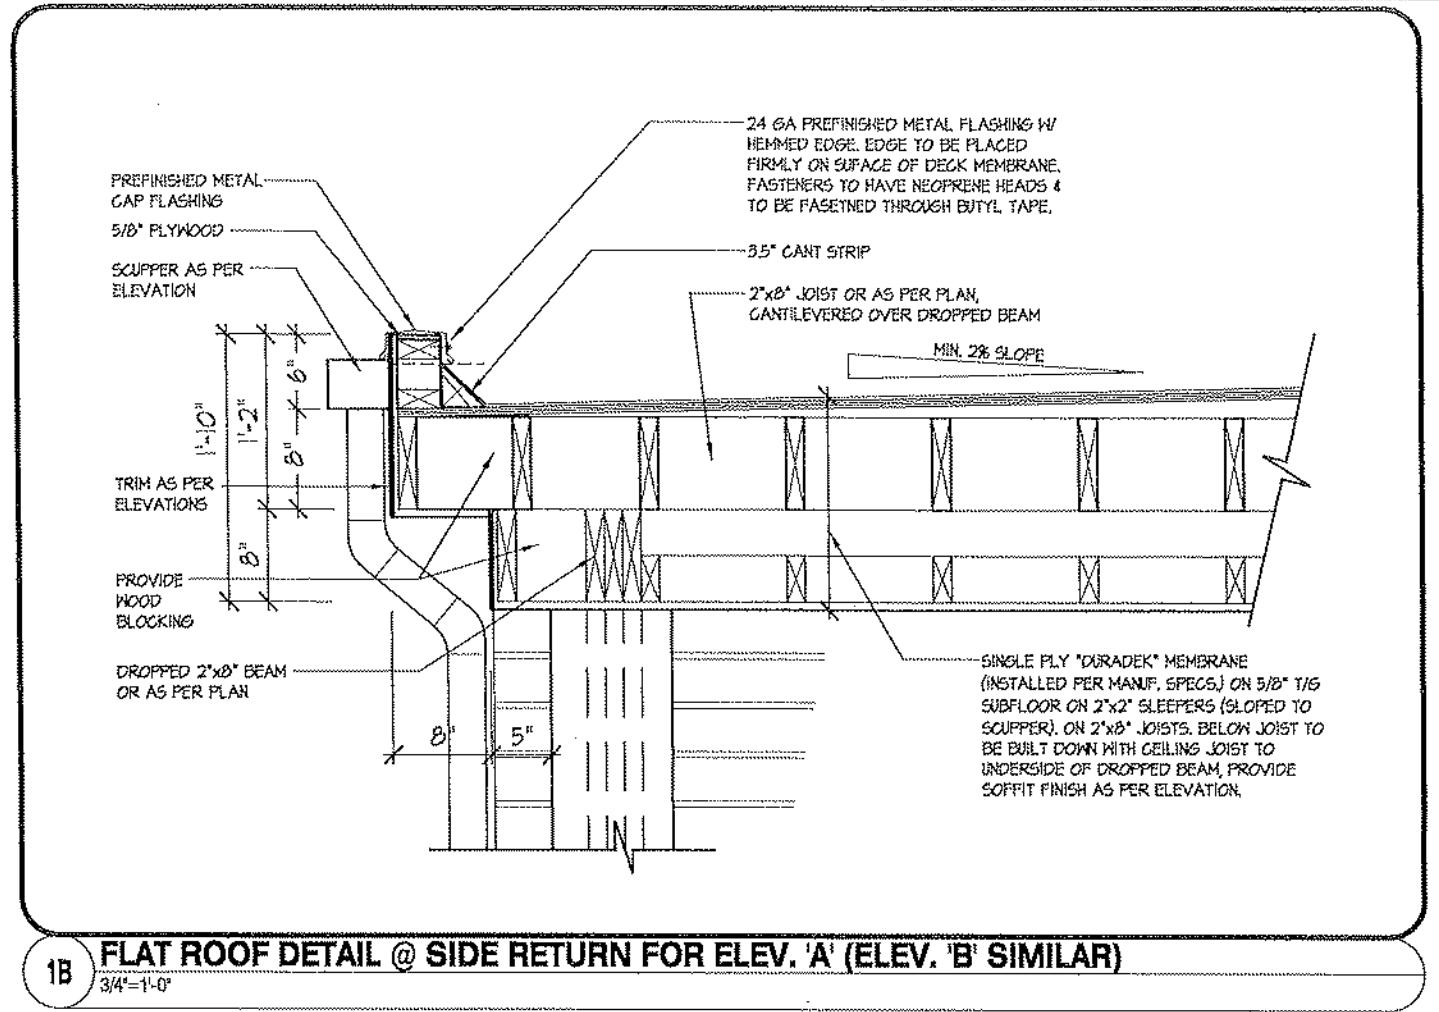

FLAT ROOF DETAIL @ SIDE RETURN FOR ELEV. 'A' (ELEV. 'B' SIMILAR)

$$3/4^{\circ} = 11.25^{\circ}$$


$$3/4^{\circ} = 11.25^{\circ}$$

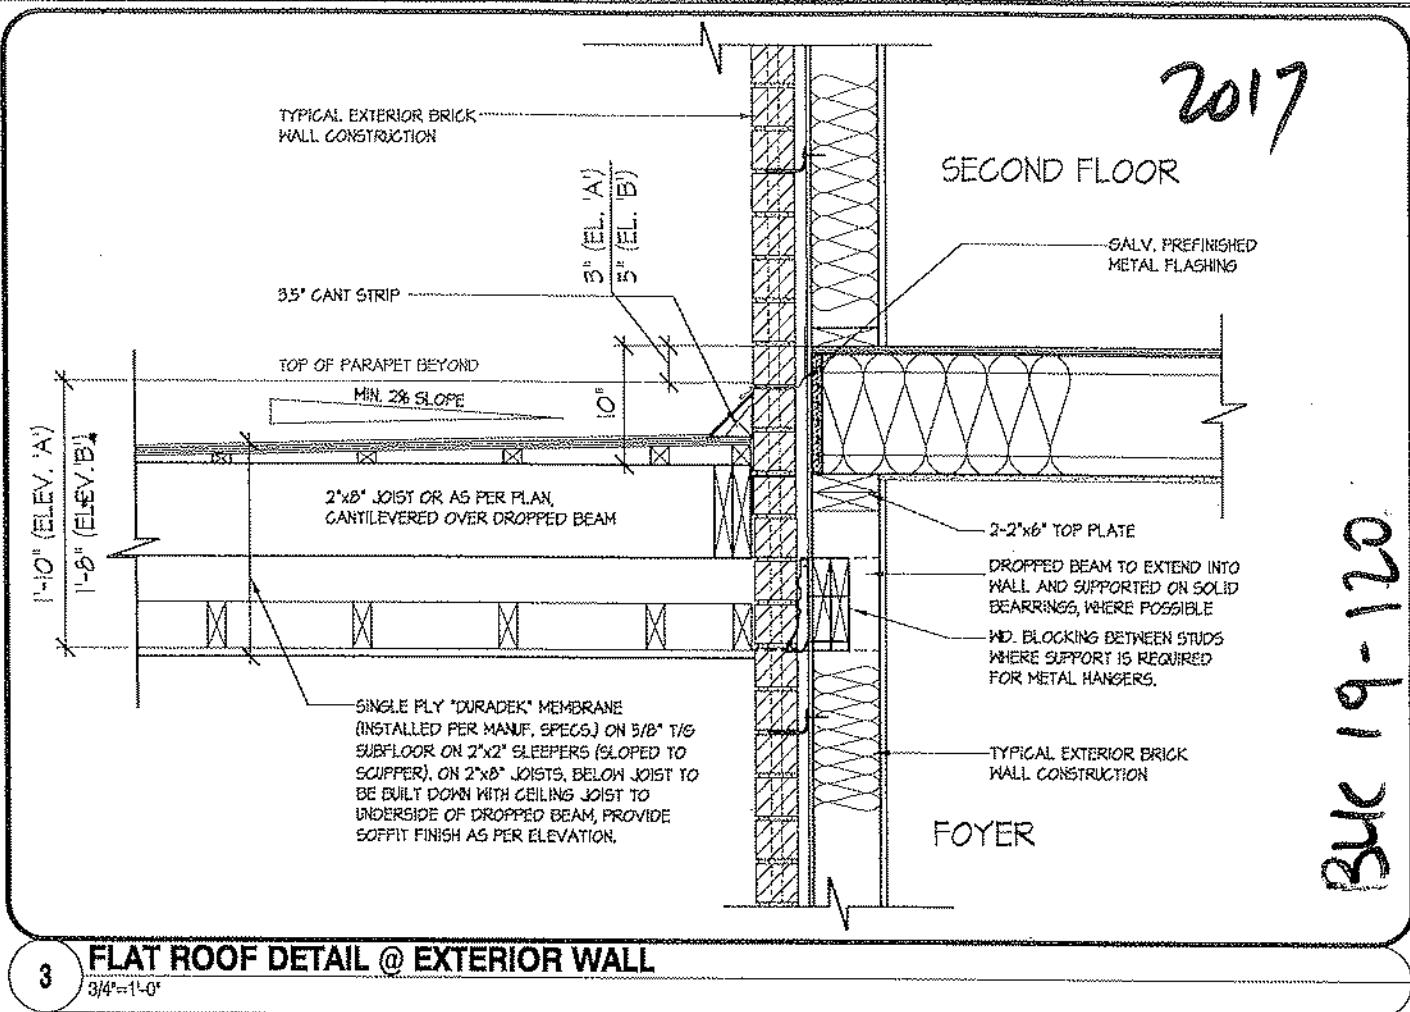

FLAT ROOF DETAIL @ EXTERIOR WALL


3

3

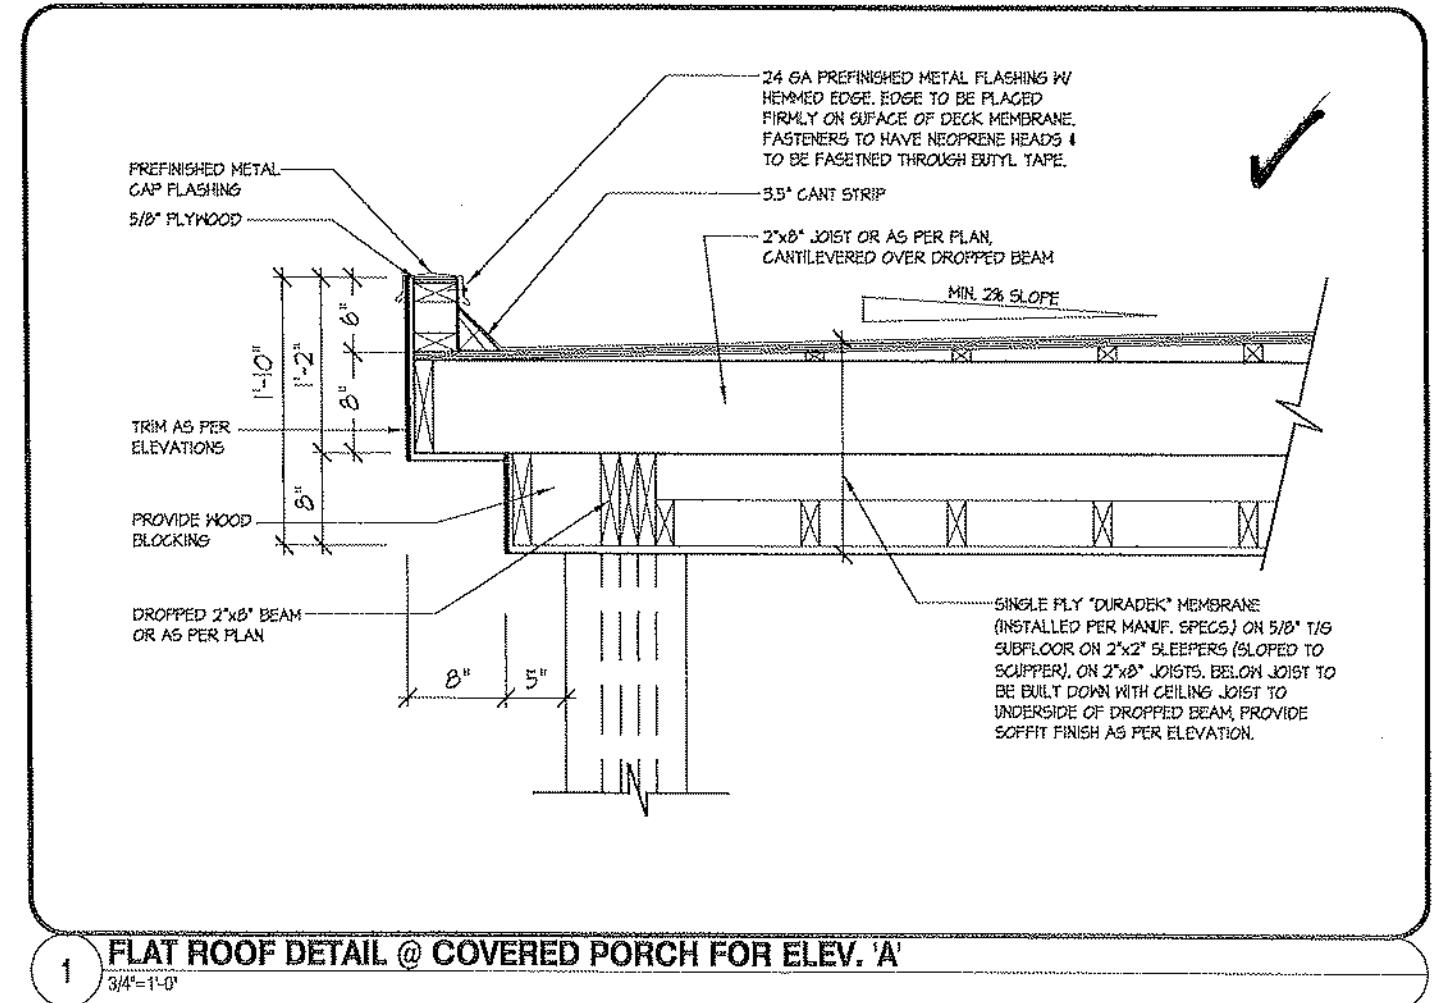

FLAT ROOF DETAIL @ COVERED PORCH FOR ELEV. A

$$3/4 = 1 - \frac{1}{4}$$

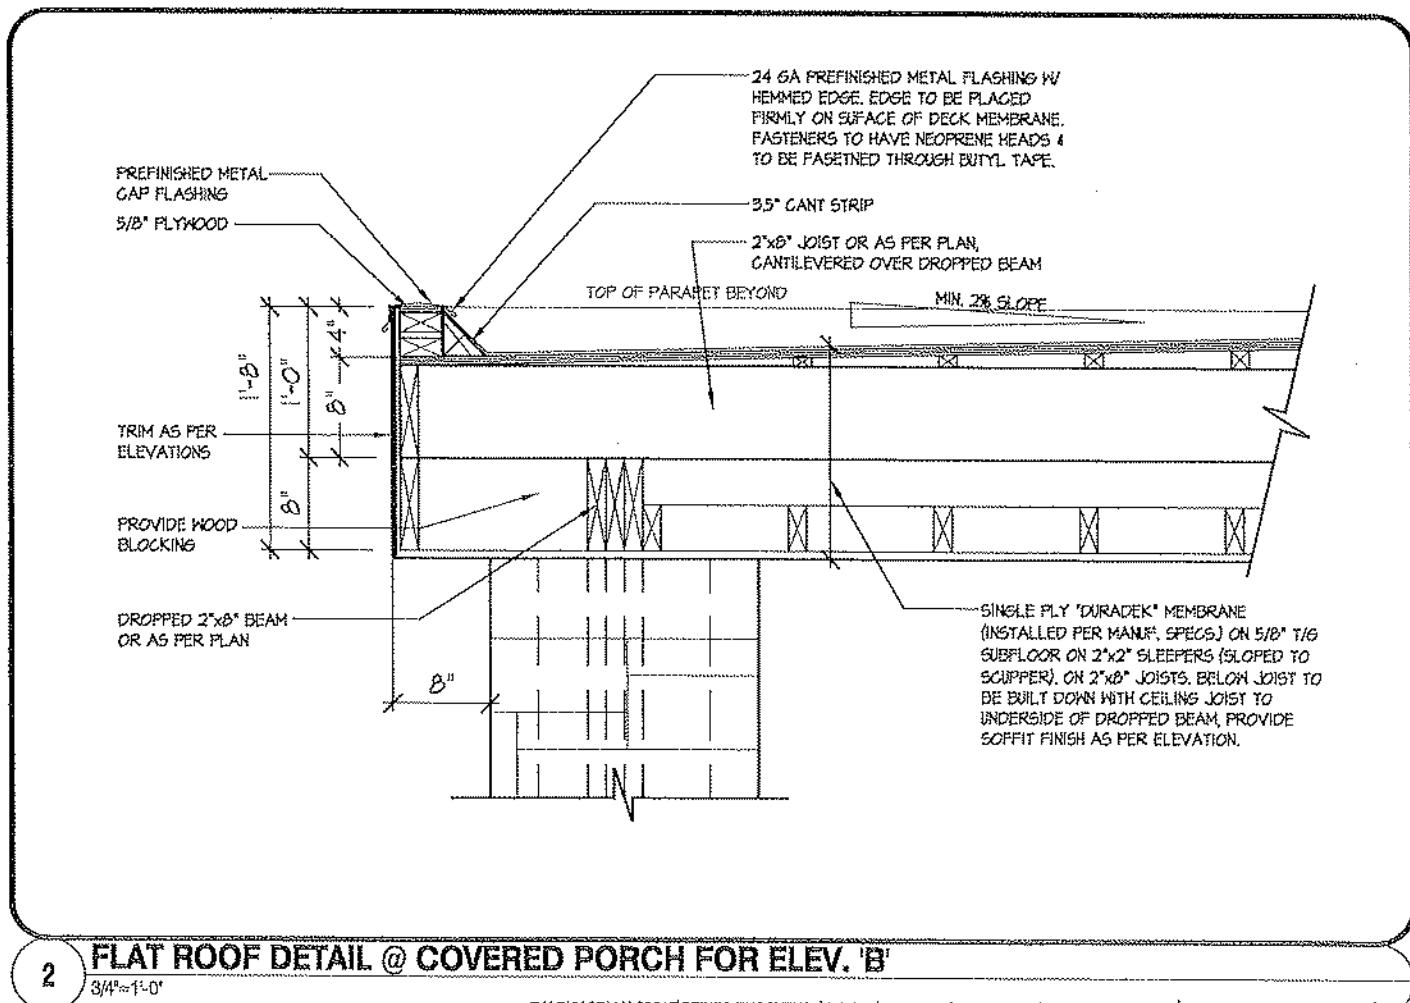


2 FLAT ROOF DETAIL @ COVERED PORCH FOR ELEV. 'B'

1

Preliminary

NOT FINAL April 22 2025

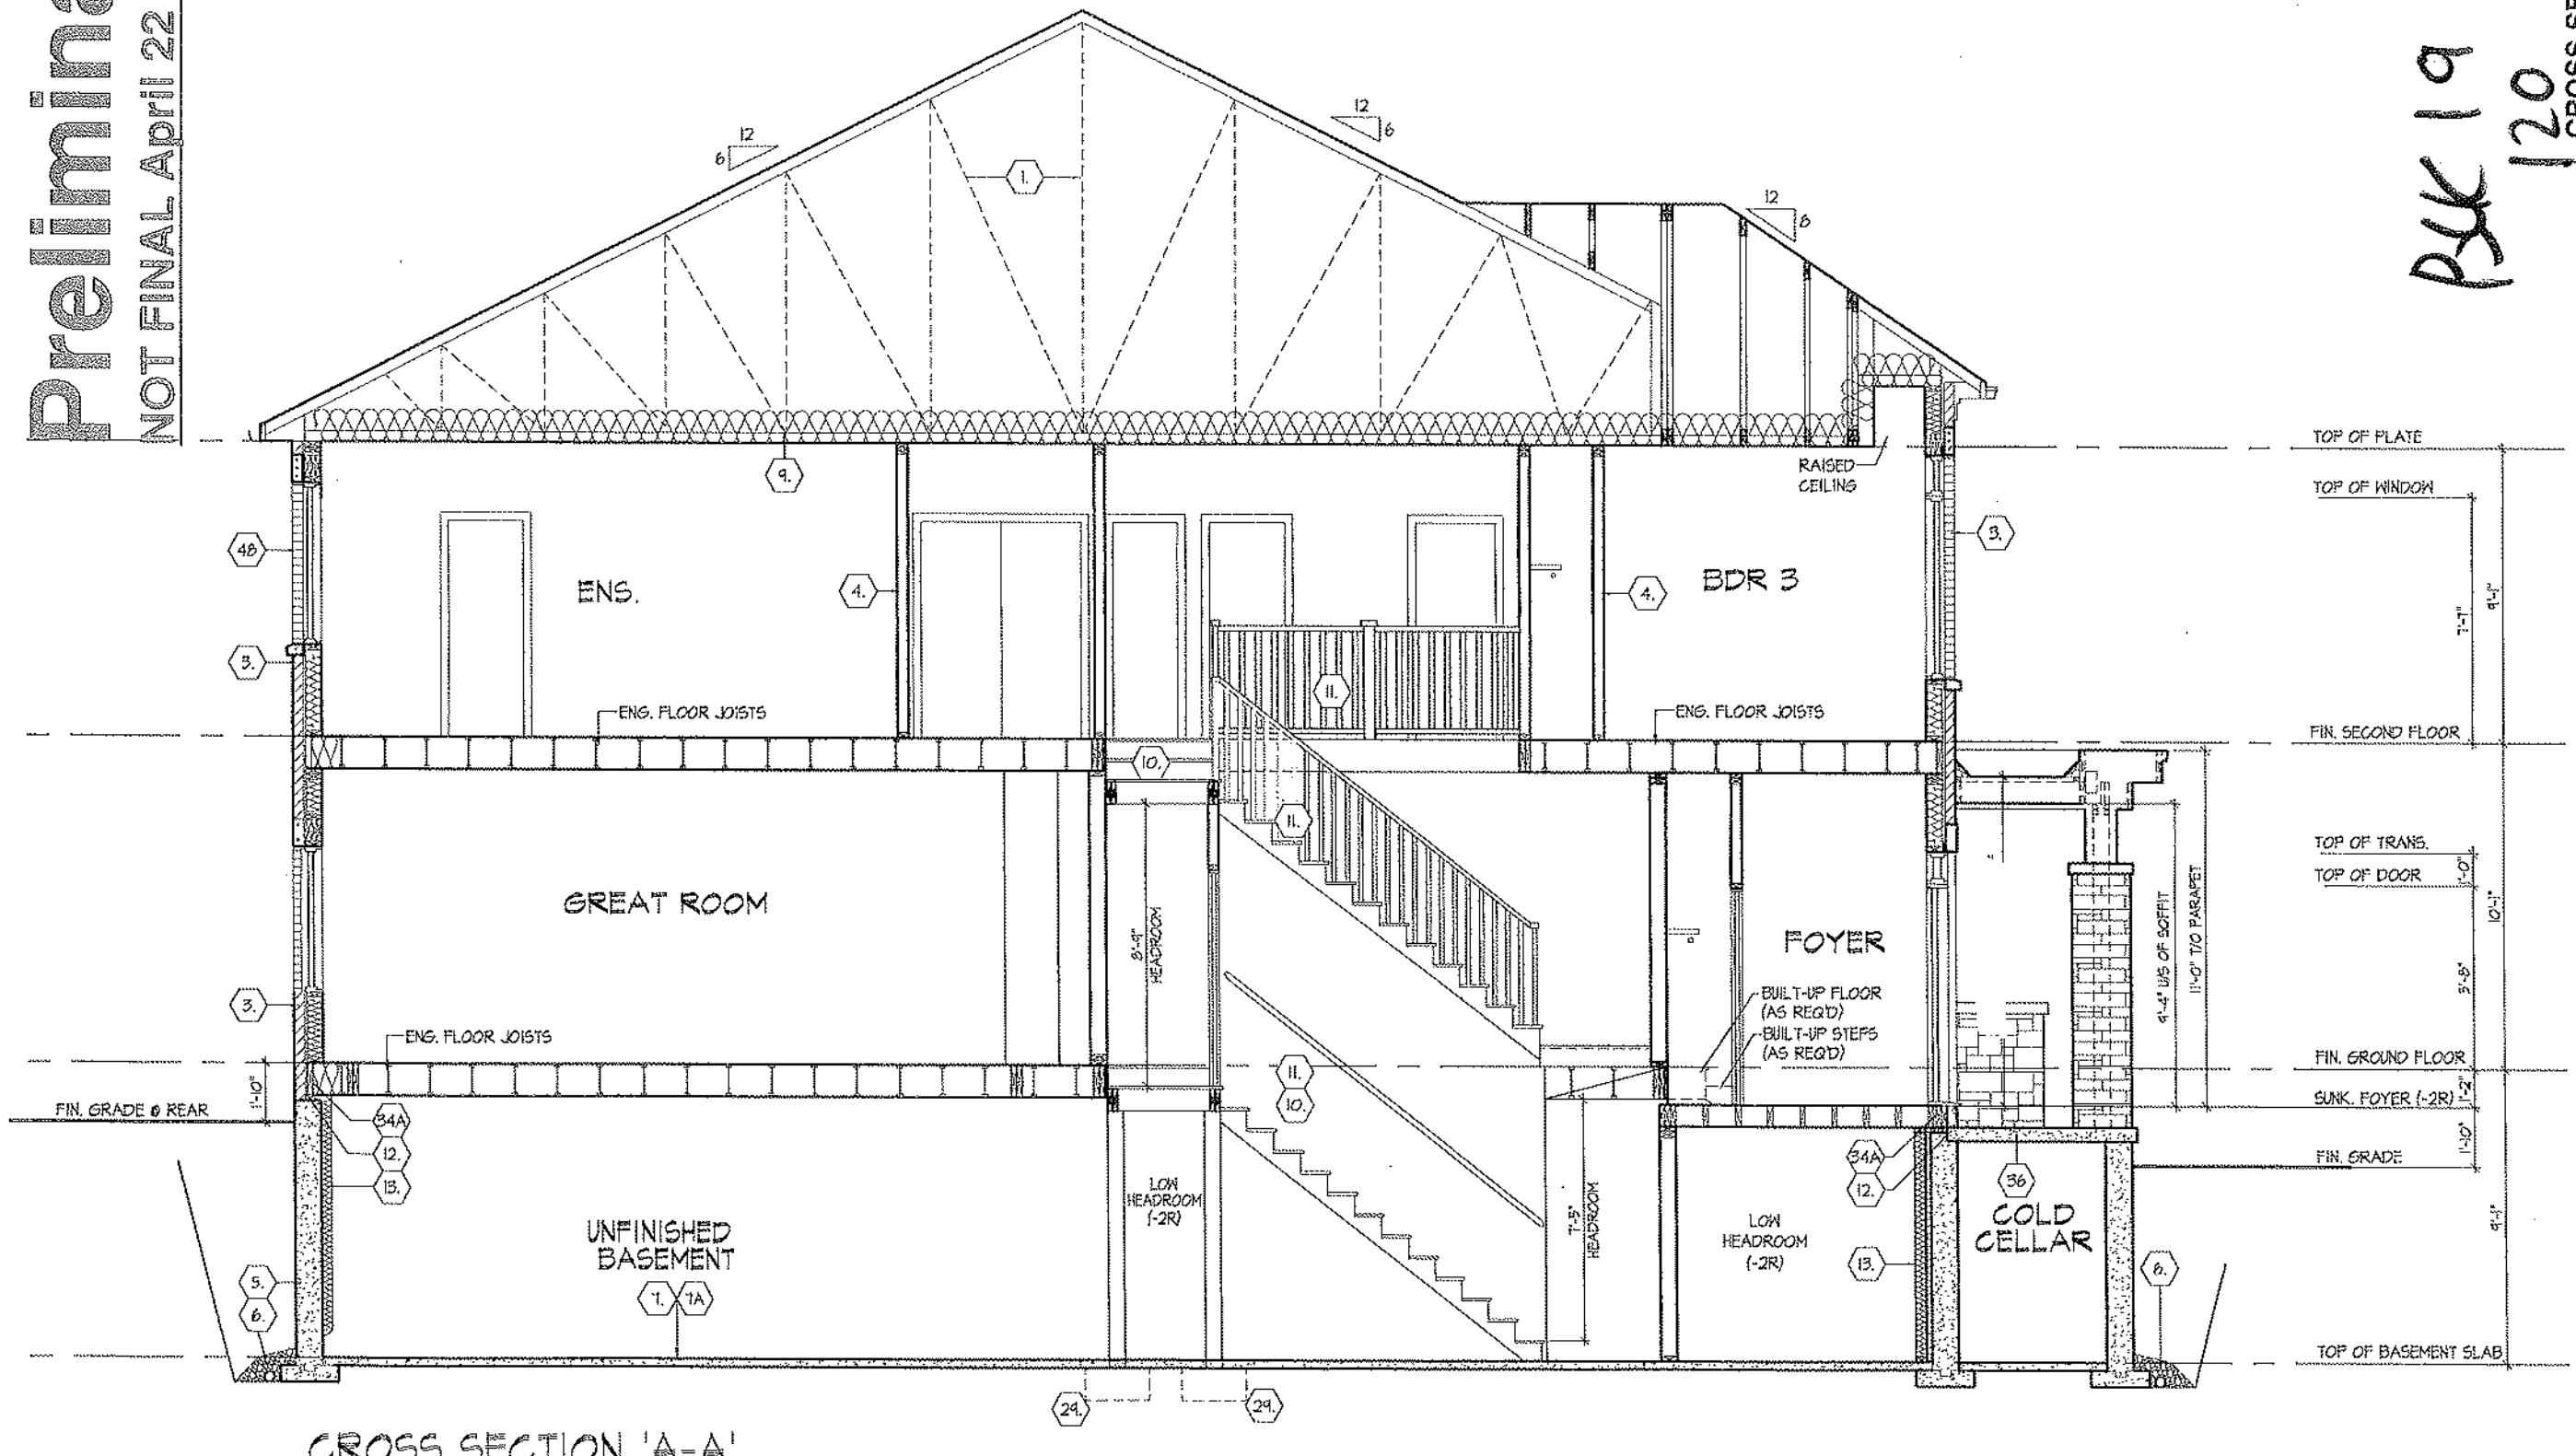

CROSS SECTION 'A-A

MNEELLO [MON MAR 31/25 11:21 AM] KAPROJECTS201611094140ROWWORKINGOWNSY. TREASURE SERIESTS180944W120173WGE

2127
RE
1986
CRAFTSMANSHIP
IN THE DESIGN AND BUILDING OF PROJECTS TO BE A WORKMASTER.
CERTIFICATE INFORMATION
ECONOMIC MEDIUM
DATE
SIGNATURE
FACSIMILE
QUINT DESIGN ASSOCIATES INC.
Detailed drawings, specifications related documents and designs are the property


HUNT		DESIGN ASSOCIATES INC.		921 BAYVIEW, RICHMOND HILL, ON.	
				Came By KM/T/T	
				Checked By DS/M/M	
				3/16 = 1-0"	
				File Number 21809-WT2017	
				Page Number 24 of 27	
				905-737-5133 F 905-737-7326	
				9556 Woodbine Ave., Markham, ON L3R 0J7	
				www.hundesign.ca	

REV.2025.03.26


Print or stamp on back of this property in whole or in part is strictly prohibited without H.D.A.'s written permission. H.D.A. assumes no responsibility or liability for this property unless it bears the appropriate BCIN number and original signature.



BAYVIEW HEIGHTS RICHMOND HILL

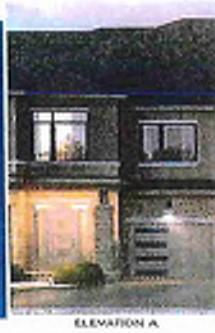


6.1.1.10

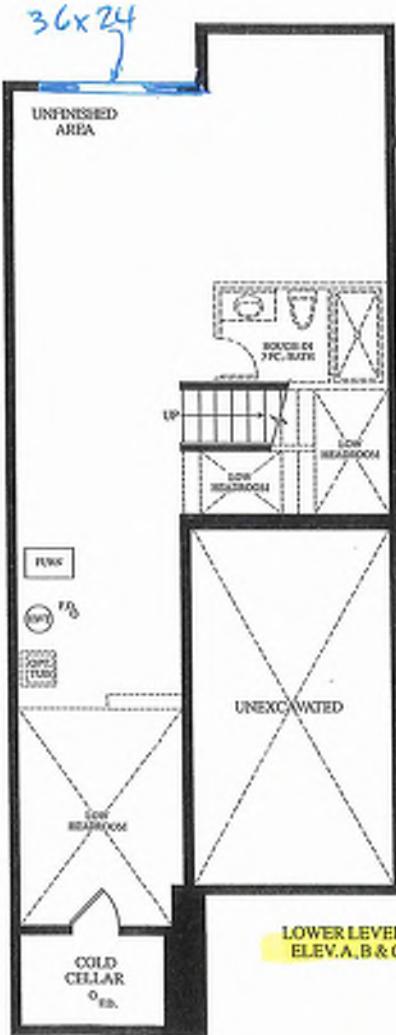


**LOWER LEVEL
ELEV.A,B & C**

EXTENDED
HEIGHT
FRONT
DOOR
66x98

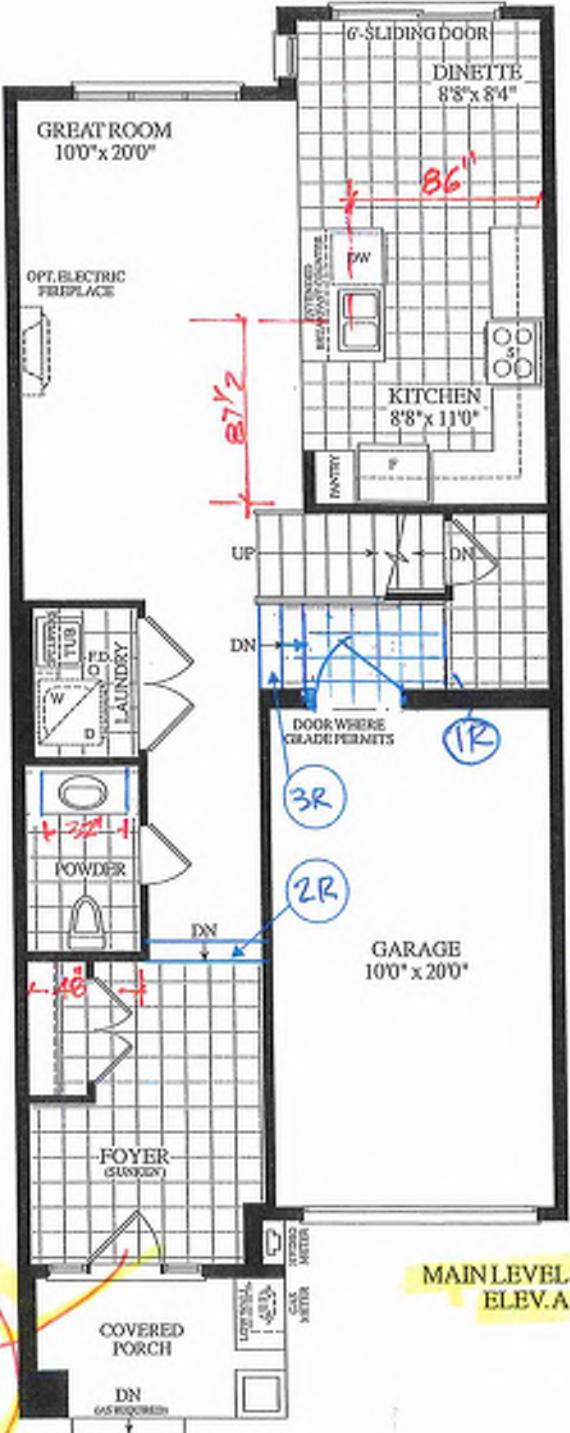

MAIN LEVEL
ELEV A

Materials, specifications and floor plans are subject to change without notice. All renderings are artist's concept. All floor plans are approximate dimensions. Actual usable floor space may vary from the stated floor area. E.B.O.E.

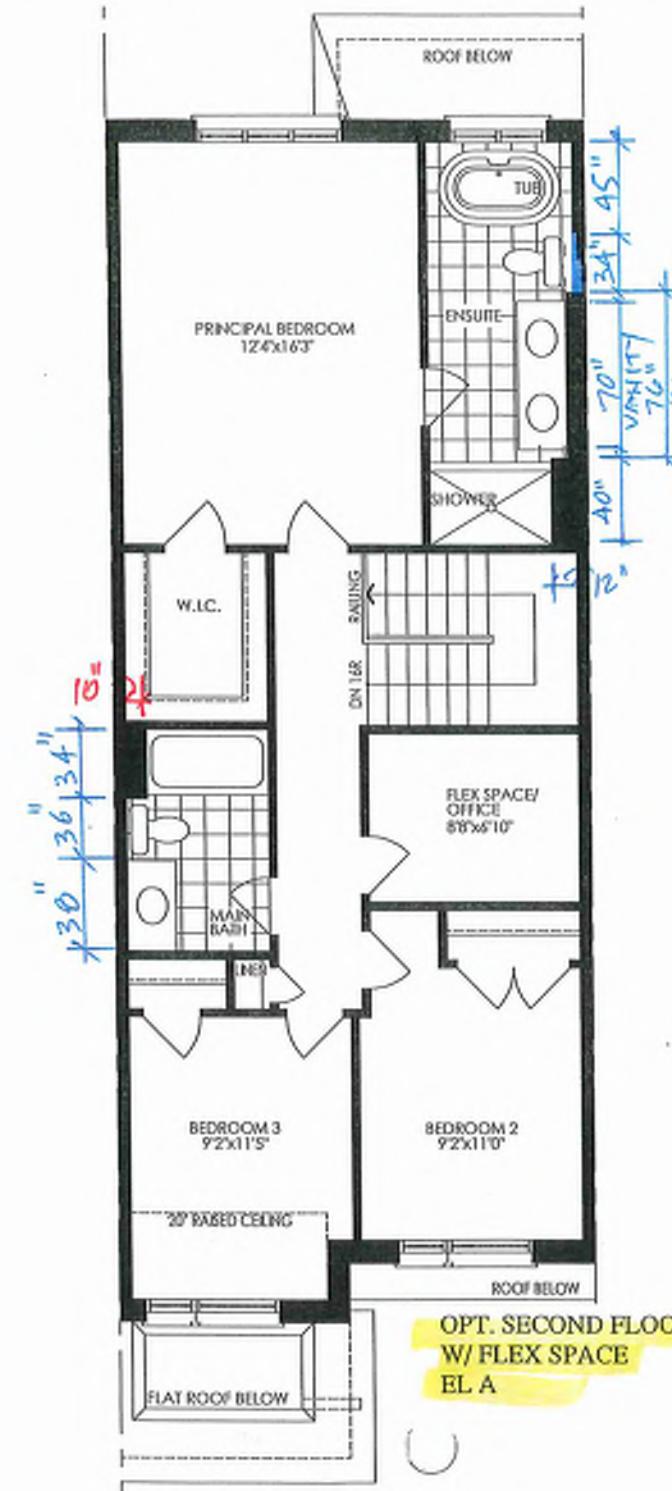

**OPT. SECOND FLOOR PLAN
W/ FLEX SPACE
EL A**

卷之三



20-15 THE ANNE

EL. A 4 BDRM 2 BATH 1685 SQ.FT.

PARK 19-121

GROUND TO SECOND
122' HT 11-7/8' JOIST

BASEMENT TO GROUND
BSMT 11-7/8' JOIST

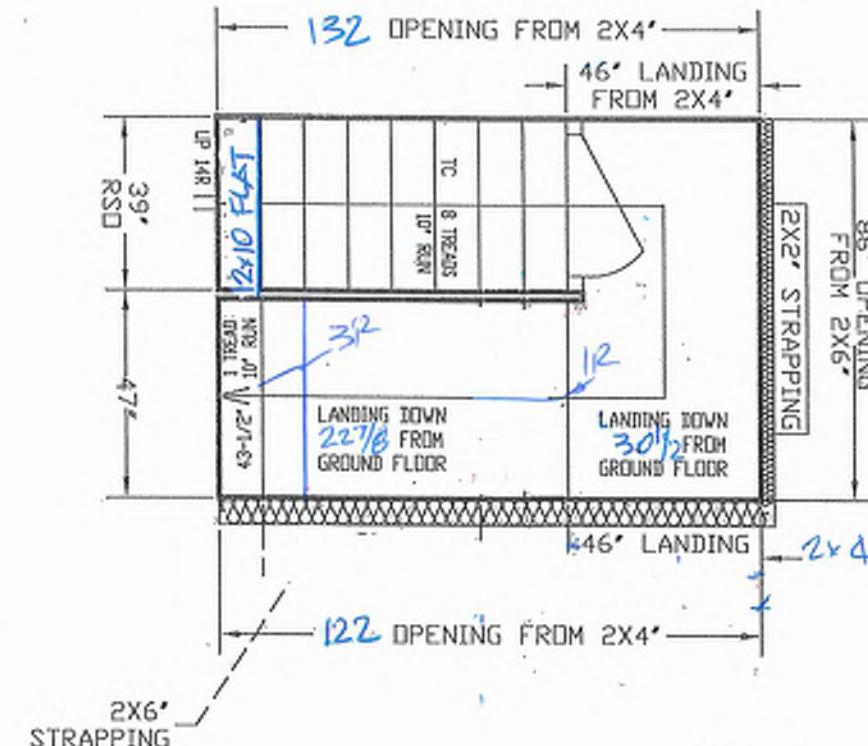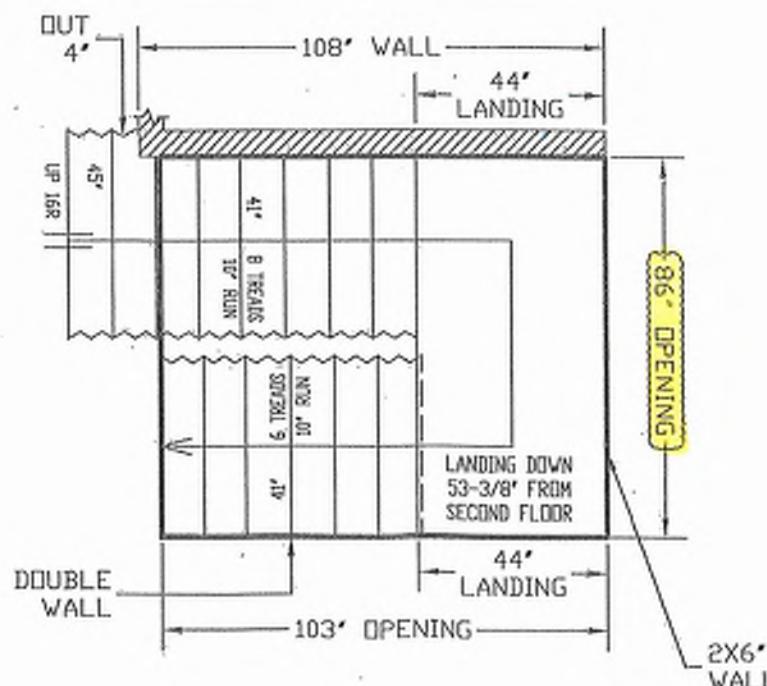

REVISED
JUNE 5, 2025

ALL OPENINGS ARE ALLOWED FOR 1 LAYER OF DRY WALL.
ANY ADDITIONAL LAYERS MUST BE ALLOWED BY CARPENTERS

STAIRS LINE UP BY
PARTY WALL & GARAGE WALL

2" CONC. LEDGE
IN GARAGE

GARAGE RIGHT >




Quality To Step Up To

ALL LANDINGS TO BE SUPPLIED AND SUPPORTED BY OTHERS UNLESS SPECIFIED ABOVE
ANY STRAPPING ALLOWANCES TO BE COMPUTED BY CARPENTERS
ALL STAIR DIMENSIONS MAY BE SHOWN IN FEET, INCHES OR FRACTIONAL FEET. BLUE PRINTS OR SPECS AS SUPPLIED
TO ALPA STAIRS AND RAILINGS INC. MEASUREMENTS SHOWN ON LAYOUTS ARE DESIGNED TO
INSTALL THE STAIRS. NOT PROVIDED WITH LOCATION OR STRAPPING ALLOWANCES. ALPA
STAIRS AND RAILINGS INC. WILL NOT BE RESPONSIBLE. STAIR LAYOUTS SHOULD BE CHECKED BY
CARPENTERS OR SITE SUPERVISORS TO MAKE SURE THERE ARE NO DISCREPANCIES BEFORE PROCEEDING
WITH CONSTRUCTION

ALPA STAIRS AND RAILINGS INC.
3770 NASHUA DRIVE, UNIT 3 MISSISSAUGA, ONTARIO L4V 1M6
TEL: (905) 694-9556 | www.alpastairs.com



SITE	DRAWN BY	NAME	DATE
BAYVIEW HEIGHTS		PARAMJEET	MAY 23, 2025
LOT #	CLIENT	ROYAL PINE HOMES	
HOST	LAYOUT #		
UNIT 2015	SCALE	1:85	

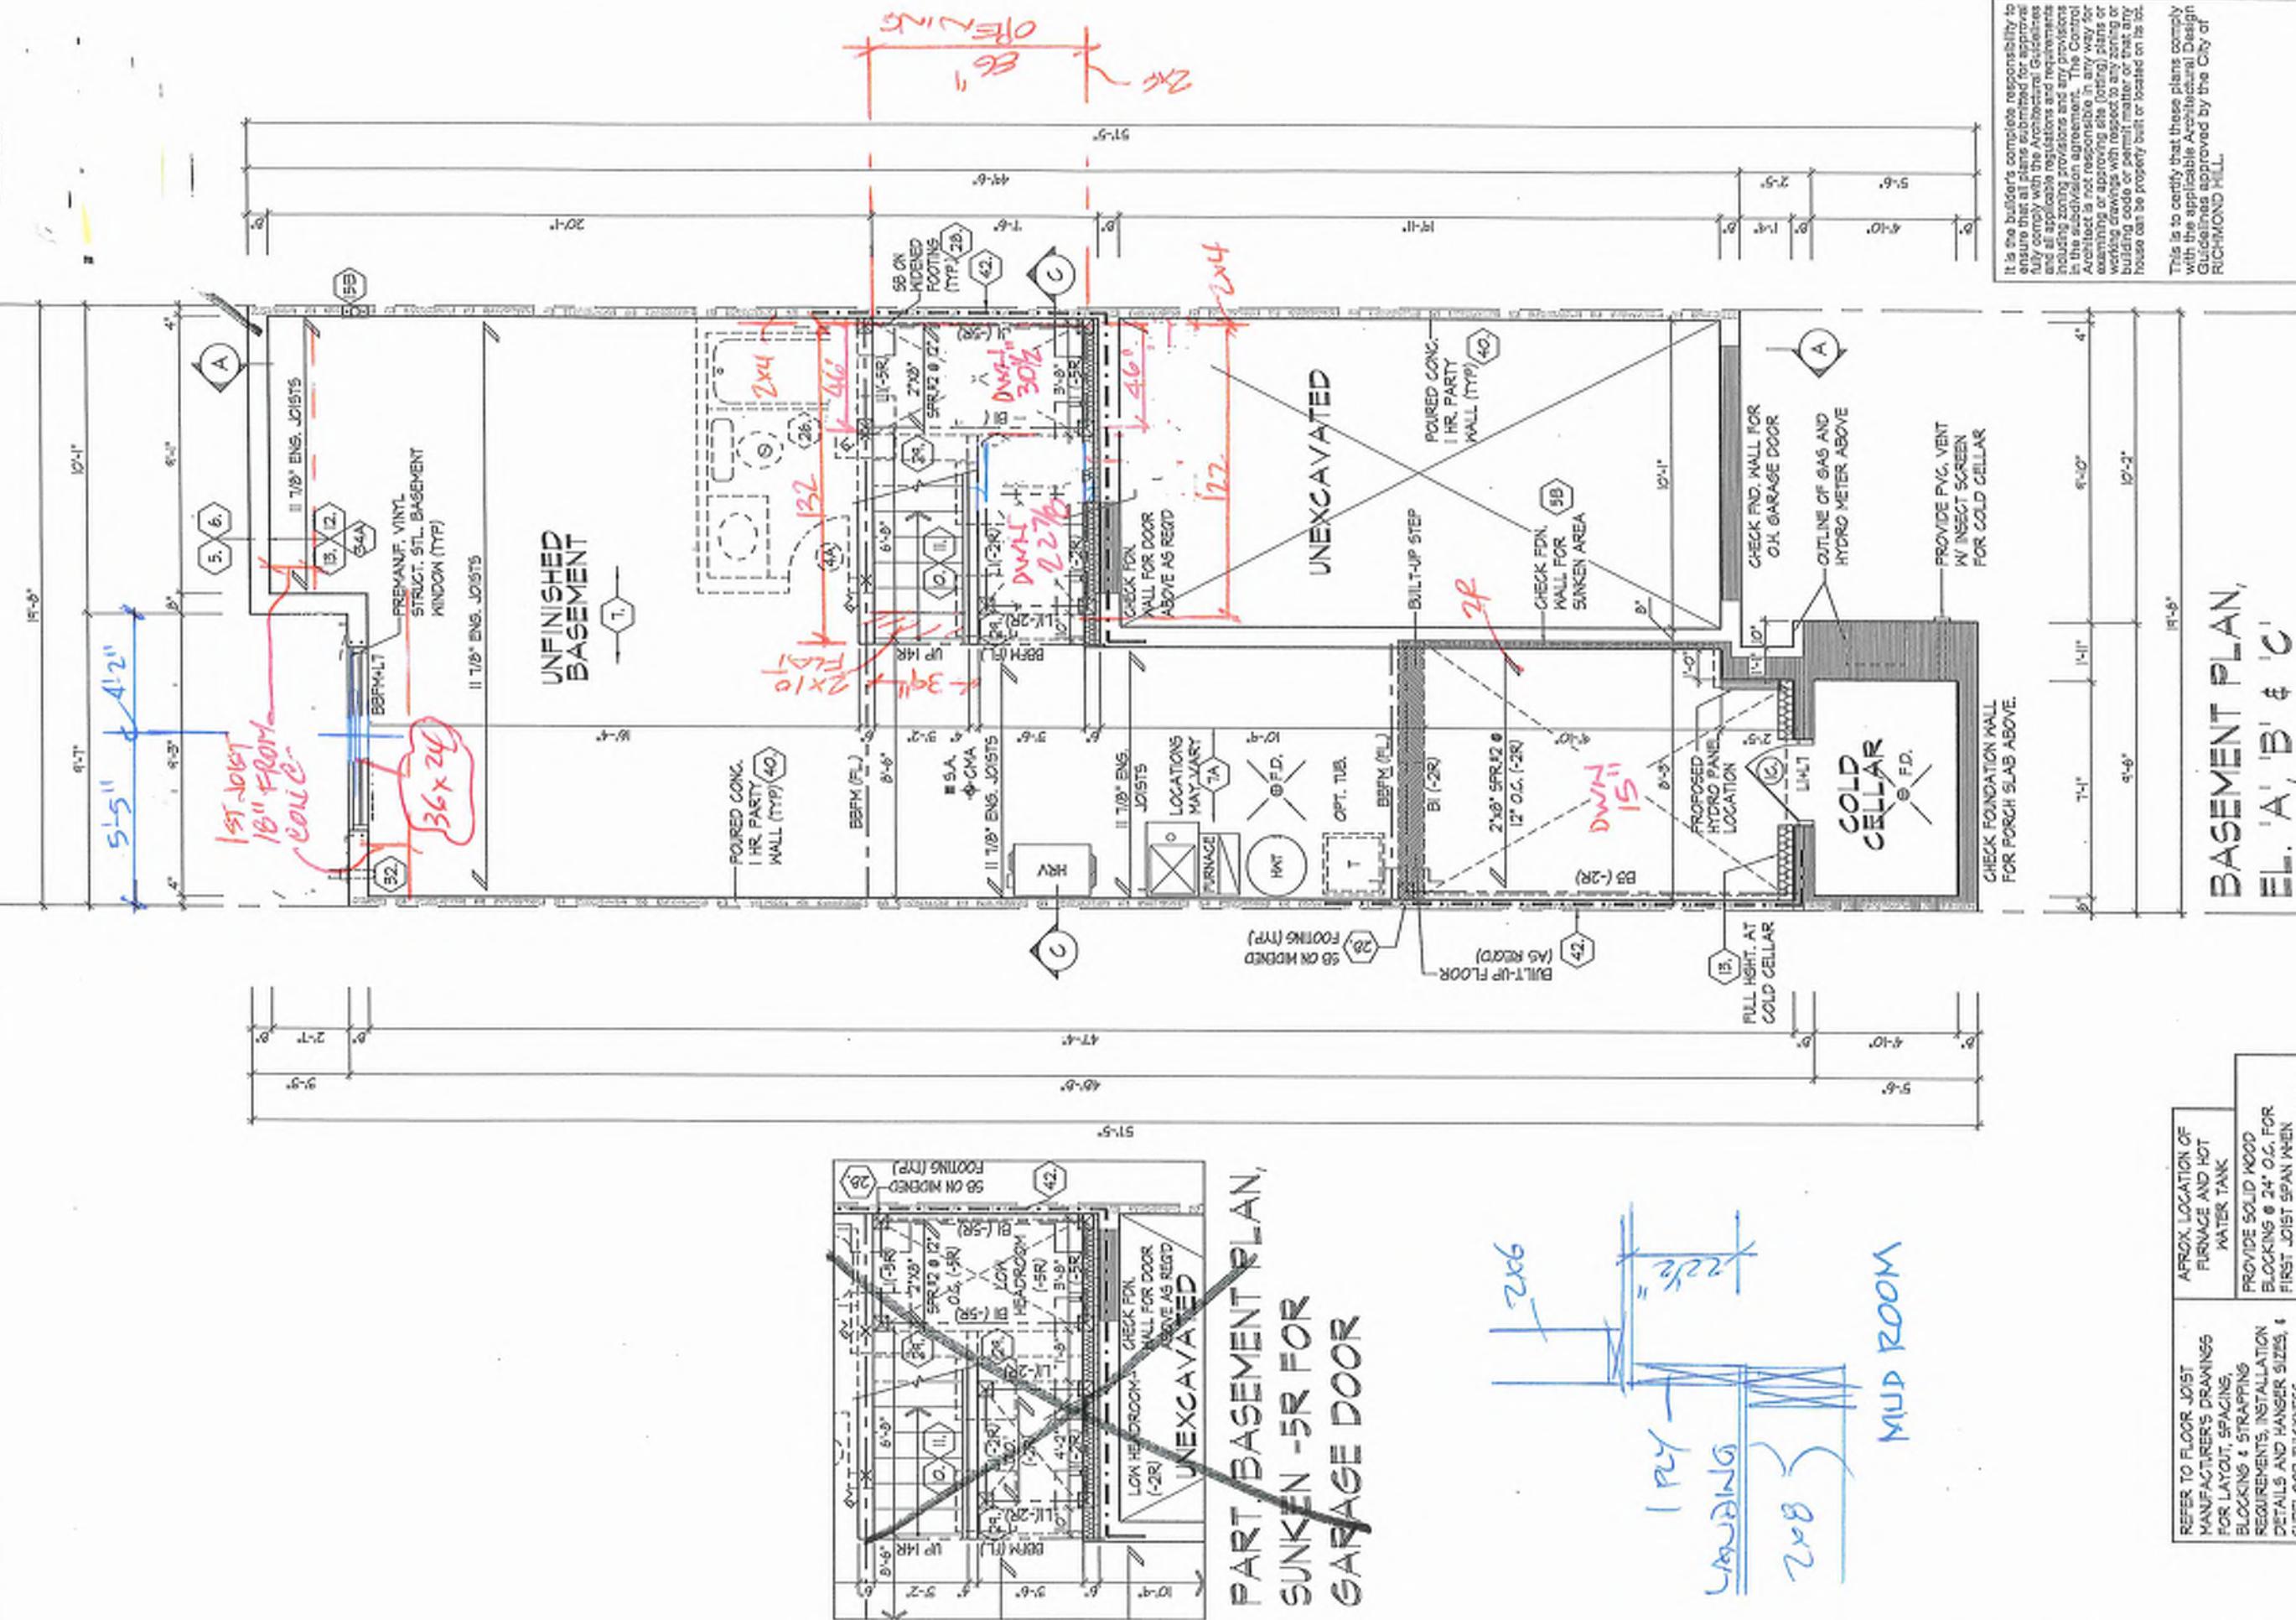

BCK 19-121

BASEMENT PLAN
Elev. A-B-C


Royal Pine Homes - 218094
BAS

EV. 'A', 'B' & 'C'
UNIT 2015


ROYAL PINE HOMES - 218094
BASEMENT PLAN,

121

MELVILLE | THE UNDERSTORY: TWO REVIEWS AND THREE PERSPECTIVES FOR THIS CLASSIC AND THE DUAL PHANTOMS AND MONSTERS IT REQUIRES

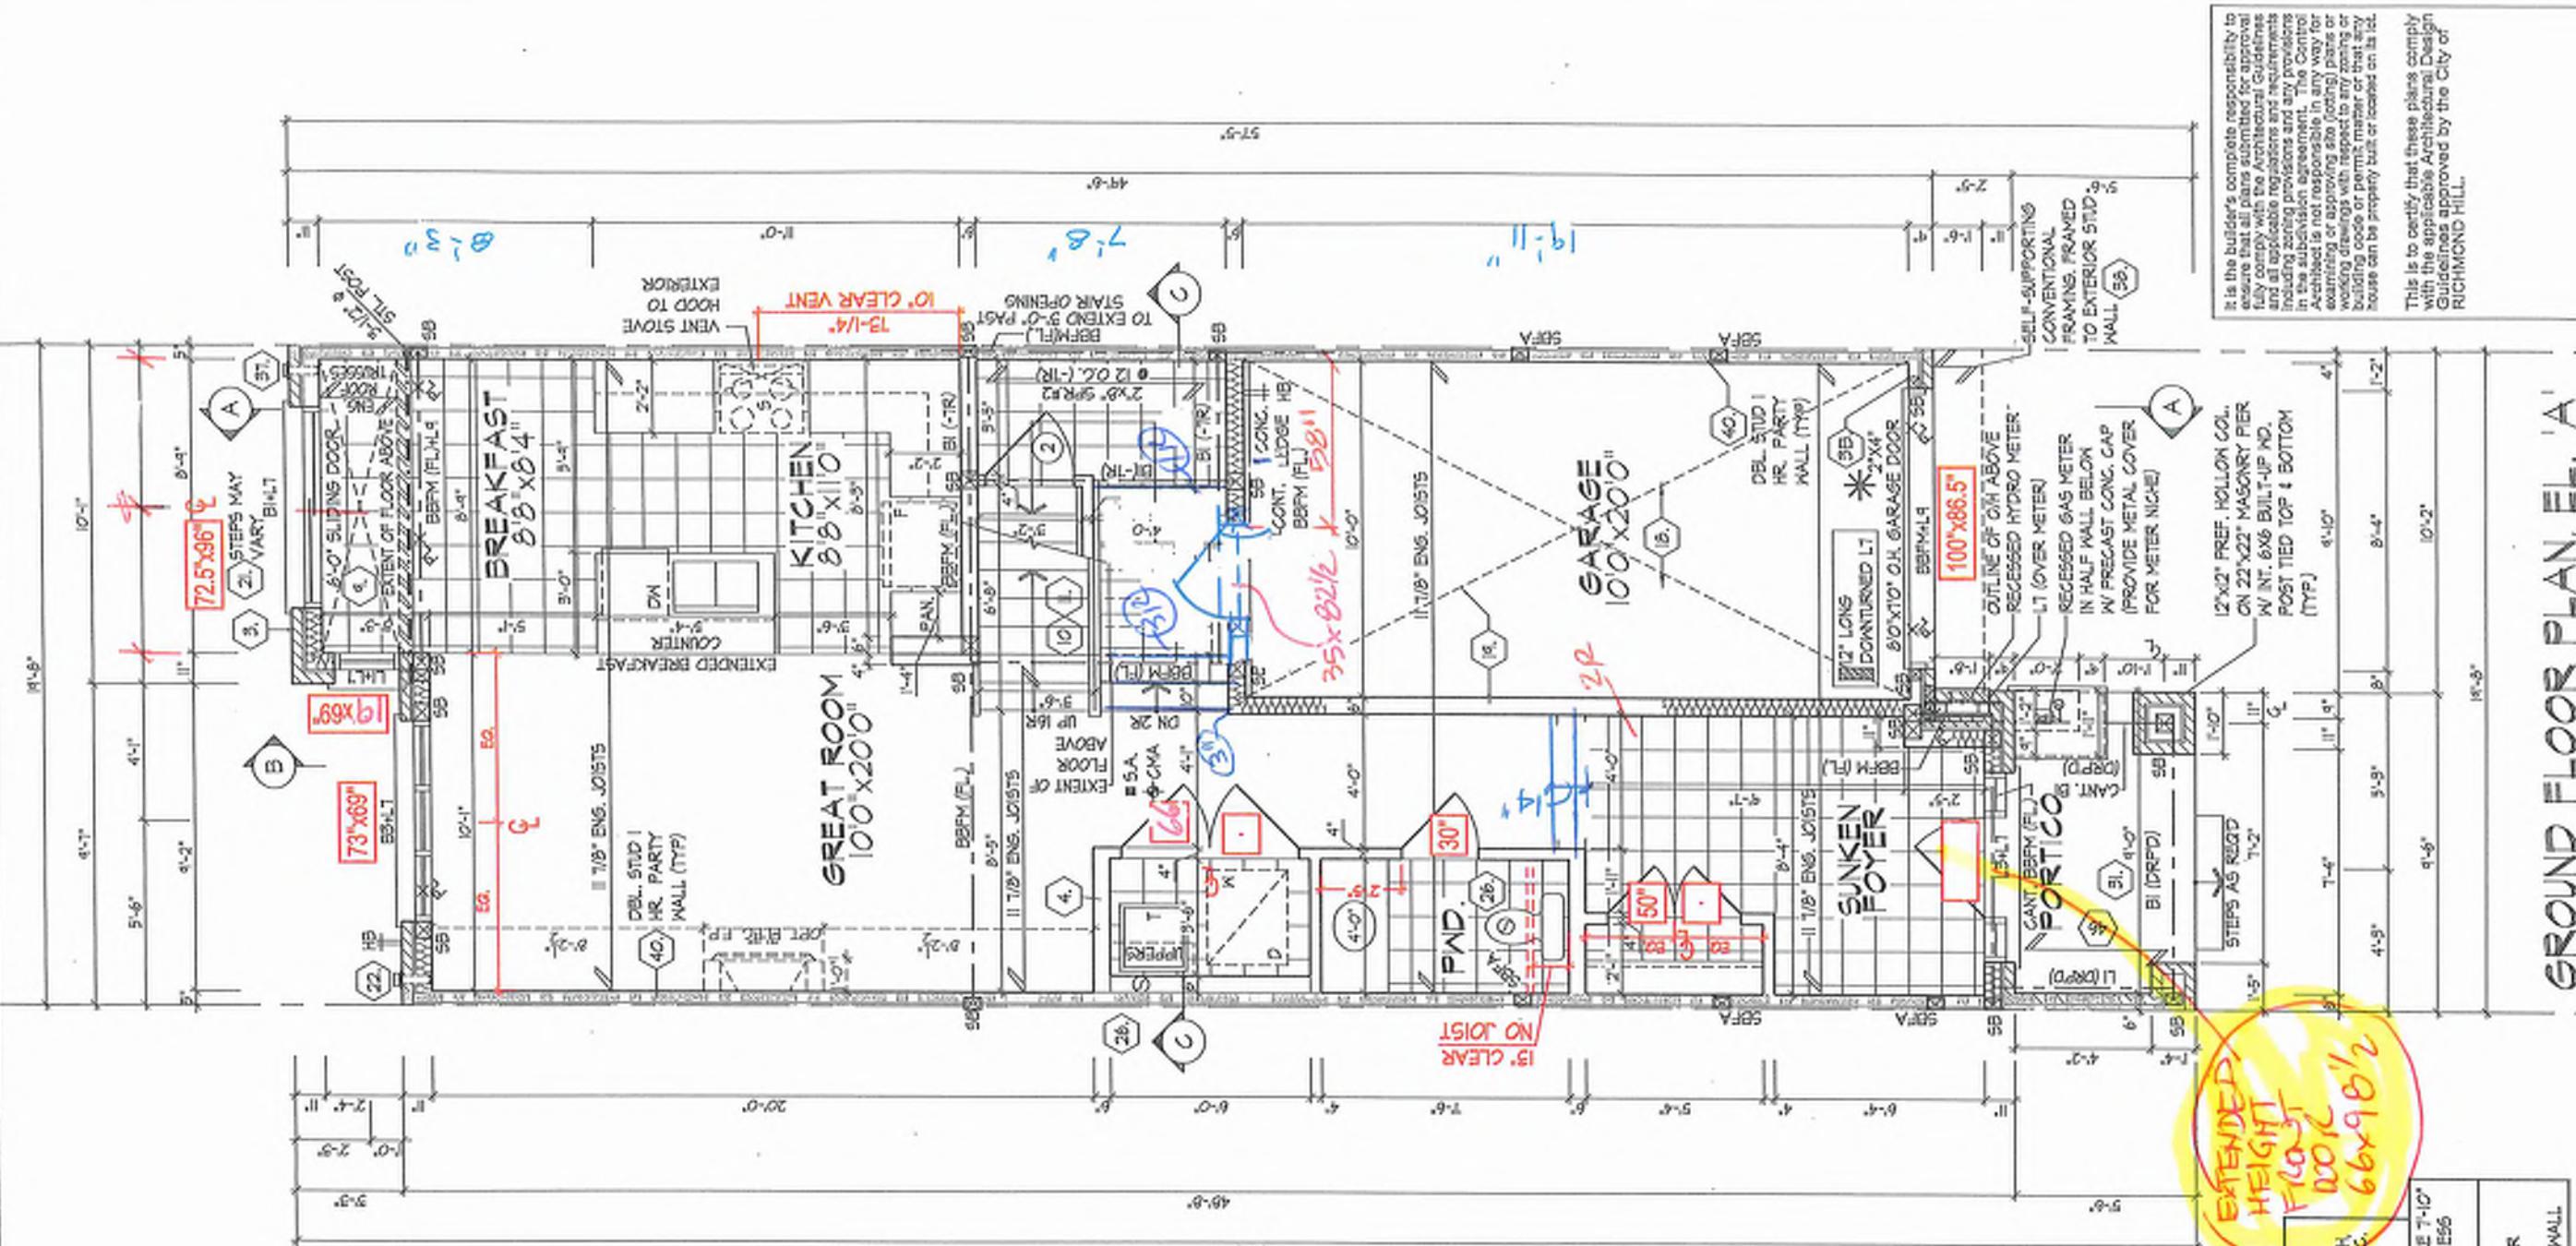

INT. DOORS 83 1/2
WINDOWS SEE TELEU.

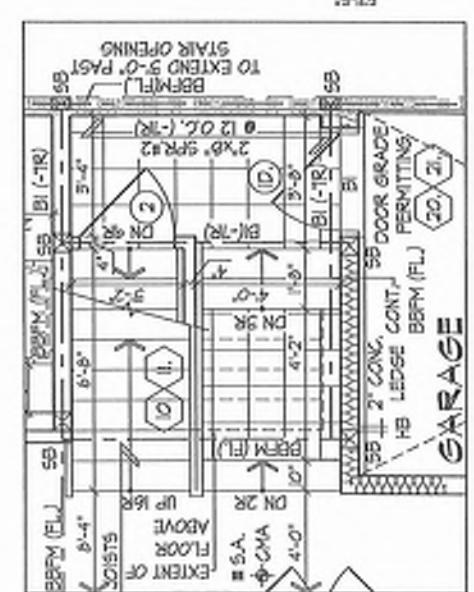

PART. GROUND FLOOR
PLAN, SUNKEN -5R FOR
GARAGE DOOR

<p>MAX UNSUPPORTED HEIGHT</p> <p>FOR WALLS GREATER THAN 4'-0" TO MAX. 12'-0"</p> <ul style="list-style-type: none"> - NO FLOOR LOAD, DOUBLE UP EVERY STUD @ 7'-0" - W/ FLOOR LOAD, DOUBLE UP EVERY STUD @ 6'-0" <p>PROVIDE BLOCKING EVERY 4'-0" O.C., VERTICAL</p>	<p>ALL DOORS ON PLANE HIGH TOP OF FRAME LABLED OTHERWISE</p> <p>PROVIDE SOLID NO BLOCKING @ 24'-0"</p> <p>FIRST JOIST SPAN PARALLEL W/ EXTER-</p>
<p>REFER TO FLOOR JOIST</p> <p>MANUFACTURER'S DRAWINGS FOR LAYOUT, SPACINGS, BLOCKINGS & STRAPPING REQUIREMENTS, INSTALLATION DETAILS AND HANGER SIZES, 4 SUBFLOOR THICKNESS</p>	

This is to certify that these plans comply with the applicable Architectural Design Guidelines approved by the City of RICHMOND HILL.

卷之三

BUL 19-121


HUNT
DESIGN ASSOCIATES INC.

HUNT DESIGN ASSOCIATES INC. 1983
All drawings specifications related documents and details are the copyright

921 BAYVIEW, RICHMOND HILL, ON.			Page Number	Page Number
Owner By KMM/M	Owned By DS/MM	Date 3/16/ = 1-0"	File Number 2118094WT2015	3 of 25
8988 Woodbine Ave., Markham, ON L3R 0J7	T 905.737.5138	F 905.737.7328		

Page 3 of 3

It is the builder's complete responsibility to ensure that all plans submitted for approval fully comply with the Architectural Guidelines and all applicable regulations and requirements including zoning provisions and any provisions in the subdivision agreement. The Control Architect is not responsible in any way for examining or approving site (grading) plans or working drawings with respect to any zoning or building code or permit matter or that any house can be properly built or located on its lot. This is to certify that these plans comply With the applicable Architectural Design Guidelines approved by the City of RICHMOND HILL.

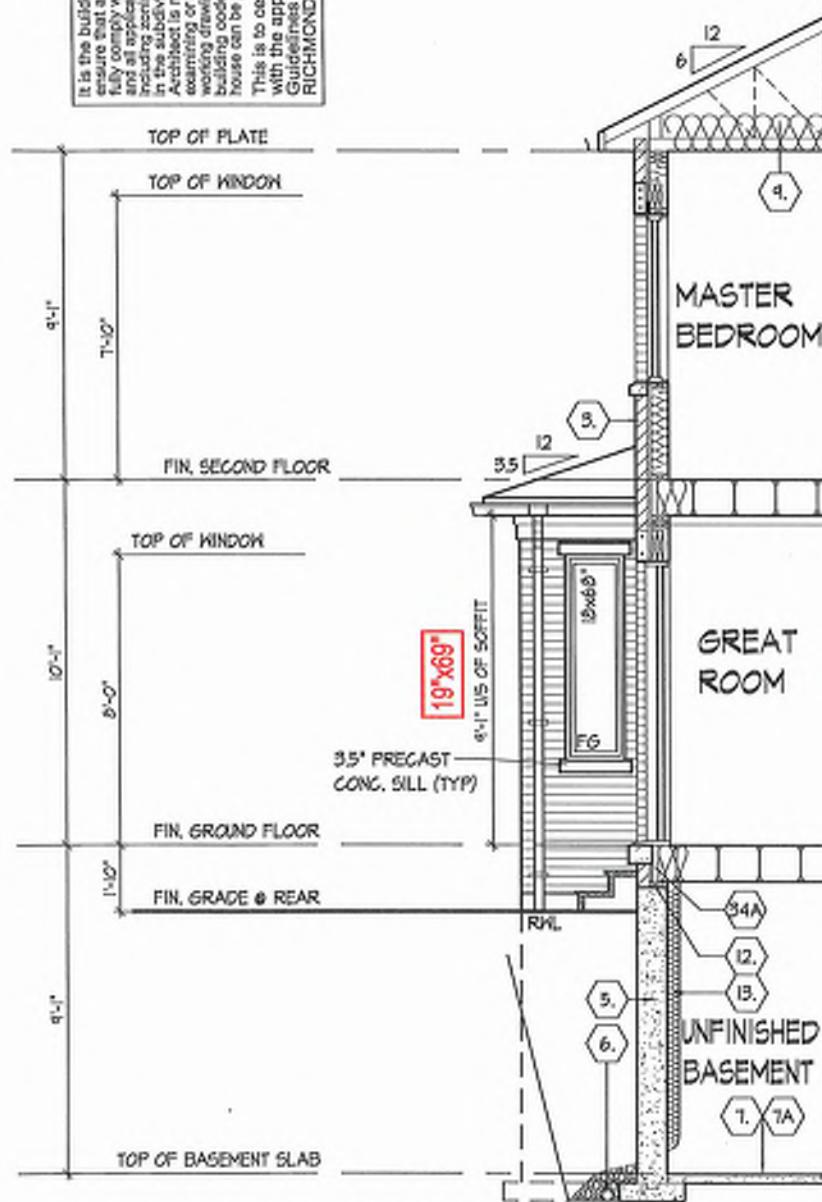

PART. SECTION 'B'
FOR UPGRADED REAR
FOR ELEV. 'A'

REFER TO FRONT
ELEVATION FOR TYPICAL
NOTES & INFORMATION

ROOF OVERHANGS TO BE 12"
UNLESS NOTED OTHERWISE

612

PART.
SECTION 'B'

REAR ELEVATION 'A', 'B' & 'C'

ROYAL PINE HOMES - 218094
921 BAYVIEW, RICHMOND HILL, ON.
REAR ELEVATION A, B & C
UNIT 2015
REV.2025.03.25

HUNT

PRINTING NUMBER: 21274
SIGNATURE: BGD
REGISTRATION INFORMATION:
HUNT DESIGN ASSOCIATES INC.
19888
All drawings and specifications related to the above documents and deletion are the copyright of

FLAT ROOF DETAILS OVER COVERED PORCH

ROYAL PINE HOMES - 218094
921 BAYVIEW, RICHMOND HILL, ON.

UNIT
REV. 2025 03 25

Page Number
27 of **28**

Design By
KM/MM
 8985 Woodbine Ave, Markham, ON L3R 0J7

Checked By
DS/MM
 $3\frac{1}{4} = 1\text{-}0"$

Filing Number
218094WT2015
 F 905-737-5133

Printed On
2025-03-25

All drawings, specifications, related documents and notes are the copyright property of Hunt Design Associates Inc. Reproduction of this document in whole or in part is strictly prohibited without H.D.A.'s written permission. H.D.A. assumes no responsibility for liability for this property unless it bears his name or signature.

The undersigned has reviewed and takes responsibility for this design and has the authority and means to meet the requirements set out in the Ontario Building Code to be designed.

Qualification Information
Dominic M. Molina
 SIGNATURE
HUNT DESIGN ASSOCIATES INC.

Registration Information
19855
 SIGNATURE
HUNT DESIGN ASSOCIATES INC.

NAME
 Dominic Molina
 DATE
 21/27/24
 EDIN

PHONE NUMBER
 905-737-5133
 FAX NUMBER
 905-737-5133

EMAIL ADDRESS
 dominic.molina@huntdesign.com

ADDRESS
 8985 Woodbine Ave, Markham, ON L3R 0J7

POSTAL CODE
 L3R 0J7

CITY
 Markham

STATE
 Ontario

ZIP CODE
 N/A

PHONE NUMBER
 905-737-5133

FAX NUMBER
 905-737-5133

EMAIL ADDRESS
 dominic.molina@huntdesign.com

POSTAL CODE
 N/A

CITY
 Markham

STATE
 Ontario

ZIP CODE
 N/A

PHONE NUMBER
 905-737-5133

FAX NUMBER
 905-737-5133

EMAIL ADDRESS
 dominic.molina@huntdesign.com

POSTAL CODE
 N/A

CITY
 Markham

STATE
 Ontario

ZIP CODE
 N/A


ROYAL PINE HOMES - 218094
921 BAYVIEW, RICHMOND HILL, ON.
UNIT 2015
REV 2025.03.25
File Number: 218094V/T2015
Page Number: 25 of 29
Drawn By: KMM
Checked By: DMM
Date: 3/16/21-1-0
Design Associates Inc.:
8888 Woodbine Ave, North York, ON M3J 2Z8
HUNT DESIGN ASSOCIATES INC.
www.huntassociates.ca

The undersigned has reviewed and takes responsibility for this drawing and has the full protection and warranty that it conforms to set out in the Ontario Building Code to be a design intent.

QUALIFICATION INFORMATION
Dominic Mello
Signature: 21274
Registration Number: 16085
Hunt Design Associates Inc.
All drawings, specifications, related documents and designs are the copyright property of Hunt Design Associates Inc. Reproduction of this property in whole or in part is strictly prohibited without HDA's written permission.

CROSS SECTION 'A-A'

BLOC 19-121

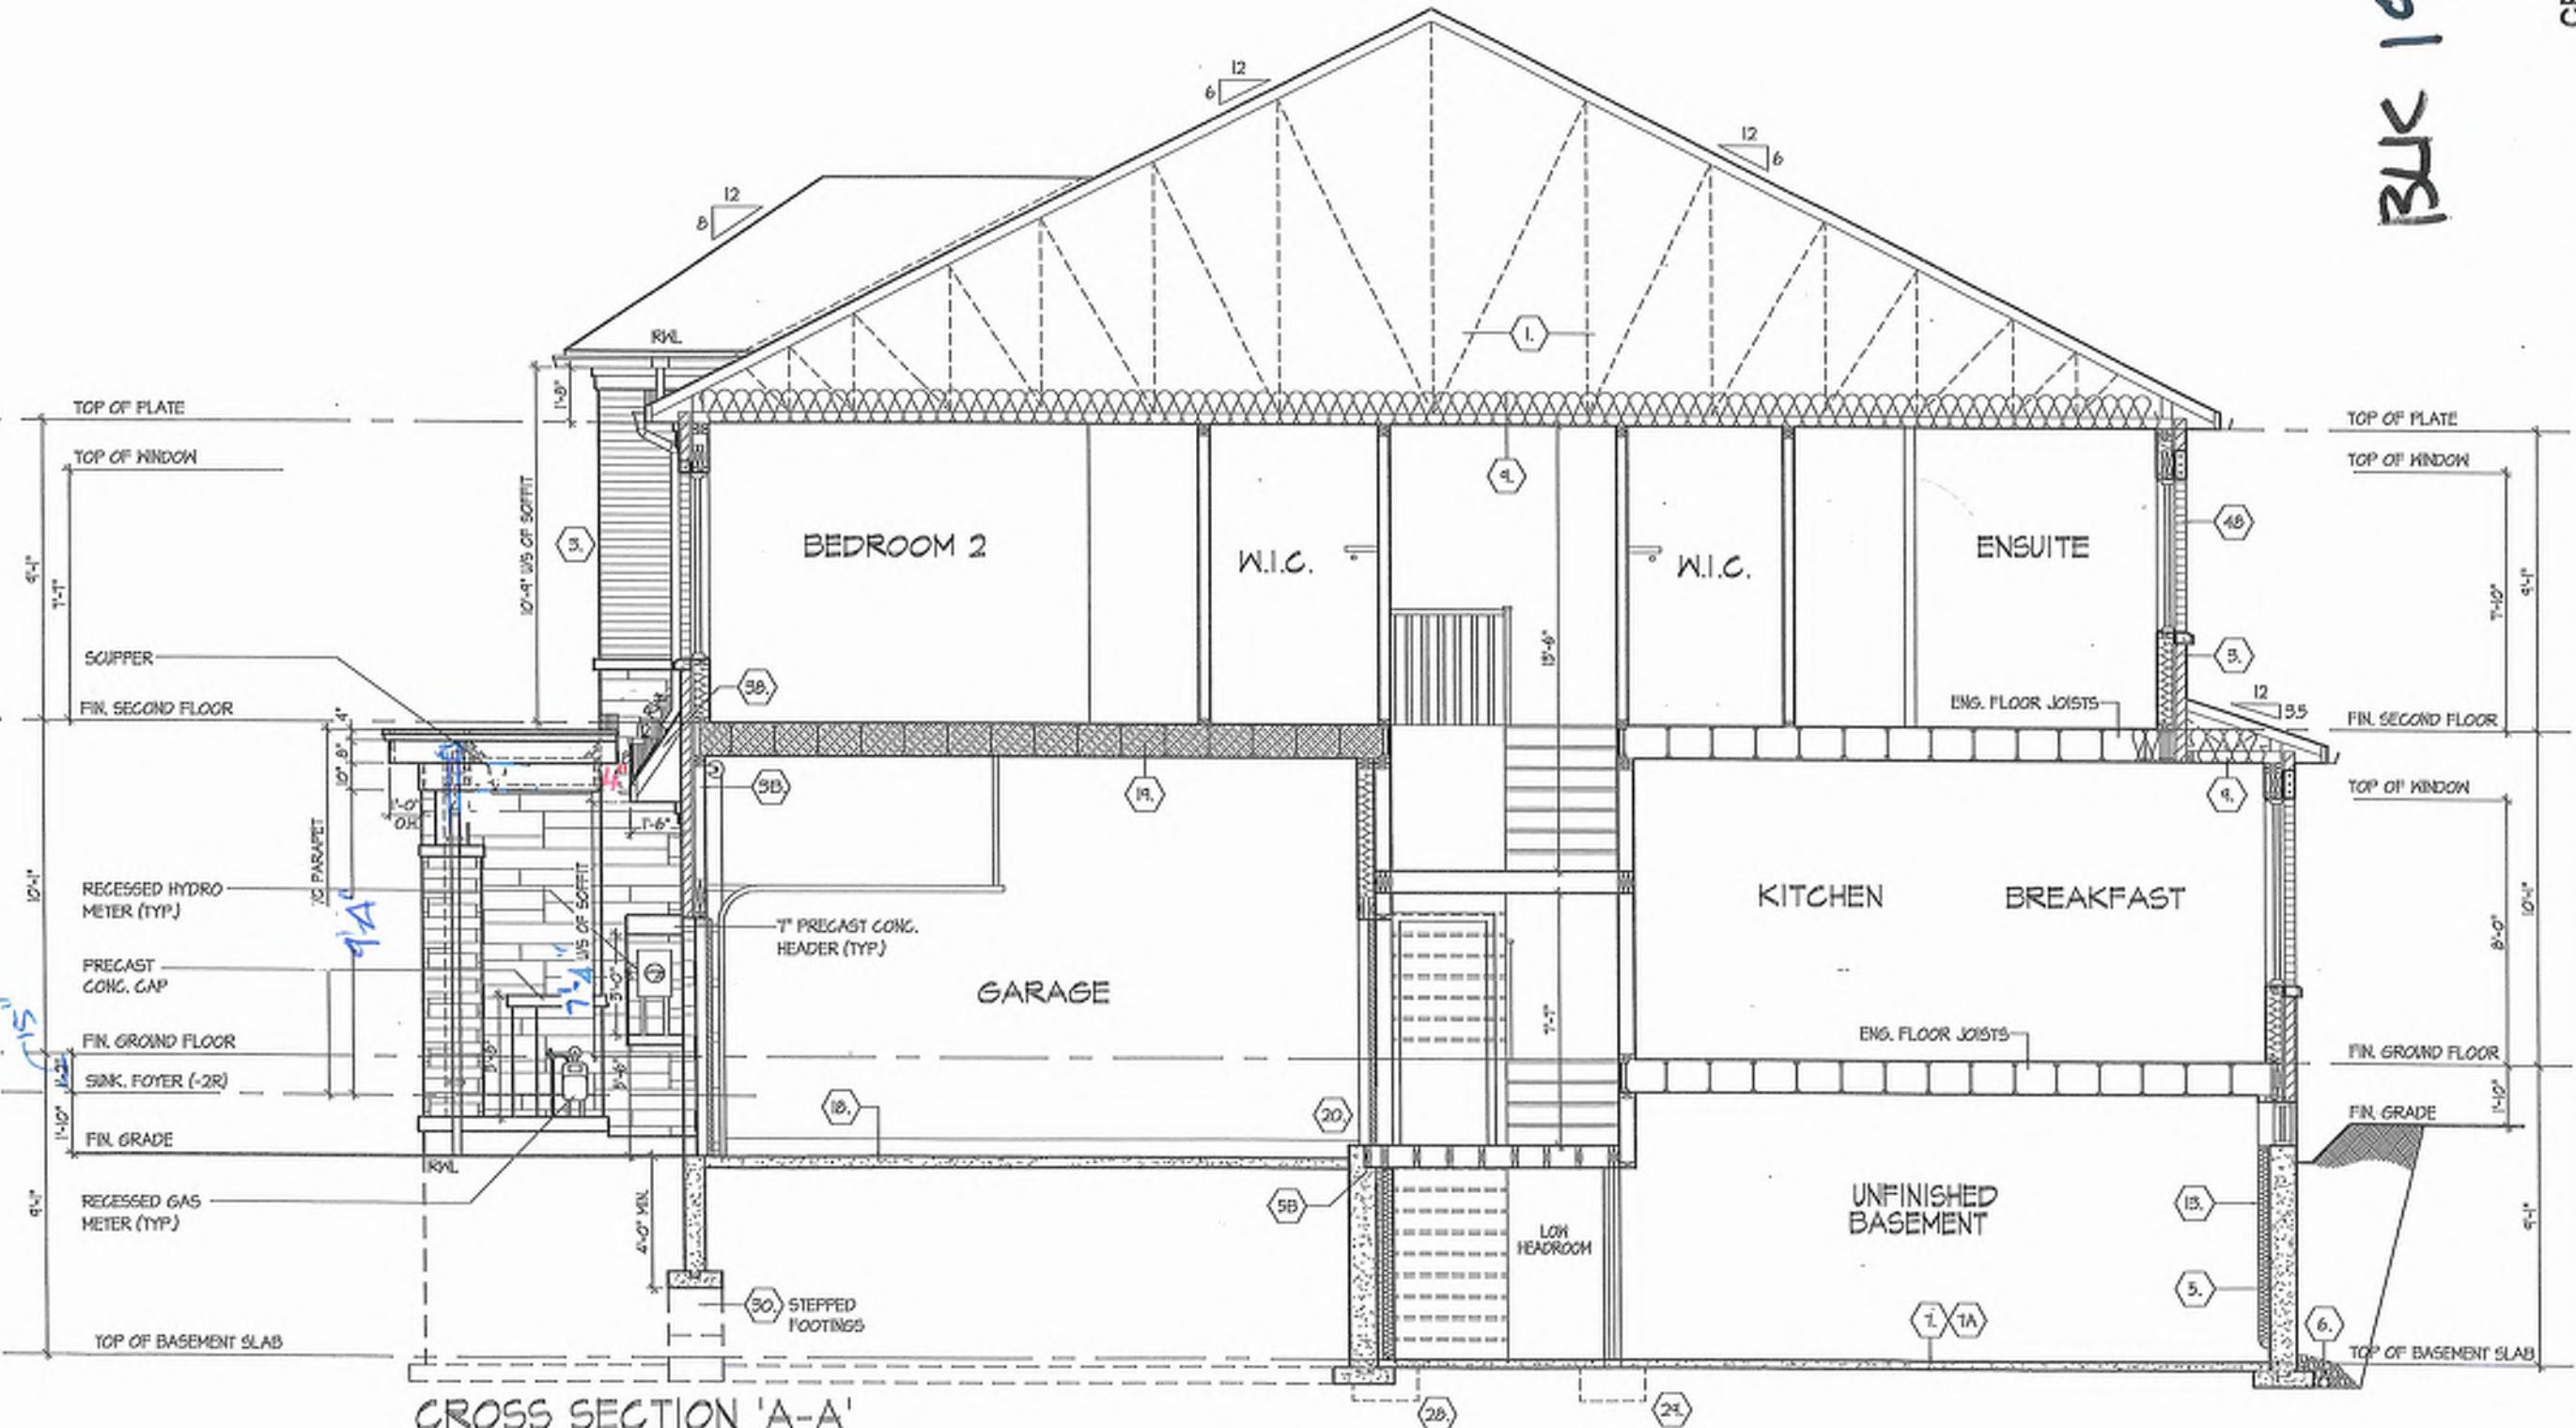

SECTION 1.0. CONSTRUCTION NOTES

REFER TO SB-12 ENERGY EFFICIENCY DESIGN MATRIX ON THE TITLE PAGE FOR ALL VALUES AS REQUIRED PER 3.1.1, 3.1.2, 3.1.3. OF THE D.O.C.

REFER TO SB-12 ENERGY EFFICIENCY DESIGN MATRIX ON THE TITLE PAGE FOR ALL VALUES AS REQUIRED PER 3.1.1, 3.1.2, 3.1.3. OF THE O.B.C.

THE UNDERSIGNED HAS REVIEWED AND TAKES RESPONSIBILITY FOR THE DESIGN AND WAS THE QUALIFICATIONS AND MEETS THE REQUIREMENTS SET OUT IN THE CRAFTS BUILDING CODE TO BE A DESIGNER.

QUALIFICATION INFORMATION:
Dominic Nobile
NAME: _____
REGISTRATION INFORMATION:
Signature _____
21274
BON

HUNT DESIGN ASSOCIATES INC.
13695
www.hundesign.com
19965 Woodbine Ave. Markham, ON L3R 4J7
T 905.737.5133 F 905.737.7325
As drawings specifications, referred documents, and designs are the copyright property of Hunt Design Associates Inc., Reproduction of this property in whole or in part is strictly prohibited without H.D.A.'s written permission. H.D.A. assumes no responsibility or liability for this property unless it bears its proprietary DCD number, and original signature.

cont. SECTION 1.0. CONSTRUCTION NOTES

REFER TO SB-12 ENERGY EFFICIENCY DESIGN MATRIX ON THE TITLE PAGE FOR ALL VALUES AS REQUIRED PER 3.1.1, 3.1.2, 3.1.3. OF THE O.B.C.

SECTION 2.0. GENERAL NOTES

2.1. WINDOWS

12' (12') GYPSUM SHEATHING ON EACH SIDE ON 2x2' (38x38) VERTICAL WD. STRAPPING @ 24" (600) O.C. ON 12' (380) CONG. BLOCK FILLED STUCCO. CARRY EACH SIDE WITH AT LEAST ONE ABSORPTIVE MATERIAL PROCESSED FROM ROCK, SLAG OR GLASS. TAPE, FELT AND ALL GYPSUM JOINTS. FURRED WITH 2x2' (38x38) WD. STRAPPING & 1/2" (12.7) GYPSUM SHEATHING.

40 1. HB. PARTY WALL, DOUBLE STUD. [SB-3] WALL TYPE B&E [B15]

12' (12') GYPSUM SHEATHING ON EXTERIOR SIDE OF 2 ROWS OF 12x12' (38x38) STUDS @ 16" (400) O.C., 12' (380) APART. ONE SIDE OF STUD CAVITY WITH AT LEAST 50% OF ABSORPTIVE MATERIAL PROCESSED FROM ROCK, SLAG OR GLASS. TAPE, FELT AND ALL GYPSUM JOINTS.

40A 2. HB. FIREWALL. [SB-3] WALL TYPE B&E [B15]

12' (12') GYPSUM SHEATHING ON EACH SIDE ON 2x2' (38x38) VERTICAL WD. STRAPPING @ 24" (600) O.C. ON 12' (380) CONG. BLOCK FILLED STUCCO. CARRY EACH SIDE WITH AT LEAST ONE ABSORPTIVE MATERIAL PROCESSED FROM ROCK, SLAG OR GLASS. TAPE, FELT AND ALL GYPSUM SHEATHING. FURRED WITH 2x2' (38x38) WD. STRAPPING & 1/2" (12.7) GYPSUM SHEATHING TO BE ATTACHED TO CONC. BLOCK. REFER TO DETAILS).

41 STUCCO WALL CONSTRUCTION. [2x6] W/ CONTIN. INSUL. STUCCO FINISH CONFORMING TO O.B.C. SECTION 19-28] AND APPLIED PER MANUFACTURERS SPECIFICATIONS OVER 1/2" (12.7) DENS. GLASS GOLD GYPSUM BOARD. APPROVED DRAINAGE MAT ON 12' (380) CONG. BLOCK. GOLD GYPSUM BOARD ON STUDS CONFORMING TO O.B.C. [19-23.10.1.1 & SECTION 11-1/2" (12.7) GYPSUM APPROVED 5 MIL POLYETHYLENE VAPOUR BARRIER, 1/2" (12.7) GYPSUM WALLBOARD INT. FINISH. REFER TO 36 NOTES AS REQUIRED).

41A STUCCO WALL CONSTRUCTION. [2x6] W/ CONTIN. INSUL. STUCCO FINISH CONFORMING TO O.B.C. SECTION 19-28] AND APPLIED PER MANUFACTURERS SPECIFICATIONS OVER 1/2" (12.7) DENS. GLASS GOLD GYPSUM BOARD. APPROVED DRAINAGE MAT ON APPROVED AIR-WATER BARRIER AS PER O.B.C. [6-27.3] ON EXTERIOR TYPE RIGID INSULATION (WANTS UNTESTED).

Mechanically fastened as per manufacturer's specifications on 11-1/2" (380) CONG. BLOCK. REINFORCING STAINLESS STEEL, 1/2" (12.7) GYPSUM BOARD. EXTERIOR TYPE SHEATHING ON STUDS CONFORMING TO O.B.C. [19-23.10.1.1 & SECTION 11-1/2" (12.7) GYPSUM WALLBOARD INT. FINISH. REFER TO 35 NOTES AS REQUIRED).

42 REINFORCED FOUNDATION WALLS. [3-15-4-2] PROVIDE STUD WALL REINFORCEMENT & MASONRY CONCRETE. CONFORMING TO O.B.C. [3-5.2-4(1)] REFER TO DETAILS).

43 WINDOW WELLS WHERE A 2x5' (60x152) WINDOW WELL SHALL BE PROVIDED IN FRONT OF THE WINDOW. OTHER STUD ELEMS. MUST BE DRILLED TO THE FOOTING LEVEL OR OTHER STUD ELEM. LOCATED WITH A 1" (25mm) WEEING TIE CLOTH WRAP AND FILLED WITH CRUSHED STONE. [93-10-1.13]. [14-4-3]

44 SLOPED CEILING CONSTRUCTION. [18-12-1] (3-11-16). [9-23-2-2] FOR DRAILINGS USING CONTIN. INSULATION CONSTRUCTION. OVER FLOORING (AS RECD) AND STUDS IN LIEU OF 1/2" (12.7) EXTERIOR TYPE SHEATHING OVER APPROVED DRAINAGE MAT ON 12' (380) CONG. GLASS GOLD GYPSUM BOARD. 2-20M BARS IN TOP PORTION OF WALL TO 10% OPENING. 4-20M BARS IN TOP PORTION OF WALL TO 15% OPENING. - BARS STACKED AT INFERIOR FACE OF WALL.

REINFORCING AT STAIRS AND SUNKEN FLOOR AREAS CONFORMING MEMBRANE [6-26.11.16-26.16] FULLY ADHERED TO 2x8' (38x38) WD. SPACERS LAD. PLATE ON 2x10' (38x225) SPR. #2 TO 2x8' (38x38) WD. SPACERS LAD PLATE PARALLEL TO JOISTS. ON 12' (380) WD. SPACERS @ 16" (400) O.C. (UNLESS OTHERWISE NOTED). BLT UP CLIP TO BE 4" (100) MM. ABOVE FINISHED BALCONY FLOOR. CONTINUOUS LT TRIM CROP EDGE TO BE PROVIDED ON OUTSIDE FACE OF CURB. SCUPPER DRAIN TO BE LOCATED 24" (600) MM. AWAY FROM HOLE. PREFINISHED ALUMINUM OR PANEL FOR UNDERSIDE OF SOFFIT 19-23.3. REINFORCE CURB WHERE REQ.

BALCONY CONDITION. WATERPROOFING MEMBRANE [6-26.11.16-26.16] FULLY ADHERED TO 2x8' (38x38) WD. SPACERS LAD PLATE ON 2x10' (38x225) SPR. #2 TO 2x8' (38x38) WD. SPACERS LAD PLATE PARALLEL TO JOISTS. ON 12' (380) WD. SPACERS @ 16" (400) O.C. (UNLESS OTHERWISE NOTED). BLT UP CLIP TO BE 4" (100) MM. ABOVE FINISHED BALCONY FLOOR. CONTINUOUS LT TRIM CROP EDGE TO BE PROVIDED ON OUTSIDE FACE OF CURB. SCUPPER DRAIN TO BE LOCATED 24" (600) MM. AWAY FROM HOLE. PREFINISHED ALUMINUM OR PANEL FOR UNDERSIDE OF SOFFIT 19-23.3. REINFORCE CURB WHERE REQ.

45 BARREL VAULT CONSTRUCTION. CANTILEVERED 2x4" (38x88) SPACERS LAD. PLATE ON 2x10' (38x225) SPR. #2 ROOF. JOIST NAMED TO BLT UP 3-1/4" (19) PLYWOOD HEADER PROFILED TO BARREL. SPRAY FOAM INSULATION BETWEEN JOISTS W/ GYPSUM BOARD. INTERFACER. REFER TO DETAILS).

46 EGRESS. WINDOW ABOVE GRADE. [6-9-10-1.1.16-8.6.1.5] SIZE PLATE PROOFBALCONY CONSTRUCTION NOTE FOR ASSEMBLY. REFER TO PLANS FOR FLOOR JOIST SIZE & REFER TO HEX NOTE 9 FOR INSULATION AND INTERIOR FINISH.

47 CANTILEVERED 2x4" (38x88) SPACERS LAD. PLATE ON 2x10' (38x225) SPR. #2 ROOF. JOIST NAMED TO BLT UP 3-1/4" (19) PLYWOOD HEADER PROFILED TO BARREL. SPRAY FOAM INSULATION BETWEEN JOISTS W/ GYPSUM BOARD. INTERFACER. REFER TO DETAILS).

48 EGRESS. WINDOW ABOVE GRADE. [6-9-10-1.1.16-8.6.1.5] SIZE PLATE PROOFBALCONY CONSTRUCTION NOTE FOR ASSEMBLY. REFER TO PLANS FOR FLOOR JOIST SIZE & REFER TO HEX NOTE 9 FOR INSULATION AND INTERIOR FINISH.

49 SIZE & SPACING OF STUDS. O.B.C. REFERENCE: TABLE 9-23.10.1.1.

MIN. STUD SIZE, IN (MM) MAX. UNSUPPORTED HEIGHT, FEET (M)

ROOF W. OR WD. SPACERS @ 16" (400) 18' (5.4) 12' (3.6) 12' (3.6) 12' (3.6)

WD. SPACERS @ 16" (400) 9' (2.7) 9' (2.7) 9' (2.7) 9' (2.7)

MAX. STUD SPACING, IN (MM) O.C.

24' (7.3) 9'-10" (3.0) 9'-10" (3.0) 9'-10" (3.0) 9'-10" (3.0)

24' (7.3) 24'-6" (7.3) 24'-6" (7.3) 24'-6" (7.3) 24'-6" (7.3)

(SB-14) - 9'-10" (3.0) 11'-10" (3.6) 5'-11" (1.8)

24' (7.3) 24'-6" (7.3) 24'-6" (7.3) 24'-6" (7.3) 24'-6" (7.3)

(SB-14) - 9'-10" (3.0) 11'-10" (3.6) 5'-11" (1.8)

24' (7.3) 24'-6" (7.3) 24'-6" (7.3) 24'-6" (7.3) 24'-6" (7.3)


(SB-14) - 9'-10" (3.0) 11'-10" (3.6) 5'-11" (1.8)

24' (7.3) 24'-6" (7.3) 24'-6" (7.3) 24'-6" (7.3) 24'-6" (7.3)</p




BAYVIEW HEIGHTS


RICHMOND HILL

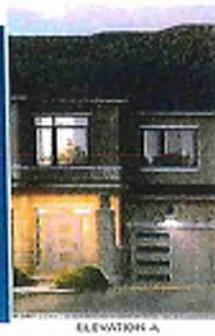


ELEVATION A

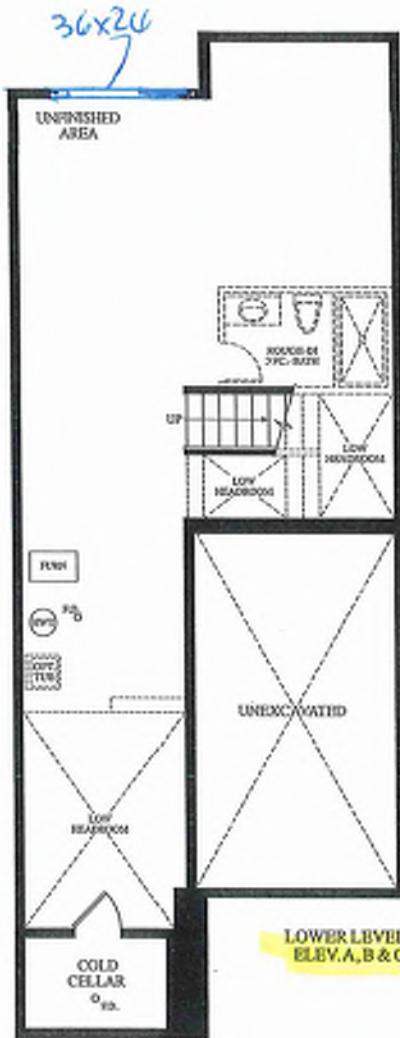

EXTENDED HEIGHT FRONT DOOR
66x98 1/2

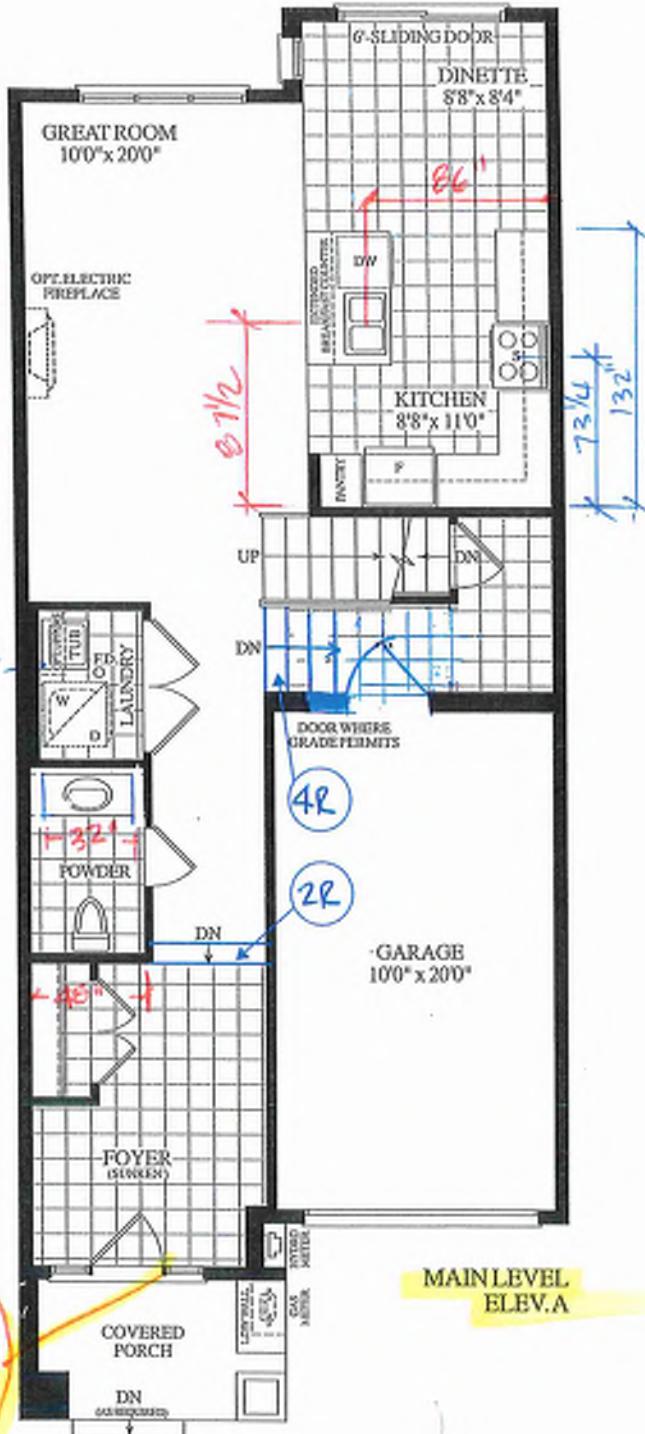

Materials, specifications and floor plans are subject to change without notice. All renderings are artist's concept. All floor plans are approximate dimensions. Actual usable floor space may vary from the stated floor area. E&OE.

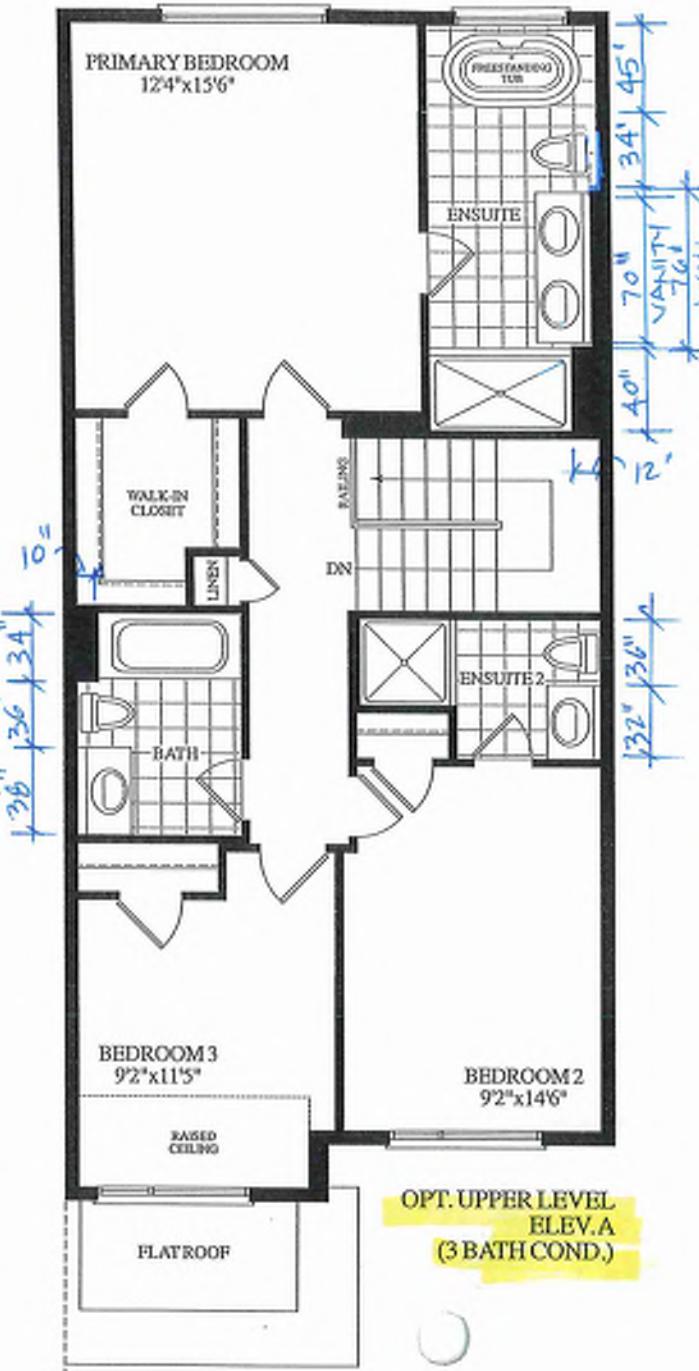

INVENTORY HOUSE

BLK. 19 TH. 122 20-15 THE ANNE

EL. A 3 BDRM 3 BATH

1685 SQ.FT.




RJIC 19-122




REVISED JUNE 5, 2025

GROUND TO SECOND
122, HT 11-7/8, JD151

BSMT 11-7/8" JOIST
BASEMENT TO GROUND

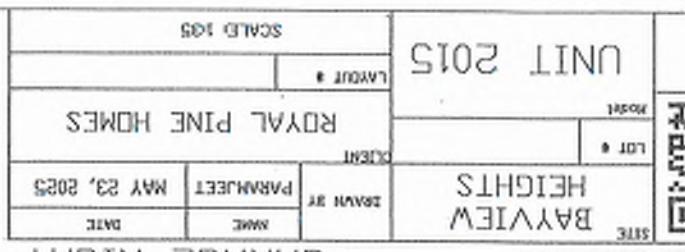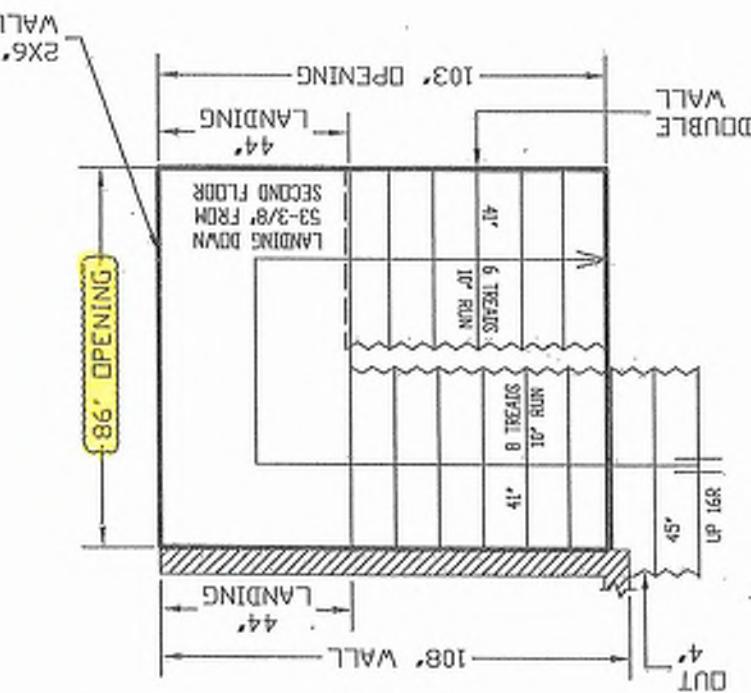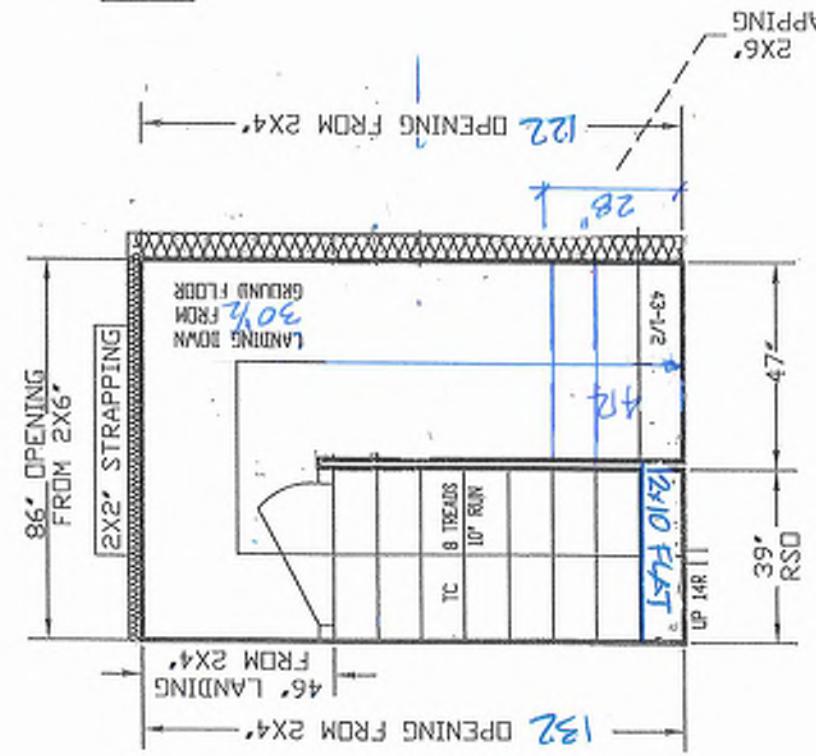

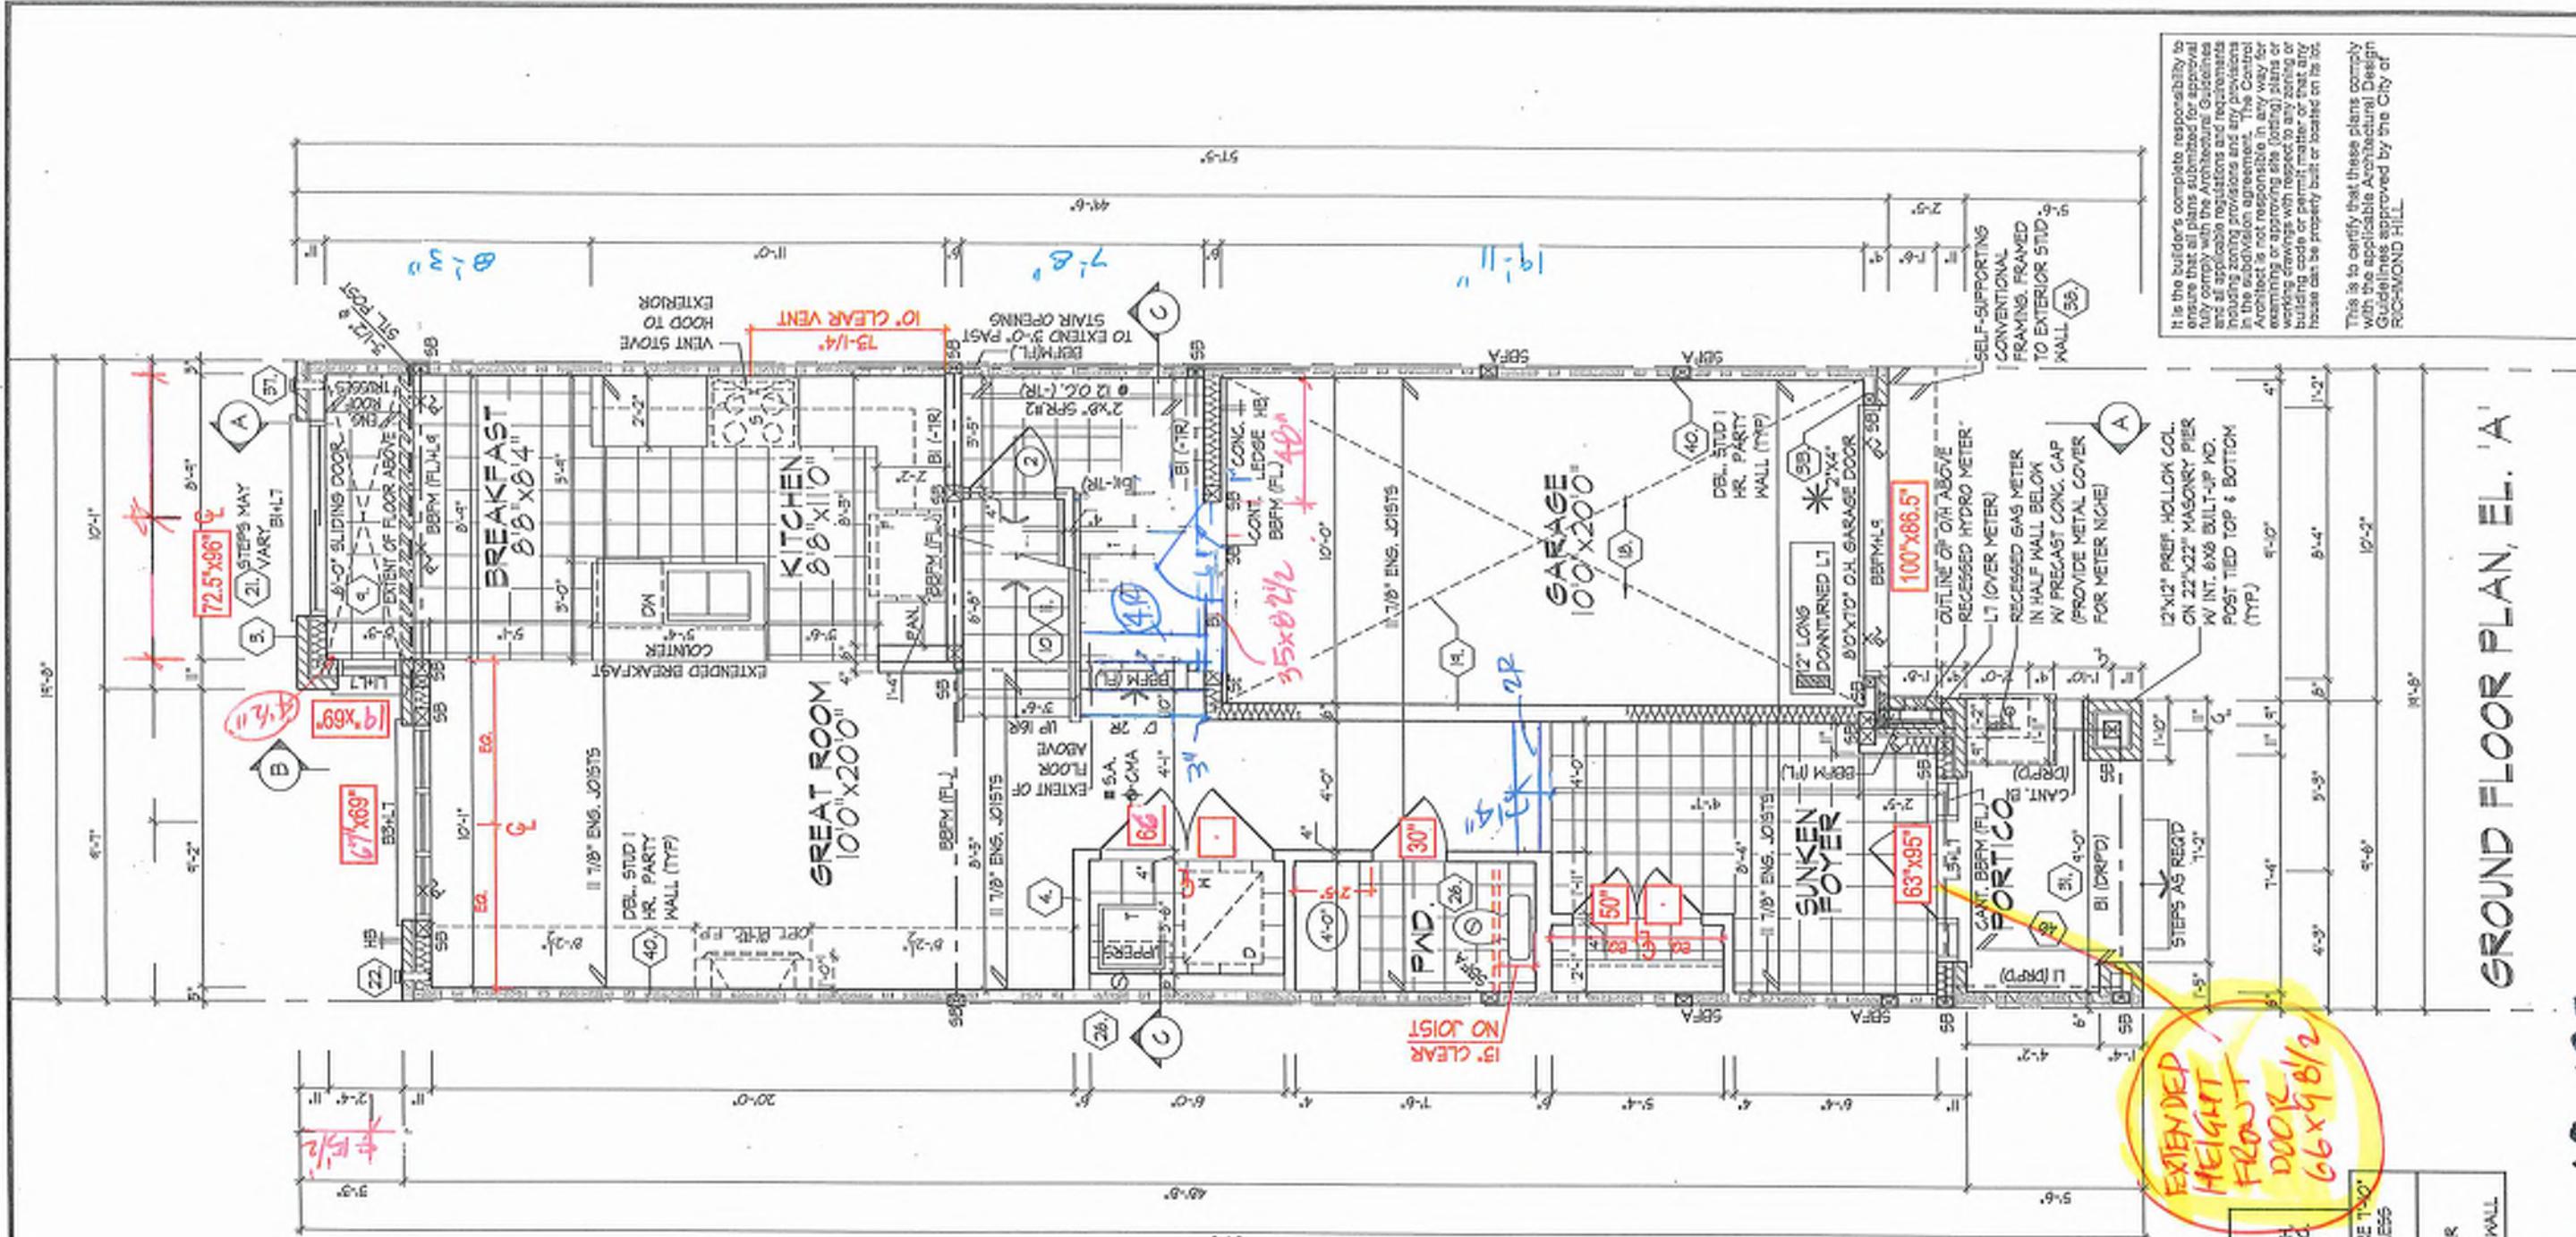

GROUND FLOOR PLAN, EL. A'

ROYAL PINE HOMES - 218094
921 BAYVIEW, RICHMOND HILL, ON.
DSMM
KMM
www.huntodesign.ca

HUNT
DESIGN ASSOCIATES INC.
9886 Woodbine Ave., Markham, ON L3R 3J7
T 905.737.5133 F 905.737.7320

UNIT 2015
REV.2025.03.25
Page Number
3 of 25

GROUND FLOOR PLAN, EL. A'


ROYAL PINE HOMES - 218094
921 BAYVIEW, RICHMOND HILL, ON.
DSMM
KMM
www.huntodesign.ca

HUNT
DESIGN ASSOCIATES INC.
9886 Woodbine Ave., Markham, ON L3R 3J7
T 905.737.5133 F 905.737.7320

UNIT 2015
REV.2025.03.25
Page Number
3 of 25

The undersigned has reviewed and takes responsibility for this design and that the calculations and meets the requirements set out in the onward building code to be a designer.
Dmitriy Melillo
Residential Information
HUNT DESIGN ASSOCIATES INC.
19886

All drawings, specifications, related documents and details are the copyright property of Hunt Design Associates (G.D.A.). Reproduction of this property in whole or in part is strictly prohibited without G.D.A.'s written permission. G.D.A. assumes no responsibility or liability for this property unless it bears the appropriate G.C.N. number and original document.

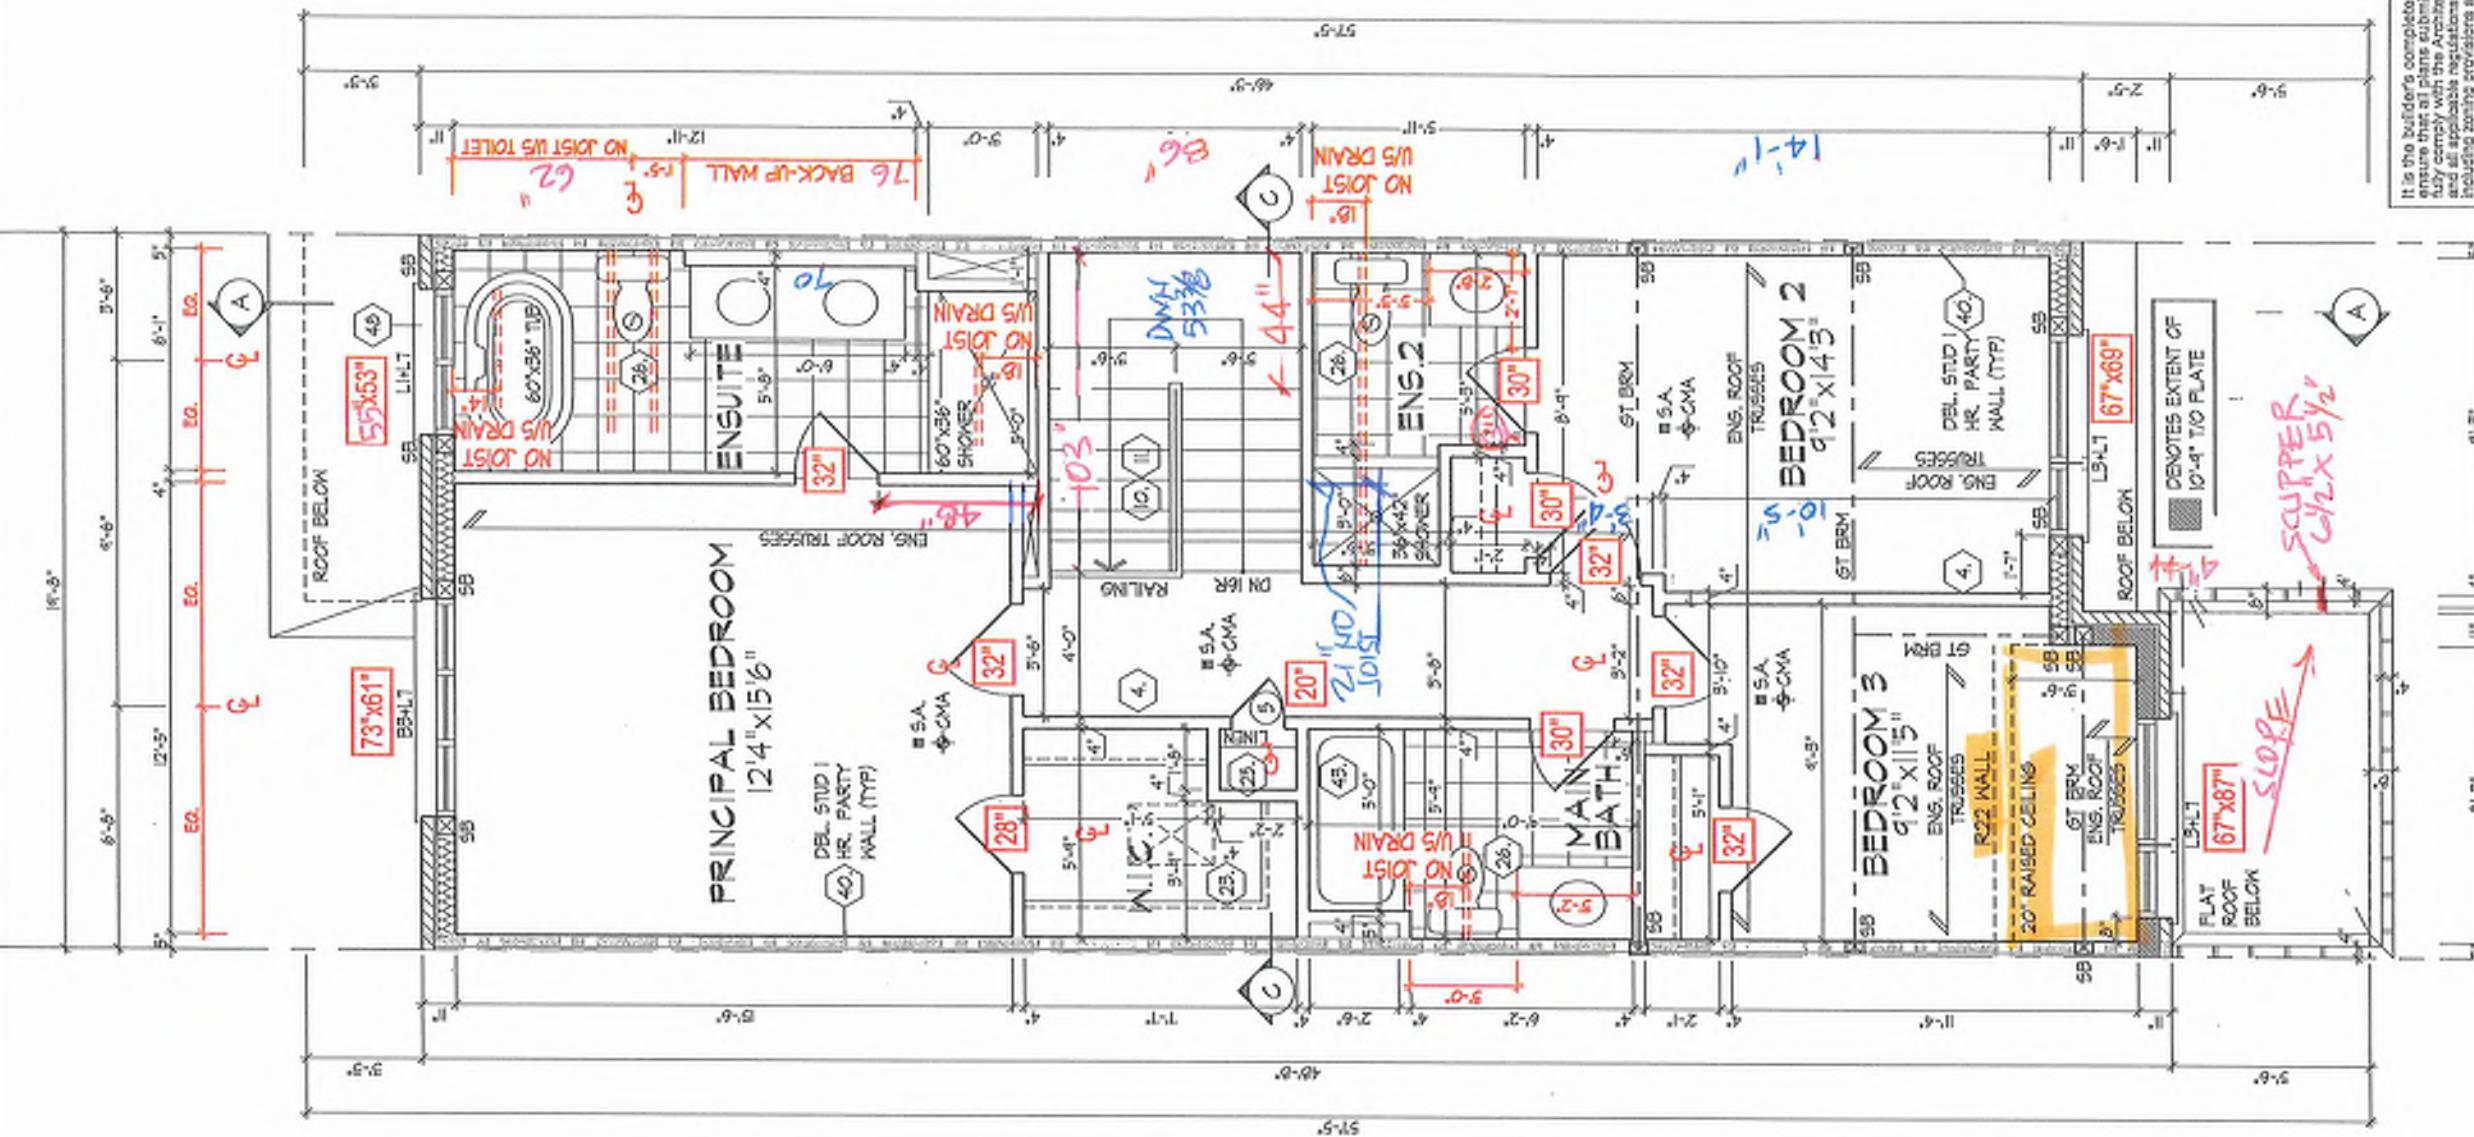

1st. DOORS & 3/2"
WINDOWS SEE B&U.

REFER TO ROOF TRUSS
MANUFACTURER'S DRAWINGS
FOR LAYOUT, SPACINGS,
INSTALLATION DETAILS AND
HANGER SIZES.

OPT. SECOND FLOOR
PLAN EL. 'A' W/ 3 BATHS

OPP. SECOND FLOOR

INSTALLATION DETAILS AND HANGER SIZES.


BYK 19-122

HOMES - 218094
UNIT 201

HOMES - 218094
UNIT 201

9221 BAYVIEW, RICHMOND HILL, ON.
Dwelling No. Checked By Date File Number
REV. 2025.0

DESIGN ASSOCIATES INC.
www.huntadesign.ca 865 Woodbine Ave., North York, ON M3J 2C7
316-11-0° D5/MM T 905.737.5133 F 905.737.7325
KAMM 2180949/T2015
© 2015 HDA. All rights reserved. HDA is a registered trademark of Hunt Associates Inc. in Canada and/or the United States and/or other countries.

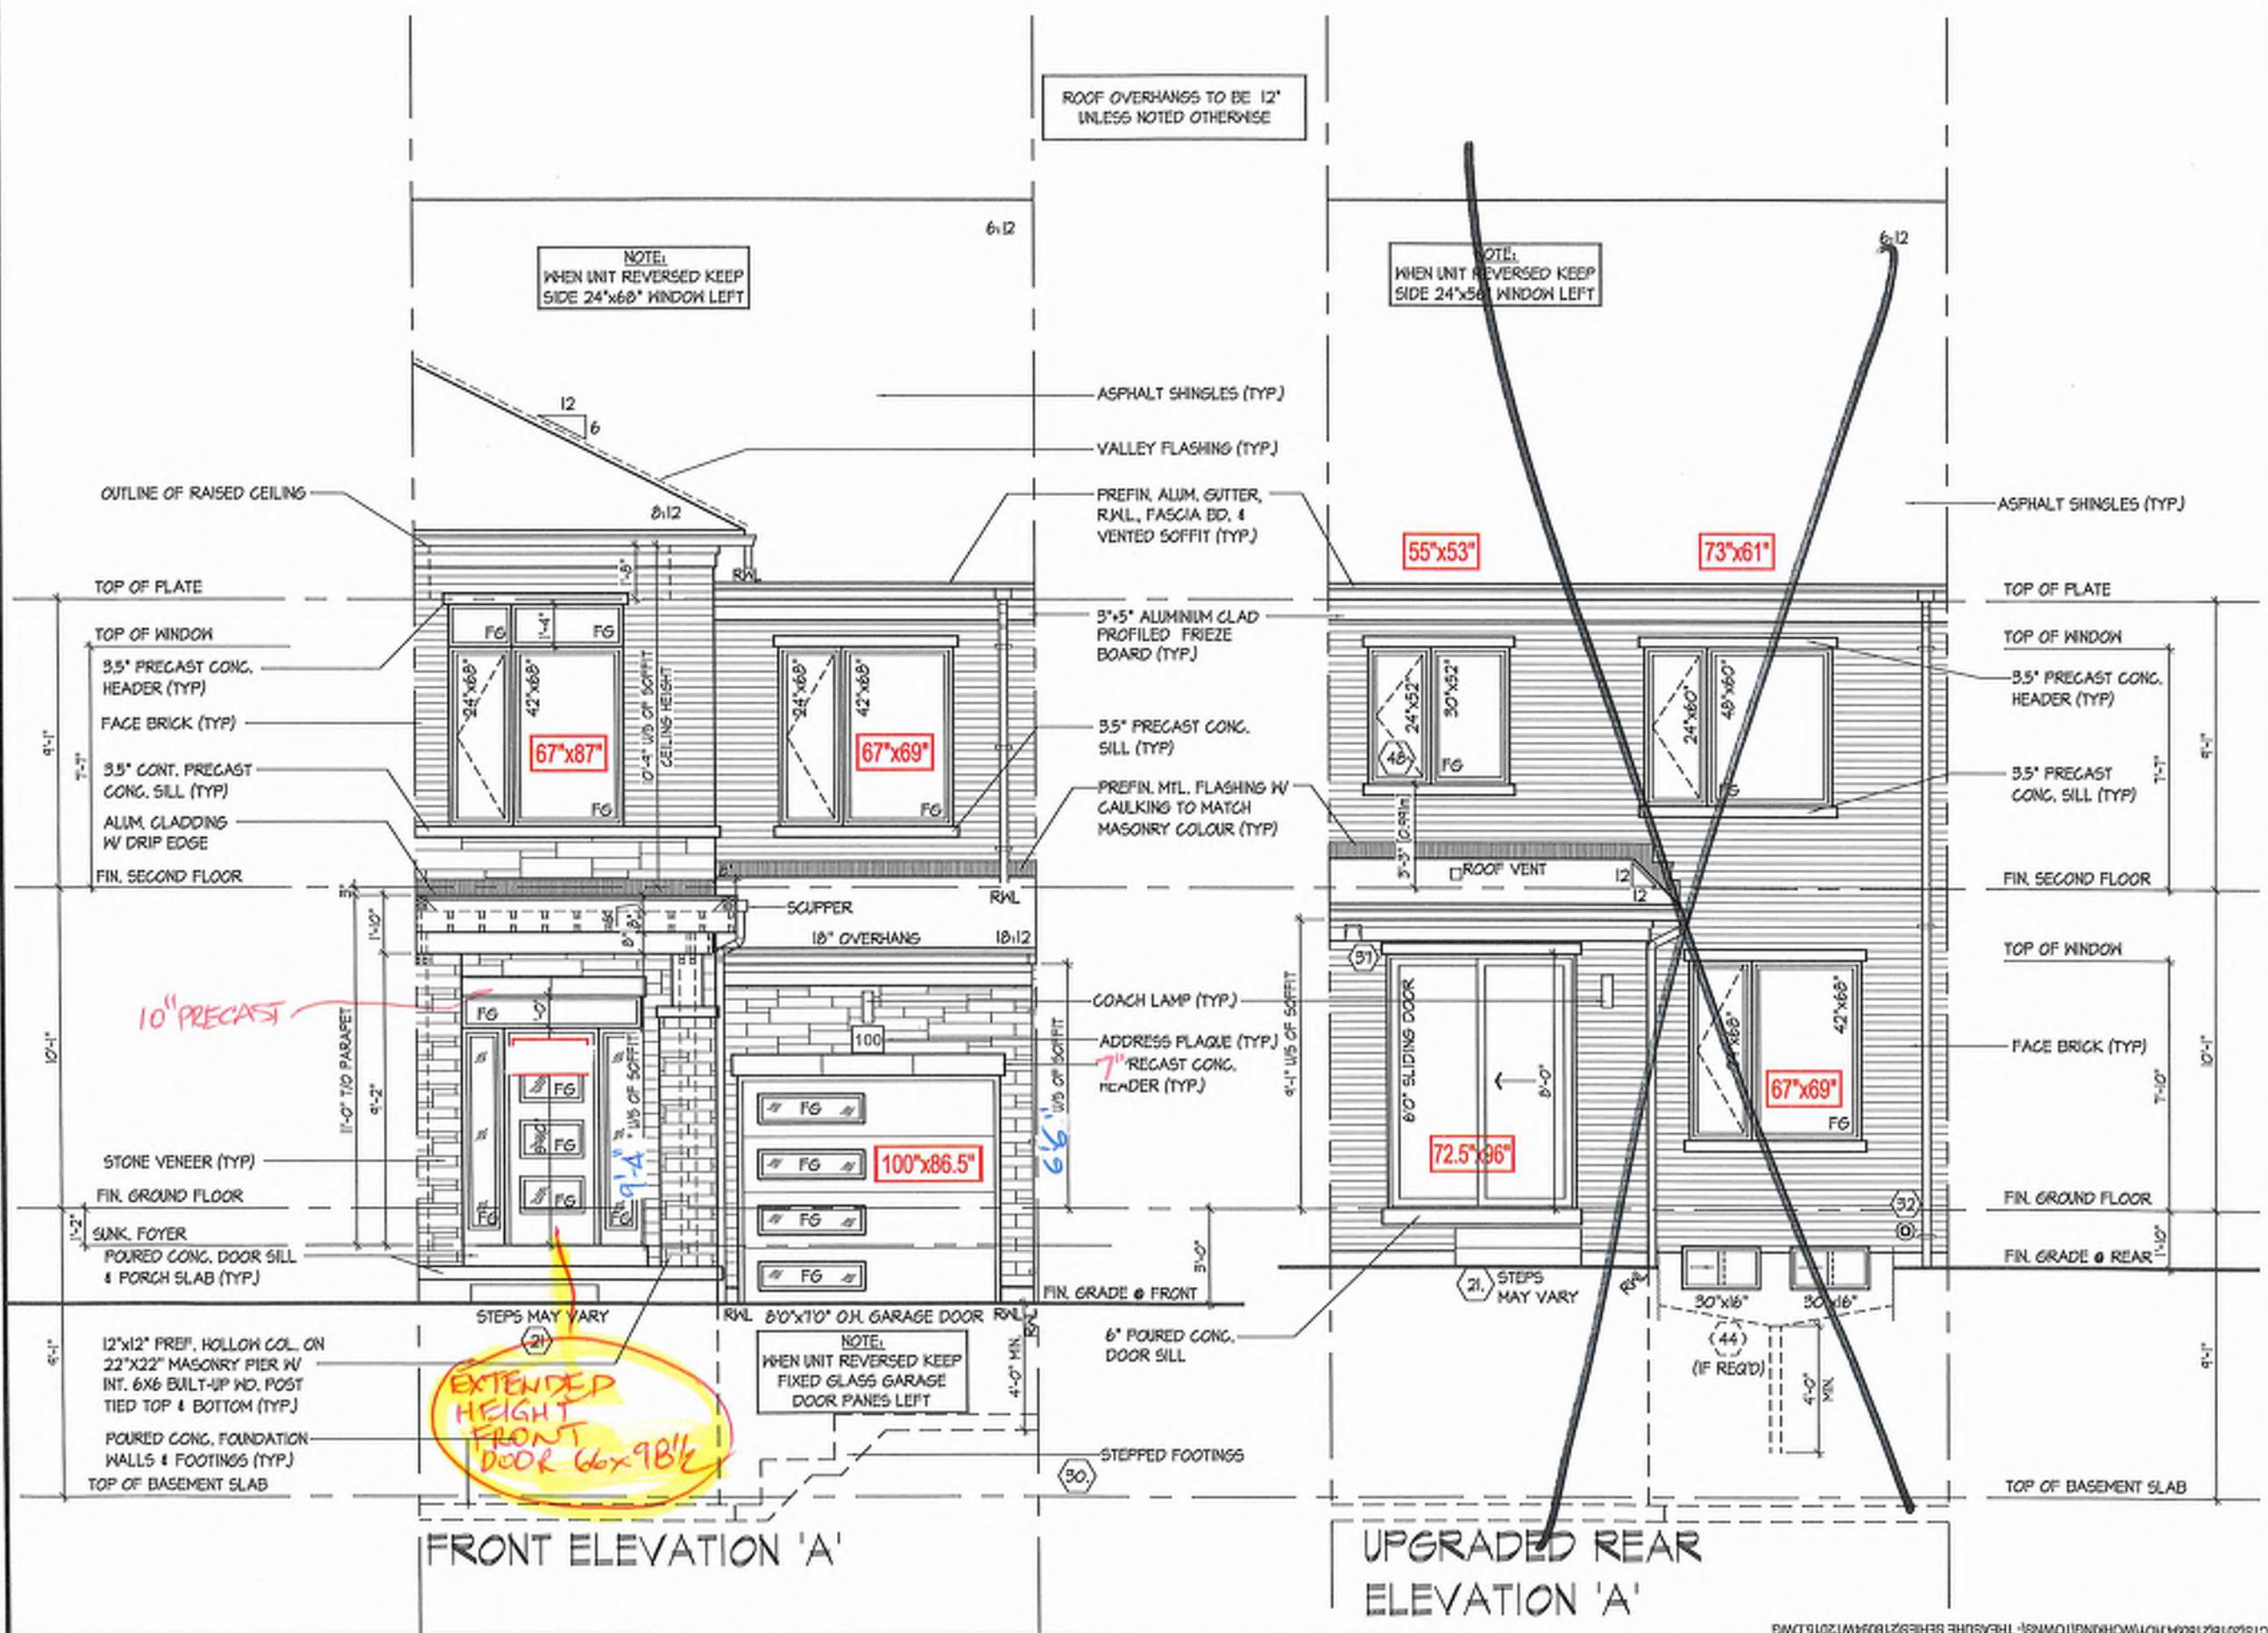

ROOF PLAN
EL. 'A'
N.T.S.

BUK 19
122

It is the intent of the City to ensure that all plans submitted for approval fully comply with the Architectural Guidelines and all applicable regulations and mechanisms including zoning regulations and any provisions in the Subdivision Agreement. The Control Architect is not responsible in any way for obtaining or approving site (zoning) plans or building drawings with respect to any zoning, building code or permit matter or that any house can be properly built or located on its lot. This is to certify that these plans comply with the applicable Architectural Design Guidelines approved by the City of RICHMOND HILL.

ROYAL PINE HOMES - 218094
921 BAYVIEW, RICHMOND HILL, ON.

FRONT ELEV. A & REAR UFG. ELEV. A
UNIT 2015
REV. 2025.03.25

UNIT 2015
REV.2025.03.25

Page Number
15 of 25

FRONT ELEV. A &

ROYAL PINE HOMES - 218094
921 BAYVIEW, RICHMOND HILL, ON.

Drawn By	Checked By	Date	File Number
KMM/M	DS/MM	3/16/07 - 11-0 ^c	218094WT2
B966 Woodbine Ave., Markham, ON L3R 0J7 T 905.737.5133 F 905.737.7326			

HUNT DESIGN ASSOCIATES INC.
www.hundtdesign.ca

Printed on this document in whole or in part is a trademark of Hunt Design Associates Inc. Hunt Design Associates Inc. assumes no responsibility or liability for this document unless it relates to a project for which it has been specifically prepared.


File Number
21-8094WT2
Date Issued
10/16/2014
Issuing Authority
Ontario Ministry of Natural Resources
Address
8965 Woodbine Ave., Markham, ON L3R 0J7
Phone
905.737.5133
Fax
905.737.7325
Comments
This document is valid for 1 year from the date of issue.
It is the responsibility of the持有人 to ensure it remains valid.

DESIGN ASSOCIATES
www.huntdesign.com

E THIS DESIGNER HAS PREPARED AND TAKES RESPONSIBILITY FOR THIS DESIGN AND HAS THE QUALIFICATIONS AND MEETS THE REQUIREMENTS SET OUT IN THE ONTARIO BUILDING CODE TO BE A DESIGNER.
QUALIFICATION INFORMATION
[www.oic.on.ca](#)

LOTTINGHORST
SARAH
REGISTRATION INFORMATION
HUNT DESIGN ASSOCIATES INC.
All driveline associations related documents and details are the copyright
of LOTTINGHORST SARAH. All rights reserved.


It is the builder's complete responsibility to ensure that all plans submitted for approval fully comply with the Architectural Guidelines and all applicable regulations and requirements including zoning provisions as set forth in the subdivision agreement. The Control Architect is not responsible in any way for examining or approving site (lotting) plans or building drawings with respect to any zoning or building codes or permit matters or that any house can be properly built or located on its lot. This is to certify that these plans comply with the applicable Architecture Design Guidelines approved by the City of RICHMOND HILL.

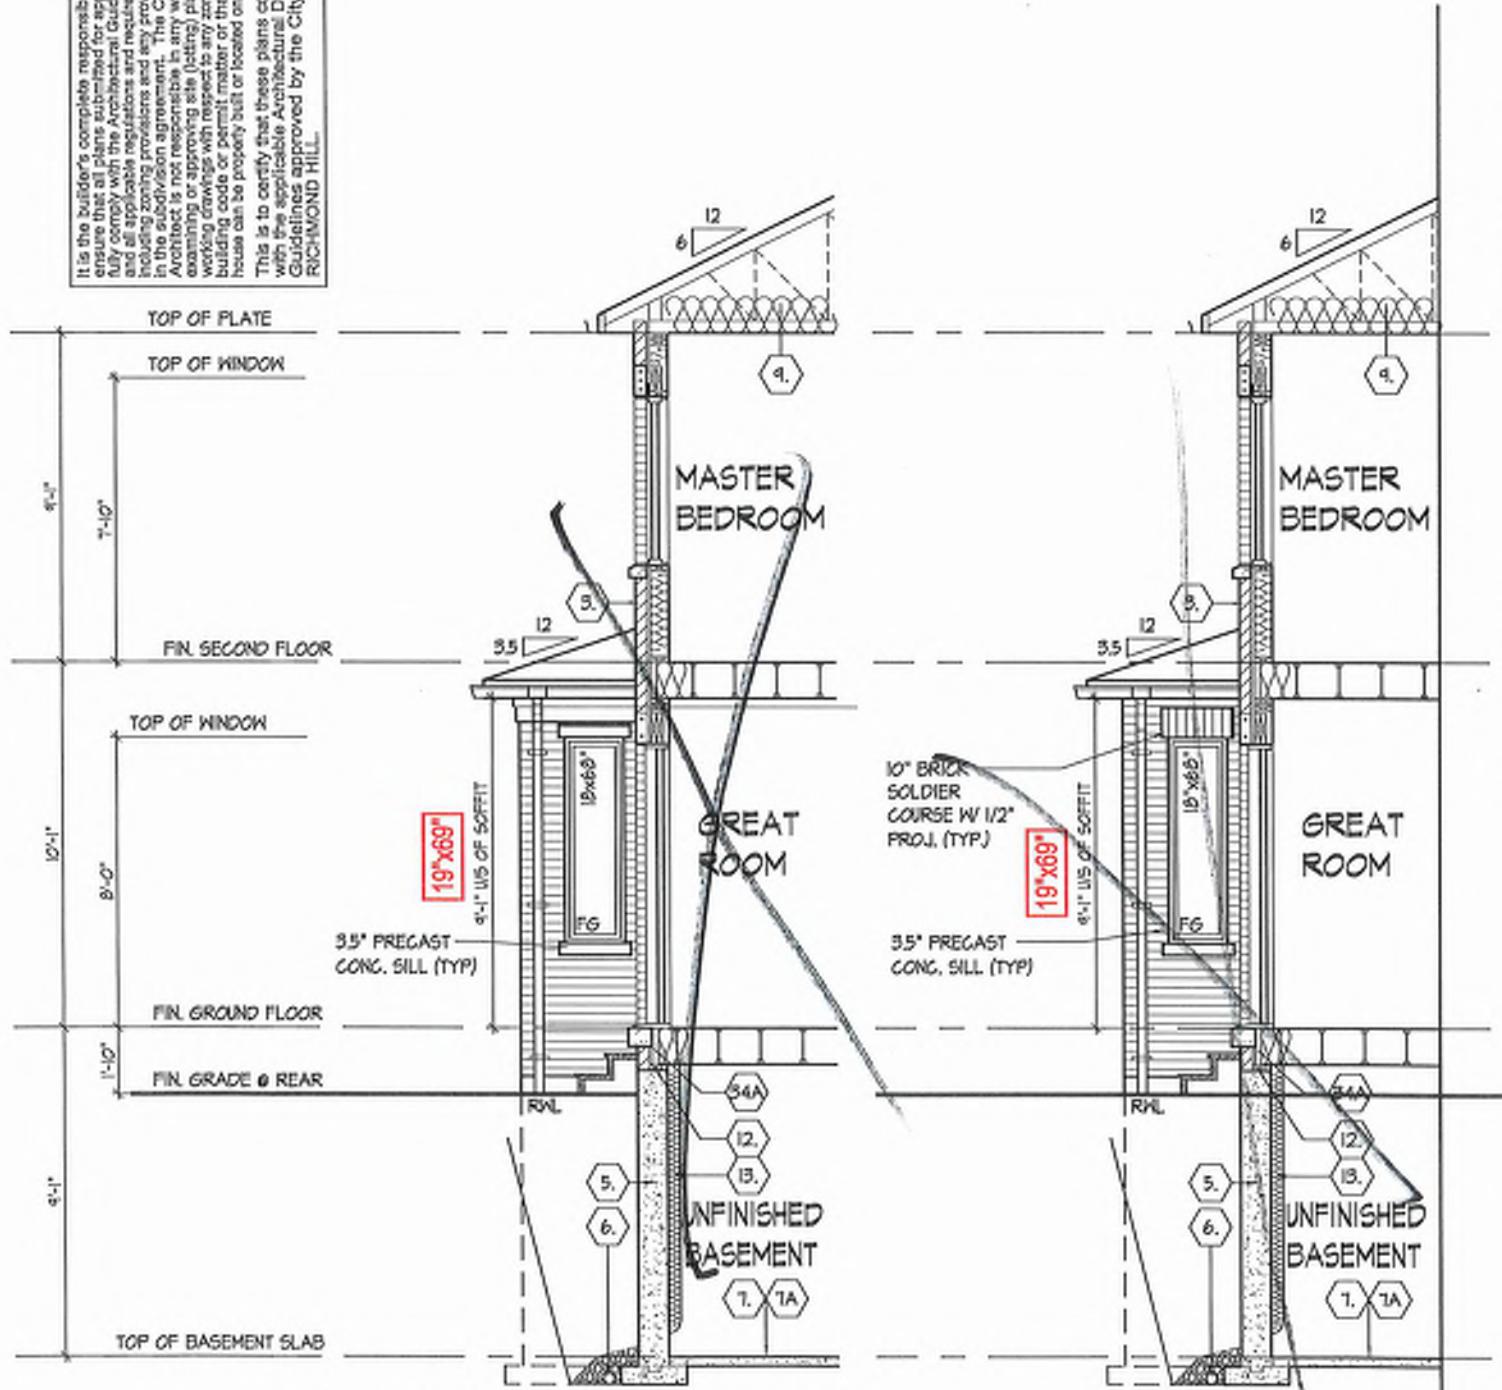

PART. SECTION 'B'
FOR UPGRADED REAR
FOR ELEV. 'A'

REFER TO FRONT
ELEVATION FOR TYPICAL
NOTES & INFORMATION

ROOF OVERHANGS TO BE 12"
UNLESS NOTED OTHERWISE

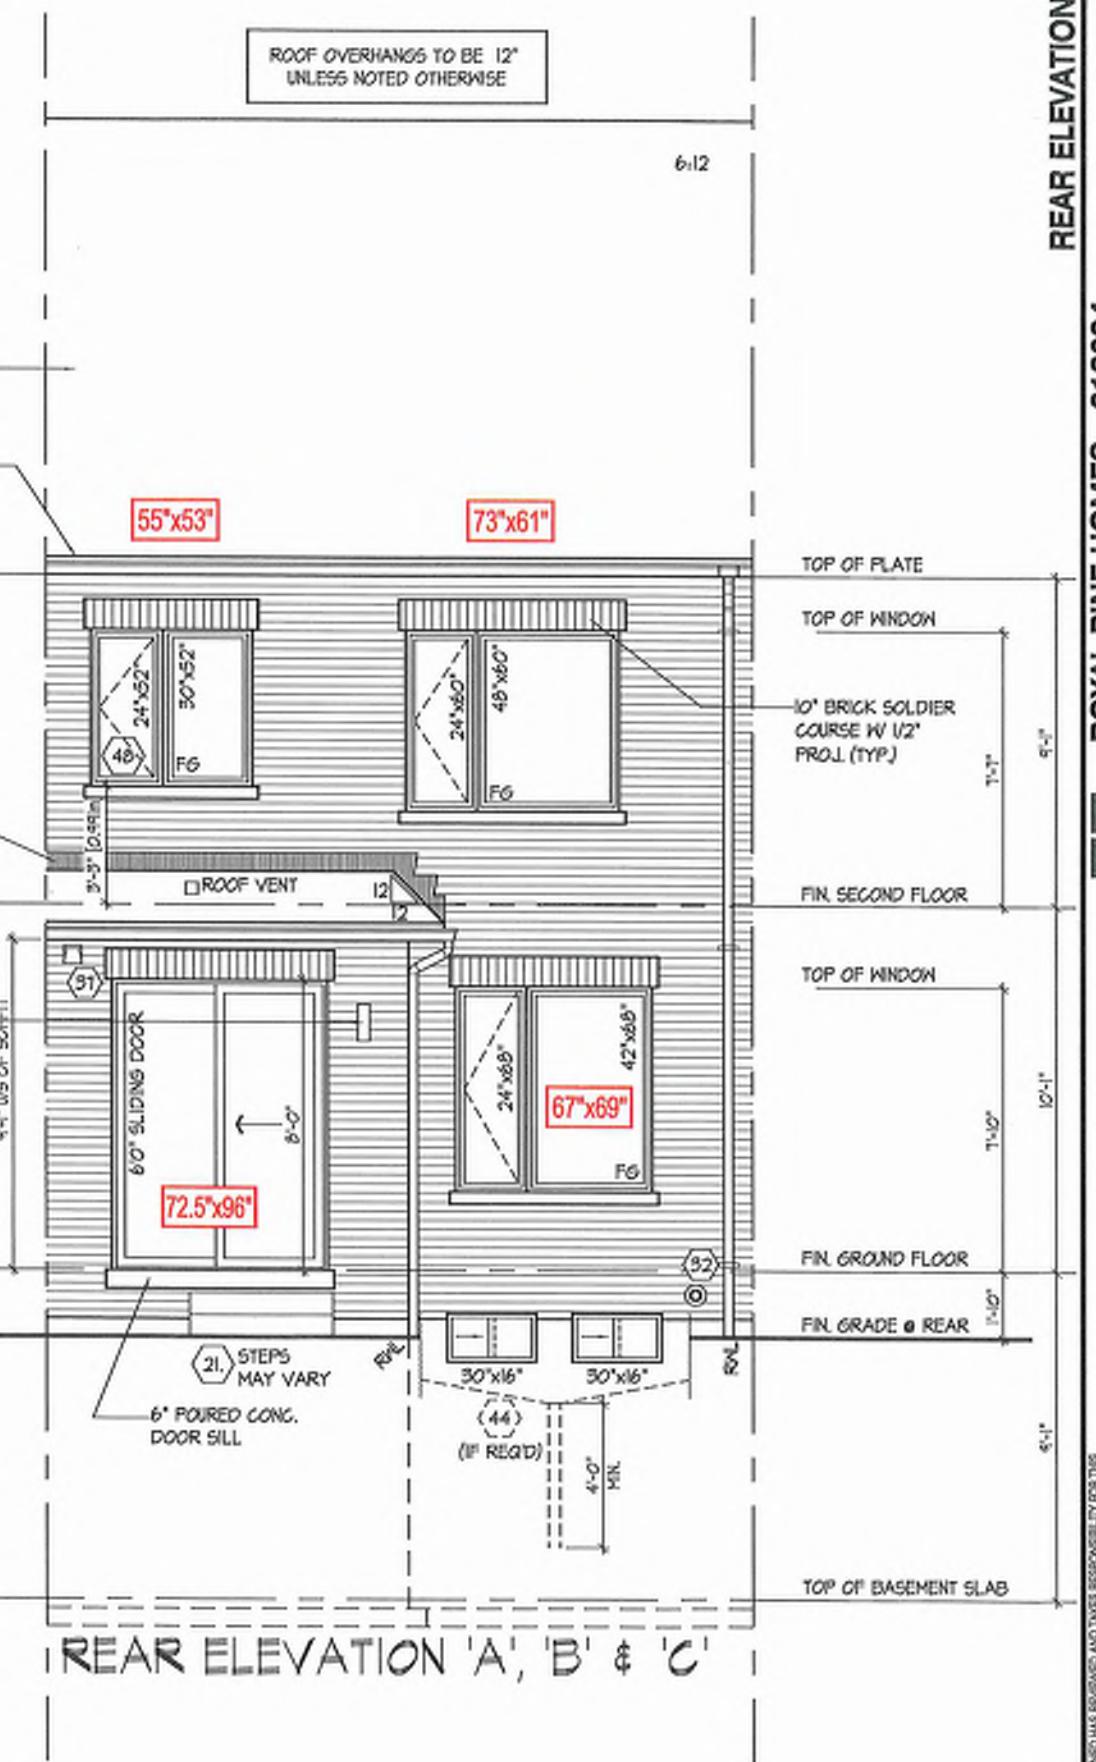

REAR ELEVATION 'A', 'B' & 'C'


REGISTRATION INFORMATION		CONFIRMATION INFORMATION
Hunt Design Associates Inc.	Qualification Mobile	Qualification Hunt Design Associates Inc.
2127 E. 10th Street	2127 E. 10th Street	2127 E. 10th Street
Bethesda, MD 20814	Bethesda, MD 20814	Bethesda, MD 20814
(301) 961-1000	(301) 961-1000	(301) 961-1000
		1995

All drawings, specifications, related documents and designs are the property of

ROYAL PINE HOMES - 218094	
921 BAYVIEW, RICHMOND HILL, ON.	
DESIGN ASSOCIATES INC.	Drawn By
HUNT	KW/MM
www.huntodesign.ca	Checked By
	DS/MM
	Date
	3/16/2015
	Job Number
	218094/T/2015
UNIT 2015	Page Number
REV.2025.03.25	16 of 25


1B FLAT ROOF DETAIL @ SIDE RETURN FOR ELEV. 'A' (ELEV. 'B' SIMILAR)

3/4"-1'-0"

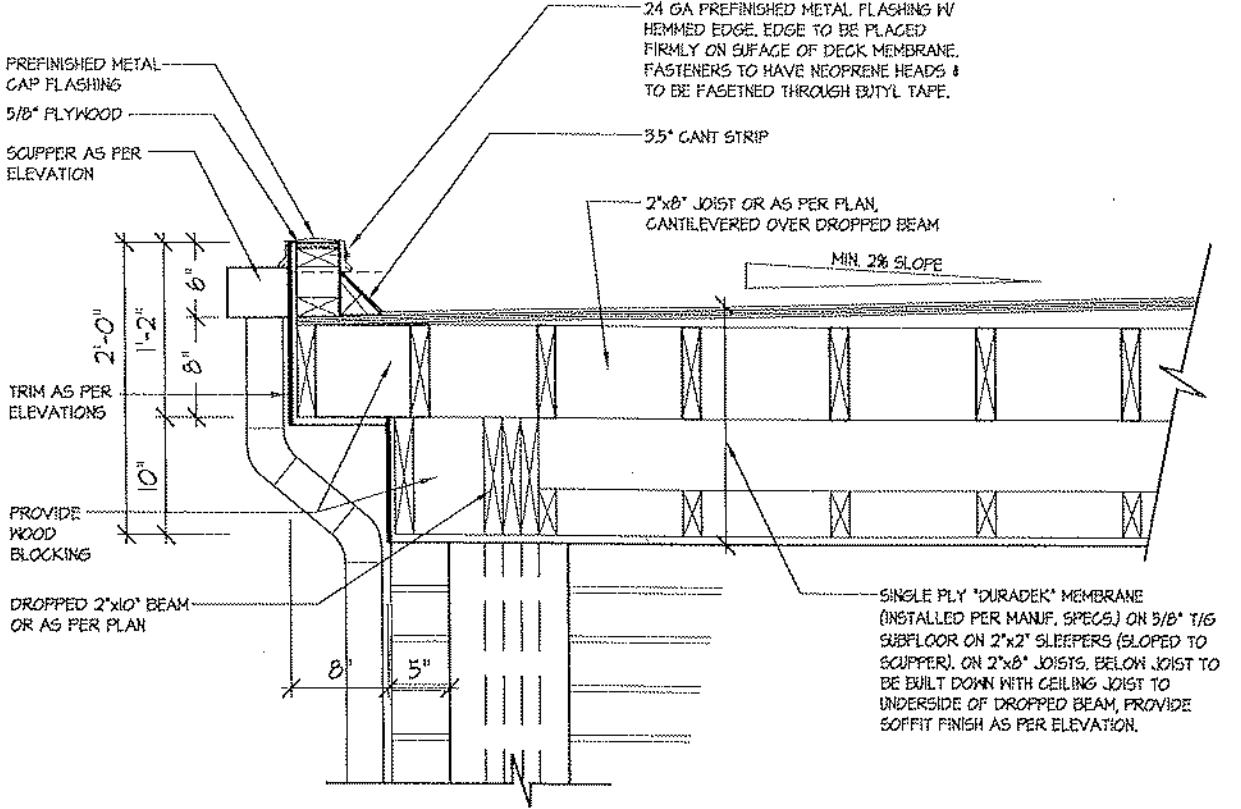

3 FLAT ROOF DETAIL @ EXTERIOR WALL


3/4"-1'-0"

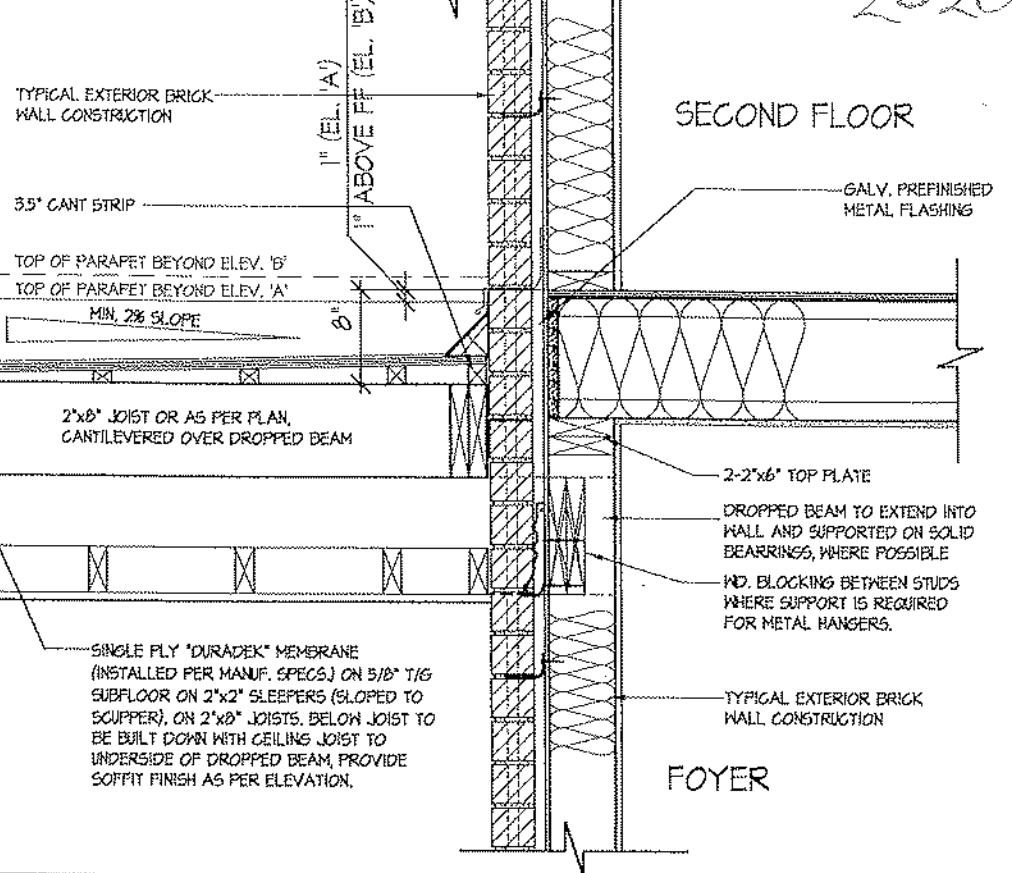

FOYER


1 FLAT ROOF DETAIL @ COVERED PORCH FOR ELEV. 'A'


3/4"-1'-0"


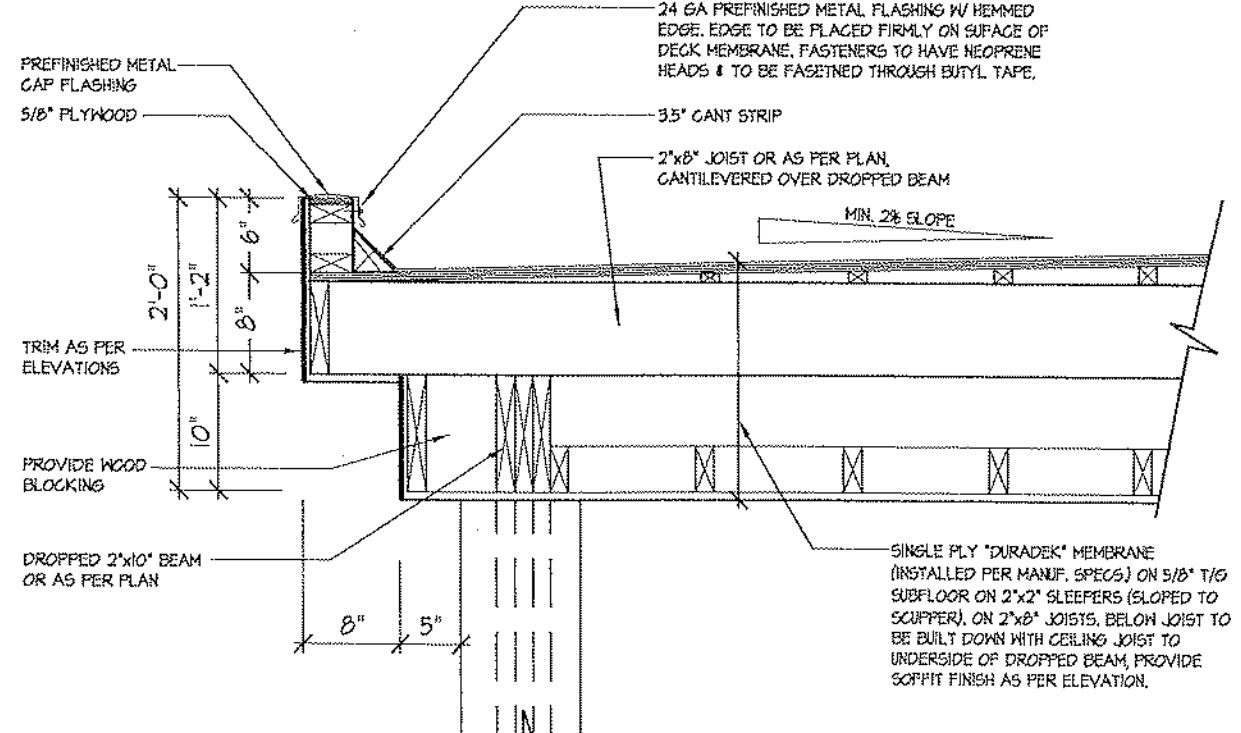


2 FLAT ROOF DETAIL @ COVERED PORCH FOR ELEV. 'B'

3/4"-1'-0"

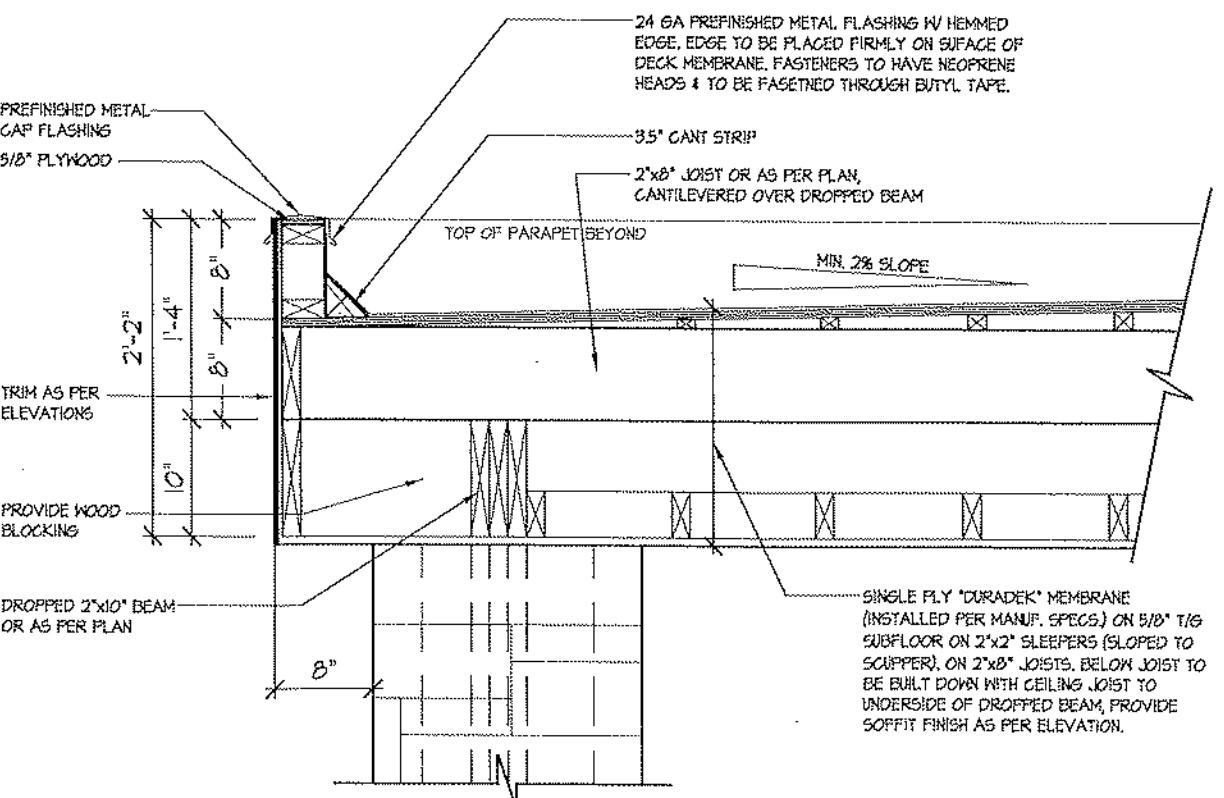

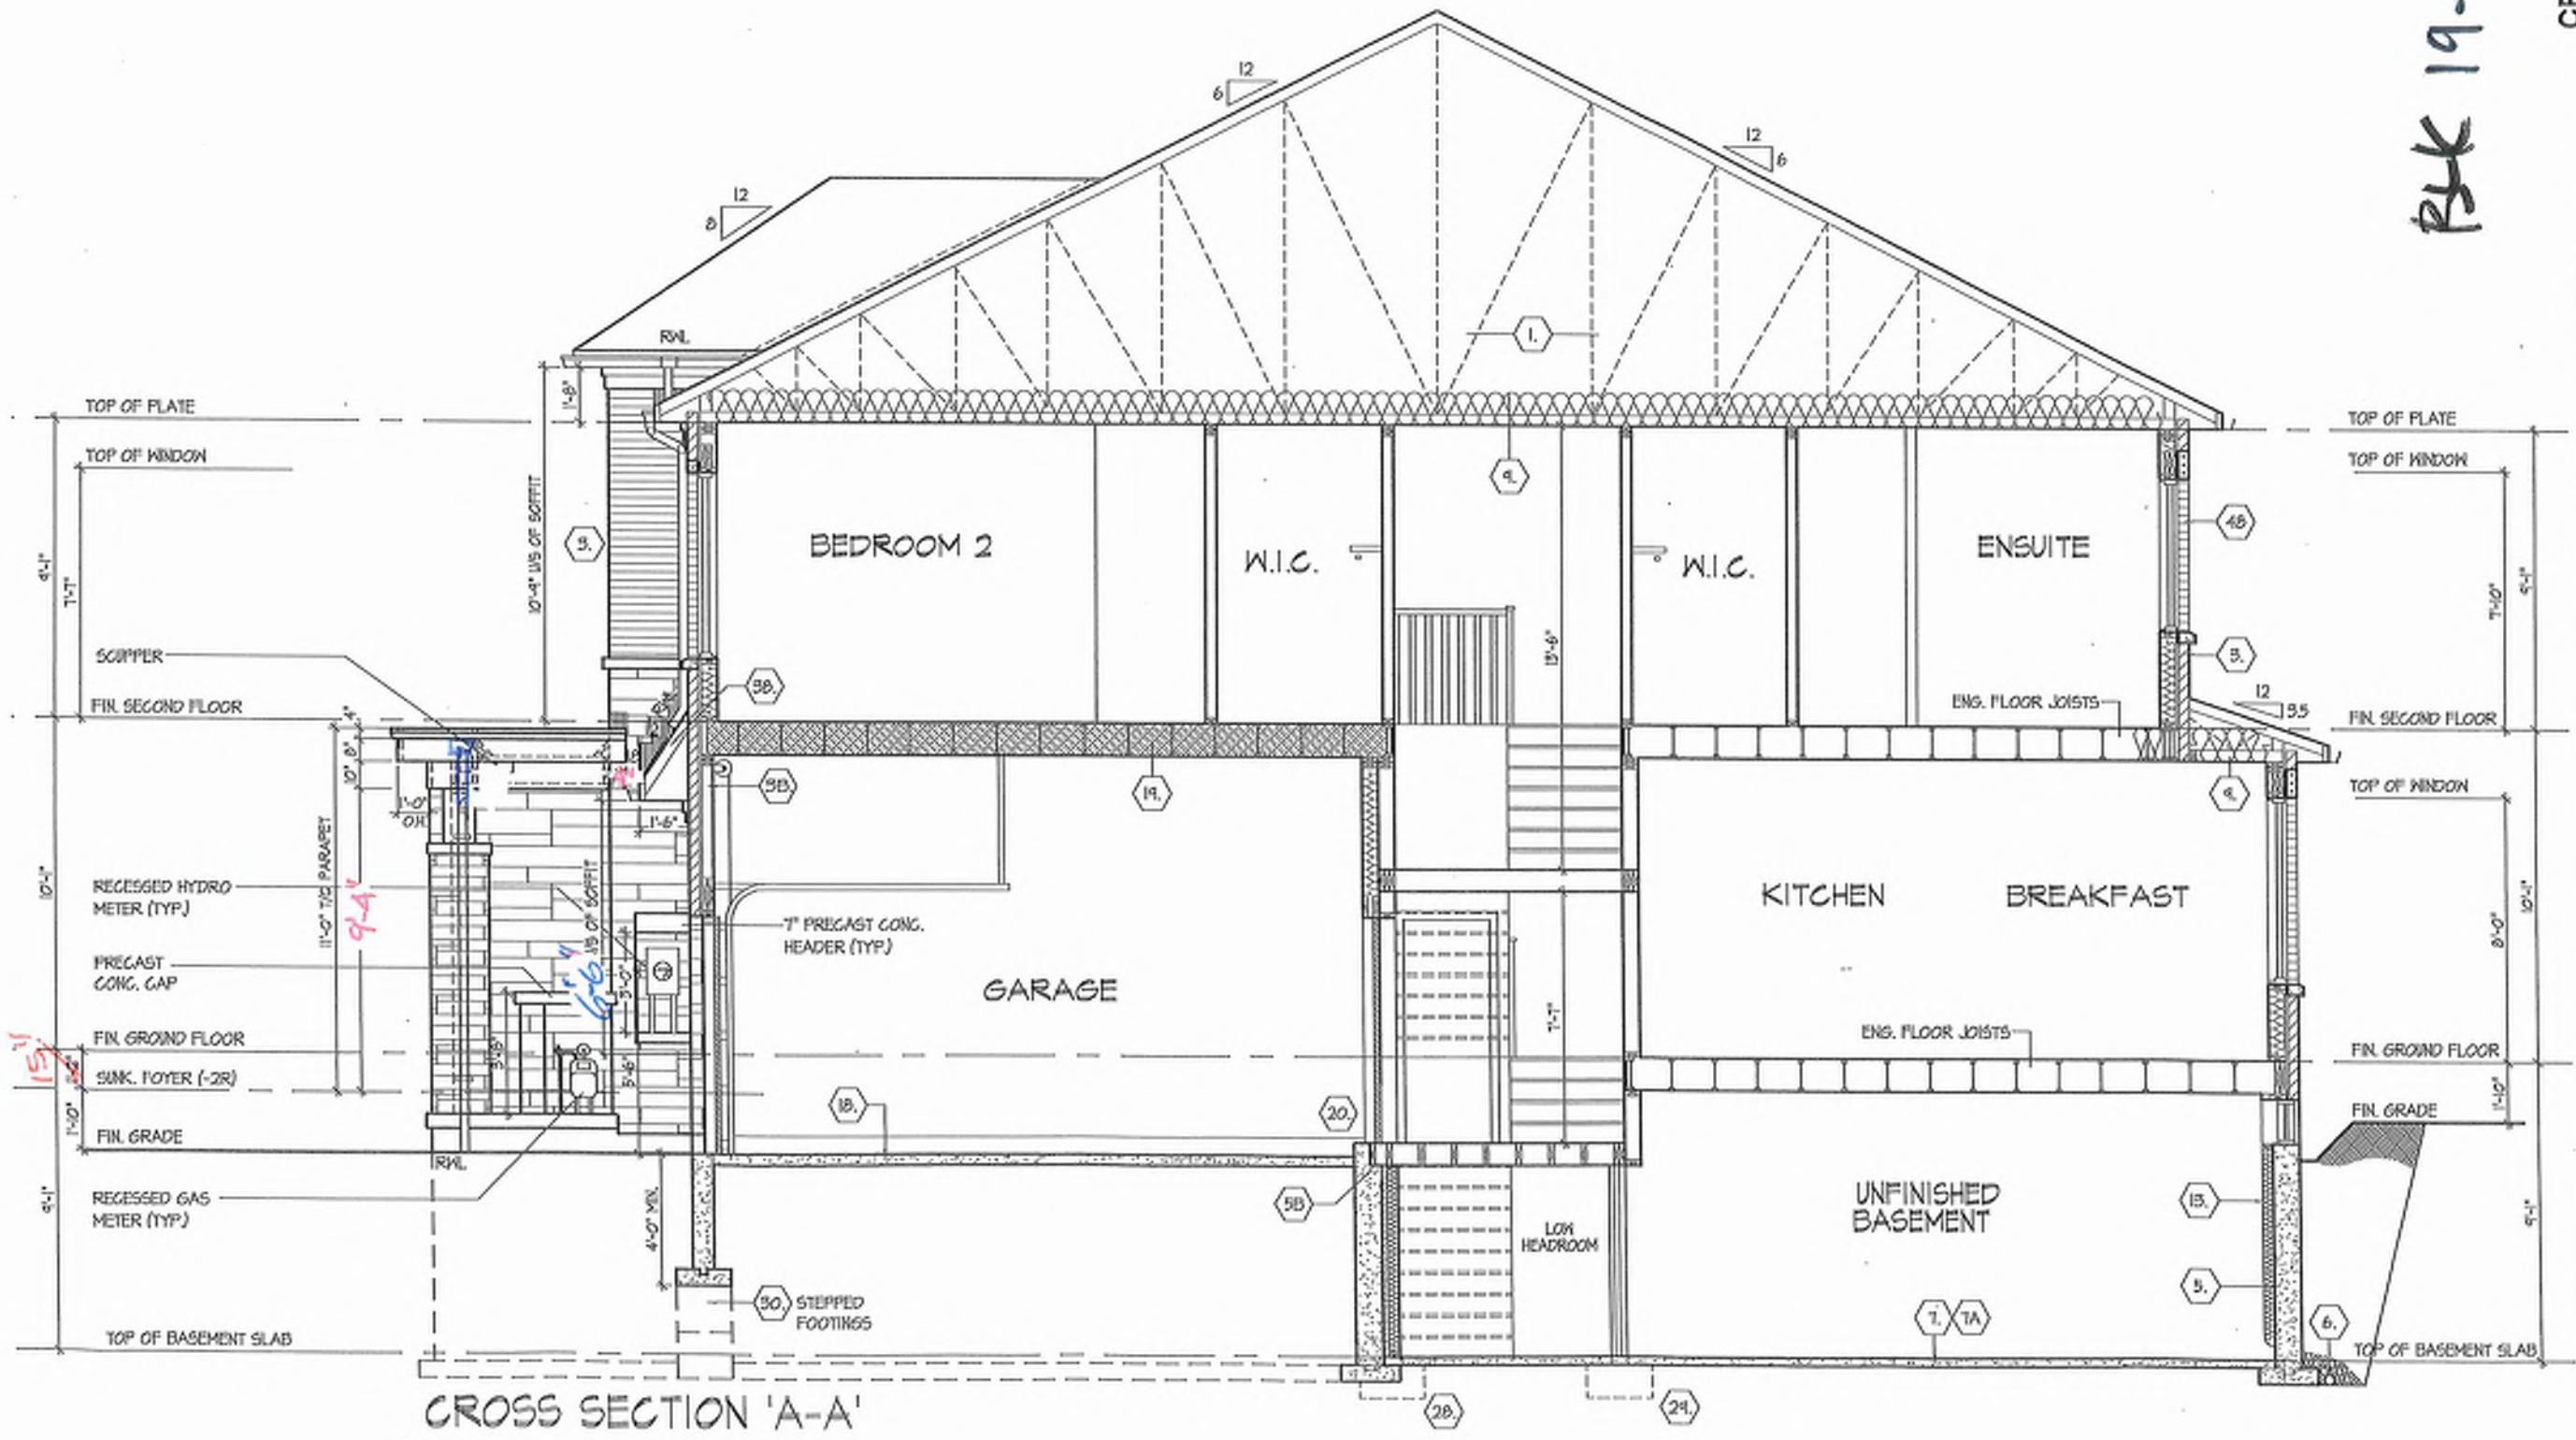

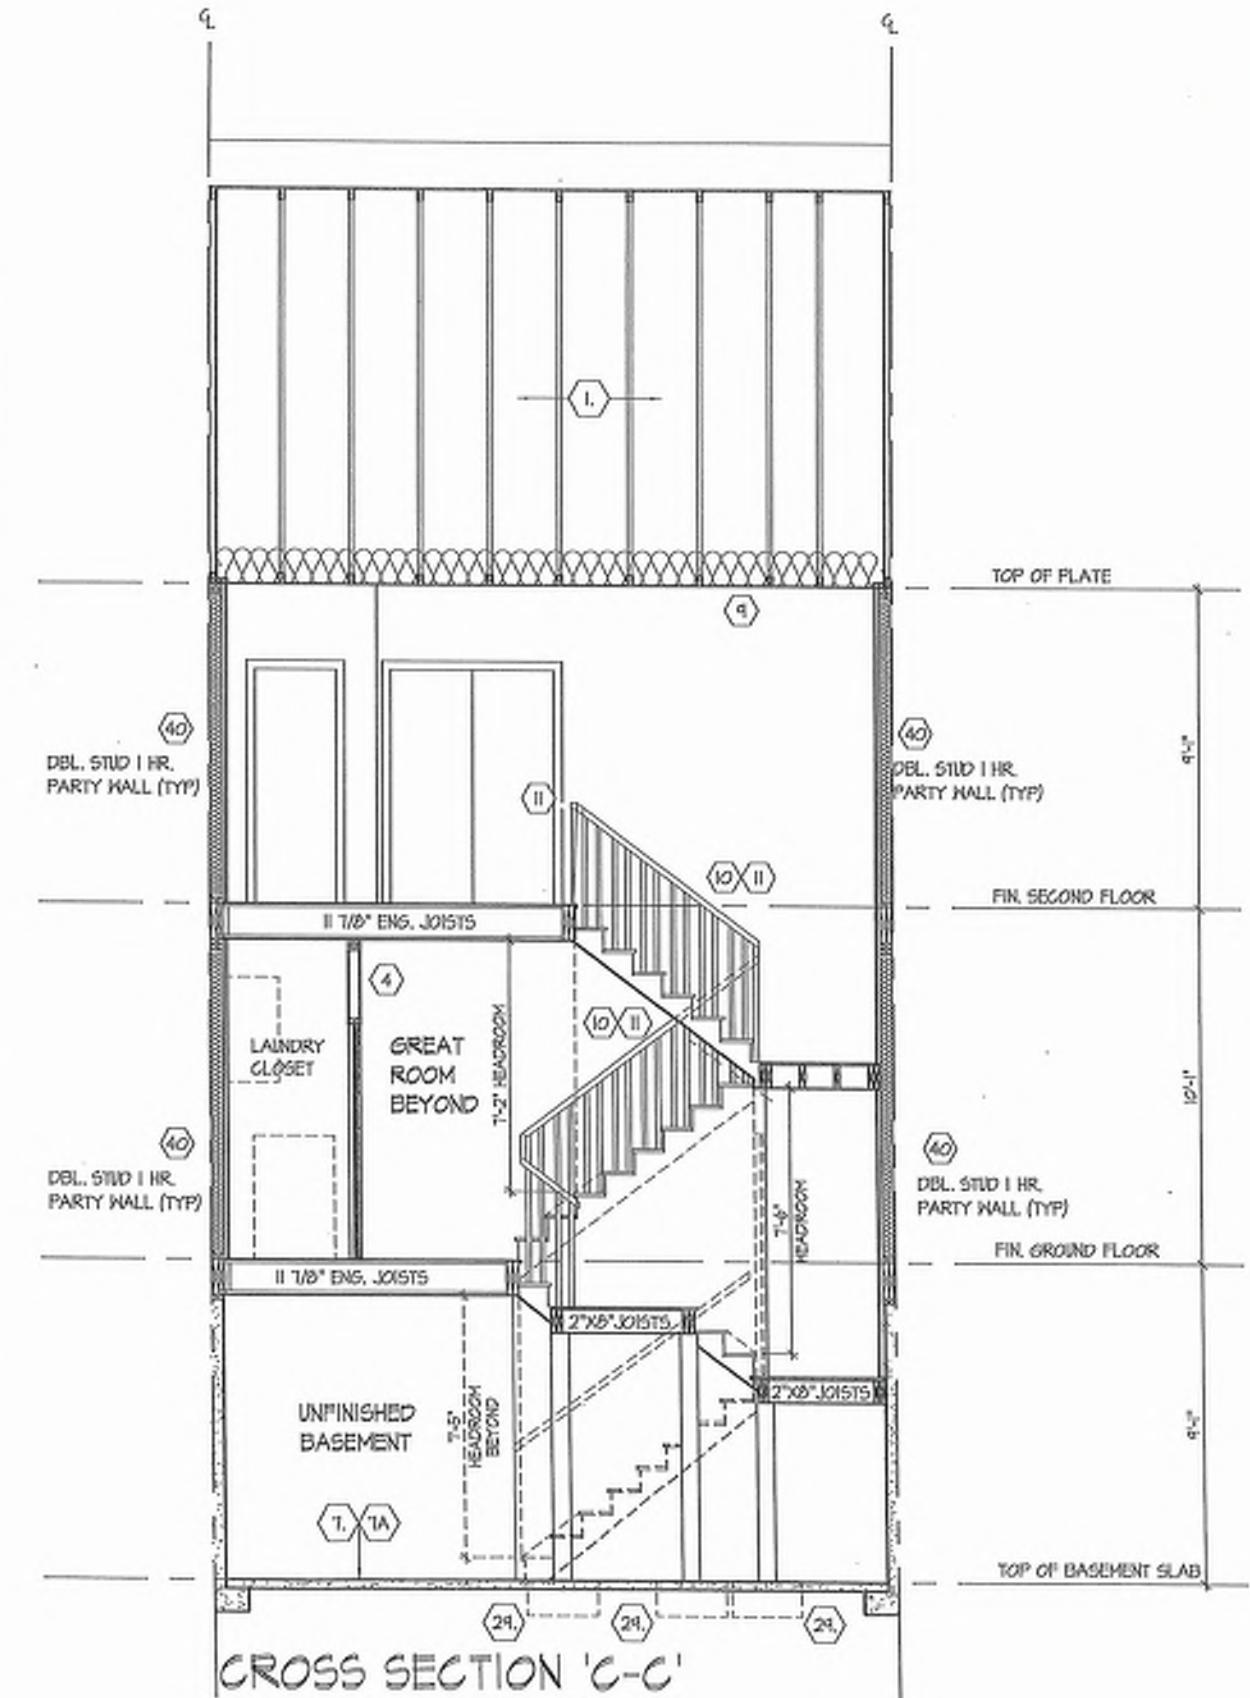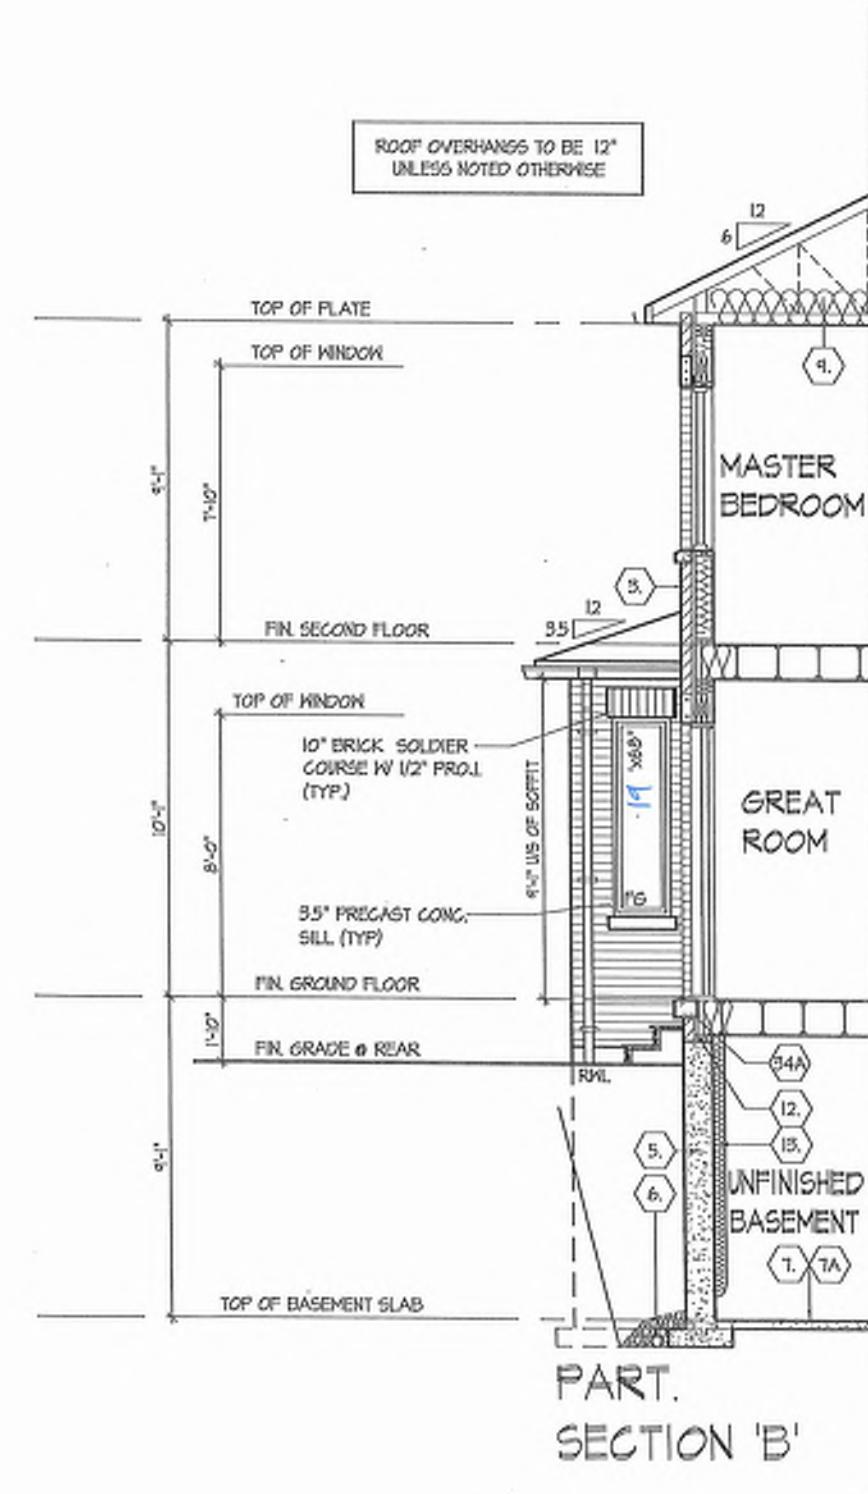

221-19-1

PART CROSS SECTION 'B' & CROSS SECTION 'C-C'

REV. 2025.03.25 UNI 2016

Page Number
28 A6 25

222 M. BURG

REV.2025.03.25
UNI 2018
921 BAYVIEW, RICHMOND HILL, ON.
ROYAL PINE HOMES - 218094
Drawn By: D.G.M.A. Checked By: S.B. Scale: 1:100 File Number: 218094-00015
D.G.M.A. D.G.M.A. Page Number: 1/2

卷之三

HUNN DESIGN ASSOCIATES

www.hindseian.com

THE MANUFACTURER IS THE OWNER AND MAKES RESPONSIBLE FOR THIS
CAR AND ALL THE DILAPIDATIONS AND HASTENS THE REPAIRS THAT ARE SET
OUT IN THE DEFECTIVE DECLARATION CODE TO A CAR OWNER.
GUAIAÇU FÁTIMA ASSOCIATION
Domicilio: Nô 010
Data: 01/01/2014

cont. SECTION 10. CONSTRUCTION NOTES

REFER TO SB-12 ENERGY EFFICIENCY DESIGN MATRIX ON THE TITLE PAGE FOR ALL VALUES AS REQUIRED PER 3.1.1, 3.1.2, 3.1.3. OF THE O.B.C.

SECTION 2.0. GENERAL NOTES

2.1. WINDOWS

- 1) EXCEPT WHERE A DOOR ON THE SAME FLOOR LEVEL AS THE BEDROOM PROVIDES DIRECT ACCESS TO THE EXTERIOR, EVERY FLOOR LEVEL CONTAINING A BEDROOM IS TO HAVE AT LEAST ONE OUTSIDE WINDOW. MIN. 0.35m² UNOBSTRUCTED OPEN PORTION W/ NO DIMENSION LESS THAN 1.43' (430). CAPABLE OF MAINTAINING THE OPENING WITHOUT THE NEED FOR ADDITIONAL SUPPORT, CONFORMING TO 9.3.10.
- 2) WINDOW GUARDS, A GUARD OR A WINDOW WITH A MAXIMUM RESTRICTED OPENING WIDTH OF 4' (1.22) IS REQUIRED WHERE THE TOP OF THE WINDOW SILL IS LOCATED LESS THAN 3' (0.90) ABOVE FIN FLOOR AND THE DISTANCE FROM THE FINISHED FLOOR TO THE ADJACENT GRADE IS GREATER THAN 3' (1.00) (G.R.A.).
- 3) WINDOWS IN EXIT STAIRWAYS THAT EXTEND TO LESS THAN 2' (1.00) (H.D.) FOR ALL ROOMS IN THE STAIRWAY SHALL BE PROTECTED BY GUARDS IN ACCORDANCE WITH NOTE #2 (ABOVE), OR THE WINDOW SHALL BE NON-OPENABLE AND DESIGNED TO WITHSTAND THE SPECIFIED LOADS FOR BALCONY GUARDS AS PROVIDED IN [4.1.15] OR [9.8.2].

4) REFER TO TITLE PAGE FOR MAX. U-VALUE REQUIREMENTS

2.2. CEILING HEIGHTS

THE CEILING HEIGHTS OF ROOMS AND SPACES SHALL CONFORM TO TABLE 9.5.3.1.

ROOM OR SPACE	MINIMUM HEIGHTS
LIVING ROOM, DINING ROOM AND KITCHEN	7'-7" OVER 75% OF REQUIRED FLOOR AREA WITH A CLEAR HEIGHT OF 6'-11" AT ANY POINT
BEDROOM	7'-7" OVER 50% OF REQUIRED FLOOR AREA OVER ALL OF THE REQUIRED FLOOR AREA
BASEMENT	6'-11" OVER AT LEAST 75% OF THE BASEMENT AREA EXCEPT THAT UNDER SEAMS AND DUCTS THE CLEARANCE IS PERMITTED TO BE REDUCED TO 6'-6".
BATHROOM, LAUNDRY AREA ABOVE GRADE	6'-11" IN ANY AREA WHERE A PERSON WOULD NORMALLY BE SPANDING
MEZZANINES	6'-11" ABOVE & BELOW FLOOR ASSEMBLY [3.5.3.2]
STORAGE GARAGE	6'-7" [9.5.3.3.]

2.3. MECHANICAL PLUMBING [9.8.2]

- 1) REFER TO HOT WATER TANK MANUFACTURER SPECS CONFORM TO O.B.C. [9.3.1.6] REFER TO MECHANICAL DRAWINGS.
- 2) REFER TO TITLE PAGE FOR SPACE HEATING EQUIPMENT, HWY AND DOMESTIC HOTWATER HEATER MEDIUM EFFICIENCIES.
- 3) DRINK WATER HEAT RECOVERY UNITS WILL BE INSTALLED CONFORMING TO THE REQUIREMENTS OF [3.8.1.2] - [3.1.1.2] OF THE O.B.C.

2.4. LUMBER

- 1) ALL LUMBER SHALL BE SPRUCE NO.2 GRADE OR BETTER, UNLESS NOTED OTHERWISE.
- 2) STUDS SHALL BE SPRUCE APPROVED METAL HANGERS FOR ALL JOISTS AND SJOWNS HANGERS PROVIDED APPROVED METAL HANGERS FOR FLUSH BUILT-UP WOOD MEMBERS.
- 3) LUMBER EXPOSED TO THE EXTERIOR TO BE SPRUCE NO. 2 GRADE PRESSURE TREATED OR PEGAR UNLESS NOTED OTHERWISE.
- 4) ALL LAMINATED VENEER LUMBER (LVL) BEAMS, GIRDER TRUSSES, AND METAL HANGER CONNECTIONS SUPPORTING ROOF OF FRAMING TO BE DESIGNED & CERTIFIED BY FCIC AND ROOF TRUSS MANUFACTURER.

2.5. STEEL [9.3.4.3]

- 1) ALL ROOF OVERHANGS SHALL CONFORM TO CAN/CSA-G40-21 GRADE 350W, FOLLOW STRUCTURAL STEEL SHALL CONFORM TO CAN/CSA-G40-21 GRADE 350W CLASS H.

2.6. FLAT ARCHES

- 1) ALL ROOF OVERHANGS SHALL BE 14"-0" (360) UNLESS NOTED OTHERWISE.

2.7. ROOF OVERHANGS

2.8. FLASHING [9.20.31, 9.26.41 (3.27.3)]

- 1) FLASHING MATERIALS & INSTALLATION SHALL CONFORM TO O.B.C.

2.9. GRADING

- 1) THE BUILDING SHALL BE LOCATED ON THE BUILDING SITE GRADED SO THAT WATER WILL NOT ACCUMULATE OR NEAR THE BUILDING AND WILL NOT ADVERSELY AFFECT ADJACENT PROPERTIES. CONFORM TO [9.14.6].

2.10. U.L.C. SPECIFIED ASSEMBLIES

- ALL INCLUDED INDIVIDUAL COMPONENTS THAT FORM PART OF ANY ULC LISTED ASSEMBLY SPECIFIED WITHIN THESE DRAWINGS CANNOT BE ALTERED OR SUBSTITUTED FOR ANY OTHER MATERIAL PRODUCT OR SPECIFIED MANUFACTURER THAT IS IDENTIFIED IN THAT SPECIFIED ULC LISTING. THERE SHALL BE NO DEVIATIONS UNDER ANY CIRCUMSTANCES IN ANY ULC LISTED ASSEMBLY IDENTIFIED IN THESE DRAWINGS.

SECTION 3.0. LEGEND

3.1. WOOD LINTELS AND BUILT-UP WOOD

DIVISION B PART 9. TABLES 9.23.4.2-A-[L]-[L]

FORAGING PART OF SENTENCE [9.23.4.2.1] [9.23.4.2.4] [9.23.12.3.1][3], [9.23.14.6.2][2] [9.26.3.1.1]

3.2. STEEL LINTELS SUPPORTING MASONRY VENEER

DIVISION B PART 9. TABLE 9.20.5.2-B-[L]

FORAGING PART OF SENTENCE [9.20.5.2.1] & [9.20.5.2.2]

3.3. DOOR SCHEDULE

L7 3'-0" x 3'-12" x 1/4" [39 x 89 x 6.4]

L8 4'-0" x 3'-12" x 1/4" [120 x 89 x 6.4]

L9 5'-0" x 3'-12" x 5/8" [127 x 89 x 7.9]

L10 5'-0" x 3'-12" x 7/16" [127 x 89 x 11]

L11 6'-0" x 3'-12" x 7/16" [182 x 89 x 11]

L12 7'-0" x 7'-15" [182 x 122 x 11]

3.4. ACRONYMS

ABV ABOVE

AFF ABOVE FINISHED FLOOR

BFRM BEAM BY FLOOR MANUFACTURER

BFRM BEAM BY ROOF MANUFACTURER

BFL BIM BEAM

CFR CONVENTIONAL ROOF FRAMING

CW COMPLETE WITH

DFT DOUBLE, DUSTY, TRIPLE, LIST

DO DO OVER

DROP DROPPED

EST ESTIMATED

ENG ENGINEERED

ERV ENERGY RECOVERY VENTILATION UNIT

FBL BEAM

FBL RAIN WATER LEADER

FL FLUSH

FLR FLOOR

GT GIRDERS

HBL HOSE BIB

HWI HEAT RETURN VENTILATION UNIT

IWT INTEGRATED WATER TANK

JST JOST

LIN LINEN CLOSET

LVL LAMINATED VENEER LUMBER

MBM BEAM OPEN TO BELOW ABOVE

PBL POINT LOAD

PLT PLATE

PT PRESSURE TREATED

PTD PAINTED

PWD POWDER ROOM

SE SOLID BEARING WOOD POST

SJL SINGLE JOIST

SPR SPRUCE

STL STEEL

TOP TOP OF

TYP TYPICAL

US UPSIDE

WC WOOD

WF WEATHER PROOF

WB WALK IN CLOSET

WCEC WIRELESS COMMUNICATIONS

WFC WIRELESS FIRE ALARM

WPA WIRELESS SIGNALING

WPS WIRELESS SIGNALING

WRC WIRELESS RADIO CONTROL

WSP WIRELESS SECURITY SYSTEM

WTE WIRELESS TEMPERATURE

WTR WIRELESS TRANSMITTER

WTT WIRELESS TERMINAL

WUW WIRELESS UPLINK

WVW WIRELESS DOWNLINK

WZ WIRELESS ZONE

WZB WIRELESS ZONE BORDER

WZP WIRELESS ZONE POINT

WZS WIRELESS ZONE SIGHTING

WZT WIRELESS ZONE TARGET

WZU WIRELESS ZONE UPDATER

WZV WIRELESS ZONE VALIDATOR

WZW WIRELESS ZONE WORKER

WZX WIRELESS ZONE X

WZY WIRELESS ZONE Y

WZS WIRELESS ZONE Z

WZB WIRELESS ZONE BORDER

WZP WIRELESS ZONE POINT

WZS WIRELESS ZONE SIGHTING

WZT WIRELESS ZONE TARGET

WZU WIRELESS ZONE UPDATER

WZV WIRELESS ZONE VALIDATOR

WZW WIRELESS ZONE WORKER

WZX WIRELESS ZONE X

WZY WIRELESS ZONE Y



WZS WIRELESS ZONE Z




BAYVIEW HEIGHTS RICHMOND HILL



1000

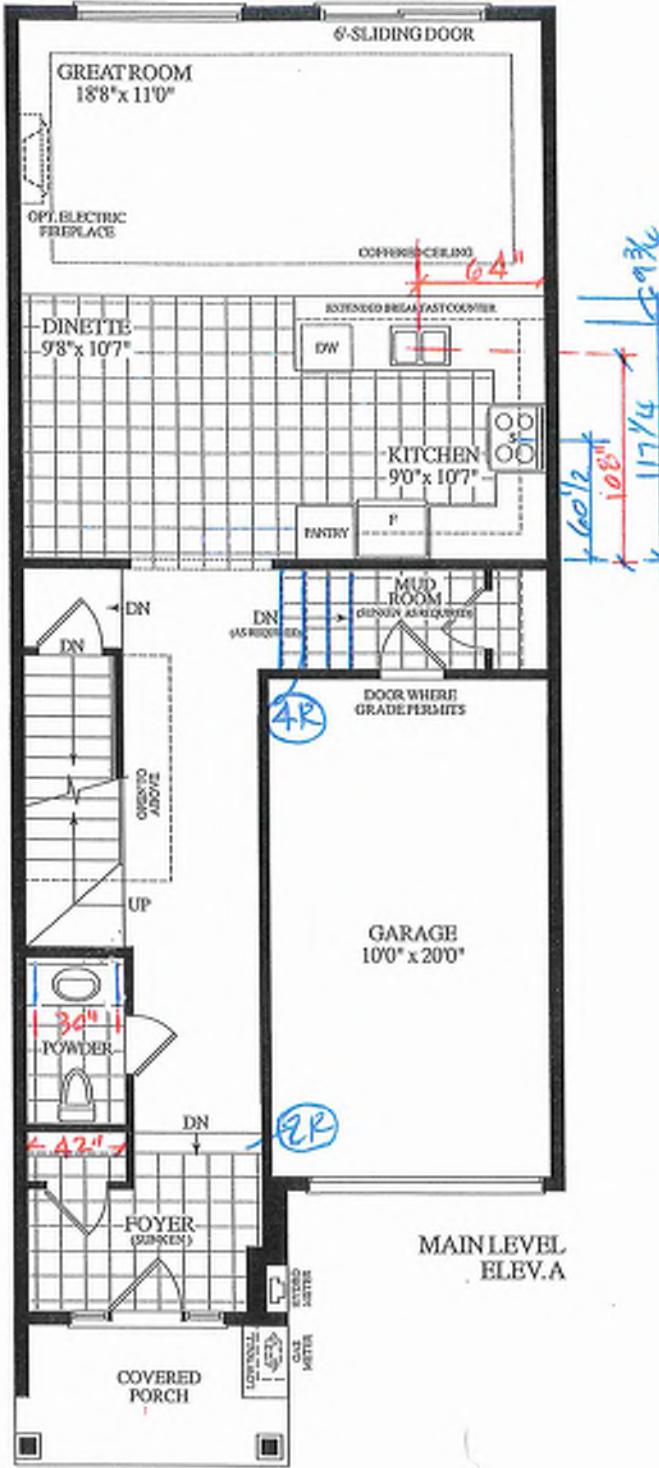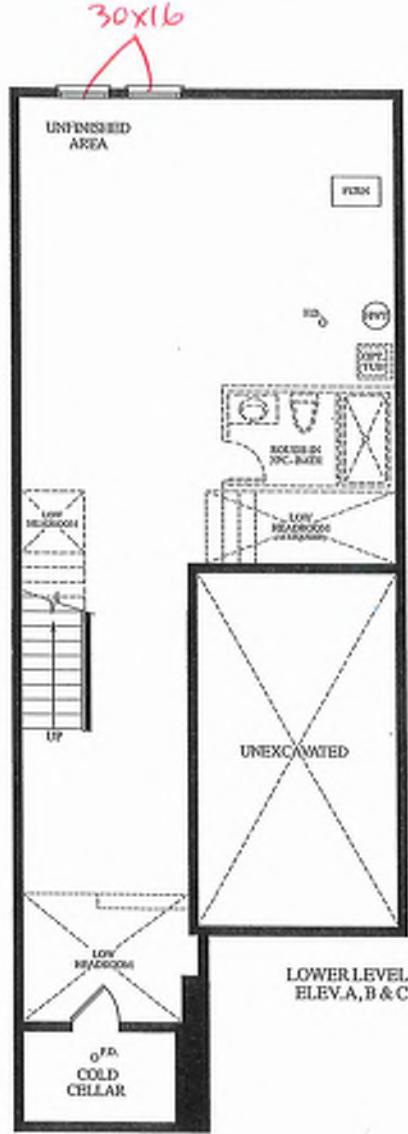

**Materials, specifications and floor plans are subject to change without notice. All renderings are artist's concept.
All floor plans are approximate dimensions. Actual usable floor space may vary from the stated floor area. E&OE.**

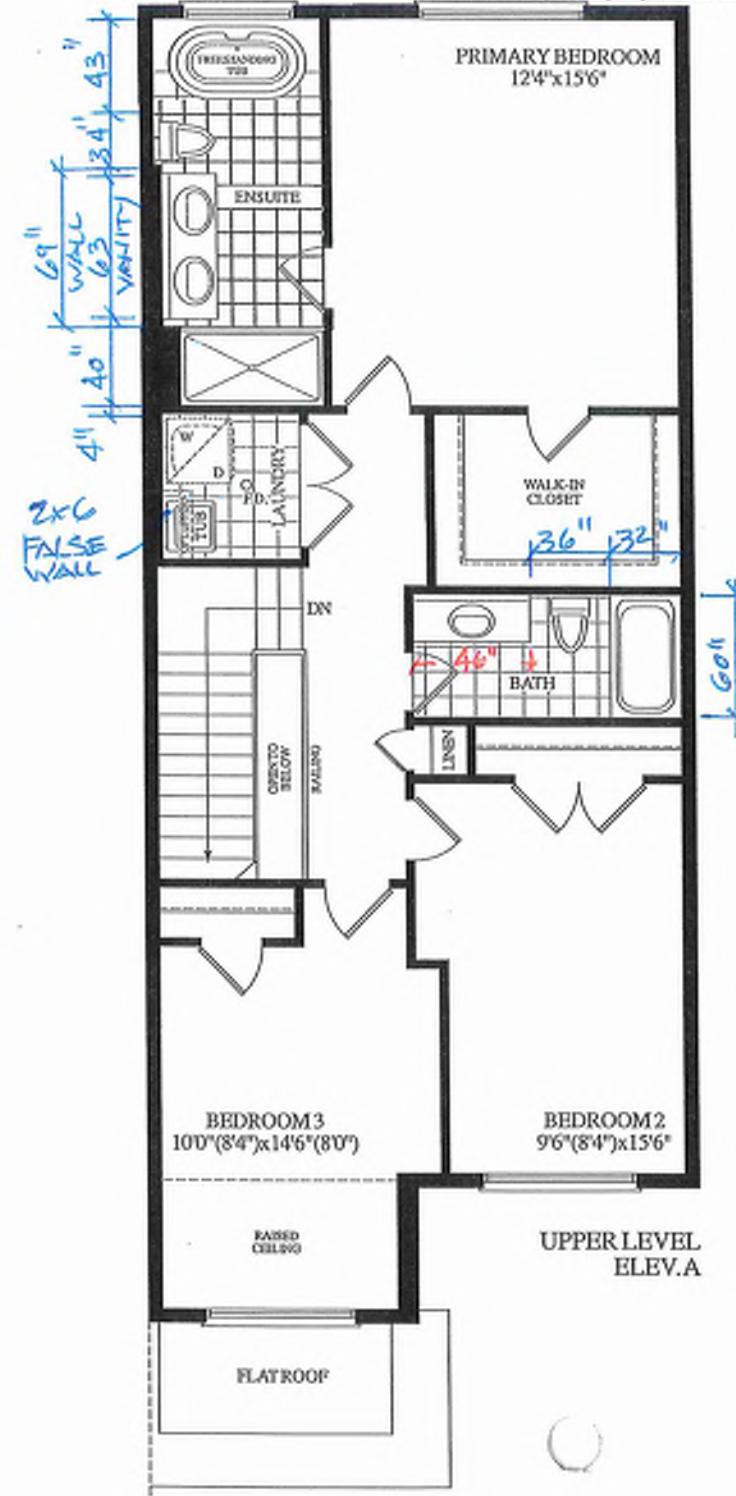


1795 SQ.FT.

BLK. 19 TH. 123 20-16 THE CHARLOTTE

GROUND TO SECOND
122' HT 11-7/8' JOIST

BASEMENT TO GROUND
BSMT 11-7/8' JOIST

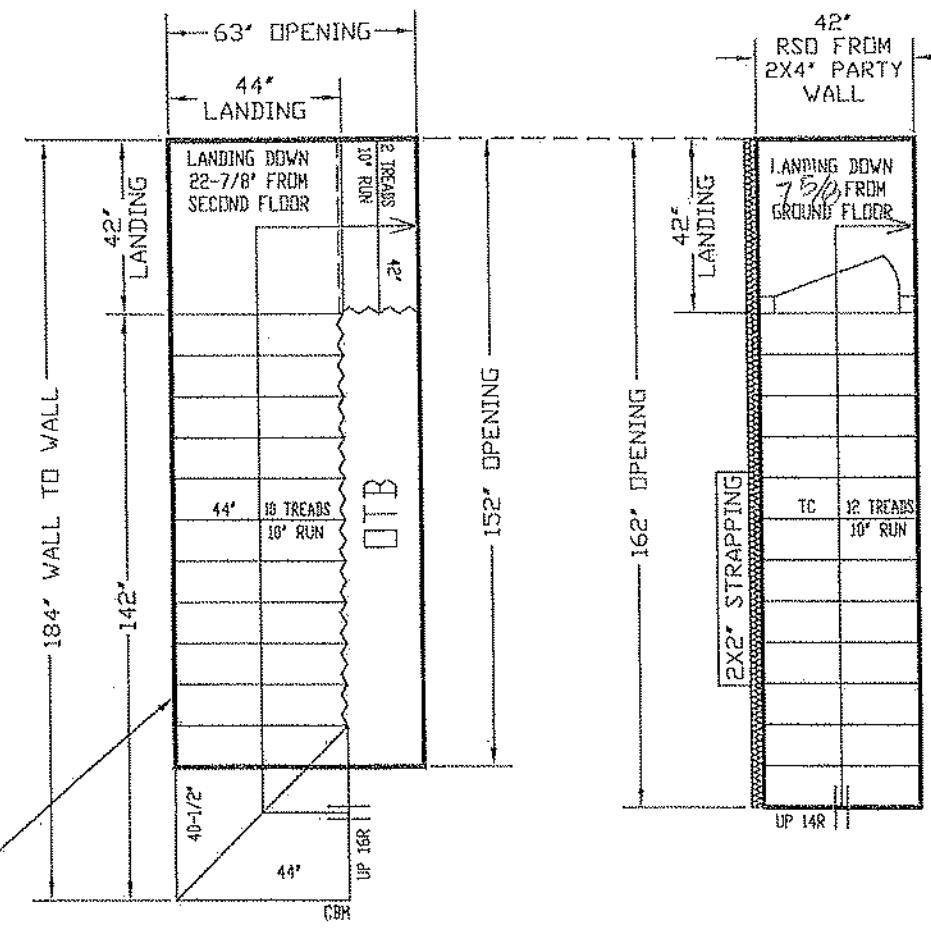

ALL OPENINGS ARE ALLOWED FOR 1 LAYER OF DRY WALL.
ANY ADDITIONAL LAYERS MUST BE ALLOWED BY CARPENTERS


STAIRS LINE UP BY
PARTY WALL

REVISED
JUNE 4, 2025


GARAGE RIGHT >

 <i>Quality To Step Up To</i>	ALL LANDINGS TO BE SUPPLIED AND SUPPORTED BY OTHERS UNLESS SPECIFIED ABOVE ANY STRAPPING ALLOWANCES TO BE COMPENSATED BY CARPENTERS ALL STAIR DIMENSIONS MAY BE MODIFIED FROM ORIGINAL BLUE PRINTS OR SPECS AS SUPPLIED TO ALPA STAIRS AND RAILINGS INC. MEASUREMENTS SHOWN ON LAYOUTS ARE REQUIRED TO INSTALL OUR STAIRS. ANY PROBLEM WITH HEADRISHER OR STRAPPING ALLOWANCES, ALPA STAIRS AND RAILINGS INC. WILL NOT BE RESPONSIBLE. STAIR LAYOUTS SHOULD BE CHECKED BY CARPENTERS OR SITE SUPER'S TO MAKE SURE THERE ARE NO DISCREPANCIES BEFORE PROCEEDING WITH CONSTRUCTION	
	 ALPA STAIRS AND RAILINGS INC. 3770 NASHUA DRIVE, UNIT 3 MISSISSAUGA, ONTARIO L4V 1M6 TEL: (905) 694-9556 www.alpastairs.com	
<p>SITE: BAYVIEW HEIGHTS DRAWN BY: PARAHJECT DATE: MAY 23, 2025</p> <p>LOT #: Model: ROYAL PINE HOMES</p> <p>LAYOUT #: SCALE: 1:35</p>		
UNIT 2016		

Bulk 19-123

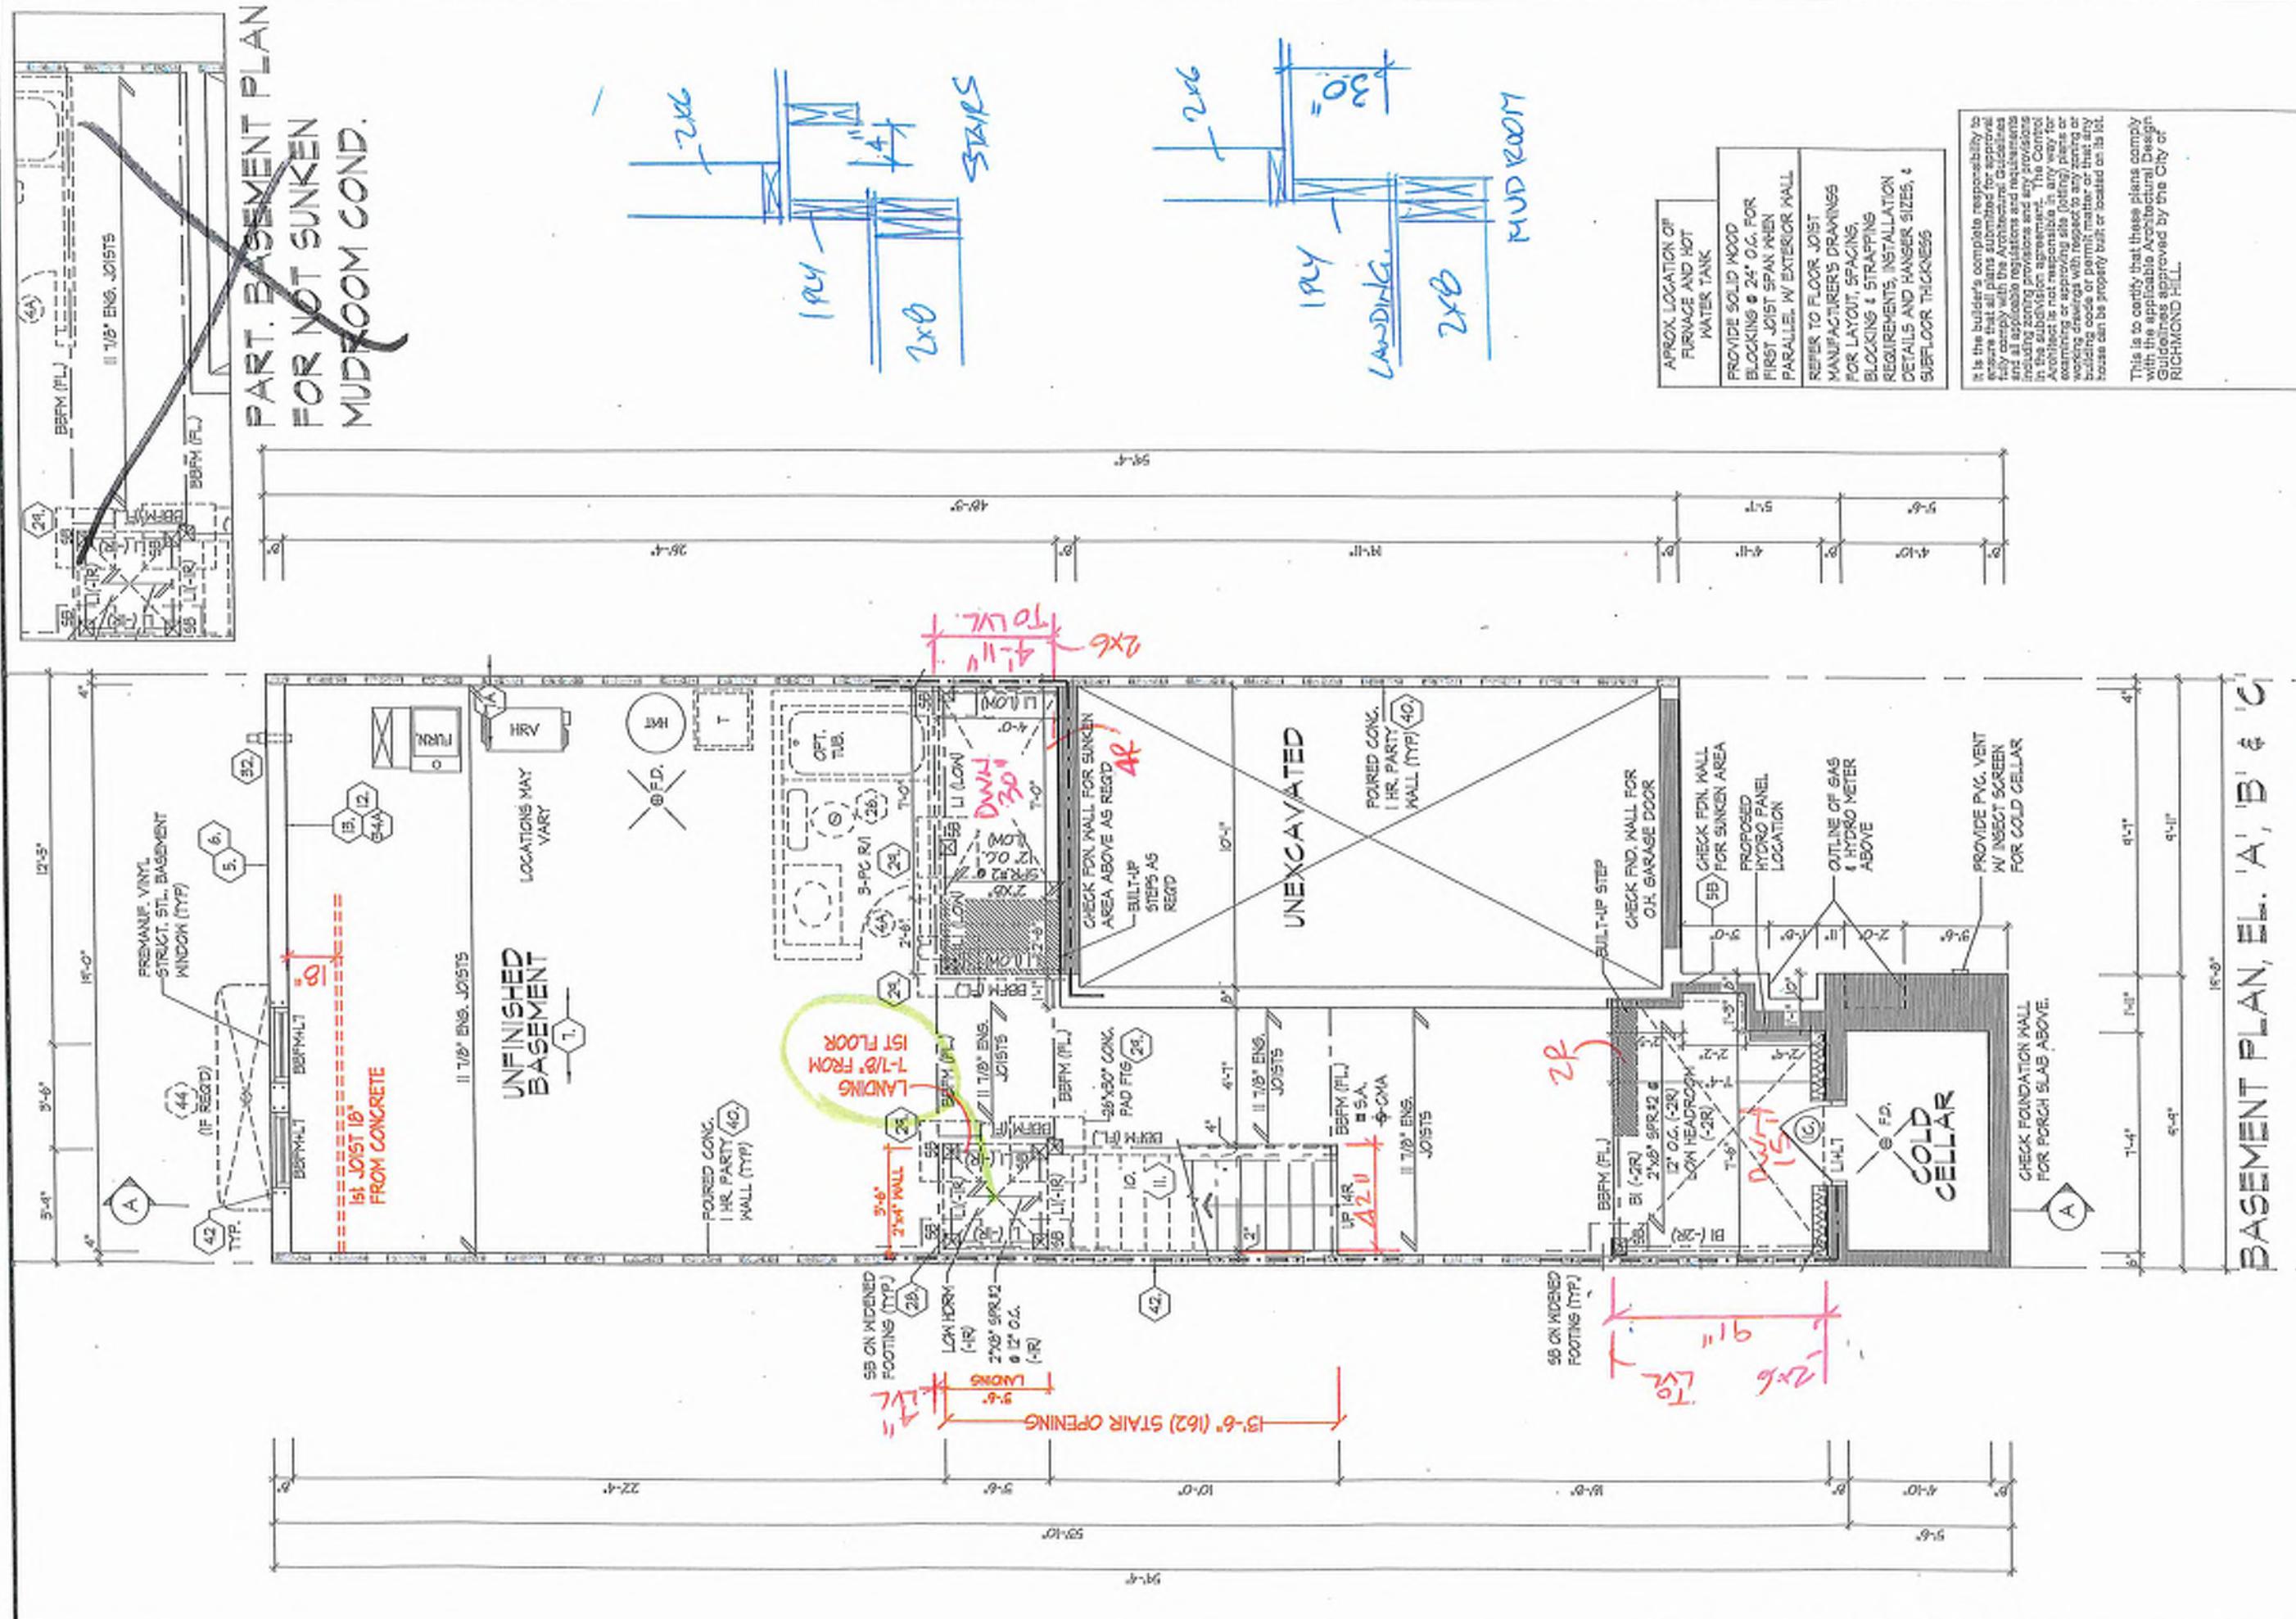

ROYAL PINE HOMES - 218094
921 BAYVIEW, RICHMOND HILL, ON.
Design By: KMWTT
Conducted By: KMWTT
Date: 03/24/2025
File Number: 218094-W12016
Page Number: 2 of 25
Page Notes: REV.2025.03.24
Comments: All drawings, specifications, related documents and details are the copyright property of Hunt Design Associates (K.D.A.) except as noted or stated. Hunt Design Associates (K.D.A.) assumes no responsibility or liability for this drawing unless it bears the associate B2N number and/or date signature.

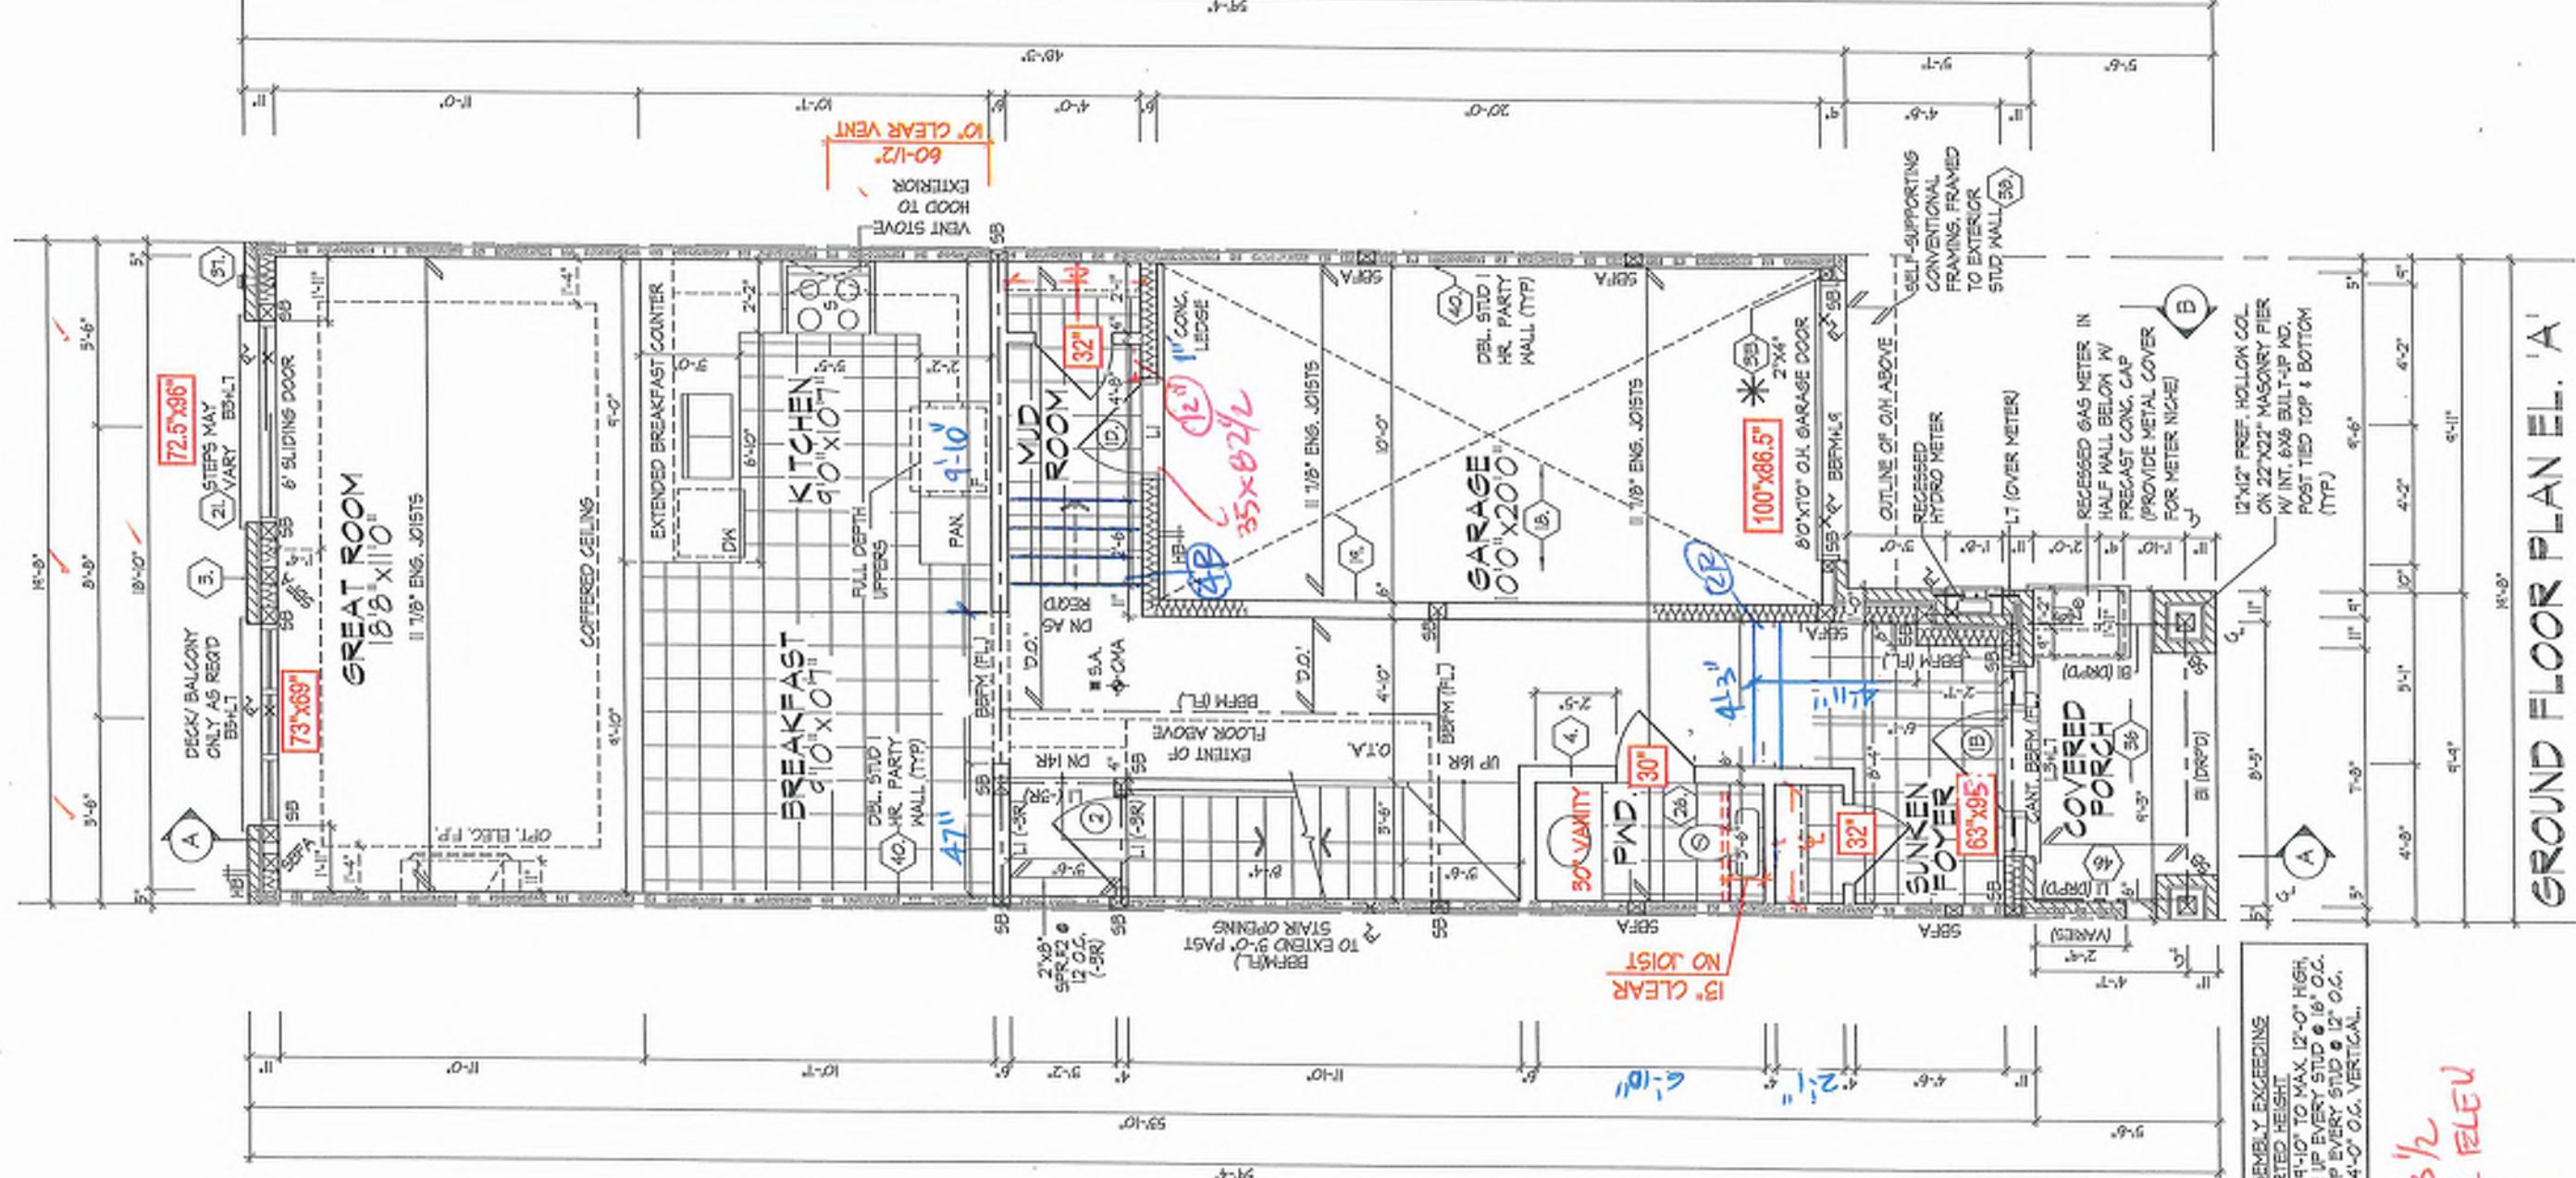

GROUND FLOOR PLAN, EL. A'
UNIT 2016
REV.2025.03.24
File Number: 2118094W12016
Date: 3/16/2016
F 905.737.5133


GROUND FLOOR PLAN, EL. A'
UNIT 2016
REV.2025.03.24
File Number: 2118094W12016
Date: 3/16/2016
F 905.737.5133

ROYAL PINE HOMES - 218094
921 BAYVIEW, RICHMOND HILL, ON.
Drawn By: KM/T
Design Associates Inc.
www.huntdesign.ca

HUNT
DESIGN ASSOCIATES INC.
www.huntdesign.ca

THE DESIGNER HAS REVIEWED AND TAKES RESPONSIBILITY FOR THIS DOCUMENT AND HAS THE INFORMATION AND KNOWLEDGEABLE TO MEET THE REQUIREMENTS SET OUT IN THE CONTRACT SUBMITTED TO BE A DESIGNER.
Dominic Mallo
Project Information
Signature: **DOMINIC MALLLO**
Date: **1/18/2025**

THE CONTRACTOR HAS READ AND UNDERSTOOD THE REQUIREMENTS SET OUT IN THE CONTRACT SUBMITTED TO BE A CONTRACTOR.
Dominic Mallo
Project Information
Signature: **DOMINIC MALLLO**
Date: **1/18/2025**

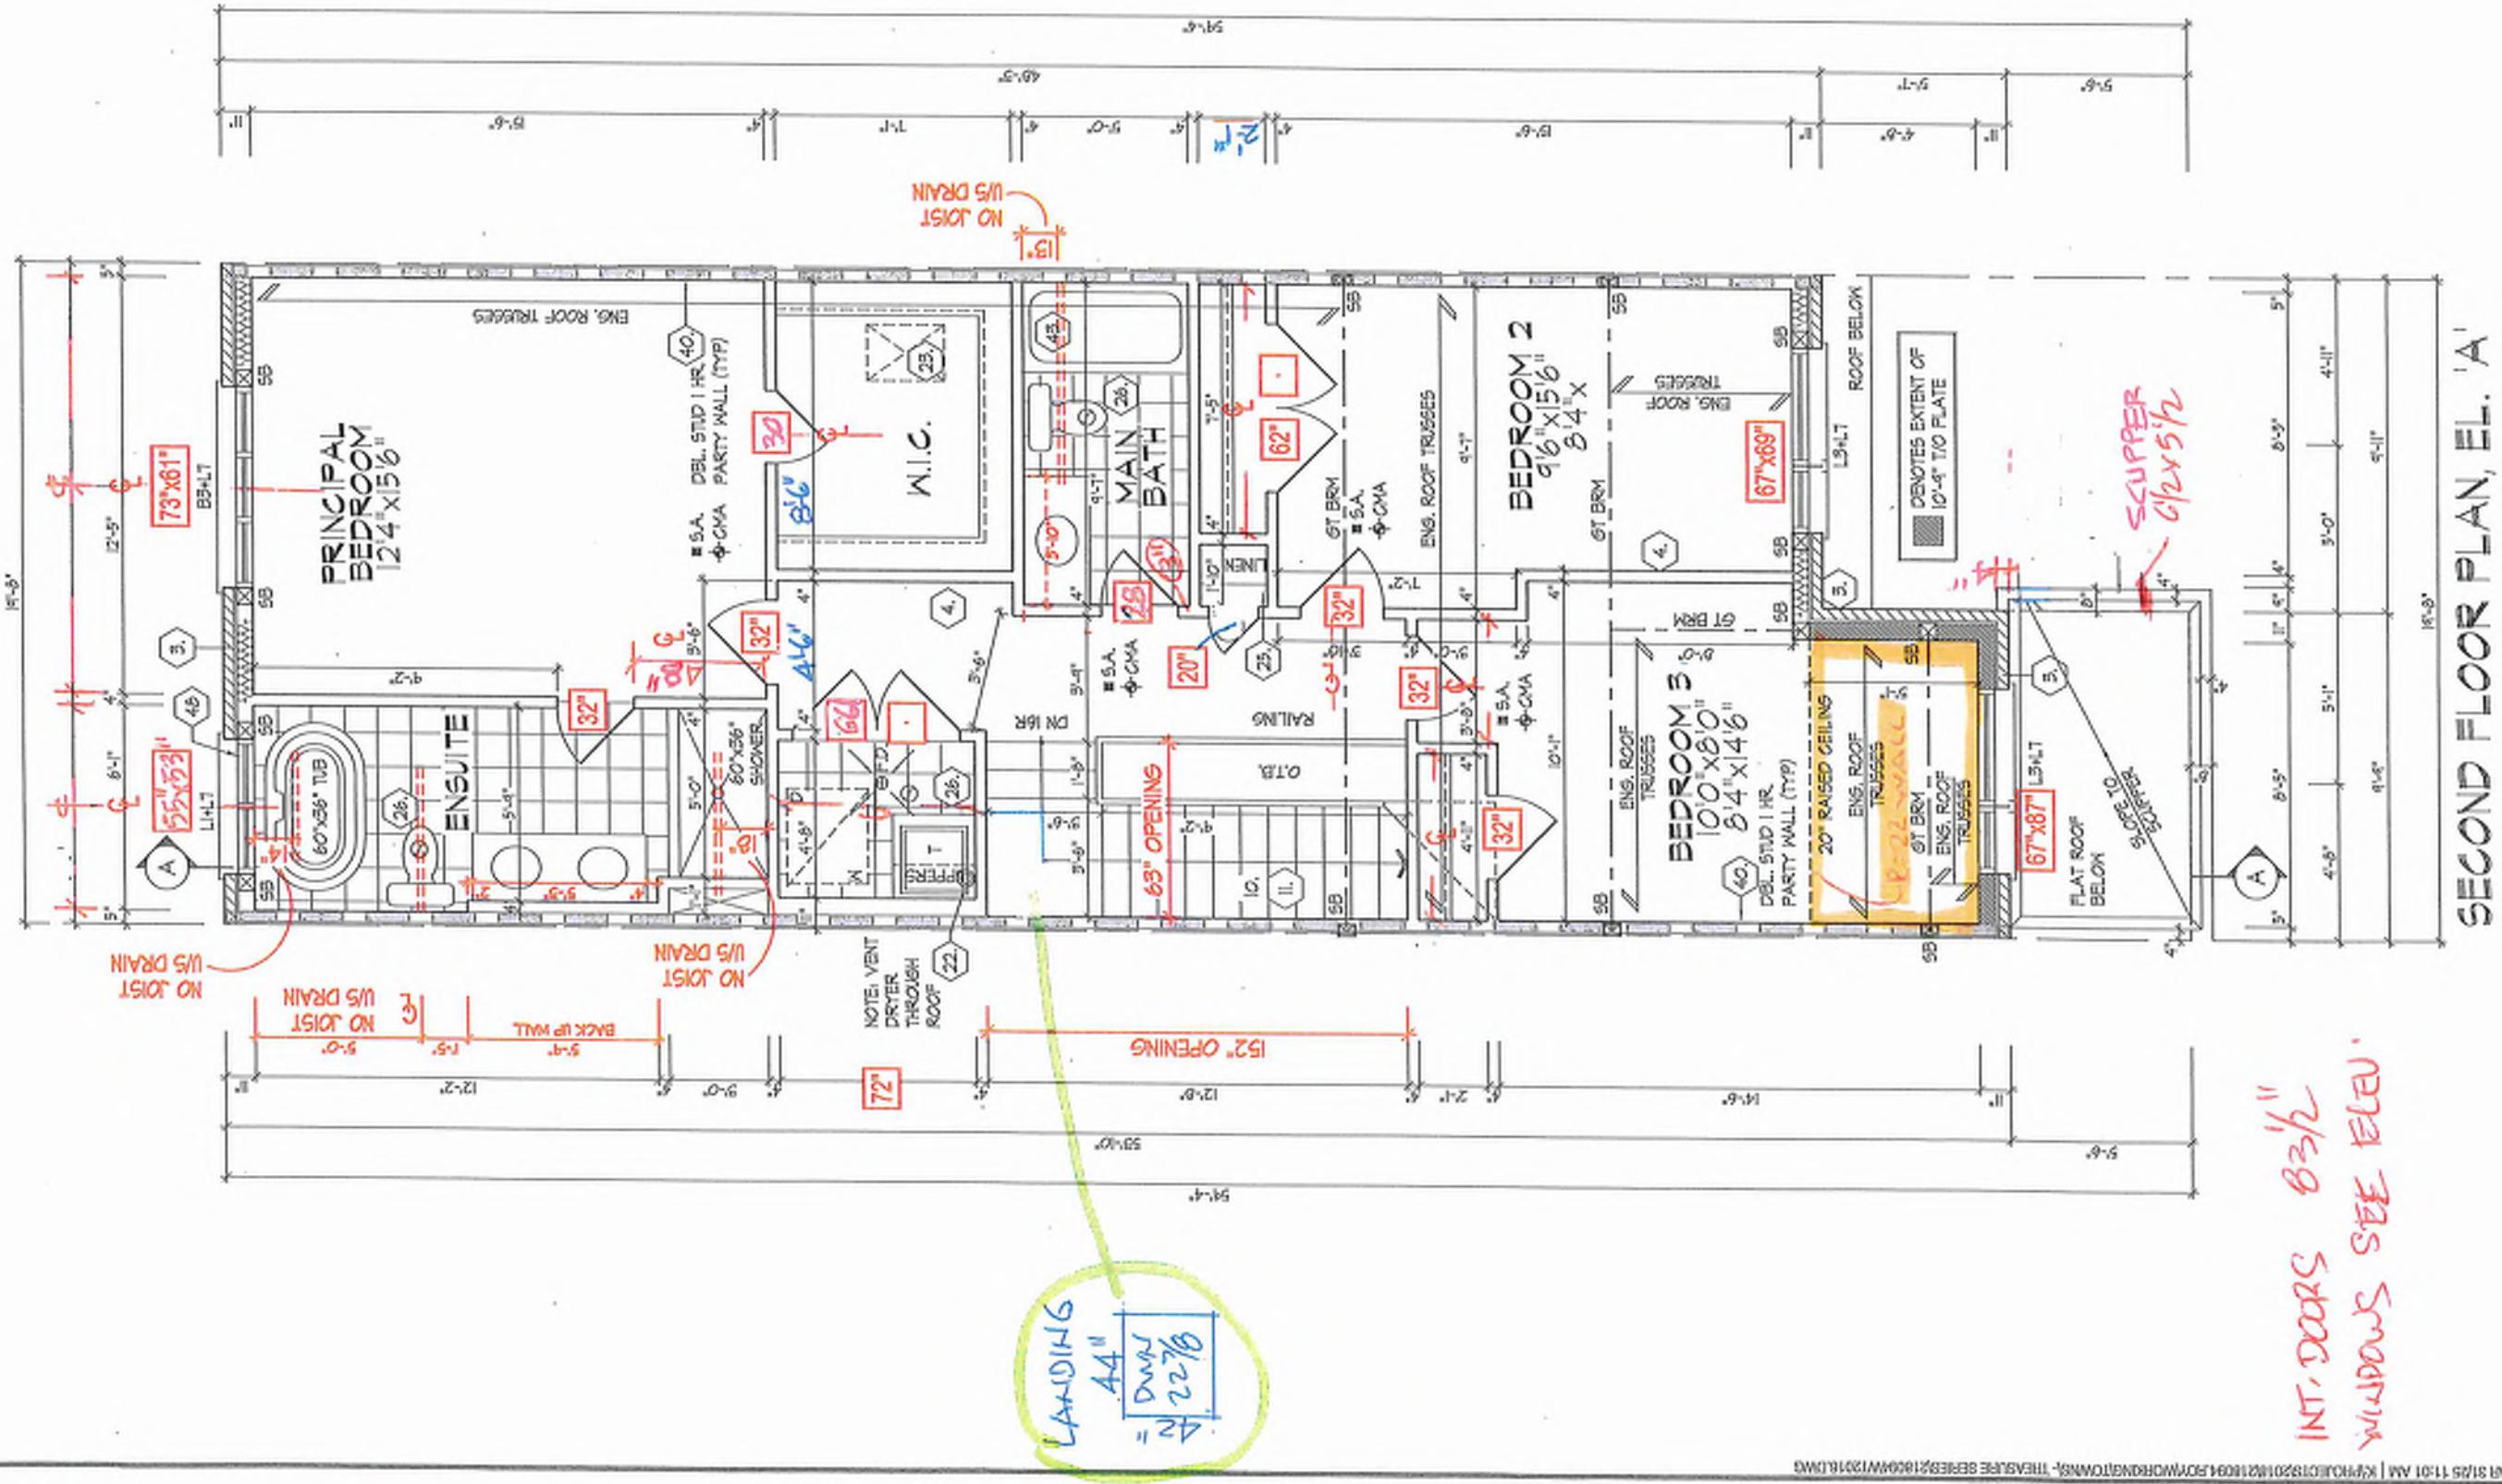

SECOND FLOOR PLAN, EL. A'

UNIT 2016
REV 2025.03.24


File Number:
218094-WT2016
Printed:
2025-03-24
Page:
5 of 26

ROYAL PINE HOMES - 218094
921 BAYVIEW, RICHMOND HILL, ON.

HUNT
DESIGN ASSOCIATES INC.
www.huntdesign.ca

THE DESIGNER HAS REVIEWED AND TAKEN RESPONSIBILITY FOR THIS DESIGN AND HAS THE QUALIFICATIONS AND KNOWLEDGE TO MEET THE REQUIREMENTS SET OUT IN THE ONTARIO BUILDING CODE TO BE A REGISTERED DOMESTIC MECHANICAL CONTRACTOR.

DOMESTIC MECHANICAL CONTRACTOR INFORMATION
HUNTINGTON DESIGN ASSOCIATES INC.
Signature: 18655
Date: 21/2/24
FIRM SIGNATURE

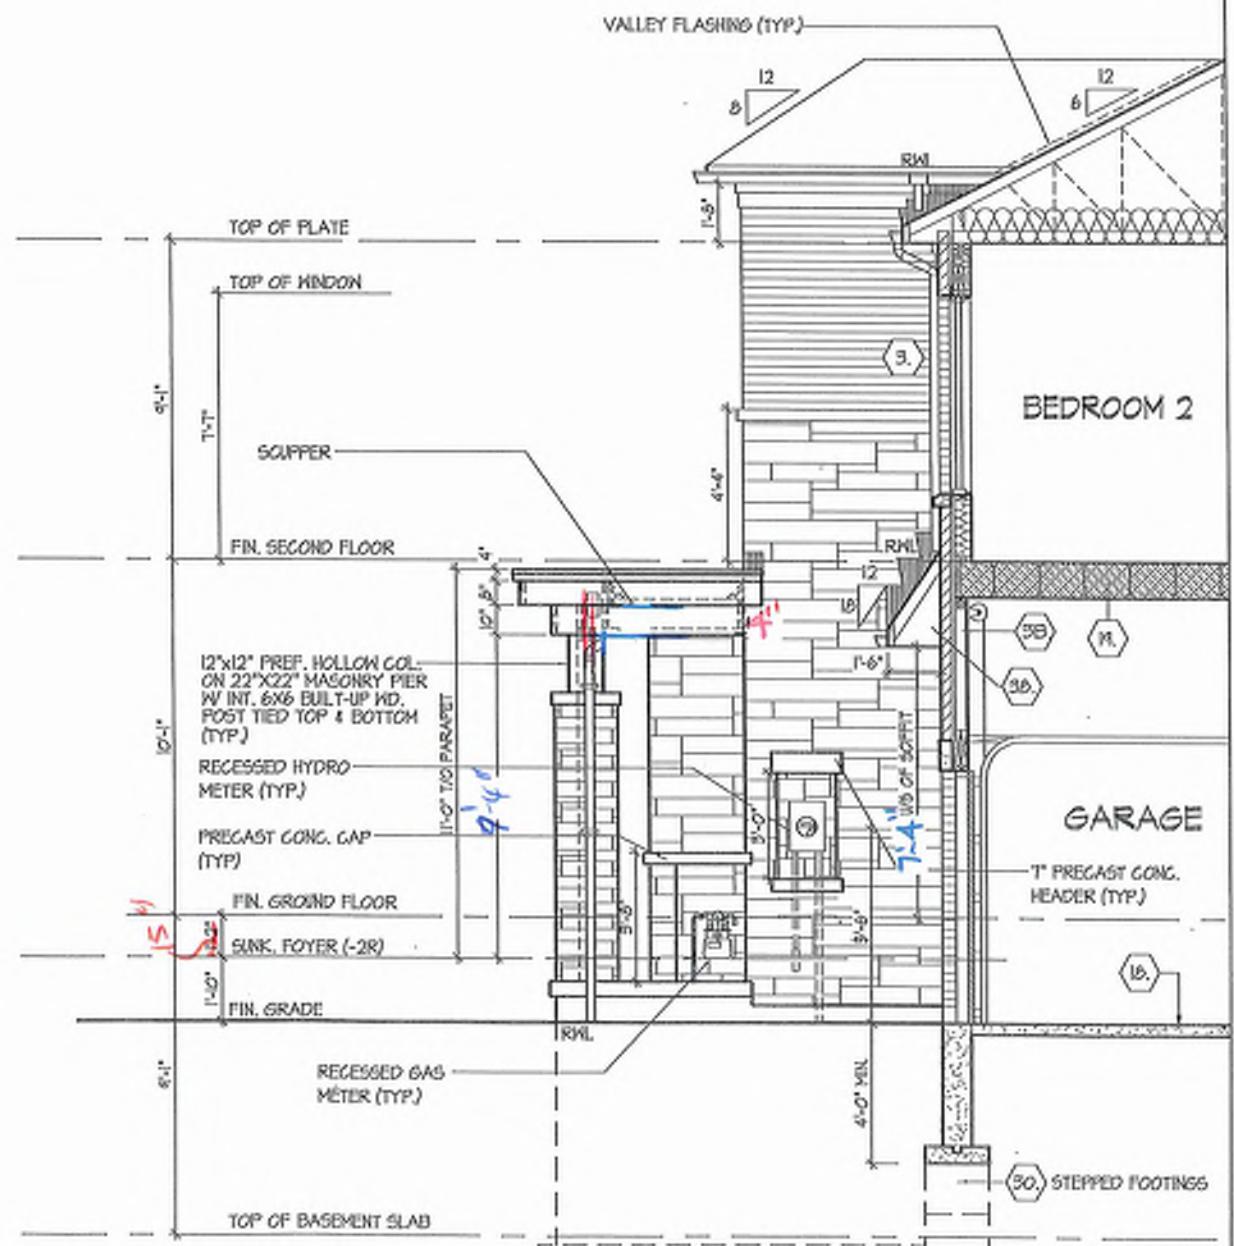

PARTIAL SECTION 'B', EL. 'A'

Buk 19

123

PARTIAL SECTION B, EL. 'A'

UNIT 2016
REV.2025.03.24

Page Number
17 of 29

File Number
2118084-WT2016

Scale
3016=1'-0"

Drafted By
KM/T

Design Associates Inc.
www.HuntDesign.ca

8906 Woodbine Ave, Markham, ON L3R 6J7
F: 905.767.7535

Architectural specifications related documents and design are the copyright property of Hunt Design Associates Ltd. Reproduction of this property in whole or in part is strictly prohibited without HDA's written permission HDA assumes no responsibility or liability for the property unless it bears the appropriate HDA number and original signature.

HUNT
DESIGN ASSOCIATES INC.

www.HuntDesign.ca

8906 Woodbine Ave, Markham, ON L3R 6J7

F: 905.767.7535

2118084-WT2016

3016=1'-0"


3016=1'-0"

The undersigned has reviewed and takes responsibility for the design and has the due regard to meet the requirements set out in the detailed technical code to be observed.

Qualification Information


Dominic Mello

HUNT DESIGN ASSOCIATES INC.

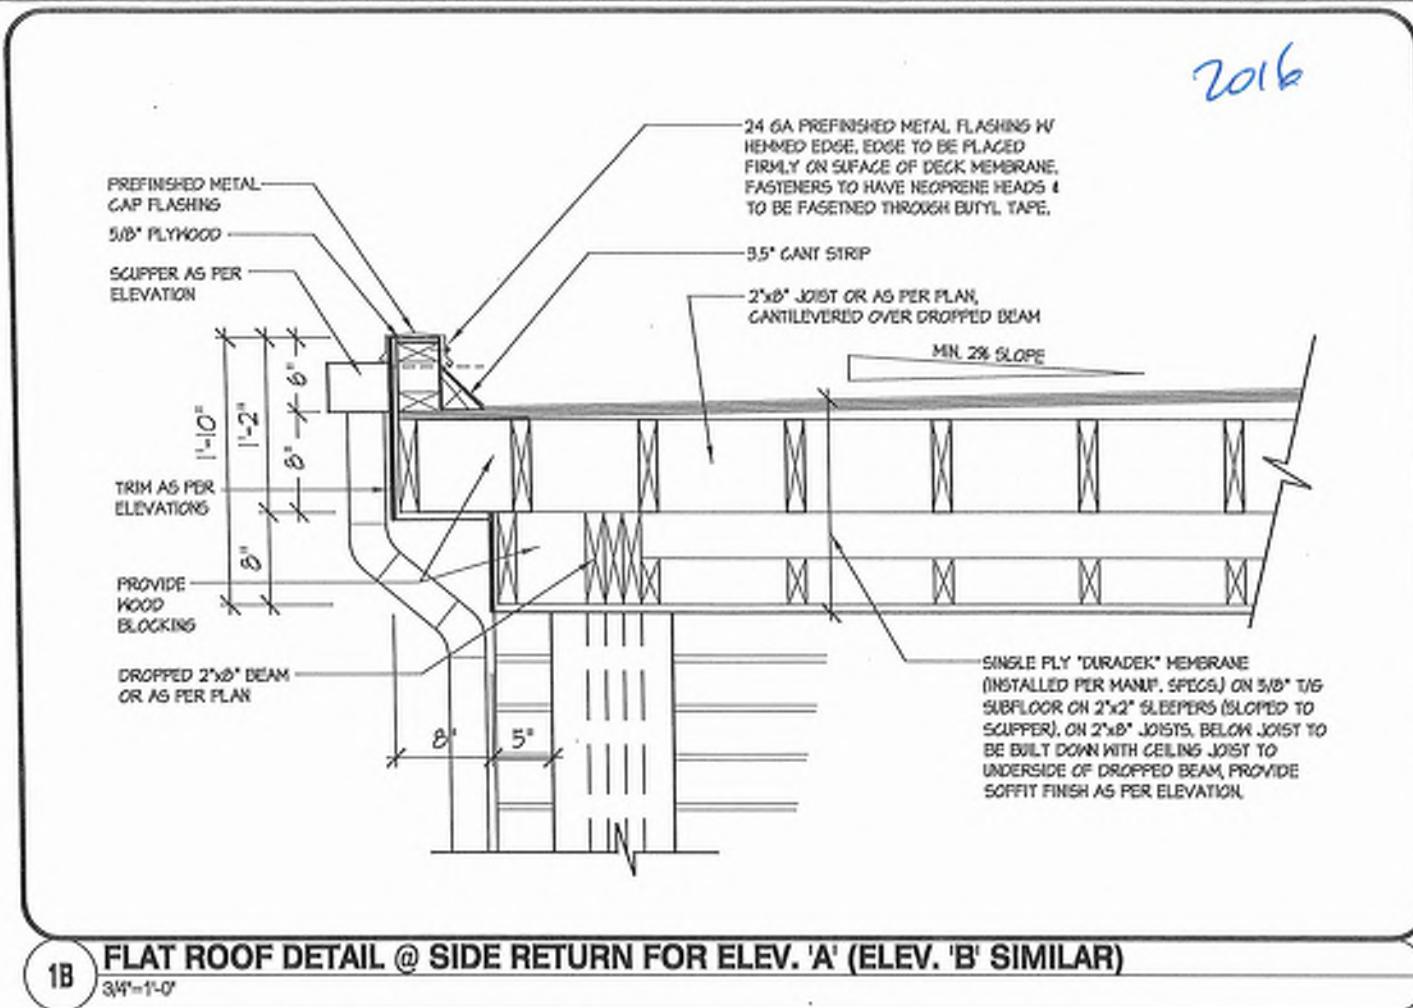


1B FLAT ROOF DETAIL @ SIDE RETURN FOR ELEV. 'A' (ELEV. 'B' SIMILAR)

1B

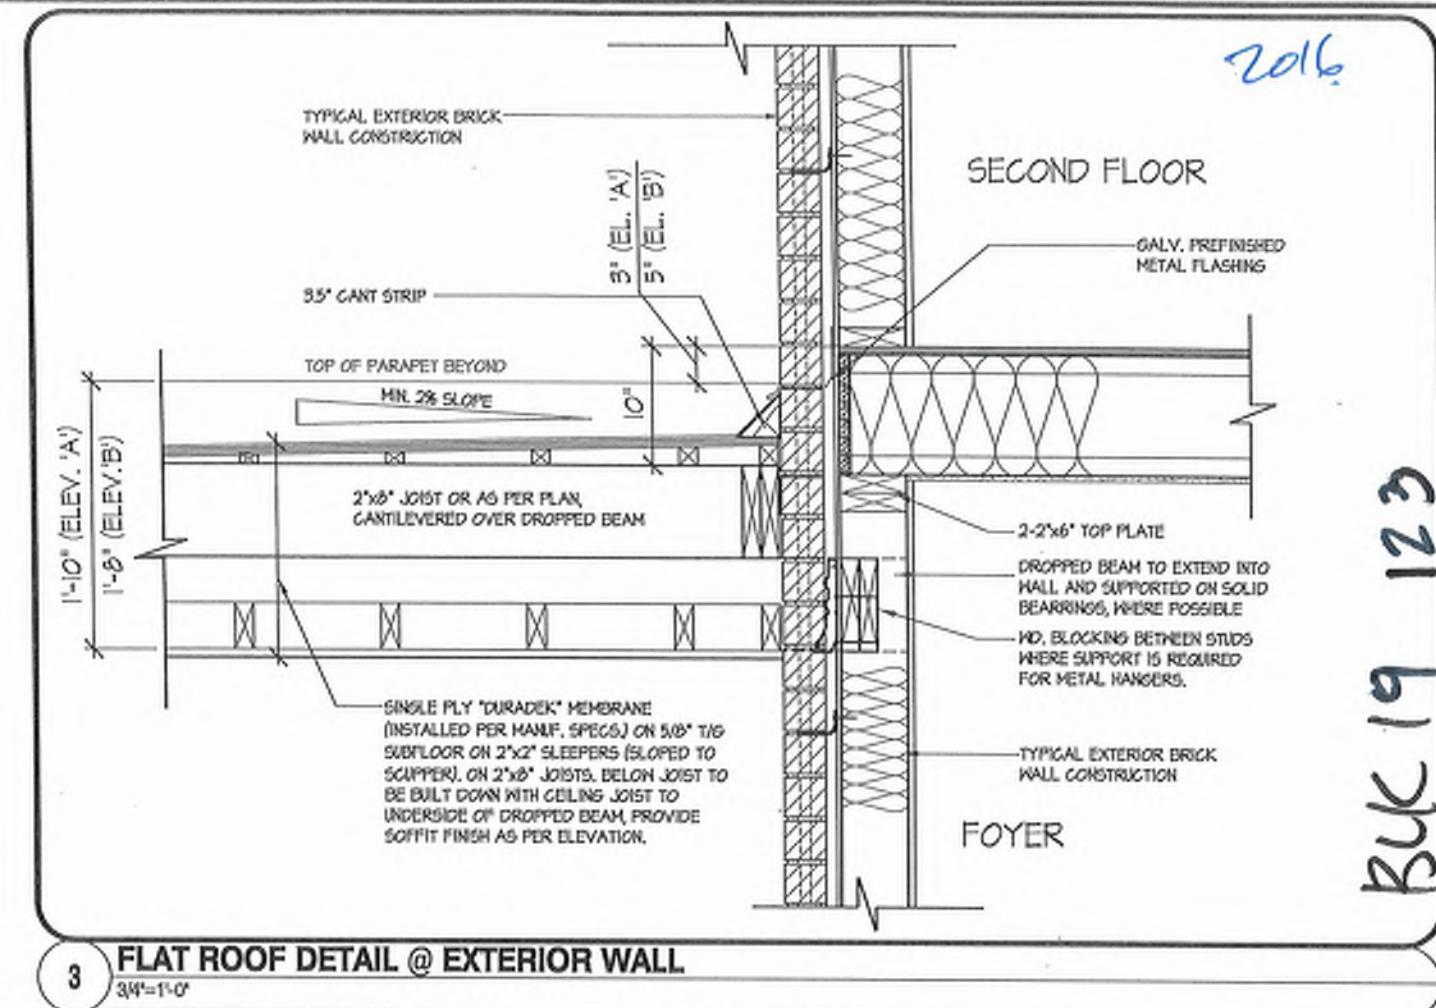


3 FLAT ROOF DETAIL @ EXTERIOR WALL

3 $\sqrt{34^2 - 1^2} \cdot 0^2$

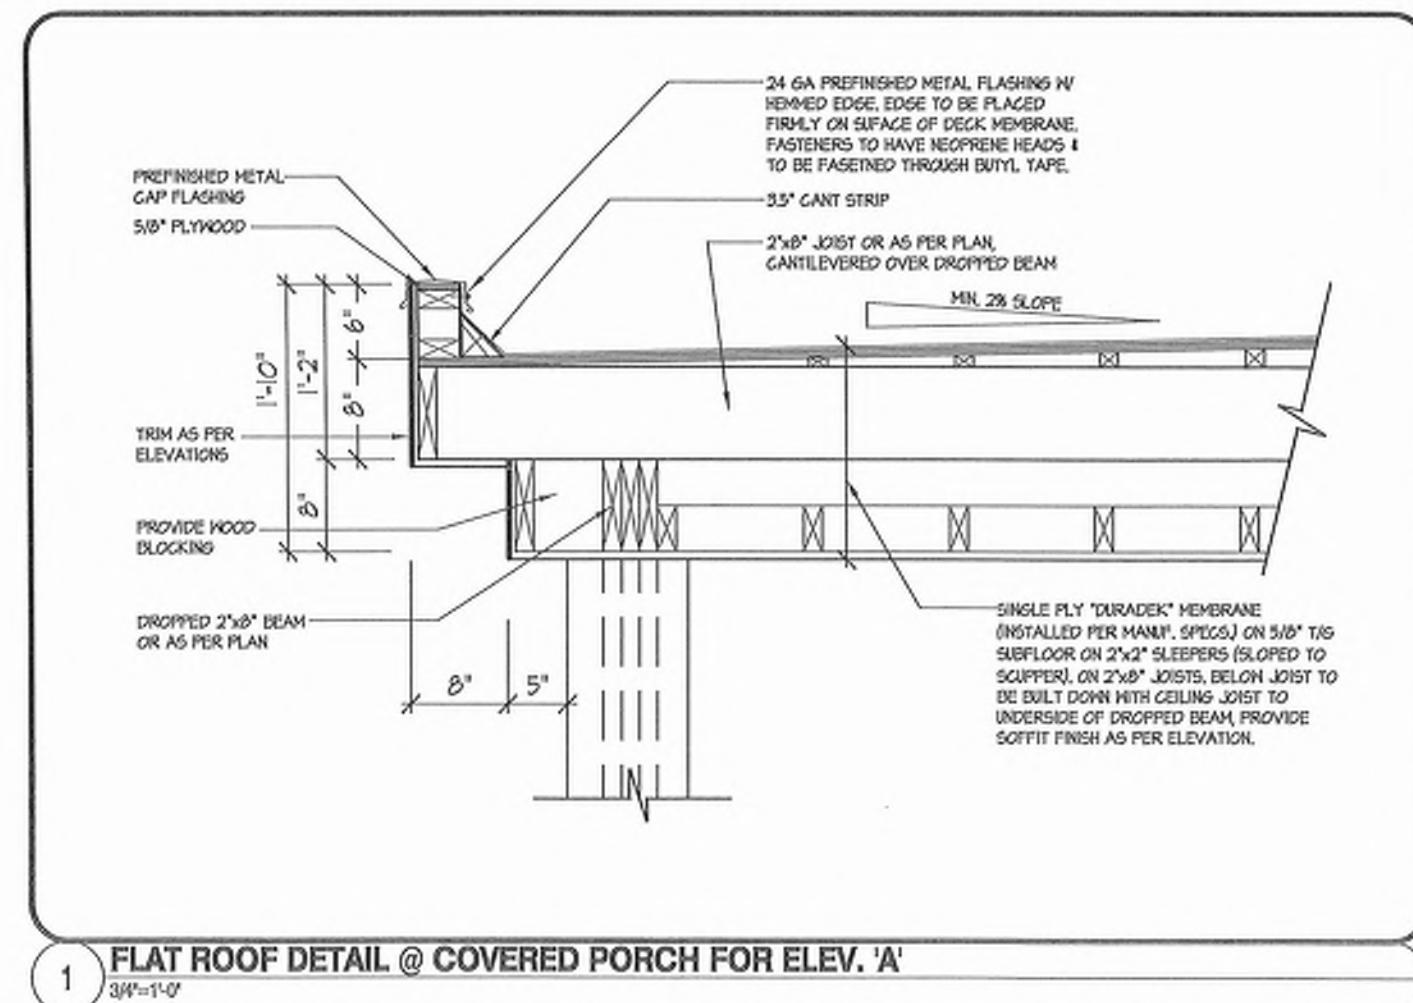

FLAT ROOF DETAIL @ COVERED PORCH FOR ELEV. 1

$$34^\circ = 1^{\circ} 0$$

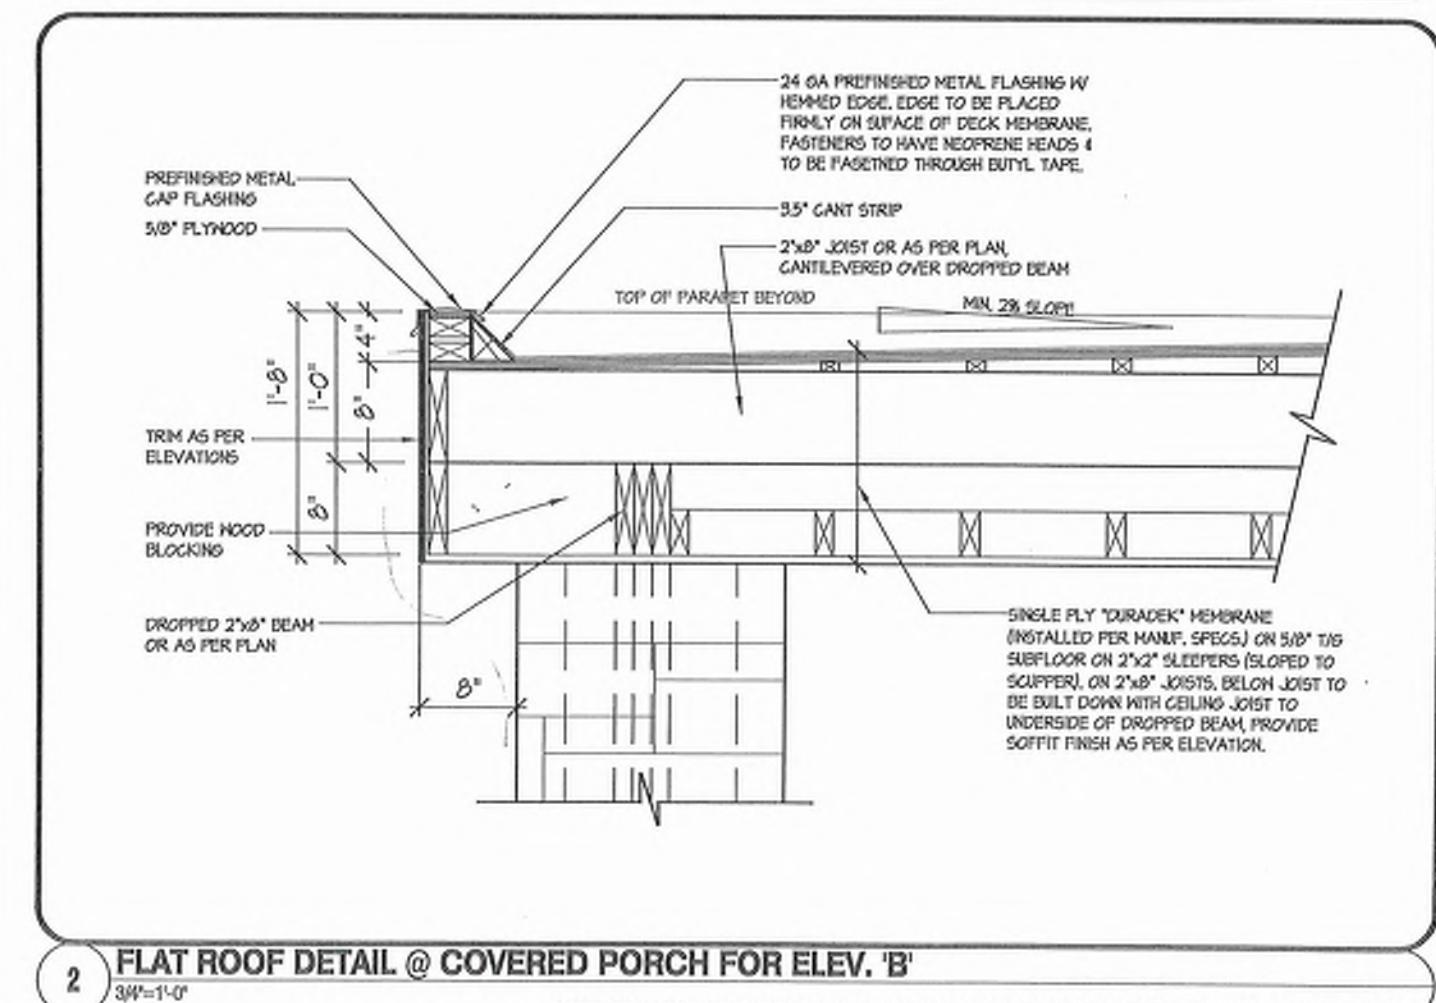

FLAT ROOF DETAIL @ COVERED PORCH FOR ELEV. 'B'

$34^\circ = 140^\circ$

Bk 19
123

CROSS SECTION 'A-A'

UNIT 2016

REV.2025.03.24

Page Number
26 of 29

ROYAL PINE HOMES - 218094

921 BAYVIEW, RICHMOND HILL, ON.

File Number
218094WTT2016

Page Number
26 of 29

HUNT

DESIGN ASSOCIATES INC.

www.huntassociates.ca

8989 Woodbine Ave, Markham, ON L3R 0J7 T 905.737.5133 F 905.737.7326

The undersigned has reviewed and takes responsibility for this drawing.
Design and has the sole right to build or let it be designed.

Signature _____ Date _____


Dominic Mabio
HUNT DESIGN ASSOCIATES INC.

Registration Information

1555

Domestic Model No.

All drawings specifically referred to and design are the copyright property of Hunt Design Associates Inc. Reproduction of this property in whole or in part is strictly prohibited without HDA's written permission.

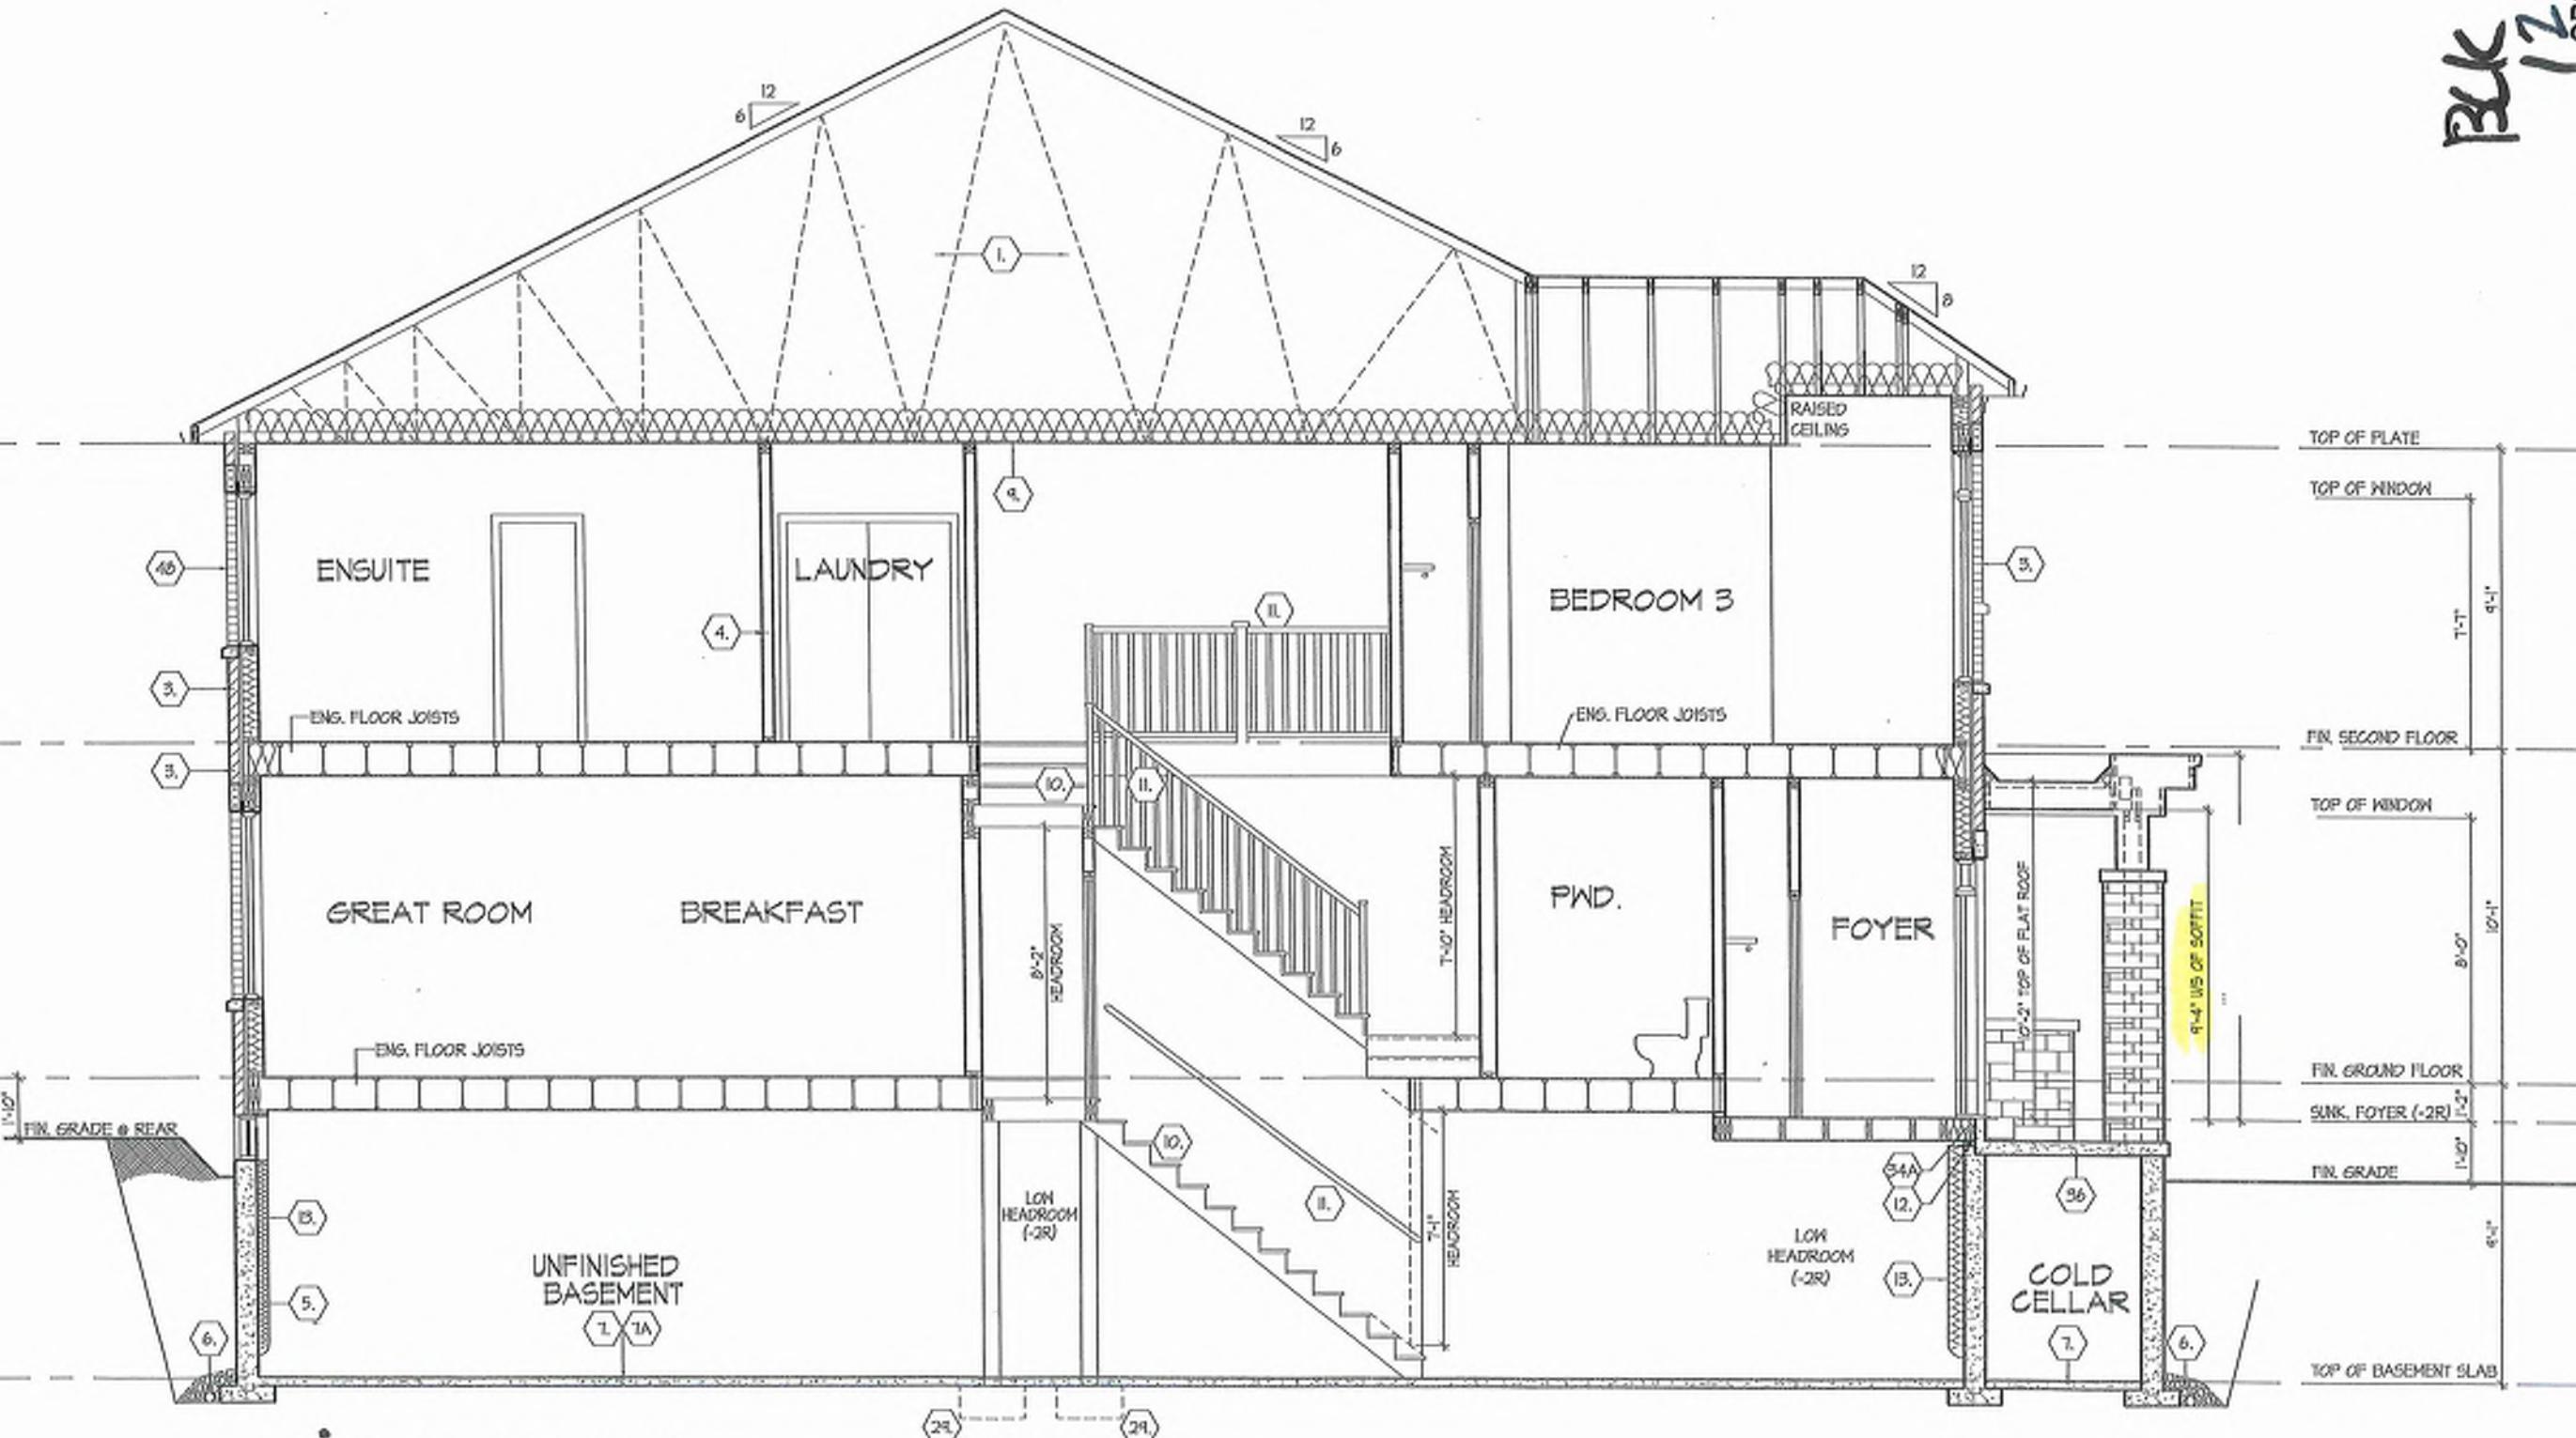

CROSS SECTION 'A-A'

cont. SECTION 1.0. CONSTRUCTION NOTES

REFER TO SE-12 ENERGY EFFICIENCY DESIGN MATRIX ON THE TITLE PAGE FOR ALL VALUES AS REQUIRED PER 3.1.1, 3.1.2, 3.1.3 OF THE O.B.C..

SECTION 2.0. GENERAL NOTES

2.1. WINDOWS

1) EXCEPT WHERE A DOOR ON THE SAME FLOOR LEVEL AS THE BEDROOM PROVIDES DIRECT ACCESS TO THE EXTERIOR, EVERY FLAT, STRAPPING CAVITY EACH SIDE WHETHER IT IS EAST 90% OF INSULATIVE MATERIAL PROCESSED FROM ROCK, SLUG OR GLASS, TAPE, FILM & SAND, ALL GYPSUM JOINTS EXPOSED BLD-2C MUST BE SEALED W/ 2 COATS OF PAINT OR FILLED WITH 1/2" (38x38) WD. STRAPPING & 1/2" (12.7) GYPSUM SHEATHING.

1 HR. PARTY WALL (DOUBLE STUD)

50" (1270) GYPSUM SHEATHING ON EXTERIOR SIDE OF 2 ROWS OF 25" (635) STUDS @ 16" (406) O.C. MIN. 1" (25) APART ON SEPARATE 2" (50) STUD PLATES. 1/2" (38x38) AS REQUIRED FULL ONE SIDE OF STUD CAVITY WITH AT LEAST 50% OF ABSORPTIVE MATERIAL PROCESSED FROM ROCK, SLUG OR GLASS, TAPE FIL & SAND ALL GYPSUM JOINTS.

2 HR. FIREWALL (18x4) WALL TYPE SW 8. B101

12" (305) GYPSUM SHEATHING ON EACH SIDE ON 2x2" (50x50) VERTICAL WD. FILLED STRAPPING CAVITY EACH SIDE WITH AT LEAST 80% OF ABSORPTIVE MATERIAL PROCESSED FROM ROCK, SLUG OR GLASS, TAPE FIL & SAND, ALL GYPSUM JOINTS EXPOSED BLD-2C MUST BE SEALED W/ 2 COATS OF PAINT OR FILLED WITH 1/2" (38x38) WD. STRAPPING & 1/2" (12.7) GYPSUM SHEATHING.

2.2. CEILING HEIGHTS

THE CEILING HEIGHTS OF ROOMS AND SPACES SHALL CONFORM TO TABLE 8.5.3.1. MINIMUM HEIGHTS

2.3. MECHANICAL PLUMBING [B-32]

1) MECHANICAL VENTILATION IS REQUIRED TO PROVIDE 1 AIR CHANGE PER HOUR REFER TO TLE PLATE FOR MAX. U-VALUE REQUIREMENTS.

2.4. LUMBER

TALL UMBERS SHALL BE APPROVED NO.2 GRADE OR BETTER, UNLESS NOTED OTHERWISE. 1) REFER TO TLE PLATE FOR SPACE HEATING EQUIPMENT, H.V. AND DOMESTIC HOT WATER HEATER MINIMUM EFFICIENCIES.

2.5. STEEL [B-23.4.0]

1) ALL ROOF OVERHANGS SHALL BE 1/4" (30) UNLESS NOTED OTHERWISE. 1) FLASHING MATERIALS & INSTALLATION SHALL CONFORM TO O.B.C.

2.6. FLAT ARCHES

1) JOST HANDBARS: PROVIDE APPROVED METAL HANDBARS FOR ALL JOISTS AND BUILT-UP WOOD MEMBERS INTERSECTING WITH FLUSH BUILT-UP WOOD MEMBERS. 2) FOR 1/2" (12.7) CELINGS, FLAT ARCHES SHALL BE 7" (178) A.F.F.

2.7. ROOF OVERHANGS

1) ALL ROOF OVERHANGS SHALL BE 1/4" (30) UNLESS NOTED OTHERWISE. 1) FLASHING MATERIALS & INSTALLATION SHALL CONFORM TO O.B.C.

2.8. GRADING

1) THE BUILDING SHALL BE LOCATED ON THE BUILDING SITE GRADED SO THAT WATER WILL NOT ACCUMULATE AT OR NEAR THE BUILDING AND WILL NOT ADVERSELY AFFECT ADJACENT PROPERTIES. CONFIRM TO [B-14.6].

2.10. U.L.C. SPECIFIED ASSEMBLIES

ALL REQUIRED INDIVIDUAL COMPONENTS THAT FORM PART OF ANY U.L.C. LISTED ASSEMBLY SPECIFIED IN THESE DRAWINGS, CANNOT BE ALTERED OR SUBSTITUTED FOR ANY OTHER MATERIAL PRODUCT OR SPECIFIED MANUFACTURER THAT IS IDENTIFIED IN THAT SPECIFIED U.L.C. LISTING. THERE SHALL BE NO DEViations UNDER ANY CIRCUMSTANCES. SEE SECTION 2.0 FOR U.L.C. LISTED ASSEMBLY IDENTIFIED IN THESE DRAWINGS.

SECTION 3.0. LEGEND

3.1. WOOD LINTELS AND BUILT-UP WOOD

[DIVISION B. PART 9. TABLES 9.23.4.2-(A-L)]
FORMING PART OF SENTENCE: [9.23.4.2.(1)], [9.23.4.2.(4)], [9.23.12.1.(1)], [B-1], [B-23.4.2.(1)]

3.2. STEEL LINTELS SUPPORT MASONRY VENEER

[DIVISION B. PART 9. TABLE 9.20.20.2-B.]
FORMING PART OF SENTENCE: 9.20.20.2-B & 9.20.5.2.(3)

3.3. DOOR SCHEDULE

CODE SIZE 2X10' SPRUCE #2 2X12' SPRUCE #2 2X12' SPRUCE #2 EXPOSED BUILDING FACE-O.B.C. 8.10.14. CR 9.10.16.
REFER TO HEX NOTE 26 & DETAILS FOR TYPE AND SPECIFICATIONS.

3.4. DOOR SCHEDULE

L1 2/2X10' (238x164) L3 2/2X10' (238x235) L5 2/2X12' (238x235)
S1 3/2X12' (338x164) S3 3/2X10' (338x235) S5 3/2X12' (338x235)
B2 4/2X12' (438x164) B4 4/2X10' (438x235) B6 4/2X12' (438x235)
B7 5/2X12' (538x164) B8 5/2X10' (538x235) B9 5/2X12' (538x235)

SECTION 4.0. CLIMATIC DATA

REFER TO O.B.C. FOR DESIGN SNOW LOAD [9.4.2.2]
& WIND PRESSURE (SB-1, TABLE 2)

4.1. EXPOSED BUILDING (BUILT-UP WOOD, COLUMNS AND STUD POSTS)

SOLID BEARING (BUILT-UP WOOD, COLUMNS AND STUD POSTS) CHECKING LOCAL BYLAWS FOR REQUIREMENTS* A CARBON MONOXIDE ALARM(S) SHALL BE INSTALLED ON OR NEAR THE CEILING IN EACH DWELLING UNIT, ON EACH STOREY AND ADJACENT TO EACH SLEEPING ROOM AND A CARBON MONOXIDE ALARM IS REQUIRED IN ANY SLEEPING ROOM THAT CONTAINS OR SHARES A WALL OR FLOOR CEILING WITH A ROOM THAT CONTAINS A FUEL BURNING APPLIANCE OR FUELS. ALARMS SHALL BE REQUIRED IN ANY SLEEPING ROOM ADJACENT TO AN ELECTRICAL CIRCUIT AND WITH A BATTERY BACKUP. ALARM SIGNAL SHALL MEET TEMPORAL SOUND PATTERN. MIN. ALARMS SHALL HAVE A VISUAL SIGNALING COMPONENT AS PER THE NATIONAL FIRE ALARM AND SIGNALLING CODE 72.

4.2. CMA - CARBON MONOXIDE ALARM [B-10.15]

■ PROVIDE ONE PER FLOOR, NEAR THE STAIRS CONNECTING THE FLOOR LEVEL ALARMS ARE TO BE INSTALLED IN EACH SLEEPING ROOM AND IN A LOCATION BETWEEN SLEEPING ROOMS AND CONNECTING HALLWAYS AND WIRED TO BE INTERCONNECTED TO ACTIVATE ALL ALARMS IF ONE SOUNDS. ALARMS ARE TO BE CONNECTED TO AN ELECTRICAL CIRCUIT AND WITH A BATTERY BACKUP. ALARM SIGNAL SHALL MEET TEMPORAL SOUND PATTERN. MIN. ALARMS SHALL HAVE A VISUAL SIGNALING COMPONENT AS PER THE NATIONAL FIRE ALARM AND SIGNALLING CODE 72.

4.3. EXHAUST VENT

■ CLASS B VENT DUCT OUTLET (12 HIGH) ■ CLASS C VENT DUCT OUTLET (12 HIGH)

4.4. DUCT OUTLET HEIGHT AS NOTED (AFF)

■ FA FLAT ARCH ■ ID FLOOR DRAIN ■ FB FIXED GLASS ■ TIO TOP OF

4.5. SWITCH (3/4 WAY)

■ HEAVY DUTY OUTLET ■ LIGHT FIXTURE (CEILING MOUNTED)

4.6. LIGHT FIXTURE (FLOOR)

■ GARDER TBSS ■ GARDER TRUSS ■ GARDER TRUSS BY ROOF MANUFACTURER

4.7. TELEPHONE JACK

■ CABLE TV JACK ■ CENTRAL VACUUM OUTLET ■ CHANDELIER (CEILING MOUNTED)

4.8. ELECTRIC VEHICLE CHARGING STATION ROUGH-IN

4.9. SMOKE ALARM [B-10.15]


■ SA SMOKE ALARM ■ CMA - CARBON MONOXIDE ALARM ■ CANCGA-4.1.1 ■ CANCGA-4.1.2 ■ CANCGA-4.1.3 ■ CANCGA-4.1.310 ■ CANCGA-4.1.311 ■ CAN




BAYVIEW HEIGHTS
RICHMOND HILL



INVENTORY

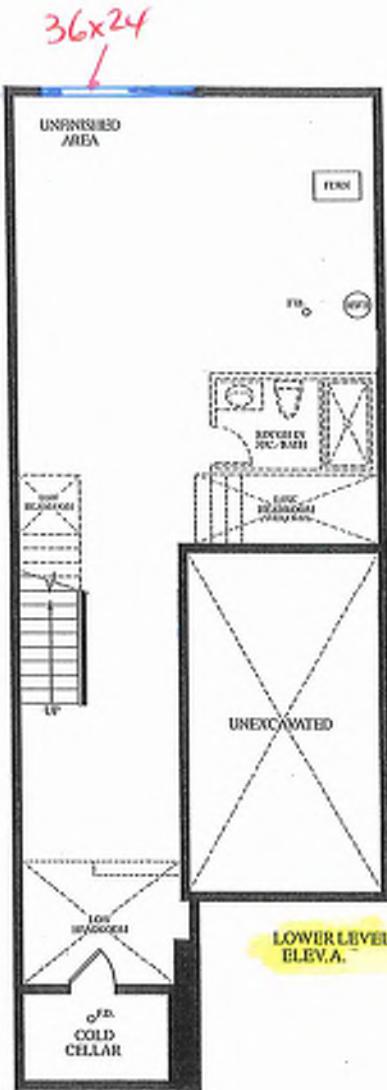

EXTENDED HEIGHT FRONT DOOR
 $66 \times 98\frac{1}{2}$

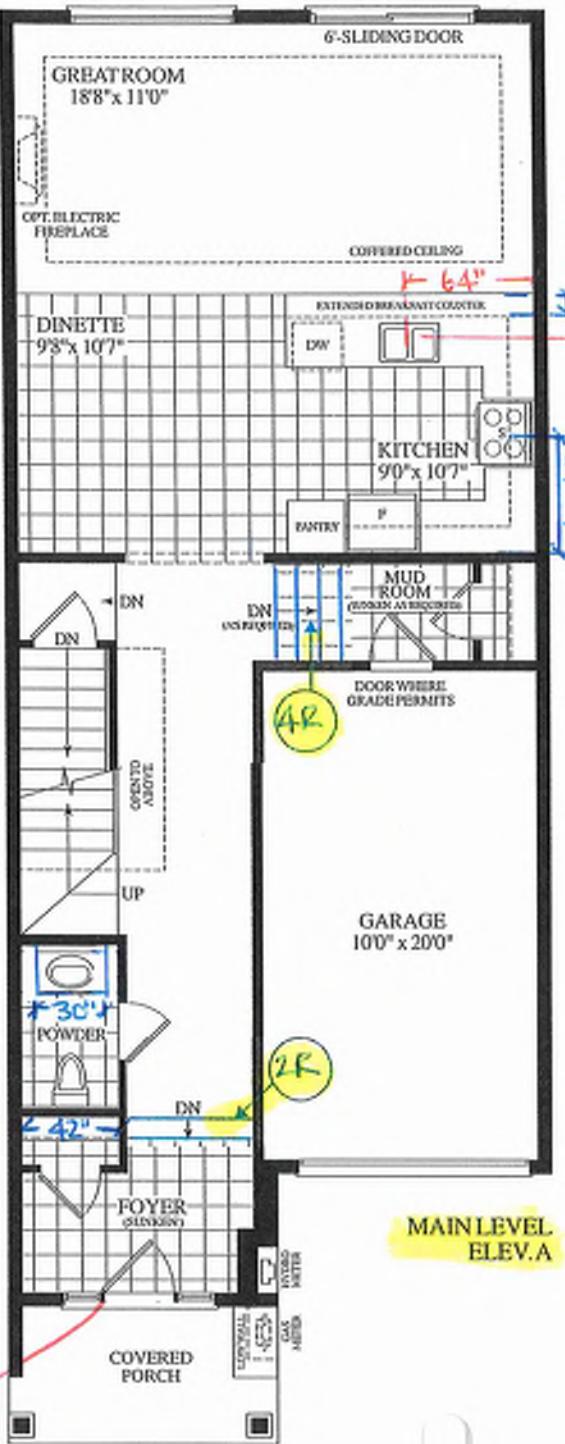

INVENTORY - T. H


BLK.19 TH.124 20-16 THE CHARLOTTE ELEV. A
STD. MAIN OPT.
UPPER LEVEL 3 BATH.

1795 SQ.FT

Materials, specifications and floor plans are subject to change without notice. All renderings are artist's concept.
All floor plans are approximate dimensions. Actual usable floor space may vary from the stated floor area. E&OE.

GROUND TO SECOND
122' HT 11-7/8" JOIST

BASEMENT TO GROUND
BSMT 11-7/8" JOIST

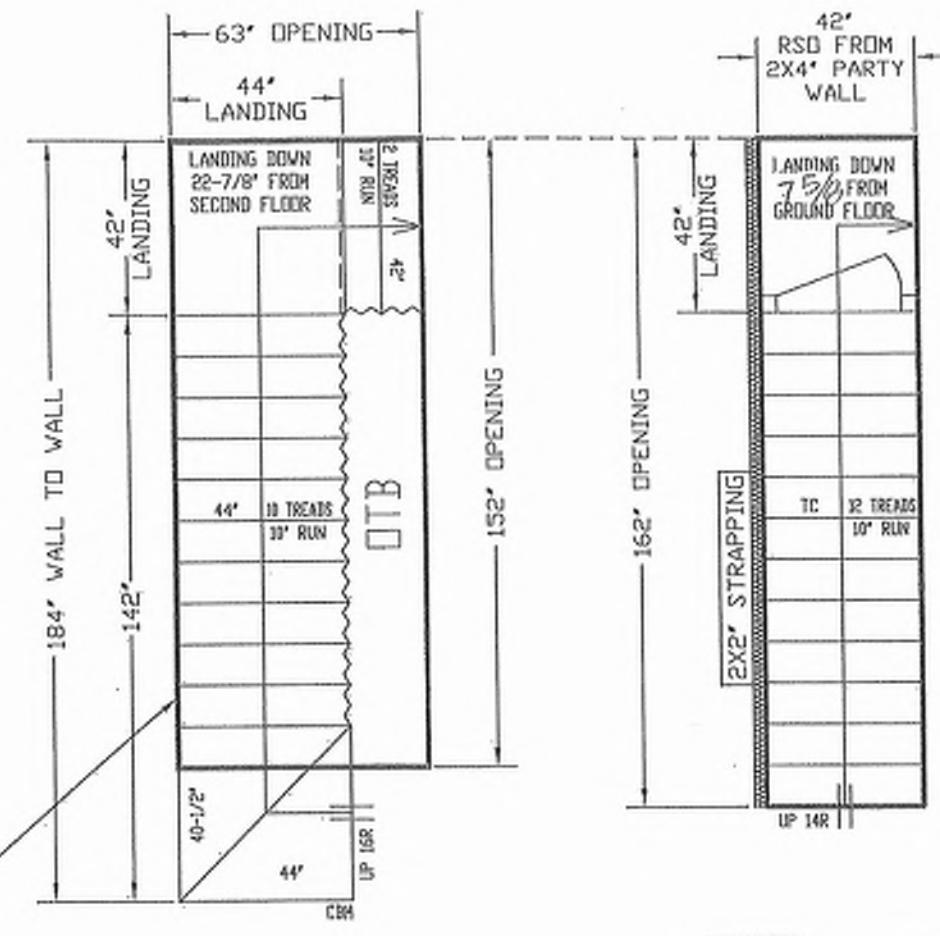

ALL OPENINGS ARE ALLOWED FOR 1 LAYER OF DRY WALL.
ANY ADDITIONAL LAYERS MUST BE ALLOWED BY CARPENTERS

STAIRS LINE UP BY
PARTY WALL

REVISED
JUNE 4, 2025

GARAGE RIGHT >

SITE	BAYVIEW HEIGHTS	DRAWN BY	NAME	DATE
LOT #		DRAWN BY	PARAMJEET	MAY 23, 2025
Model		DESIGN		
	ROYAL PINE HOMES	LAYOUT #		
	UNIT 2016	SCALE	135	




ALL LANDINGS TO BE SUPPLIED AND SUPPORTED BY OWNERS UNLESS SPECIFIED ABOVE.
ANY STRAPPING ALLOWANCES TO BE COMPENSATED BY CARPENTERS.
ALL STAIR DIMENSIONS MAY BE ADJUSTED FROM ORIGINAL BLUE PRINTS OR SPEC'S AS SUPPLIED
TO ALPHA STAIRS AND RAILINGS INC. MEASUREMENTS SHOWN ON LAYOUTS ARE REQUIRED TO
INSTALL OUR STAIRS. ANY PROBLEMS WITH STRAPPING OR STRAPPING ALLOWANCES, ALPHA
STAIRS AND RAILINGS INC. WILL NOT BE RESPONSIBLE. STAIR LAYOUTS SHOULD BE CHECKED BY
CARPENTERS OR SITE SUPERVISORS TO MAKE SURE THERE ARE NO DISCREPANCIES BEFORE PROCEEDING
WITH CONSTRUCTION.

ALPHA STAIRS AND RAILINGS INC.
3770 NASHUA DRIVE, UNIT 3 MISSISSAUGA, ONTARIO L4V 1M5
TELE (905) 694-9556 | www.alpastairs.com




BLK 19-124

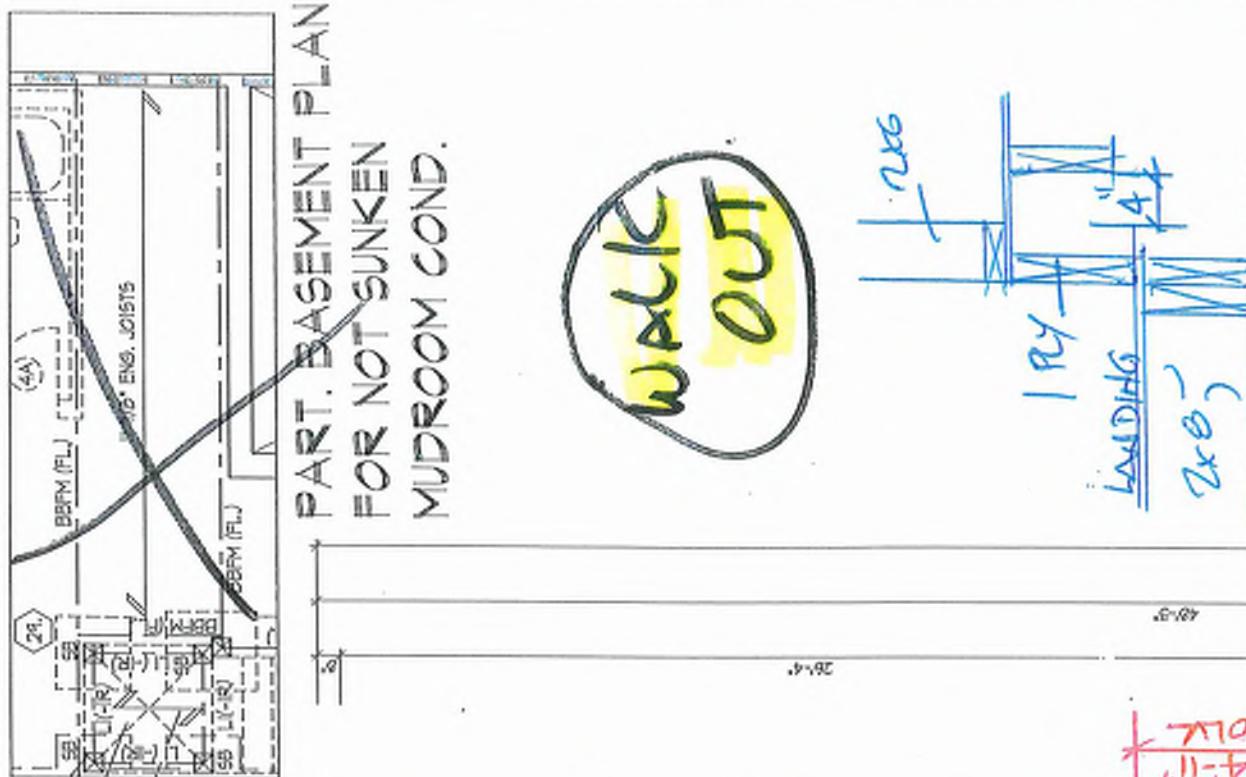

~~PART BASEMENT PLAN
FOR NOT SUNKEN
MUDROOM COND.~~


105

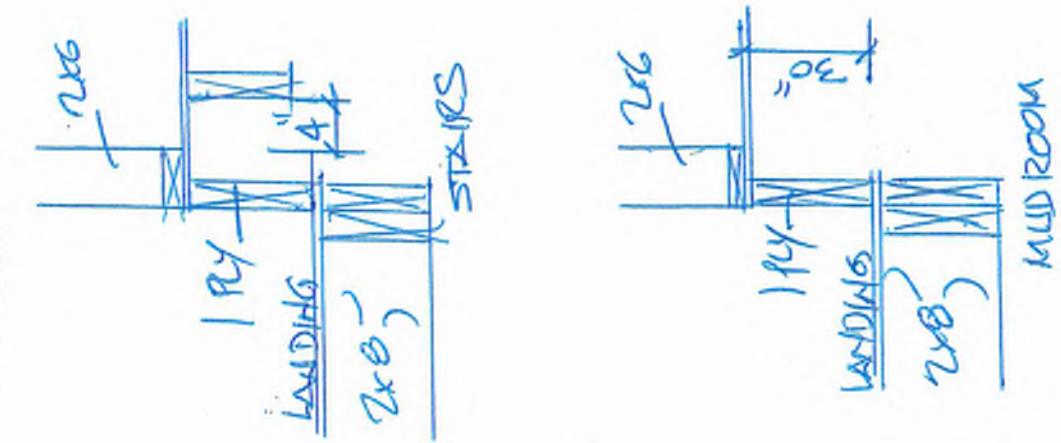

Hall Book

<p>FURNACE AND HOT WATER TANK</p> <p>PROVIDE SOLID WOOD BLOCKING @ 24" O.C. FOR FIRST JOIST SPAN WHEN PARALLEL TO EXTERIOR WALL.</p>	<p>REFER TO FLOOR JOIST MANUFACTURER'S DRAWINGS FOR LAYOUT, SPACINGS, BLOCKING & STRAPPING REQUIREMENTS, INSTALLATION DETAILS AND HANGER SIZES, SUBFLOOR THICKNESS</p>
--	--

This is to certify that these plans comply with the applicable Architectural Design Guidelines approved by the City of RICHMOND HILL.

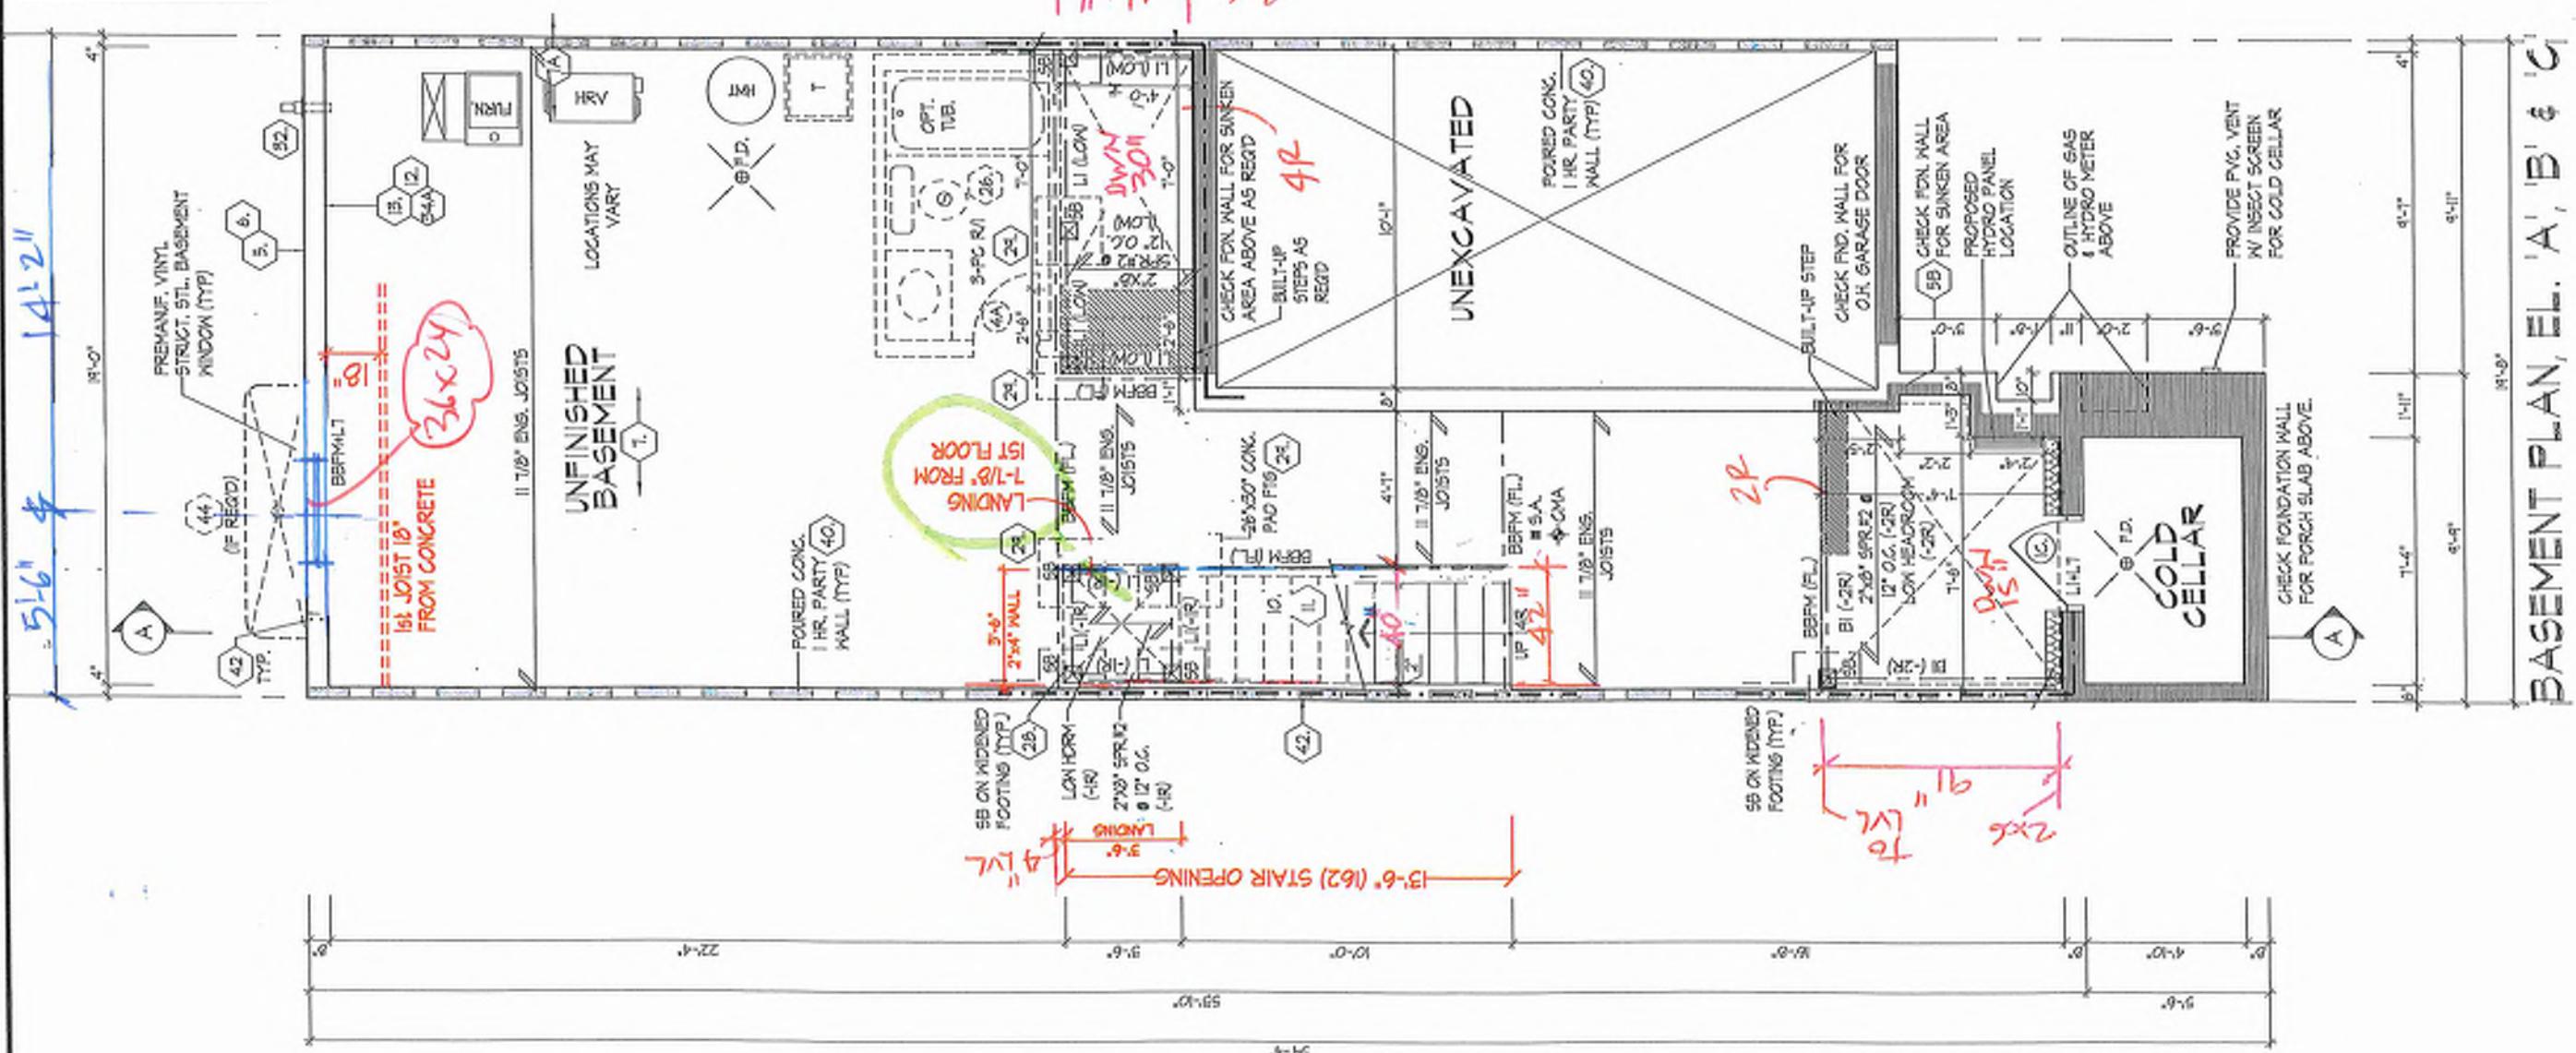


BLK 19-124

HUNT
GLOBAL CONSULTING

www.huntdesign.com

ROYAL PINE HOMES - 218094
9221 BAYVIEW, RICHMOND HILL, ON.
UNIT 2016
REV.2025.03.24
Page Number _____
Printed By _____
Checked By _____
File Number _____

218084VT2016
2 cf 25
8888 Woodbine Ave., Markham, ON L3R 0J7 T 905.757.5133 F 905.757.7535

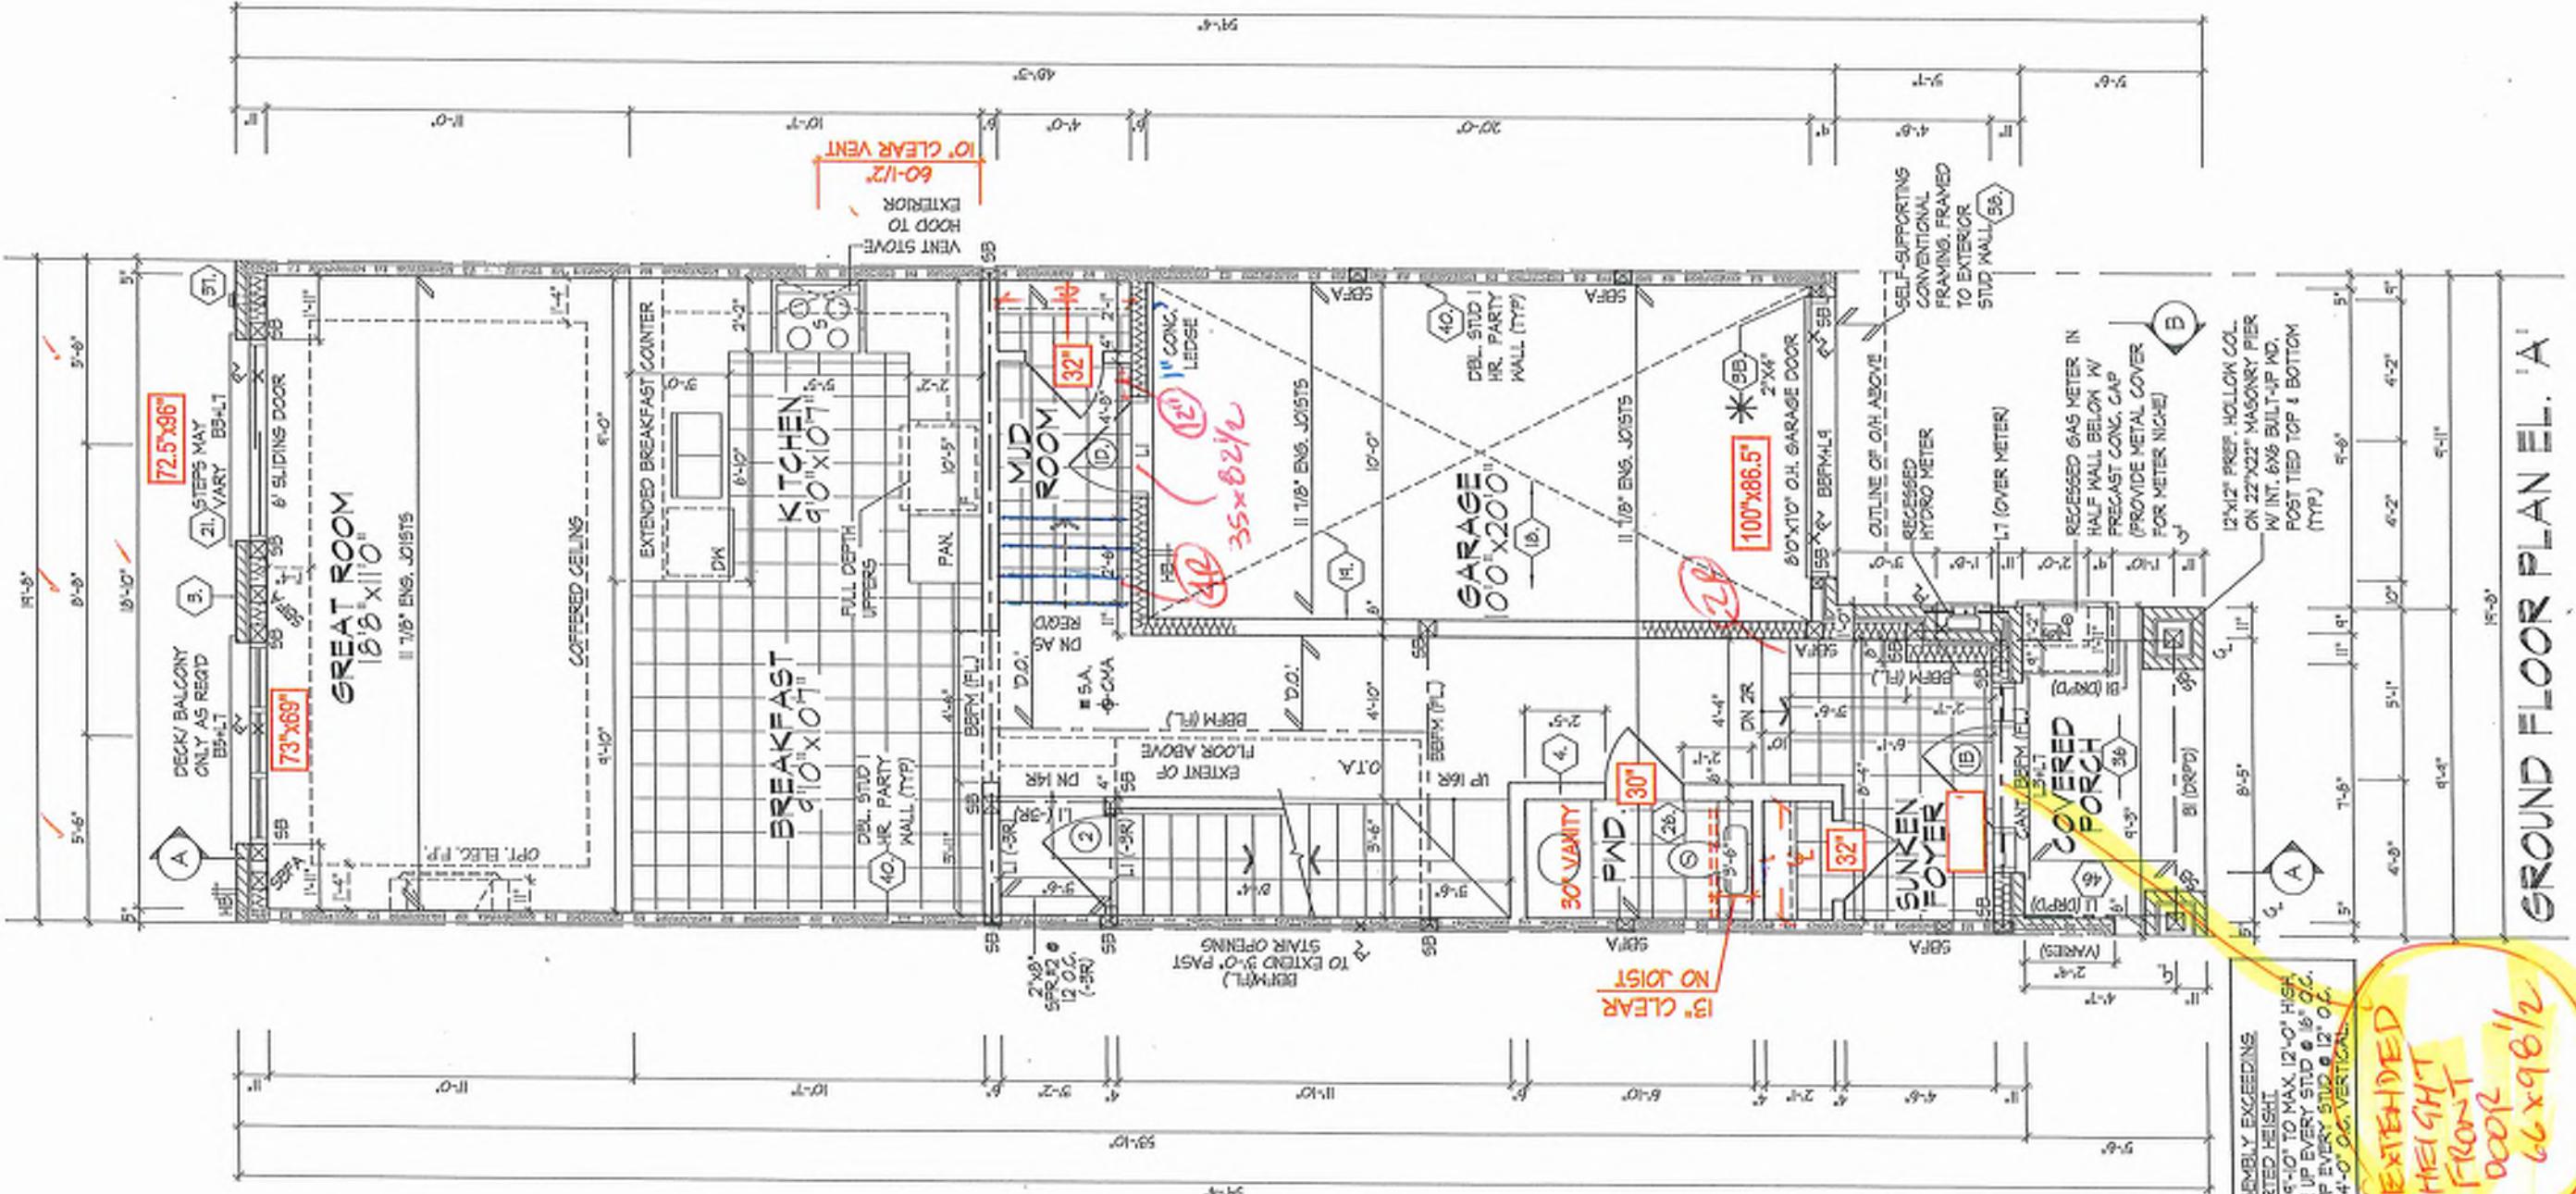

INTERDOORS & BSH
WILDCATS SEEJ
EHEV

124

10

THE UNDERGROUND HAIR SALON OWNED AND OPERATED BY HEATHER LEE THIS
BUSINESS HAS THE FOLLOWING FEATURES AND MEETS THE REQUIREMENTS SET
OUT IN THE ONTARIO BUILDING CODE TO BE A BARBERSHOP.
GRANVILLE AVENUE
DAMONIC MOTEL
NAME: 8888888888
NAME:

UNIT 2016
REV.2025.03.24
Page Number
3 of 25

64M72046
The House

ROYAL PINE HOMES - 218094
 921 BAYVIEW, RICHMOND HILL, ON.
 Built By KWT
 Checked By MM
 Date 3/16/1976
 3116-1-L-0

HUNT
DESIGN ASSOCIATES INC.

1

UNIT 2016
REV.2025.03.24
Page Number
3 of 25


64M72046

OMES - 218094
RHMOND HILL, ON.

ROYAL PINE
9921 BAYVIEW,
MISSISSAUGA,
ONTARIO
L4Y 4B2

HUNT
DESIGN ASSOCIATES INC.

1

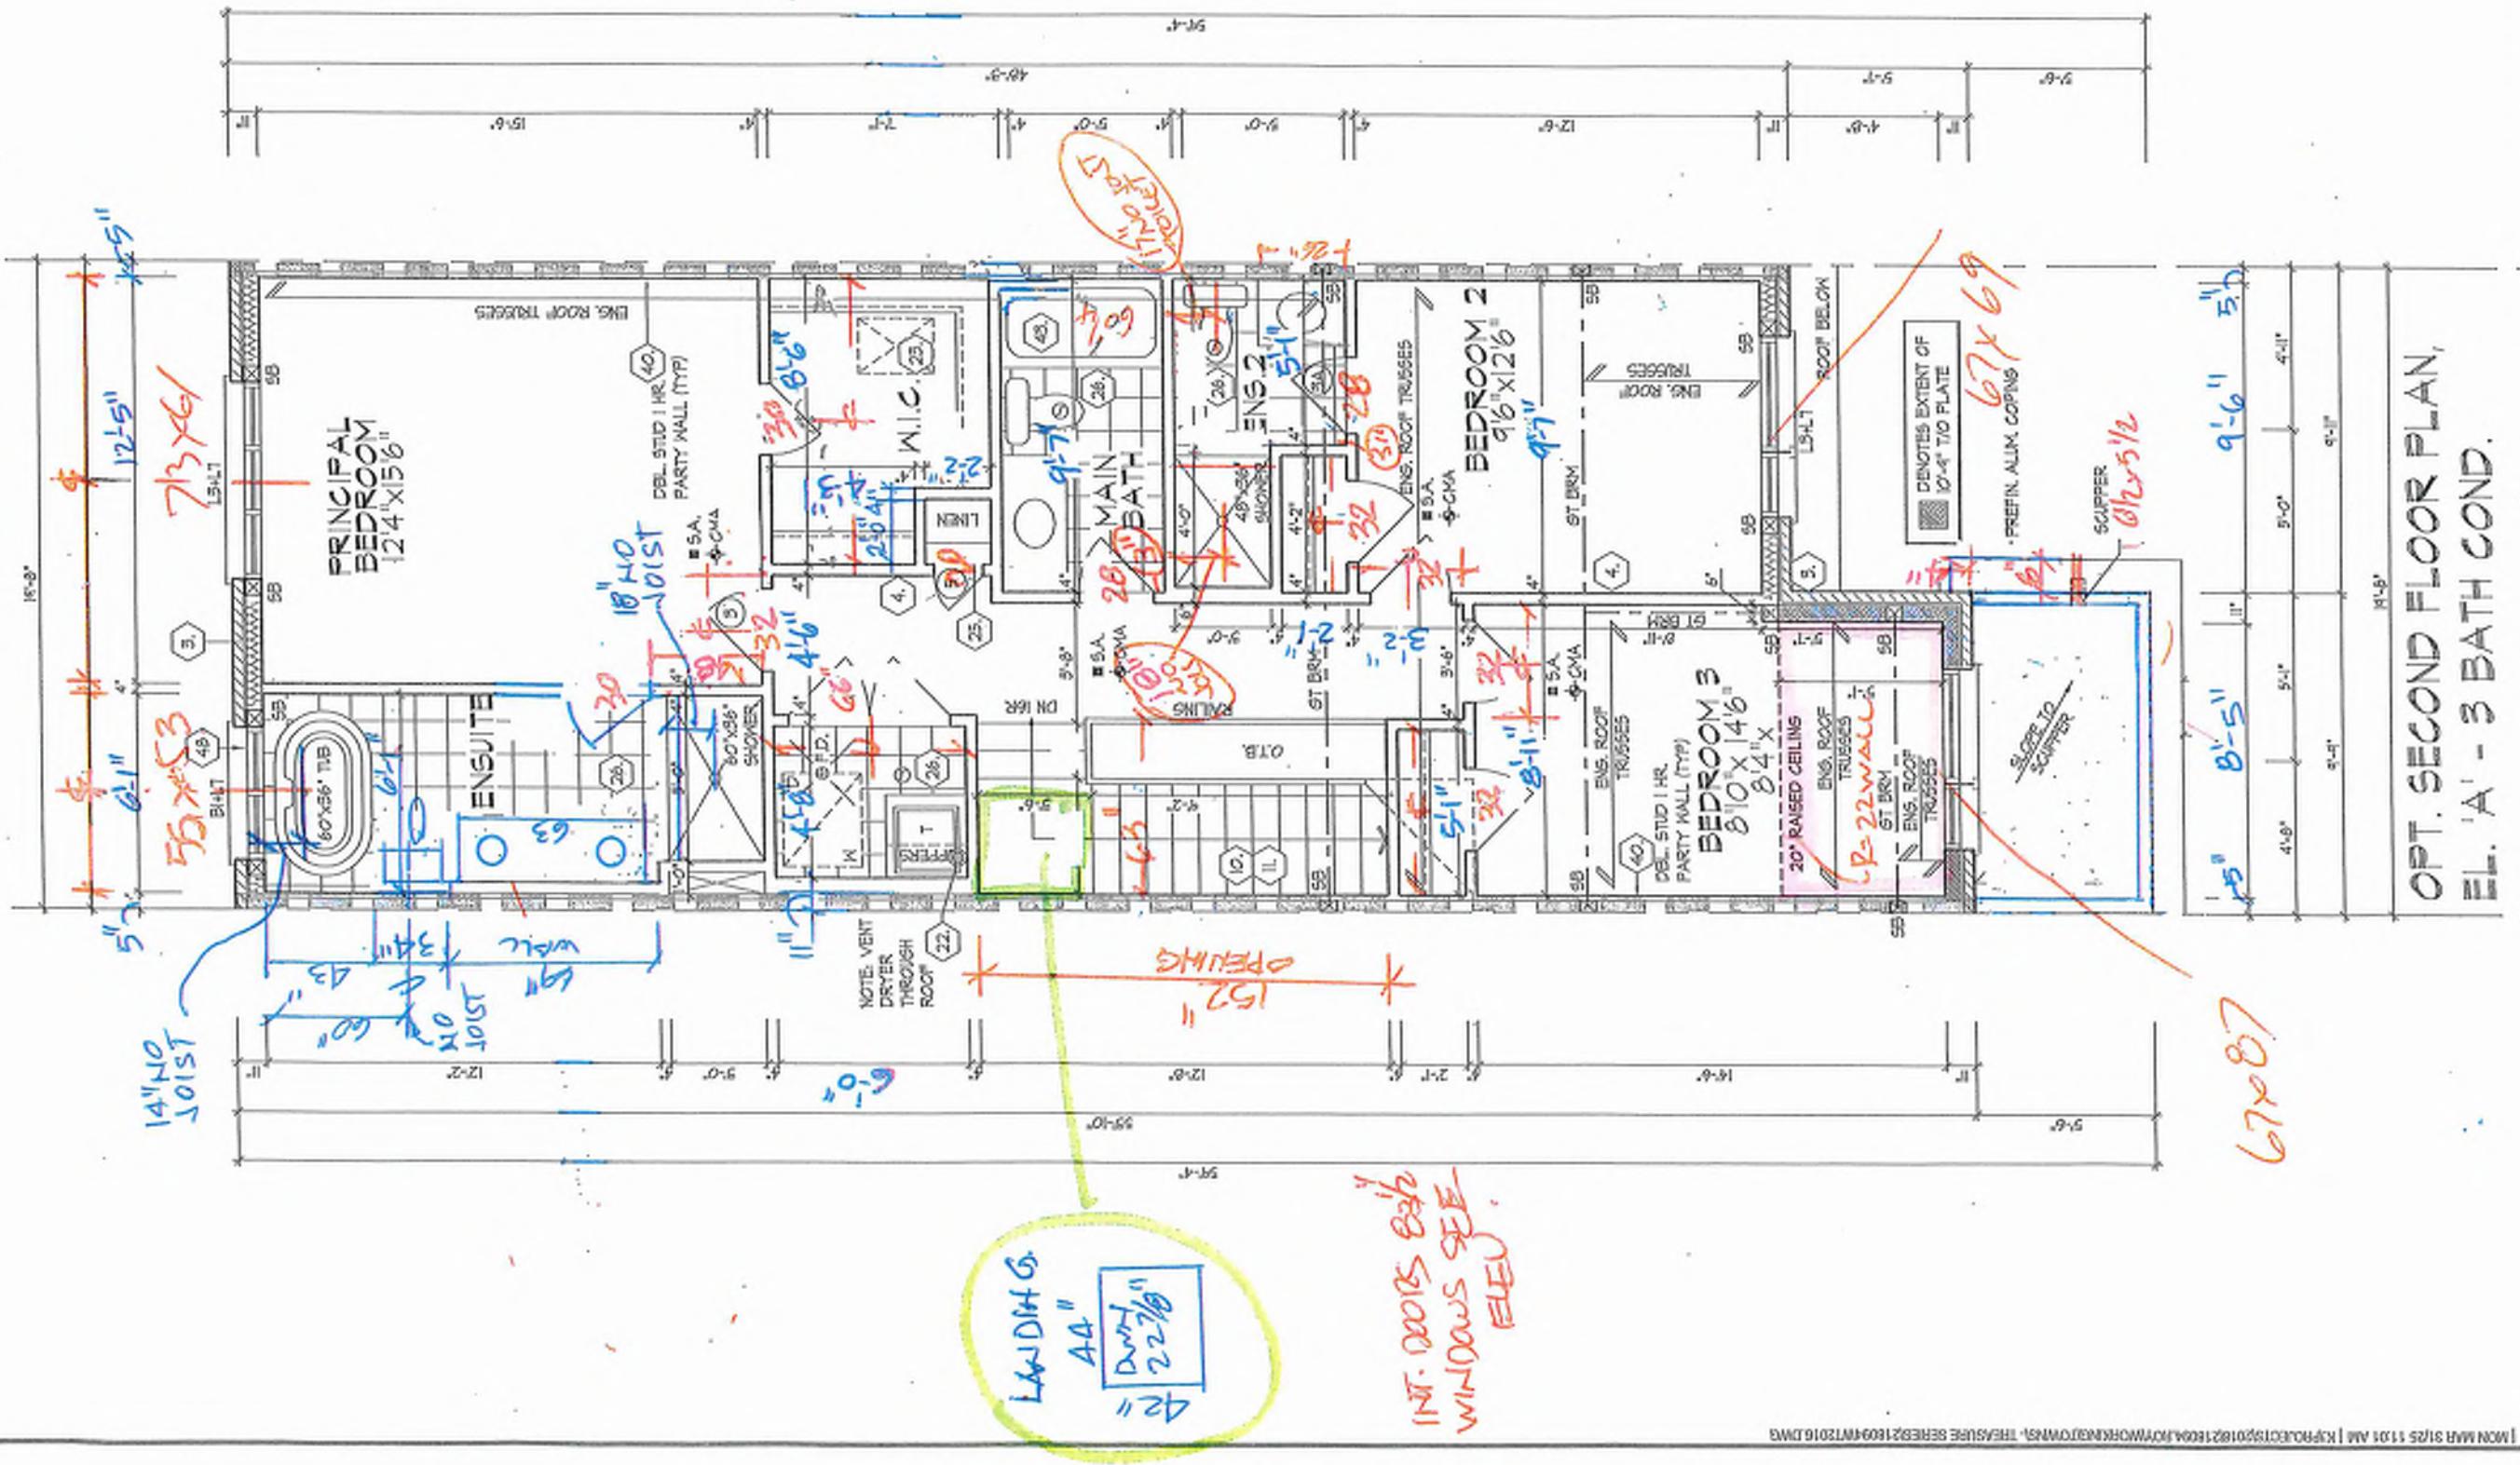

BOYAL P

HUMAN

Grown By
KMUTT


www.HuntDesigns.ca 8088 Woodbine Ave., Etobicoke, ON M3J 2M2, Canada. Tel: 416-239-1111, Fax: 416-239-1112.

© 2004 SAGE Publications [SAGE] Reproduction of this property in whole or in part is strictly prohibited without written permission.

REV.2025-03-24
Page Number _____
6 of 29
Station #D.A. assumed no responsibility or liability for this property unless it became the appropriate BORN number and original signature.

ROOF PLAN
EL. 'A'
N.T.S.

EL. A
N.T.S.

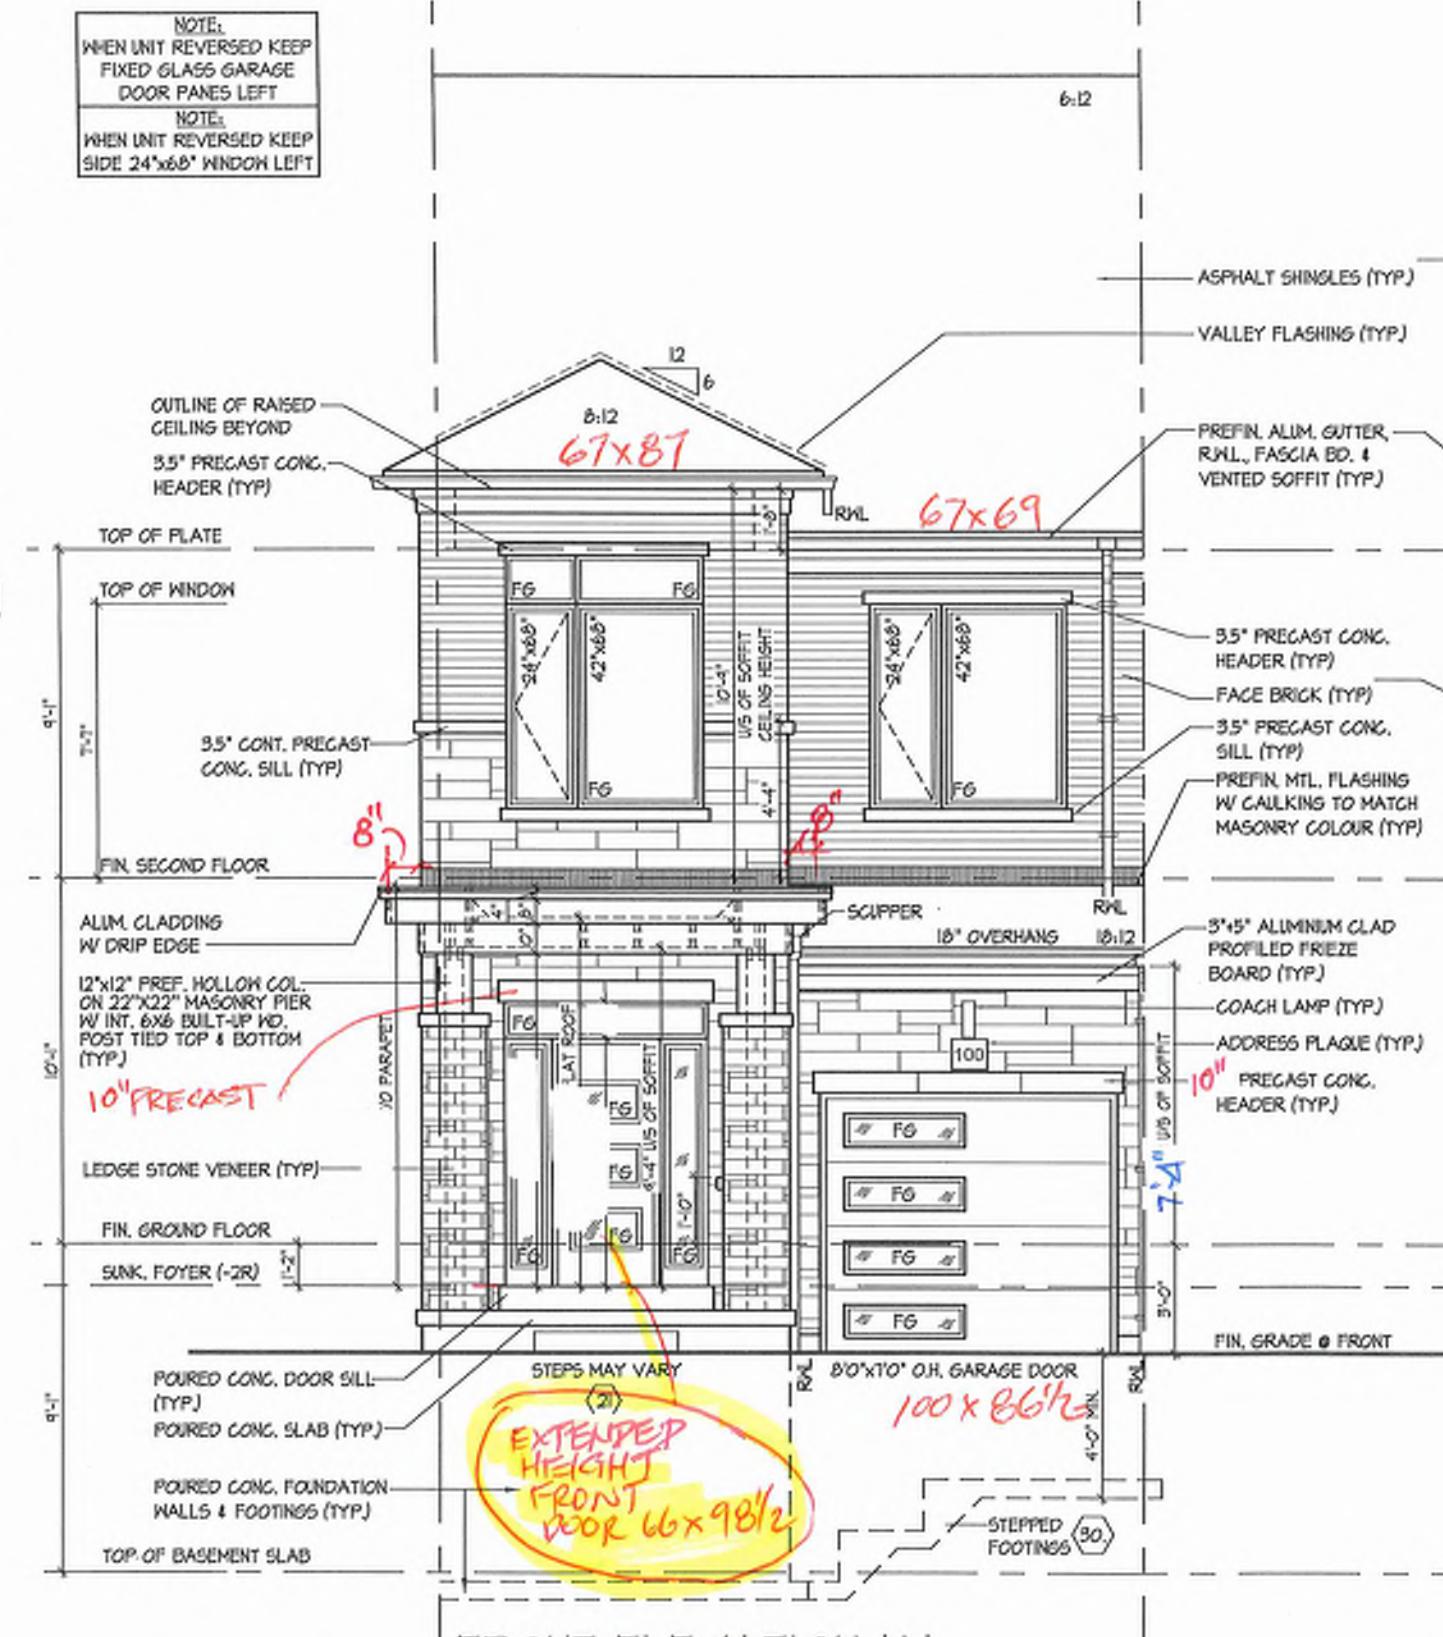

FRONT ELEVATION 'A'

REAR ELEVATION 'A', 'B' & 'C'

NOTES & INFORMATION

**ROOF OVERHANGS TO
UNLESS NOTED OTHERWISE**

ROOF OVERHANGS TO BE 12'
UNLESS NOTED OTHERWISE

WINDOW FOR OPTIONAL
SECOND FLOOR PLAN

55" x 49"

55" x 49"

ensure that all plans submitted for approval fully comply with the Architectural Guidelines and all applicable regulations and requirements including zoning provisions and any provisions in the subdivision agreement. The Control Architect is not responsible in any way for examining or approving site (lot) plan or working drawings with respect to any zoning or building code or permit matter, and that every house can be properly built or located on its lot. This is to certify that these plans comply with the applicable Architectural Design Guidelines approved by the City of RICHMOND HILL.

UNIT 2016
REV 2025-03-24

ROYAL PINE HOMES - 218094
921 BAYVIEW, RICHMOND HILL, ON.

INIT

THE UNDERSIGNED HAS REVIEWED AND TAKES RESPONSIBILITY FOR THIS
DESIGN AND HAS THE QUALIFICATIONS AND WANTS THE REQUIREMENTS SET
OUT IN THE ONTARIO BUILDING CODE TO BE A DESIGNER.

JULIA ROTONDO INFORMATION

Barcode Print Number Page Number
3/16=1-0^o 218094WT2016 15 of 25
ON L3R 0J7 T 905.737.5133 F 905.737.7325
DISCLAIMER: No responsibility or liability for this document unless it bears the appropriate BOM number and original signature.


It is the builder's complete responsibility to measure that all plans submitted for approval fully comply with the Architectural Guidelines and all applicable regulations and requirements including zoning provisions and any provisions in the subdivision agreement. The Consultant Architect is not responsible in any way for examining or approving site plan, plans or working drawings with respect to any zoning or building code permit matter or that any house can be properly built or located on its lot. This is to certify that these plans comply with the applicable Architectural Design Guidelines approved by the City of RICHMOND HILL.

Bulk 19
124

PARTIAL SECTION B, EL. 'A'

UNIT 2016
REV.2025.03.24

Page Number
17 of 29

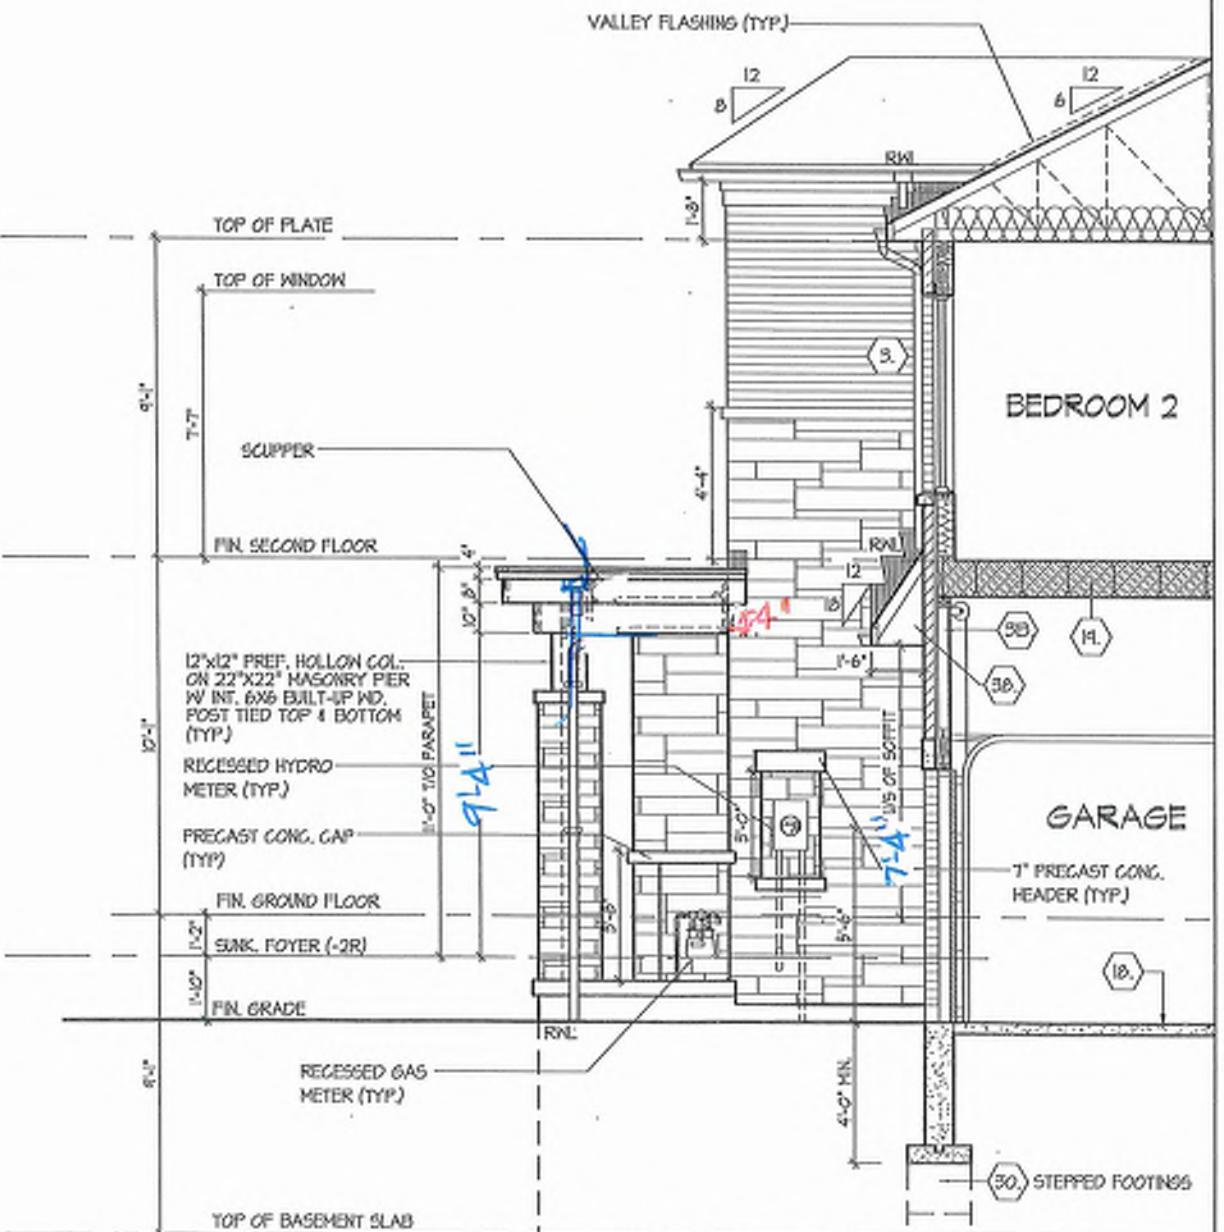

PARTIAL SECTION 'B', EL. 'A'

THE UNDERSIGNED HAS REVIEWED AND TAKES RESPONSIBILITY FOR THIS DESIGN AND HAS THE QUALIFICATIONS AND MEETS THE REQUIREMENTS SET OUT IN THE ONWARD BUILDING CODE TO BE A DESIGNER.
QUALIFICATION INFORMATION
Design Firm Name
HUNT ASSOCIATES INC.
Design Firm Address
8888 Woodbine Ave., North York, ON M3J 2Z8
Design Firm Telephone
416-286-1222
Design Firm Fax
416-286-1222
Design Firm Email
info@huntdesign.com
Design Firm Website
www.huntdesign.com

ROYAL PINE HOMES - 218094
921 BAYVIEW, RICHMOND HILL, ON.

Page Number
218094V/T2016
1



DESIGN ASSOCIATES INC.
www.huntdesign.com
8888 Woodbine Ave., North York, ON M3J 2Z8
T 416-286-1222 F 416-286-7338

All drawings, specifications, related documents and design are the copyright property of Hunt Design Associates (H.D.A.). Reproduction of this property in whole or in part is strictly prohibited without H.D.A.'s written permission. H.D.A. assumes no responsibility or liability for this property unless it bears the approved DCD number and original signature.

cont. SECTION 1.0. CONSTRUCTION NOTES

REFER TO SB-12 ENERGY EFFICIENCY DESIGN MATRIX ON THE TITLE PAGE FOR ALL VALUES AS REQUIRED PER 3.1.1, 3.1.2, 3.1.3, OF THE O.B.C.

SECTION 2.0. GENERAL NOTES

- 2.1. WINDOWS**
1) EXCEPT WHERE A DOOR ON THE SAME FLOOR LEVEL AS THE BEDROOM PROVIDES DIRECT ACCESS TO THE EXTERIOR, EVERY FLOOR LEVEL CONTAINING A BEDROOM IS TO HAVE AT LEAST ONE OUTSIDE WINDOW MIN. 0.33m² UNSTRUCTURED OPEN PORTION W/ NO DIMENSION LESS THAN 1.93' (380). CAPABLE OF MAINTAINING THE OPENING WITHOUT THE NEED FOR ADDITIONAL SUPPORT, CONFORMING TO [3.4.10].
2) WINDOW GUARDS: A GLUDED OR A WINDOW WITH A MAXIMUM RESTRICTED OPENING WIDTH OF 4' (1.22) IS REQUIRED WHERE THE TOP OF THE WINDOW SILL IS LOCATED LESS THAN 3' (0.915) ABOVE THE FLOOR AND THE DISTANCE FROM THE FLOOR TO THE STARBOARD IS GREATER THAN 5' (1.52).
3) WINDOWS IN BOT STARWAYS THAT EXTEND TO LESS THAN 2' (1.52) (1.07m) FOR ALL OTHER BUILDINGS SHALL BE PROTECTED BY GUARDERS IN ACCORDANCE WITH NOTE #2 (ABOVE), OR THE WINDOW SHALL BE NON-OPERABLE AND DESIGNED TO WITHSTAND THE SPECIFIED LOADS FOR BALCONY GUARDS AS PROVIDED IN [4.1.5] TO [4.1.6] OR [3.4.8].
- 4) REFER TO TITLE PAGE FOR MAX. U/WL REQUIREMENTS
- 2.2. CEILING HEIGHTS**
THE CEILING HEIGHTS OF ROOMS AND SPACES SHALL CONFORM TO TABLE 9.5.3.1.
- | ROOM OR SPACED | MINIMUM HEIGHTS |
|--------------------------------------|---|
| LIVING ROOM, DINING ROOM AND KITCHEN | 7'11" OVER 75% OF REQUIRED FLOOR AREA OR 6'11" CLEAR HEIGHT OF 6'11" AT ANY POINT |
| BEDROOM | 7'7" OVER 50% OF REQUIRED FLOOR AREA OR 6'11" OVER 1/2 OF THE REQUIRED FLOOR AREA. |
| BASEMENT | 6'11" OVER 1/2 AT LEAST 75% OF THE BASEMENT AREA EXCEPT THAT UNDER BEAMS AND ADJACENT TO CLEARANCE IN ANY AREA WHERE A PERSON WOULD NORMALLY BE STANDING 6'11". |
| BATHROOM, LAUNDRY AREA ABOVE GRADE | FINISHED ROOM NOT MENTIONED ABOVE 6'11". |
| MEZZANINES | 6'11" ABOVE & BELOW FLOOR ASSEMBLY [5.3.3.2] |
| STORAGE GARAGE | 6'11" 9'5 3/3." |
- 2.3. MECHANICAL / PLUMBING** [3.3.1]
1) MECHANICAL VENTILATION IS REQUIRED TO PROVIDE 1 AIR CHANGE PER HOUR REFER TO MECHANICAL DRAWINGS.
2) REFER TO HOT WATER TANK MANUFACTURER SPECS. CONFORM TO O.B.C. [3.1.6].
3) REFER TO TITLE PAGE FOR SPACE HEATING EQUIPMENT, HW AND DOMESTIC HOT WATER HEATER MINIMUM EFFICIENCIES.
- 2.4. LUMBER**
1) ALL LUMBER SHALL BE SPRUCE #2 GRADE OR BETTER, UNLESS NOTED OTHERWISE.
2) STUDS SHALL BE STUD GRADE SPRUCE, UNLESS NOTED OTHERWISE.
3) LUMBER EXPOSED TO THE EXTERIOR TO BE SURFACE NO. 2 GRADE PRESSURE TREATED OR CEDAR, IN LESS NOTED OTHERWISE.
- 2.5. STEEL** [3.23.4.3]
1) ALL LAMINATED VENEER LUMBER (LVL) BEAMS, GIRDERS, TRUSSES, AND METAL HANGER CONNECTIONS SUPPORTING ROOF FRAMING TO BE DESIGNED & CERTIFIED BY FLOOR AND ROOF TRUSS MANUFACTURER.
- 2.6. FLAT ARCHES**
1) FOR 18'-0" (2440) CELINGS, PLAT ARCHES SHALL BE 6'10" (2080) A.F.F.
2) FOR 9'-0" (1090) (340) CELINGS, PLAT ARCHES SHALL BE 7'10" (2400) A.F.F.
3) FOR 10'-0" (1200) (360) CELINGS, PLAT ARCHES SHALL BE 8'5" (2600) A.F.F.
- 2.7. ROOF OVERHANGS**
1) FULL ROOF OVERHANGS SHALL BE 1'0" (300), UNLESS NOTED OTHERWISE.
- 2.8. FLASHING** [3.20.13], [3.26.4], [18.27.4]
- 2.9. GRADING**
1) STRUCTURAL STEEL SHALL CONFORM TO CAN/CSA-A421 GRADE 350W, HOLLOW FLASHER MATERIALS & INSTALLATION SHALL CONFORM TO O.B.C.
- 2.10. ULC SPECIFIED ASSEMBLIES**
1) ALL REQUIRED INDIVIDUAL COMPONENTS THAT FORM PART OF ANY ULC LISTED ASSEMBLY, PROVIDED APPROVED METAL HANGERS FOR ALL JOISTS AND BUILT-UP WOOD MEMBERS INTERSECTING WITH FLUSH BUILT-UP WOOD MEMBERS, STRUCT. SECTIONS SHALL CONFORM TO CAN/CSA-H40-21 GRADE 350W CLASS 4A.
2) REINFORCING STEEL SHALL CONFORM TO CSA-G30-18M GRADE 400R.
- 2.11. STUD WALL REINFORCEMENT**
1) FOR STUD WALL REINFORCEMENT, PROVIDE APPROVED ARMOURED BARRELS AS PER MANUFACTURER'S SPECIFICATIONS, ON 7/16" SECTION 1.1, INSULATION APPROVED ON STUDS CONFORMING TO O.B.C. [3.23.10.1.4] EXTERIOR TYPE BIG3 INSULATION JOINTS (UNITED).
2) STUDS MECHANICALLY FASTENED AS PER MANUFACTURER'S SPECIFICATIONS, ON 7/16" SECTION 1.1, INSULATION APPROVED ON STUDS CONFORMING TO O.B.C. [3.23.10.1.4] EXTERIOR TYPE BIG3 INSULATION JOINTS (UNITED).
3) STUDS STACKED VERTICALLY AT INTERIOR FACE OF WALL.
4) REINFORCING AT BASEMENT WINDOWS 2-15MM HORIZONTAL REINFORCEMENT ON THE INSIDE AND OUTSIDE FACE OF THE FOUNDATION WALL, BECAUSE THE WIN. SILL EXTEND BARS ARE 5/16" BEYOND THE OPENING, 2-15MM VERTICAL REINFORCEMENT ON EACH SIDE OF THE WINDOW OPENING.
- BARS TO HAVE MIN. 1" (25) CONC. COVER
- BARS EXTEND 2-15" (60) BEYOND BOTH SIDES OF OPENING
- 2.12. STUCCO WALL @ GARAGE CONST.** [3.24.10] (REFER TO DETAILS)
- 2.13. STUD WALL REINFORCEMENT IN MAIN BATHROOM CONFORMING TO O.B.C. [3.24.10])** (REFER TO DETAILS)
- 2.14. WINDOW/WELLS**
WHERE A WINDOW OPENS INTO A WINDOW WELL, A CLEARANCE OF NOT LESS THAN 21 SAY (585) SHALL BE PROVIDED IN FRONT OF THE WINDOW, EVERY WINDOW WELL SHALL BE DRAINED TO THE FOOTING TIE GW X FILTER CLOTH WRAP AND FILLED WITH CRUSHED STONE. [3.9.10.1.3], [3.14.6.3]
- 2.15. SLOPED CEILING CONSTRUCTION** [1.58-12], [3.1.1.4], [3.23.4.2]
21'11" (65255) ROOF JOISTS @ 16" (400) O.C. MAX. (UNLESS OTHERWISE NOTED) IN 2'2" (348) PURLS @ 16" (400) O.C. DEPENDANT TO ROOF JOIST (PURLS NOT REG. WI SPRAY FOAM). W/ INSULATION BETWEEN ROOF PURLS ANGLED TOWARDS SCUPPER @ 25° VAWIN LAD PERPENDICULAR TO PURLS. BUILT UP CURB TO BE 4" (100) MM. ABOVE FINISHED BALCONY FLOOR CONTINUOUS LTRIN DRIP EDGE TO BE PROVIDED ON OUTSIDE FACE OF CURB. SCUPPER DRAIN TO BE LOCATED 24" (600) MM AWAY FROM HOUSE. SEE SECTION 2.0 GENERAL NOTES, 2.1. WINDOWS [2.3.2.3]. REMOVE CURB WHERE REG.
- 2.16. BALCONY CONDITION**
SEE FLAT ROOF/BALCONY CONSTRUCTION NOTE, INCLUDE 2'4" (360) SPR. #2, 4" (100) MM. GAPS LAD FLAT PARALLEL TO JOISTS ON 2'4" (360) DECKING W/ 1/4" (6.4) GAPS LAD FLAT PARALLEL TO JOISTS PT. SLEEPERS @ 12" (300) O.C. LAD FLAT PERPENDICULAR TO JOISTS BALCONY OVER HEATED SPACE CONDITION SEE FLAT ROOF/BALCONY CONSTRUCTION NOTE FOR ASSIBLY. REFER TO PLANS FOR RE/COR JOIST SIZE & REFER TO HX NOTE 3 FOR INSULATION AND INTERIOR FIN. (REFER TO DETAILS)
- 2.17. BARRREL VULT CONSTRUCTION**
CANTILEVERED 25" (635) SPRICES LAD FLAT ON 2X10" (360x235) SPR. #2, JOIST NAIL TO LAD FLAT PARALLEL TO JOISTS ON 2'4" (360) PLWOOD HEADER PROVIDED FOR BALCONY. SPRAY FOAM INSULATION PROVIDED FOR EXTERIOR CONSTRUCTION NOTE, SEE SECTION 2.0 GENERAL NOTES, 2.1. WINDOWS [2.3.2.3].
- 2.18. EGRESS / WINDOW ABOVE GRADE** [3.9.10.1], [3.4.8.1.6]
EVERY FLOOR WITH A BEDROOM, EXCEPT WHERE A DOOR IS PROVIDED W/ DIRECT ACCESS TO THE EXTERIOR, SHALL HAVE A MINIMUM OF ONE WINDOW WITH A MIN. SILL HEIGHT OF 3'0" (915) TO A MAX. 3'4" (1020) FROM FINISHED FLOOR. THIS WINDOW SHALL HAVE AN UNSTRUCTURED OPEN PORTION OF 3.77 SQ. FT. (W/ 55%2) WITH NO DIMENSION LESS THAN 15" (380) AND BE FREE OF ANY LIMITING HARDWARE AND USED AS MEANS OF EGRESS. SEE SECTION 2.0 GENERAL NOTES, 2.1. WINDOWS

SECTION 3.0. LEGEND

3.1. WOOD LINTELS AND BUILT-UP WOOD

FORMING PART OF SECTION: [3.23.4.2], [3.23.4.2.1], [3.23.12.3.1], [3.23.1.1], [3.23.1.1.1]

3.2. STEEL LINTELS SUPPORTING MASONRY VENEER

(DIVISION B PART 9, TABLE 9.20.5.2-B)
FORMING PART OF SECTION: 9.20.5.2.2 & 9.20.5.2.3

3.3. DOOR SCHEDULE

CODE SIZE

3.4. ACRONYMS

ABV / ABOVE

3.5. SYMBOLS

ALL ELECTRICAL FACILITIES SHALL BE INSTALLED IN ACCORDANCE WITH SECTION 9.3.4.

3.6. CONSTRUCTION NOTES

CLASS B VENT

3.7. CEILING HEIGHTS

DUPLEX OUTLET [12' HIGH]

3.8. ROOF OVERHANGS

HEAVY DUTY OUTLET

3.9. FLASHING

POT LIGHT

3.10. CEILING HEIGHTS

LIGHT FIXTURE (CEILING MOUNTED)

3.11. CEILING HEIGHTS

GT GIRDERS TRUSS

3.12. CEILING HEIGHTS

GT GIRDERS TRUSS BY SOOF MANUFACTURER

3.13. CEILING HEIGHTS

HOSE BB

3.14. CEILING HEIGHTS

WEATHER PROOF

3.15. CEILING HEIGHTS

WHR RETURN VENTILATION UNIT

3.16. CEILING HEIGHTS

HWT HOT WATER TANK

3.17. CEILING HEIGHTS

JST JOIST

3.18. CEILING HEIGHTS

LIN CLOSET

3.19. CEILING HEIGHTS

LVL LAMINATED VENEER LUMBER

3.20. CEILING HEIGHTS

OPEN TO BELOW ABOVE

3.21. CEILING HEIGHTS

PILOT POLE LOAD

3.22. CEILING HEIGHTS

PLT PLATE

3.23. CEILING HEIGHTS

PTT PRESSURE TREATED

3.24. CEILING HEIGHTS

PTD PAINTED

3.25. CEILING HEIGHTS

PWD POWDER ROOM

3.26. CEILING HEIGHTS

RNL RAIN WATER LEADER

3.27. CEILING HEIGHTS

SB SOLID BEARING WOOD POST

3.28. CEILING HEIGHTS

SPR SPRUCE

3.29. CEILING HEIGHTS

STL STEEL

3.30. CEILING HEIGHTS

TOD TOP OF

3.31. CEILING HEIGHTS

TOP TOP OF

3.32. CEILING HEIGHTS

WHT WHIT

3.33. CEILING HEIGHTS

WHT WHIT



3.54. CEILING HEIGHTS




BAYVIEW HEIGHTS RICHMOND HILL



30x16

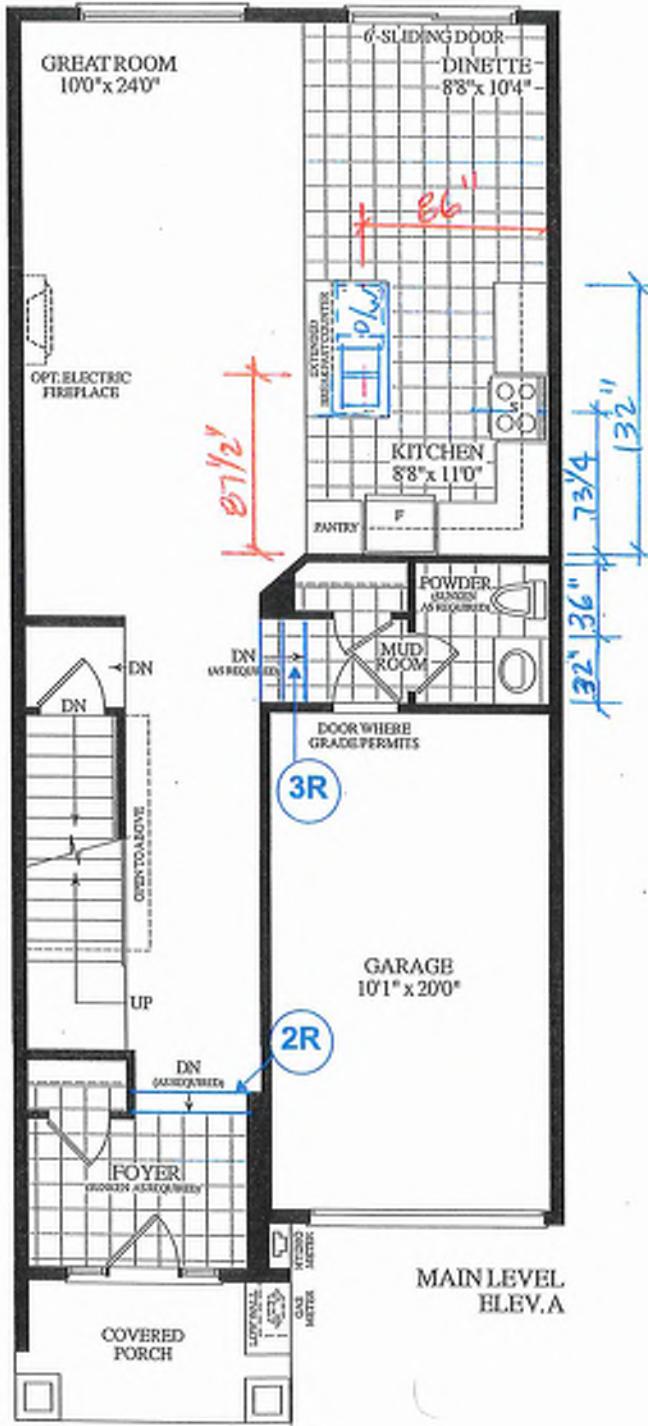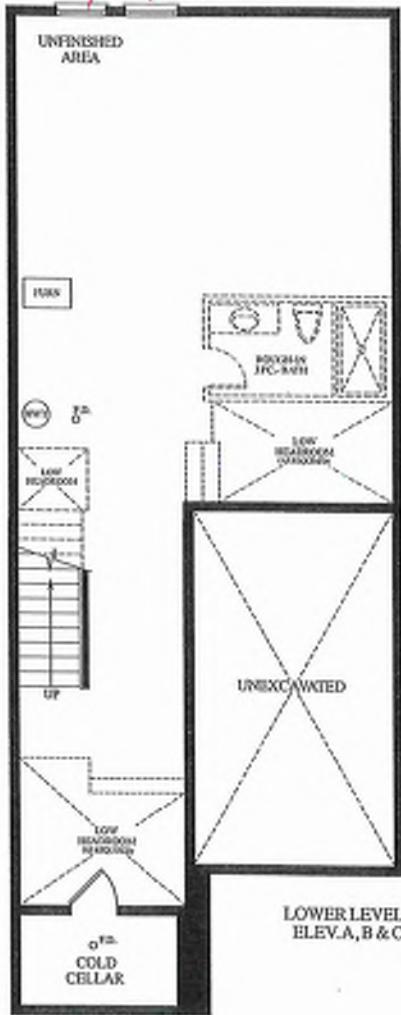

Materials, specifications and floor plans are subject to change without notice. All renderings are artist's concept. All floor plans are approximate dimensions. Actual usable floor space may vary from the stated floor area. E&OE.

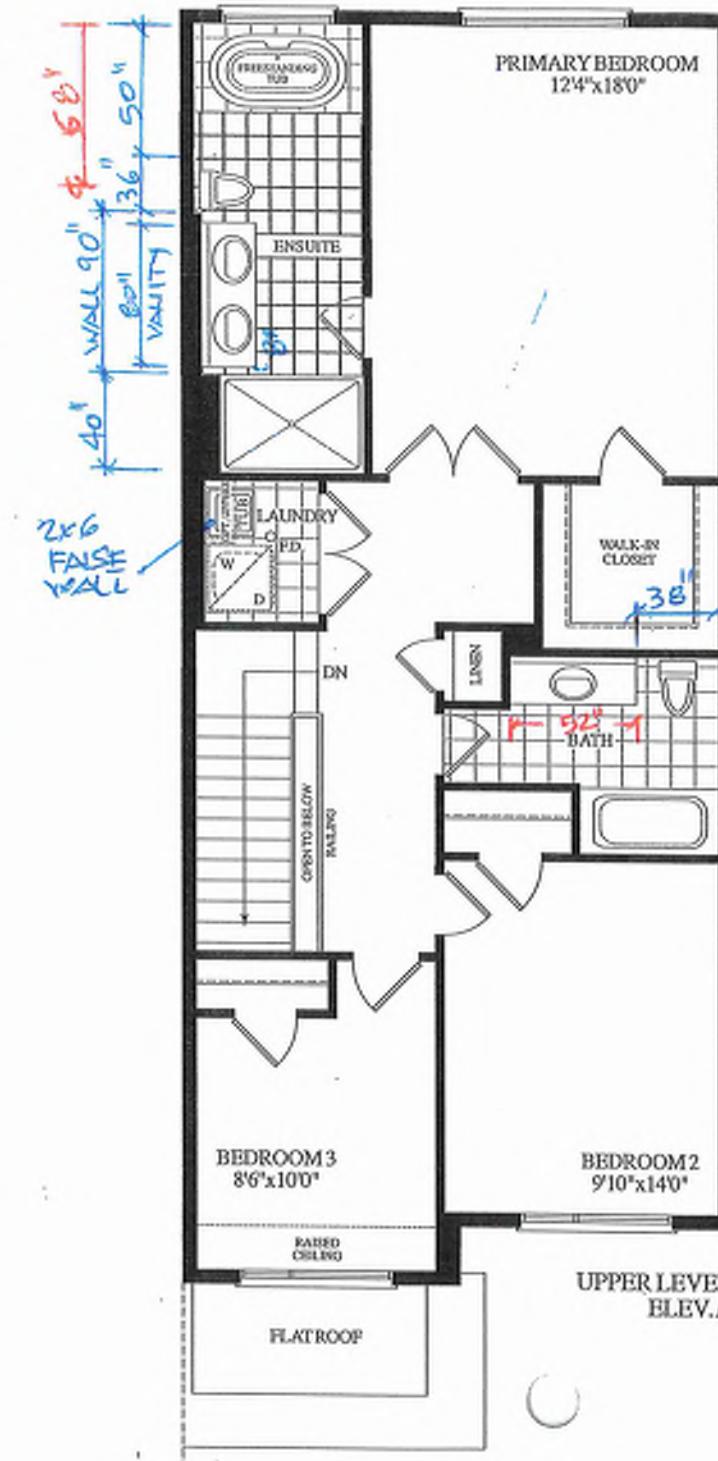

B1 K 19 TH 125


20-17 THE DIANA EI A

3 BDRM 2 BATH

1795 SO ET

GROUND TO SECOND
122" HT 11-7/8" JOIST

BASEMENT TO GROUND
BSMT 11-7/8" JOIST

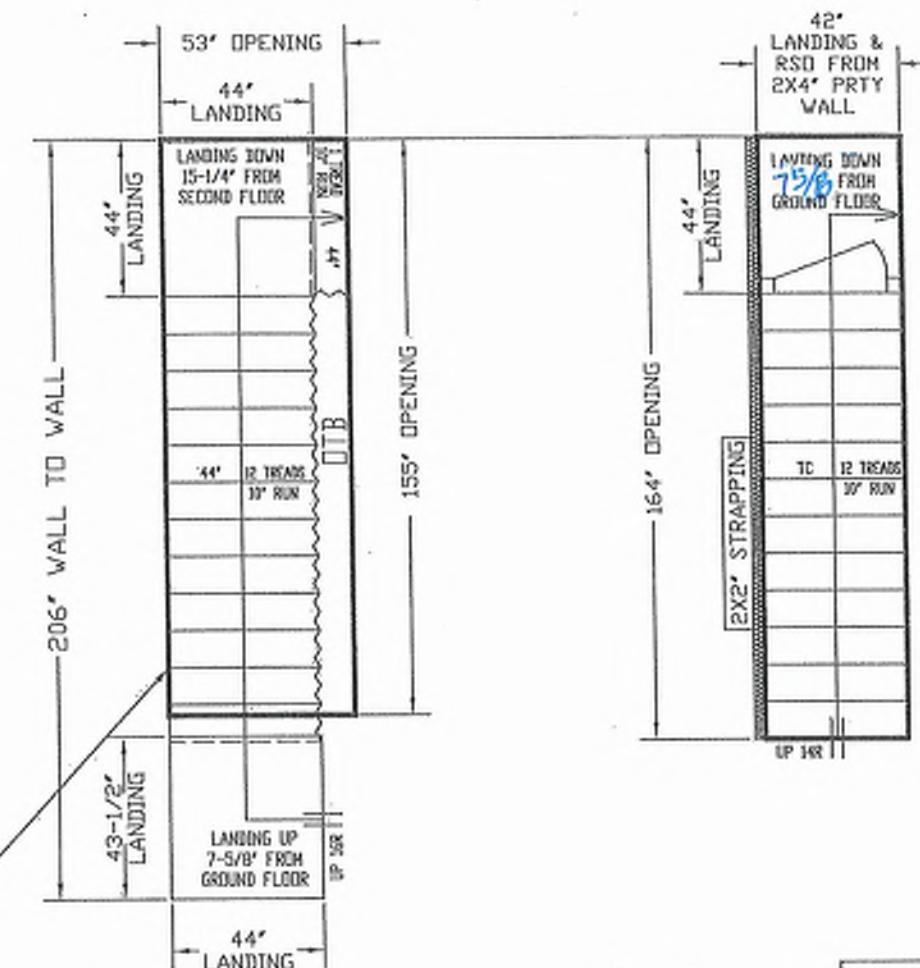

REVISED
JUNE 4, 2025

GARAGE RIGHT >

ALL OPENINGS ARE ALLOWED FOR 1 LAYER OF DRY WALL
ANY ADDITIONAL LAYERS MUST BE ALLOWED BY CARPENTERS

STAIRS LINE UP BY
PARTY WALL



ALL LANDINGS TO BE SUPPLIED AND SUPPORTED BY OTHERS UNLESS SPECIFIED ABOVE
AND STRAPPING ALLOWANCES TO BE COMPUTED BY CARPENTERS.
ALL STAIR DIMENSIONS MAY BE MINDED FROM ORIGINAL BLUE PRINTS OR ESTIMS AS SUPPLIED
TO ALPHA STAIRS AND RAILINGS INC. NO RESPONSIBILITY SHOWN FOR CHANGES MADE TO
INSTALL OUR STAIRS. NOT PROPER USE OF STAIRS CAN CAUSE STAIRS TO FAIL AND CAUSE INJURIES. ALPHA
STAIRS AND RAILINGS INC. WILL NOT BE HELD LIABLE IF STAIRS FAIL. STAIRS SHOULD BE CHECKED BY
CARPENTERS OR SITE SUPER TO MAKE SURE THERE ARE NO DISCRENCIES BEFORE PROCEEDING
WITH CONSTRUCTION.


ALPHA STAIRS AND RAILINGS INC.
3770 NASHUA DRIVE, UNIT 3 MISSISSAUGA, ONTARIO L4V 2M5
TEL: 4930 694-5356 | www.alpastairs.com

SITE	BAYVIEW HEIGHTS	DRAWN BY	SMC	DATE
LOT #		PROJECT	MAY 23, 2025	
Model	ROYAL PINE HOMES	CLIENT		
		LAYOUT #		
	UNIT 2017	SCALE	105'	

Buk 19- 125

Preliminary
NOT FINAL April 22 2025

NOT FINAL April 22 2025

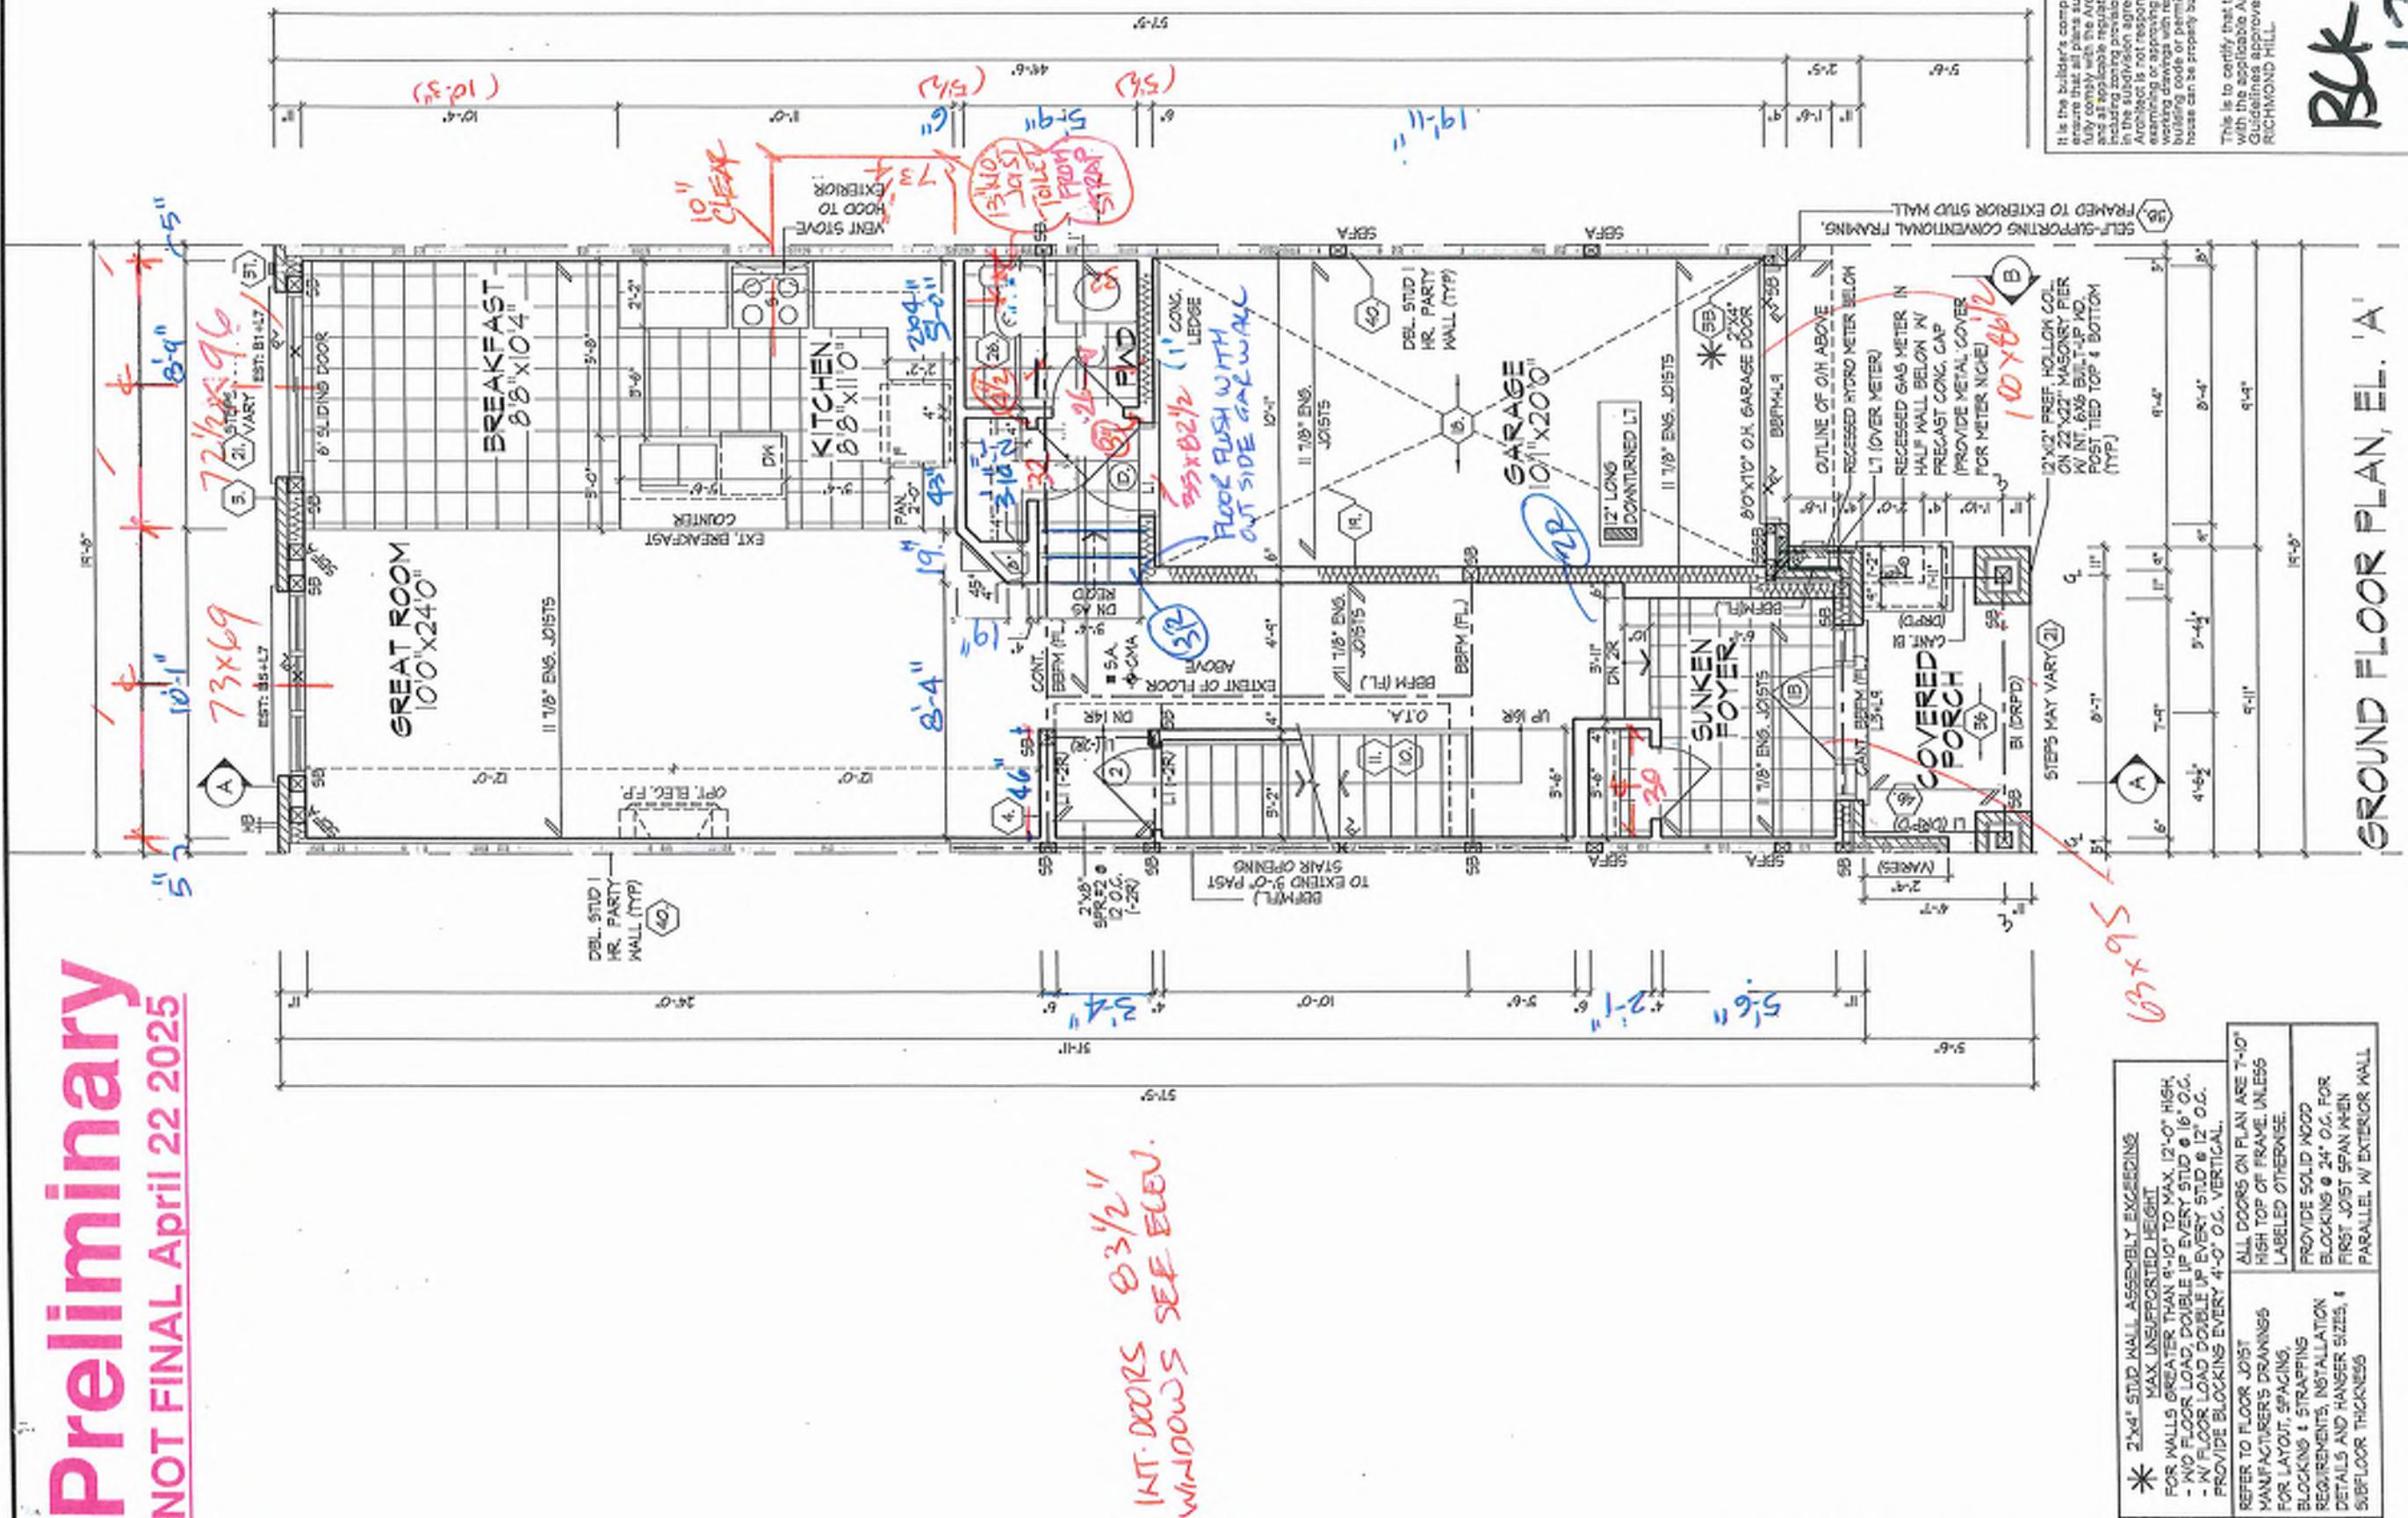

INT. DOORS 83 1/2'
WINDOWS SEE ELEV.

 <p>2x4" STUD WALL ASSEMBLY EXCEEDING MAX UNSUPPRTED HEIGHT</p> <p>FOR WALLS GREATER THAN 8'-0" TO MAX. 12'-0" HIGH</p> <ul style="list-style-type: none"> - NO FLOOR LOAD DOUBLE UP EVERY STUD @ 16" O.C. - NO FLOOR LOAD DOUBLE UP EVERY STUD @ 12" O.C. PROVIDE BLOCKING EVERY 4'-0" O.C. VERTICAL. 	<p>ALL DOORS ON PLAN ARE 7'-0" HIGH TOP OF FRAME, UNLESS LABLED OTHERWISE.</p>
<p>REFER TO FLOOR JOIST MANUFACTURERS DRAWINGS FOR LAYOUT, SPACING, BLOCKINGS & STRAPPINGS</p>	<p>PROVIDE SOLID NODCO BLOCKINGS @ 24" O.C. FOR FIRST JOIST SPAN WHEN PARALLEL W/ EXTERIOR WALL</p>

This is to certify that these plans comply with the applicable Architectural Design Guidelines approved by the City of RICHMOND Hill.

GROUND FLOOR PLAN, EL. A


ROYAL PINE HOMES - 218094
921 BAYVIEW, RICHMOND HILL, ON.

HUNT
DESIGN ASSOCIATES INC.

BCN number and original signature.

Preliminary
NOT FINAL April 22 2025

NOT FINAL - April 22, 2025

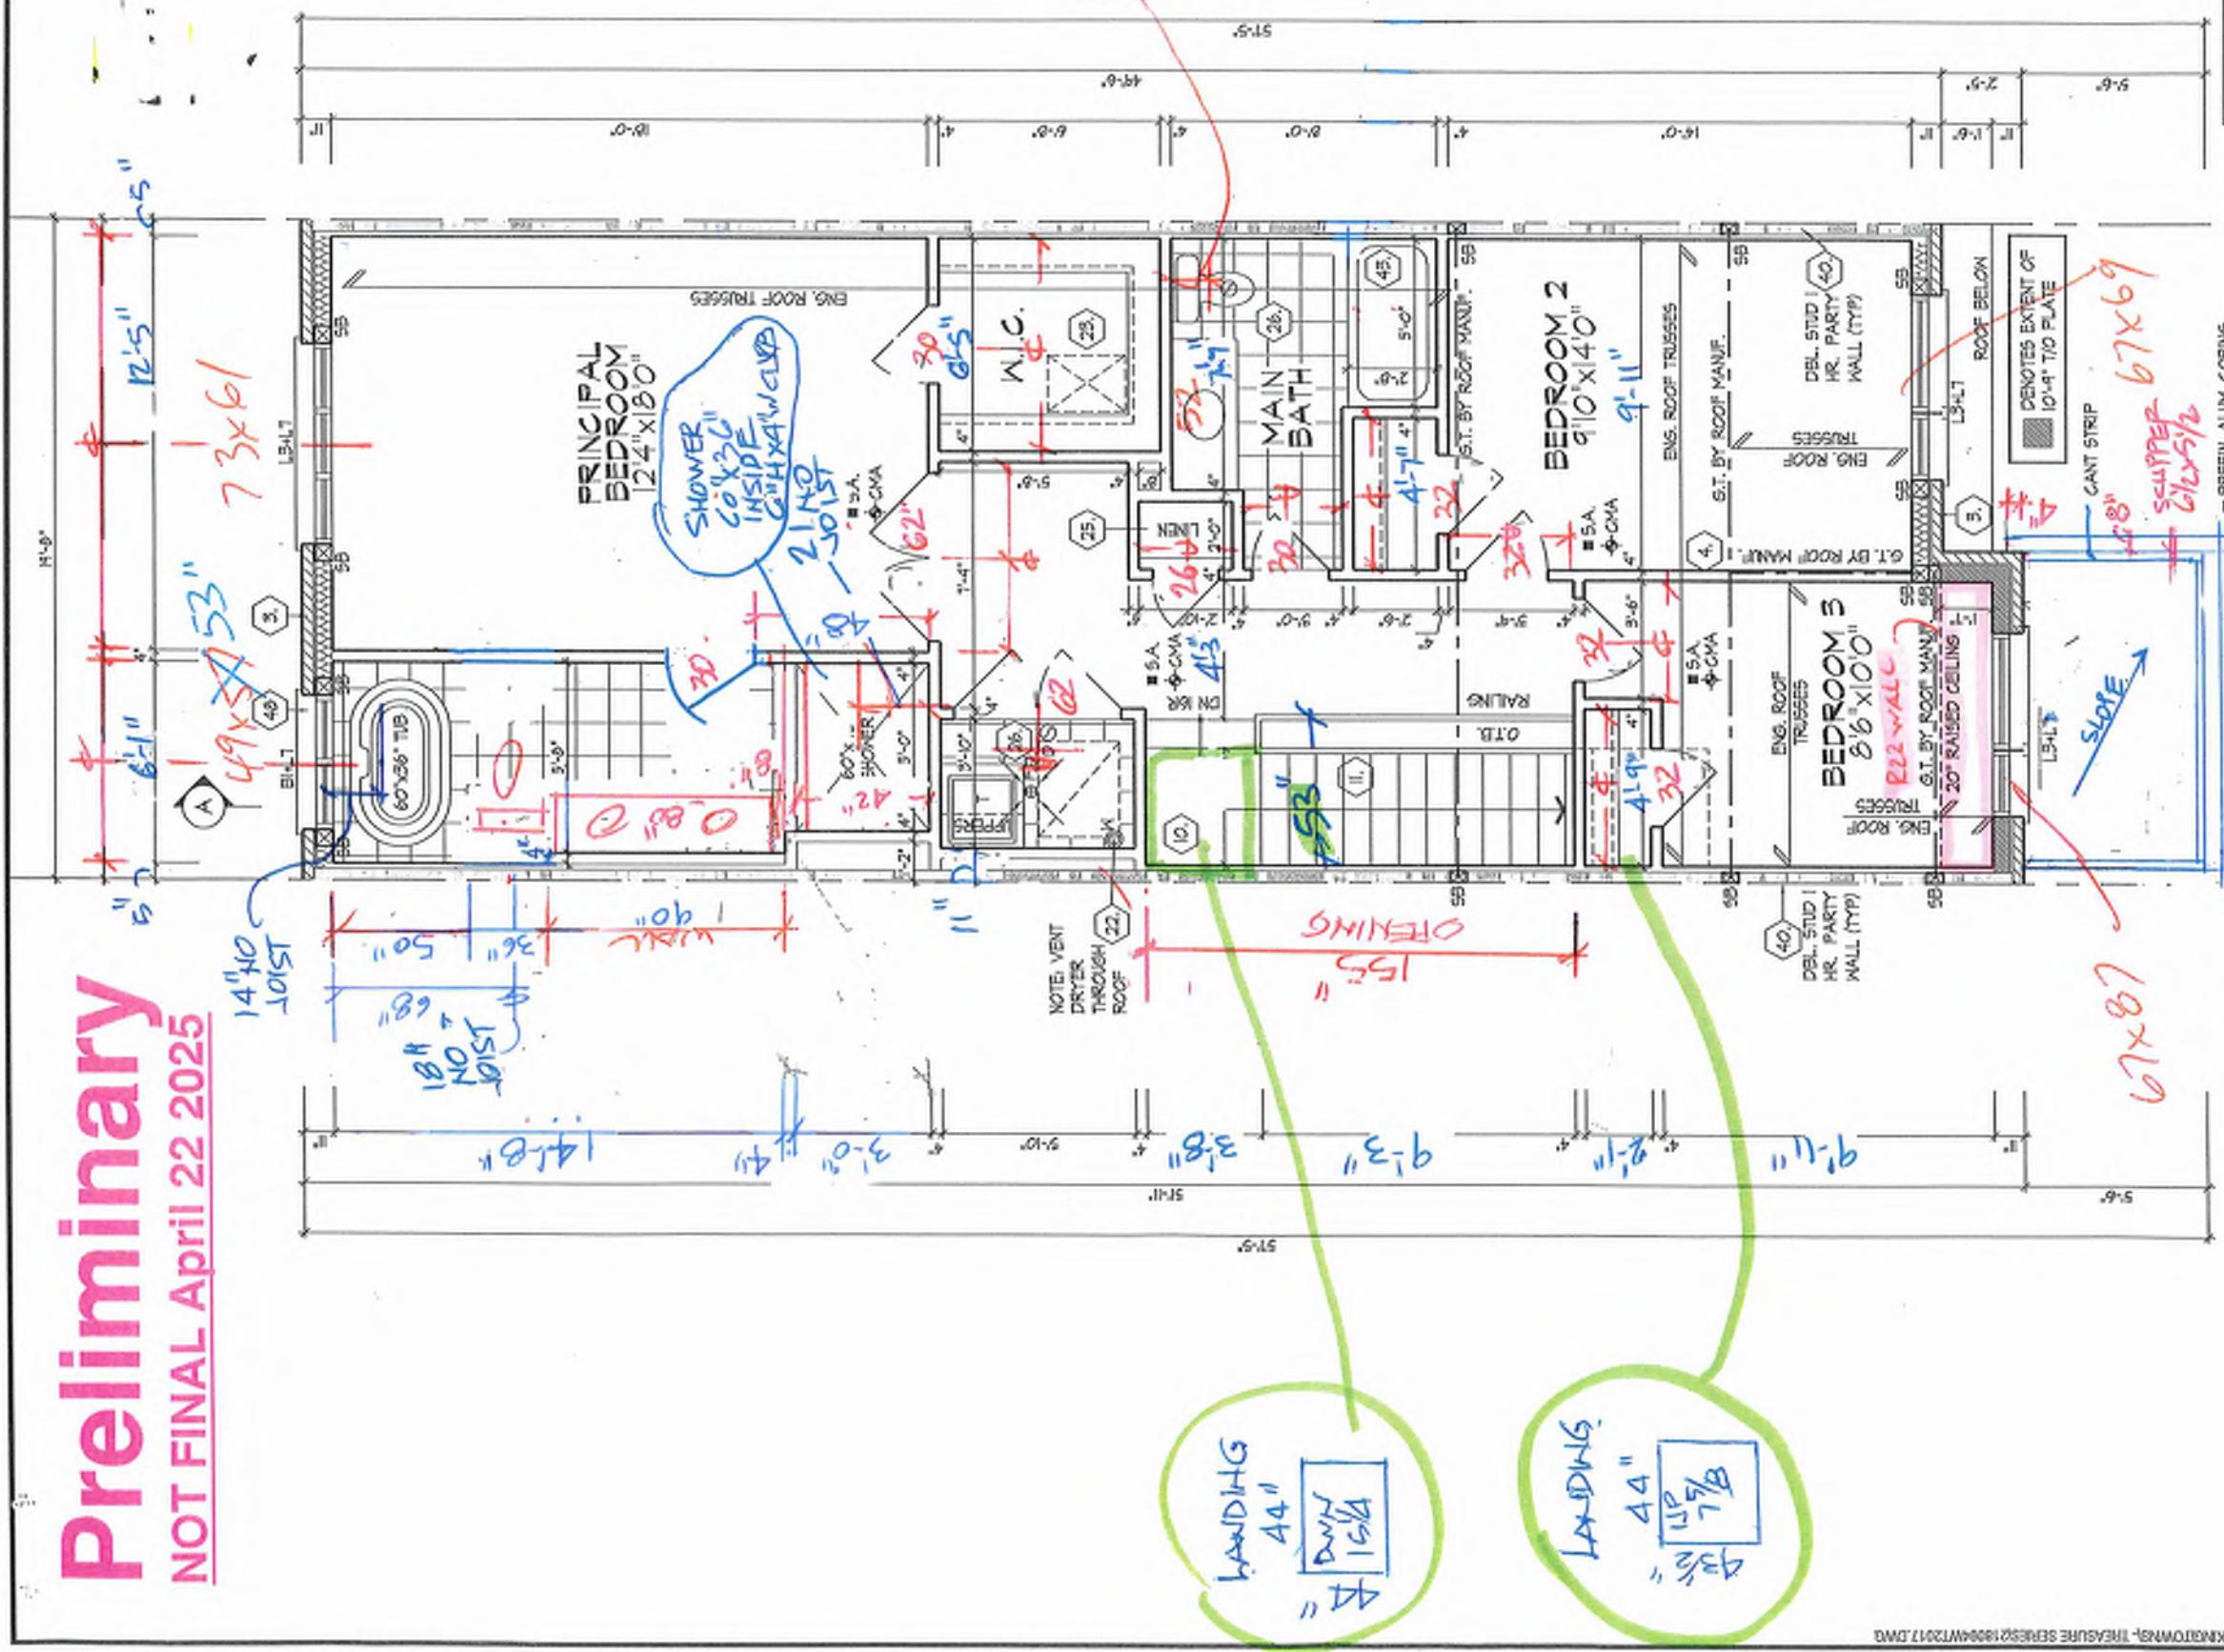

This is to certify that these plans comply with the applicable Architectural Design Guidelines approved by the City of RICHMOND HILL.

104

10

三

一一

四

三

הנִזְקָנָה וְהַנִּזְקָנָה

SECOND FLOOR PLAN, EL. A

UNIT 201

REV.2025.03.2

Page Number 4 of 3

BROWNSVILLE

અનુભૂતિક વિશ્વાસ કરીને આપણું જો હોઈ શકું હોય તો એ હોય

Preliminary

NOT FINAL April 22 2025

ROOF PLAN EL. 'A' N.T.S.



ROOF OVERHANGS TO BE 12"
UNLESS NOTED OTHERWISE

NOTE:
WHEN UNIT REVERSED KEEP
FIXED GLASS GARAGE
DOOR PANES LEFT

NOTE:
WHEN UNIT REVERSED KEEP
SIDE 24'x68" WINDOW LEFT

6:12

ASPHALT SHINGLES (TYP.)
VALLEY FLASHING (TYP.)

REFER TO FRONT
ELEVATION FOR TYPICAL
NOTES & INFORMATION
ROOF OVERHANGS TO BE 12"
UNLESS NOTED OTHERWISE

6:12

Buk 19
125

OUTLINE OF RAISED
CEILING BEYOND

TOP OF PLATE

TOP OF WINDOW

3.5' PRECAST CONG.
HEADER (TYP.)

3.5' CONT. PRECAST
CONG. SILL (TYP.)

ALUM. CLADDING W/
Drip Edge

FIN. SECOND FLOOR

12'x12" PREF. HOLLOW COL. ON
22"x22" MASONRY PIER W/ INT.
6x6 BUILT-UP ND. POST TIED
TOP & BOTTOM (TYP.)

10" PRECAST

STONE VENEER (TYP.)

FIN. GROUND FLOOR

SUNK. FOYER

FIN. GRADE

POURED CONG. DOOR SILL
& PORCH SLAB (TYP.)

POURED CONG. FOUNDATION
WALLS & FOOTINGS (TYP.)

TOP OF BASEMENT SLAB

FRONT ELEVATION 'A'

67x87

67x69

F0

100

100


100

100
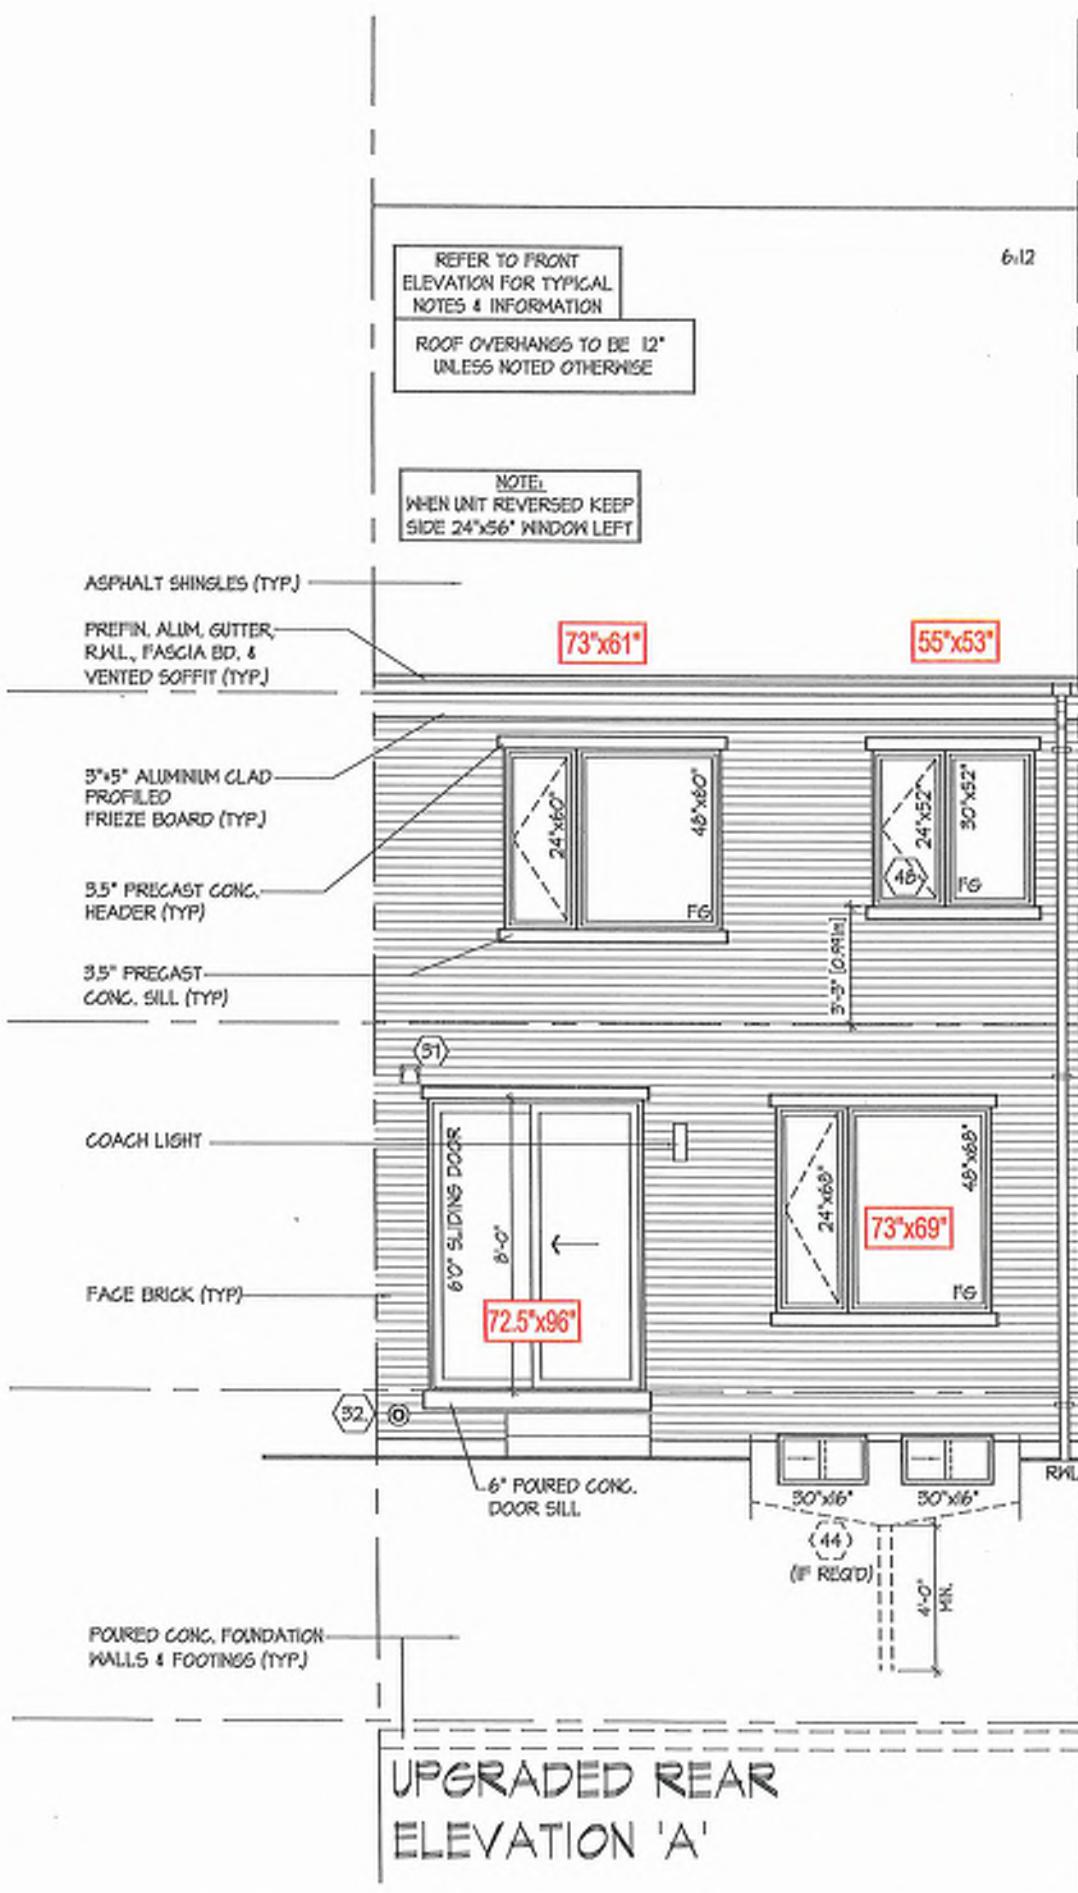

**UPGRADED REAR
ELEVATION 'A'**

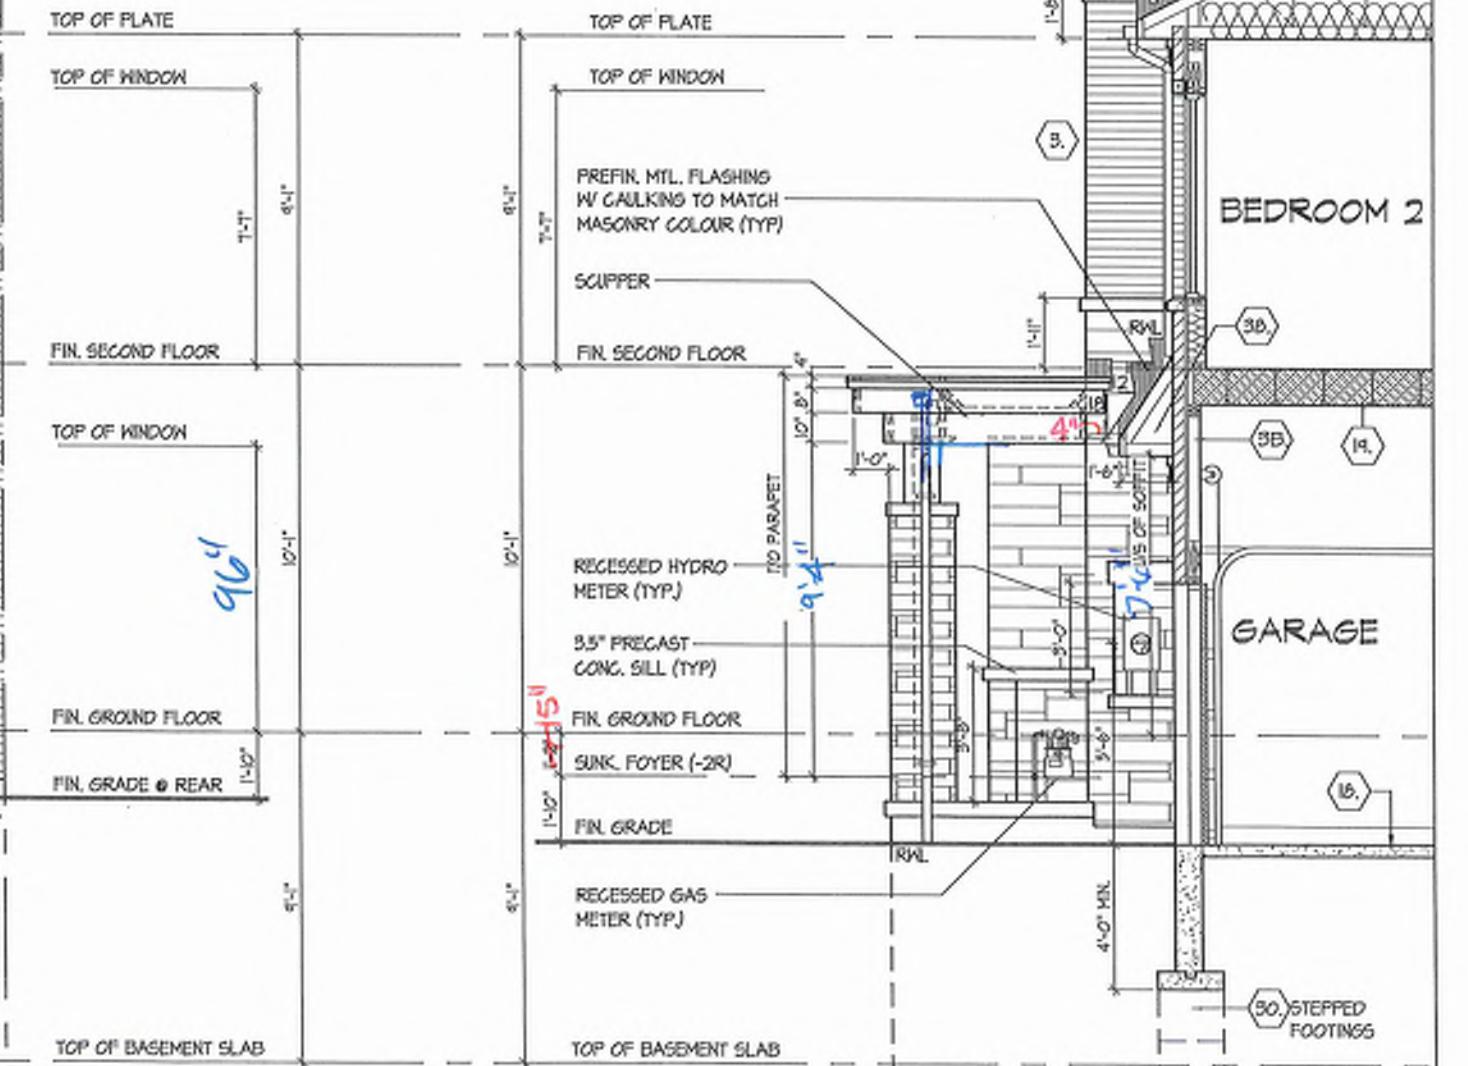

PARTIAL SECTION 'B', EL. 'A'

and fully comply with the Architectural Guidelines and all applicable regulations and requirements including zoning provisions and any provisions in the subdivision agreement. The Control Architect is not responsible in any way for examining or approving site [lotting] plans or working drawings with respect to any zoning or building code or permit matter or that any house can be properly built or located on its lot.

This is to certify that these plans comply with the applicable Architectural Design Guidelines approved by the City of RICHMOND HILL.

ROYAL PINE HOMES - 218094 UNIT 2017

REV.2025.03.26
Page Number:
921 BAYVIEW, RICHMOND HILL, ON.
Entered By: _____
Created By: _____
Status: _____
File Number: _____

15 of 27
F905.737.7328
218084WT2017

© 2003 Houghton Mifflin Company. All rights reserved. Houghton Mifflin Company, the Houghton Mifflin logo, and the Grade 5 logo are trademarks of Houghton Mifflin Company.

THE INVESTIGATOR HAS REVIEWED AND TAKES RESPONSIBILITY FOR THIS
DISCUSSION AND HAS THE QUALIFICATIONS AND MEETS THE REQUIREMENTS SET
OUT IN THE APPLICABLE CLINICAL TRIAL DOCUMENT AS A PROPOSER


GUIDELINES FOR THE USE AND MAINTENANCE OF THE INFORMATION
Dermotix Mobile 212

NAME: **WILLIAM DEESEN ASSOCIATES INC.**
REGISTRATION INFORMATION
SIGNATURE

All drawings, specifications, related documents and station are the property of the State of Florida.

Preliminary
NOT FINAL April 22 2025

NOT FINAL April 22 2025

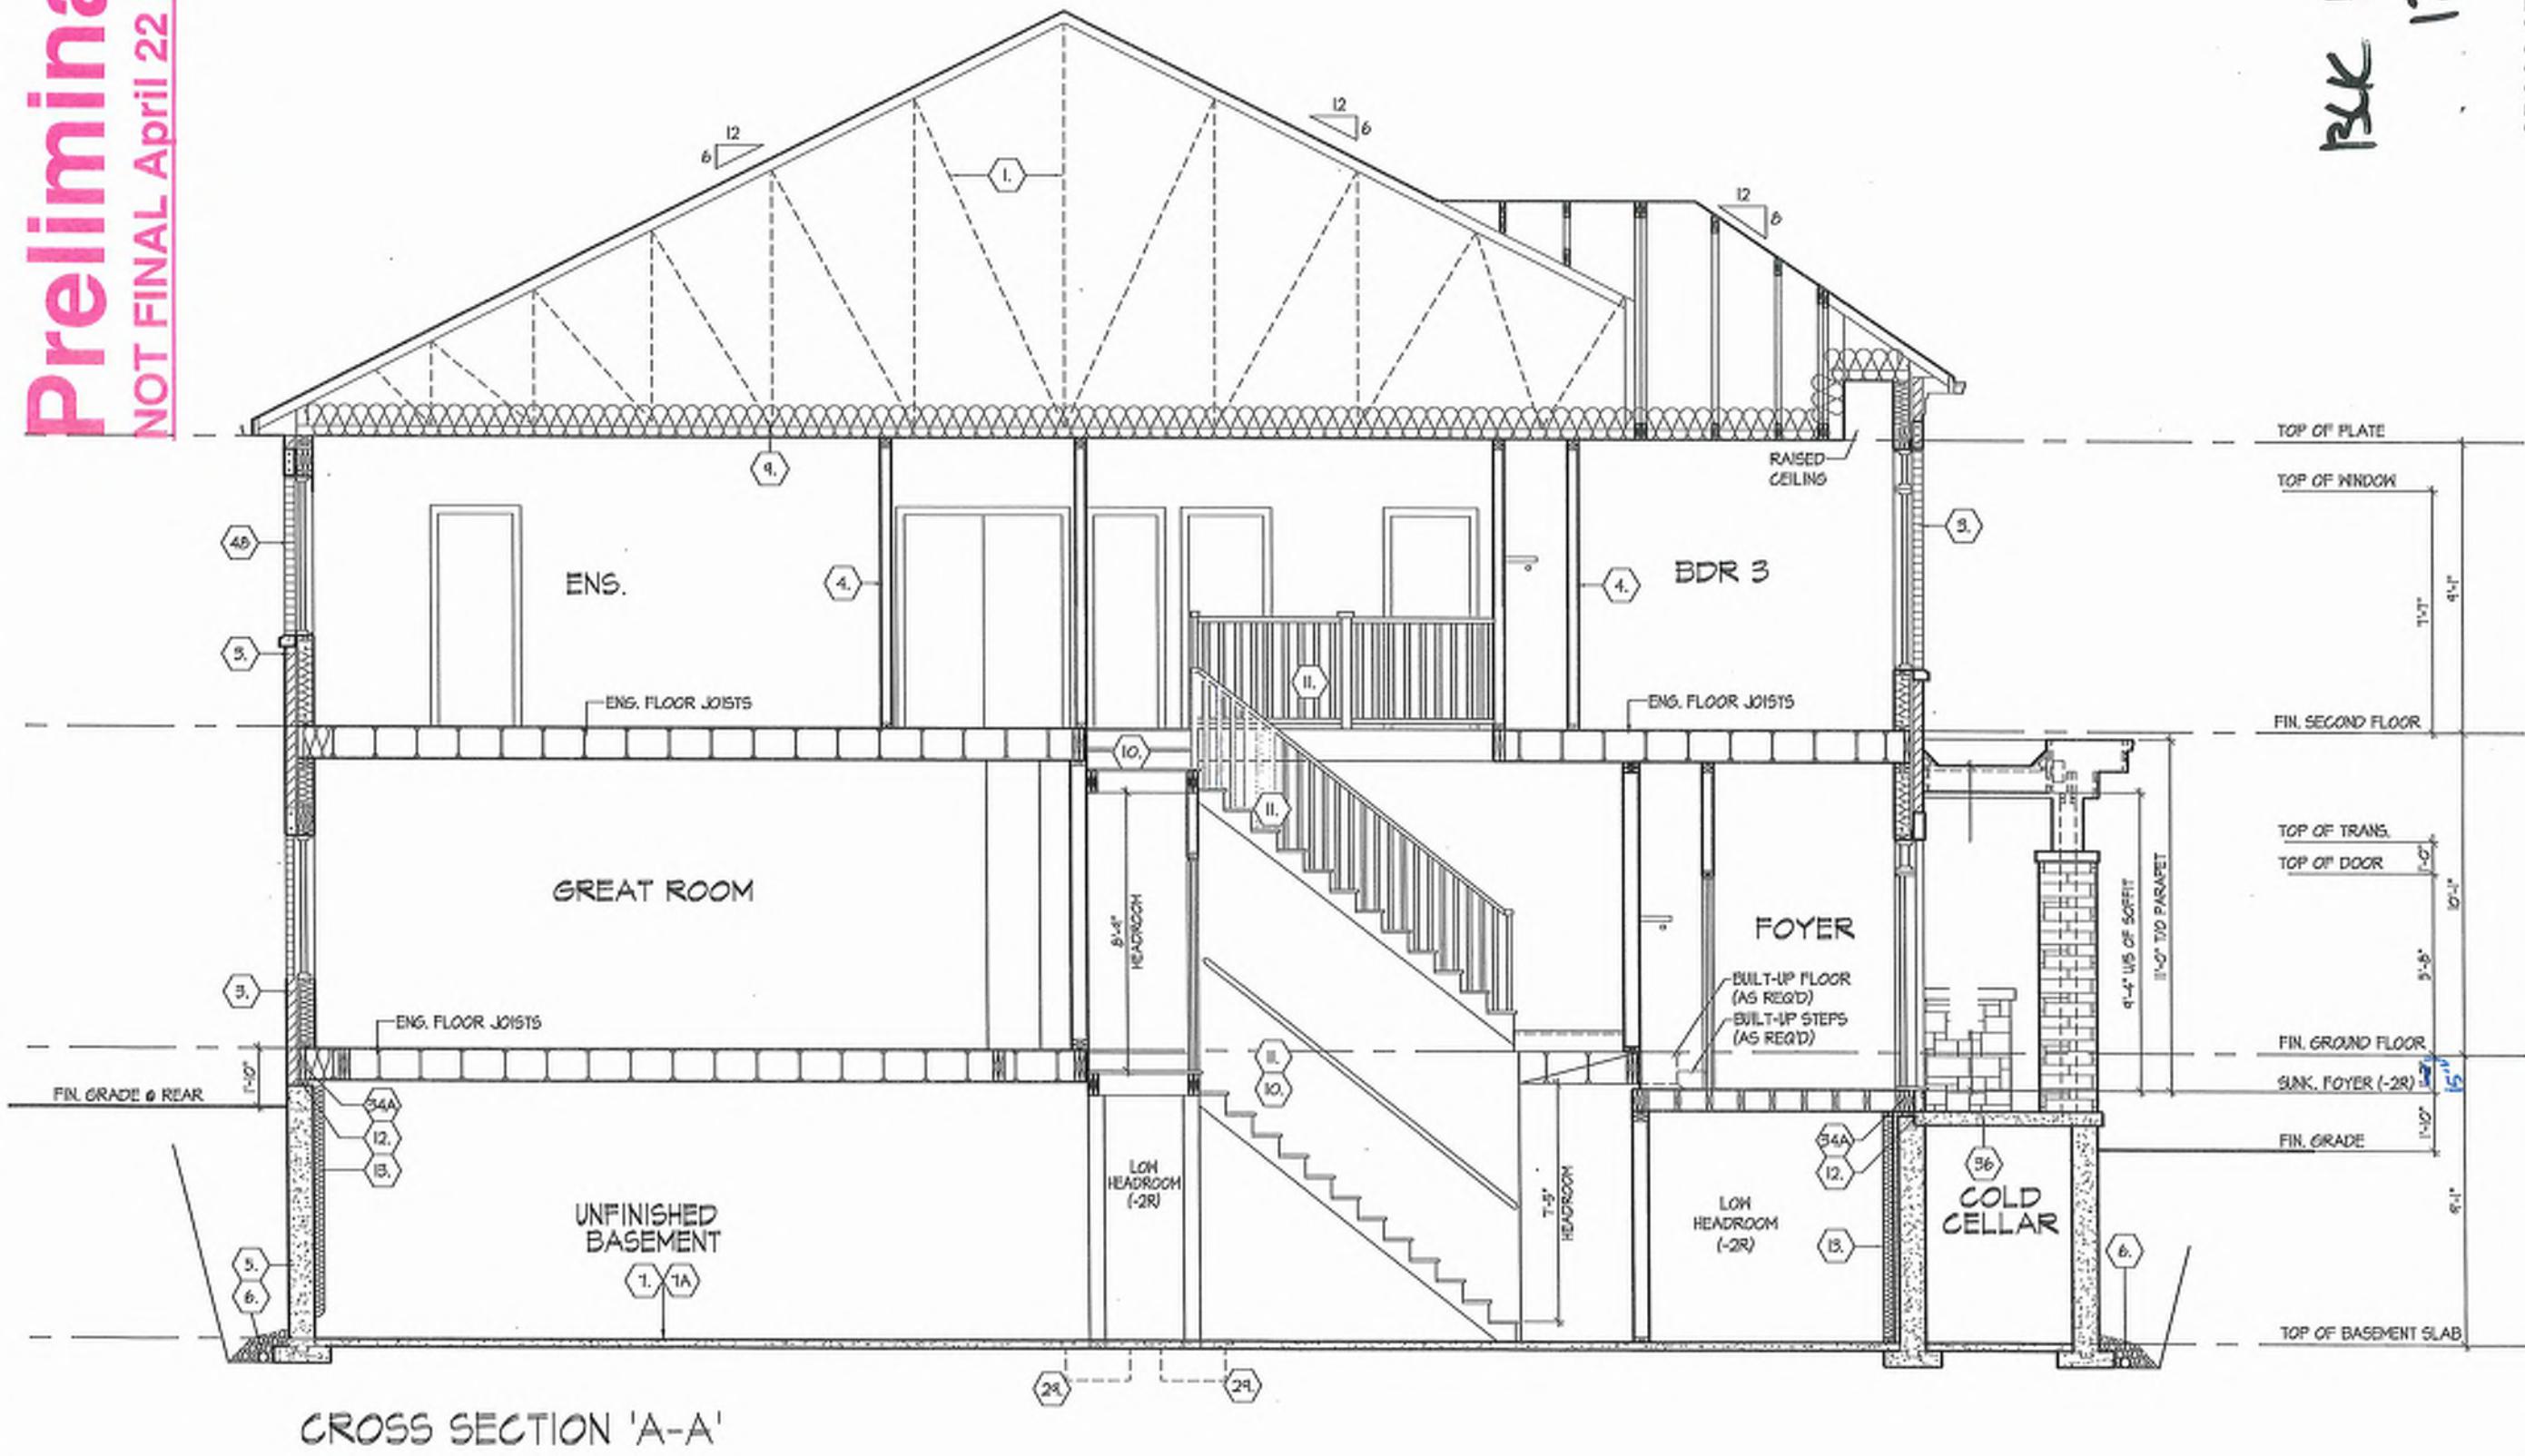

THE LANDOWNER HAS PROVIDED AND TAKES RESPONSIBILITY FOR THE DESIGN AND HAS THE DUE-PROTECTION AND MEETS THE REQUIREMENTS SET OUT IN THIS BUILDING CODE TO BE A DESIGNER.	
LANDOWNER INFORMATION	
Dominic Modilo	21074 SBN
DESIGNATION INFORMATION	
HUNT DESIGN ASSOCIATES INC.	55655
HUNT DESIGN ASSOCIATES INC.	
www.huntdesign.ca	
All drawings, specifications, related documents and designs are the copyright property of Hunt Design Associates Inc. Reproduction of this property in whole or in part is strictly prohibited without HDA's written permission HDA assumes no responsibility or liability for this property unless it bears the appropriate BOM number and original signature.)	

SECTION 1.0. CONSTRUCTION NOTES

REFER TO SB-12 ENERGY EFFICIENCY DESIGN MATRIX ON THE TITLE PAGE FOR ALL VALUES AS REQUIRED PER 3.1, 3.1.2, 3.1.3, OF THE O.B.C.

ROOF CONSTRUCTION [9.19, 9.23.14, 9.23.16]

- 1** NO. 210 (10.25 KG/M²) ASPHALT SHINGLES, 38'-9.5" PLYWOOD SHEATHING WITH #4 COATS APPROVED WOOD SHEATHING @ 24"-600" O.C. MAX APPROVED EAVES PROTECTION TO EXTERIOR PLATE, 100% D.R. PROOF OF DROOF AND MAN. 12'-300" BEYOND INNER FACE OF EXTERIOR WALL, 2X5 3/8" TRUSS BEAVERSTOOGH @ 610° (1830) C.O. AT BOTTOM CHORD, PREFAB ALUM. INSULATED CEILING AREA WITH MIN 25% OF REQUIRED OPENINGS LOCATED AT TOP OF SPACE & MIN 25% OF REQUIRED OPENINGS LOCATED AT BOTTOM OF SPACE EAST THOUGH TO BE 4' MIN. WITH R/WL DISCHARGING ONTO CONCRETE SPLASH PADS OR PER MUNICIPAL REQUIREMENTS. TOWNHOUSES TO HAVE 55" MIN. EAVESTROUGH WITH ELECTRICAL HEATER CABLE ALONG EAVESTROUGH AND DOWN R/WL.

ICE AND WATER SHIELD

- 1A** PROVIDE ICE AND WATER SHIELD IN THE AREAS INDICATED. THE ICE AND WATER SHEILD SHALL BE A SELF ADHERING AND SELF SEALING MEMBRANE. SIDE LAP MUST BE MINIMUM 3.12" (90) AND END LAP A MINIMUM 6" (150), AND TO EXPED UP DORMER WALLS A MINIMUM 12" (305).

PROFILED ROOF TRUSSES

- 1B** ROOF TRUSSES SHALL BE PROFILED AND/OR STEPPED AT RAISED COFFER/TAY CER. LGS. ANGLED TRAY CEILINGS WILL BE SHEATHED W/ 38'-9.5" PLYWOOD. SIDING MATERIAL AS PER ELEVATION ATTACHED TO FRAMING MEMBERS, FURRING MEMBERS OR BLOCKING BETWEEN THE FRAMING MEMBERS ON STUDS CONFORMING TO O.B.C. 9.23.10.1 & SECTION 1.1. INSULATION APPROVED 6 MIL POLYETHYLENE VAPOUR BARRIER ON 1/2" (12.7) GYPSUM WALLBOARD FOR THE ATTACHMENT OF SIDING @ 23.17.11.1 (REFER TO 35 NOTE AS REQ.)

SIDING WALL CONSTRUCTION (2x6) @ GARAGE CONSTRUCTION

- 2A** SIDING MATERIAL AS PER ELEVATION ATTACHED TO FURRING MEMBERS ON STUDS CONFORMING TO O.B.C. [9.23.10.1] & SECTION 1.1. INSULATION AND FIBER BOARD SHALL NOT BE USED FOR THE ATTACHMENT OF SIDING @ 23.17.8(1) (REFER TO 35 NOTE AS REQ.)

SIDING WALL CONSTRUCTION (2x6) @ BRICK VENEER WALL

- 3A** SIDING MATERIAL AS PER ELEVATION ATTACHED TO FRAMING MEMBERS, FURRING MEMBERS OR BLOCKING BETWEEN THE FRAMING MEMBERS ON STUDS CONFORMING TO O.B.C. 9.23.10.1 & SECTION 1.1. INSULATION APPROVED 6 MIL POLYETHYLENE VAPOUR BARRIER ON 1/2" (12.7) GYPSUM WALLBOARD BEHIND RIGID INSULATION, AND FIBERBOARD SHALL NOT BE USED FOR THE ATTACHMENT OF SIDING @ 23.17.8(1) (REFER TO 35 NOTE AS REQ.)

INTERIOR STUD PARTITIONS [9.23, 9.23.9.8, 9.23.10.1 & 9.23.17.8(1)]

- 4** BEARING PARTITIONS SHALL BE A MINIMUM 2" (50.80) @ 15'-400" O.C. FOR 2 STOREY & 1" (25) O.C. FOR 3 STOREY. NON-BEARING ARTHITIS @ 38'-680" @ 24"-600" O.C. PROVIDE 2X4" (50.80) BOTTOM PLATE AND 2X4" (50.80) TOP PLATE, 12'-11.2" IN. DRYWALL, BOTH SIDES OF STUDS PROVIDED. 2X6" (610) SHEATHING STUDS CONFORMING TO O.B.C. 9.23.10.1 & SECTION 1.1. INSULATION AND 6 MIL POLYETHYLENE VAPOUR BARRIER @ 24"-600" OLD LADDER TRAVERS @ 24"-600" O.C. (2X 24"-13.6") AT BOTTOM COURSE AND OVER OPENINGS. PROVIDE BASE FLASHING UP MIN. 6" (150) BEING SHEATHING PAPER @ 20.13.6 (REFER TO 35 NOTE AS REQ.)

EXT.-LOFT WALL CONSTRUCTION (2x6) @ GARAGE CONSTRUCTION

- 5** 3/12"-90" BRICK VENEER, MIN. 1" (25) AIR SPACE, 7/8"-10" (22.2-25.4) GALV. METAL TEES @ 18"-400" O.C. HOLLOW 1/2" (12.7) GYPSUM WALLBOARD INT. FINISH. @ 18"-400" O.C. HOLLOW 24"-600" O.C. VERT. BONDING AND FASTENING FOR TIES TO EXTERIOR SHEATHING PAPER ON 18'-6.5" EXT. SHEATHING ON STUDS CONFORMING TO O.B.C. 9.23.10.1 & SECTION 1.1. INSULATION APPROVED 6 MIL POLYETHYLENE VAPOUR BARRIER ON 1/2" (12.7) GYPSUM WALLBOARD INT. FIN. (GYPSUM SHEATHING, RIGID INSULATION, AND FIBERBOARD SHALL NOT BE USED FOR THE ATTACHMENT OF SIDING @ 23.17.8(1) (REFER TO 35 NOTE AS REQ.)

INTERIOR STUD PARTITIONS [9.23, 9.23.9.8, 9.23.10.1]

- 6** @ 24"-600" O.C. PROVIDE 2X4" (50.80) BOTTOM PLATE AND 2X4" (50.80) TOP PLATE, 12'-11.2" IN. DRYWALL, BOTH SIDES OF STUDS PROVIDED. 2X6" (610) SHEATHING STUDS CONFORMING TO O.B.C. 9.23.10.1 & SECTION 1.1. INSULATION AND 6 MIL POLYETHYLENE VAPOUR BARRIER @ 24"-600" OLD LADDER TRAVERS @ 24"-600" O.C. (2X 24"-13.6") AT BOTTOM COURSE AND OVER OPENINGS. PROVIDE BASE FLASHING UP MIN. 6" (150) BEING SHEATHING PAPER @ 20.13.6 (REFER TO 35 NOTE AS REQ.)

EXT.-LOFT WALL CONSTRUCTION (2x6)

- 7** NO. 210 (10.25 KG/M²) ASPHALT SHINGLES, 38'-9.5" PLYWOOD SHEATHING WITH #4 COATS APPROVED WOOD SHEATHING @ 24"-600" O.C. MAX APPROVED EAVES PROTECTION TO EXTERIOR PLATE, 100% D.R. PROOF OF DROOF AND MAN. 12'-300" BEYOND INNER FACE OF EXTERIOR WALL, 2X5 3/8" TRUSS BEAVERSTOOGH @ 610° (1830) C.O. AT BOTTOM CHORD, PREFAB ALUM. INSULATED CEILING AREA WITH MIN 25% OF REQUIRED OPENINGS LOCATED AT TOP OF SPACE & MIN 25% OF REQUIRED OPENINGS LOCATED AT BOTTOM OF SPACE EAST THOUGH TO BE 4' MIN. WITH R/WL DISCHARGING ONTO CONCRETE SPLASH PADS OR PER MUNICIPAL REQUIREMENTS. TOWNHOUSES TO HAVE 55" MIN. EAVESTROUGH WITH ELECTRICAL HEATER CABLE ALONG EAVESTROUGH AND DOWN R/WL.

ICE AND WATER SHIELD

- 8** PROVIDE ICE AND WATER SHIELD IN THE AREAS INDICATED. THE ICE AND WATER SHEILD SHALL BE A SELF ADHERING AND SELF SEALING MEMBRANE. SIDE LAP MUST BE MINIMUM 3.12" (90) AND END LAP A MINIMUM 6" (150), AND TO EXPED UP DORMER WALLS A MINIMUM 12" (305).

PROFILED ROOF TRUSSES

- 9** ROOF TRUSSES SHALL BE PROFILED AND/OR STEPPED AT RAISED COFFER/TAY CER. LGS. ANGLED TRAY CEILINGS WILL BE SHEATHED W/ 38'-9.5" PLYWOOD. SIDING MATERIAL AS PER ELEVATION ATTACHED TO FRAMING MEMBERS, FURRING MEMBERS OR BLOCKING BETWEEN THE FRAMING MEMBERS ON STUDS CONFORMING TO O.B.C. 9.23.10.1 & SECTION 1.1. INSULATION APPROVED 6 MIL POLYETHYLENE VAPOUR BARRIER ON 1/2" (12.7) GYPSUM WALLBOARD BEHIND RIGID INSULATION, AND FIBERBOARD SHALL NOT BE USED FOR THE ATTACHMENT OF SIDING @ 23.17.8(1) (REFER TO 35 NOTE AS REQ.)

SIDING WALL CONSTRUCTION (2x6) @ BRICK VENEER WALL

- 10** SIDING MATERIAL AS PER ELEVATION ATTACHED TO FRAMING MEMBERS, FURRING MEMBERS OR BLOCKING BETWEEN THE FRAMING MEMBERS ON STUDS CONFORMING TO O.B.C. 9.23.10.1 & SECTION 1.1. INSULATION APPROVED 6 MIL POLYETHYLENE VAPOUR BARRIER ON 1/2" (12.7) GYPSUM WALLBOARD BEHIND RIGID INSULATION, AND FIBERBOARD SHALL NOT BE USED FOR THE ATTACHMENT OF SIDING @ 23.17.8(1) (REFER TO 35 NOTE AS REQ.)

INTERIOR STUD PARTITIONS [9.23, 9.23.9.8, 9.23.10.1]

- 11** BEARING PARTITIONS SHALL BE A MINIMUM 2" (50.80) @ 15'-400" O.C. FOR 2 STOREY & 1" (25) AIR SPACE, 7/8"-10" (22.2-25.4) GALV. METAL TEES @ 18"-400" O.C. VERT. BONDING AND FASTENING FOR TIES TO EXTERIOR SHEATHING PAPER ON 18'-6.5" EXT. SHEATHING ON STUDS CONFORMING TO O.B.C. 9.23.10.1 & SECTION 1.1. INSULATION APPROVED 6 MIL POLYETHYLENE VAPOUR BARRIER ON 1/2" (12.7) GYPSUM WALLBOARD INT. FIN. (GYPSUM SHEATHING, RIGID INSULATION, AND FIBERBOARD SHALL NOT BE USED FOR THE ATTACHMENT OF SIDING @ 23.17.8(1) (REFER TO 35 NOTE AS REQ.)

INTERIOR STUD PARTITIONS [9.23, 9.23.9.8, 9.23.10.1]

- 12** BEARING PARTITIONS SHALL BE A MINIMUM 2" (50.80) @ 15'-400" O.C. FOR 2 STOREY & 1" (25) AIR SPACE, 7/8"-10" (22.2-25.4) GALV. METAL TEES @ 18"-400" O.C. VERT. BONDING AND FASTENING FOR TIES TO EXTERIOR SHEATHING PAPER ON 18'-6.5" EXT. SHEATHING ON STUDS CONFORMING TO O.B.C. 9.23.10.1 & SECTION 1.1. INSULATION APPROVED 6 MIL POLYETHYLENE VAPOUR BARRIER ON 1/2" (12.7) GYPSUM WALLBOARD INT. FIN. (GYPSUM SHEATHING, RIGID INSULATION, AND FIBERBOARD SHALL NOT BE USED FOR THE ATTACHMENT OF SIDING @ 23.17.8(1) (REFER TO 35 NOTE AS REQ.)

INTERIOR STUD PARTITIONS [9.23, 9.23.9.8, 9.23.10.1]

- 13** BEARING PARTITIONS SHALL BE A MINIMUM 2" (50.80) @ 15'-400" O.C. FOR 2 STOREY & 1" (25) AIR SPACE, 7/8"-10" (22.2-25.4) GALV. METAL TEES @ 18"-400" O.C. VERT. BONDING AND FASTENING FOR TIES TO EXTERIOR SHEATHING PAPER ON 18'-6.5" EXT. SHEATHING ON STUDS CONFORMING TO O.B.C. 9.23.10.1 & SECTION 1.1. INSULATION APPROVED 6 MIL POLYETHYLENE VAPOUR BARRIER ON 1/2" (12.7) GYPSUM WALLBOARD INT. FIN. (GYPSUM SHEATHING, RIGID INSULATION, AND FIBERBOARD SHALL NOT BE USED FOR THE ATTACHMENT OF SIDING @ 23.17.8(1) (REFER TO 35 NOTE AS REQ.)

INTERIOR STUD PARTITIONS [9.23, 9.23.9.8, 9.23.10.1]

- 14** BEARING PARTITIONS SHALL BE A MINIMUM 2" (50.80) @ 15'-400" O.C. FOR 2 STOREY & 1" (25) AIR SPACE, 7/8"-10" (22.2-25.4) GALV. METAL TEES @ 18"-400" O.C. VERT. BONDING AND FASTENING FOR TIES TO EXTERIOR SHEATHING PAPER ON 18'-6.5" EXT. SHEATHING ON STUDS CONFORMING TO O.B.C. 9.23.10.1 & SECTION 1.1. INSULATION APPROVED 6 MIL POLYETHYLENE VAPOUR BARRIER ON 1/2" (12.7) GYPSUM WALLBOARD INT. FIN. (GYPSUM SHEATHING, RIGID INSULATION, AND FIBERBOARD SHALL NOT BE USED FOR THE ATTACHMENT OF SIDING @ 23.17.8(1) (REFER TO 35 NOTE AS REQ.)

INTERIOR STUD PARTITIONS [9.23, 9.23.9.8, 9.23.10.1]

- 15** BEARING PARTITIONS SHALL BE A MINIMUM 2" (50.80) @ 15'-400" O.C. FOR 2 STOREY & 1" (25) AIR SPACE, 7/8"-10" (22.2-25.4) GALV. METAL TEES @ 18"-400" O.C. VERT. BONDING AND FASTENING FOR TIES TO EXTERIOR SHEATHING PAPER ON 18'-6.5" EXT. SHEATHING ON STUDS CONFORMING TO O.B.C. 9.23.10.1 & SECTION 1.1. INSULATION APPROVED 6 MIL POLYETHYLENE VAPOUR BARRIER ON 1/2" (12.7) GYPSUM WALLBOARD INT. FIN. (GYPSUM SHEATHING, RIGID INSULATION, AND FIBERBOARD SHALL NOT BE USED FOR THE ATTACHMENT OF SIDING @ 23.17.8(1) (REFER TO 35 NOTE AS REQ.)

INTERIOR STUD PARTITIONS [9.23, 9.23.9.8, 9.23.10.1]

- 16** BEARING PARTITIONS SHALL BE A MINIMUM 2" (50.80) @ 15'-400" O.C. FOR 2 STOREY & 1" (25) AIR SPACE, 7/8"-10" (22.2-25.4) GALV. METAL TEES @ 18"-400" O.C. VERT. BONDING AND FASTENING FOR TIES TO EXTERIOR SHEATHING PAPER ON 18'-6.5" EXT. SHEATHING ON STUDS CONFORMING TO O.B.C. 9.23.10.1 & SECTION 1.1. INSULATION APPROVED 6 MIL POLYETHYLENE VAPOUR BARRIER ON 1/2" (12.7) GYPSUM WALLBOARD INT. FIN. (GYPSUM SHEATHING, RIGID INSULATION, AND FIBERBOARD SHALL NOT BE USED FOR THE ATTACHMENT OF SIDING @ 23.17.8(1) (REFER TO 35 NOTE AS REQ.)

INTERIOR STUD PARTITIONS [9.23, 9.23.9.8, 9.23.10.1]

- 17** BEARING PARTITIONS SHALL BE A MINIMUM 2" (50.80) @ 15'-400" O.C. FOR 2 STOREY & 1" (25) AIR SPACE, 7/8"-10" (22.2-25.4) GALV. METAL TEES @ 18"-400" O.C. VERT. BONDING AND FASTENING FOR TIES TO EXTERIOR SHEATHING PAPER ON 18'-6.5" EXT. SHEATHING ON STUDS CONFORMING TO O.B.C. 9.23.10.1 & SECTION 1.1. INSULATION APPROVED 6 MIL POLYETHYLENE VAPOUR BARRIER ON 1/2" (12.7) GYPSUM WALLBOARD INT. FIN. (GYPSUM SHEATHING, RIGID INSULATION, AND FIBERBOARD SHALL NOT BE USED FOR THE ATTACHMENT OF SIDING @ 23.17.8(1) (REFER TO 35 NOTE AS REQ.)

INTERIOR STUD PARTITIONS [9.23, 9.23.9.8, 9.23.10.1]

- 18** BEARING PARTITIONS SHALL BE A MINIMUM 2" (50.80) @ 15'-400" O.C. FOR 2 STOREY & 1" (25) AIR SPACE, 7/8"-10" (22.2-25.4) GALV. METAL TEES @ 18"-400" O.C. VERT. BONDING AND FASTENING FOR TIES TO EXTERIOR SHEATHING PAPER ON 18'-6.5" EXT. SHEATHING ON STUDS CONFORMING TO O.B.C. 9.23.10.1 & SECTION 1.1. INSULATION APPROVED 6 MIL POLYETHYLENE VAPOUR BARRIER ON 1/2" (12.7) GYPSUM WALLBOARD INT. FIN. (GYPSUM SHEATHING, RIGID INSULATION, AND FIBERBOARD SHALL NOT BE USED FOR THE ATTACHMENT OF SIDING @ 23.17.8(1) (REFER TO 35 NOTE AS REQ.)

INTERIOR STUD PARTITIONS [9.23, 9.23.9.8, 9.23.10.1]

- 19** BEARING PARTITIONS SHALL BE A MINIMUM 2" (50.80) @ 15'-400" O.C. FOR 2 STOREY & 1" (25) AIR SPACE, 7/8"-10" (22.2-25.4) GALV. METAL TEES @ 18"-400" O.C. VERT. BONDING AND FASTENING FOR TIES TO EXTERIOR SHEATHING PAPER ON 18'-6.5" EXT. SHEATHING ON STUDS CONFORMING TO O.B.C. 9.23.10.1 & SECTION 1.1. INSULATION APPROVED 6 MIL POLYETHYLENE VAPOUR BARRIER ON 1/2" (12.7) GYPSUM WALLBOARD INT. FIN. (GYPSUM SHEATHING, RIGID INSULATION, AND FIBERBOARD SHALL NOT BE USED FOR THE ATTACHMENT OF SIDING @ 23.17.8(1) (REFER TO 35 NOTE AS REQ.)

INTERIOR STUD PARTITIONS [9.23, 9.23.9.8, 9.23.10.1]

- 20** BEARING PARTITIONS SHALL BE A MINIMUM 2" (50.80) @ 15'-400" O.C. FOR 2 STOREY & 1" (25) AIR SPACE, 7/8"-10" (22.2-25.4) GALV. METAL TEES @ 18"-400" O.C. VERT. BONDING AND FASTENING FOR TIES TO EXTERIOR SHEATHING PAPER ON 18'-6.5" EXT. SHEATHING ON STUDS CONFORMING TO O.B.C. 9.23.10.1 & SECTION 1.1. INSULATION APPROVED 6 MIL POLYETHYLENE VAPOUR BARRIER ON 1/2" (12.7) GYPSUM WALLBOARD INT. FIN. (GYPSUM SHEATHING, RIGID INSULATION, AND FIBERBOARD SHALL NOT BE USED FOR THE ATTACHMENT OF SIDING @ 23.17.8(1) (REFER TO 35 NOTE AS REQ.)

INTERIOR STUD PARTITIONS [9.23, 9.23.9.8, 9.23.10.1]

- 21** BEARING PARTITIONS SHALL BE A MINIMUM 2" (50.80) @ 15'-400" O.C. FOR 2 STOREY & 1" (25) AIR SPACE, 7/8"-10" (22.2-25.4) GALV. METAL TEES @ 18"-400" O.C. VERT. BONDING AND FASTENING FOR TIES TO EXTERIOR SHEATHING PAPER ON 18'-6.5" EXT. SHEATHING ON STUDS CONFORMING TO O.B.C. 9.23.10.1 & SECTION 1.1. INSULATION APPROVED 6 MIL POLYETHYLENE VAPOUR BARRIER ON 1/2" (12.7) GYPSUM WALLBOARD INT. FIN. (GYPSUM SHEATHING, RIGID INSULATION, AND FIBERBOARD SHALL NOT BE USED FOR THE ATTACHMENT OF SIDING @ 23.17.8(1) (REFER TO 35 NOTE AS REQ.)

INTERIOR STUD PARTITIONS [9.23, 9.23.9.8, 9.23.10.1]

- 22** BEARING PARTITIONS SHALL BE A MINIMUM 2" (50.80) @ 15'-400" O.C. FOR 2 STOREY & 1" (25) AIR SPACE, 7/8"-10" (22.2-25.4) GALV. METAL TEES @ 18"-400" O.C. VERT. BONDING AND FASTENING FOR TIES TO EXTERIOR SHEATHING PAPER ON 18'-6.5" EXT. SHEATHING ON STUDS CONFORMING TO O.B.C. 9.23.10.1 & SECTION 1.1. INSULATION APPROVED 6 MIL POLYETHYLENE VAPOUR BARRIER ON

cont. SECTION 1.0 CONSTRUCTION NOTES

REFER TO SB-12 ENERGY EFFICIENCY DESIGN MATRIX ON THE TITLE PAGE FOR ALL VALUES AS REQUIRED PER 3.1.1, 3.1.2, 3.1.3 OF THE O.B.C.

SECTION 2.0. GENERAL NOTES

REFER TO SB-12 ENERGY EFFICIENCY DESIGN MATRIX ON THE TITLE PAGE FOR MAX. U-VALUE REQUIREMENTS

2.1. WINDOWS

1) EXCEPT WHERE A DOOR ON THE SAME FLOOR LEVEL AS THE BEDROOM PROVIDES DIRECT ACCESS TO THE EXTERIOR, EVERY FLOOR LEVEL CONTAINING A BEDROOM IS TO HAVE AT LEAST ONE OUTSIDE WINDOW/W MIN. 0.256 SQ.FT. UNDERSTRUCTURED OPEN PORTION W/ NO DIMENS LESS THAN 11" X 30". CAPABLE OF MAINTAINING THE OPENING WITHOUT GUARDS FOR ADDITIONAL SUPPORT CONFORMING TO 8.9.10.

2) WINDOW GUARDS: A GUARD FOR A WINDOW WITH A MAXIMUM RESTRICTED OPENING WIDTH OF 4" (100) IS REQUIRED WHERE THE TOP OF THE WINDOW SILL IS LOCATED LESS THAN 40" ABOVE THE FLOOR AND THE DISTANCE FROM THE FINISHED FLOOR TO THE ADJACENT GRADE IS GREATER THAN 5'-11" (180). [3.8.1]

3) WINDOWS IN NEXT STAIRWAYS THAT EXTEND TO LESS THAN 24'-11" (900). [3.8.1] FOR ALL OTHER BALCONY GUARDS SHALL BE PROVIDED BY GUARDS IN ACCORDANCE WITH NOTE #2 ABOVE, OR THE WINDOW SHALL BE NON-OPERABLE AND DESIGNED TO WITHSTAND THE SPECIFIED LOADS FOR BALCONY GUARDS AS PROVIDED IN K-15.10 AND SB-12.

4) REFER TO TITLE PAGE FOR MAX. U-VALUE REQUIREMENTS

2.2. CEILING HEIGHTS

THE CEILING HEIGHTS OF ROOMS AND SPACES SHALL CONFORM TO TABLE 9.5.3.1.

2.3. MECHANICAL / PLUMBING

1) MECHANICAL VENTILATION IS REQUIRED TO PROVIDE 1 AIR CHANGE PER HOUR REFER TO MECHANICAL DRAWINGS

2) REFER TO HOT WATER TANK MANUFACTURER SPECS. CONFORM TO O.B.C. 19.31.61

3) REFER TO TITLE PAGE FOR SPACE HEATING EQUIPMENT, HW AND DOMESTIC HOT WATER HEATER MINIMUM REQUIREMENTS.

4) DRAIN WATER HEAT RECOVERY UNITS WILL BE INSTALLED CONFORMING TO THE REQUIREMENTS OF (SB-12) - (3.1.1.12) OF THE O.B.C.

2.4. LUMBER

TALL TIMBERS SHALL BE SPRUCE NO.2 GRADE OR BETTER, UNLESS NOTED OTHERWISE.

2.5. STEEL

STRUCTURAL STEEL SHALL CONFORM TO CAN/CSA-G4-21 GRADE 350W HOLLOW I FLANGE MATERIALS & INSTALLATION SHALL CONFORM TO O.B.C.

2.6. ROOF OVERHANGS

1) FLASHING MATERIALS SHALL BE LOCATED OR NEAR THE BUILDING AND WILL NOT ADVERSELY AFFECT ADJACENT PROPERTIES. CONFORM TO [8.14.5]

2) ROOF HANGERS: PROVIDE APPROACHED METAL HANGERS FOR ALL JOISTS AND BUILT-UP WOOD MEMBERS IN THERMALLY INSULATED ROOF MEMBERS.

3) FLASHING NOT TREATED WITH A WOOD PRESERVATIVE, IN CONTACT WITH CONCRETE, SHALL BE SEPARATED FROM THE CONG. BY AT LEAST 2" IN POLYETHYLENE FILM AND 4" (48MM) ROLL ROOFING OR OTHER DAMP PROOFING MATERIAL, EXCEPT WHERE THE WOOD MEMBER IS AT LEAST 6" (152) ABOVE THE GROUND.

2.7. FLASHING

1) FLASHING SHALL BE LOCATED OR NEAR THE BUILDING AND WILL NOT ADVERSELY AFFECT ADJACENT PROPERTIES. CONFORM TO [8.14.5]

2.8. ROOFING

1) ROOFING SHALL BE LOCATED OR NEAR THE BUILDING AND WILL NOT ADVERSELY AFFECT ADJACENT PROPERTIES. CONFORM TO [8.14.5]

2.9. GRADING

1) GRAVEL, DIRT, SOIL, ETC. SHALL BE TREATED OR TREATED WITH A PRODUCT THAT PREVENTS THE EXTERIOR SURFACE OF THE CONCRETE FROM ABSORBING WATER.

2.10. ULC SPECIFIED ASSEMBLIES

1) ALL REQUIRED NON-COMPLIANT COMPONENTS THAT FORM PART OF ANY ULC LISTED ASSEMBLY, SPECIFIED WITHIN THESE DRAWINGS, CANNOT BE ALTERED OR SUBSTITUTED FOR ANY OTHER MATERIAL/PRODUCT OR SPECIFIED MANUFACTURER THAT IS IDENTIFIED IN THAT SPECIFIED ULC LISTING. THERE SHALL BE NO DEViations UNDER ANY CIRCUMSTANCES IN ANY ULC LISTED ASSEMBLY IDENTIFIED IN THESE DRAWINGS.

SECTION 3.0. LEGEND

3.1. WOOD INT'L'S AND BUILT-UP WOOD

[DIVISION B PART 9, TABLES 9.23.4.2-A-(1)-(1), 9.23.12.3.(1)-(3), 9.23.14.8.(2)]

SECTION 4.0. CLIMATIC DATA

4.1. SOLID BEARING (BUILT-UP WOOD COLUMNS AND STUD POSTS)

1) CHECK LOCAL BY-LAWS FOR REQUIREMENTS* A CARBON MONOXIDE ALARM(S) CONFORMING TO CAN/CGA-G19 SHALL BE INSTALLED ON ONE FLOOR, IN EACH DWELLING UNIT, AND ADJACENT TO EACH SLEEPING ROOM AND IN A LOCATION BETWEEN SLEEPING ROOMS AND CONNECTION HALLWAYS AND WISSED TO BE INTERCONNECTED TO ACTIVATE ALL ALARMS & ONE SOUNDS. ALARMS ARE TO BE CONNECTED TO AN ELECTRICAL CIRCUIT AND WITH A BATTERY BACK-UP. ALARM SIGNAL SHALL MEET TEMPORAL SOUND PATTERN AS PER THE NATIONAL FIRE ALARM AND SIGNALING CODE*.

2) SA (SMOKE ALARM) [3.10.18] PROVIDE ONE PER FLOOR, NEAR THE STAR'S CONNECTING THE FLOOR LEVEL ALARMS TO BE INSTALLED IN EACH STOREY AND ADJACENT TO EACH SLEEPING ROOM AND IN A LOCATION BETWEEN SLEEPING ROOMS AND CONNECTION HALLWAYS AND WISSED TO BE INTERCONNECTED TO ACTIVATE ALL ALARMS & ONE SOUNDS. ALARMS ARE TO BE CONNECTED TO AN ELECTRICAL CIRCUIT AND WITH A BATTERY BACK-UP. ALARM SIGNAL SHALL MEET TEMPORAL SOUND PATTERN AS PER THE NATIONAL FIRE ALARM AND SIGNALING CODE*.

3) C-MDA (CARBON MONOXIDE ALARM) [6.3.3], [9.32.3.9] CHECK LOCAL BY-LAWS FOR REQUIREMENTS* A CARBON MONOXIDE ALARM(S) CONFORMING TO CAN/CGA-G19 SHALL BE INSTALLED ON ONE FLOOR, IN EACH DWELLING UNIT, AND ADJACENT TO EACH SLEEPING ROOM AND IN A LOCATION BETWEEN SLEEPING ROOMS AND CONNECTION HALLWAYS AND WISSED TO BE INTERCONNECTED TO ACTIVATE ALL ALARMS & ONE SOUNDS. ALARMS ARE TO BE CONNECTED TO AN ELECTRICAL CIRCUIT AND WITH A BATTERY BACK-UP. ALARM SIGNAL SHALL MEET TEMPORAL SOUND PATTERN AS PER THE NATIONAL FIRE ALARM AND SIGNALING CODE*.

4) EXHAUST VENT [3.5.5. SYMBOLS] CLASS BY-VENT

5) DUPLEX OUTLET [12.1 HIGH] CLASS BY-DUPLX OUTLET (NEG. AS NOTED)

6) FLOOR DRAIN CLASS BY-FLOOR DRAIN

7) GIRDER TRUSS CLASS BY-GIRDER TRUSS

8) ENGINEERED CLASS BY-ENGINEERED

9) ENERGY RECOVERY VENTILATION UNIT CLASS BY-ENERGY RECOVERY VENTILATION UNIT

10) EXPOSED CONCRETE CLASS BY-EXPOSED CONCRETE

11) EXPOSED WOOD COLUMN CLASS BY-EXPOSED WOOD COLUMN

12) EXPANDED METAL GRID CLASS BY-EXPANDED METAL GRID

13) EXPANDED METAL GRID CLASS BY-EXPANDED METAL GRID




89) EXPANDED METAL GRID CLASS BY-EXPANDED METAL GRID

90) EXPANDED METAL GRID CLASS BY-EXPANDED METAL GRID


9



BAYVIEW HEIGHTS
RICHMOND HILL

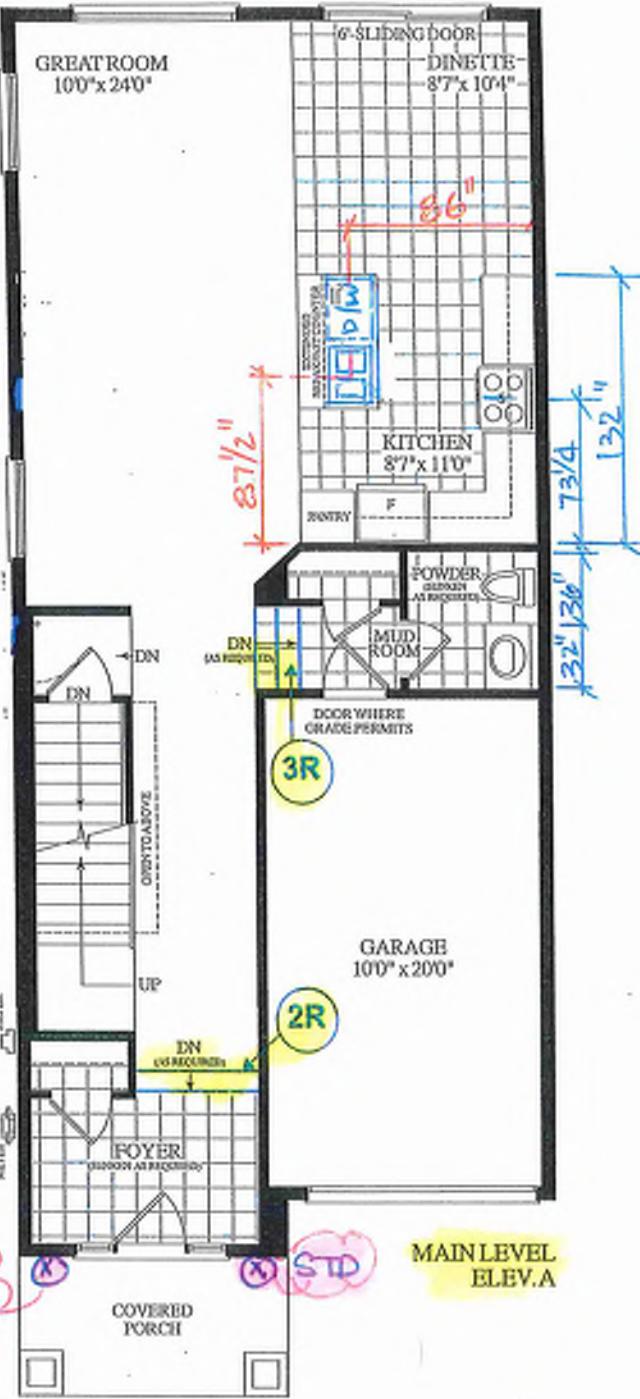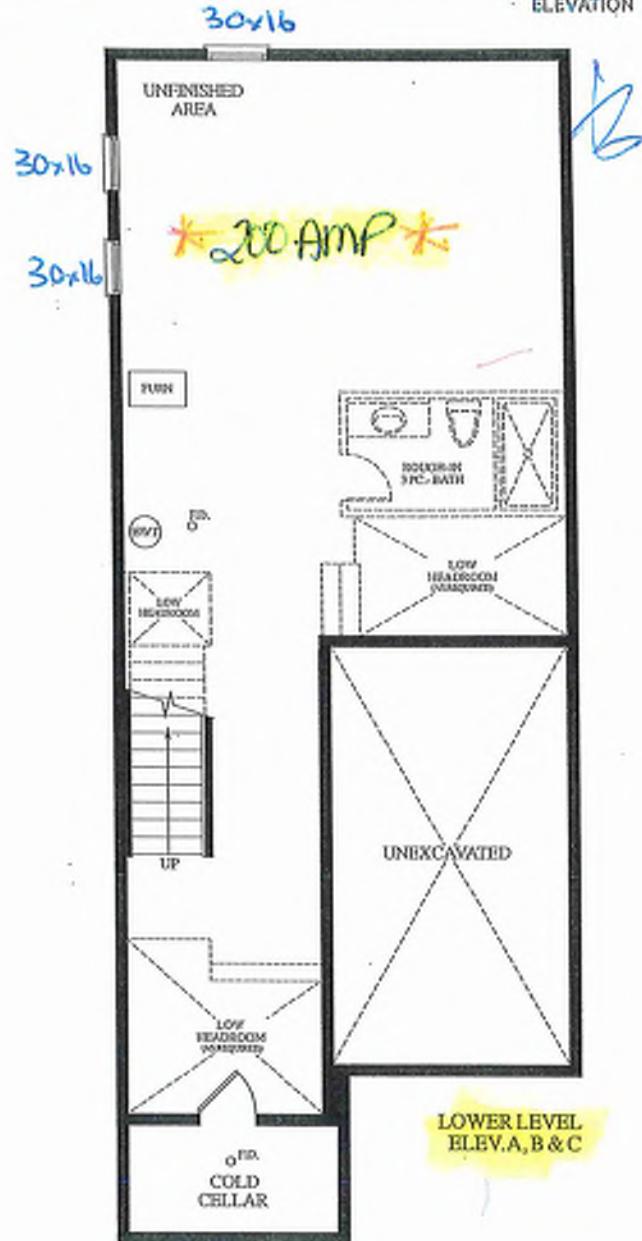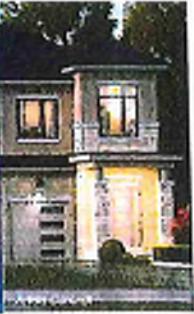


Materials, specifications and floor plans are subject to change without notice. All renderings are artist's concept. All floor plans are approximate dimensions. Actual usable floor space may vary from the stated floor area. E&OE.

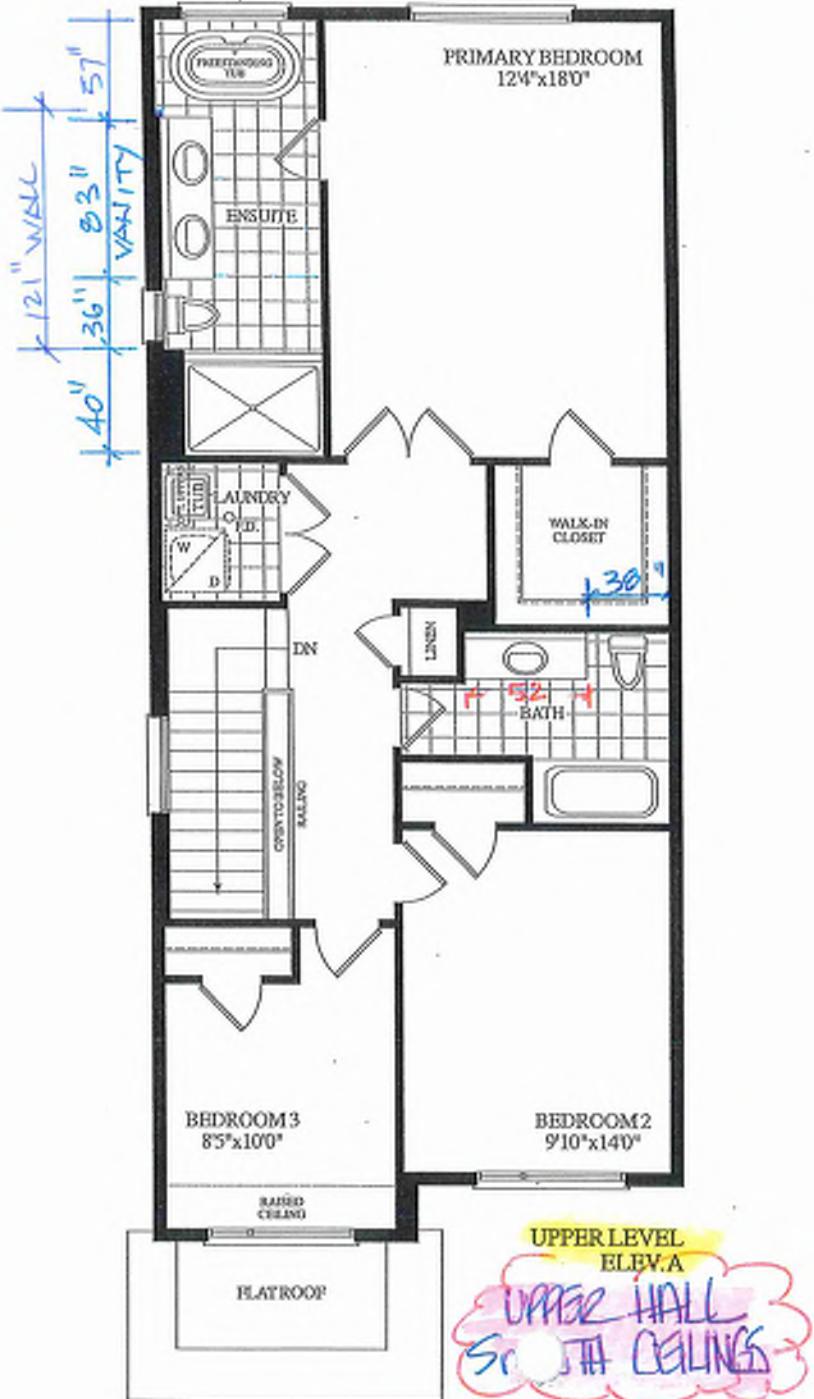

BLK. 19 TH. 126 20-18 THE KATHERINE (END) EL. A 3 BDRM 2 BATH 1815 SQ.FT.

GROUND TO SECOND
122' HT 11-7/8" JOIST

BASEMENT TO GROUND
BSMT 11-7/8" JOIST

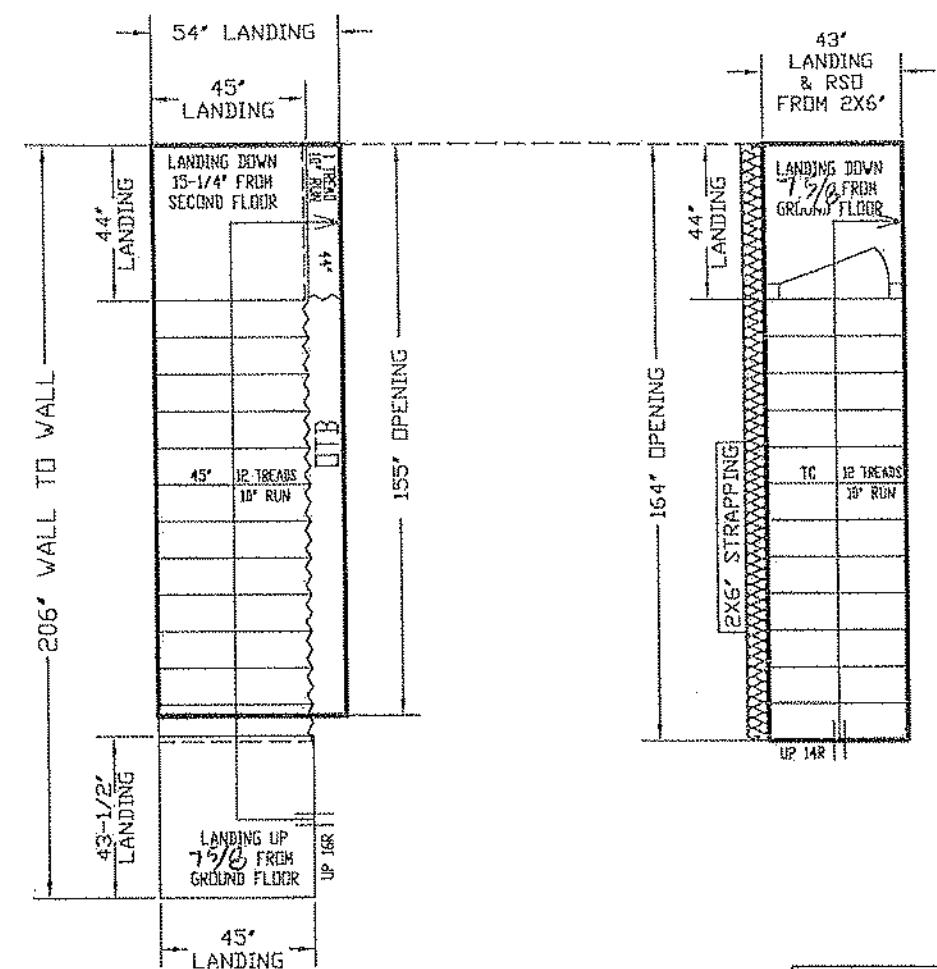

REVISED
JUNE 4, 2025

GARAGE RIGHT >

ALL OPENINGS ARE ALLOWED FOR 1 LAYER OF DRY WALL. ANY ADDITIONAL LAYERS MUST BE ALLOWED BY CARPENTERS		STAIRS LINE UP BY THE EXTERIOR WALL		NO WALLS UNTIL STAIRS INSTALLED	
ALPA STAIRS AND RAILINGS INC. Quality To Step Up To	ALL LANDINGS TO BE SUPPLIED AND SUPPORTED BY OTHERS UNLESS SPECIFIED ABOVE. ANY STRAPPING OR UNDERS TO BE COMPUTED BY CARPENTERS. ALL STAIR DIMENSIONS MAY BE MODIFIED FROM ORIGINAL BLUE PRINTS OR SPICES AS SUPPLIED. TO ALPA STAIRS AND RAILINGS INC. MEASUREMENTS SHOWN ON LAYOUTS ARE RELEIVED TO INSTALL OUR STAIRS. ANY PROBLEMS WITH HANDBRAKES OR STRAPPING ALLOWANCES, ALPA STAIRS AND RAILINGS INC. WILL NOT BE RESPONSIBLE. STAIR LAYOUTS SHOULD BE CHECKED BY CARPENTERS OR SITE SUPERVISORS TO MAKE SURE THERE ARE NO DISCREPANCIES BEFORE PROCEEDING WITH CONSTRUCTION.		SITE: BAYVIEW HEIGHTS DRAWN BY: PARAMEET DATE: MAY 23, 2025 LOT #: <input type="text"/> OWNER: ROYAL PINE HOMES UNIT: UNIT 2018 END: END LAYOUT #: <input type="text"/> SCALE: 1:35		
	ALPA STAIRS AND RAILINGS INC. 3770 NASHUA DRIVE, UNIT 3 MISSISSAUGA, ONTARIO L4V 1H6 TEL: (905) 694-9556 www.alpastairs.com				

Blk 19 - 126

Preliminary
NOT FINAL April 22 2025

NOT FINAL April 22 2025

72 1/2" 94

Aaylio

۱۷۹

INT-DOKS Ø3½"

 <p>2x4" STUD WALL ASSEMBLY EXCEEDING MAX UNSUPPORTED HEIGHT</p> <p>FOR WALLS GREATER THAN 4'-0" TO MAX 12'-0" HIGH, - NO FLOOR LOAD, DOUBLE UP EVERY 5'DP @ 16" O.C. - W/ FLOOR LOAD DOUBLE UP EVERY STUD @ 12" O.C. PROVIDE BLOCKING EVERY 4'-0" O.C. VERTICAL.</p>	ALL DOORS ON PLAN ARE 7'-0" HIGH TOP OF FRAME, UNLESS LABELED OTHERWISE.	PROVIDE SOLID HOOD BLOCKS @ 24"-0" O.C. FOR FIRST JOINT SPAN WHEN PARALLEL W/ EXTERIOR WALL
 <p>REFER TO FLOOR JOIST MANUFACTURER'S DRAWINGS FOR LAYOUT, SPACINGS, BLOCKING & STRAPPING REQUIREMENTS, INSTALLATION DETAILS AND HANGER SIZES, & SUBFLOOR THICKNESS</p>		

This is to certify that these plans comply
with the builder's committee responsibility to
ensure that all plans submitted for approval
fully comply with the Architectural Guidelines
and all applicable regulations and requirements
including zoning provisions and any provisions
in the subordination agreement. The Control
Architect is not responsible in any way for
examining or approving site (lot) plans or
working drawings with respect to any zoning or
building code or permit matter of that any
house can be properly built or located on its lot.

with the applicable Architectural Design
Guidelines approved by the City of
RICHMOND HILL

ROYAL PINE HOMES

HUNT

DESIGN ASSOCIATES INC.
www.huntdesign.ca

Digitized by srujanika@gmail.com


UNIT 2018-END
REV.2025.03.27

3 of 3


MATERIALS AND METHODS

Preliminary


NOT FINAL April 22 2025

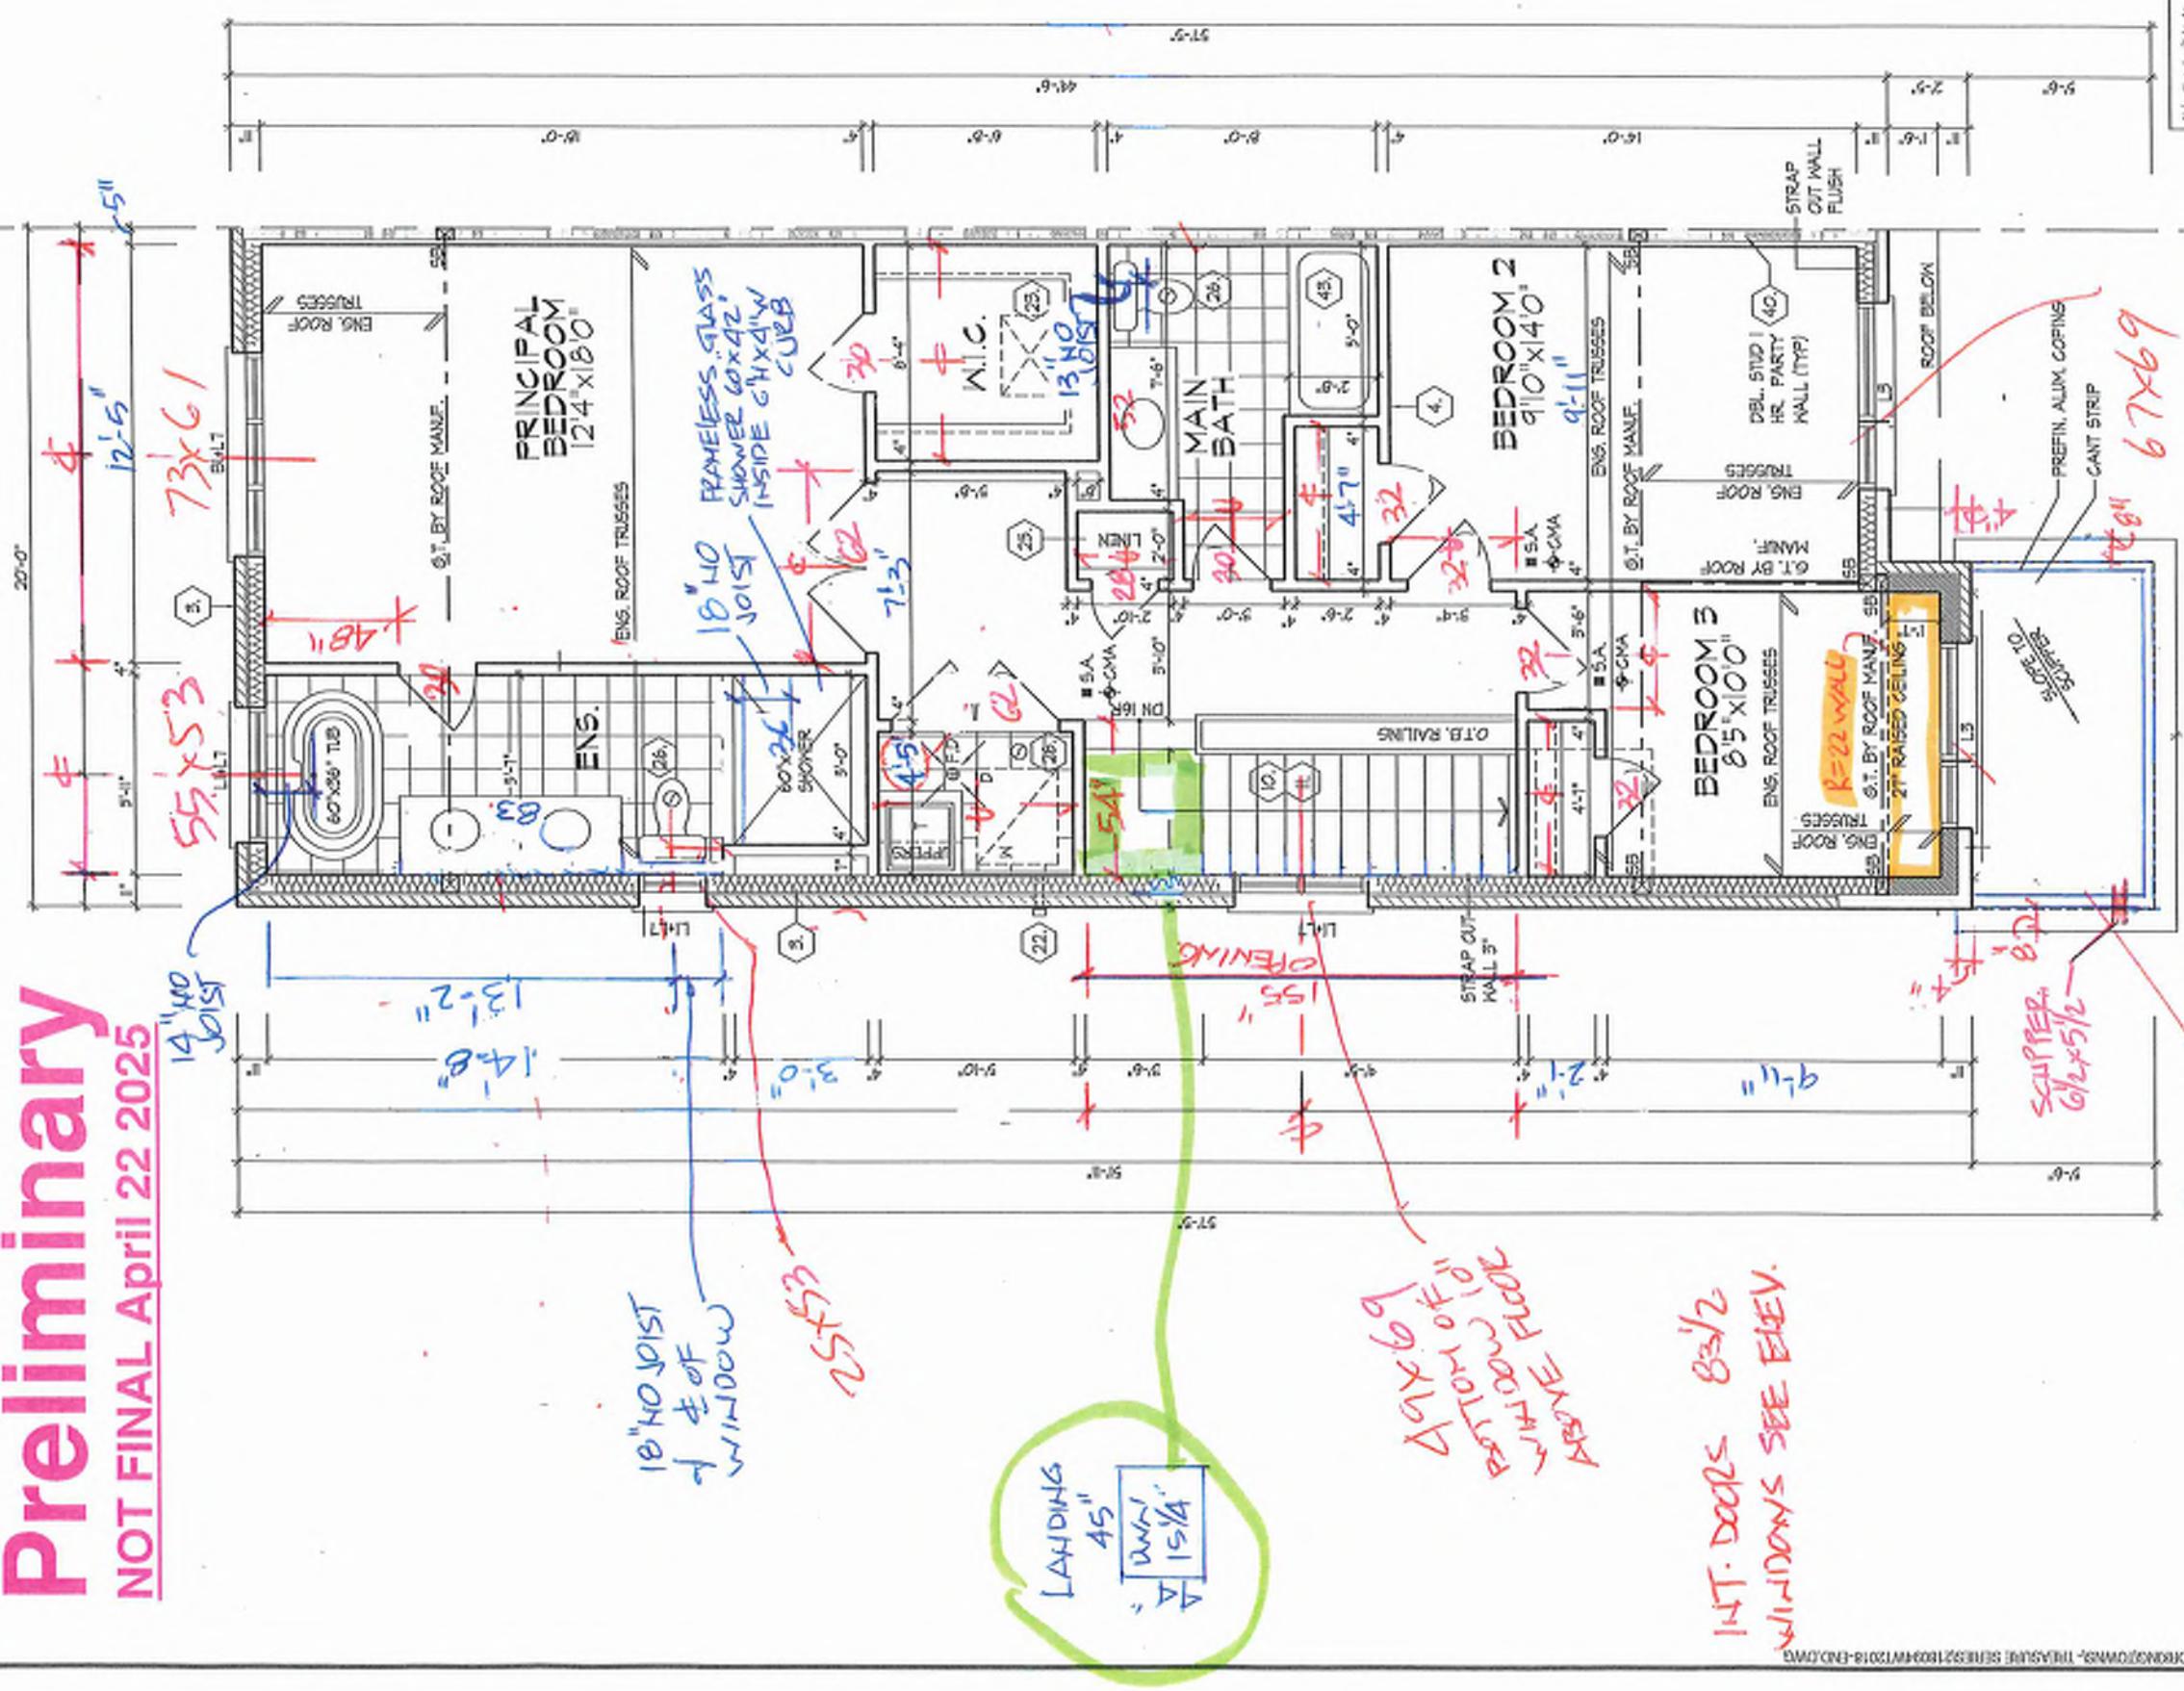

ROOF PLAN
EL. 'A'
N.T.S.

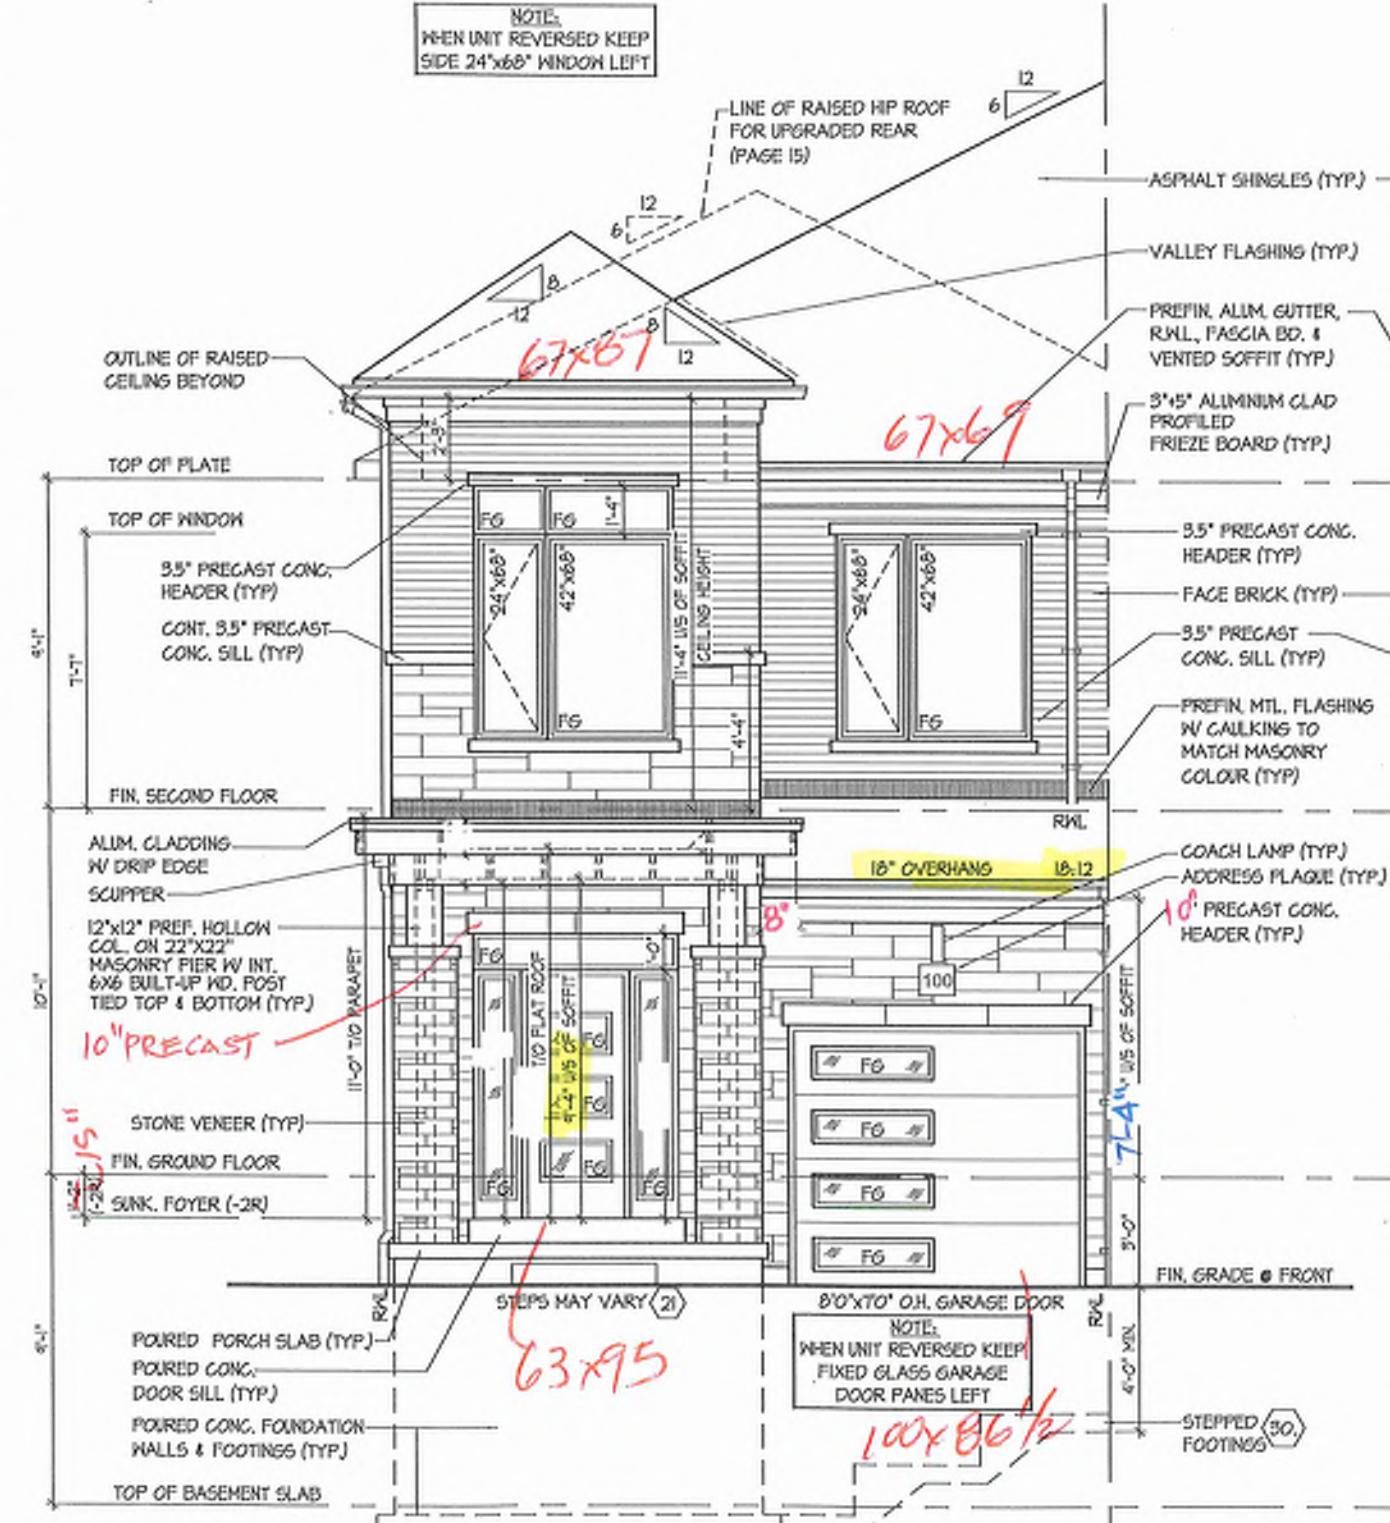

FRONT ELEVATION 'A'

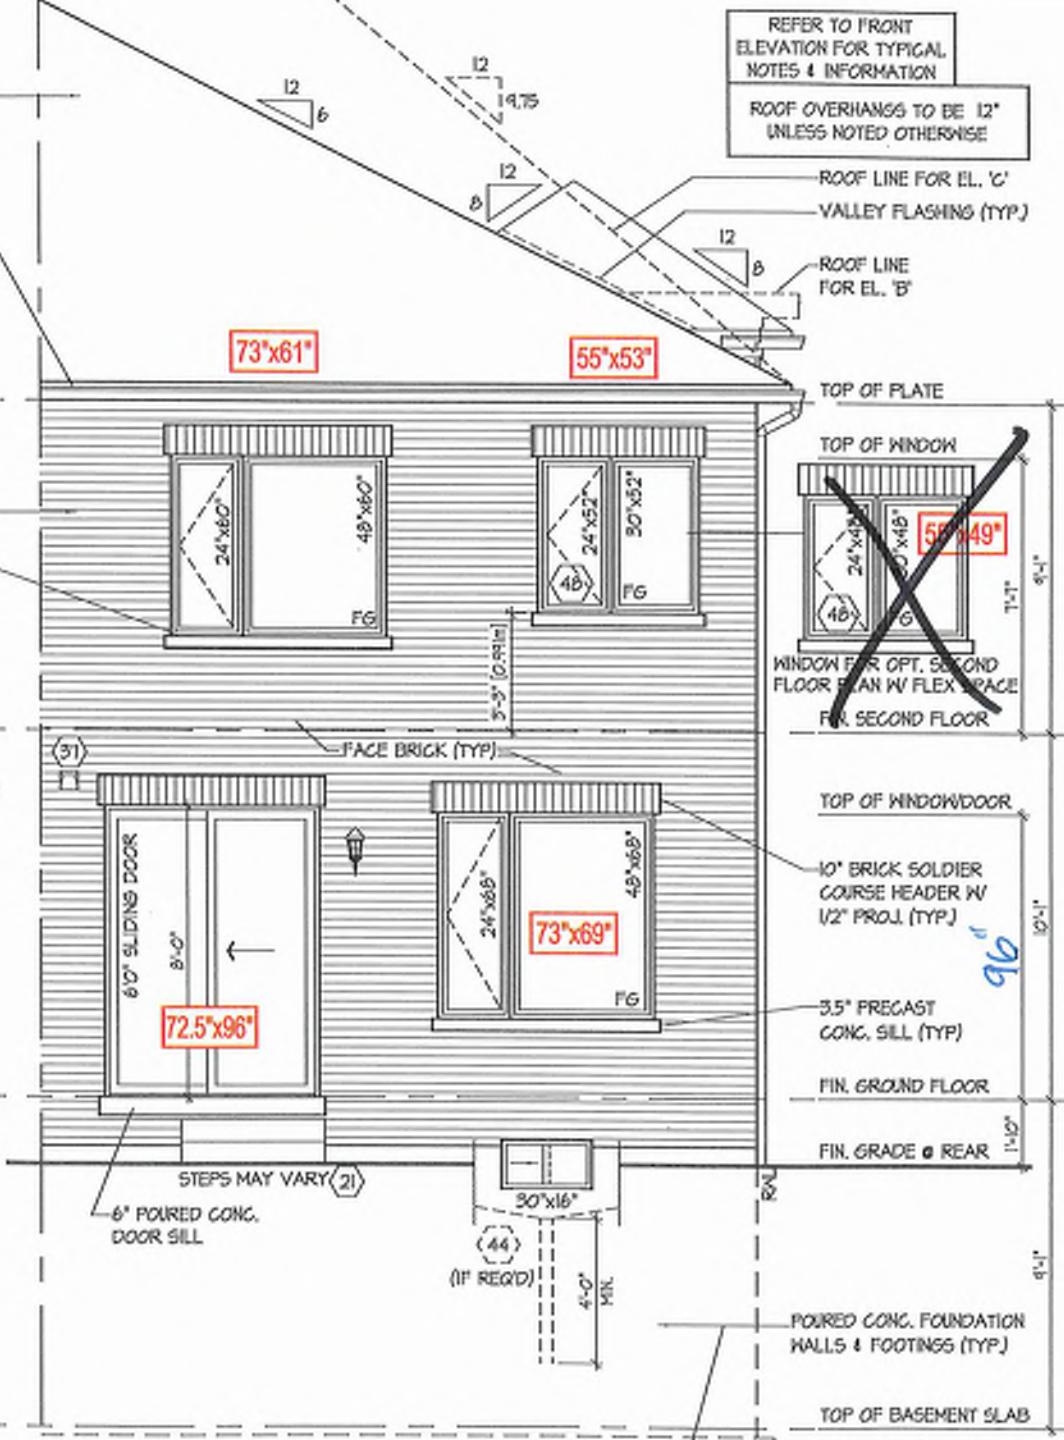

REAR ELEVATION 'A', 'B' & 'C'

This is to certify that these plans comply with the applicable Architectural Design Guidelines approved by the City of RICHMOND HILL.

UNIT 2018-END
REV. 2025.03.27

FRONT ELEVATION A
ROYAL PINE HOMES - 218094
921 BAYVIEW, RICHMOND HILL, ON.

E-2

THE UNDERGROUND HAS REVIEWED AND TAKES RESPONSIBILITY FOR THIS DOCUMENT AND HAS THE DOCUMENTS AND MEETS THE REQUIREMENTS SET OUT IN THE OFFICIAL BUILDING CODE TO BE A DESIGNATED EQUIPMENT INFORMATION SOURCE.

Page Number
14 of 31

Printed by KMM/TT
89868 Woodbine Ave., Markham, ON L3R 0J7
Directed by MM/DS
3116=1-0¹
Date 8086

REGISTRATION INFORMATION
HUNT DESIGN ASSOCIATES INC.
1969

SPATIAL CALCULATION PER O.B.C. TABLE 9.10.15.4			
LEFT SIDE ELEVATION A			
EXPOSING BUILDING FACE AREA	1174.07	S.F.	
	109.07	S.M.	
PORTION WALL AREA	1174.07	S.F.	
	109.07	S.M.	
LIMITING DISTANCE	1.2 m		
MAX. % OPENINGS	7	%	
W	E	N	WINDOW/DOOR FRAME SIZE (S.F.)
W	E	N	
1	24°	52°	0.87
1	45°	68°	13.50
2	39°	12°	4.33
2	45°	68°	33.11
0	0°	0°	0.00
0	0°	0°	0.00
0	ARCH		0.00
OPENINGS ALLOWED	82.18	S.F.	
OPENINGS PROVIDED	93.57	S.F.	
ADDITIONAL NOTES			
GLAZED AREA CALCULATED W/ FRAME SIZES MINUS 2" AROUND ENTIRE PERIMETER			

GLAZED AREA CALCULATED WI FRAME SIZE
MINUS 2" AROUND ENTIRE PERIMETER.

25" x 53"

WINDOW LOCATION FOR OPT. SEC
FLOOR PLAN W FLEX ROOM ONLY

FACE BRICK (TYP)

10" BRICK 50

4

1

11

30°x16°


(IF REQ'D)

1

— — — — —

FT SIDE E

EXTENTS OF SPATIAL
CALCULATIONS.
REFER TO WINDOW SUMMARY FOR
ADDITIONAL INFORMATION

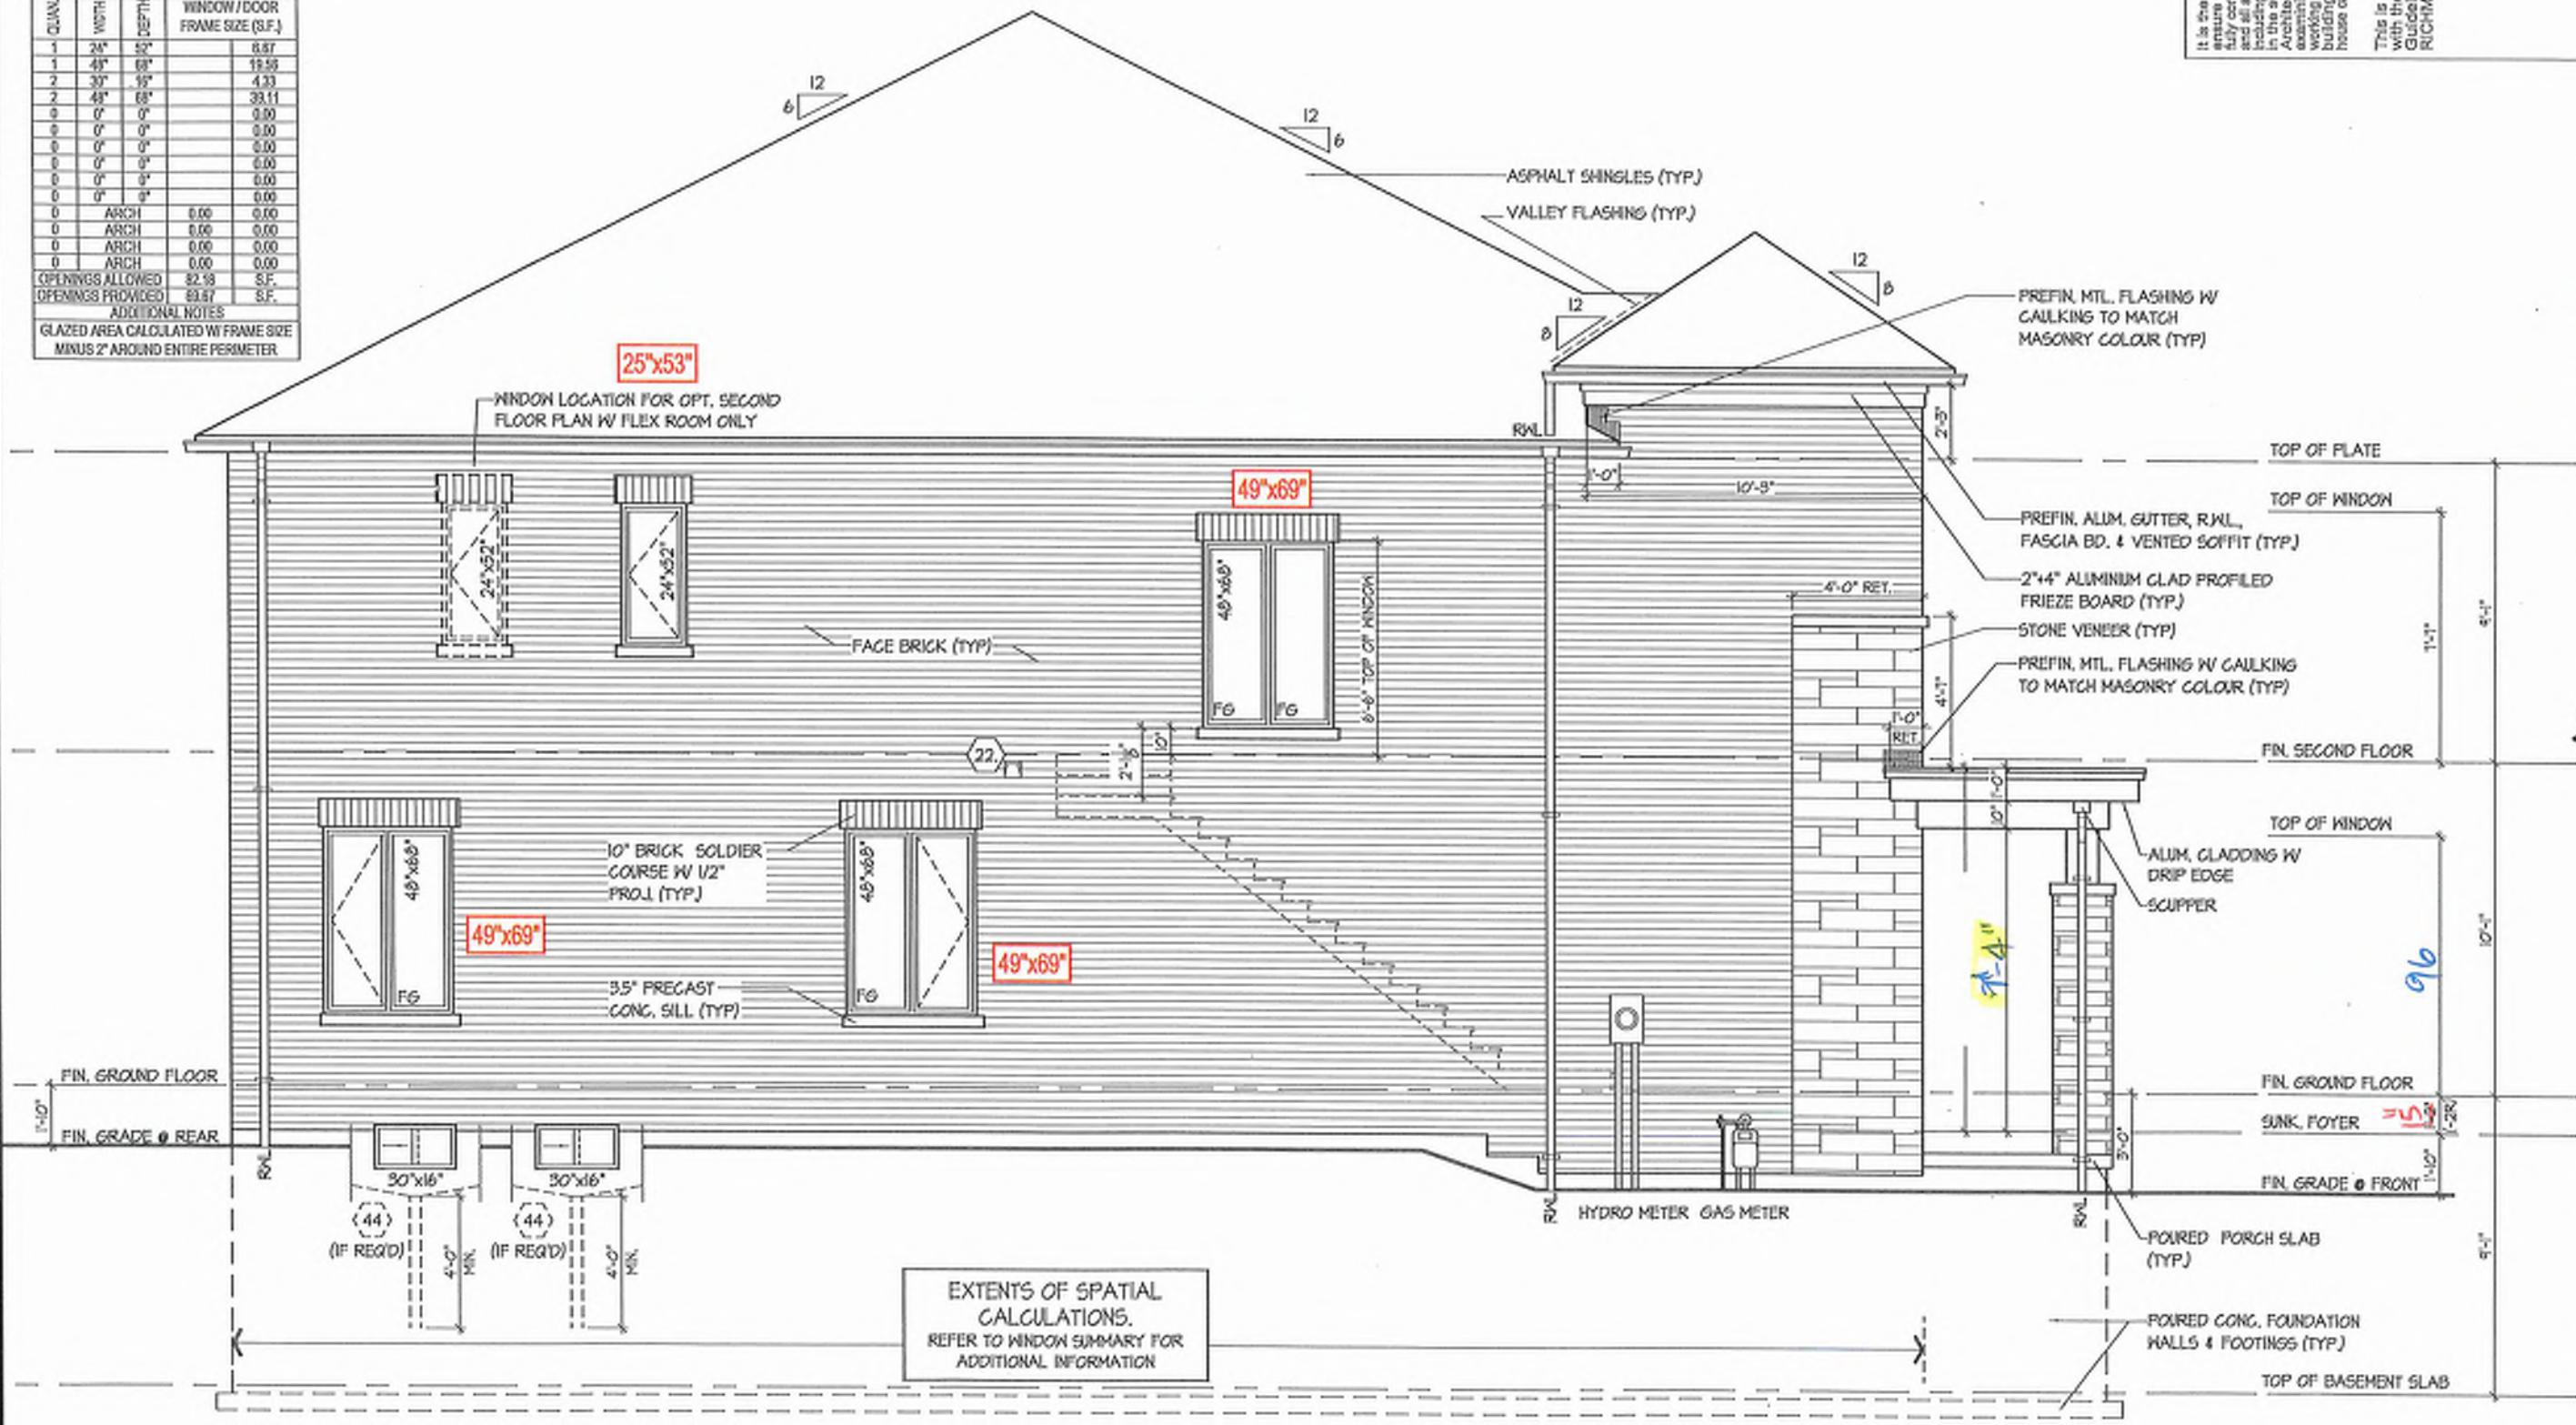

LEFT SIDE ELEVATION 'A'

This is to certify that those plans comply with the applicable Architectural Design Guidelines approved by the City of RICHMOND, VA.

LEFT SIDE ELEVATION 'A'

UNI 2018-END
REV.2025.03.27

Page Number
15 cf. 31

卷之三


ISBN number and added start.

THE UNDERGROUND HAS INNOVATED AND TAKES RESPONSIBILITY FOR THIS DESIGN AND HAS THE QUALIFICATIONS AND MEETS THE REQUIREMENTS SET OUT IN THE ONTARIO BUILDING CODE TO BE A CLASSIFIED, SUBDIVISION INSPECTOR.


REGISTRATION OF INFORMATION

HUNT DESIGN ASSOCIATES INC.


All elements, specifications related documents and designs are the copyright of

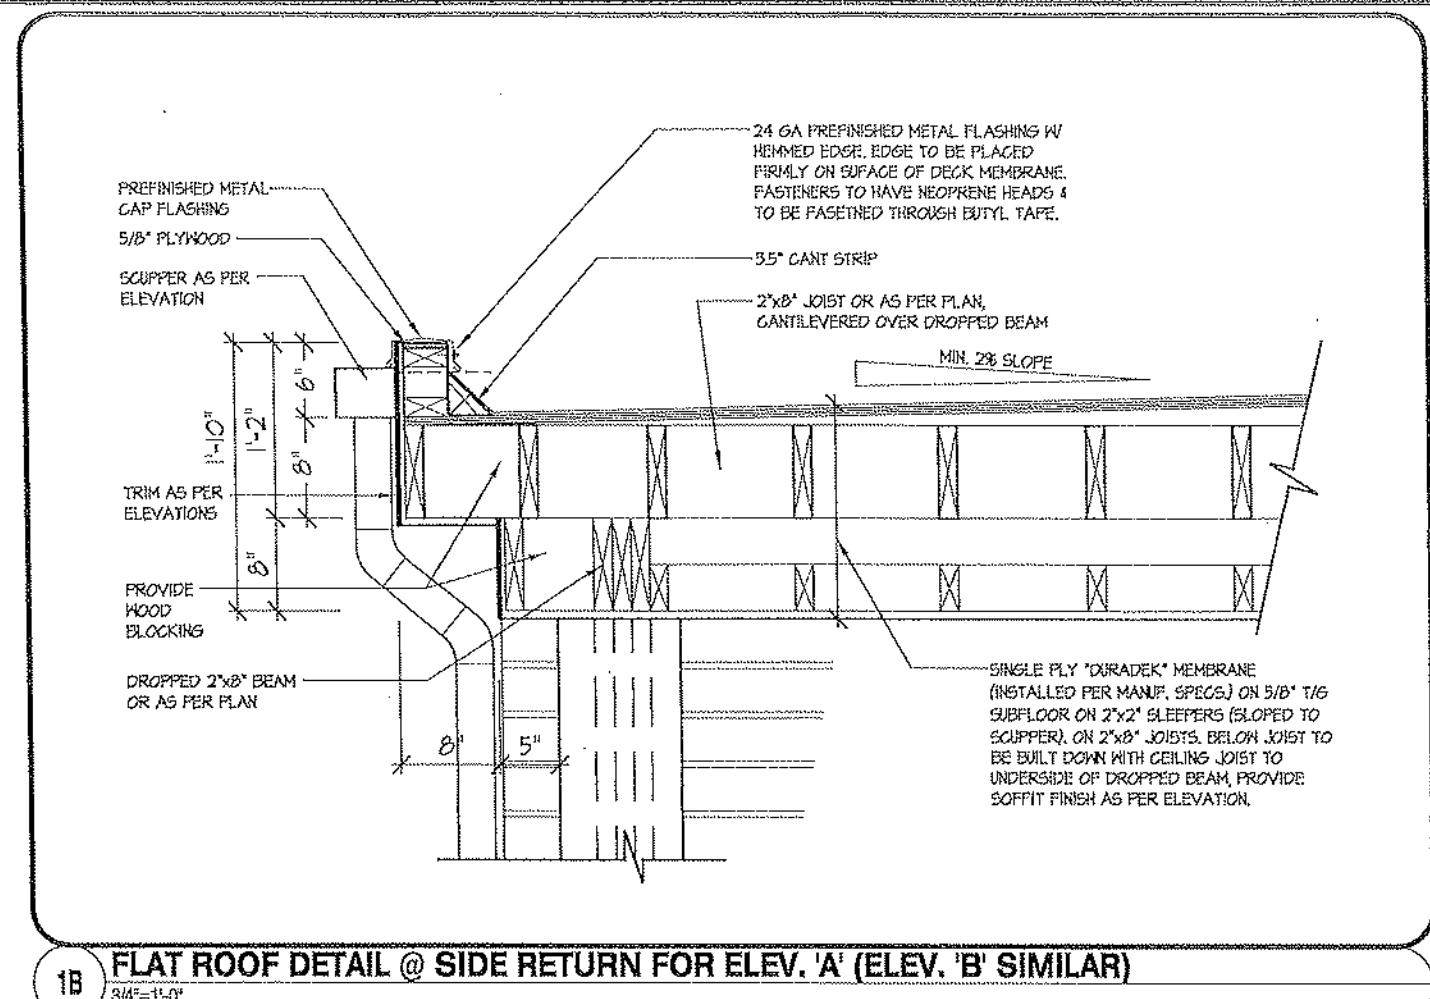


1B FLAT ROOF DETAIL @ SIDE RETURN FOR ELEV. 'A' (ELEV. 'B' SIMILAR)
3/4" = 1'-0"

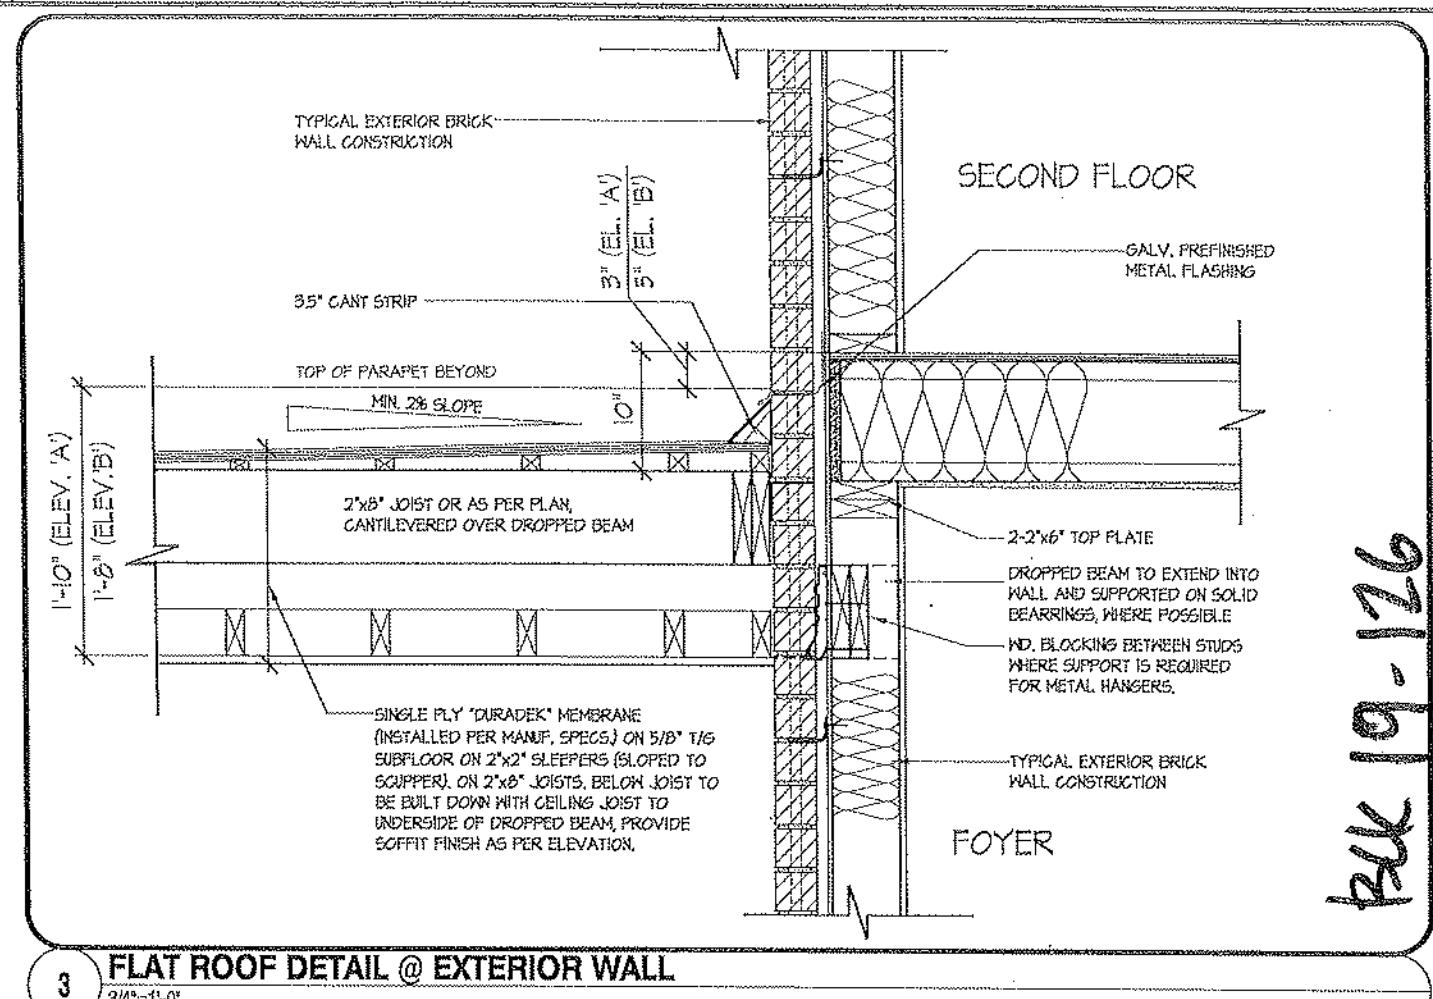

FLAT ROOF DETAIL @ EXTERIOR WALL

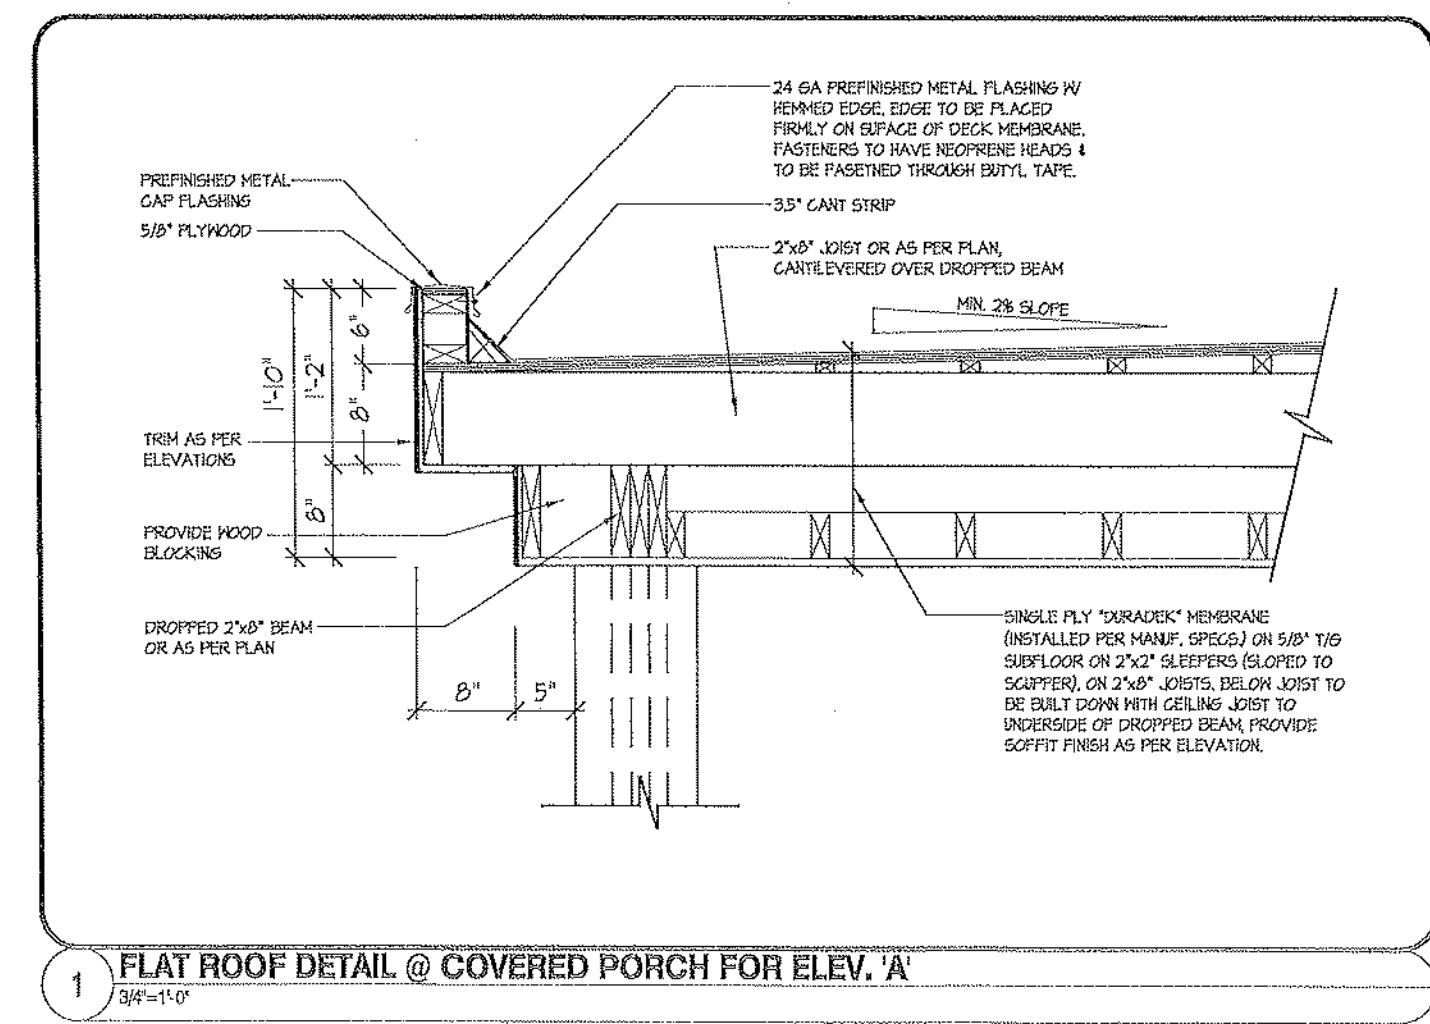

1 FLAT ROOF DETAIL @ COVERED PORCH FOR ELEV. A

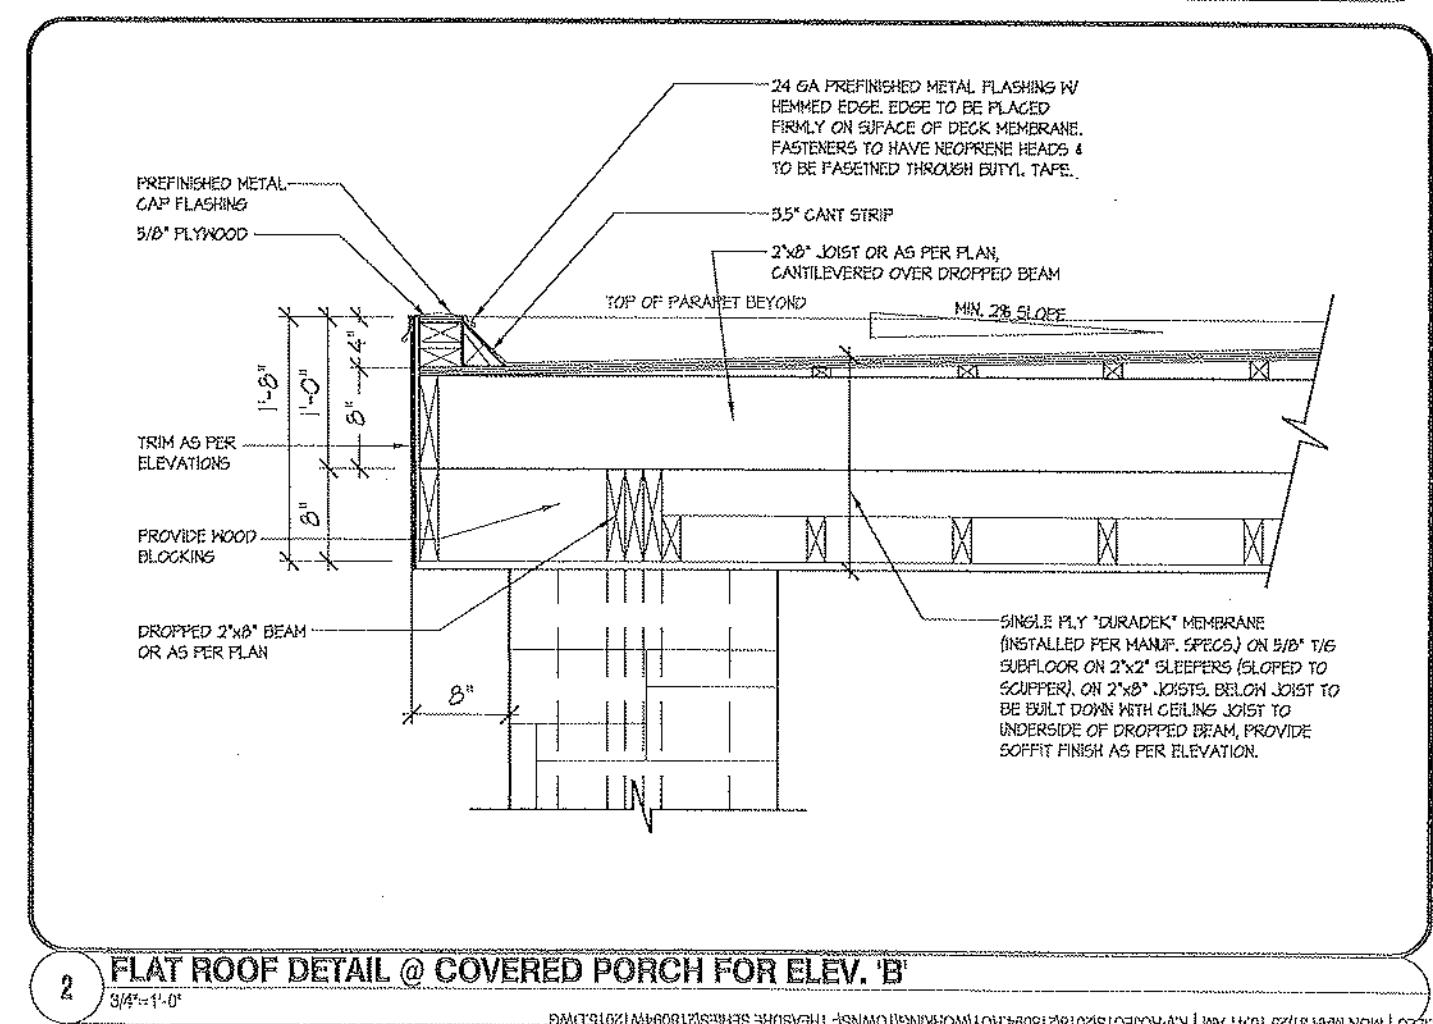

FLAT ROOF DETAIL @ COVERED PORCH FOR ELEV. 'B'

ROYAL PINE HOMES # 218094
921 BAYVIEW, RICHMOND HILL, ON.


Printed By	RKM/M/M	Change By	SMB	Date	3/16/2015	File Number	218094-VT2015
REV.2025.03.25	908.737.7326						
UNIT 2015	F 908.737.7326						
Page Number	27 of 25						

HUNT
DESIGN ASSOCIATES INC.
www.huntdesign.ca

THE UNDERSIGNED HAS BEEN REVIEWED AND TAKES RESPONSIBILITY FOR THIS QUALIFICATION IN THE CRAFTSMANSHIP AND WORKS THE REQUIREMENTS SET FOR QUALIFICATION UNDER SECTION 10 OF THE CALIFORNIA BUILDING CODE TO BE A DESIGNER.	Signature Scotting Modillo	21274	BON	19695
NAME FAX	REGISTRATION NUMBER REGISTRATION INFORMATION	REGISTRATION DATE RENEWAL DATE	EXPIRATION DATE EXPIRATION DATE	EXPIRATION DATE EXPIRATION DATE

Preisnominierung

NOTICE OF HEARING AND
NOTIFICATION

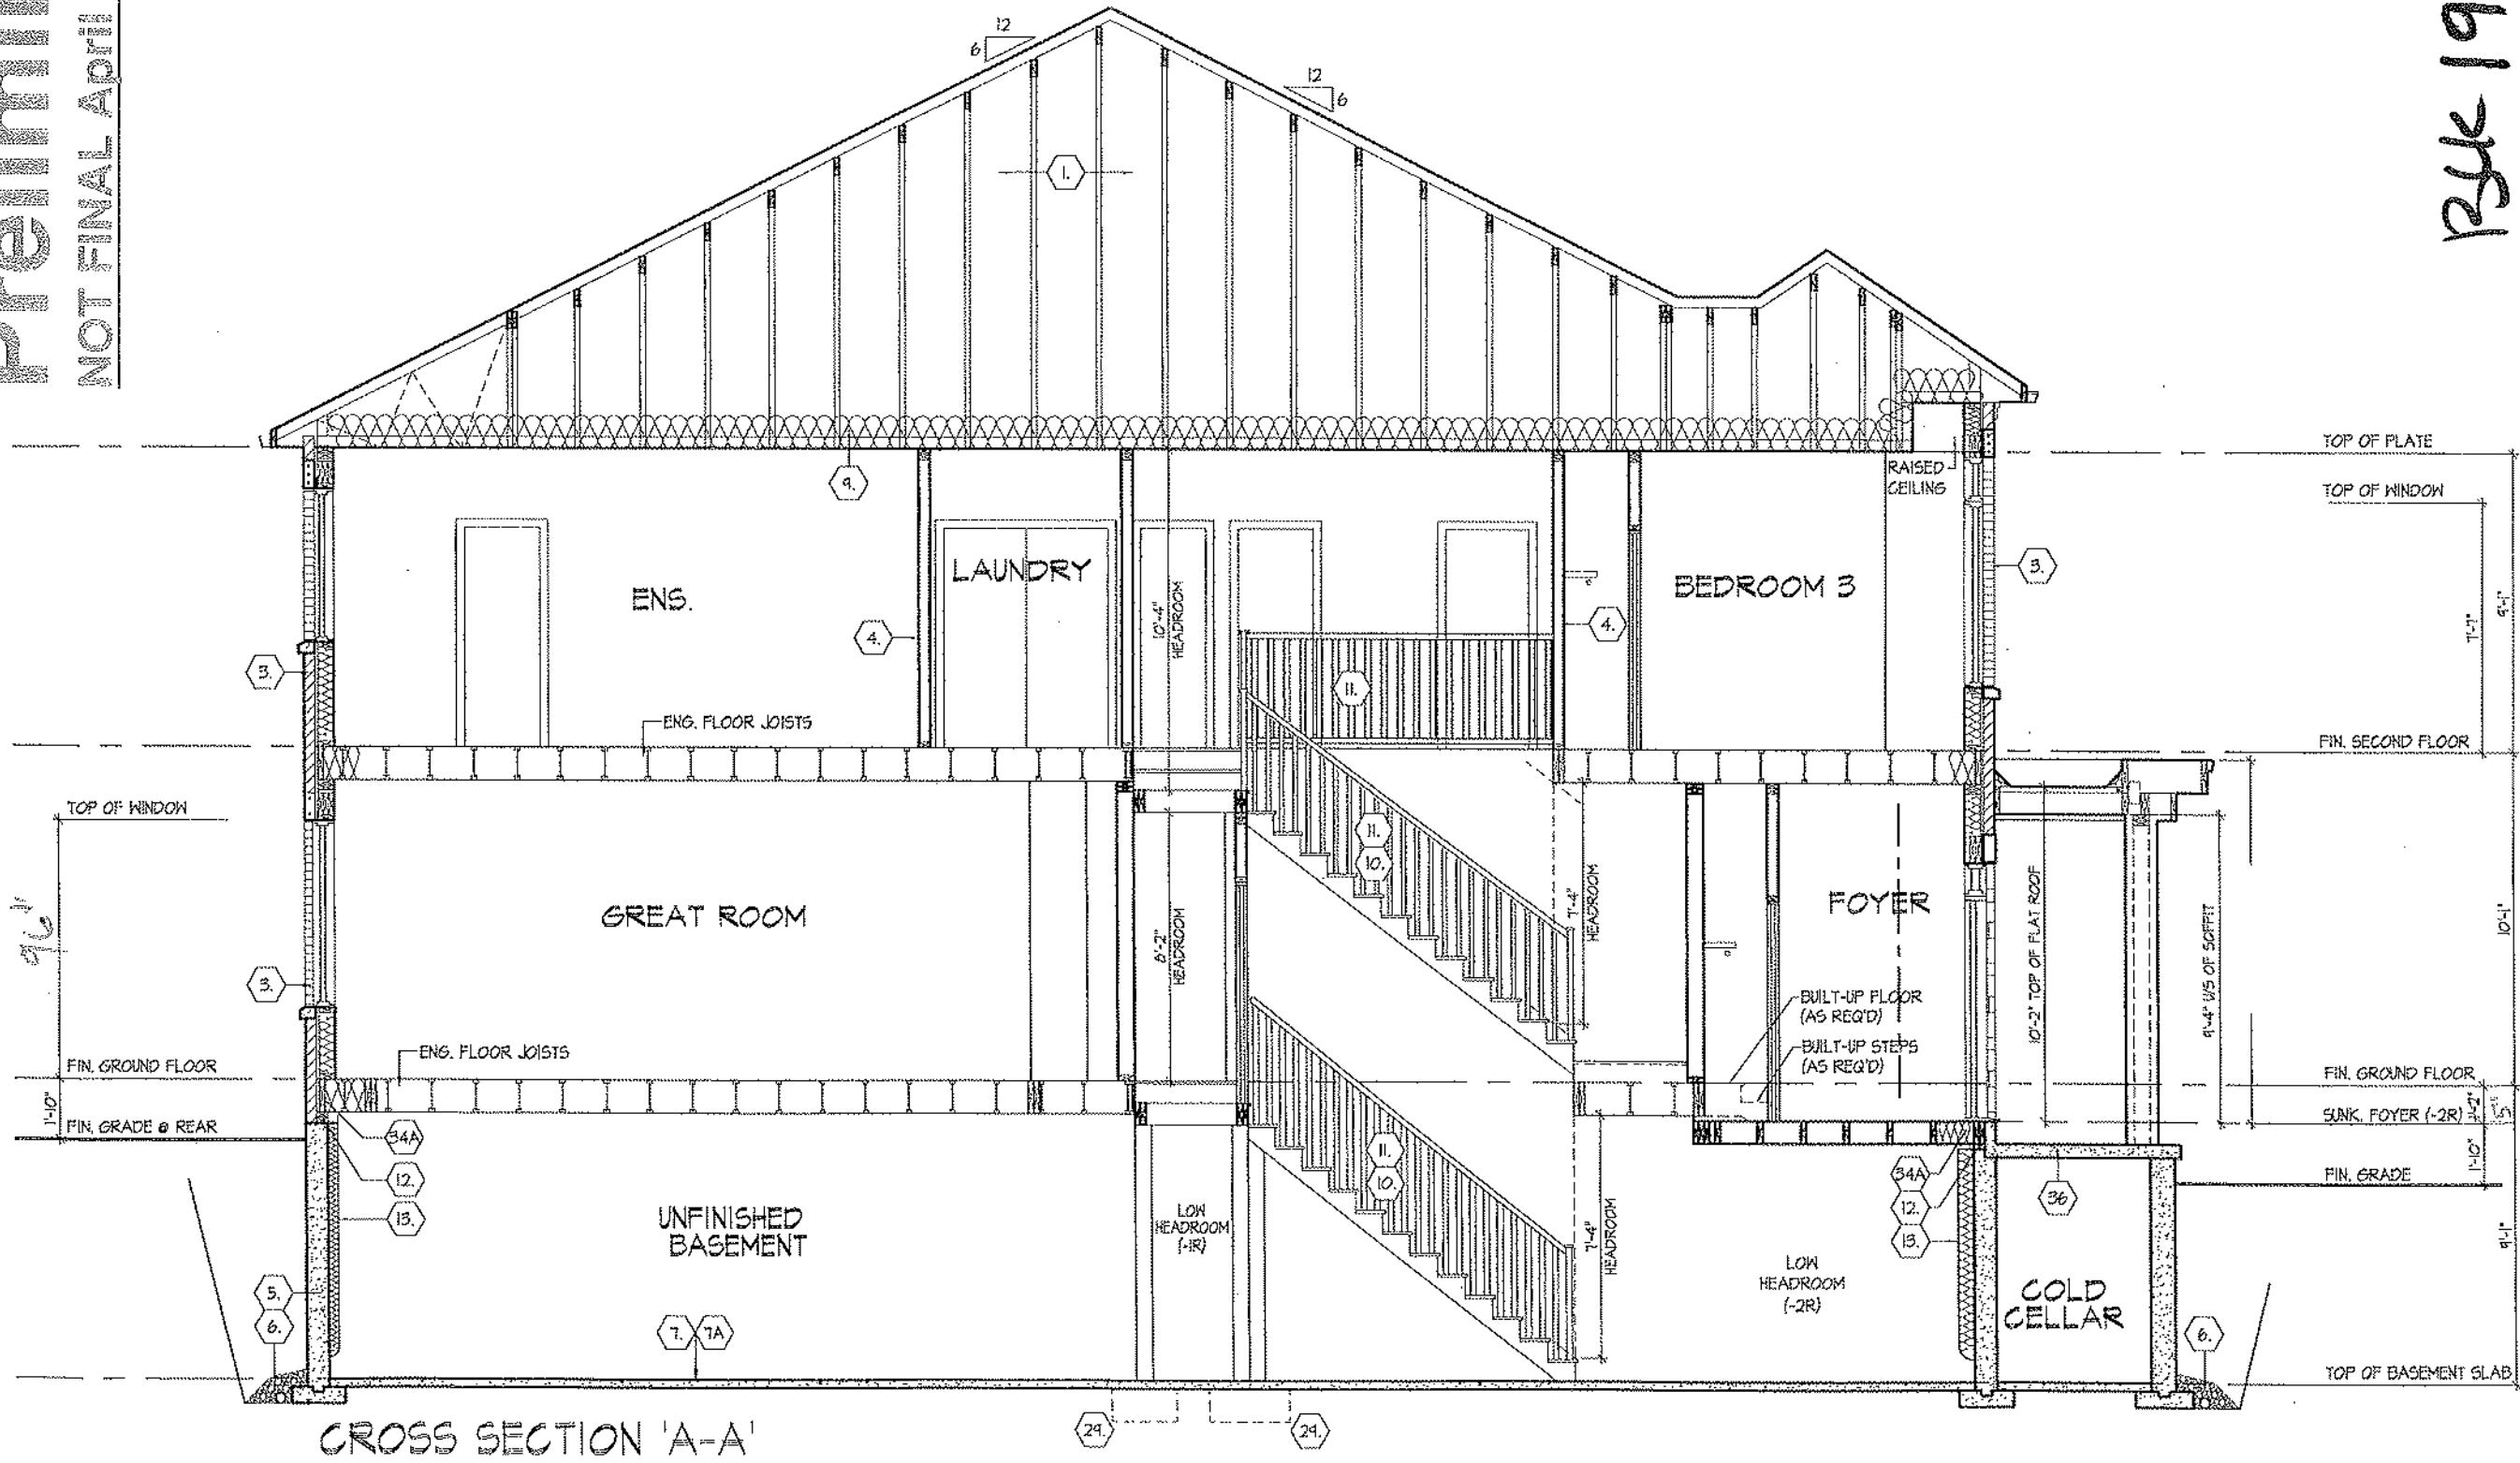

CROSS SECTION 'A-A

CROSS SECTION A-A		UNIT 2018-END		Page 31 of 31	
		REV.2025.03.27			
ROYAL PINE HOMES - 218094		921 BAYVIEW, RICHMOND HILL, ON.			
Kraft		Milds		218094W72018-END	
Drawn by	Checked by	Date	Date	Printed	Page
Kraft	Milds	3/16/2018	1-40"	Feb 05, 2018	28 of 31
DESIGN ASSOCIATES INC.		926 Woodbine Ave, Markham, ON L3R 0J7		F 0957375133	
VANCOUVER MUNICIPAL ENGINEERING CO.		T 9057377326			
1100 10th Street, Vancouver, BC V6E 2L5, Canada					
T 604 685 4000 F 604 685 4001					
Email: info@vancouver.ca					
www.vancouver.ca					
Information contained in this document is the sole property of Royal Pine Homes Inc. It is to be used only for the purpose intended by the client and is not to be reproduced or distributed without the express written consent of Royal Pine Homes Inc.					

SECTION 1.0 CONSTRUCTION NOTES

REFER TO SB-12 ENERGY EFFICIENCY DESIGN MATRIX ON THE TITLE PAGE FOR ALL VALUES AS REQUIRED PER 3.1.1., 3.1.2., 3.1.3. OF THE O.B.C..

ROOF CONSTRUCTION [B.19, 9.23.14, 9.23.16]

- 1** NO. 210 (1.05 KGM2) ASPHALT SHINGLES, 3/8" (9.5) PLYWOOD SHEATHING WITH 1/4" CUP, APPROVED WOOD TRUSSSES @ 24" (600) G.C. MAX APPROVED EAVES PROTECTION TO 24" (600) INCHES FROM EDGE OF ROOF AND MIN. 12" (300) BEYOND INNER FACE OF EXTERIOR WALL, 2 1/4" (38x89) TIE BRACING @ B10-1830 (1.05) O.C. AT BOTTOM CHORD, PRE-FAB, ALUM. EAVESTROUGH FASCIA, RAIL & VENTED ROOF, APPROVED 1:30:00 OF INSULATED CEILING AREA WITH MIN. 25% OF REQUIRED OPENINGS LOCATED AT TOP OF SPACE & MIN. 25% OF REQUIRED OPENINGS LOCATED AT BOTTOM OF SPACE, EAVESTROUGH TO BE 4' MIN. WITH HVAL DISCHARGING ONTO CONCRETE SPLASH PADS OR PER MUNICIPAL REQUIREMENTS. TOWNHOUSES TO HAVE 5' MIN. EAVESTROUGH WITH ELEC. TRACED HEATER CABLE ALONG EAVESTROUGH AND DOWNPIPE.

ICE AND WATER SHIELD

- 1A** PROVIDE ICE AND WATER SHEILD IN THE AREAS INDICATED. THE ICE AND WATER SHEILD SHALL BE A SELF ADHERING AND SELF SEALING MEMBRANE. SIDE LAPS MUST BE A MINIMUM 3 1/2" (90) AND END LAPS, MINIMUM 6" (152), AND TO EXTEND UP DORMER WALLS A MINIMUM 12" (305).

PROFILED ROOF TRUSSES

- 1B** ROOF TRUSSES SHALL BE PROFILED AND/OR STEPPED AT RAISED COPPER/TIN CEILINGS. ANGLED TRAY CEILINGS WILL BE SHEATHED W/ 3/8" (9.5) PLYWOOD. SIDING MATERIAL AS PER ELEVATION ATTACHED TO FRAMING MEMBERS.

SIDING WALL CONSTRUCTION [2x8x6] [3.23.17-31]

- 2** SIDING MATERIALS OR BLOCKING BETWEEN THE FRAMING MEMBERS ON APPROVED SHEATHING PAPER ON 3/8" (9.5) EXTERIOR TYPE SHEATHING ON STUDS CONFORMING TO O.B.C. [B.23.10.1.5] SECTION 1.1, 1/2" (12.7) GYPSUM BOARD INTERIOR AIRVAPUR BARIER, ON 1/2" (12.7) GYPSUM WALLBOARD, APPROVED 6 MIL POLYETHYLENE AIRVAPUR BARIER, ON 1/2" (12.7) GYPSUM WALLBOARD, APPROVED 6 MIL POLYVAPOR BARIER, IN PERIOD FINISH, APPROVED CONTR. AIR BARRIER, 1/2" (12.7) GYPSUM WALLBOARD INTERIOR FINISH, PROVIDED SHEATHING PAPER @ 32" (800) O.C. INT. FIN. (GYPSUM SHEATHING, RIGID INSULATION, AND FIBERBOARD SHEATHING PAPER [B.20.13.6]). REFER TO 35' NOTE AS REQ.)

SIDING WALL CONSTRUCTION (2x8x7) W/ CONTIN. INSULATION

- 2A** SIDING MATERIALS PER ELEVATION ATTACHED TO FURNING MEMBERS ON INSULATION GROUTS UNPAVED MECHANICALLY FASTENED AS PER APPROVED AIRVAPOR BARIER AS PER O.B.C. [B.23.10.1.5] EXTERIOR TYPE SHEATHING, RIGID INSULATION, AND FIBERBOARD SHEATHING, NOT BE USED FOR THE ATTACHMENT OF SIDING. (CANULEC ST52, 9.13.10.17.10)

SIDING WALL CONSTRUCTION (2x8x7) W/ CONTIN. INSULATION

- 2B** SIDING MATERIALS AS PER ELEVATION ATTACHED TO FRAMING MEMBERS, FURNING MEMBERS OR BLOCKING BETWEEN THE FRAMING MEMBERS ON APPROVED SHEATHING PAPER ON 3/8" (9.5) EXTERIOR TYPE SHEATHING ON STUDS CONFORMING TO O.B.C. [B.23.10.1.5] SECTION 1.1, 1/2" (12.7) GYPSUM BOARD INTERIOR AIRVAPUR BARIER, ON 1/2" (12.7) GYPSUM WALLBOARD, APPROVED 6 MIL POLYVAPOR BARIER, IN PERIOD FINISH, APPROVED CONTR. AIR BARRIER, 1/2" (12.7) GYPSUM WALLBOARD INTERIOR FINISH, PROVIDED SHEATHING PAPER @ 32" (800) O.C. INT. FIN. (GYPSUM SHEATHING, RIGID INSULATION, AND FIBERBOARD SHEATHING PAPER [B.20.13.6]). REFER TO 35' NOTE AS REQ.)

SIDING WALL CONSTRUCTION (2x8x7) [3.23.17-31]

- 2** SIDING MATERIALS AS PER ELEVATION ATTACHED TO FRAMING MEMBERS, FURNING MEMBERS OR BLOCKING BETWEEN THE FRAMING MEMBERS ON APPROVED SHEATHING PAPER ON 3/8" (9.5) EXTERIOR TYPE SHEATHING ON STUDS CONFORMING TO O.B.C. [B.23.10.1.5] SECTION 1.1, 1/2" (12.7) GYPSUM BOARD INTERIOR AIRVAPUR BARIER, ON 1/2" (12.7) GYPSUM WALLBOARD, APPROVED 6 MIL POLYVAPOR BARIER, IN PERIOD FINISH, APPROVED CONTR. AIR BARRIER, 1/2" (12.7) GYPSUM WALLBOARD INTERIOR FINISH, PROVIDED SHEATHING PAPER @ 32" (800) O.C. INT. FIN. (GYPSUM SHEATHING, RIGID INSULATION, AND FIBERBOARD SHEATHING PAPER [B.20.13.6]). REFER TO 35' NOTE AS REQ.)

BRICK VENEER WALL CONSTRUCTION

- 3A** 3 1/2" (90) BRICK VENEER 1/2" (50) AIR SPACE, 7/8" (22.2) 3/8" (10.0) GYPSUM WALLBOARD INTERIOR FINISH, APPROVED SHEATHING PAPER @ 32" (800) O.C. INT. FIN. (GYPSUM SHEATHING, RIGID INSULATION, AND FIBERBOARD SHEATHING PAPER [B.20.13.6]). REFER TO 35' NOTE AS REQ.)

BRICK VENEER WALL CONSTRUCTION (2x8x7)

- 3** BRICK VENEER 1/2" (50) AIR SPACE, 7/8" (22.2) 3/8" (10.0) GYPSUM WALLBOARD INTERIOR FINISH, APPROVED SHEATHING PAPER @ 32" (800) O.C. INT. FIN. (GYPSUM SHEATHING, RIGID INSULATION, AND FIBERBOARD SHEATHING PAPER [B.20.13.6]). REFER TO 35' NOTE AS REQ.)

EXT. LOFT WALL CONSTRUCTION [2x8x7] [3.23.17-31]

- 4B** APPROVED AIRVAPOR BARIER AS PER O.B.C. [B.27.3] ON EXTERIOR TYPE SHEATHING, STUDS CONFORMING TO O.B.C. [B.23.10.1.5] SECTION 1.1, 1/2" (12.7) GYPSUM WALLBOARD INTERIOR FINISH, APPROVED CONTR. AIR BARRIER, 1/2" (12.7) GYPSUM WALLBOARD INTERIOR FINISH, PROVIDED SHEATHING PAPER @ 32" (800) O.C. INT. FIN. (GYPSUM SHEATHING, RIGID INSULATION, AND FIBERBOARD SHEATHING PAPER [B.20.13.6]). REFER TO 35' NOTE AS REQ.)

INTERIOR STUD PARTITIONS

- 4** BEARING PARTITIONS SHALL BE A MINIMUM 2x4" (50x89) @ 16" (400) G.C. FOR 2 STOREY, AND 2x6" (600) O.C. FOR 3 STOREY. NON-BEARING PARTITIONS 2x4" (50x89) @ 24" (600) O.C. PROVIDE 2x4" (50x89) BOTTOM PLATE AND 2x2" (50x50) TOP PLATE, 1/2" (12.7) INT. DRYWALL, BOTH SIDES OF STUDS, PROVIDED 2x6" (600) O.C. STUDS WHERE NOTE NOTED. PROVIDE 2x4" (50x89) @ 24" (600) O.C. LADDER FRAMING, WHERE STUDS INTERSECT PERPENDICULAR TO ONE ANOTHER. PROVIDE 2x4" (50x89) STUDS CONFORMING TO O.B.C. [B.23.10.1.5] SECTION 1.1, INSULATION AND 6 mil POLYVAPOR BARIER, IN PERIOD FINISH, PROVIDED SHEATHING PAPER @ 32" (800) O.C. INT. FIN. (GYPSUM SHEATHING, RIGID INSULATION, AND FIBERBOARD SHEATHING PAPER [B.20.13.6]). REFER TO 35' NOTE AS REQ.)

EXT. LOFT WALL CONSTRUCTION (2x8x7) * NO CLADDING [3.23.17-31]

- 4A** 3 1/2" (90) EXTERIOR TYPE SHEATHING, STUD CONFORMING TO O.B.C. [B.23.10.1.5] SECTION 1.1, INSULATION AND 6 mil POLYVAPOR BARIER, IN PERIOD FINISH, PROVIDED SHEATHING PAPER @ 32" (800) O.C. INT. FIN. (GYPSUM SHEATHING, RIGID INSULATION, AND FIBERBOARD SHEATHING PAPER [B.20.13.6]). REFER TO 35' NOTE AS REQ.)

INTERIOR STUD PARTITIONS

- 4** POURED CONC. FOUNDATION WALL AS PER CHART BELOW ON CONTINUOUS CONCRETE FOOTING FOUNDATION WALLS SHALL EXEND NOT LESS THAN 6' (1830) ABOVE FINISHED GRADE. THE CUTLINE OF THE FOUNDATION SHALL BE DRAINED OFF FROM THE TOP OF THE FOOTING TO THE FINISHED GRADE AND BRUSH COAT FROM THE TOP TO 2' BELOW GRADE. PROVIDE A DRAINAGE LAYER ON THE OUTSIDE OF THE FOUNDATION WALL, SEAL THE DRILLED HOLE AT THE TOP. THE TOP OF THE CONC. FOOTING SHALL BE DAMPROOFED CONCRETE FOOTINGS SUPPORTING JOIST SPANS GREATER THAN 16' (4800) SHALL BE REINFORCED IN ACCORDANCE WITH 3.15.3(1)(8)(2) OF THE O.B.C. REFER TO CHART BELOW FOR RESPECTIVE SIZE, BRACE FOUNDATION WALL PRIOR TO BACKFILLING. ALL FOOTINGS SHALL REST ON NATURALUNDISTURBED SOIL OF 75KPa OR COMPACTED ENGINEERED FILL WITH MIN. BEARING CAPACITY OF 150Kpa. IF SOIL BEARING DOES NOT MEET MINIMUM CAPACITY, ENGINEERED FOOTINGS ARE REQUIRED. ACTUAL SOIL BEARING CAPACITY TO BE VERIFIED WITH SOR ENGINEERING REPORT.

FOUNDATION WALL FOOTINGS

- 5** REFER TO CONSTRUCTION DRAWINGS AND DETAILS FOR FOUNDATION WALL STRENGTH AND THICKNESS AND 3.15.4. REFER TO 35' NOTE AS REQ.) HEIGHT UNLESS OTHERWISE NOTED. (3.15.4.2.1)

UNREINFORCED SOLID CONCRETE FOUNDATION WALLS [3.15.4.2.]

- 5** MAX. HEIGHT FROM IN. SLAB TO GRADE SUPPORTED AT TOP
- | EX | IN | SLAB | AT TOP | -\$2.5m | >2.5m & <2.75m | >2.75m & <3.0m | >3.0m & <3.25m | >3.25m & <3.5m | >3.5m & <3.75m | >3.75m & <4.0m | >4.0m & <4.25m |
|----|-----|----------------|---------------|---------------|----------------|----------------|----------------|----------------|----------------|----------------|----------------|
| 3 | 8' | 3'-11" (1.22m) | 7'-0" (2.15m) | 7'-0" (2.15m) | 7'-0" (2.15m) | 7'-0" (2.15m) | 7'-0" (2.15m) | 7'-0" (2.15m) | 7'-0" (2.15m) | 7'-0" (2.15m) | 7'-0" (2.15m) |
| 4 | 10' | 4'-11" (1.46m) | 7'-0" (2.15m) | 7'-0" (2.15m) | 7'-0" (2.15m) | 7'-0" (2.15m) | 7'-0" (2.15m) | 7'-0" (2.15m) | 7'-0" (2.15m) | 7'-0" (2.15m) | 7'-0" (2.15m) |
| 5 | 12' | 5'-11" (1.76m) | 7'-0" (2.15m) | 7'-0" (2.15m) | 7'-0" (2.15m) | 7'-0" (2.15m) | 7'-0" (2.15m) | 7'-0" (2.15m) | 7'-0" (2.15m) | 7'-0" (2.15m) | 7'-0" (2.15m) |
| 6 | 10' | 4'-11" (1.46m) | 7'-0" (2.15m) | 7'-0" (2.15m) | 7'-0" (2.15m) | 7'-0" (2.15m) | 7'-0" (2.15m) | 7'-0" (2.15m) | 7'-0" (2.15m) | 7'-0" (2.15m) | 7'-0" (2.15m) |
| 7 | 12' | 4'-11" (1.50m) | 7'-0" (2.15m) | 7'-0" (2.15m) | 7'-0" (2.15m) | 7'-0" (2.15m) | 7'-0" (2.15m) | 7'-0" (2.15m) | 7'-0" (2.15m) | 7'-0" (2.15m) | 7'-0" (2.15m) |

NON-ADJUSTABLE STEEL BASEMENT COLUMN

- 15A** SUPPORTING 3 STORY FLR. LOAD PROVIDED 40x40x18" (1065x160x480) CONC. FOOTING SUPPORTING 3 STORY FLR. LOAD PROVIDED 40x40x24" (1065x160x560) CONC. FOOTING

NON-ADJUSTABLE STL. COLUMN AT FOUNDATION WALL [3.15.3]

- 15B** 3 1/2" (90) X 1.08" (4.76) NON-ADJUSTABLE STEEL COLUMN WITH 6x8x38" (152x200x9.5) TOP PLATE & 2x4" (50x89) CONNECTION, POURED CONCRETE FOOTING ON NATURAL INDUSTRIED SOIL, CF 75KPa OR COMPACTED ENGINEERED FILL WITH MIN. BEARING CAPACITY OF 150Kpa AS PER SOILS REPORT.

SUPPORTING 2 STORY FLR. LOAD PROVIDED 40x40x18" (1065x160x480) CONC. FOOTING

SUPPORTING 3 STORY FLR. LOAD PROVIDED 40x40x24" (1065x160x560) CONC. FOOTING

- 15C** 3 1/2" (90) X 1.08" (4.76) NON-ADJUSTABLE STEEL COLUMN WITH 6x8x38" (152x200x9.5) TOP PLATE & 2x4" (50x89) CONNECTION, POURED CONCRETE FOOTING ON NATURAL INDUSTRIED SOIL, CF 75KPa OR COMPACTED ENGINEERED FILL WITH MIN. BEARING CAPACITY OF 150Kpa AS PER SOILS REPORT.

STEEL BEAM BEARING AT FOUNDATION WALL [3.23.8.1]

- 16** BEAM FOOTER OR 3x8" (200x220) POURED CONC. NB WALLS, MN. BEARING 3 1/2" (90) CONC. NB WALLS TO HAVE EXTENDED FOOTINGS

WOOD STRAPPING AT STEEL BEAMS [3.23.8.3]

- 17** 1/2" (15.24) CONC. NB WALLS STRAPPING BOTH SIDES OF STEEL BEAM.

FOUNDATIONS

- 1** REFER TO 35' NOTE AS PER SCAFFOLDING REQUIREMENTS.

SOIL TESTS

- 2** REFER TO 35' NOTE AS PER SCAFFOLDING REQUIREMENTS.

SOIL TESTS

