

Indulgence - 1 - 1 - Alta Vista Elev. A

Registere Plan Number: Municipal Address: 555 Highvalley Drive Closing: 15-Sep-20

CABINETRY

Inv. 92	1 - HIGHER UPPER CABINET IN KITCHEN
6	
Line 1197	Note:
13Apr20 / 13Apr20	
Inv. 174	1 - KITCHEN: INSTALL LEVEL 8 CABINET
51	
Line 2337	Note:
18Sep20 / 23Sep20	
Inv. 174	1 - SERVERY: INSTALL LEVEL 8 CABINET
52	
Line 2338	Note:
18Sep20 / 23Sep20	
Inv. 174	1 - POWDER ROOM: INSTALL LEVEL 7 CABINET
53	
Line 2339	Note:
18Sep20 / 23Sep20	
Inv. 174	1 - DEN ENSUITE: INSTALL LEVEL 7 CABINET
54	
Line 2340	Note:
18Sep20 / 23Sep20	
Inv. 174	1 - MASTER ENSUITE: INSTALL LEVEL 6 CABINET
55	
Line 2341	Note:
18Sep20 / 23Sep20	
Inv. 174	1 - KITCHEN: INSTALL TWO-TONE COLOUR FOR BASE CABINETS IN KITCHEN AREA ONLY (NOT SERVEY) (40J)
84	
Line 2370	Note:
18Sep20 / 23Sep20	
Inv. 174	1 - KITCHEN: INSTALL TWO-TONE COLOUR FOR ISLAND CABINETS (40J)
85	
Line 2371	Note:
18Sep20 / 23Sep20	
Inv. 174	1 - KITCHEN: INSTALL UPGRADE 2 HARDWARE THROUGHOUT KITCHEN AND SERVERY (03G)
86	
Line 2372	Note:
18Sep20 / 23Sep20	
Inv. 174	1 - KITCHEN: INSTALL STACKED CABINETS (03A)
87	
Line 2373	Note:
18Sep20 / 23Sep20	
Inv. 174	1 - SERVERY: INSTALL STACKED CABINETS (03A)
88	
Line 2374	Note:
18Sep20 / 23Sep20	
Inv. 174	1 - PANTRY: INSTALL STACKED CABINETS (03A)
89	
Line 2375	Note:
18Sep20 / 23Sep20	



CONSTRUCTION SUMMARY

Indulgence - 1 - 1 - Alta Vista Elev. A

Register Plan Number: Municipal Address: **555 Highvalley Drive** Closing: **15-Sep-20**

Inv. 174 90	1 - LAUNDRY/MUD ROOM: INSTALL STACKED CABINETS (03A)	
Line 2376	Note:	
18Sep20 / 23Sep20		
Inv. 174 91	1 - KITCHEN: INSTALL SOFT CLOSE CABINETS	
Line 2377	Note:	
18Sep20 / 23Sep20		
Inv. 174 92	1 - KITCHEN: INSTALL VALANCE LIGHTING IN KITCHEN/ SERVERY	
Line 2378	Note:	
18Sep20 / 23Sep20		
Inv. 174 93	7 - KITCHEN: INSTALL SEVEN (7) TOP DRAWERS IN KITCHEN (09B)	
Line 2379	Note:	
18Sep20 / 23Sep20		
Inv. 174 94	1 - KITCHEN: INSTALL POT AND PAN DRAWER IN PANTRY (17B)	
Line 2380	Note:	
18Sep20 / 23Sep20		
Inv. 174 95	1 - KITCHEN: INSTALL POT AND PAN DRAWERS IN KITCHEN	
Line 2381	Note:	
18Sep20 / 23Sep20		
Inv. 174 96	1 - INSTALL POT AND PAN DRAWER IN SERVERY (13B)	
Line 2382	Note:	
18Sep20 / 23Sep20		
Inv. 174 97	2 - KITCHEN: INSTALL TWO (2) ALUMINUM FRAMED DOORS IN KITCHEN, ON EITHER SIDE OF STOVE (24A)	
Line 2383	Note:	
18Sep20 / 23Sep20		
Inv. 174 98	2 - KITCHEN: INSTALL TWO (2) ALUMINUM FRAMED DOORS IN SERVERY, ON EITHER SIDE OF WINDOW (24A)	
Line 2384	Note:	
18Sep20 / 23Sep20		
Inv. 174 99	1 - KITCHEN: INSTALL SPICE RACK BESIDE STOVE (21B)	
Line 2385	Note:	
18Sep20 / 23Sep20		
Inv. 174 100	1 - KITCHEN: INSTALL RECYCLE CENTRE BESIDE SINK (20B)	
Line 2386	Note:	
18Sep20 / 23Sep20		
Inv. 174 101	1 - KITCHEN: INSTALL 48" RANGETOP CABINET (26H)	
Line 2387	Note:	
18Sep20 / 23Sep20		
Inv. 174 102	1 - SERVERY: PREPARE CABINET IN SERVERY FOR WINE FRIDGE	
Line 2388	Note:	
18Sep20 / 23Sep20		



CONSTRUCTION SUMMARY

Indulgence - 1 - 1 - Alta Vista Elev. A

Registere Plan Number: Municipal Address: 555 Highvalley Drive Closing: 15-Sep-20

Inv. 174 103 Line 2389 18Sep20 / 23Sep20	1 - LAUNDRY ROOM: INSTALL BANK OF DRAWERS BESIDE SINK (11B) Note:
Inv. 174 104 Line 2390 18Sep20 / 23Sep20	2 - DEN ENSUITE: INSTALL TWO (2) TOP DRAWERS IN VANITY (11D) Note:
Inv. 174 105 Line 2391 18Sep20 / 23Sep20	2 - ENSUITE 2: INSTALL TWO (2) TOP DRAWERS IN VANITY (11D) Note:
Inv. 174 106 Line 2392 18Sep20 / 23Sep20	1 - MASER ENSUITE: INSTALL HUTCH WITH 2 FROSTED GLASS DOORS AND MATCHING INTERIOR (36A) Note:
Inv. 174 107 Line 2393 18Sep20 / 23Sep20	6 - ALL VANITIES: INCREASE THE HEIGHT OF ALL VANITIES TO KITCHEN HEIGHT TOTAL SIX (6). (03D) POWDER ROOM, DEN ENS., ENSUITE 2, 3, 4, AND MASTER Note:

CEILING

Inv. 92 7 Line 1198 13Apr20 / 13Apr20	1 - WAFFLED CEILING IN GREAT ROOM AND DINING ROOM Note:
Inv. 131 37 Line 1773 8Jul20 / 13Jul20	1 - 2ND FLOOR: INSTALL SMOOTH CEILING ON SECOND FLOOR Note:

CERAMIC TILE

Inv. 92 3 Line 1194 13Apr20 / 13Apr20	1 - MINIMUM OF 24" X 24" PORCELAIN TILE Note:
Inv. 174 59 Line 2345 18Sep20 / 23Sep20	1 - FOYER: INSTALL UPGRADE 6 TILE Note:
Inv. 174 60 Line 2346 18Sep20 / 23Sep20	1 - SIDE HALL: INSTALL UPGRADE 6 TILE Note:
Inv. 174 61 Line 2347 18Sep20 / 23Sep20	1 - POWDER ROOM: INSTALL UPGRADE 6 TILE Note:



CONSTRUCTION SUMMARY

Indulgence - 1 - 1 - Alta Vista Elev. A

Registere Plan Number: Municipal Address: 555 Highvalley Drive Closing: 15-Sep-20

Inv.174	1 - LAUNDRY/MUD ROOM: INSTALL UPGRADE 6 TILE
62	
Line 2348	Note:
18Sep20 / 23Sep20	
Inv.174	1 - KITCHEN/ BREAKFAST AREA: INSTALL UPGRADE 6 TILE
63	
Line 2349	Note:
18Sep20 / 23Sep20	
Inv.174	1 - BASEMENT LANDING: INSTALL UPGRADE 6 TILE
64	
Line 2350	Note:
18Sep20 / 23Sep20	
Inv.174	1 - MAIN HALL: INSTALL UPGRADE 6 TILE
65	
Line 2351	Note:
18Sep20 / 23Sep20	
Inv.174	1 - SERVERY/ PANTRY: INSTALL UPGRADE 6 TILE
66	
Line 2352	Note:
18Sep20 / 23Sep20	
Inv.174	1 - MASTER ENSUITE: INSTALL UPGRADE 5 TILE ON FLOOR
67	
Line 2353	Note:
18Sep20 / 23Sep20	
Inv.174	1 - DEN ENSUITE: INSTALL UPGRADE 3 TILE ON SHOWER WALL
68	
Line 2354	Note:
18Sep20 / 23Sep20	
Inv.174	1 - ENSUITE 2: INSTALL UPGRADE 4 TILE ON SHOWER WALL
69	
Line 2355	Note:
18Sep20 / 23Sep20	
Inv.174	1 - ENSUITE 3: INSTALL UPGRADE 3 TILE ON SHOWER WALL
70	
Line 2356	Note:
18Sep20 / 23Sep20	
Inv.174	1 - ENSUITE 4: INSTALL UPGRADE 3 TILE ON SHOWER WALL
71	
Line 2357	Note:
18Sep20 / 23Sep20	
Inv.174	1 - MASTER ENSUITE: INSTALL UPGRADE 5 TILE ON SHOWER WALL
72	
Line 2358	Note:
18Sep20 / 23Sep20	

CONSTRUCTION

Inv.131	1 - BASEMENT: INSTALL COLD CELLAR
42	
Line 1781	Note:
8Jul20 / 13Jul20	



CONSTRUCTION SUMMARY

Indulgence - 1 - 1 - Alta Vista Elev. A

Registere Plan Number: Municipal Address: 555 Highvalley Drive Closing: 15-Sep-20

Inv.131 31 Line 1767 8Jul20 / 13Jul20	1 - DEN: INSTALL A DOUBLE DOOR ENTRY INTO THE DEN. TOTAL WIDTH OF DOORS TO BE 5' WIDE AND DELETE CLOSET Note:
Inv.131 32 Line 1768 8Jul20 / 13Jul20	1 - MASTER ENSUITE: ENLARGE DOOR INTO TOILET ROOM, LIKE LOT 4, IN ENSUITE Note:
Inv.131 33 Line 1769 8Jul20 / 13Jul20	1 - FOYER: DELETE LOW ARCH BETWEEN FOYER AND MAIN HALL Note:
Inv.131 34 Line 1770 8Jul20 / 13Jul20	1 - EXTERIOR @ MASTER BEDROOM: INSTALL COVERED PORCH OFF OF MASTER BEDROOM Note:
Inv.131 35 Line 1771 8Jul20 / 13Jul20	1 - EXTERIOR @ MASTER BEDROOM: INSTALL DOUBLE FRENCH DOORS TO COVERED PORCH OFF OF MASTER BEDROOM Note:
Inv.131 36 Line 1772 8Jul20 / 13Jul20	1 - EXTERIOR: CHANGE THE STUCCO ON THE FRONT OF THE HOUSE TO BRICK Note:
Inv.131 21 Line 1758 8Jul20 / 13Jul20	1 - MASTER ENSUITE: INSTALL SHOWER SEAT IN MASTER ENSUITE Note:
Inv.131 29 Line 1765 8Jul20 / 13Jul20	1 - MASTER BEDROOM: DELETE CENTRE WALL IN MASTER BEDROOM WALK-IN CLOSET AND RELOCATE DOORS INTO CLOSET AS SHOWN ON FLOOR PLAN Note:

COUNTERTOP

Inv.92 2 Line 1193 13Apr20 / 13Apr20	1 - ALL COUNTERS TO HAVE QUARTZ OR GRANITE Note:
Inv.174 56 Line 2342 18Sep20 / 23Sep20	1 - KITCHEN - SERVERY: INSTALL MSI 2 THROUGHOUT KITCHEN AND SERVERY Note:
Inv.174 57 Line 2343 18Sep20 / 23Sep20	1 - KITCHEN: INSTALL WATERFALL LEGS IN MSI 2 ON KITCHEN ISLAND Note:
Inv.174 58 Line 2344 18Sep20 / 23Sep20	1 - KITCHEN: INSTALL MSI 2 STONE ON BACKSPLASH OF KITCHEN AND SERVERY Note:

ELECTRICAL



CONSTRUCTION SUMMARY

Indulgence - 1 - 1 - Alta Vista Elev. A

Registere Plan Number: Municipal Address: 555 Highvalley Drive Closing: 15-Sep-20

Inv.131 24 Line 1793 8Jul20 / 13Jul20	2 - EXTERIOR PORCH POT LIGHTS- OFF MAIN FLOOR AND MASTER BEDROOM: INSTALL - TWO (2) DIMMER SWITCHES FOR LED POT LIGHTS. Note:
Inv.131 16 Line 1794 8Jul20 / 13Jul20	8 - EXTERIOR PORCH CEILINGS- OFF MAIN AND MASTER BEDROOM: INSTALL EIGHT (8) POT LIGHTS - 4" LED - EXTERIOR SOFFITS FOUR ON EACH PORCH CEILING Note:
Inv.131 17 Line 1795 8Jul20 / 13Jul20	2 - EXTERIOR CEILING, PORCH OFF MAIN FLOOR AND MASTER BEDROOM: INSTALL TWO (2) LIGHT ROUGH IN - EXTERIOR - ON EXISTING SWITCH ONE IN THE CENTRE OF EACH CEILING Note:
Inv.174 48 Line 2334 18Sep20 / 23Sep20	1 - KITCHEN: INSTALL RECEPTACLES - ADDITIONAL 15 AMP 120 VOLT RECEPTABLE FOR GAS STOVE Note:
Inv.174 49 Line 2335 18Sep20 / 23Sep20	1 - KITCHEN: INSTALL RECEPTACLES - DEDICATED 15 AMP 120 VOLT RECEPTABLE FOR FREEZER Note:
Inv.174 50 Line 2336 18Sep20 / 23Sep20	1 - SERVERY: INSTALL RECEPTACLES - DEDICATED 15 AMP 120 VOLT RECEPTABLE FOR WINE FRIDGE Note:
Inv.92 4 Line 1195 13Apr20 / 13Apr20	1 - 30 PT LIGHTS Note:
Inv.131 8 Line 1739 8Jul20 / 13Jul20	1 - BELL AND CABLE LOCATION SKETCH. LOCATIONS MAY VARY SLIGHTLY DUE TO JOIST LOCATIONS Note:
Inv.131 11 Line 1742 8Jul20 / 13Jul20	6 - INSTALL SIX (6) RECEPTACLES - DEDICATED 15 AMP 120 VOLT RECEPTABLE FOR TV'S ON THE WALLS. TO GO ABOVE FIREPLACE IN THE GREAT ROOM AND MASTER BEDROOM, BED #2, #3, #4 AND IN THE DEN. Note:
Inv.131 14 Line 1747 8Jul20 / 13Jul20	1 - KITCHEN: MOVE CEILING FIXTURE - RELOCATE STANDARD CEILING FIXTURE- TO GO OVER ISLAND. SEE SKETCH Note:
Inv.131 15 Line 1748 8Jul20 / 13Jul20	16 - INSTALL SIXTEEN (16) ADDITIONAL POT LIGHTS - 4" LED NON-INSULATED CEILINGS. NOTE 30 WERE STANDARD IN APS. LOCATIONS ARE LISTED ON THE FLOOR PLAN Note:
Inv.131 23 Line 1760 8Jul20 / 13Jul20	6 - MAIN FLOOR POT LIGHTS: INSTALL SIX (6) SWITCHES - DIMMER FOR LED POT LIGHTS. DIMMERS TO GO IN KITCHEN, BREAKFAST AREA, GREAT ROOM, MAIN HALL AND DEN LOCATIONS. Note:



CONSTRUCTION SUMMARY

Indulgence - 1 - 1 - Alta Vista Elev. A

Registere Plan Number: Municipal Address: 555 Highvalley Drive Closing: 15-Sep-20

Inv.131	1 - KITCHEN: INSTALL VALANCE LIGHTING - UNDER CABINET - INCLUDING SERVERY
25	
Line 1761	Note:
8Jul20 / 13Jul20	

FIREPLACE

Inv.131	1 - MASTER BEDROOM: INSTALL FIREPLACE ON WALL THAT BACKS ONTO THE CLOSET
30	
	ALLURAVISION 42" SLIM ELECTRIC FIREPLACE, GLASS FRONT AND BACK
Line 1766	MODEL#NEFL42CHS
	Note:
8Jul20 / 13Jul20	
Inv.174	1 - GREAT ROOM: UPGRADE STANDARD MANTLE TO PF 51
81	
Line 2367	Note:
18Sep20 / 23Sep20	

HARDWOOD FLOORING

Inv.92	1 -
1	5" HARDWOOD FLOORS IN ALL BEDROOMS, UPPER LANDING, DEN, GREAT ROOM AND DINING ROOM
Line 1192	Note:
13Apr20 / 13Apr20	
Inv.174	1 - DINING ROOM: INSTALL LEVEL 3 HARDWOOD
76	
Line 2362	Note:
18Sep20 / 23Sep20	
Inv.174	1 - DEN: INSTALL LEVEL 3 HARDWOOD
77	
Line 2363	Note:
18Sep20 / 23Sep20	
Inv.174	1 - GREAT ROOM: INSTALL LEVEL 3 HARDWOOD
78	
Line 2364	Note:
18Sep20 / 23Sep20	
Inv.174	1 - SECOND FLOOR: INSTALL LEVEL 3 HARDWOOD THROUGHOUT
79	
Line 2365	Note:
18Sep20 / 23Sep20	

HVAC

Inv.174	1 - KITCHEN: INSTALL GAS PIPING AND OTHER - UPGRADE STOVE VENT FROM 6 INCH TO 10 INCH - DOES NOT INCLUDE MAKE - UP AIR IF REQUIRED - EACH
46	
Line 2332	Note:
18Sep20 / 23Sep20	
Inv.174	1 - KITCHEN: INSTALL GAS PIPING AND OTHER - GAS LINE R/I FOR MAIN FLOOR - STOVE - UP TO 3/4 INCH LINE
47	
Line 2333	Note:
18Sep20 / 23Sep20	

INTERIOR DOORS & TRIM



CONSTRUCTION SUMMARY

Indulgence - 1 - 1 - Alta Vista Elev. A

Registere Plan Number: Municipal Address: 555 Highvalley Drive Closing: 15-Sep-20

Inv.174	10 - MAIN FLOOR ONLY: UPGRADE TEN (10) MAIN FLOOR DOORS TO MASONITE EXPO HERITAGE SERIES LOGAN MOULDED PANEL DOOR
74	
Line 2360	(DOES NOT INCLUDE DEN) Note:
18Sep20 / 23Sep20	
Inv.174	1 - DEN: INSTALL ONE (1) NO PANEL FROSTED SHAKER FRENCH DOOR.
75	
Line 2361	Note:
18Sep20 / 23Sep20	
Inv.92	1 - 8' SOLID DOORS THOUGHOUT INTERIOR
5	4" CASING WITH BACKBAND
	8" BASEBOARDS
Line 1196	Note:
13Apr20 / 13Apr20	

MISCELLANEOUS

Inv.131	4 - INSTALL FRAMELESS SHOWER ENCLOSURES IN: MASTER ENSUITE, BED #2, BED #4 AND
38	DEN
Line 1774	Note:
8Jul20 / 13Jul20	
Inv.131	1 - Purchaser has attended a Structural appointment at the Decor Centre & has DECLINED any additional
44	upgrades and accepts and acknowledges that there will be no further structural
	changes/additions/deletions to be made upon signing
Line 1782	Note:
8Jul20 / 13Jul20	
Inv.131	1 - Purchasers are aware & accepts that ANY changes made to upgrades after signing this Purchasers
45	Extra Form are subject to a minimum administration fee
Line 1783	Note:
8Jul20 / 13Jul20	
Inv.131	1 - BONUS PACKAGE: \$7500.00 WORTH OF UPGRADES FROM VALERY HOMES DÉCOR
43	CENTRE IS BEING APPLIED TOWARD THE COLOUR APPOINTMENT.
Line 1784	Note:
8Jul20 / 13Jul20	
Inv.174	1 - Purchaser has attended a Colour appointment at the Decor Centre & has DECLINED any additional
108	upgrades and accepts and acknowledges that there will be no further structural
	changes/additions/deletions to be made
Line 2394	Note:
18Sep20 / 23Sep20	
Inv.174	1 - Purchasers are aware & accepts that ANY changes made to upgrades after signing this Purchasers
109	Extra Form are subject to a minimum administration fee
Line 2395	Note:
18Sep20 / 23Sep20	

PAINT

Inv.174	1 - STAIRCASE: STAIN TWO SETS OF STAIRS
80	
Line 2366	Note:
18Sep20 / 23Sep20	

PLUMBING



CONSTRUCTION SUMMARY

Indulgence - 1 - 1 - Alta Vista Elev. A

Registere Plan Number: Municipal Address: 555 Highvalley Drive Closing: 15-Sep-20

Inv.174	1 - KITCHEN: UPGRADE KITCHEN SINK TO
73	
Line 2359	STRIVE K-5282-NA
	Note:
18Sep20 / 23Sep20	
Inv.131	4 - INSTALL FOUR (4) HAND HELD SHOWERS: IN MASTER , ENSUITE 2, 3 AND DEN
39	
	POSI-TEMP SHOWER ONLY WITH 3 FUNCTION TRANSFER VALVE/TRIM AND SLIDE BAR WITH HAND SHOWER
	MODEL# TL182EP/ 3372/T4171/ 62320/ 3669EP/ A725
Line 1775	Note:
8Jul20 / 13Jul20	
Inv.131	1 - KITCHEN: INSTALL POT FILLER
40	
	MODERN 2 HANDLE POT FILLER FAUCET WITH DUAL SHUT-OFFS
	MODEL # S665 SRS
Line 1776	Note:
8Jul20 / 13Jul20	
Inv.131	1 - MASTER ENSUITE: INSTALL SHOWER HEAD - RAINSHOWER HEAD. **PLUMBING
22	ONLY** TO COME FROM CEILING, NOT WALL.
	INSTALL STANDARD SHOWER HEAD AND PURCHASER WILL REPLACE AFTER CLOSING.
Line 1759	Note:
8Jul20 / 13Jul20	
Inv.131	1 - BACKFLOW PREVENTER VALVE
26	
Line 1762	Note:
8Jul20 / 13Jul20	
Inv.131	1 - KITCHEN: INSTALL EXTRA ROUGH-IN LINE FOR FRIDGE ICE MAKER WITH SHUT-OFF
27	
Line 1763	Note:
8Jul20 / 13Jul20	
Inv.131	1 - SERVERY: INSTALL BAR SINK IN SERVEY . SEE SKETCH
28	
Line 1764	Note:
8Jul20 / 13Jul20	

STAIRS

Inv.174	1 - STAIRCASE: UPGRADE TO DISPLAY 2B SPOON SERIES, 1/2" METAL SINGLE SPOON/DBL
82	SPOON, TEXTURED BLACK
Line 2368	Note:
18Sep20 / 23Sep20	
Inv.174	1 - STAIRCASE: UPGRADE TO VICTORIAN POSTS WITH CAP
83	
Line 2369	Note:
18Sep20 / 23Sep20	

VACCUM/BELL

CONSTRUCTION SUMMARY

Indulgence - 1 - 1 - Alta Vista Elev. A

Register Plan Number: Municipal Address: 555 Highvalley Drive Closing: 15-Sep-20


Inv. 131	6 - INSTALL SIX (6) CONDUITS - 1 1/4" ORANGE FLEX CONDUIT APPROX. 35FT FOR TV'S ON THE WALLS. TO GO ABOVE FIREPLACE IN THE GREAT ROOM AND MASTER BEDROOM, BED #2, #3, #4 AND IN THE DEN. Note: IN BEDROOMS THEY ARE TO BE PLACED 6 FEET UP FROM THE FINISHED FLOORS WITH THE OTHER CONDUIT RIGHT BELOW AT STANDARD PLUG LEVEL
8Jul20 / 13Jul20	HEIGHT ABOVE BOTH FIREPLACES TO BE AS PER USUAL.
Inv. 131	1 - CENTRAL VACUUM - CENTRAL VAC PIPING COMPLETE TO GARAGE - ONE OUTLET IN BASEMENT
18	Note:
Line 1754	
8Jul20 / 13Jul20	
Inv. 131	1 - SURROUND SOUND - ROUGH-IN SPEAKER WIRES (X5) SUBWOOFER CABLE (X1) 6.5 INCH SPEAKER ROUGH-IN BRACKETS (X5)
20	Note:
Line 1755	
8Jul20 / 13Jul20	
Inv. 131	1 - CENTRAL VACUUM - CENTRAL VAC KICKPLATE ROUGH-IN ONLY
19	Note:
Line 1757	
8Jul20 / 13Jul20	
Inv. 131	1 - INSTALL CONDUIT - 1 1/4" ORANGE FLEX CONDUIT APPROX. 15FT FOR ATTIC
12	Note:
Line 1743	
8Jul20 / 13Jul20	
Inv. 131	1 - INSTALL: WIRELESS ACCESS POINT PACKAGE - 2-CAT6 NETWORK CABLES AND 2-UBIQUITI AC LITE ACCESS POINTS. TO GO IN GREAT ROOM AND DEN
13	Note:
Line 1745	
8Jul20 / 13Jul20	
Inv. 131	4 - INSTALL ADDITIONAL CABLE- CAT-5E NETWORK CABLE: TO GO IN BED #2, #3, #4, DEN
9	TO BE INSTALLED UP ON THE WALL FOR WALL MOUNTED TV
Line 1746	Note:
8Jul20 / 13Jul20	
WINDOWS	
Inv. 131	4 - BASEMENT: INSTALL LARGER BASEMENT WINDOW -FOUR (4) TO 36 X 30
41	Note:
Line 1777	
8Jul20 / 13Jul20	

2071

2071

2071

INDULGENCE ALTA VITA 4-438 SQFT

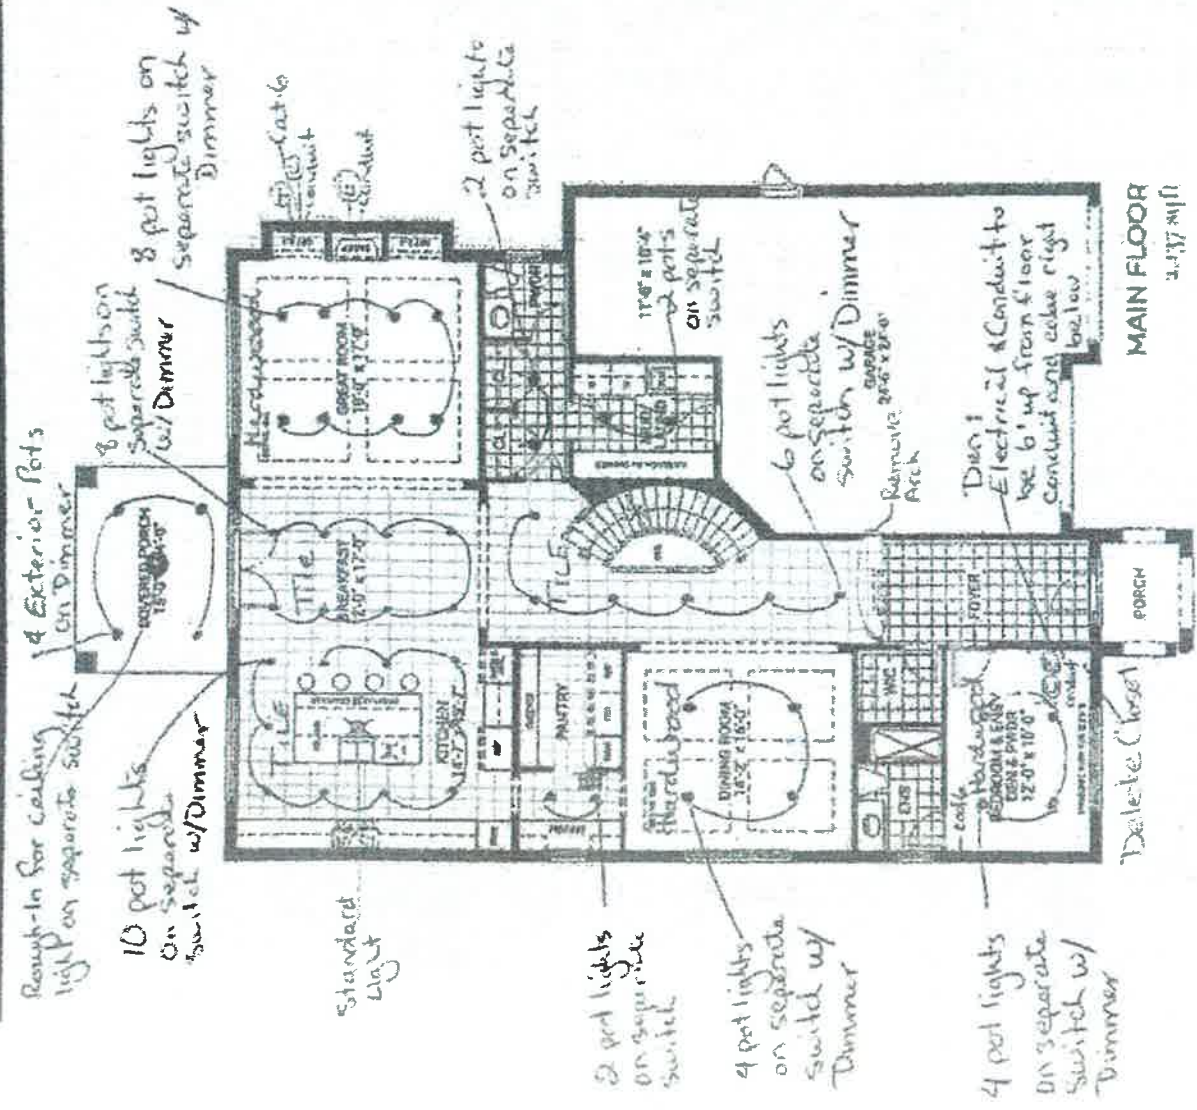


Pot Lights		Exterior Pots	
Kitchen	10 w/dimmer	Porch-main Floor	w/ Dimmer 4
Breakfast	8 w/ dimmer	Porch-2nd Floor Master w/ Dimmer	4
Great Room	8 w/dimmer		
Breakfast	2		
Side Hall	2		
Master Hall	6 w/ Dimmer		
Dining Room	4 w/ Dimmer		
Den	4 w/ Dimmer		
Master Bed	2		

RECEIVED
SEP 22 2020

RECEIVED

SEP 22 2020

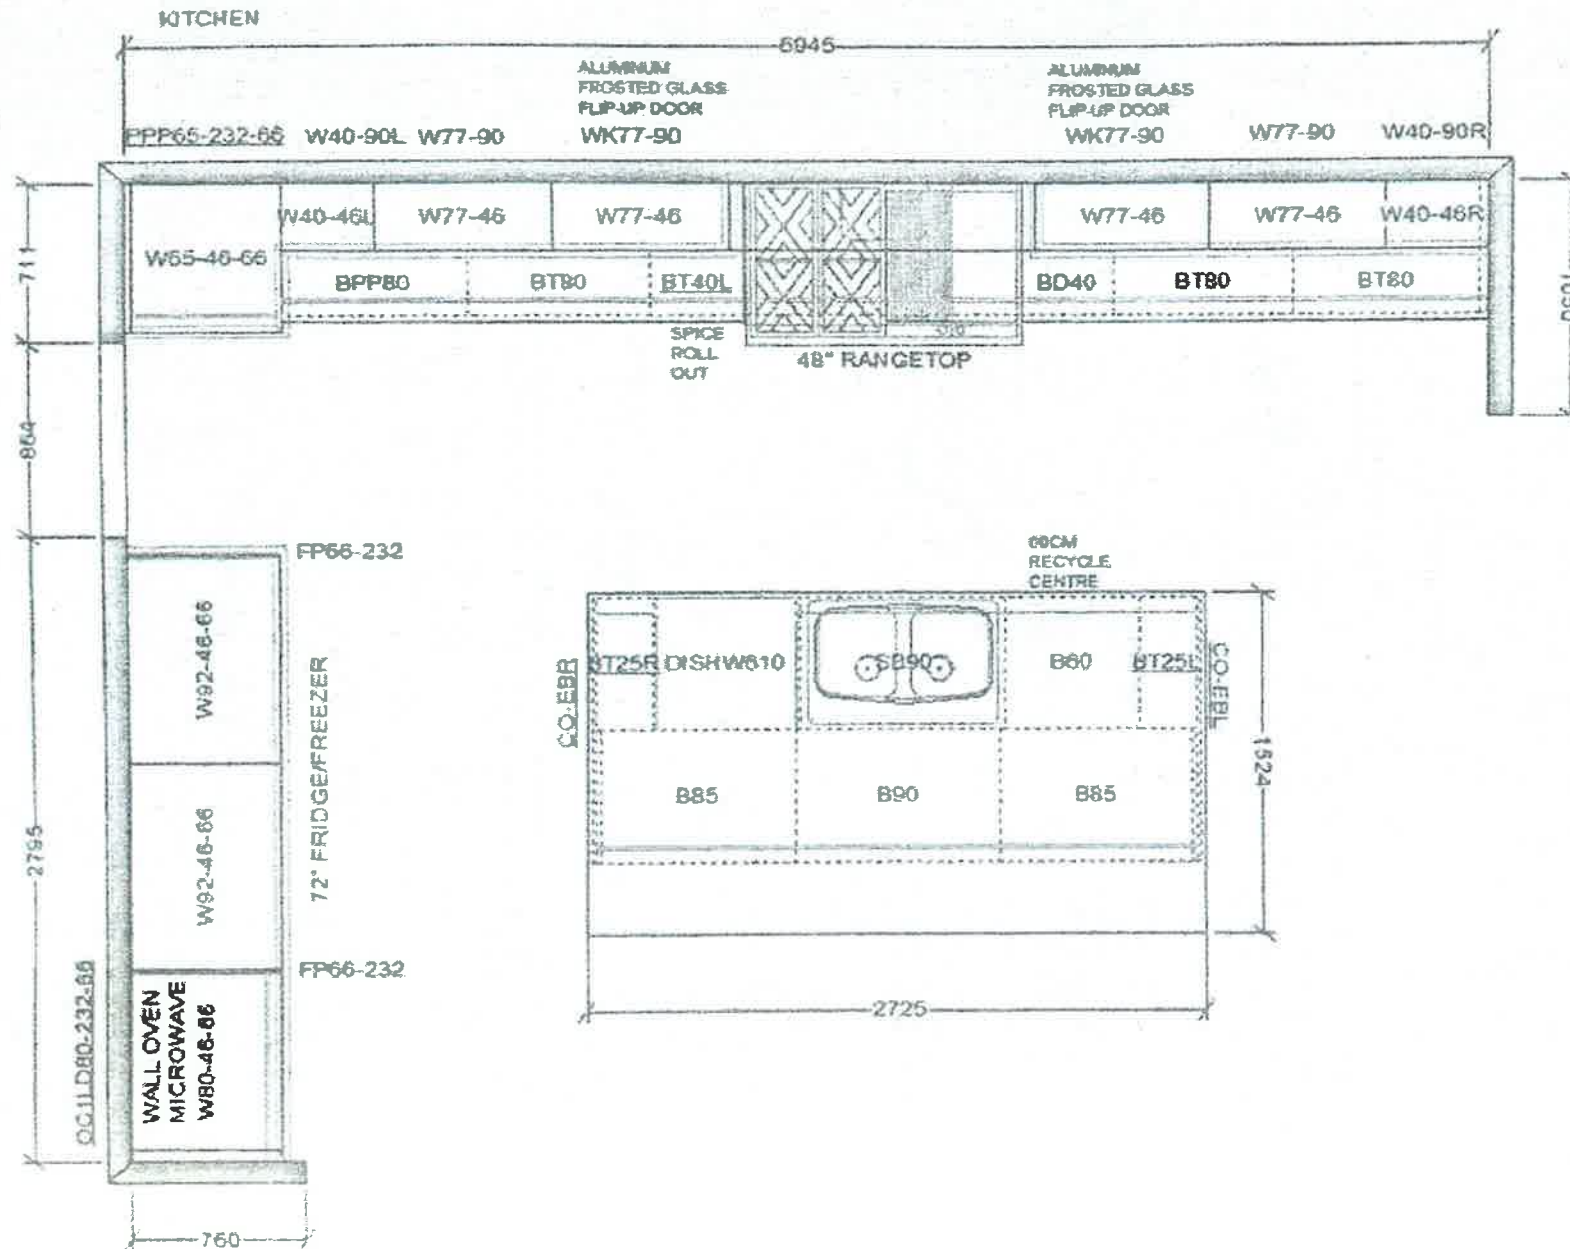

This sketch is for DESIGN PURPOSES ONLY - It is not meant to be an exact rendition.



VALERY HOMES
HIGHVALLEY ESTATES
LOT 1





Drawn By:
Date: September 17, 2020
Scale: Not To Scale

Approved By Builder:

Date:

RECEIVED

SEP 22 2020

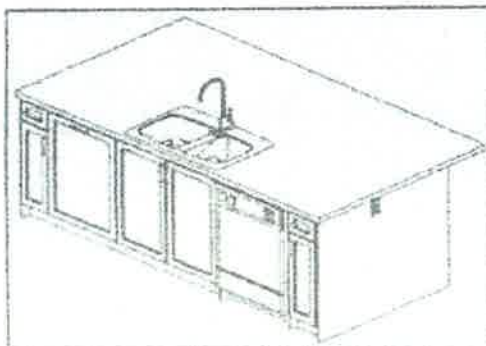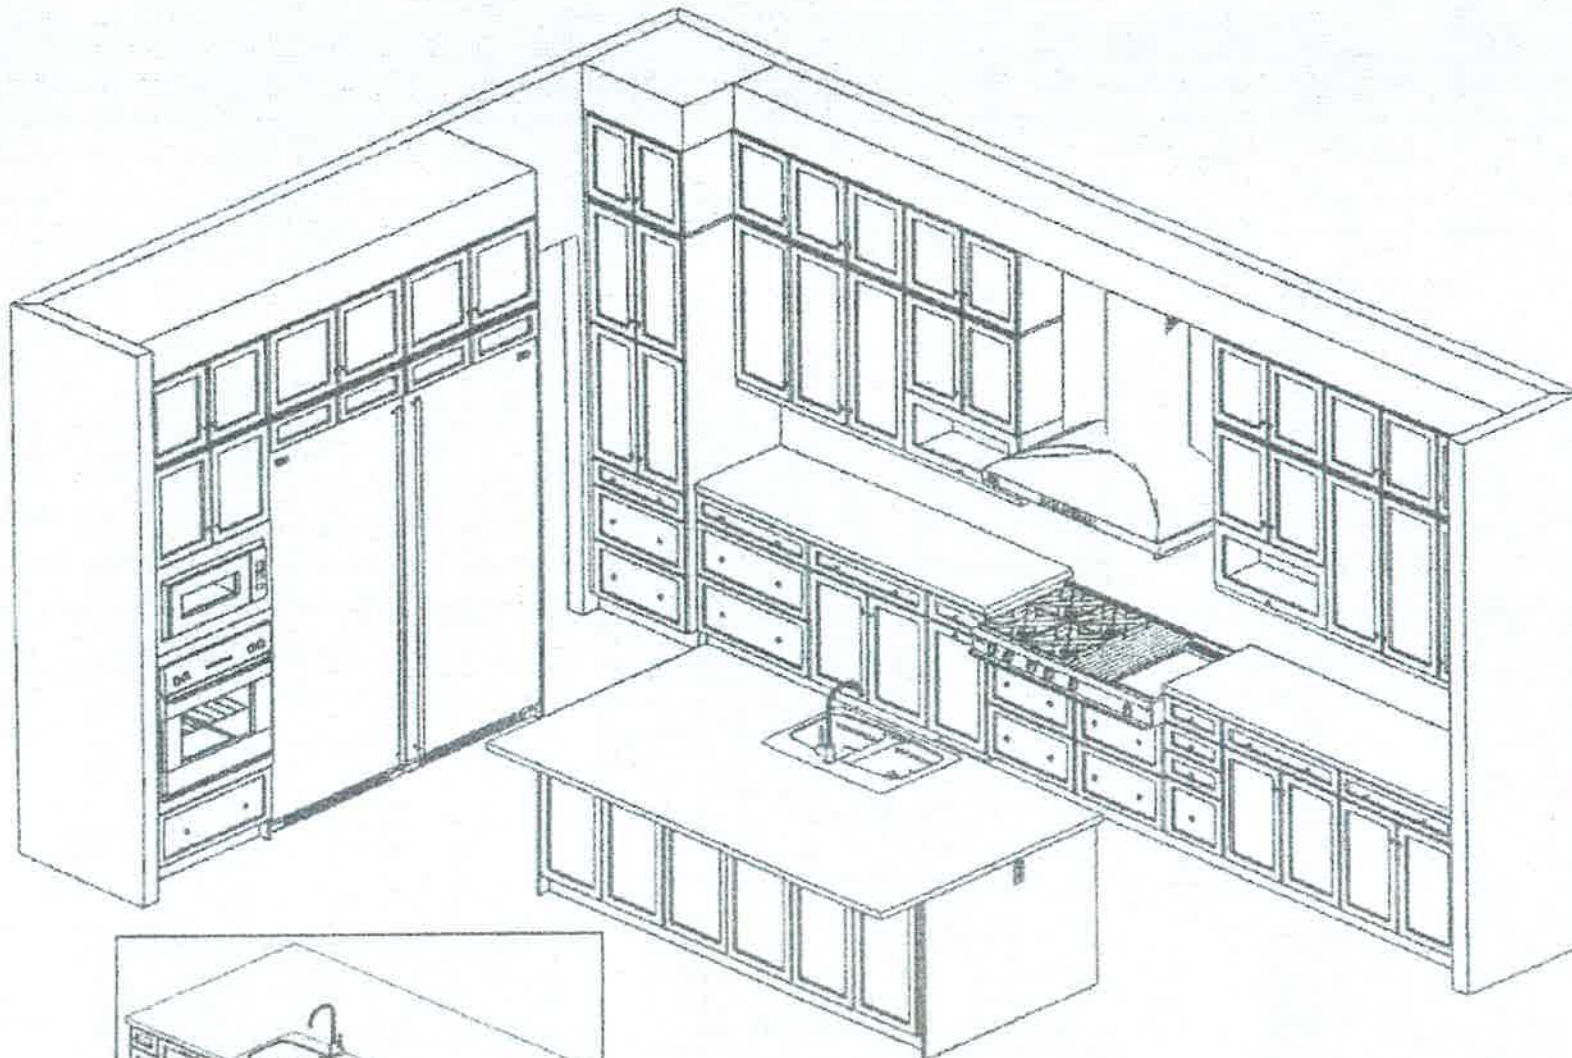

This sketch is for DESIGN PURPOSES ONLY - It is not meant to be an exact rendition.



FRENDEL
KITCHENS & BATHS
10000 Highway 100, Suite 100, Dallas, TX 75244

VALERY HOMES
HIGHVALLEY ESTATES
LOT 1





Drawn By:
Date: September 17, 2020
Scale: Not To Scale

Approved By Builder

Date:

RECEIVED
SEP 22 2020

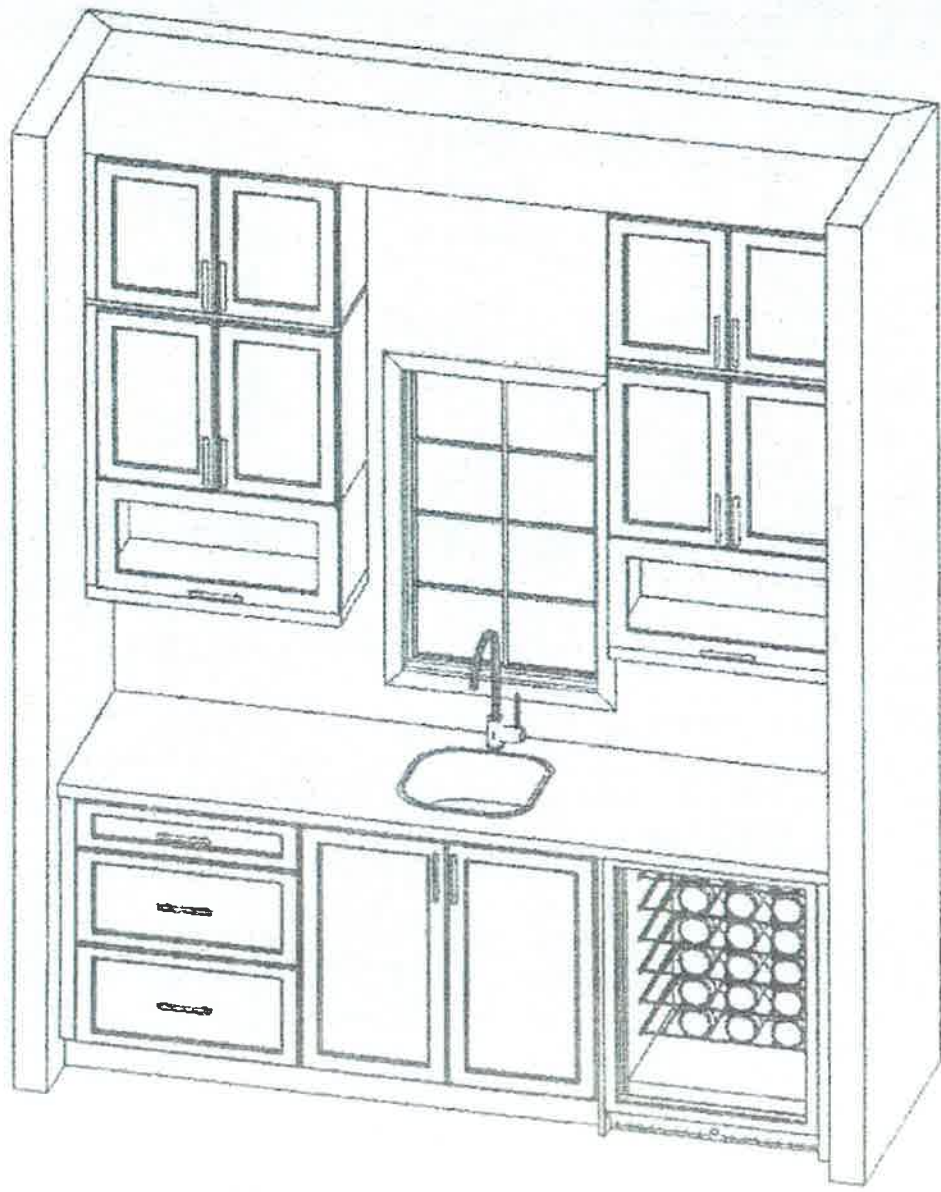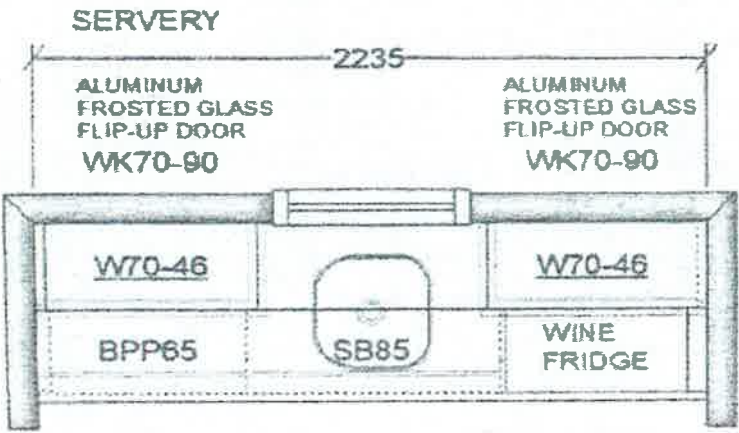

VALERY HOMES
HIGHVALLEY ESTATES
LOT 1

Handwritten initials: FIK



Drawn By:
Date: September 17, 2020
Scale: Not To Scale

Approved By Builder:

Date:

RECEIVED

SEP 22 2020

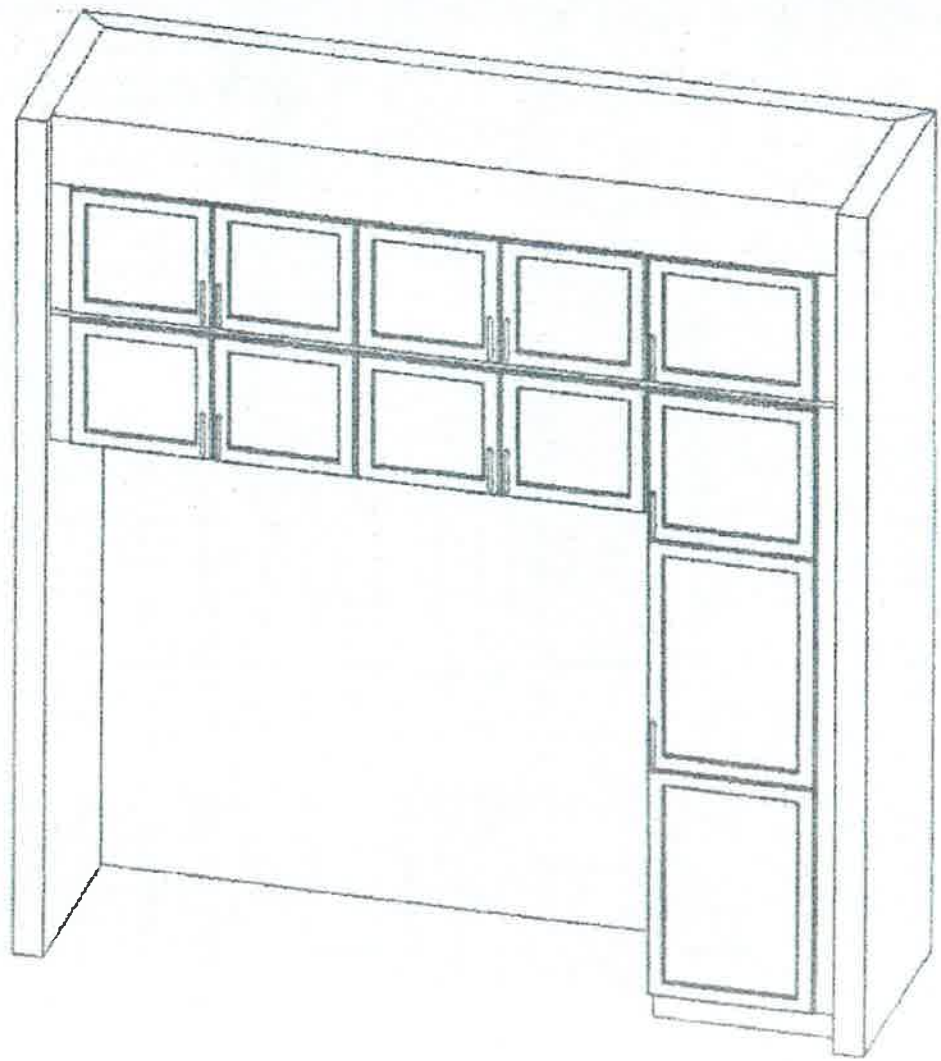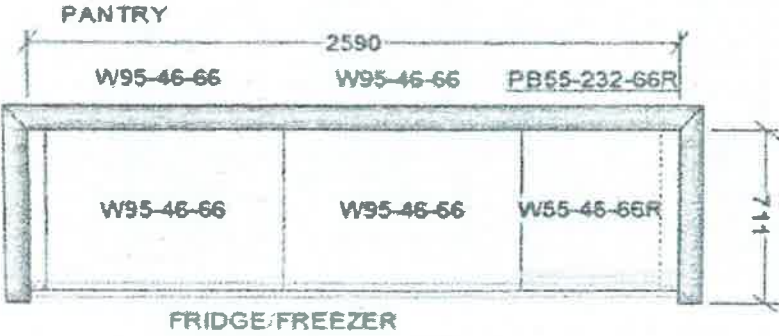

VALERY HOMES
HIGHVALLEY ESTATES
LOT 1

PA




Drawn By:
Date: September 17, 2020
Scale: Not To Scale

Approved By Builder:

Date:

RECEIVED

SEP 22 2020

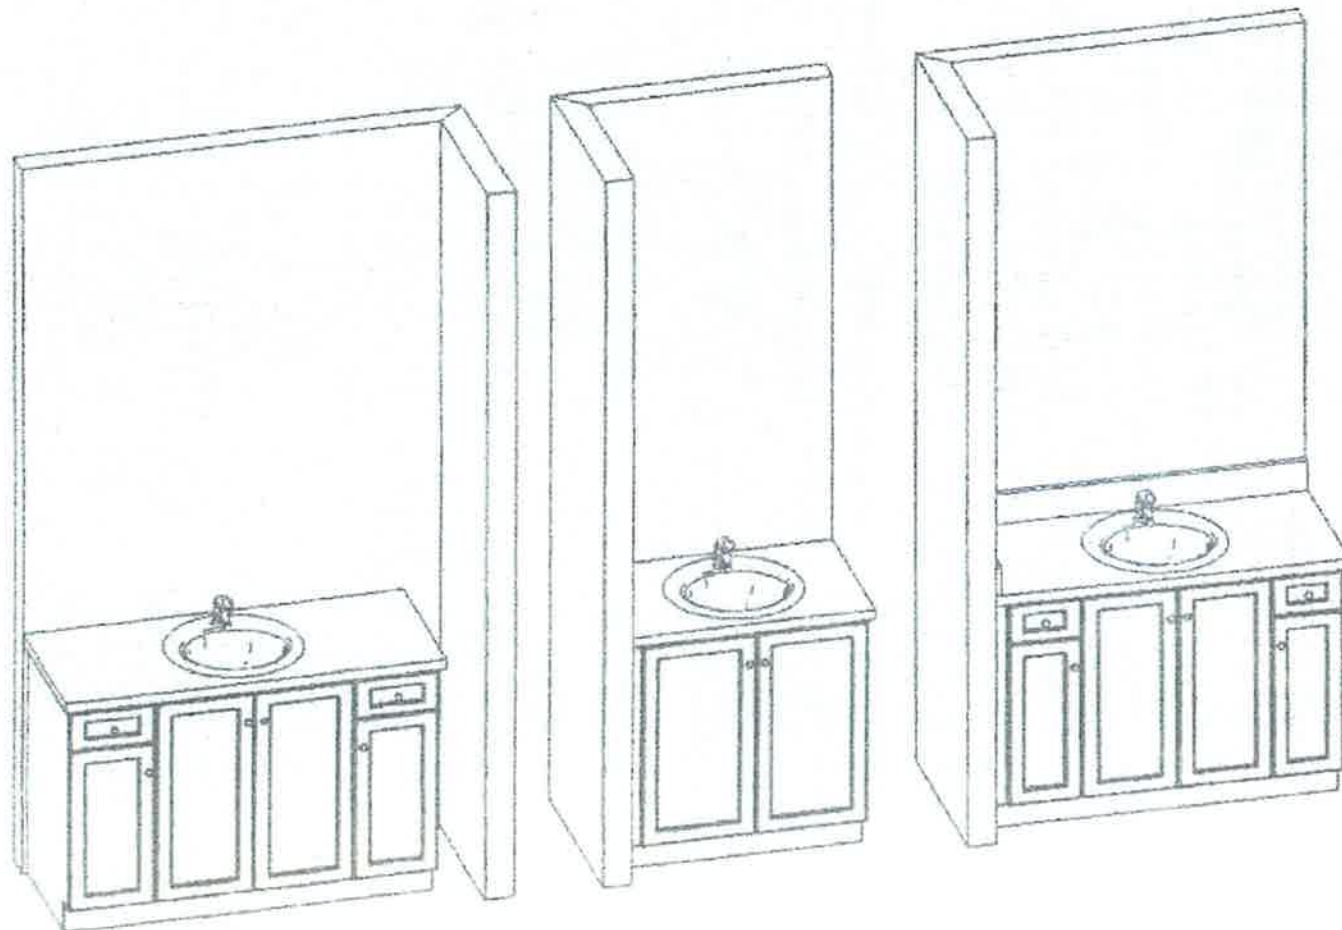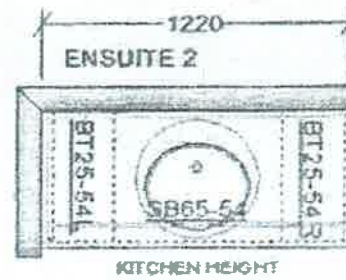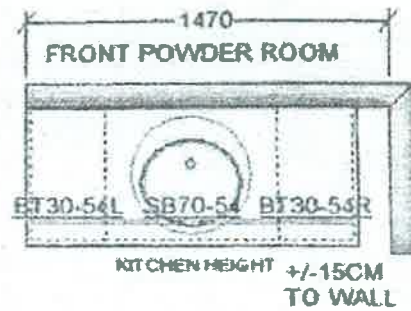

This sketch is for DESIGN PURPOSES ONLY - It is not meant to be an exact rendition.



VALERY HOMES
HIGHVALLEY ESTATES
LOT 1





Drawn By:
Date: September 17, 2020
Scale: Not To Scale

Approved By Builder:


Date:

RECEIVED
SEP 22 2020

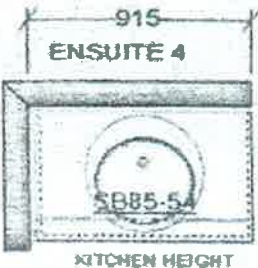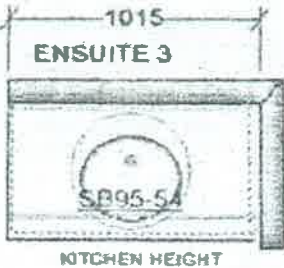

VALERY HOMES
HIGHVALLEY ESTATES
LOT 1

PL

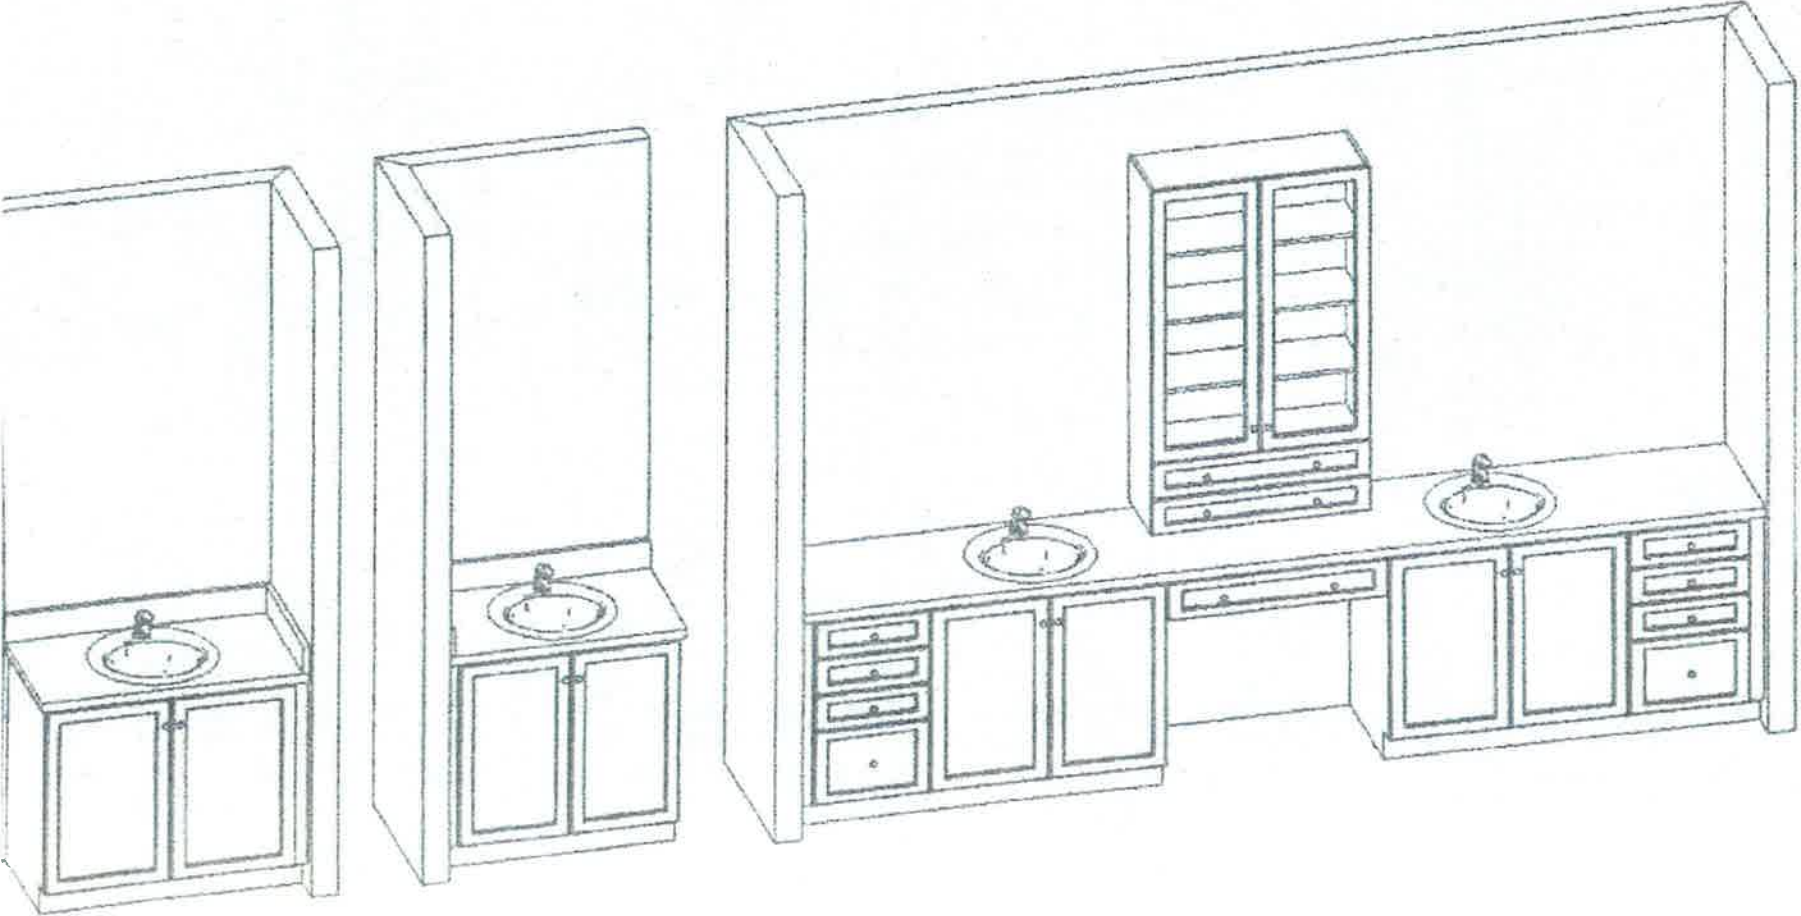

Drawn By:
Date: September 17, 2020
Scale: Not To Scale





Approved By Builder:

Date:

This sketch is for DESIGN PURPOSES ONLY - It is not meant to be an exact rendition.

RECEIVED

SEP 22 2020

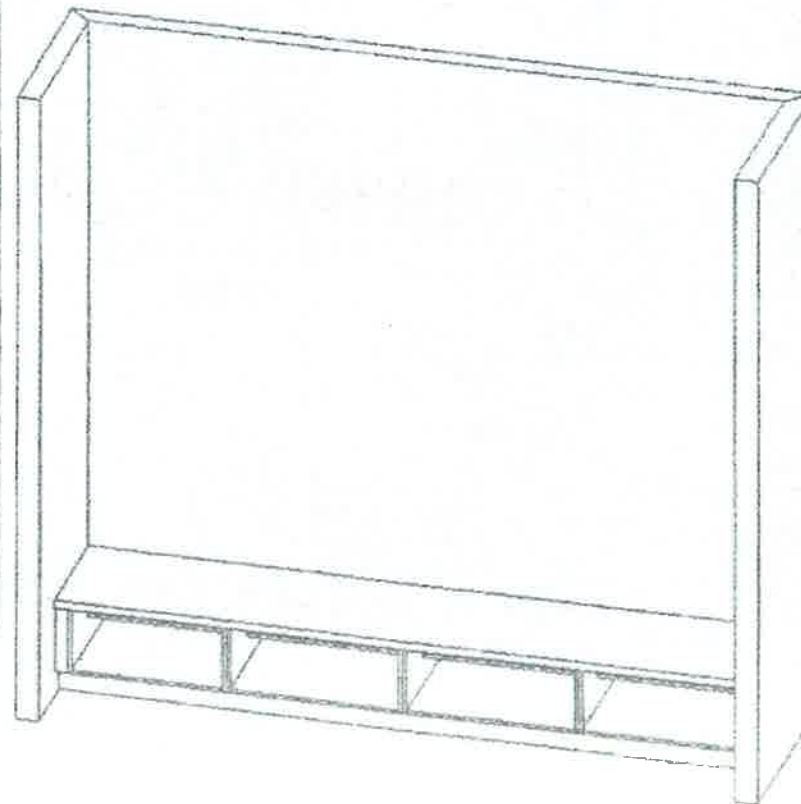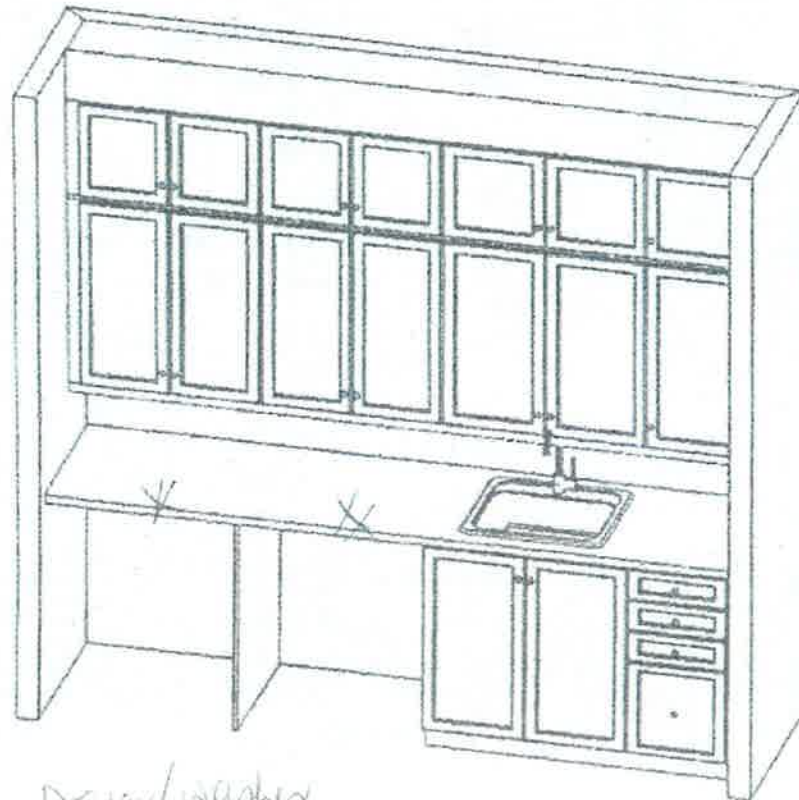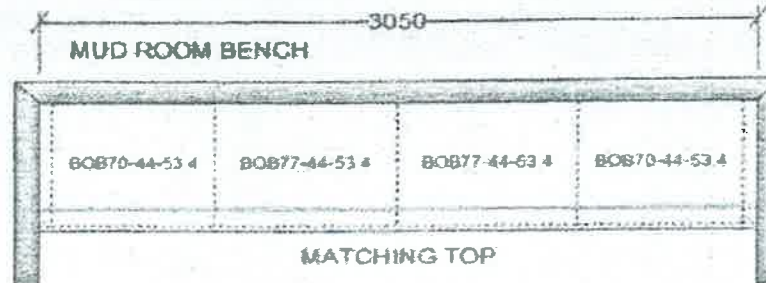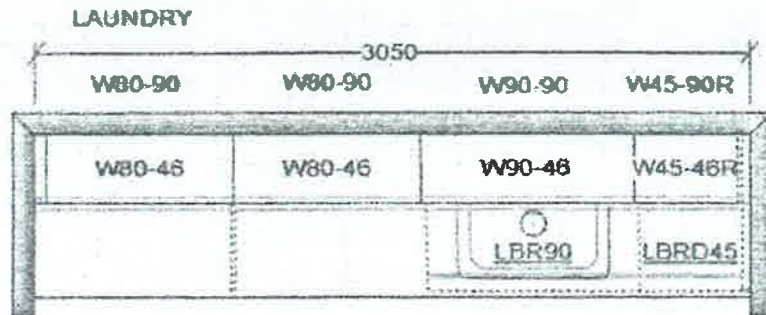

VALERY HOMES
HIGH VALLEY ESTATES
LOT 1

SK

Drawn By:
Date: September 17, 2020
Scale: Not To Scale

Approved By Builder:

Date:

This sketch is for DESIGN PURPOSES ONLY - It is not meant to be an exact rendition.

LD 1



BACK



MASONITE.
Open to extraordinary.

* Main Floor Only
x10


Masonite
Expo™
Heritage®
Series
Lincoln
Park™
Moulded
Panel
Door



WHERE TO BUY


Door • Moulded Panel Door
Masonite Expo™ Heritage®
Series

\$250/door

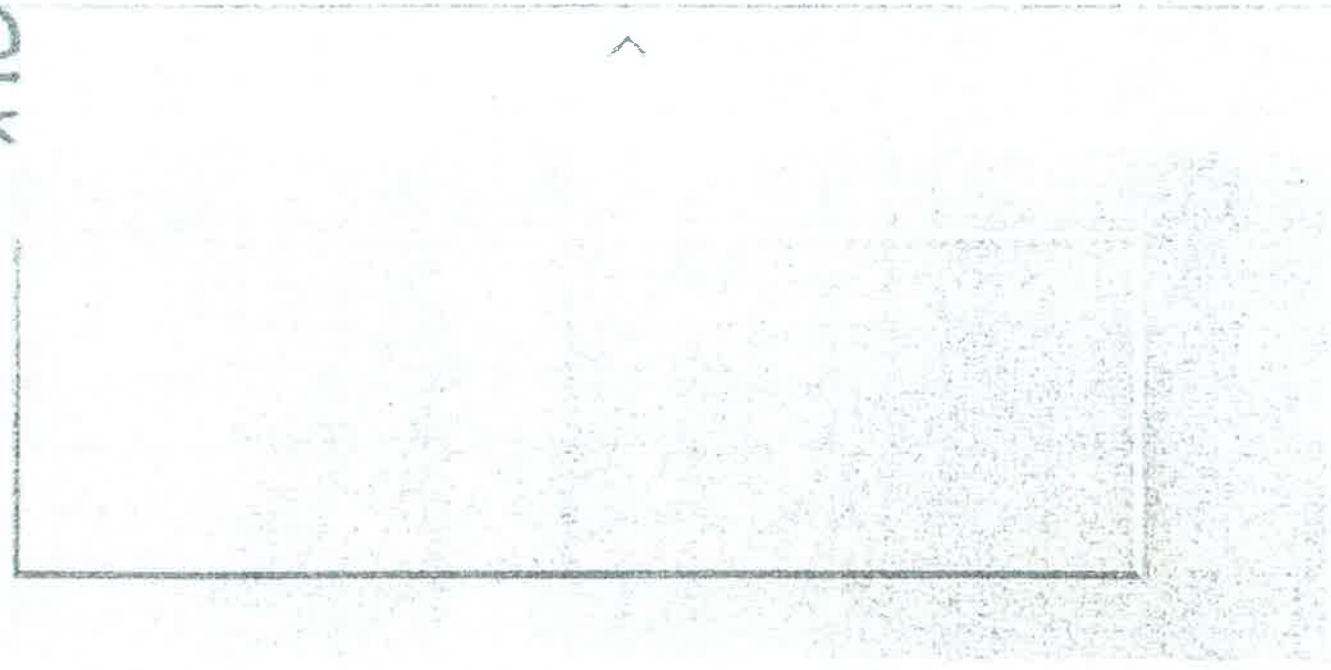

RECEIVED
SEP 22

Not 1
Kitchen

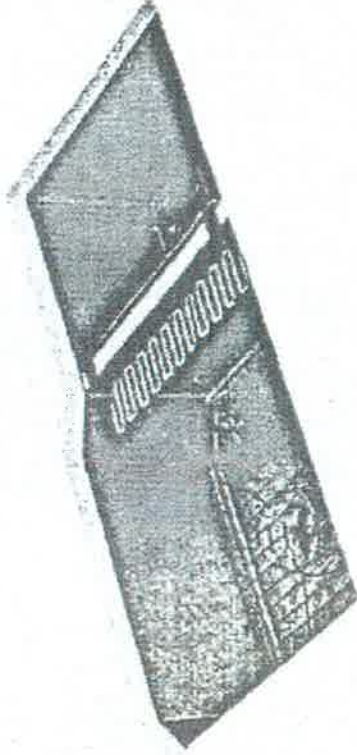

Strive®

35-1/2" x 20-1/4" x 9-5/16" under-mount
extra-large/medium double-bowl kitchen
sink with sink rack

K-5282-NA
CAD \$1,517.00 List
Price

COLOR: Not Applicable



This Strive kitchen sink offers professional style with easy-to-clean curved corners. **Made of** thick, premium quality 16-gauge stainless steel, the unique extra-large offset bowls maximize cabinet space, making room for your largest bakeware and cookware. Strive features a sound-absorption system that significantly reduces disposal and

Want to know more?


[Read our Cookie Policy](#)

RECEIVED

SEP 22 2021

Not a Vantary 10x2 Fridges

Whirlpool 21 Cu. Ft. Side-by-Side Refrigerator - WRS321SDHZ | The Brick

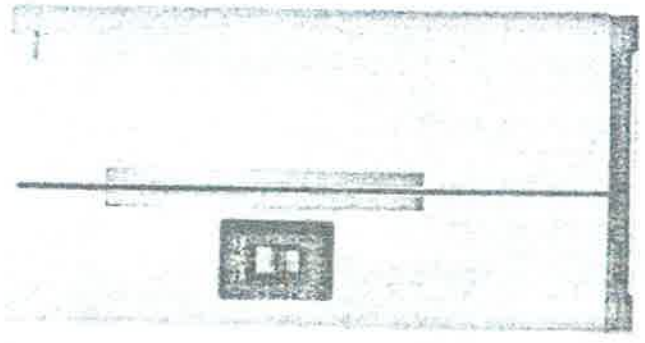

**WHIRLPOOL 21
CU. FT. SIDE-BY-
SIDE
REFRIGERATOR -
WRS321SDHZ**

\$ 1,399.00

SKU: WRS321DZ VSN: WRS321SDHZ

Dimensions

Height 33.12' (84.1 cm)
Width 30.92' (79.2 cm)
Depth 23.62' (59.4 cm)

Give your family the ease and access of this Whirlpool wide side-by-side refrigerator that was created specifically to serve you and your busy lifestyle. With 21 cubic feet inside, this Whirlpool fridge is packed with unique storage features that make unloading the groceries a simple task. Use the deli drawer to store your favourite meats and cheeses, and then fill the can caddy with your ideal beverages to keep up even more shelf space. Thirsty? Pour yourself a glass of filtered water and ice from the exterior dispenser and enjoy the seamless outside look thanks to hidden hinges.



RECEI
SEP 21

Unique Features

Can Caddy:

Free up shelf space and get more flexibility using this in-door can caddy that holds cans and bottles.

Frameless Glass Shelves:

Make the most of each shelf with well-to-wall frameless glass shelves, which offer greater storage flexibility.

Adjustable Gallon Door Bins:

Move these adjustable bins anywhere in the door for increased loading flexibility when and where you need it.

Deli Drawer:

Store plenty of meat and cheese with a deli drawer designed to keep your favourite snacks at an optimal temperature.

LED Interior Lighting:

Light is cast inside the refrigerator to eliminate dark corners and to make your food look good.

Exterior Ice and Water Dispenser with EveryDrop™ Filtration

Access fresh filtered water and ice without ever opening the refrigerator door using dual pad dispensers.

Tap Touch Controls:

Clean these controls as easily as you use them.

Hidden Hinges:

Get a seamless look with door hinges that stay out of sight.

Electronic Temperature Controls:

Choose the ideal temperature for whatever foods you're storing with convenient, up-front controls.

Fingerprint Resistant Stainless Steel:

Resist fingerprints and smudges with steel that easily wipes clean and looks sleek.

Factory-Installed Ice Maker:

Forget about refilling ice trays with this pre-installed ice maker that ensures you always have plenty of ice on hand.

Adaptive Defrost:

Adaptive defrost automatically monitors the freezer environment and runs the cycle only when necessary, saving time and energy.

LED Dispenser Night Light:

Easily find water and ice at night when you turn on the dispenser night light.

General Details

VSN	WRS321SDHZ
UPC/EIN	883049435039

General Details

Appliance Features	Child Lock, Fingerprint Resistant
Refrigeration Features	Exterior Water Dispenser, Exterior Ice Dispenser, Ice Water, Frost-Free
Refrigerator Type	Side-by-Side
Finish Colour	Fingerprint Resistant Stainless Steel
Control Panel	Electronic Touch
Lighting	LED
Ice Maker	Factory Installed
Water Dispenser	• Filtered Water • Ice Dispenser Lock • Measured/Metered Fill • Night Light

Energy 120 V

Consumption

Door

Side-by-Side

Refrigerator Details

Refrigerator 8 in 1 Dairy, 1 Fixed Full-Width, 3 Adjustable Gallon

Refrigerator Shelves 4

Freezer Details

Freezer Shelves 3 Adjustable Full-Width Glass

Installation Details

Installation Requirements https://ap.whirlpoolcentral.ca/resources/documents/WRS321SDHZ_use_and_care_en.pdf

2071



Whirlpool 21 Cu. Ft. Side-by-Side Refrigerator - WRS121SDHZ | The Brick

General Details

Instruction Manual URL	Instruction Manual (PDF) https://www.whirlpool.com/resources/documents/WRS121SDHZ_Installation_Instruction_en.pdf
------------------------	---

Additional Details

Safety Details	See Owner's Manual
----------------	--------------------

Additional Dimensions


Refrigerator Capacity (cu. ft.)	14.63
Freezer Capacity (cu. ft.)	5.77
Total Capacity (cu. ft.)	21.4
Depth with Door Open 90 degrees (in.)	49.3125
Other Dimensions	▪ Height To Top Of Cabinet: 65.625 ▪ Depth Excluding Handles: 31.625 ▪ Depth Closed Including Handles: 33.625

RECEIVED
SEP 22

2571
(1 of 2)

2571

PRODUCT DIMENSIONS

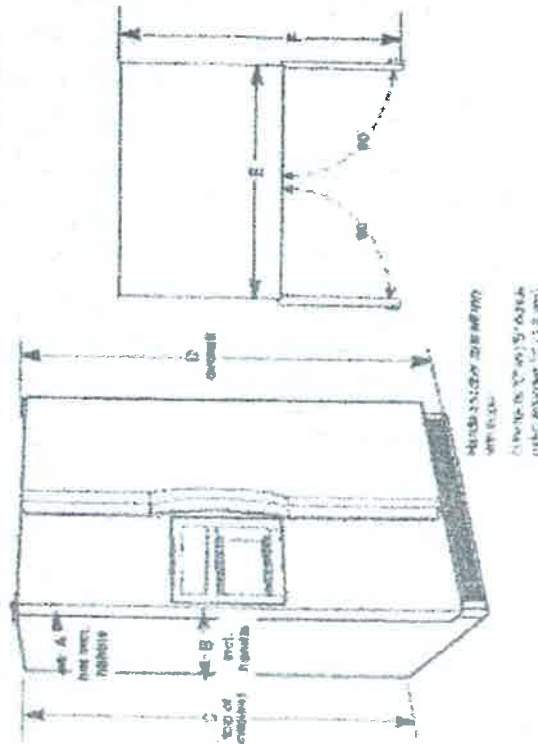

Model Number/ Capacity	Depth Without Handles "B"	Depth With Handles "C"	Height to top of Cabinet "D"	Overall height "F"	Cabinet Width "E"	Depth with Doors Open "F"
WRS315SDH 24.37 cu. ft.	31 1/8" (80.33 cm)	33 1/8" (85.41 cm)	68 1/8" (174.31 cm)	69 1/8" (176.85 cm)	35 1/8" (89.11 cm)	49 1/8" (125.25 cm)
WRS315ENH 25.1 cu. ft.	31 1/8" (80.33 cm)	33 1/8" (85.41 cm)	68 1/8" (174.31 cm)	69 1/8" (176.85 cm)	35 1/8" (89.11 cm)	49 1/8" (125.25 cm)
WRS312SDH 21.88 cu. ft.	31 1/8" (80.33 cm)	33 1/8" (85.41 cm)	65 1/8" (164.31 cm)	66 1/8" (169.23 cm)	32 1/8" (84.12 cm)	46 1/8" (125.25 cm)
WRS313SDH 24.54 cu. ft.	31 1/8" (80.33 cm)	33 1/8" (85.41 cm)	68 1/8" (174.31 cm)	69 1/8" (176.85 cm)	35 1/8" (89.11 cm)	49 1/8" (125.25 cm)
WRS311SDH 21.22 cu. ft.	31 1/8" (80.33 cm)	33 1/8" (85.41 cm)	65 1/8" (164.31 cm)	66 1/8" (169.23 cm)	32 1/8" (84.12 cm)	46 1/8" (125.25 cm)
WRS312ENH 21.88 cu. ft.	31 1/8" (80.33 cm)	33 1/8" (85.41 cm)	65 1/8" (164.31 cm)	66 1/8" (169.23 cm)	32 1/8" (84.12 cm)	46 1/8" (125.25 cm)
WRS315SDH 24.51 cu. ft.	31 1/8" (80.33 cm)	33 1/8" (85.41 cm)	68 1/8" (174.31 cm)	69 1/8" (176.85 cm)	35 1/8" (89.11 cm)	49 1/8" (125.25 cm)
WRS315ENH 25.1 cu. ft.	31 1/8" (80.33 cm)	33 1/8" (85.41 cm)	68 1/8" (174.31 cm)	69 1/8" (176.85 cm)	35 1/8" (89.11 cm)	49 1/8" (125.25 cm)
WRS312SDH 21.42 cu. ft.	31 1/8" (80.33 cm)	33 1/8" (85.41 cm)	65 1/8" (164.31 cm)	66 1/8" (169.23 cm)	32 1/8" (84.12 cm)	46 1/8" (125.25 cm)
WRS312ENH 22.60 cu. ft.	31 1/8" (80.33 cm)	33 1/8" (85.41 cm)	68 1/8" (174.31 cm)	69 1/8" (176.85 cm)	35 1/8" (89.11 cm)	49 1/8" (125.25 cm)

Refrigerator dimensions are based on the refrigerator being used as a refrigerator. Dimensions are subject to change without notice.

Refrigerator dimensions are based on the refrigerator being used as a refrigerator. Dimensions are subject to change without notice.

WHS10001212 30/12

RECEIVED
SEP 2

Whirlpool®

Side by Side Refrigerator

PRODUCT MODEL NUMBERS


WRS315SDH* WRS315SNH*
WRS312SDH* WRS303SDH*
WRS301SDH* WRS311SDH*
WRS307SDH* WRS555SDH*
WRS316SDH* WRS305SDH*

Electrical: A 115-volt, 60-Hz, 40-amp, 15- or 20-amp fused, grounded electrical supply is required. It is recommended that a separate circuit serving only your refrigerator be provided. Use an outlet that cannot be turned off by a switch. Do not use an extension cord.

Water: A cold water supply with water pressure of between 30 and 120 psi (207 and 827 kPa) is required to operate the water dispenser and ice maker. If you have questions about your water pressure, call a licensed, qualified plumber.

Reverse Osmosis Water Supply: The pressure of the water supply coming out of a reverse osmosis system going to the water inlet valve of the refrigerator needs to be between 30 and 120 psi (207 and 827 kPa).

LOCATION REQUIREMENTS

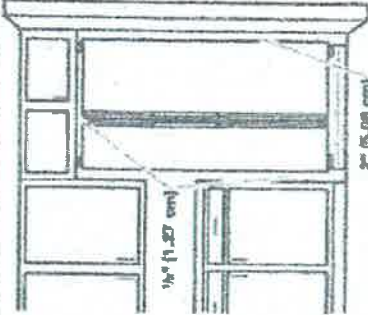

To ensure proper ventilation for your refrigerator, allow for 1/4" (1.27 cm) of space on each side and at the top. Allow for 1" (2.54 cm) of space behind the refrigerator. If your refrigerator has an ice maker, allow extra space at the back for the water line connections. When installing your refrigerator next to a fixed wall, leave a 2" (5.08 cm) minimum space on each side (depending on your model) to allow the doors to swing open.

NOTES:

- This refrigerator is intended for use in a location where the temperature ranges from a minimum of 55°F (13°C) to a maximum of 110°F (43°C). The preferred room temperature range for optimum performance, which reduces electricity usage and provides superior cooling, is between 60°F (15°C) and 80°F (32°C). It is recommended that you do not install the refrigerator near a heat source, such as an oven or radiator.
- Normal minimum cabinet cutout width required for product installation is 36" (91.44 cm). However, if the product is placed against an extended wall and the ability to remove the crisper pans is desired, an additional 18" (45.72 cm) of cabinet width is required, so a total cabinet opening width of 54" (137.16 cm) is recommended.

RECEIVE

SEP 22 21

Pantry 2 of 2 Fridges