

CONSTRUCTION SUMMARY

Indulgence - 1 - 1 - Alta Vista Elev. A

Registere Plan Number: Municipal Address: 555 Highvalley Drive Closing: 15-Sep-20

CABINETRY

Inv. 92	1 - HIGHER UPPER CABINET IN KITCHEN	
6		
Line 1197	Note:	
13Apr20 / 13Apr20		
Inv. 174	1 - KITCHEN: INSTALL LEVEL 8 CABINET	
51		
Line 2337	Note:	
18Sep20 / 23Sep20		
Inv. 174	1 - SERVERY: INSTALL LEVEL 8 CABINET	
52		
Line 2338	Note:	
18Sep20 / 23Sep20		
Inv. 174	1 - POWDER ROOM: INSTALL LEVEL 7 CABINET	
53		
Line 2339	Note:	
18Sep20 / 23Sep20		
Inv. 174	1 - DEN ENSUITE: INSTALL LEVEL 7 CABINET	
54		
Line 2340	Note:	
18Sep20 / 23Sep20		
Inv. 174	1 - MASTER ENSUITE: INSTALL LEVEL 6 CABINET	
55		
Line 2341	Note:	
18Sep20 / 23Sep20		
Inv. 174	1 - KITCHEN: INSTALL TWO-TONE COLOUR FOR BASE CABINETS IN KITCHEN AREA ONLY (NOT SERVEY) (40J)	
84		
Line 2370	Note:	
18Sep20 / 23Sep20		
Inv. 174	1 - KITCHEN: INSTALL TWO-TONE COLOUR FOR ISLAND CABINETS (40J)	
85		
Line 2371	Note:	
18Sep20 / 23Sep20		
Inv. 174	1 - KITCHEN: INSTALL UPGRADE 2 HARDWARE THROUGHOUT KITCHEN AND SERVERY (03G)	
86		
Line 2372	Note:	
18Sep20 / 23Sep20		
Inv. 174	1 - KITCHEN: INSTALL STACKED CABINETS (03A)	
87		
Line 2373	Note:	
18Sep20 / 23Sep20		
Inv. 174	1 - SERVERY: INSTALL STACKED CABINETS (03A)	
88		
Line 2374	Note:	
18Sep20 / 23Sep20		
Inv. 174	1 - PANTRY: INSTALL STACKED CABINETS (03A)	
89		
Line 2375	Note:	
18Sep20 / 23Sep20		

CONSTRUCTION SUMMARY

Indulgence - 1 - 1 - Alta Vista Elev. A

Register Plan Number: Municipal Address: **555 Highvalley Drive** Closing: **15-Sep-20**

Inv. 174 90 Line 2376 18Sep20 / 23Sep20	1 - LAUNDRY/MUD ROOM: INSTALL STACKED CABINETS (03A) Note:
Inv. 174 91 Line 2377 18Sep20 / 23Sep20	1 - KITCHEN: INSTALL SOFT CLOSE CABINETS Note:
Inv. 174 92 Line 2378 18Sep20 / 23Sep20	1 - KITCHEN: INSTALL VALANCE LIGHTING IN KITCHEN/ SERVERY Note:
Inv. 174 93 Line 2379 18Sep20 / 23Sep20	7 - KITCHEN: INSTALL SEVEN (7) TOP DRAWERS IN KITCHEN (09B) Note:
Inv. 174 94 Line 2380 18Sep20 / 23Sep20	1 - KITCHEN: INSTALL POT AND PAN DRAWER IN PANTRY (17B) Note:
Inv. 174 95 Line 2381 18Sep20 / 23Sep20	1 - KITCHEN: INSTALL POT AND PAN DRAWERS IN KITCHEN Note:
Inv. 174 96 Line 2382 18Sep20 / 23Sep20	1 - INSTALL POT AND PAN DRAWER IN SERVERY (13B) Note:
Inv. 174 97 Line 2383 18Sep20 / 23Sep20	2 - KITCHEN: INSTALL TWO (2) ALUMINUM FRAMED DOORS IN KITCHEN, ON EITHER SIDE OF STOVE (24A) Note:
Inv. 174 98 Line 2384 18Sep20 / 23Sep20	2 - KITCHEN: INSTALL TWO (2) ALUMINUM FRAMED DOORS IN SERVERY, ON EITHER SIDE OF WINDOW (24A) Note:
Inv. 174 99 Line 2385 18Sep20 / 23Sep20	1 - KITCHEN: INSTALL SPICE RACK BESIDE STOVE (21B) Note:
Inv. 174 100 Line 2386 18Sep20 / 23Sep20	1 - KITCHEN: INSTALL RECYCLE CENTRE BESIDE SINK (20B) Note:
Inv. 174 101 Line 2387 18Sep20 / 23Sep20	1 - KITCHEN: INSTALL 48" RANGETOP CABINET (26H) Note:
Inv. 174 102 Line 2388 18Sep20 / 23Sep20	1 - SERVERY: PREPARE CABINET IN SERVERY FOR WINE FRIDGE Note:



CONSTRUCTION SUMMARY

Indulgence - 1 - 1 - Alta Vista Elev. A

Registere Plan Number: Municipal Address: 555 Highvalley Drive Closing: 15-Sep-20

Inv. 174 103 Line 2389 18Sep20 / 23Sep20	1 - LAUNDRY ROOM: INSTALL BANK OF DRAWERS BESIDE SINK (11B) Note:
Inv. 174 104 Line 2390 18Sep20 / 23Sep20	2 - DEN ENSUITE: INSTALL TWO (2) TOP DRAWERS IN VANITY (11D) Note:
Inv. 174 105 Line 2391 18Sep20 / 23Sep20	2 - ENSUITE 2: INSTALL TWO (2) TOP DRAWERS IN VANITY (11D) Note:
Inv. 174 106 Line 2392 18Sep20 / 23Sep20	1 - MASER ENSUITE: INSTALL HUTCH WITH 2 FROSTED GLASS DOORS AND MATCHING INTERIOR (36A) Note:
Inv. 174 107 Line 2393 18Sep20 / 23Sep20	6 - ALL VANITIES: INCREASE THE HEIGHT OF ALL VANITIES TO KITCHEN HEIGHT TOTAL SIX (6). (03D) POWDER ROOM, DEN ENS., ENSUITE 2, 3, 4, AND MASTER Note:
Inv. 203 113 Line 3553 14Oct20 / 15Oct20	1 - KITCHEN ISLAND: ENLARGE LENGTH OF KITCHEN ISLAND BY 8" - TWO 4" PANELS ON EACH SIDE- TO ACCOMODATE FOR THE ELECTRICAL OUTLETS. SEE ATTACHED SKETCH Note:

CEILING

Inv. 92 7 Line 1198 13Apr20 / 13Apr20	1 - WAFFLED CEILING IN GREAT ROOM AND DINING ROOM Note:
Inv. 131 37 Line 1773 8Jul20 / 13Jul20	1 - 2ND FLOOR: INSTALL SMOOTH CEILING ON SECOND FLOOR Note:

CERAMIC TILE

Inv. 92 3 Line 1194 13Apr20 / 13Apr20	1 - MINIMUM OF 24" X 24" PORCELAIN TILE Note:
Inv. 174 59 Line 2345 18Sep20 / 23Sep20	1 - FOYER: INSTALL UPGRADE 6 TILE Note:
Inv. 174 60 Line 2346 18Sep20 / 23Sep20	1 - SIDE HALL: INSTALL UPGRADE 6 TILE Note:



CONSTRUCTION SUMMARY

Indulgence - 1 - 1 - Alta Vista Elev. A

Registere Plan Number: Municipal Address: 555 Highvalley Drive Closing: 15-Sep-20

Inv. 174	1 - POWDER ROOM: INSTALL UPGRADE 6 TILE
61	
Line 2347	Note:
18Sep20 / 23Sep20	
Inv. 174	1 - LAUNDRY/MUD ROOM: INSTALL UPGRADE 6 TILE
62	
Line 2348	Note:
18Sep20 / 23Sep20	
Inv. 174	1 - KITCHEN/ BREAKFAST AREA: INSTALL UPGRADE 6 TILE
63	
Line 2349	Note:
18Sep20 / 23Sep20	
Inv. 174	1 - BASEMENT LANDING: INSTALL UPGRADE 6 TILE
64	
Line 2350	Note:
18Sep20 / 23Sep20	
Inv. 174	1 - MAIN HALL: INSTALL UPGRADE 6 TILE
65	
Line 2351	Note:
18Sep20 / 23Sep20	
Inv. 174	1 - SERVERY/ PANTRY: INSTALL UPGRADE 6 TILE
66	
Line 2352	Note:
18Sep20 / 23Sep20	
Inv. 174	1 - MASTER ENSUITE: INSTALL UPGRADE 5 TILE ON FLOOR
67	
Line 2353	Note:
18Sep20 / 23Sep20	
Inv. 174	1 - DEN ENSUITE: INSTALL UPGRADE 3 TILE ON SHOWER WALL
68	
Line 2354	Note:
18Sep20 / 23Sep20	
Inv. 174	1 - ENSUITE 2: INSTALL UPGRADE 4 TILE ON SHOWER WALL
69	
Line 2355	Note:
18Sep20 / 23Sep20	
Inv. 174	1 - ENSUITE 3: INSTALL UPGRADE 3 TILE ON SHOWER WALL
70	
Line 2356	Note:
18Sep20 / 23Sep20	
Inv. 174	1 - ENSUITE 4: INSTALL UPGRADE 3 TILE ON SHOWER WALL
71	
Line 2357	Note:
18Sep20 / 23Sep20	
Inv. 174	1 - MASTER ENSUITE: INSTALL UPGRADE 5 TILE ON SHOWER WALL
72	
Line 2358	Note:
18Sep20 / 23Sep20	

CONSTRUCTION



CONSTRUCTION SUMMARY

Indulgence - 1 - 1 - Alta Vista Elev. A

Registere Plan Number: Municipal Address: 555 Highvalley Drive Closing: 15-Sep-20

Inv.131 42 Line 1781 8Jul20 / 13Jul20	1 - BASEMENT: INSTALL COLD CELLAR Note:
Inv.131 31 Line 1767 8Jul20 / 13Jul20	1 - DEN: INSTALL A DOUBLE DOOR ENTRY INTO THE DEN. TOTAL WIDTH OF DOORS TO BE 5' WIDE AND DELETE CLOSET Note:
Inv.131 32 Line 1768 8Jul20 / 13Jul20	1 - MASTER ENSUITE: ENLARGE DOOR INTO TOILET ROOM, LIKE LOT 4, IN ENSUITE Note:
Inv.131 33 Line 1769 8Jul20 / 13Jul20	1 - FOYER: DELETE LOW ARCH BETWEEN FOYER AND MAIN HALL Note:
Inv.131 34 Line 1770 8Jul20 / 13Jul20	1 - EXTERIOR @ MASTER BEDROOM: INSTALL COVERED PORCH OFF OF MASTER BEDROOM Note:
Inv.131 35 Line 1771 8Jul20 / 13Jul20	1 - EXTERIOR @ MASTER BEDROOM: INSTALL DOUBLE FRENCH DOORS TO COVERED PORCH OFF OF MASTER BEDROOM Note:
Inv.131 36 Line 1772 8Jul20 / 13Jul20	1 - EXTERIOR: CHANGE THE STUCCO ON THE FRONT OF THE HOUSE TO BRICK Note:
Inv.131 21 Line 1758 8Jul20 / 13Jul20	1 - MASTER ENSUITE: INSTALL SHOWER SEAT IN MASTER ENSUITE Note:
Inv.131 29 Line 1765 8Jul20 / 13Jul20	1 - MASTER BEDROOM: DELETE CENTRE WALL IN MASTER BEDROOM WALK-IN CLOSET AND RELOCATE DOORS INTO CLOSET AS SHOWN ON FLOOR PLAN Note:
Inv.197 111 Line 2532 7Oct20 / 8Oct20	1 - DELETE ARCHWAY BETWEEN THE BREAKFAST AREA AND THE GREAT ROOM Note:

COUNTERTOP

Inv.203 114 Line 3554 14Oct20 / 15Oct20	1 - KITCHEN ISLAND: INSTALL ADDITIONAL 8" OF MSI 2 TO THE LENGTH OF THE KITCHEN ISLAND TO ACCOMODATE FOR THE ELECTRICAL PLUGS. SEE SKETCH ATTACHED Note:
Inv.92 2 Line 1193 13Apr20 / 13Apr20	1 - ALL COUNTERS TO HAVE QUARTZ OR GRANITE Note:



CONSTRUCTION SUMMARY

Indulgence - 1 - 1 - Alta Vista Elev. A

Registere Plan Number: Municipal Address: 555 Highvalley Drive Closing: 15-Sep-20

Inv. 174	1 - KITCHEN - SERVERY: INSTALL MSI 2 THROUGHOUT KITCHEN AND SERVERY
Line 2342	Note:
18Sep20 / 23Sep20	
Inv. 174	1 - KITCHEN: INSTALL WATERFALL LEGS IN MSI 2 ON KITCHEN ISLAND
57	Note:
Line 2343	Note:
18Sep20 / 23Sep20	
Inv. 174	1 - KITCHEN: INSTALL MSI 2 STONE ON BACKSPLASH OF KITCHEN AND SERVERY
58	Note:
Line 2344	Note:
18Sep20 / 23Sep20	

ELECTRICAL

Inv. 131	2 - EXTERIOR PORCH POT LIGHTS- OFF MAIN FLOOR AND MASTER BEDROOM: INSTALL -
24	TWO (2) DIMMER SWITCHES FOR LED POT LIGHTS.
Line 1793	Note:
8Jul20 / 13Jul20	
Inv. 131	8 - EXTERIOR PORCH CEILINGS- OFF MAIN AND MASTER BEDROOM: INSTALL EIGHT (8)
16	POT LIGHTS - 4" LED - EXTERIOR SOFFITS FOUR ON EACH PORCH CEILING
Line 1794	Note:
8Jul20 / 13Jul20	
Inv. 131	2 - EXTERIOR CEILING, PORCH OFF MAIN FLOOR AND MASTER BEDROOM: INSTALL TWO
17	(2) LIGHT ROUGH IN - EXTERIOR - ON EXISTING SWITCH ONE IN THE CENTRE OF EACH CEILING
Line 1795	Note:
8Jul20 / 13Jul20	
Inv. 174	1 - KITCHEN: INSTALL RECEPTACLES - ADDITIONAL 15 AMP 120 VOLT RECEPTABLE FOR
48	GAS STOVE
Line 2334	Note:
18Sep20 / 23Sep20	
Inv. 174	1 - KITCHEN: INSTALL RECEPTACLES - DEDICATED 15 AMP 120 VOLT RECEPTABLE FOR
49	FREEZER
Line 2335	Note:
18Sep20 / 23Sep20	
Inv. 174	1 - SERVERY: INSTALL RECEPTACLES - DEDICATED 15 AMP 120 VOLT RECEPTABLE FOR
50	WINE FRIDGE
Line 2336	Note:
18Sep20 / 23Sep20	
Inv. 92	1 - 30 PT LIGHTS
4	Note:
Line 1195	Note:
13Apr20 / 13Apr20	
Inv. 131	1 - BELL AND CABLE LOCATION SKETCH. LOCATIONS MAY VARY SLIGHTLY DUE TO
8	JOIST LOCATIONS
Line 1739	Note:
8Jul20 / 13Jul20	
Inv. 131	6 - INSTALL SIX (6) RECEPTACLES - DEDICATED 15 AMP 120 VOLT RECEPTABLE FOR TV'S
11	ON THE WALLS. TO GO ABOVE FIREPLACE IN THE GREAT ROOM AND MASTER BEDROOM, BED #2, #3, #4 AND IN THE DEN.
Line 1742	Note:
8Jul20 / 13Jul20	



CONSTRUCTION SUMMARY

Indulgence - 1 - 1 - Alta Vista Elev. A

Registere Plan Number: Municipal Address: 555 Highvalley Drive Closing: 15-Sep-20

Inv.131	1 - KITCHEN: MOVE CEILING FIXTURE - RELOCATE STANDARD CEILING FIXTURE- TO GO OVER ISLAND. SEE SKETCH	
Line 1747	Note:	
8Jul20 / 13Jul20		
Inv.131	16 - INSTALL SIXTEEN (16) ADDITIONAL POT LIGHTS - 4" LED NON-INSULATED CEILINGS.	
15	NOTE 30 WERE STANDARD IN APS. LOCATIONS ARE LISTED ON THE FLOOR PLAN	
Line 1748	Note:	
8Jul20 / 13Jul20		
Inv.131	6 - MAIN FLOOR POT LIGHTS: INSTALL SIX (6) SWITCHES - DIMMER FOR LED POT LIGHTS. DIMMERS TO GO IN KITCHEN, BREAKFAST AREA, GREAT ROOM, MAIN HALL AND DEN LOCATIONS.	
23	Note:	
Line 1760		
8Jul20 / 13Jul20		
Inv.131	1 - KITCHEN: INSTALL VALANCE LIGHTING - UNDER CABINET - INCLUDING SERVERY	
25		
Line 1761	Note:	
8Jul20 / 13Jul20		

FIREPLACE

Inv.131	1 - MASTER BEDROOM: INSTALL FIREPLACE ON WALL THAT BACKS ONTO THE CLOSET	
30	ALLURAVISION 42" SLIM ELECTRIC FIREPLACE, GLASS FRONT AND BACK	
Line 1766	MODEL#NEFL42CHS	
8Jul20 / 13Jul20	Note:	
Inv.174	1 - GREAT ROOM: UPGRADE STANDARD MANTLE TO PF 51	
81		
Line 2367	Note:	
18Sep20 / 23Sep20		

HARDWOOD FLOORING

Inv.92	1 -	
1	5" HARDWOOD FLOORS IN ALL BEDROOMS, UPPER LANDING, DEN, GREAT ROOM AND DINING ROOM	
Line 1192	Note:	
13Apr20 / 13Apr20		
Inv.174	1 - DINING ROOM: INSTALL LEVEL 3 HARDWOOD	
76		
Line 2362	Note:	
18Sep20 / 23Sep20		
Inv.174	1 - DEN: INSTALL LEVEL 3 HARDWOOD	
77		
Line 2363	Note:	
18Sep20 / 23Sep20		
Inv.174	1 - GREAT ROOM: INSTALL LEVEL 3 HARDWOOD	
78		
Line 2364	Note:	
18Sep20 / 23Sep20		
Inv.174	1 - SECOND FLOOR: INSTALL LEVEL 3 HARDWOOD THROUGHOUT	
79		
Line 2365	Note:	
18Sep20 / 23Sep20		



CONSTRUCTION SUMMARY

Indulgence - 1 - 1 - Alta Vista Elev. A

Registere Plan Number: Municipal Address: 555 Highvalley Drive Closing: 15-Sep-20

HVAC

Inv. 174	1 - KITCHEN: INSTALL GAS PIPING AND OTHER - UPGRADE STOVE VENT FROM 6 INCH TO 10 INCH - DOES NOT INCLUDE MAKE - UP AIR IF REQUIRED - EACH
Line 2332	Note:
18Sep20 / 23Sep20	
Inv. 174	1 - KITCHEN: INSTALL GAS PIPING AND OTHER - GAS LINE R/I FOR MAIN FLOOR - STOVE - UP TO 3/4 INCH LINE
Line 2333	Note:
18Sep20 / 23Sep20	

INTERIOR DOORS & TRIM

Inv. 174	10 - MAIN FLOOR ONLY: UPGRADE TEN (10) MAIN FLOOR DOORS TO MASONITE EXPO HERITAGE SERIES LOGAN MOULDED PANEL DOOR
74	
Line 2360	(DOES NOT INCLUDE DEN) Note:
18Sep20 / 23Sep20	
Inv. 174	1 - DEN: INSTALL ONE (1) NO PANEL FROSTED SHAKER FRENCH DOOR.
75	
Line 2361	Note:
18Sep20 / 23Sep20	
Inv. 92	1 - 8' SOLID DOORS THOUGHOUT INTERIOR
5	4" CASING WITH BACKBAND
	8" BASEBOARDS
Line 1196	Note:
13Apr20 / 13Apr20	

MISCELLANEOUS

Inv. 131	4 - INSTALL FRAMELESS SHOWER ENCLOSURES IN: MASTER ENSUITE, BED #2, BED #4 AND DEN
38	
Line 1774	Note:
8Jul20 / 13Jul20	
Inv. 131	1 - Purchaser has attended a Structural appointment at the Decor Centre & has DECLINED any additional upgrades and accepts and acknowledges that there will be no further structural changes/additions/deletions to be made upon signing
44	
Line 1782	Note:
8Jul20 / 13Jul20	
Inv. 131	1 - Purchasers are aware & accepts that ANY changes made to upgrades after signing this Purchasers Extra Form are subject to a minimum administration fee
45	
Line 1783	Note:
8Jul20 / 13Jul20	
Inv. 131	1 - BONUS PACKAGE: \$7500.00 WORTH OF UPGRADES FROM VALERY HOMES DÉCOR CENTRE IS BEING APPLIED TOWARD THE COLOUR APPOINTMENT.
43	
Line 1784	Note:
8Jul20 / 13Jul20	
Inv. 197	1 - Purchasers are aware & accepts that ANY changes made to upgrades after signing this Purchasers Extra Form are subject to a minimum administration fee
112	
Line 2533	Note:
7Oct20 / 8Oct20	



CONSTRUCTION SUMMARY

Indulgence - 1 - 1 - Alta Vista Elev. A

Registere Plan Number: Municipal Address: 555 Highvalley Drive Closing: 15-Sep-20

Inv.174	1 - Purchaser has attended a Colour appointment at the Decor Centre & has DECLINED any additional upgrades and accepts and acknowledges that there will be no further structural changes/additions/deletions to be made	Note:
108		
Line 2394		
18Sep20 / 23Sep20		
Inv.174	1 - Purchasers are aware & accepts that ANY changes made to upgrades after signing this Purchasers Extra Form are subject to a minimum administration fee	Note:
109		
Line 2395		
18Sep20 / 23Sep20		

PAINT

Inv.174	1 - STAIRCASE: STAIN TWO SETS OF STAIRS	Note:
80		
Line 2366		
18Sep20 / 23Sep20		

PLUMBING

Inv.174	1 - KITCHEN: UPGRADE KITCHEN SINK TO	STRIVE K-5282-NA	Note:
73			
Line 2359			
18Sep20 / 23Sep20			
Inv.131	4 - INSTALL FOUR (4) HAND HELD SHOWERS: IN MASTER , ENSUITE 2, 3 AND DEN	POSI-TEMP SHOWER ONLY WITH 3 FUNCTION TRANSFER VALVE/TRIM AND SLIDE BAR WITH HAND SHOWER	MODEL# TL182EP/ 3372/T4171/ 62320/ 3669EP/ A725
39			
Line 1775			
8Jul20 / 13Jul20			
Inv.131	1 - KITCHEN: INSTALL POT FILLER	MODERN 2 HANDLE POT FILLER FAUCET WITH DUAL SHUT-OFFS	MODEL # S665 SRS
40			
Line 1776			
8Jul20 / 13Jul20			
Inv.131	1 - MASTER ENSUITE: INSTALL SHOWER HEAD - RAINSHOWER HEAD. **PLUMBING ONLY** TO COME FROM CEILING, NOT WALL.	INSTALL STANDARD SHOWER HEAD AND PURCHASER WILL REPLACE AFTER CLOSING.	Note:
22			
Line 1759			
8Jul20 / 13Jul20			
Inv.131	1 - BACKFLOW PREVENTER VALVE		Note:
26			
Line 1762			
8Jul20 / 13Jul20			
Inv.131	1 - KITCHEN: INSTALL EXTRA ROUGH-IN LINE FOR FRIDGE ICE MAKER WITH SHUT-OFF		Note:
27			
Line 1763			
8Jul20 / 13Jul20			
Inv.131	1 - SERVERY: INSTALL BAR SINK IN SERVEY. SEE SKETCH		Note:
28			
Line 1764			
8Jul20 / 13Jul20			



CONSTRUCTION SUMMARY

Indulgence - 1 - 1 - Alta Vista Elev. A

Registere Plan Number: Municipal Address: 555 Highvalley Drive Closing: 15-Sep-20

Inv.179	1 - PANTRY: INSTALL EXTRA ROUGH-IN 1/4" COLD WATER LINE FOR FRIDGE ICE MAKER WITH SHUT OFF VALVE
110	
Line 2425	THIS IS IN ADDITION TO THE WATERLINE FOR THE KITCHEN FRIDGE
Note:	
23Sep20 / 24Sep20	

STAIRS

Inv.174	1 - STAIRCASE: UPGRADE TO DISPLAY 2B SPOON SERIES, 1/2" METAL SINGLE SPOON/DBL SPOON, TEXTURED BLACK
82	
Line 2368	Note:
18Sep20 / 23Sep20	
Inv.174	1 - STAIRCASE: UPGRADE TO VICTORIAN POSTS WITH CAP
83	
Line 2369	Note:
18Sep20 / 23Sep20	

VACCUM/BELL

Inv.131	6 - INSTALL SIX (6) CONDUITS - 1 1/4" ORANGE FLEX CONDUIT APPROX. 35FT FOR TV'S ON THE WALLS. TO GO ABOVE FIREPLACE IN THE GREAT ROOM AND MASTER BEDROOM, BED #2, #3, #4 AND IN THE DEN.
10	
Line 1741	Note: IN BEDROOMS THEY ARE TO BE PLACED 6 FEET UP FROM THE FINISHED FLOORS WITH THE OTHER CONDUIT RIGHT BELOW AT STANDARD PLUG LEVEL
8Jul20 / 13Jul20	
	HEIGHT ABOVE BOTH FIREPLACES TO BE AS PER USUAL.
Inv.131	1 - CENTRAL VACUUM - CENTRAL VAC PIPING COMPLETE TO GARAGE - ONE OUTLET IN BASEMENT
18	
Line 1754	Note:
8Jul20 / 13Jul20	
Inv.131	1 - SURROUND SOUND - ROUGH-IN SPEAKER WIRES (X5) SUBWOOFER CABLE (X1) 6.5 INCH SPEAKER ROUGH-IN BRACKETS (X5)
20	
Line 1755	Note:
8Jul20 / 13Jul20	
Inv.131	1 - CENTRAL VACUUM - CENTRAL VAC KICKPLATE ROUGH-IN ONLY
19	
Line 1757	Note:
8Jul20 / 13Jul20	
Inv.131	1 - INSTALL CONDUIT - 1 1/4" ORANGE FLEX CONDUIT APPROX. 15FT FOR ATTIC
12	
Line 1743	Note:
8Jul20 / 13Jul20	
Inv.131	1 - INSTALL: WIRELESS ACCESS POINT PACKAGE - 2-CAT6 NETWORK CABLES AND 2-UBIQUITI AC LITE ACCESS POINTS. TO GO IN GREAT ROOM AND DEN
13	
Line 1745	Note:
8Jul20 / 13Jul20	
Inv.131	4 - INSTALL ADDITIONAL CABLE- CAT-5E NETWORK CABLE: TO GO IN BED #2, #3, #4, DEN
9	
Line 1746	TO BE INSTALLED UP ON THE WALL FOR WALL MOUNTED TV
Note:	
8Jul20 / 13Jul20	

WINDOWS



CONSTRUCTION SUMMARY

Indulgence - 1 - 1 - Alta Vista Elev. A

Registere Plan Number: Municipal Address: **555 Highvalley Drive** Closing: **15-Sep-20**


Inv. 131			4 - BASEMENT: INSTALL LARGER BASEMENT WINDOW -FOUR (4) TO 36 X 30		
41					
Line 1777		Note:			
8Jul20 / 13Jul20					

2071

✓

612

INDULGENCE ALTA VITA 4,438 SQFT

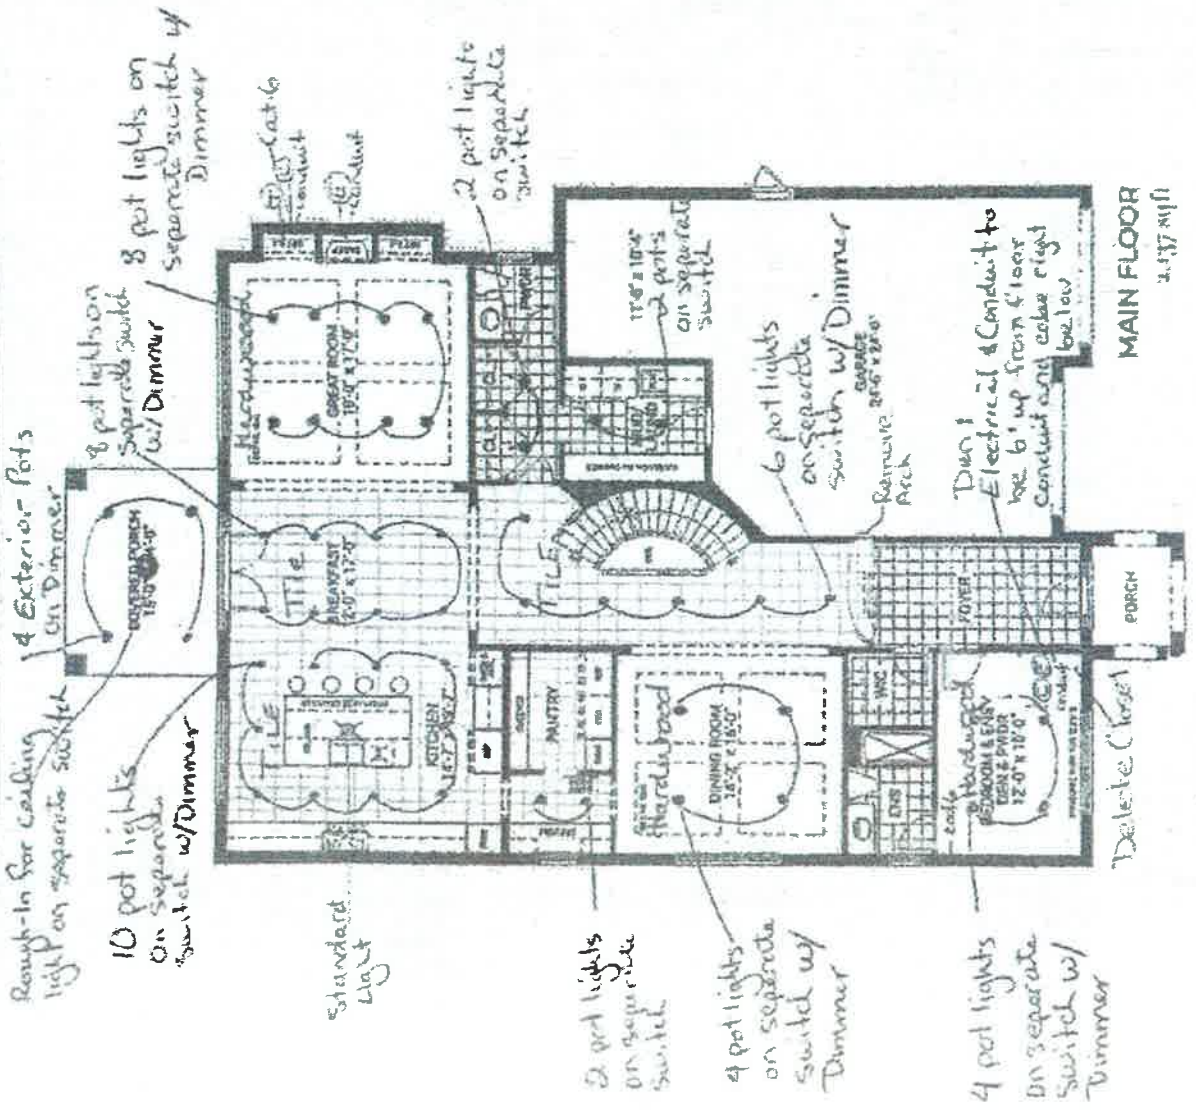

Pot Lights

Kitchen	10	w/dimmer
Breakfast	8	w/dimmer
Great Room	8	w/dimmer
Security	2	
Side Hall	2	
Main Hall	6	w/dimmer
Dining Room	4	w/dimmer
Den	4	w/dimmer
Master Rm	2	

Exterior Pots

Porch - main floor w/dimmer 4
Porch - 2nd floor Master w/dimmer 4

10 Doors - Lincoln Park Door

1 Door - No Panel Frosted Shaker
French Door

RECEIVED
SEP 22 2020

207

8/1

4




4 exterior pots on
separate switch w/
Dinner

Rough in for ceiling
light on separate switch

Install
Porch
Doors

Double French
Doors

79

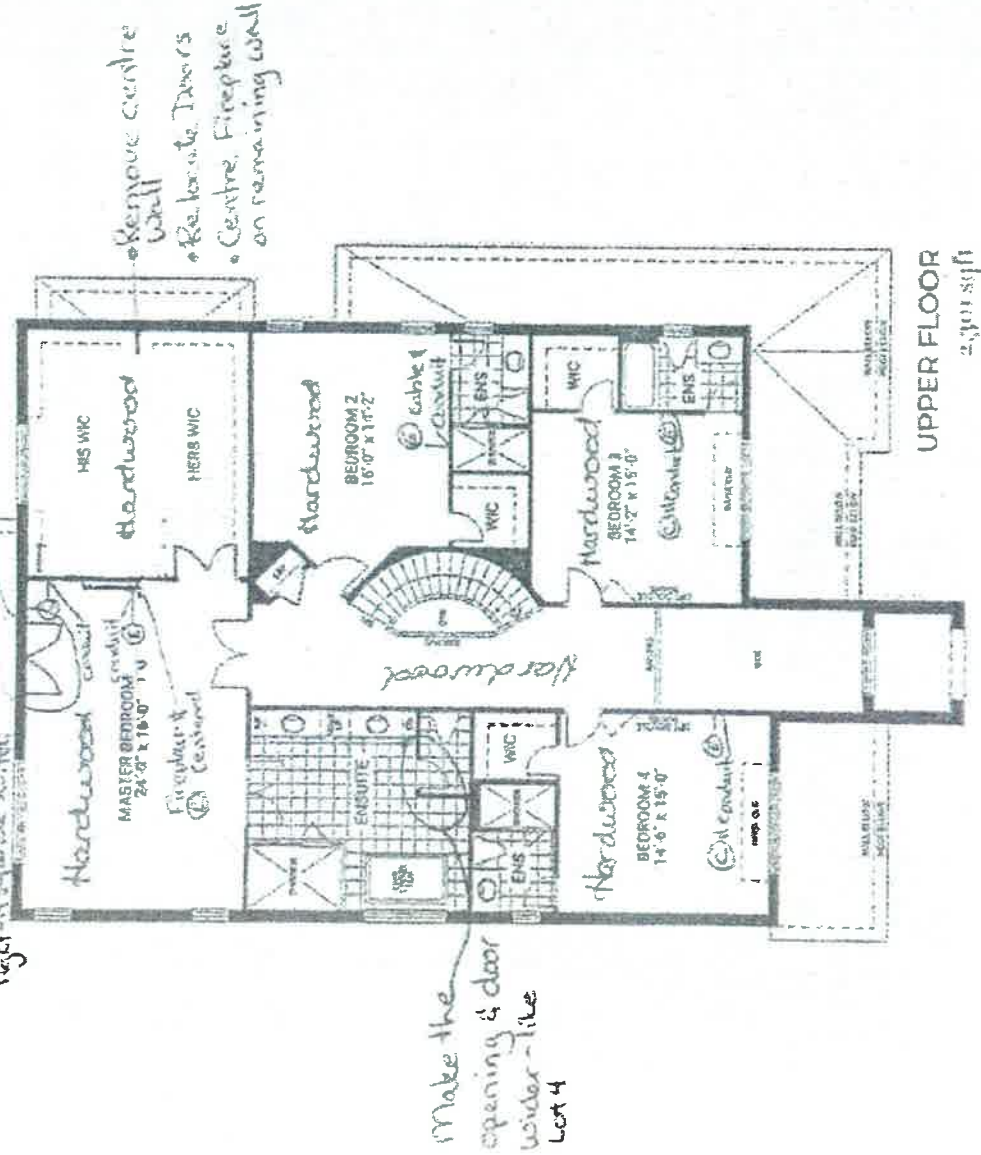

*Note: Bed 2, 3 & 4

Conduits and electrical plugs
to be installed to feet off
finished floors. Cable and conduit
to be right below it standard height

RECEIVED

SEP 22 2020


2071

2071

INDULGENCE



ALTAVILLA 4738 SQ. FT.

2071

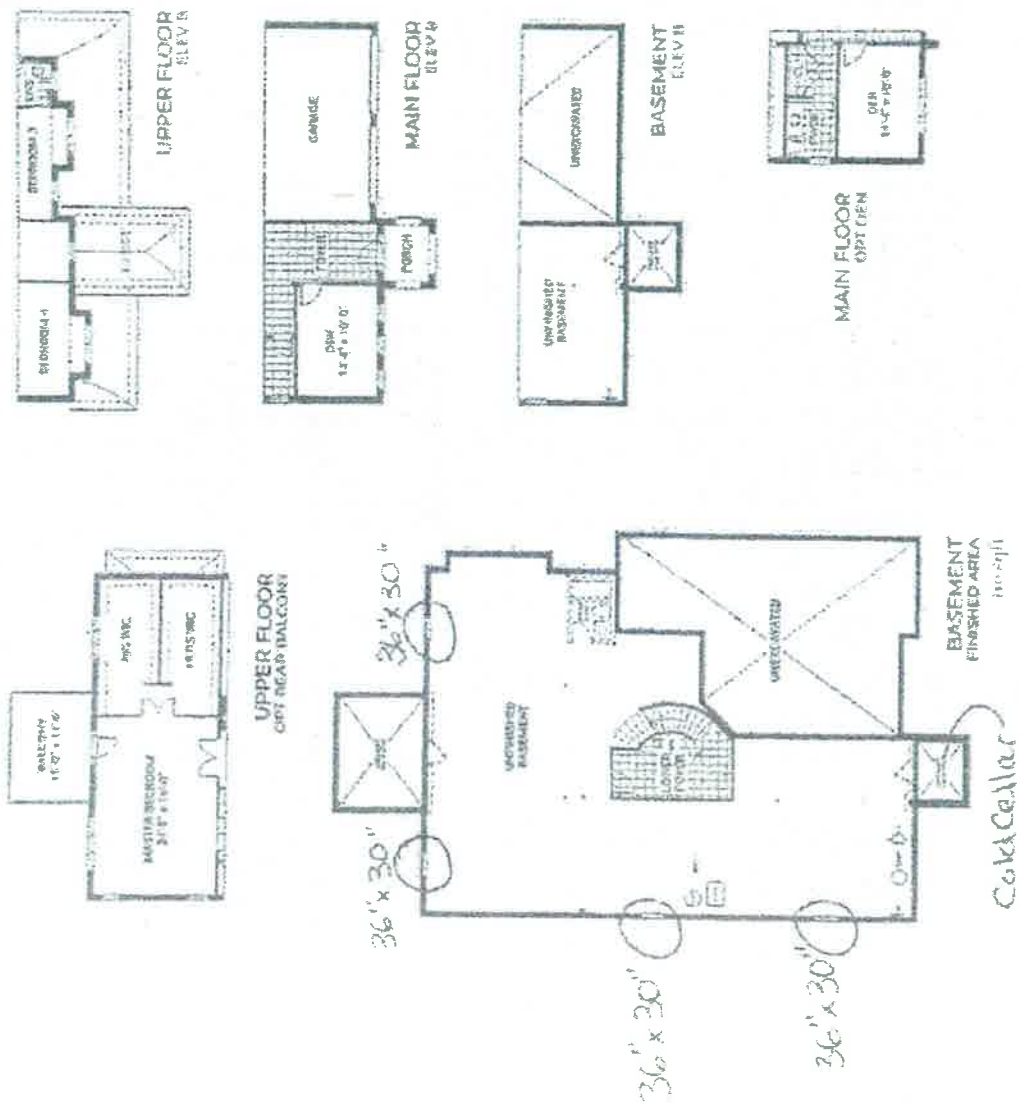

RECEIVED
SEP 22 2020

OPTION 2

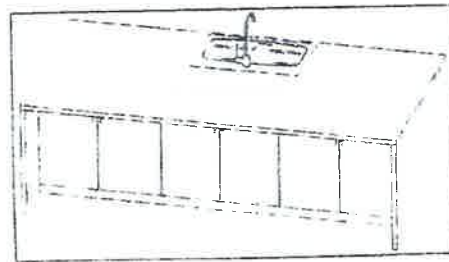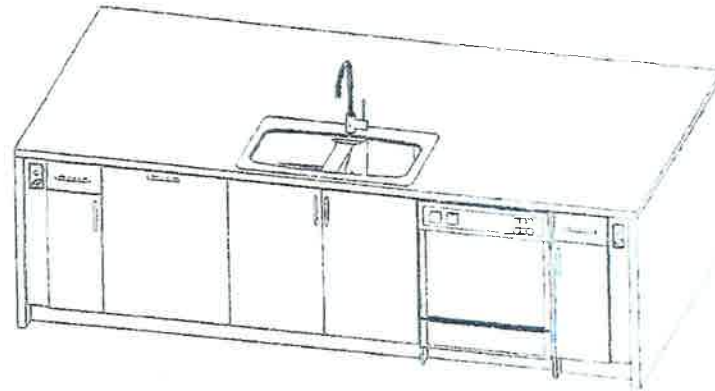

Install additional 8" to island to accommodate for plugs


This sketch is for DESIGN PURPOSES ONLY - It is not meant to be an exact rendition

	PROJECT
VALLEY HOMES HIGH VALLEY ESTATES LOT 1	
	
Drawn by: _____ Date: October 13, 2020 Scale: 1/4" = 1'-0"	
Approved by: _____ Date: _____	

RECEIVED

OCT 15 2020

SERVERY

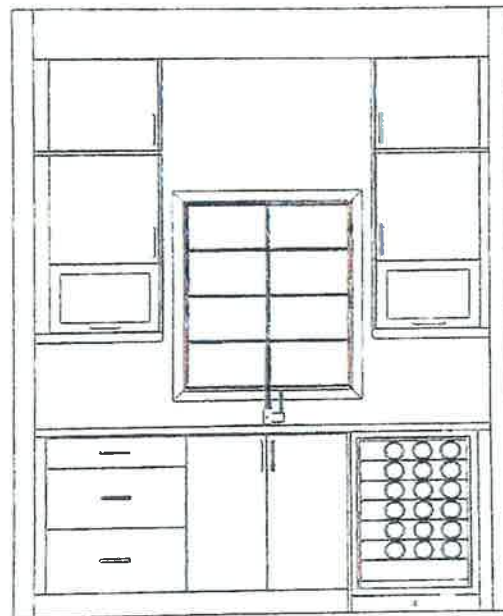


This sketch is for DESIGN PURPOSES ONLY - It is not meant to be an exact rendition

 FRENDEL ARCHITECTS
VALERY HOMES HIGH VALLEY ESTATES LOT 1
 
Drawn By: Date: October 13, 2020 Scale: Not To Scale
Approved By Builder: _____ Date: _____

RECEIVED
OCT 15 2020

RECEIVED

SEP 22 2020

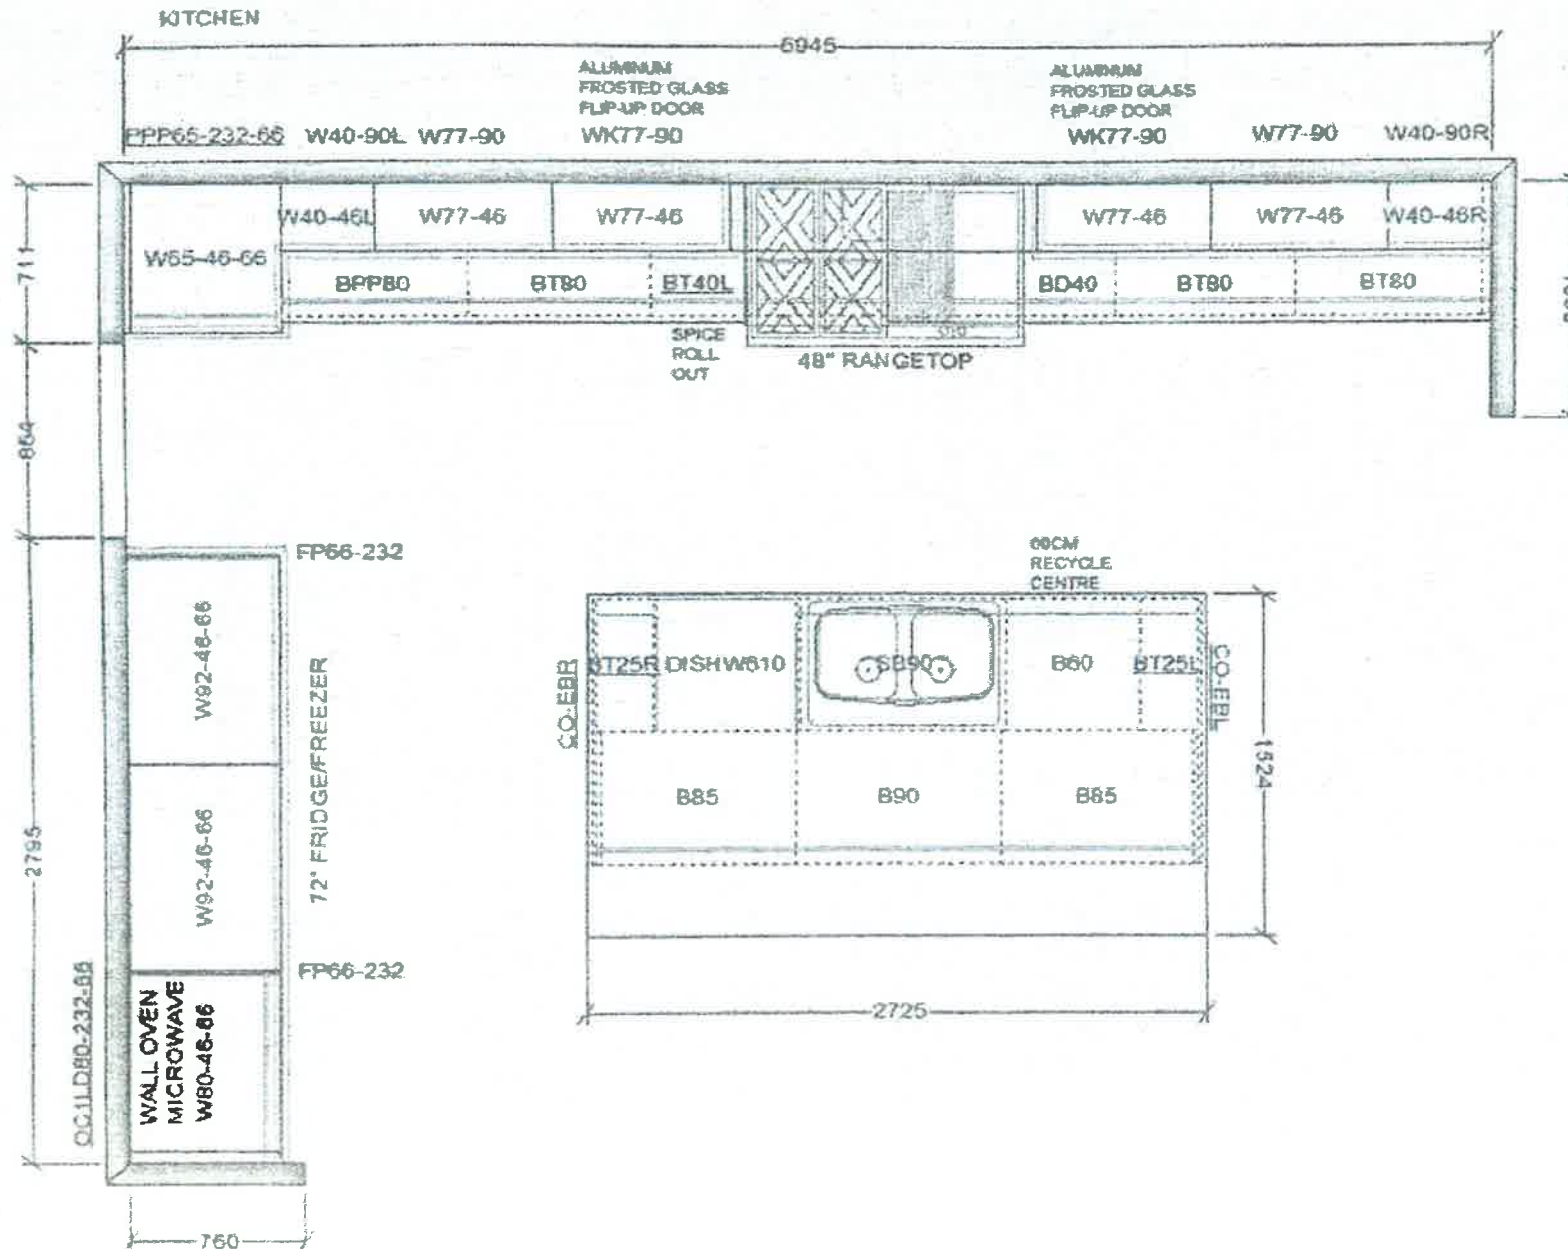

VALERY HOMES
HIGHVALLEY ESTATES
LOT 1



Drawn By:
Date: September 17, 2020
Scale: Not To Scale



Approved By Builder:

Date:

This sketch is for DESIGN PURPOSES ONLY - It is not meant to be an exact rendition.

RECEIVED

SEP 22 2020

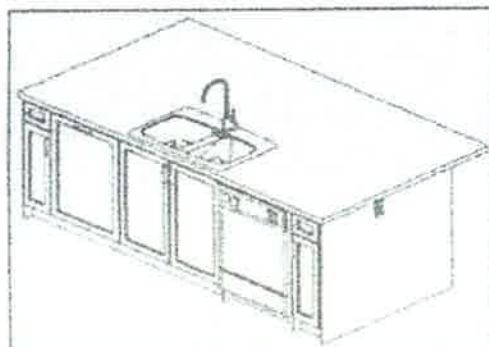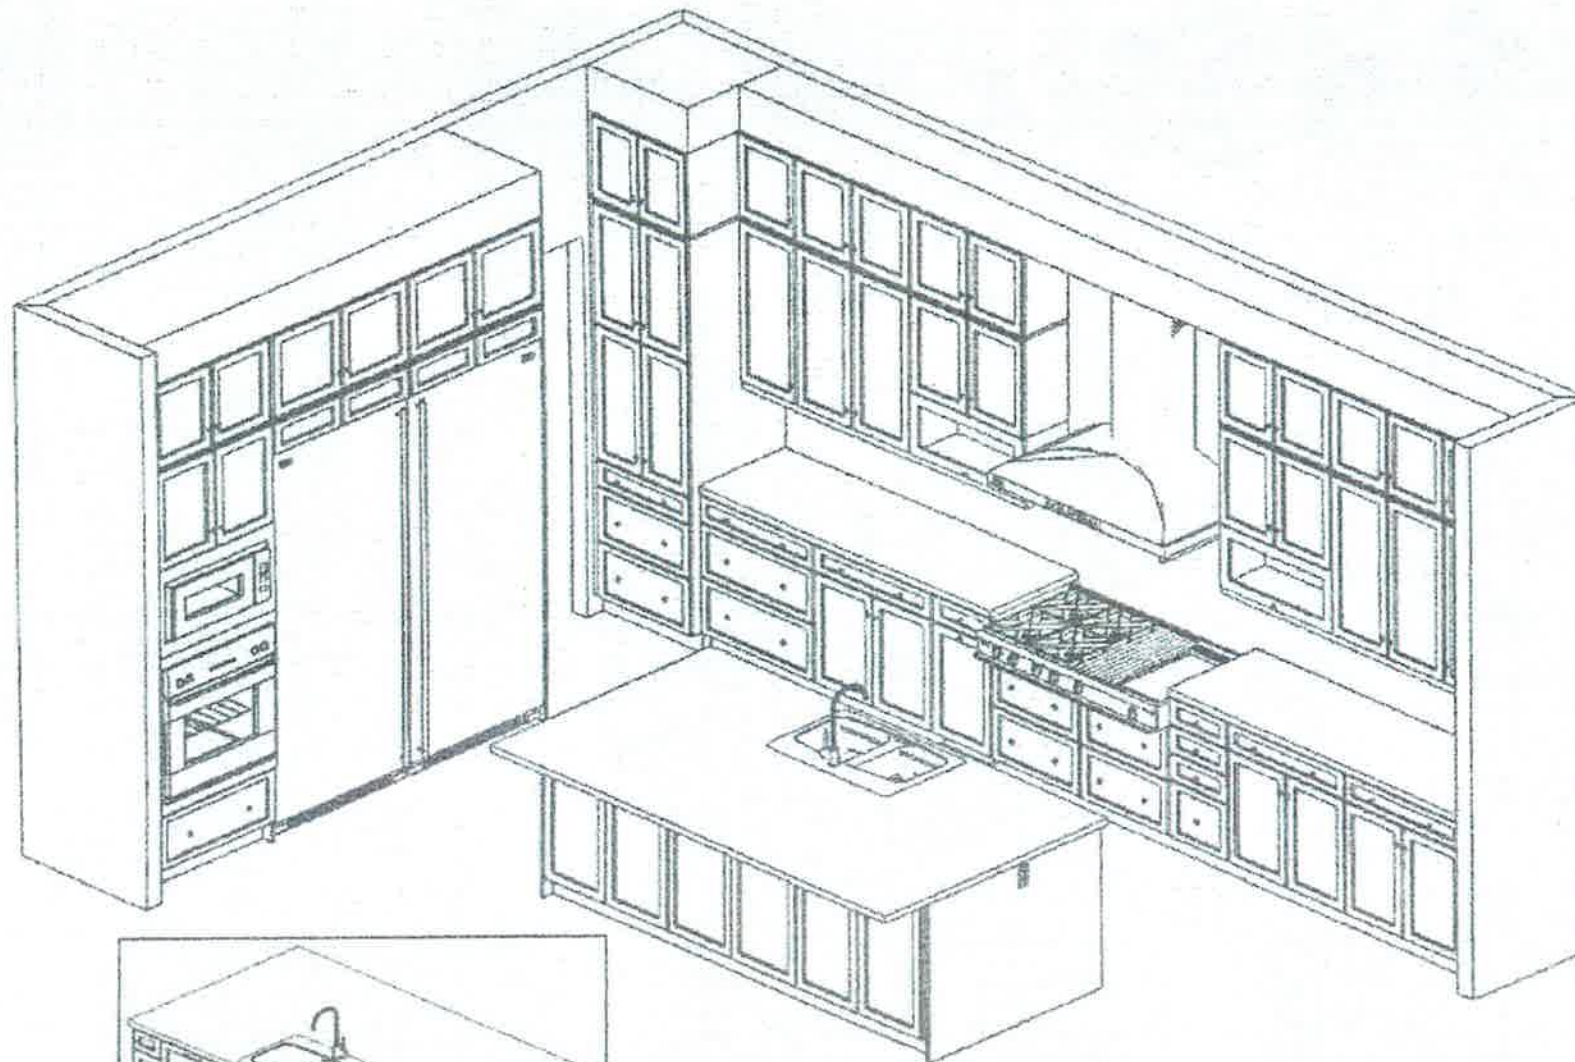

This sketch is for DESIGN PURPOSES ONLY - It is not meant to be an exact rendition.



VALERY HOMES
HIGHVALLEY ESTATES
LOT 1





Drawn By:
Date: September 17, 2020
Scale: Not To Scale

Approved By Builder:

Date:

RECEIVED
SEP 22 2020

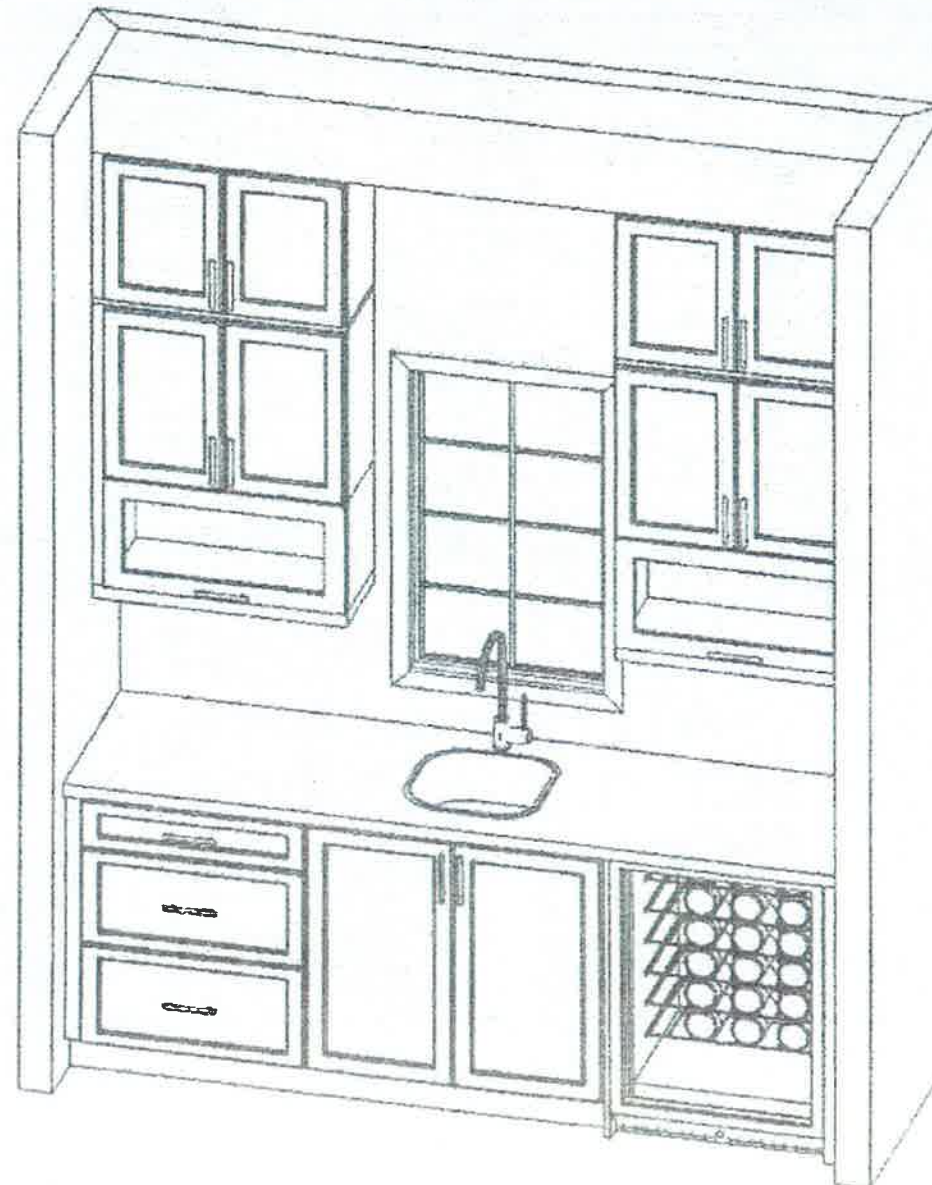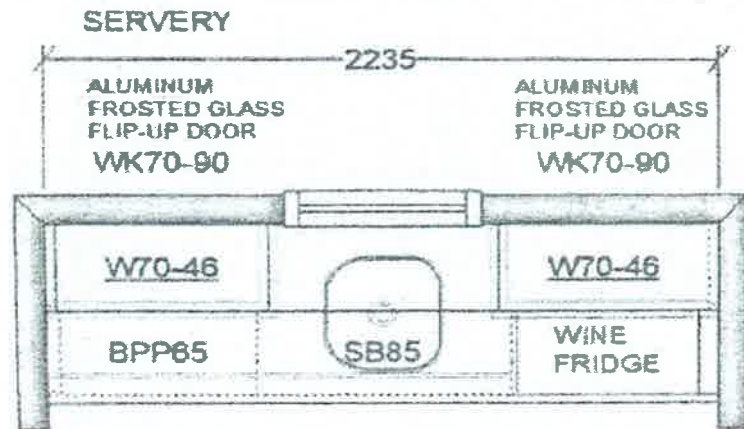

VALERY HOMES
HIGHVALLEY ESTATES
LOT 1

SK



Drawn By:
Date: September 17, 2020
Scale: Not To Scale

Approved By Builder:

Date:

RECEIVED

SEP 22 2020

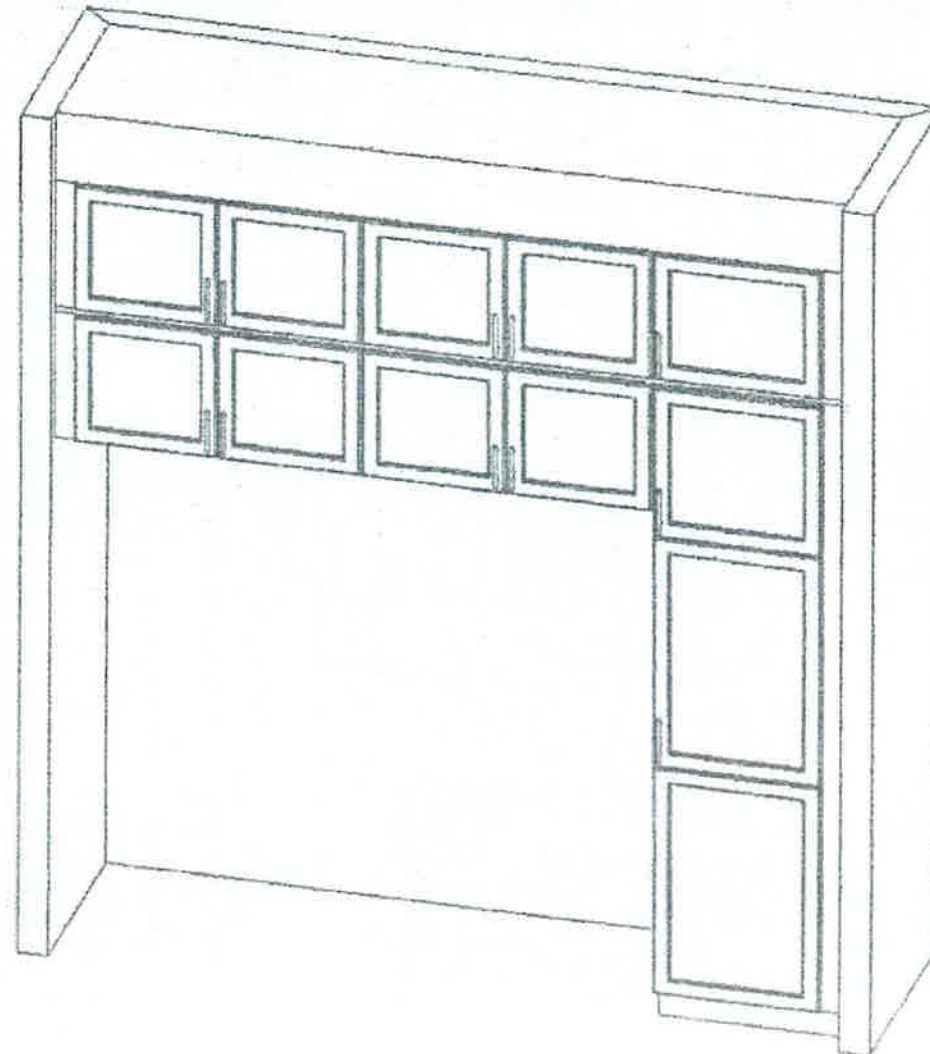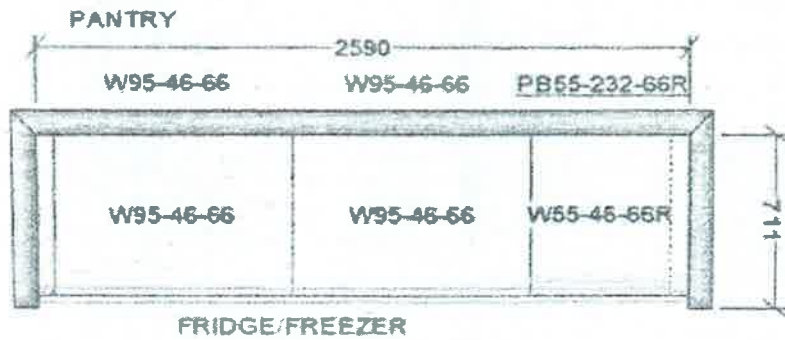

VALERY HOMES
HIGHVALLEY ESTATES
LOT 1

PA

Drawn By:
Date: September 17, 2020
Scale: Not To Scale





Approved By Builder:

Date:

This sketch is for DESIGN PURPOSES ONLY – It is not meant to be an exact rendition.

RECEIVED

SEP 22 2020

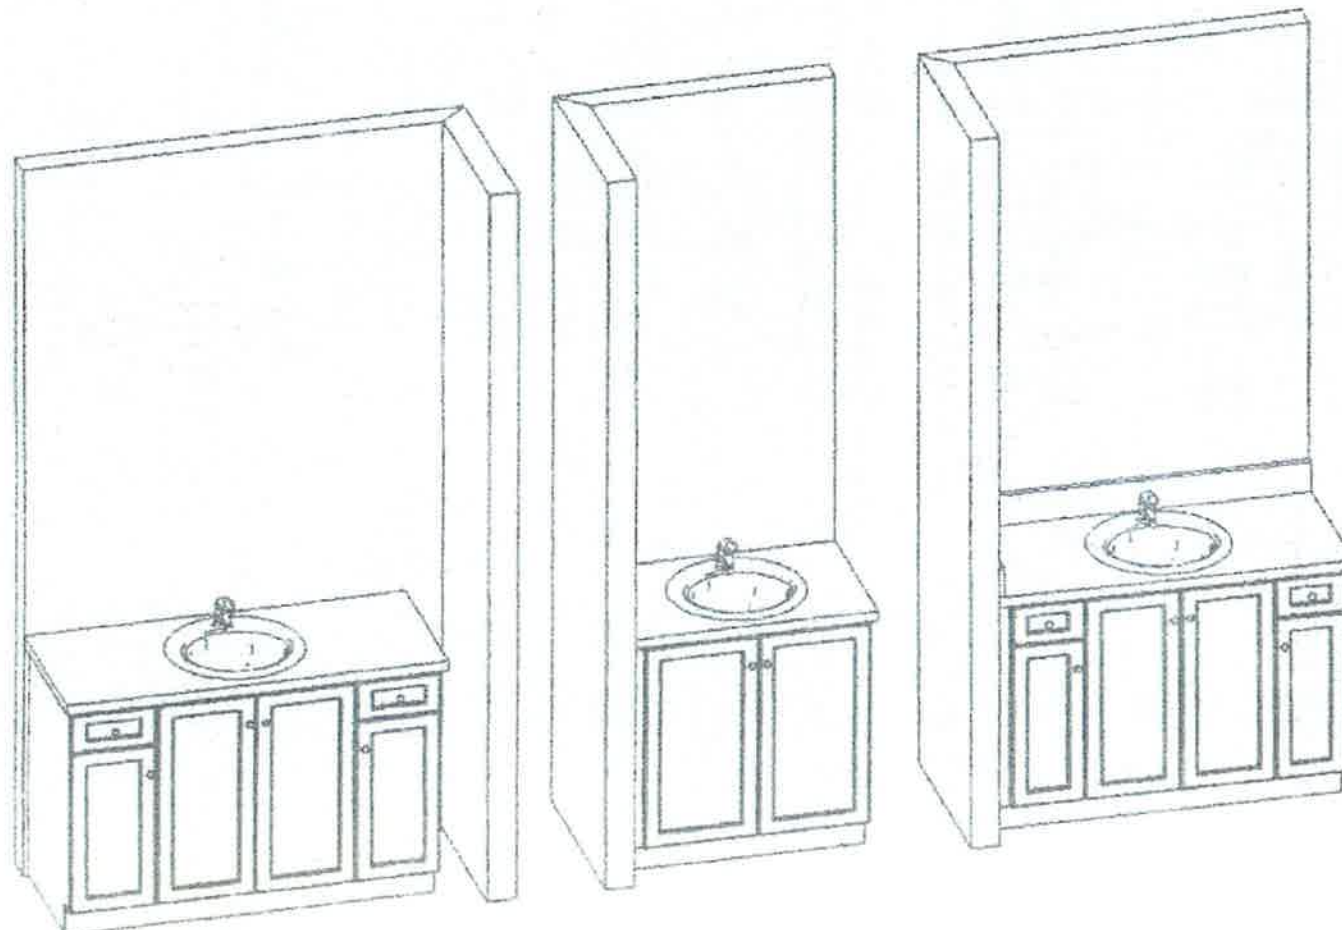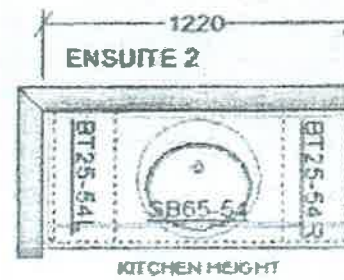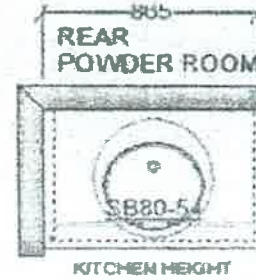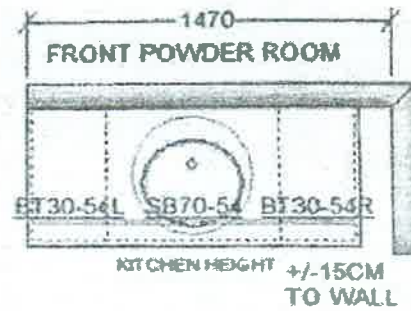

This sketch is for DESIGN PURPOSES ONLY – It is not meant to be an exact rendition.



VALERY HOMES
HIGHVALLEY ESTATES
LOT 1

Handwritten signature/initials.




Drawn By:
Date: September 17, 2020
Scale: Not To Scale

Approved By Builder:

Date:


RECEIVED

SEP 22 2020

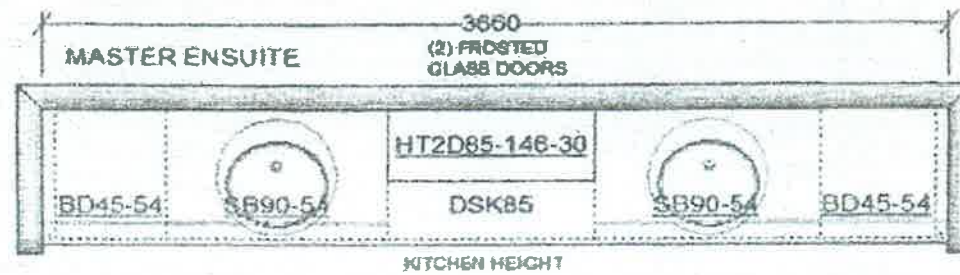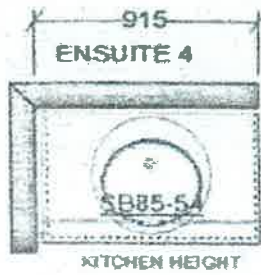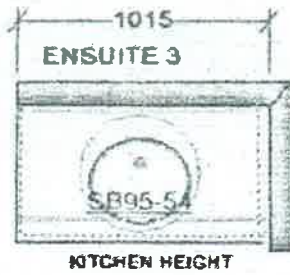

VALERY HOMES
HIGHVALLEY ESTATES
LOT 1

PL

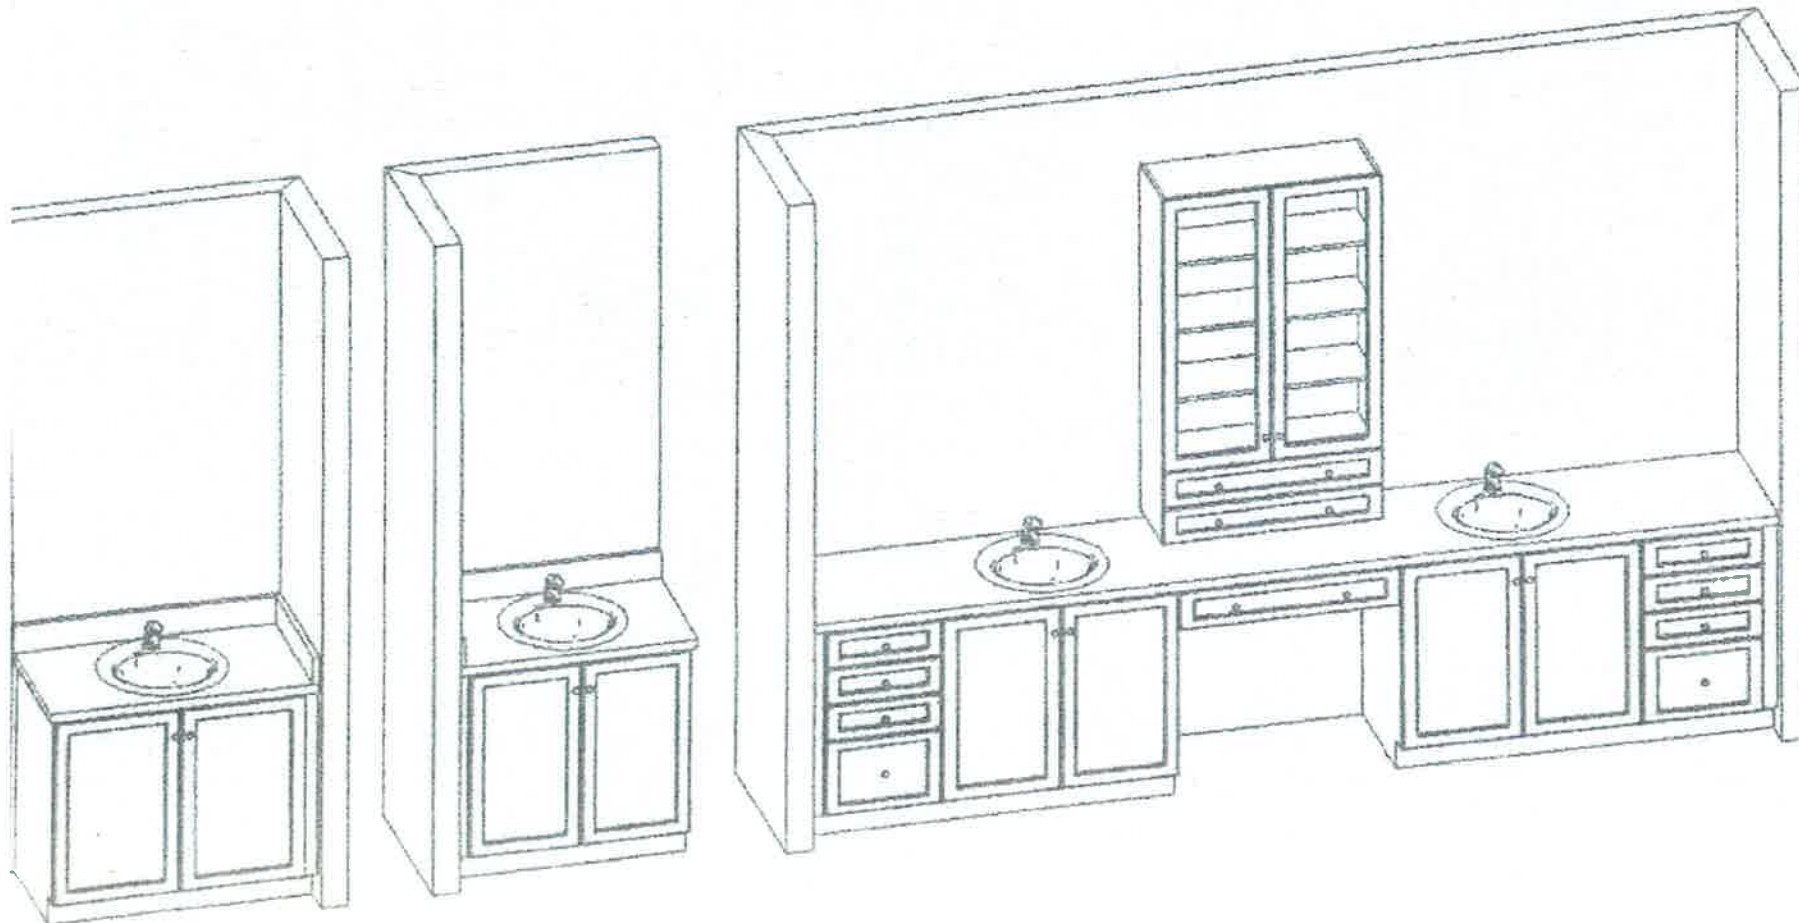

Drawn By:
Date: September 17, 2020
Scale: Not To Scale




Approved By Builder:

Date:

This sketch is for DESIGN PURPOSES ONLY - It is not meant to be an exact rendition.

RECEIVED

SEP 22 2020

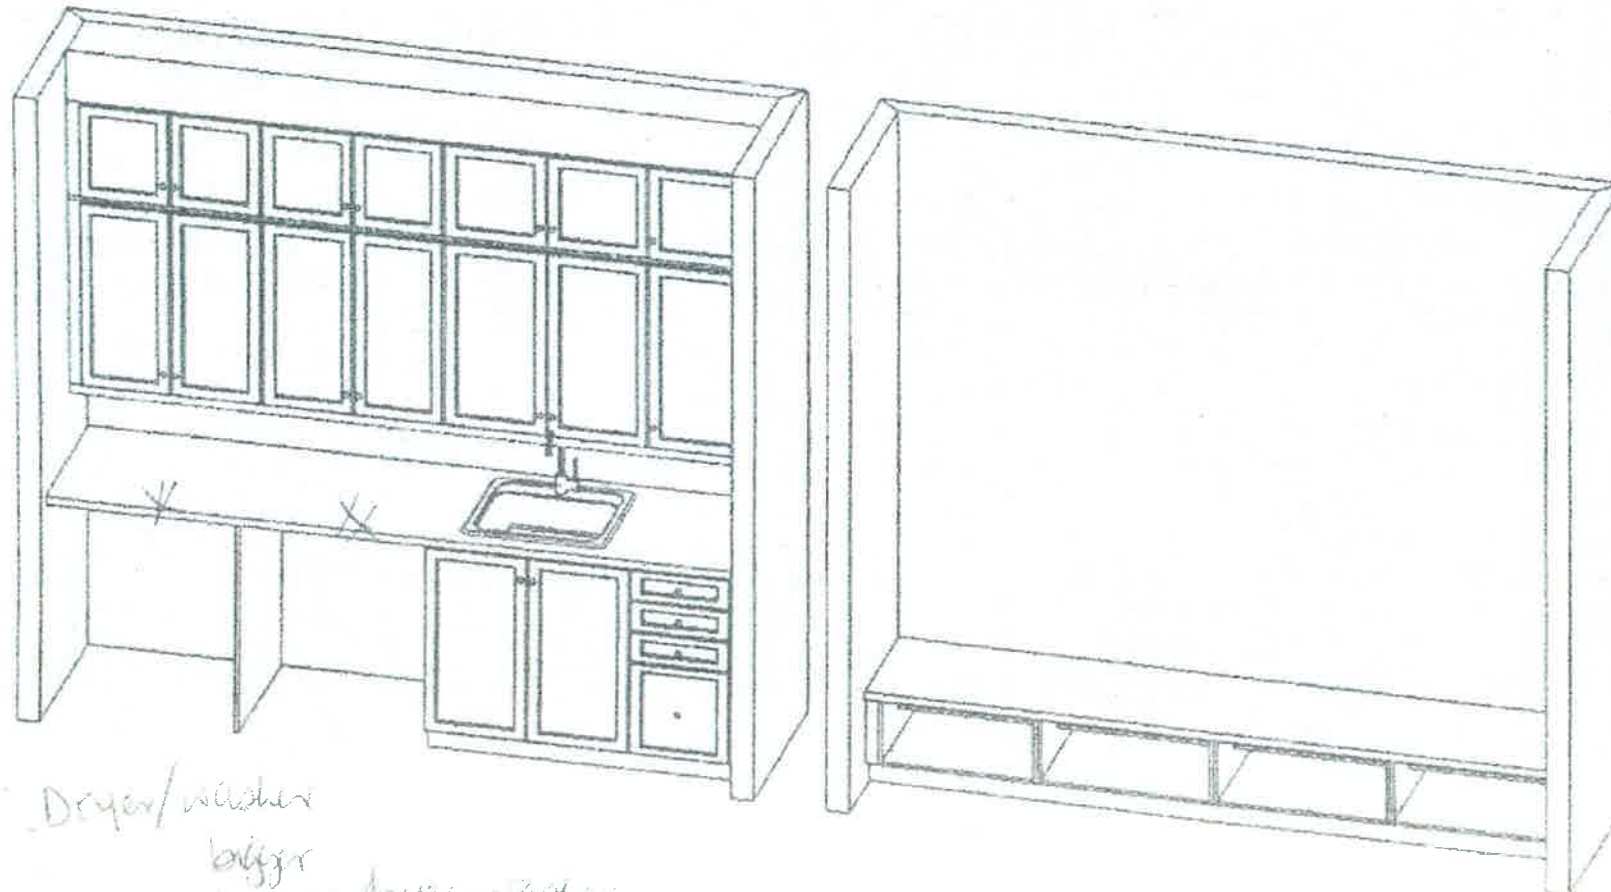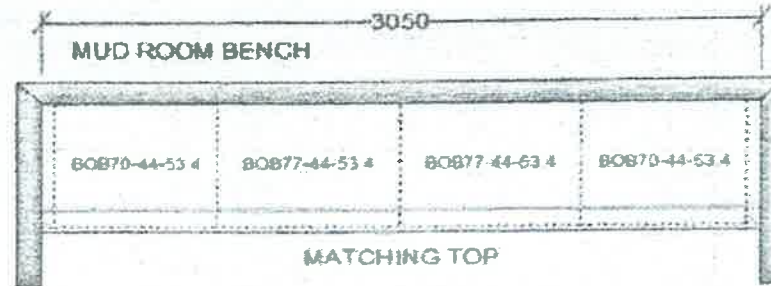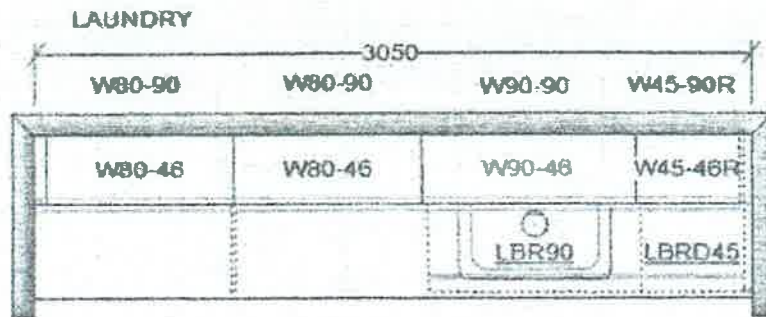

VALERY HOMES
HIGH VALLEY ESTATES
LOT 1



Drawn By:
Date: September 17, 2020
Scale: Not To Scale

Approved By Builder:

Date:

This sketch is for DESIGN PURPOSES ONLY - It is not meant to be an exact rendition.

Lot 1

210

BACK



* Main Floor Only
x10


Masonite
Expo™
Heritage®
Series
Lincoln
Park™
Moulded
Panel
Door



WHERE TO BUY

Door • Moulded Panel Door •
Masonite Expo™ Heritage®
Series


\$250/door

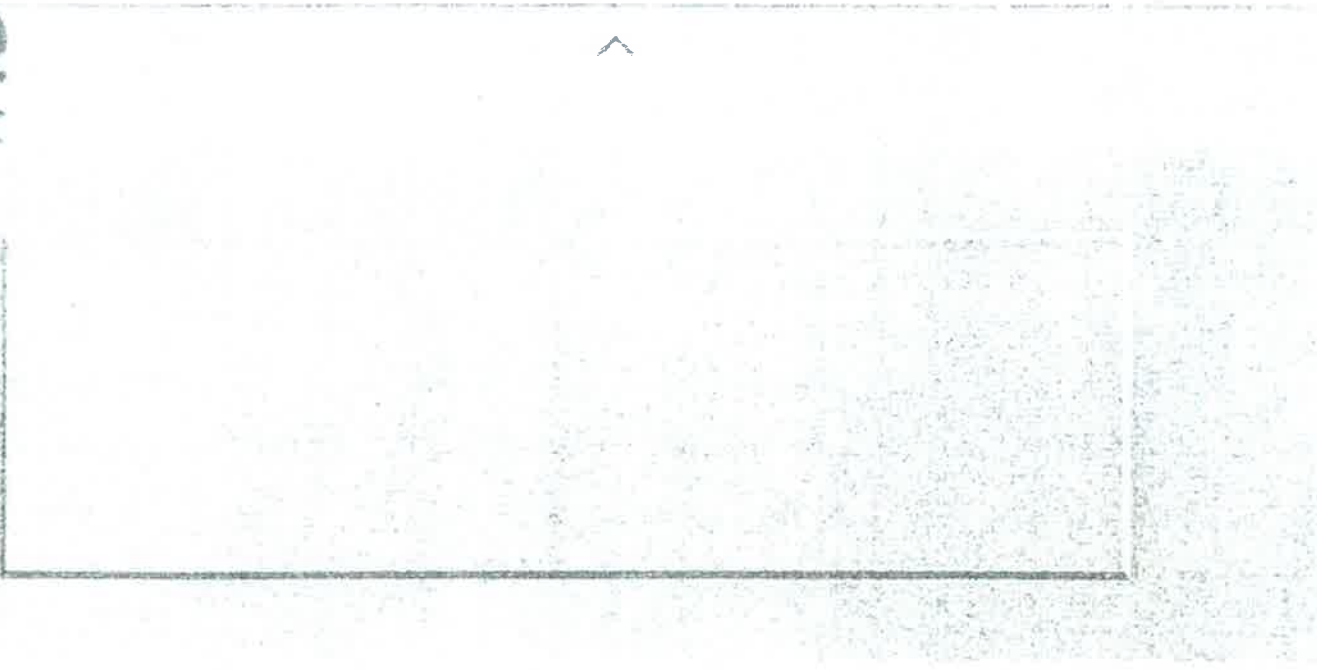

RECEIVED
SEP 22

THE GOLD LOCK
OF KOHLER,

Not 1
Kitchen

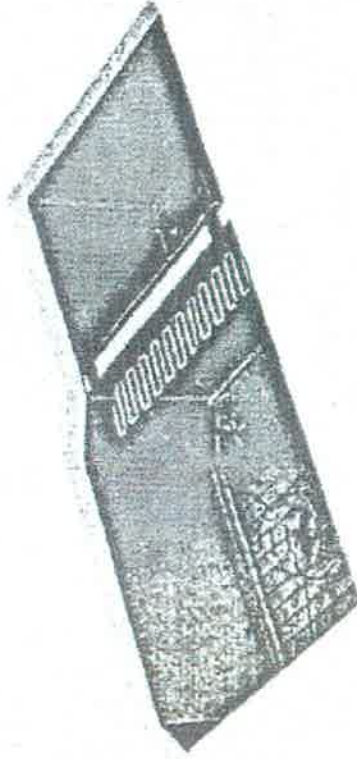

< >

Strive®

35-1/2" x 20-1/4" x 9-5/16" under-mount
extra-large/medium double-bowl kitchen
sink with sink rack

K-5282-NA

CAD \$1,517.00 List
Price

COLOR: Not Applicable

NA

This Strive kitchen sink offers professional style with easy-to-clean curved corners. **Made of** thick, premium quality 16-gauge stainless steel, the unique extra-large offset bowls maximizing cabinet space.

making room for your largest bakeware and cookware. Strive features a sound-absorption system that significantly reduces disposal and

Want to know more?

[Read our Cookie Policy](#)


RECEIVED

SEP 22 2021

Not a Vantry 102x Fridges

CA

Whirlpool 21 Cu. Ft. Side-by-Side Refrigerator - WRS321SDHZ | The Brick

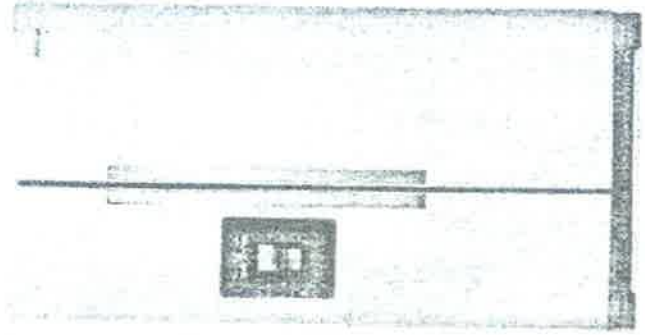

**WHIRLPOOL 21
CU. FT. SIDE-BY-
SIDE
REFRIGERATOR -
WRS321SDHZ**

\$ 1,399.00

SKU: WRS321DZ VSN: WRS321SDHZ

Dimensions

Height: 33.12' (84.1 cm)
Width: 24.82' (69.2 cm)
Depth: 23.62' (59.4 cm)

Give your family the ease and access of this Whirlpool wide side-by-side refrigerator that was created specifically to serve you and your busy lifestyle. With 21 cubic feet inside, this Whirlpool fridge is packed with unique storage features that make unloading the groceries a simple task. Use the deli drawer to store your favourite meats and cheeses, and then fill the can caddy with your ideal beverages to free up even more shelf space. Thirsty? Pour yourself a glass of filtered water and ice from the exterior dispenser and enjoy the seamless outside look thanks to hidden hinges.



RECEI
SEP 21

Unique Features

Can Caddy:

Free up shelf space and get more flexibility using this in-door can caddy that holds cans and bottles.

Frameless Glass Shelves:

Make the most of each shelf with wall-to-wall frameless glass shelves, which offer greater storage flexibility.

Adjustable Gallon Door Bins:

Move these adjustable bins anywhere in the door for increased loading flexibility when and where you need it.

Deli Drawer:

Store plenty of meat and cheese with a deli drawer designed to keep your favourite snacks at an optimal temperature.

LED Interior Lighting:

Light is cast inside the refrigerator to eliminate dark corners and to make your food look good.

Exterior Ice and Water Dispenser with EveryDrop™ Filtration

Access fresh filtered water and ice without ever opening the refrigerator door using dual pod dispensers.

Tap Touch Controls:

Clean these controls as easily as you use them.

Hidden Hinges:

Get a seamless look with door hinges that stay out of sight.

Electronic Temperature Controls:

Choose the ideal temperature for whatever foods you're storing with convenient, up-front controls.

Fingerprint Resistant Stainless Steel:

Resist fingerprints and smudges with steel that easily erases clean and looks sleek.

Factory-Installed Ice Maker:

Forget about refilling ice trays with this pre-installed ice maker that ensures you always have plenty of ice on hand.

Adaptive Defrost:

Adaptive defrost automatically monitors the freezer environment and runs the cycle only when necessary, saving time and energy.

LED Dispenser Night Light:

Easily find water and ice at night when you turn on the dispenser night light.

General Details

VSN WRS321SDHZ

UPC/EIN 883049435033

<https://www.thebrick.com/products/whirlpool-21-cu-ft-side-by-side-refrigerator-wrs321sdhz> 9/17/2020

RECEIVED

SEP 22 202

General Details

Appearance Features	Cooler Lock, Fingerprint-Resistant
Refrigeration Features	Exterior Water Dispenser, Exterior Ice Dispenser, Ice Maker, Frost-Free
Refrigerator Type	Side-by-Side
Finish Colour	Fingerprint-Resistant Stainless Steel
Control Panel	Electronic Touch
Lighting	LED
Ice Maker	Factory Installed
Water Dispenser	• Filtered Water • Ice Dispenser Lock • Measured/Metered Fill • Night Light

Energy Consumption

120 V

Door

Side-by-Side

Refrigerator Details

Refrigerator Bins
1 Dairy, 1 Fixed Full-Width, 3 Adjustable Gallon

Refrigerator Shelves
4

Freezer Details

Freezer Shelves
3 Adjustable Full-Width Glass

Installation Details

Installation Requirements
https://api.whirlpoolcentral.ca/resources/documents/WRS321SDHV_use_and_care_en.pdf

14071



General Details

Instruction Manual (PDF)	Instruction Manual
(Click on links with product details to download documents. WRS121SDHZ model features document_en.pdf)	

Additional Details

Safety Details	See Owner's Manual
----------------	--------------------


Additional Dimensions

Refrigerator Capacity (cu. ft.)	14.62
Freezer Capacity (cu. ft.)	6.77
Total Capacity (cu. ft.)	21.4
Depth with Door Open 90 degrees (in.)	49.3125
Other Dimensions	▪ Height To Top Of Cabinet: 55.625 ▪ Depth Excluding Handles: 31.625 ▪ Depth Closed including Handles: 33.625

RECEIVED
SEP 22

2571 (1 of 2)

PRODUCT DIMENSIONS

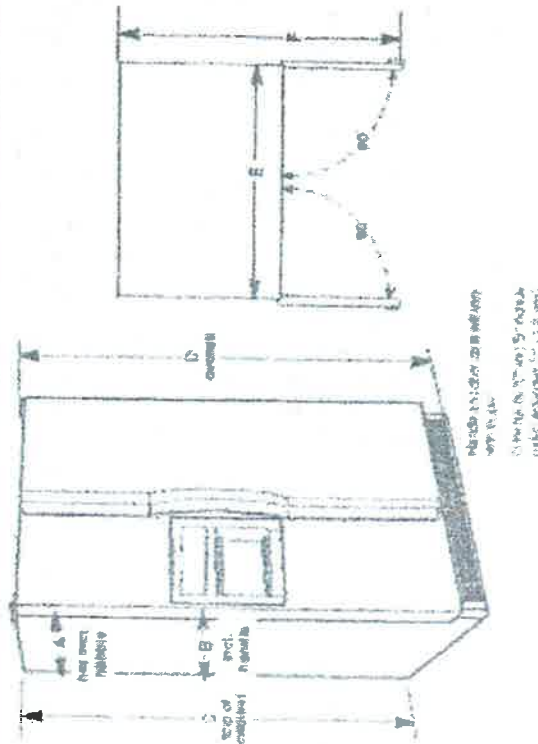

Model Number/ Capacity	Depth Without Handles "A"	Depth With Handles "B"	Height to top of Cabinet "C"	Overall Height "D"	Cabinet Width "E"	Depth with Doors Open 90° "F"
WRS315SDH 24.57 cu. ft.	31 1/8" (80.33 cm)	33 1/8" (85.41 cm)	68 1/8" (174.31 cm)	69 1/8" (176.85 cm)	36 1/8" (90.11 cm)	49 1/8" (125.25 cm)
WRS315SNH 25.1 cu. ft.	31 1/8" (80.33 cm)	33 3/8" (85.41 cm)	68 7/8" (174.31 cm)	69 7/8" (176.85 cm)	35 7/8" (90.11 cm)	49 1/8" (125.25 cm)
WRS312SNH 21.88 cu. ft.	31 1/8" (80.33 cm)	33 1/8" (85.41 cm)	65 5/8" (174.31 cm)	66 1/8" (169.23 cm)	32 1/8" (84.12 cm)	49 1/8" (125.25 cm)
WRS335SDH 24.54 cu. ft.	31 1/8" (80.33 cm)	33 3/8" (85.41 cm)	68 1/8" (169.23 cm)	69 1/8" (176.85 cm)	35 1/8" (90.11 cm)	49 1/8" (125.25 cm)
WRS311SDH 21.42 cu. ft.	31 1/8" (80.33 cm)	33 1/8" (85.41 cm)	65 1/8" (174.31 cm)	66 1/8" (169.23 cm)	32 1/8" (84.12 cm)	49 1/8" (125.25 cm)
WRS315SDH 24.57 cu. ft.	31 1/8" (80.33 cm)	33 1/8" (85.41 cm)	68 1/8" (174.31 cm)	69 1/8" (176.85 cm)	32 1/8" (84.12 cm)	49 1/8" (125.25 cm)
WRS355SDH 26.51 cu. ft.	31 1/8" (80.33 cm)	33 1/8" (85.41 cm)	68 1/8" (174.31 cm)	69 1/8" (176.85 cm)	35 7/8" (90.18 cm)	49 1/8" (125.25 cm)
WRS315SNH 25.1 cu. ft.	31 1/8" (80.33 cm)	33 3/8" (85.41 cm)	68 7/8" (174.31 cm)	69 7/8" (176.85 cm)	35 7/8" (90.11 cm)	49 1/8" (125.25 cm)
WRS335SDH 21.42 cu. ft.	31 1/8" (80.33 cm)	33 1/8" (85.41 cm)	65 1/8" (174.31 cm)	66 1/8" (169.23 cm)	32 1/8" (84.12 cm)	49 1/8" (125.25 cm)
WRS325SDH 22.50 cu. ft.	31 1/8" (80.33 cm)	33 1/8" (85.41 cm)	68 1/8" (174.31 cm)	69 1/8" (176.85 cm)	35 1/8" (90.11 cm)	49 1/8" (125.25 cm)

See page 10 for detailed dimensions and capacity information. Dimensions are for planning purposes only. For complete details, see installation instructions included with product. Specifications subject to change without notice.

Rev. 01/15/2012

RECEIVED
SEP 2

Whirlpool®

Side by Side Refrigerator

PRODUCT MODEL NUMBERS


WRS315SDH* WRS315SNH*
WRS315SDH* WRS315SNH*
WRS315SDH* WRS315SNH*
WRS315SDH* WRS315SNH*

Electrical: A 115-volt, 60-Hz, 40-amp, 15- or 20-amp fused, grounded electrical supply is required. It is recommended that a separate circuit serving only your refrigerator be provided. Use an outlet that cannot be turned off by a switch. Do not use an extension cord.

Water: A cold water supply with water pressure of between 30 and 120 psi (207 and 827 kPa) is required to operate the water dispenser and ice maker. If you have questions about your water pressure, call a licensed, qualified plumber.

Reverse Osmosis Water Supply: The pressure of the water supply coming out of a reverse osmosis system going to the water inlet valve of the refrigerator needs to be between 30 and 120 psi (207 and 827 kPa).

LOCATION REQUIREMENTS

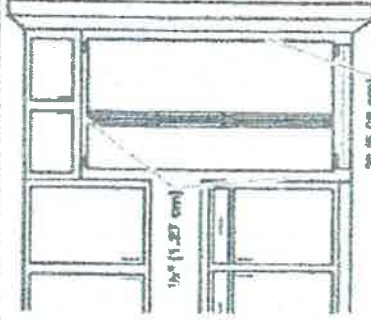

To ensure proper ventilation for your refrigerator, allow for 1/2" (1.27 cm) of space on each side and at the top. Allow for 1" (2.54 cm) of space behind the refrigerator. If your refrigerator has an ice maker, allow extra space at the back for the water line connections. When installing your refrigerator next to a fixed wall, leave a 2" (5.08 cm) minimum space on each side (depending on your model) to allow the doors to swing open.

NOTES:

- This refrigerator is intended for use in a location where the temperature ranges from a minimum of 55°F (13°C) to a maximum of 110°F (43°C). The preferred room temperature range for optimum performance, which reduces electricity usage and provides superior cooling, is between 60°F (15°C) and 90°F (32°C). It is recommended that you do not install the refrigerator near a heat source, such as an oven or radiator.
- Normal minimum cabinet cutout width required for product installation is 36" (91.44 cm). However, if the product is placed against an extended wall and the ability to remove the dispenser panel is desired, an additional 18" (45.72 cm) of cabinet width is required, so a total cabinet opening width of 54" (137.16 cm) is recommended.

RECEIVED

SEP 22 2024