


Feb/2020/25-
T.H.

TV/NE1
Above
Fireplace
RUG ABOVE
F/P

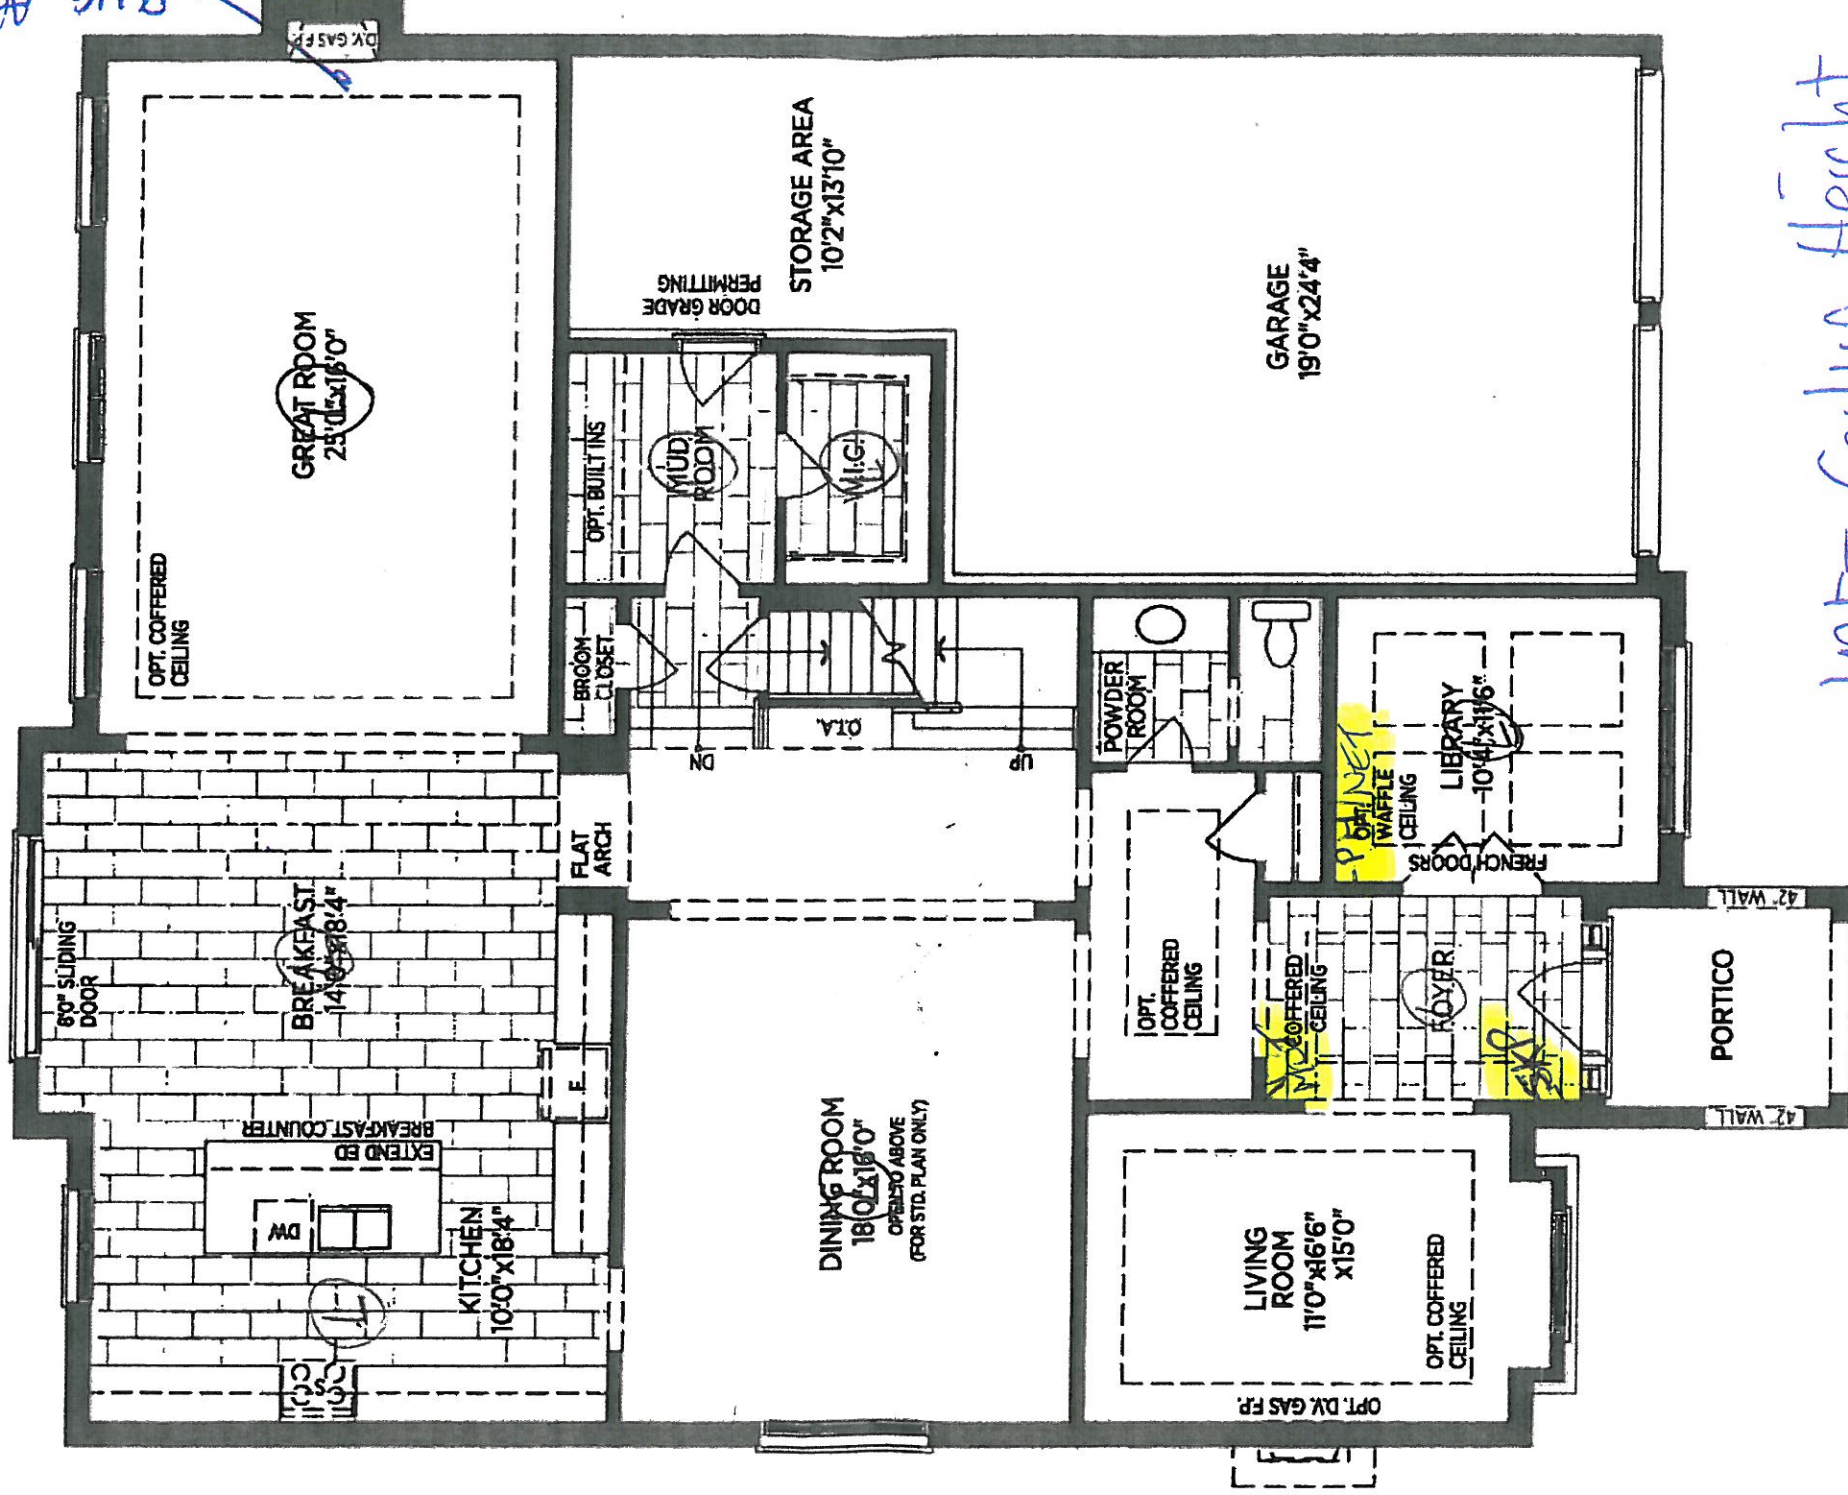


- 10 FT Ceiling Height
- 8 FT DOORS
- TRANSOMS ABOVE WINDOWS

GROUND FLOOR EL. (B)

BELCOURT 60-03

25 Cookstown

GP

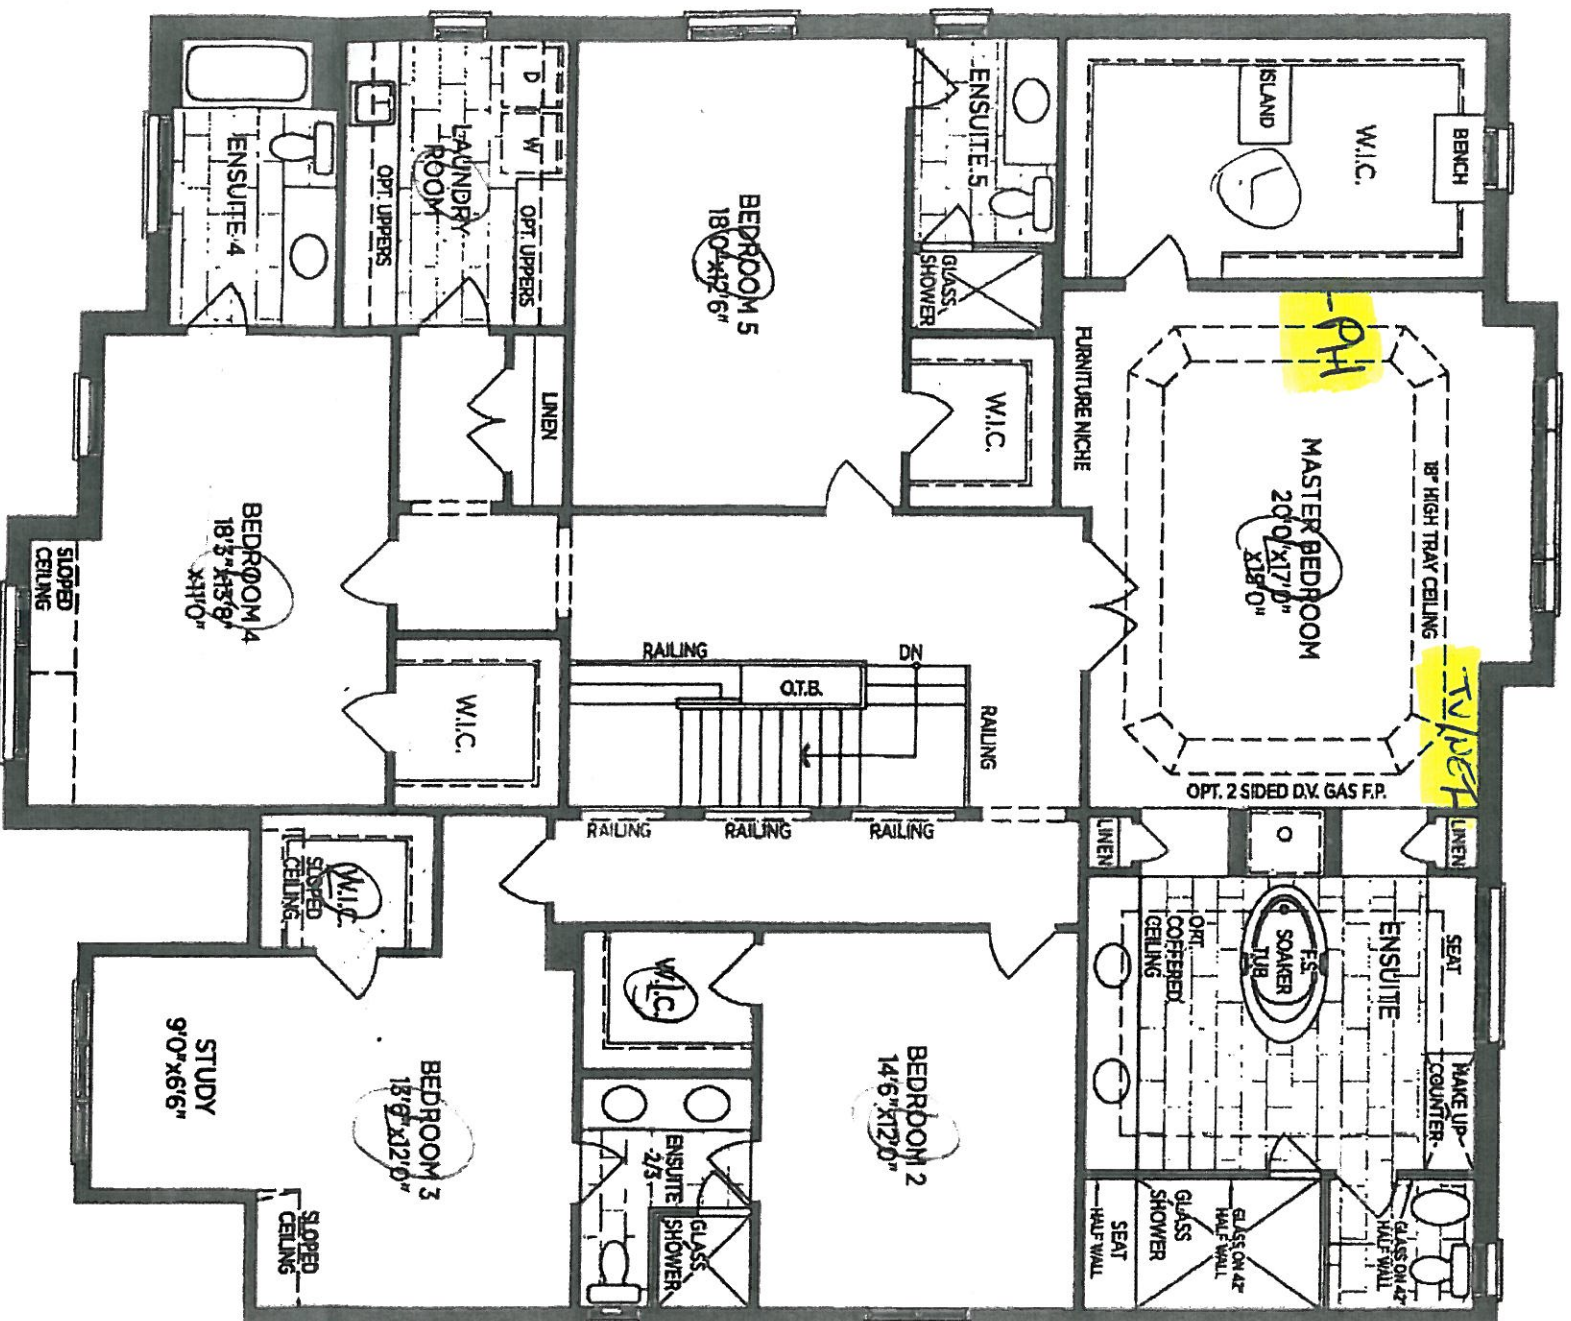


OPT. SECOND FLOOR W/ 5 BEDROOM PLAN, EL. 11'10" (B)

BELCOURT 60-03

AS Constructed

Feb/25/2020

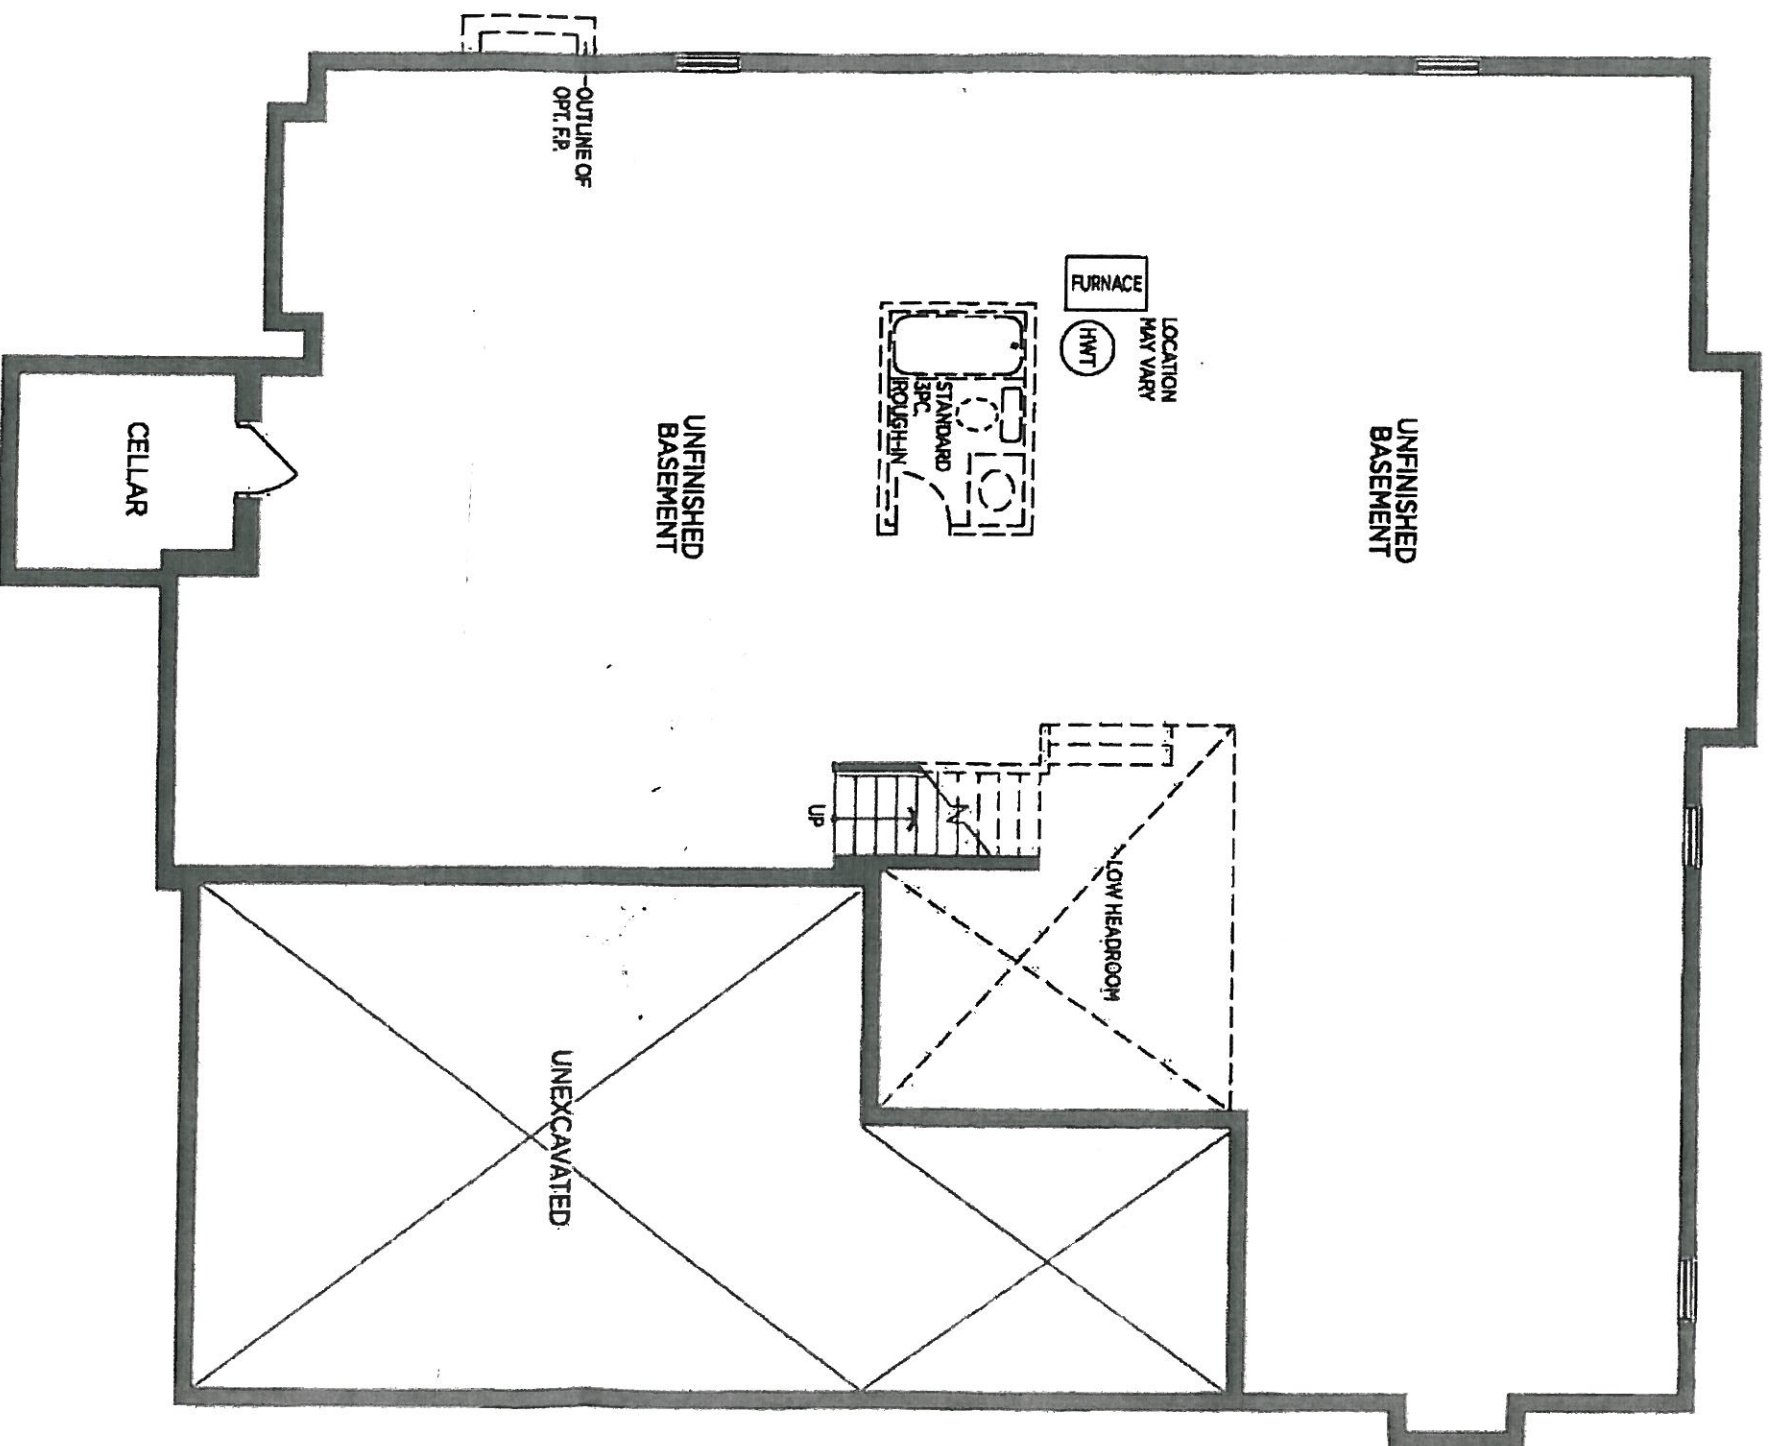




BASEMENT PLAN EL. 11'3"

BELCOURT 60-03

25 October 2020

Feb 25/2020 R.

Optional Plans & Partials

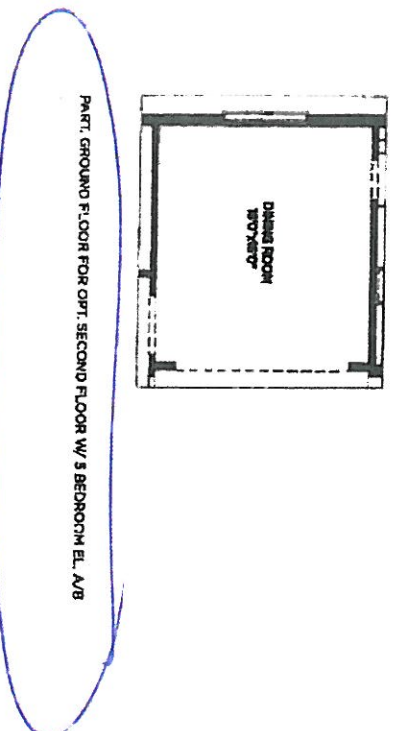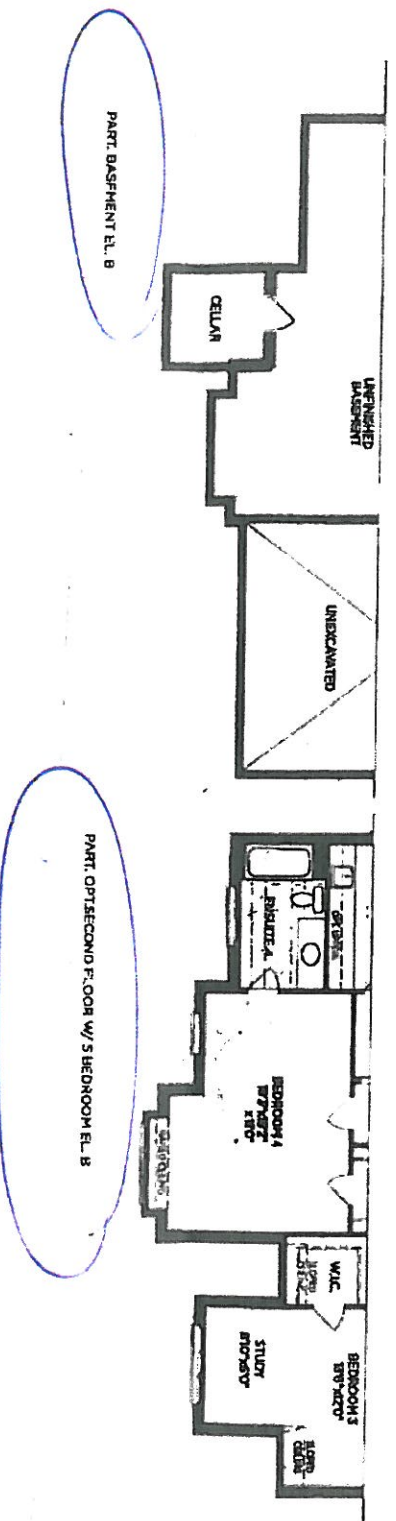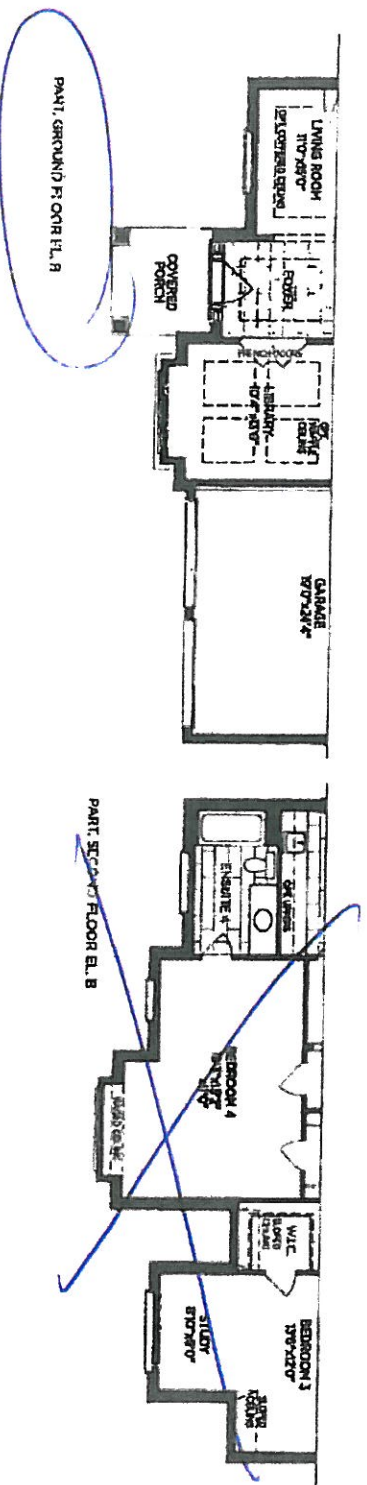

6.15

BELCOURT 60-03

B w/opt. 2nd.

25 Costing
SIT

File Feb 125/2020