

**Kleinburg Glen - 2R - 1 - 25-3 Elev.B OAKMOUNT OPT- SFA4**  
**CENTRAL VAC AND WIRING**

Inv.657	3 - REAR OF HOUSE / KITCHEN / FAMILY ROOM / LIVING DINING ROOM: ROUGH - IN WIRING FOR THREE PAIRS OF SPEAKERS. 2 in Family Room, 1 in Kitchen, 1 in Living/Dining Room, 2 Outside. Please see floorplan for locations.
Line8353	Note:
12Jul16 / 29Aug16	
Inv.657	1 - KITCHEN: INSTALL VAC PAN UNDER KITCHEN SINK
Line8354	Note:
12Jul16 / 29Aug16	
Inv.657	2 - MUD ROOM & MASTER BEDROOM: ROUGH - IN FOR EXTRA SECURITY KEY PAD. Please see floorplan for locations
Line8355	Note:
12Jul16 / 29Aug16	
Inv.657	1 - FAMILY ROOM: CONDUIT PIPE - FOR FUTURE TELEVISION ABOVE FIREPLACE APPROX 66" AFF. TERMINATION LEFT OF FIREPLACE. Please see floor plan for location
Line8357	Note:
12Jul16 / 29Aug16	

**CERAMIC**

Inv.1,008	1 - FOYER / MUD ROOM / POWDER ROOM - Floor Tile: UPG 4
Line14411	Note:
22Nov16 / 1Dec16	
Inv.1,008	1 - MASTER ENSUITE - Floor / Tub Skirt / Tub Deck / Tub Splash Tile: UPG 4
Line14422	Note:
22Nov16 / 1Dec16	
Inv.1,008	1 - MAIN BATH - Floor Tile: UPG 4
Line14424	Note:
22Nov16 / 1Dec16	
Inv.1,008	1 - MAIN BATH WALL ACCENT TILE: UPG 3: Approx 4" Horizontal accent - approx 66" AFF. Boutique Collection Mosaics Yahly - Glass /Marble / Shell Blend Black Blend (Black & Dark Grey BRICK. CODE: IO.YAH.BLK.0,4x0,8.N
Line14471	Note:
22Nov16 / 1Dec16	

**DRYWALL**

Inv.657	1 - SMOOTH CEILINGS - (2 - Story Design) 2ND FLOOR
Line8380	Note:
12Jul16 / 29Aug16	

**ELECTRICAL**

Inv.657	1 - MAIN FLOOR AND 2ND FLOOR HALLWAYS: PLEASE DELETE STANDARD HALLWAY LIGHTS TO ACCOMMODATE FOR POTLIGHTS
Line8404	Note:
12Jul16 / 29Aug16	
Inv.657	1 - EXTERIOR FRONT LIGHT: ADD SENSOR - MOTION LIGHT TO EXTERIOR FRONT PORCH LIGHT.
Line8356	Note:
12Jul16 / 29Aug16	

**Kleinburg Glen - 2R - 1 - 25-3 Elev.B OAKMOUNT OPT- SFA4**

Inv.657	1 - FAMILY ROOM: 110V WALL RECEPTACLE ON NORMAL CIRCUIT - ABOVE FIREPLACE FOR FUTURE TELEVISION, APPROX 66" AFF. Please see floorplan for location.
Line8358	Note:
12Jul16 / 29Aug16	
Inv.657	1 - KTICHEN: 110V WALL RECEPTACLE ON DEDICATED CIRCUIT - FOR MICROWAVE - MICROWAVE NOT INCLUDED. PLEASE SEE FLOORPLAN FOR LOCATION - WALL OVEN/MICROWAVE COMBO.
Line8361	Note:
12Jul16 / 29Aug16	
Inv.657	1 - KITCHEN: 220V WALL RECEPTICAL ON DEDICATED CIRCUIT - FOR 4 WIRE BUILT - IN WALL OVEN - PLEASE SEE FLOORPLAN FOR LOCATION - WALL OVEN/MICROWAVE COMBO.
Line8362	Note:
12Jul16 / 29Aug16	
Inv.657	1 - 200 AMP ELECTRICAL SERVICE
Line8363	Note:
12Jul16 / 29Aug16	
Inv.657	5 - KITCHEN CABINET VALANCE LIGHTS (UNDER CABINETS) - EACH PUCK LIGHT - DOES NOT INCLUDE (AND REQUIRES) KITCHEN UPGRADE PRICING. ON A SEPARATE SWITCH
Line8365	Note:
12Jul16 / 29Aug16	
Inv.657	1 - KITCHEN: SEPARATE SWITCH FOR UNDERCABINET PUCK LIGHTS
Line8366	Note:
12Jul16 / 29Aug16	
Inv.657	21 - MAIN FLOOR: POT LIGHTS: 4 INCH HALOGEN POT LIGHT - 440 WH - PRICED PER LIGHT. PLEASE SEE FLOORPLAN FOR LOCATIONS. ON A SEPARATE SWITCH & DIMMER.
Line8367	Note: KITCHEN: 8, LIVING/DINING ROOM: 4, GROUND FLOOR HALLWAY: 3, FAMILY ROOM: 6,
12Jul16 / 29Aug16	
Inv.657	4 - MAIN FLOOR: ADD SEPARATE SWITCH FOR POT LIGHTS IN EACH ROOM. PLEASE SEE FLOORPLAN FOR LOCATIONS.
Line8368	Note: KITCHEN, LIVING/DINING ROOM, GROUND FLOOR HALLWAY, FAMILY ROOM
12Jul16 / 29Aug16	
Inv.657	10 - THROUGHOUT: UPGRADE TO DIMMER SWITCH - ONE UNIT - FOR POTLIGHTS. PLEASE SEE FLOORPLAN FOR LOCATIONS.
Line8369	Note: KITCHEN, LIVING/DINING ROOM, GROUND FLOOR HALLWAY, FAMILY ROOM, MASTER BEDROOM, BEDROOM 2, BEDROOM 3, 2ND FLOOR HALLWAY, BATHROOM, ENSUITE
12Jul16 / 29Aug16	
Inv.657	1 - KITCHEN: RELOCATE KITCHEN CEILING LIGHT TO ABOVE ISLAND AND ADD ADDITIONAL STANDARD FIXTURE WITH SWITCH IN LINE FOR FUTURE PENDANT LIGHTING. Please see floorplan for location.
Line8371	Note:
12Jul16 / 29Aug16	
Inv.657	2 - MAIN FLOOR & 2ND FLOOR HALLWAY: UPGRADE TO 3 - WAY SWITCH (2 SWITCHES) - PLEASE SEE FLOORPLAN FOR LOCATION
Line8396	Note:
12Jul16 / 29Aug16	
Inv.657	1 - POWDER ROOM: POT LIGHT: 4 INCH HALOGEN POT LIGHT - 440 WH - PRICED PER LIGHT. TO BE ON SAME SWITCH AS STANDARD VANITY LIGHT
Line8373	Note:
12Jul16 / 29Aug16	

**Kleinburg Glen - 2R - 1 - 25-3 Elev.B OAKMOUNT OPT- SFA4**

Inv.657	25 - 2ND FLOOR: POT LIGHT: 4 INCH HALOGEN POT LIGHT - 440 WH (INSULATED) - PRICED PER LIGHT. PLEASE SEE FLOORPLAN FOR LOCATION
Line8374	Note: MASTER BEDROOM: 6, BEDROOM 2: 4, BEDROOM 3: 4, 2ND FLOOR HALLWAY: 7, BATHROOM: 2, ENSUITE: 2
12Jul16 / 29Aug16	
Inv.657	6 - 2ND FLOOR: SEPARATE SWITCH FOR POTLIGHTS IN EACH ROOM. PLEASE SEE FLOORPLAN FOR LOCATIONS.
Line8375	Note: MASTER BEDROOM, BEDROOM 2, BEDROOM 3, 2ND FLOOR HALLWAY, BATHROOM, ENSUITE
12Jul16 / 29Aug16	
Inv.657	1 - THROUGHOUT: PLEASE RELOCATE STANDARD RECEPTACLES NEXT TO ALL STANDARD CAT 5 (TELEPHONE) JACKS
Line8401	Note:
12Jul16 / 29Aug16	
Inv.657	1 - KITCHEN: RELOCATE DISHWASHER TO RIGHT SIDE OF SINK
Line10614	Note:
12Jul16 / 29Aug16	
Inv.1,008	1 - KITCHEN: 110V WALL RECEPTACLE ON DEDICATED CIRCUIT - GAS FIRED APPLIANCE - FOR AUX. EQUIPMENT - NOT A STOVE PLUG
Line14427	Note: Missed charge at Structural
22Nov16 / 1Dec16	

**EXTERIOR COLOURS**

Inv.657	1 - EXTERIOR COLOUR PACKAGE 12
Line9605	Note:
12Jul16 / 29Aug16	

**FRAMING**

Inv.657	2 - MASTER ENSUITE & BATHROOM: SHOWER STALL SHAMPOO SHELF
Line8379	Note:
12Jul16 / 29Aug16	
Inv.657	6 - FRAME MAIN FLOOR DOORS AT 96 INCH - ADDED WITH THE ADDITION OF TALLER INTERIOR DOORS
Line8390	Note:
12Jul16 / 29Aug16	
Inv.657	3 - MAIN FLOOR: INCREASE ARCHWAY TO 96"
Line8391	Note:
12Jul16 / 29Aug16	

**GARAGE DOORS**

Inv.657	1 - GARAGE DOOR OPENER - WITH 1 REMOTE - PRICE IS PER DOOR
Line8381	Note:
12Jul16 / 29Aug16	
Inv.657	1 - GARAGE: DIGITAL ENTRY KEYPAD
Line8382	Note:
12Jul16 / 29Aug16	

**GLASS AND MIRROR**

Inv.657	1 - MASTER ENSUITE: CONVERT FRAMED SHOWER TO 10MM FRAMELESS SHOWER ENCLOSURE WITH DOOR AND 10MM SIDE PANEL
Line8377	Note:
12Jul16 / 29Aug16	

**Kleinburg Glen - 2R - 1 - 25-3 Elev.B OAKMOUNT OPT- SFA4**

**GRANITE MARBLE QUARTZ**

Inv.1,008	1 - MASTER ENSUITE - COUNTERTOP: UPG 1 STD FE20 EDGE PROFILE
Line14423	Note:
22Nov16 / 1Dec16	
Inv.1,008	1 - MAIN BATH COUNTERTOP: UPG 1 Granite STD FE20 PROFILE
Line14430	Note:
22Nov16 / 1Dec16	

**HARDWOOD**

Inv.1,008	1 - MAIN FLOOR - HALLWAY / LIVING/DINING ROOM / KITCHEN / FAMILY ROOM - Hardwood: UPG 1
Line14412	Note:
22Nov16 / 1Dec16	

**HVAC**

Inv.657	1 - KITCHEN: GAS LINE ROUGH - GROUND FLOOR FOR FUTURE GAS COOKTOP
Line8360	Note:
12Jul16 / 29Aug16	
Inv.657	1 - KITCHEN: UPGRADE VENTING FOR STOVE TO 8 INCH PIPE EXTERIOR WALL
Line8385	Note:
12Jul16 / 29Aug16	
Inv.657	1 - TANKLESS HWT CONNECTION - HWT ON RENTAL BASIS / TANK NOT INCLUDED
Line8395	Note:
12Jul16 / 29Aug16	

**INTERIOR TRIM AND DOORS**

Inv.657	1 - MAIN FLOOR DOORS AT 96 INCH - ADDED WITH THE ADDITION OF TALLER INTERIOR DOORS
Line10620	Note:
12Jul16 / 29Aug16	

**KITCHEN AND BATH CABINETRY**

Inv.657	1 - KITCHEN: RELOCATE DISHWASHER TO RIGHT SIDE OF SINK
Line10615	Note:
12Jul16 / 29Aug16	
Inv.1,008	1 - KITCHEN: Adjust cabinetry for Wall Oven & Micro Combo with Cooktop
Line14413	Note: Please see spec sheets attached
22Nov16 / 1Dec16	
Inv.1,008	1 - KITCHEN: Add Pots & Pans Drawer Under Cooktop
Line14414	Note:
22Nov16 / 1Dec16	
Inv.1,008	2 - KITCHEN: Add Top Drawer, Over Grabage Pull out and right of cooktop
Line14415	Note:
22Nov16 / 1Dec16	
Inv.1,008	1 - KITCHEN: Add Waste Basket Pull-Out to island, left side
Line14416	Note: DW Relocated to right side. See Kitchen drawing attached
22Nov16 / 1Dec16	

Kleinburg Glen - 2R - 1 - 25-3 Elev.B OAKMOUNT OPT- SFA4

Inv.1,008	1 - KITCHEN: Add BiFold Base Cabinet
Line14417	Note: See Kitchen Drawing for location
22Nov16 / 1Dec16	
Inv.1,008	1 - KITCHEN: Add Upper Angled corner Cabinet
Line14418	Note: See Kitchen Drawing for location
22Nov16 / 1Dec16	
Inv.1,008	1 - KITCHEN: Add Light Valance
Line14420	Note:
22Nov16 / 1Dec16	
Inv.1,008	1 - KITCHEN: UPG Stain for Kitchen Cabinets
Line14421	Note:
22Nov16 / 1Dec16	
Inv.1,008	1 - LAUNDRY: UPG - ADD Uppers Standard Line
Line14425	Note:
22Nov16 / 1Dec16	
Inv.1,008	1 - MAIN BATH: Add top drawer, left side of vanity
Line14428	Note: See Kitchen Drawing for location
22Nov16 / 1Dec16	
Inv.1,008	1 - KITCHEN: Delete Upper cabinets over cooktop to accommodate future Chimney Hood. With finished sides
Line14431	Note:
22Nov16 / 1Dec16	
Inv.1,008	1 - KITCHEN: Raise Kitchen Base Cabinets 3/4" from wrought floor for finished hardwood
Line14448	Note:
22Nov16 / 1Dec16	

MISC.

Inv.657	1 - PAID \$26,000.00 BY CHEQUE. BALANCE OF \$24,222.85 ADDED TO MORTGAGE.
Line8408	Note:
12Jul16 / 29Aug16	
Inv.657	1 - Purchasers are aware & accepts that ANY changes made to upgrades after signing this Purchasers Extra Form are subject to a minimum administration fee of \$500. PLUS a 10% holdback fee.
Line8406	Note:
12Jul16 / 29Aug16	
Inv.657	1 - Purchaser has attended a Structural appointment at the Decor Centre & has DECLINED any additional upgrades and accepts and acknowledges that there will be no further structural changes/additions/deletions to be made upon signing on July 12, 2016.
Line8405	Note:
12Jul16 / 29Aug16	
Inv.657	1 - BONUS PACKAGE: \$5,000.00 (INCLUDING TAXES) WORTH OF UPGRADES FROM GOLD PARK HOMES DÉCOR CENTRE IS NOT BEING APPLIED TOWARD THE STRUCTURAL APPOINTMENT.
Line8407	Note: PURCHASER HAS A REMAINING AMOUNT OF \$5000.00 (INCLUDING TAXES) TO BE USED TOWARD THE COLOUR APPOINTMENT.
12Jul16 / 29Aug16	
Inv.1,008	1 - CREDIT FOR LARGER BASEMENT WINDOWS.
Line14446	Note: REF INVOICE # PE-994-2
22Nov16 / 1Dec16	

**Kleinburg Glen - 2R - 1 - 25-3 Elev.B OAKMOUNT OPT- SFA4**

Inv.1,008	1 - Purchaser has attended a Structural appointment at the Decor Centre & has DECLINED any additional upgrades and accepts and acknowledges that there will be no further structural changes/additions/deletions to be made upon signing.
Line14452	Note:
22Nov16 / 1Dec16	
Inv.1,008	1 - STAIRCASE - The purchaser was advised and therefore accepts and acknowledges that the stain of the staircase and flooring chosen do not match. This difference might result in an undesirable colour variance.
Line14454	Note: The purchaser agrees that the vendor is to be exempt from any and all claims by the purchaser regarding this colour variance.
22Nov16 / 1Dec16	
Inv.1,008	1 - KITCHEN - Purchasers request to NOT INSTALL builder's standard hood fan and standard cabinets above stove. DELETE. Do not supply, install, and/or credit. Purchasers are installing their own hood fan after closing.
Line14455	Note: Purchasers accept and acknowledge that the exhaust fan duct hole may be off-centered with stove in kitchen due to purchasers installing their own hood fan after closing. The vendor is exempt.
22Nov16 / 1Dec16	
Inv.1,008	1 - Due to the many variables that can affect the pattern, colour and/or design and "pitting" of natural products, granite installed will not be identical to the samples displayed.
Line14457	Note: Every effort is made to provide granite counter tops as close as possible but the vendor is not responsible for results which differ from the sample displayed. All countertop surfaces may have seems & product pattern & shade can change in areas containing seems.
22Nov16 / 1Dec16	
Inv.1,008	1 - TOTAL: \$29,681.11 After \$5,000 Bonus Dollars: \$24,681.11 Paid by Cheque
Line14460	Note:
22Nov16 / 1Dec16	

**PAINTING**

Inv.1,008	1 - STAIRS: Stain stairs to match hardwood - Cappucino
Line14419	Note:
22Nov16 / 1Dec16	

**PLUMBING**

Inv.657	1 - KITCHEN: ROUGH - IN - WATERLINE FOR FRIDGE.
Line8359	Note:
12Jul16 / 29Aug16	
Inv.657	1 - KITCHEN: RELOCATE DISHWASHER TO RIGHT SIDE OF SINK
Line8364	Note:
12Jul16 / 29Aug16	
Inv.657	1 - MASTER ENSUITE: UPGRADE TO JET TUB - UPG1 ONLY
Line8378	Note:
12Jul16 / 29Aug16	
Inv.657	2 - 2ND FLOOR: MASTER ENSUITE & BATHROOM -WATER SERVICE - INCREASE WATER SERVICE TO 3/4 INCH
Line8388	Note:
12Jul16 / 29Aug16	
Inv.657	1 - REAR OF HOUSE: HOSE BIB - STANDARD TO UPGRADED WITH HOT AND COLD WATER VALVE
Line8389	Note:
12Jul16 / 29Aug16	
Inv.1,008	1 - MASTER ENSUITE: Bath Tub Faucet Innovations Roman Tub 4 Piece T4716-LPH / H20 / R4716
Line14429	Note:
22Nov16 / 1Dec16	

**Kleinburg Glen - 2R - 1 - 25-3 Elev.B OAKMOUNT OPT- SFA4**

Inv.1,008	3 - MASTER ENSUITE X2 / MAIN BATH X1: UPG Vanity Sinks Contrac Minuet Vessel
Line14472	Note:
22Nov16 / 1Dec16	
Inv.1,008	1 - KITCHEN: UPG Kitchen Sink Blanco Quatrus R15 U1-3/4 Undermount 401520
Line14569	Note:
22Nov16 / 1Dec16	

**STAIRS AND RAILINGS**

Inv.1,008	1 - STAIRS: UPG to Euroline 1 With V-Groove Handrail
Line14439	Note:
22Nov16 / 1Dec16	

**WINDOWS - BASEMENT**

Inv.657	4 - BASEMENT WINDOWS - UPGRADE EXISTING BASEMENT WINDOW TO 46 INCH X 32 INCH - MAY REQUIRE INSTALLATION OF WINDOW WELL
Line8386	Note:
12Jul16 / 29Aug16	
Inv.657	4 - COLOUR MATCH UPGRADED WINDOWS
Line8387	Note:
12Jul16 / 29Aug16	

**WINDOWS AND DOORS**

Inv.657	1 - FAMILY ROOM: FRENCH DOORS IN LIEU OF PATIO SLIDERS - 6FT X 80 INCH FRENCH DOORS - NO SCREEN CLEAR GLASS
Line8392	Note:
12Jul16 / 29Aug16	
Inv.657	1 - FAMILY ROOM: SIDELITES - 1 PAIR - 12 INCH x 80 INCH HEIGHT - MUST ADD WITH 6 FOOT DOORS IN LIEU OF 8 FOOT SLIDERS
Line8393	Note:
12Jul16 / 29Aug16	

Scheduled Closing Date: October-20-16

Purchasers: Marcia V McLaughlin-Mullings &amp; Melissa Denise Property: 2R

Telephone Res. / Bus: (647) 955-8419

Project: Burkshire Holdings Inc.

Decor Advisor: Laura Lofaro

Model and Elevation: 25-3 Elev.B OAKMOUNT OPT- SFA4

Layout Changes: ☐ Yes ☐ NoSketch Attached: ☐ Yes ☐ NoExterior Colour Scheme: 

## 1. Cabinetry

	Style and Colour	Counter	Hardware
Kitchen / Breakfast	*SienaOak Espresso	Crema Caramel STD FE20 Edge	CS1-24
Laundry Room	*SienaOak Greystone	N/A	CS1-16
Powder Room	N/A		
Master Ensuite Bathroom	Carrera PVC VanillaStix	*Granite Giallo Ornamentale STD FE20 Edge	CS1-22
Second Ensuite Bathroom (If Applicable)			
Main Bath	Toscana PVC Mystic	*New Caledonia Granite STD FE20 Edge	CS1-23
Dishwasher Cabinet			

## Comment

Kitchen: Confrim wall beside fridge is in line so fridge door can open all the way.  
Kitchen: Raise Kitchen base cabinets 3/4" from rough floor for finished hardwood  
Customizations - Please see Kitchen Drawings for details

## 2. Floor Tile

	Selection	Grout	Threshold
Entrance Vestibule	*17.7x17.7 Must Polished Taupe		
Main Hall	See Hardwood		
Kitchen / Breakfast	See Hardwood		
Laundry Room	13x13 New Byzantine Azzuro Blue		
Powder Room	*17.7x17.7 Must Polished Taupe		
Master Ensuite Bathroom	*18x18 Inspire Rectified Bianco Calacutta		
Second Ensuite Bathroom (If Applicable)	*Main Bath:17.7x17.7MustPol.Dove Grey		
Lower Landing (If Applicable)			
Mud Room	*17.7x17.7 Must Polished Taupe		

## Comment

MASTER ENSUITE: Tub Face / Deck / Splash: \*18x18 Inspire Rectified Bianco Calacutta

## 3. Wall Tile

	Selection	Listello/Inserts	Describe
		<input type="radio"/> Yes <input type="radio"/> No	
Master Ensuite Bathroom			
Tub Deck	*See Floor	<input type="radio"/> Yes <input type="radio"/> No	
Shower Stall	8x10 Weave Taupe	<input type="radio"/> Yes <input checked="" type="radio"/> No	
Bathroom Walls		<input type="radio"/> Yes <input type="radio"/> No	
Second Ensuite Bathroom (If Applicable)		<input type="radio"/> Yes <input type="radio"/> No	
Main Bath	8x10 Weave Tender Grey	<input checked="" type="radio"/> Yes <input type="radio"/> No	
Kitchen Backsplash	<input type="radio"/> Yes <input type="radio"/> No	Backsplash Behind Fridge	

## Comment

Main Bath: Approx 4" Horizontal accent - approx 66" AFF. Boutique Collection Mosaics Yahly - Glass /Marble / Shell Blend Black Blend (Black & Dark Grey BRICK. CODE: IO.YAH.BLK.0,4x0,8.N



Purchasers: Marcia V McLaughlin-Mullings & Melissa Denise Property: 2R

Telephone Res. / Bus: (647) 955-8419

Project: Burkshire Holdings Inc.

Decor Advisor: Laura Lofaro

Model and Elevation: 25-3 Elev.B OAKMOUNT OPT- SFA4

#### 4. Plumbing Fixtures

<input type="text"/>	Second Ensuite	<input type="text"/>	Powder Room	<input type="text"/>
Master Ensuite Bathroom	<input type="text"/>	Other Room - Specify	<input type="text"/>	Other Washroom
	<input type="text"/>			

##### Comment

\*UPG Master Ensuite Tub faucet to 4 Piece T4716-LPH / H20 / R4716  
\*UPG Vanity Sinks, Master Ensuite x2 & Main Bath x1 - Contrac Minuet Vessel. See Spec sheet

#### 5. Hardwood Flooring

	Type and Stain		Type and Stain
Main Hall	*Preverco Red Oak Cappucino Pro	Upper Landing	N/A
Kitchen / Breakfast	*Preverco Red Oak Cappucino Pro	Upper Hall	N/A
Living Room	*Preverco Red Oak Cappucino Pro	Master Bedroom	N/A
Dining Room	*Preverco Red Oak Cappucino Pro	Bedroom #2	N/A
Family Room	*Preverco Red Oak Cappucino Pro	Bedroom #3	N/A
Den/Library	N/A	Bedroom #4	N/A
Entrance Vestibule	N/A	Bedroom #5	N/A
Lower Landing (If Applicable)	N/A	Other Room - Specify	<input type="text"/>

##### Comment

#### 6. Carpeting

	Upgrade	Description
Main Hall	<input type="checkbox"/>	N/A
Living Room	<input type="checkbox"/>	N/A
Dining Room	<input type="checkbox"/>	N/A
Family Room	<input type="checkbox"/>	N/A
Den/Library	<input type="checkbox"/>	N/A
Upper Hall	<input type="checkbox"/>	T15
Master Bedroom	<input type="checkbox"/>	T15
Bedroom #2	<input type="checkbox"/>	T15
Bedroom #3	<input type="checkbox"/>	T15
Bedroom #4	<input type="checkbox"/>	N/A
Bedroom #5	<input type="checkbox"/>	N/A
<input type="text"/>	<input type="checkbox"/>	<input type="text"/>
Upper Landing (If Applicable)	<input type="checkbox"/>	N/A
Lower Landing (If Applicable)	<input type="checkbox"/>	N/A

Upgrade Underpad	Type N/A	Area <input type="text"/>
Carpet on Stairs	Capped N/A	Runner - *Upgrade <input type="text"/>

##### Comment

Purchasers: Marcia V McLaughlin-Mullings & Melissa Denise Property: 2R

Telephone Res. / Bus: (647) 955-8419

Project: Burkshire Holdings Inc.

Decor Advisor: Laura Lofaro

Model and Elevation: 25-3 Elev.B OAKMOUNT OPT- SFA4

7. Fireplace

	Living Room			Family Room			Other Room - Specify		
	Purchased	As Per Plan	N/A	Purchased	As Per Plan	N/A	Purchased	As Per Plan	N/A
Fireplace Type	<input type="radio"/>	<input type="radio"/>	<input type="radio"/>	<input type="radio"/>	<input checked="" type="radio"/>	<input type="radio"/>	<input type="radio"/>	<input type="radio"/>	<input type="radio"/>
Mantle Type				STD					
Colour / Stain				STD Cast Stone					
Surround									
Hearth				Declined					
Comment									

8. Trim Carpentry

Interior Doors	STD	Front Door Glass Inserts	STD	Door Handles	STD
Interior Trim	STD				
Comment					

9. Plaster Mouldings and Medallions

Entrance Vestibule	N/A		Kitchen/Breakfast	N/A	
Main Hall	N/A		Den/Library	N/A	
Living Room	N/A		Lower Landing	N/A	
Dining Room	N/A		Other Room - Specify	N/A	
Family Room	N/A				
Comment					

10. Railings and Spindles

Railing Package	Euroline 1 - Square Posts and Black Wrought Iron Pickets		
Railing Colour	*Preverco Cappucino	Spindle Colour	Black
Stringer / Riser	*Preverco Cappucino	Treads	*Preverco Cappucino
Comment		Oak Stairs	<input checked="" type="radio"/> Yes <input type="radio"/> No

11. Wall Paint

Main & Upper Hall		Master Bedroom	
Living Room		Bedroom #2	
Dining Room		Bedroom #3	
Kitchen / Breakfast		Bedroom #4	
Family Room		Bedroom #5	
Powder Room		Master Ensuite	
Laundry Room			
Den/Library		Second Ensuite	
Trim Paint			
Comment	Smooth Ceilings First Floor		
Warm Grey Throughout			

Purchasers: Marcia V McLaughlin-Mullings & Melissa Denise Property: 2R

Telephone Res. / Bus: (647) 955-8419

Project: Burkshire Holdings Inc.

Decor Advisor: Laura Lofaro

Model and Elevation: 25-3 Elev.B OAKMOUNT OPT- SFA4

## 12. Electrical

Plugs and Switches ☒ White ☐ Ivory

Hood Fan ☐ White ☐ Ivory

Appliances Built in Cooktop

☒ Yes ☐ No

Built in Oven

☒ Yes ☐ No

Above Kitchen Cabinet Light ☐ Yes ☐ No

Below Kitchen Cabinet Light ☒ Yes ☐ No

Gas Stove

☒ Yes ☐ No

Microwave

☒ Yes ☐ No

Comment

## 13. Heating and Air Conditioning

Air Conditioning

Gas Provisions Dryer

Comment

Gas Provisions Stove

Gas Provisions Barbecue

## 14. Additional Comments

## 15. Disclaimers and Notes

- Colours of all materials are as close as possible to builder's selection, but not necessarily identical due to variances in manufacturing.
- Any extras listed above are null and void unless accompanied by a separate invoice/amendment. Said invoice must be paid in full.
- The Purchaser acknowledges that after Interior Colour Selection form is signed and dated, no further changes will be permitted other than re-selection due to unavailability. *MM/MLL* Purchaser's Initials
- The Purchaser acknowledges reading and accepting the "Gold Park Homes Decor Centre Disclaimers" form. This document contains other miscellaneous disclaimers.

This Interior Colour Selection is final and approved by:

Signature: *[Signature]*

Date: *NOV 24th 2016*

Signature: *Marcia McLaughlin*

Date: *NOV 24th 2016*


KLEINBURG GUEN  
LOT 2R

MM 26/1/2016

DATE:

## BLANCO QUATRUS™ R15 Undermount

### BLANCO QUATRUS™ R15 U 1 3/4

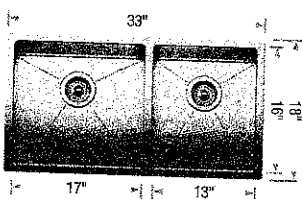

#### Sink Specifications

**Undermount**  
**Minimum Cabinet Size\***  
36" (915 mm)  
**Bowl Depth**  
9" (230 mm)  
**Cubed Weight**  
55 lb. (25 kg)

#### Model N°

401520

#### Installed Price\*\*


\$ 1584.70

#### Optional Accessories

406451	Grid (LB)	\$ 235.75
406450	Grid (SB)	\$ 211.60
406345	Ash Cutting Board	\$ 313.95
406344	Workstation	\$ 161.00
517666	CapFlow™	\$ 36.80
230694	Magnetic Caddy	\$ 112.70

#### Installed Price\*\*

### BLANCO QUATRUS™ R15 U 2

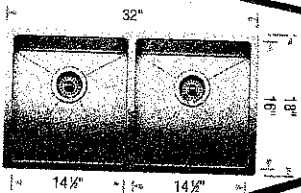

#### Sink Specifications

**Undermount**  
**Minimum Cabinet Size\***  
36" (915 mm)  
**Bowl Depth**  
9" (230 mm)  
**Cubed Weight**  
55 lb. (25 kg)

#### Model N°

401519

#### Installed Price\*\*


\$ 1584.70

#### Optional Accessories

406451	Grid	\$ 211.60
406345	Ash Cutting Board	\$ 313.95
406344	Workstation	\$ 161.00
517666	CapFlow™	\$ 36.80
230694	Magnetic Caddy	\$ 112.70

#### Installed Price\*\*

### BLANCO QUATRUS™ R15 U SUPER SINGLE

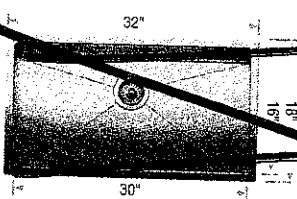

#### Sink Specifications

**Undermount**  
**Minimum Cabinet Size\***  
36" (915 mm)  
**Bowl Depth**  
9" (230 mm)  
**Cubed Weight**  
55 lb. (25 kg)

#### Model N°

401518

#### Installed Price\*\*


\$ 1584.70

#### Optional Accessories

406347	Super Single Grid	\$ 224.25
406346	Elevated Grid	\$ 195.50
406345	Ash Cutting Board	\$ 313.95
406344	Workstation	\$ 161.00
517666	CapFlow™	\$ 36.80
230694	Magnetic Caddy	\$ 112.70

#### Installed Price\*\*

### BLANCO QUATRUS™ R15 U 1 MEDIUM

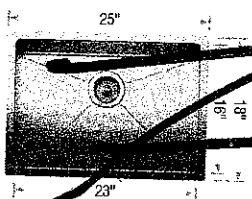

#### Sink Specifications

**Undermount**  
**Minimum Cabinet Size\***  
27" (685 mm)  
**Bowl Depth**  
9" (230 mm)  
**Cubed Weight**  
43 lb. (19.5 kg)

#### Model N°

401517

#### Installed Price\*\*


\$ 1584.70

#### Optional Accessories

406452	Grid	\$ 259.90
406345	Ash Cutting Board	\$ 313.95
406344	Workstation	\$ 161.00
517666	CapFlow™	\$ 36.80
230694	Magnetic Caddy	\$ 112.70

#### Installed Price\*\*

\* Depending on cabinet construction, a different cabinet size may be required. Consult the cabinet manufacturer.  
\*\* Installed price subject to change.

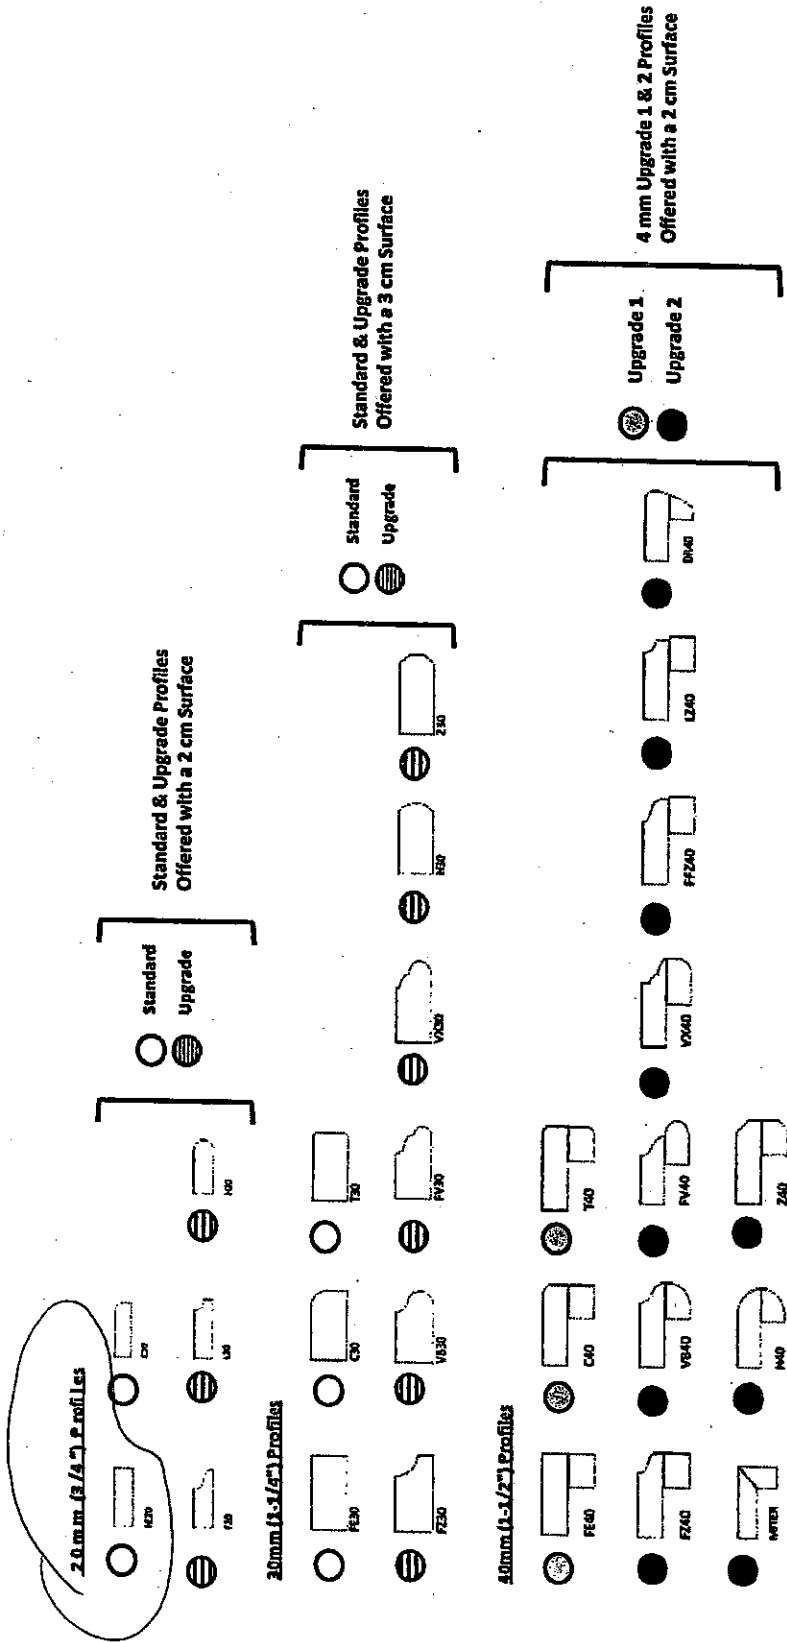

STD HE20 EDGE

KITCHEN /

MASTER ENSUITE /

MAIN BATH

NOV. 24. 2016

my. 14/1

-UPG. KITCHEN SINK -

KLEMBURG GLEN  
LOT 2R

MM NMY

DATE: NOV. 24. 2016

MASTER ENSUITE + MAIN BATH  
x2 x1

# Minuet

rectangular vessel lavatory

13-0024-W



**Finish**  
Soft white vitreous china  
Nano easy clean glaze



**Overflow**  
Rear




**Template**  
Supplied




**Faucet drilling**  
Single hole



**Dimensions**  
19" (W) x 15 1/4" (D) x 6 1/4" (H)

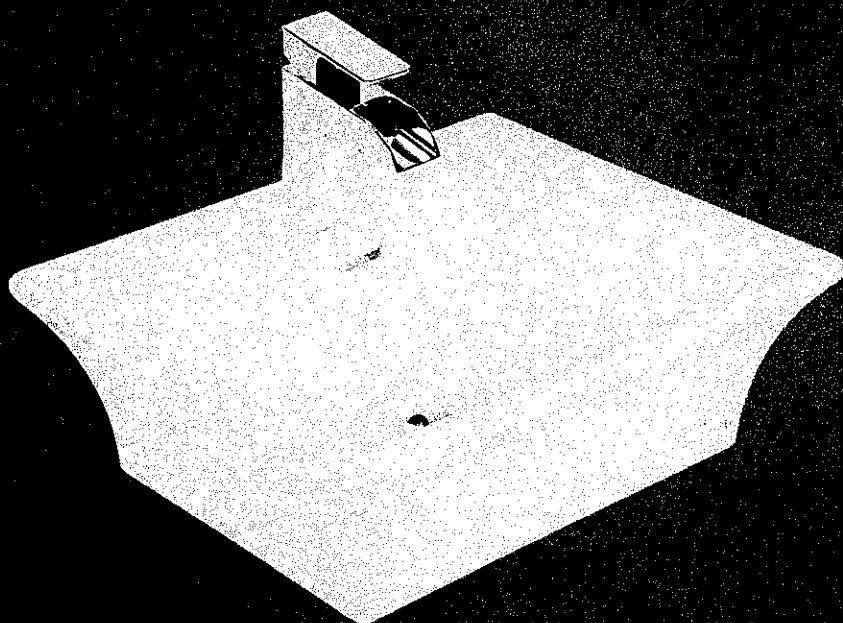

## Roman Tub

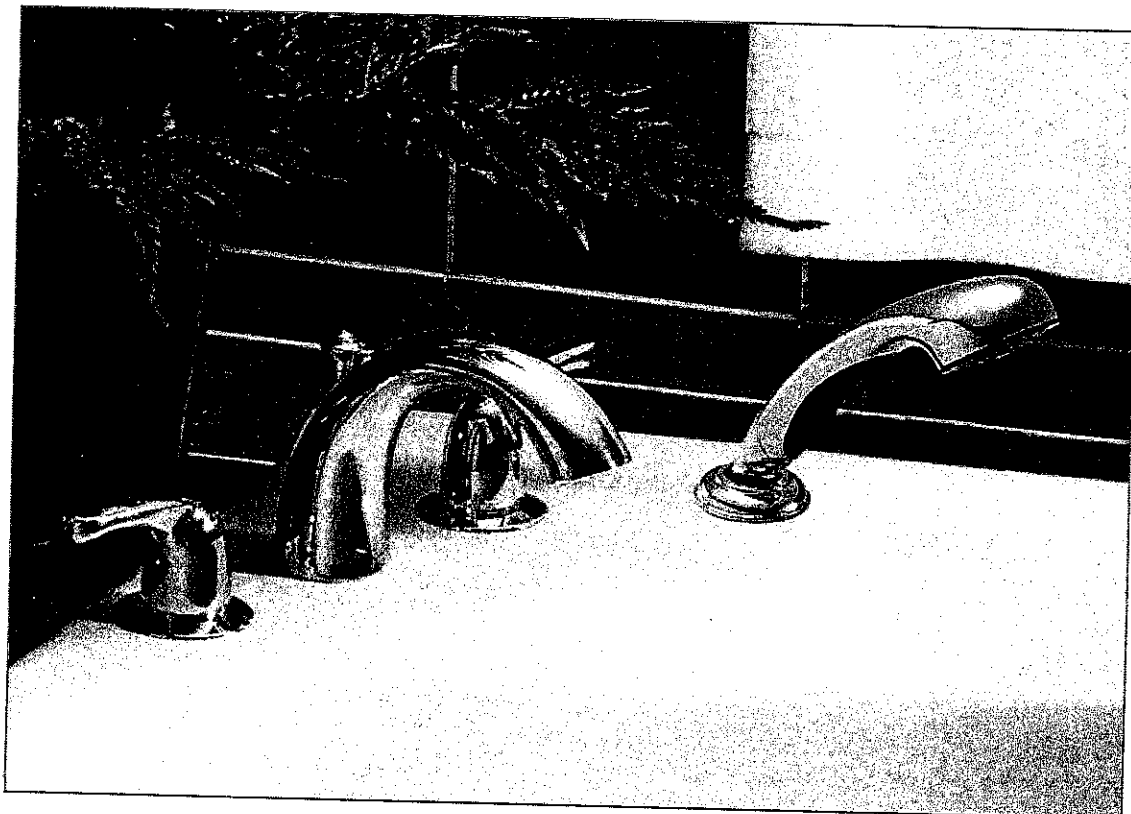

Innovations Roman Tub – 4 piece  
# T4716-LHP / H20 / R4716  
\$ 820.07

KLEINBURG GLEN  
LOT 2R  
MASTER ENSUITE


MMJ d.H.

Nov. 24 2016

Shown in Chrome

 DELTA

KitchenAid®

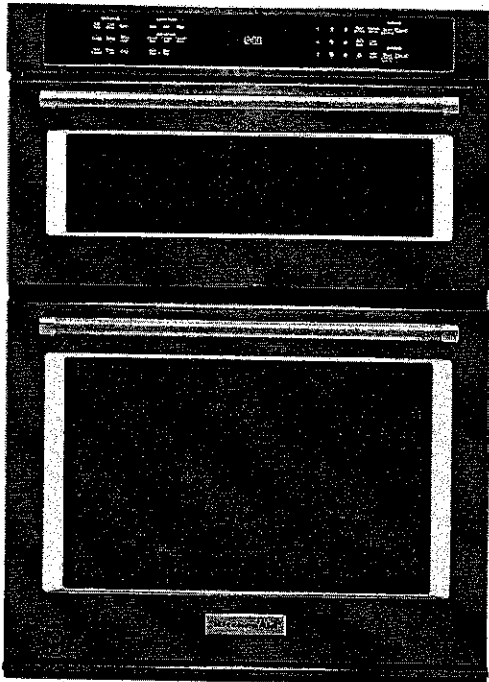

NEW


30" Combination Wall Oven with Even-Heat™ True Convection (Lower Oven)

0.0

Write a Review

This 30" Combination Wall Oven with Even-Heat™ True Convection provides consistent heating and even cooking. A unique bow-tie shaped design and convection fan helps ensure there are no burnt edges or undercooked centers. Its upper Microwave Convection Cooking Oven combines a 900 watt microwave with a 1600 watt convection element for high speed cooking. Bold design details are the perfect balance of elegance and functionality.

AVAILABLE COLOR OPTIONS

 Black Stainless - KOCE500EBS

FEATURES

Even-Heat™ True Convection Oven (Lower Oven)

produces flawless results. The unique bow-tie design and convection fan ensure the inside of the oven is heated to, and stays at, the perfect temperature.

Microwave Convection Cooking (upper oven)

Combines the power of a 900 watt microwave with a 1600 watt convection element to increase the speed of cooking and provide a secondary convection option.

Professionally-Inspired Design (VBL Light)

Combines a bold blend of professionally-inspired styling with sleek touches for the home. This beautiful built-in wall oven features Satin Textured Handles and the KitchenAid® Badge, a symbol of uncompromised quality.

Additional Features

Temperature Probe

Allows accurate measurement of internal temperatures of meats, poultry, and casseroles without having to open the oven so that food can be cooked perfectly.

5.0 Cu. Ft. Capacity (lower oven)

Provides an extra-large cooking capacity that's unsurpassed among 30" wall ovens and is perfect for large turkeys and roasts. It can even make multiple dishes at once.

EasyConvect™ Conversion System

Takes guesswork out of convection cooking by ensuring you can get exceptional results when experimenting with new or familiar recipes.

1.4 Cu. Ft. Capacity (upper oven)

Provides spacious cooking capacity while complementing your lower convection oven.

Crispwave™ Microwave Technology and Crisper Pan (upper oven)

Allows grilling, frying and convection cooking in the microwave. The specially designed crisper pan can be used to brown, crisp, and pan-fry foods.

SatinGlide™ Roll-Out Extension Rack (lower oven)

Allows easy roll-out for loading and unloading and features an easy-grip handle, giving confidence to cook with large or heavy dishes.

KLEINBURG GLEN  
LOT 2R

MM MM

DATE: NOV. 24, 2016



# KitchenAid® 27" (68.6 cm) and 30" (76.2 cm) Electric Built-In Microwave/Oven Combination

## PRODUCT MODEL NUMBERS

KEMS309E KOCE500E KOCE507E

## ELECTRICAL CONNECTION


If codes permit and a separate ground wire is used, it is recommended that a qualified electrical installer determine that the ground path and the wire gauge are in accordance with local codes. Check with a qualified electrical installer if you are not sure the oven is properly grounded.

This oven must be connected to a grounded metal, permanent wiring system.

Be sure that the electrical connection and wire size are adequate and in conformance with the National Electrical Code, ANSI/NFPA 70-latest edition or CSA Standards C22.1-94, Canadian Electrical Code, Part 1 and C22.2 No. 0-M91-latest edition, and all local codes and ordinances.

To properly install your oven, you must determine the type of electrical connection you will be using and follow the instructions provided for it here.

- Oven must be connected to the proper electrical voltage and frequency as specified on the model/serial/rating plate. See the following illustration.

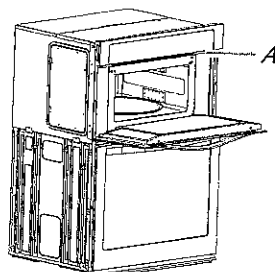

A. Model/serial/rating plate

- Models rated from 7.3 to 9.6 kW at 240 volts (5.4 to 7.4 kW at 208 volts) require a separate 40-amp circuit. Models rated at 4.8 kW and below at 240 volts (3.6 kW and below at 208 volts) require a separate 30-amp circuit.
- A circuit breaker is recommended.
- Connect directly to the fused disconnect (or circuit breaker box) through flexible, armored or nonmetallic sheathed, copper cable (with grounding wire). See "Make Electrical Connection" section.
- Flexible conduit from the oven should be connected directly to the junction box.
- Do not cut the conduit. The length of conduit provided is for serviceability of the oven.
- A UL listed or CSA approved conduit connector must be provided.
- If the house has aluminum wiring, follow the procedure below:
  - Connect a section of solid copper wire to the pigtail leads.
  - Connect the aluminum wiring to the added section of copper wire using special connectors and/or tools designed and UL listed for joining copper to aluminum.


Follow the electrical connector manufacturer's recommended procedure. Aluminum/copper connection must conform with local codes and industry accepted wiring practices.

For power requirements, refer to the following table.

Model	Voltage	Amperage (L1)*	Amperage (L2)*	Rating (W)
KOCE507E/KOCE500E	120/240	32	30	8000
KOCE507E/KOCE500E	120/208	30	28	6600


\*Amperage values noted above are for information purposes only: the units are rated in watts.

## PRODUCT DIMENSIONS

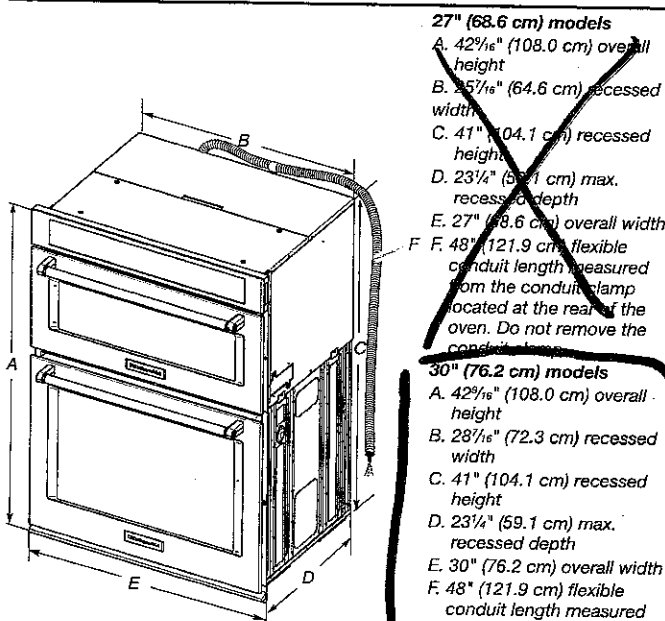

- 27" (68.6 cm) models**
- A. 42<sup>5</sup>/<sub>8</sub>" (108.0 cm) overall height
  - B. 25<sup>7</sup>/<sub>8</sub>" (64.6 cm) recessed width
  - C. 41" (104.1 cm) recessed height
  - D. 23<sup>1</sup>/<sub>4</sub>" (59.1 cm) max. recessed depth
  - E. 27" (68.6 cm) overall width
  - F. 48" (121.9 cm) flexible conduit length measured from the conduit clamp located at the rear of the oven. Do not remove the conduit clamp.
- 30" (76.2 cm) models**
- A. 42<sup>5</sup>/<sub>8</sub>" (108.0 cm) overall height
  - B. 28<sup>7</sup>/<sub>8</sub>" (72.3 cm) recessed width
  - C. 41" (104.1 cm) recessed height
  - D. 23<sup>1</sup>/<sub>4</sub>" (59.1 cm) max. recessed depth
  - E. 30" (76.2 cm) overall width
  - F. 48" (121.9 cm) flexible conduit length measured from the conduit clamp located at the rear of the oven. Do not remove the conduit clamp.

## Cabinet Dimensions

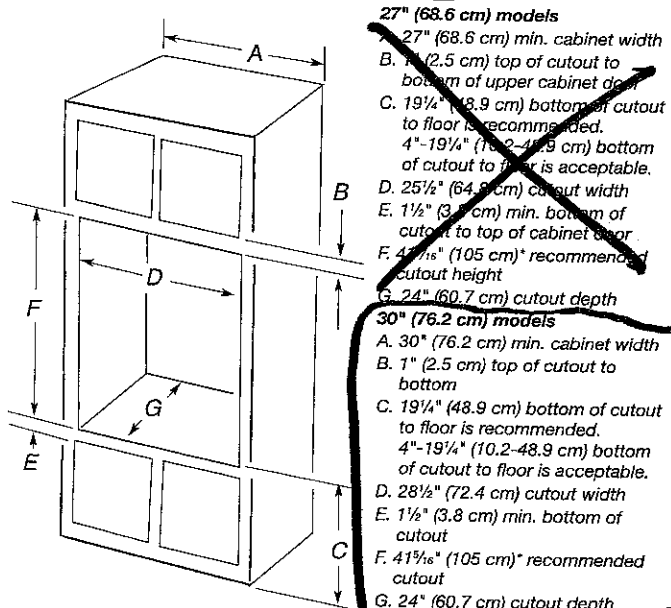

- 27" (68.6 cm) models**
- A. 27" (68.6 cm) min. cabinet width
  - B. 1" (2.5 cm) top of cutout to bottom of upper cabinet door
  - C. 19<sup>1</sup>/<sub>4</sub>" (48.9 cm) bottom of cutout to floor is recommended. 4"-19<sup>1</sup>/<sub>4</sub>" (10.2-48.9 cm) bottom of cutout to floor is acceptable.
  - D. 25<sup>1</sup>/<sub>2</sub>" (64.9 cm) cutout width
  - E. 1<sup>1</sup>/<sub>2</sub>" (3.8 cm) min. bottom of cutout to top of cabinet door
  - F. 41<sup>5</sup>/<sub>8</sub>" (105 cm)\* recommended cutout height
  - G. 24" (60.7 cm) cutout depth
- 30" (76.2 cm) models**
- A. 30" (76.2 cm) min. cabinet width
  - B. 1" (2.5 cm) top of cutout to bottom
  - C. 19<sup>1</sup>/<sub>4</sub>" (48.9 cm) bottom of cutout to floor is recommended. 4"-19<sup>1</sup>/<sub>4</sub>" (10.2-48.9 cm) bottom of cutout to floor is acceptable.
  - D. 28<sup>1</sup>/<sub>2</sub>" (72.4 cm) cutout width
  - E. 1<sup>1</sup>/<sub>2</sub>" (3.8 cm) min. bottom of cutout
  - F. 41<sup>5</sup>/<sub>8</sub>" (105 cm)\* recommended cutout
  - G. 24" (60.7 cm) cutout depth

\* NOTE: The cabinet height can be between 41" (104.1 cm) and 41<sup>1</sup>/<sub>2</sub>" (105.6 cm) for microwave/oven combination.

\* TOP OF WALL OVEN TRIM TO BE @ 70" AFF. \*

Because Whirlpool Corporation includes a continuous commitment to improve our products, we reserve the right to change materials and specifications without notice.

Dimensions are for planning purposes only. For complete details, see Installation Instructions packed with product. Specifications subject to change without notice.

Ref. W10725683B  
2/10/15

KLEINBURG GLEN

LOT 2R


MM MM

DATE: NOV 24 2016

11/18/2016

44 dBA Dishwasher with Dynamic Wash Arms (KDTM404EBS Black Stainless) | KitchenAid

KitchenAid®

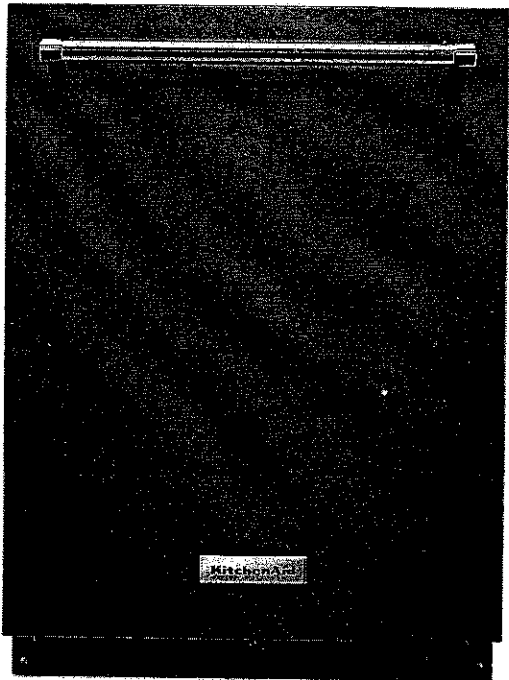

NEW

44 dBA Dishwasher with Dynamic Wash Arms

2.8

4 Reviews Write a Review

This beautiful top control dishwasher harnesses the power of the Dynamic Wash Arms to provide complete water coverage and superior cleaning. The unique design has nine arms that directly spray water everywhere in the dishwasher, including hard to reach places. It also features exclusive Clean Water Wash System that continuously cleans the wash water for superior performance, even with the heaviest loads.

AVAILABLE COLOR OPTIONS



Black Stainless - KDTM404EBS

FEATURES

Dynamic Wash Arm

Features nine wash arms in one for 3 times better coverage. This unique design directly sprays water everywhere in the dishwasher, including hard to reach places. This means dishes get a powerful clean no matter where they are placed in the rack.

Clean Water Wash System

Continuously removes food particles from the wash water. The result of this exclusive technology is reduced cycle times and less water and energy usage. Plus, there's no need to ever remove and clean the filter.

Professionally-Inspired Design

Combines a bold blend of professionally-inspired styling with sleek touches for the home. This beautiful console dishwasher features the KitchenAid® Badge, a symbol of uncompromised quality.

Additional Features

ProScrub® Option

Helps eliminate soaking or pre-scrubbing with 40 targeted spray jets that help remove stubborn messes like seared or baked-on foods.

ProScrub™ Upper (was Trio)

Provides 39% more coverage with targeted wash action. In addition to the 40 spray jets at the back of the dishwasher, you get two concentrated spray zones in the upper rack to clean deeper or oddly shaped items.

Third Level Rack

Makes it easy to clean hard-to-place items such as spatulas, serving utensils and measuring cups, freeing up space in the lower two racks.

Advanced ProDry™ System

Delivers the best drying performance without rinseaid\* using a recessed heating element and a fan to draw moisture out of the wash tub giving you better drying results.

ProWash™ Cycle

Determines the ideal cycle for washing dishes based on soil level and then makes real-time adjustments to achieve the best cleaning performance.

SatinGlide® Max Rails (Upper and Lower Racks)

Creates a smooth, premium feeling when pulling out the upper and lower racks, particularly with heavy loads.

2 Rows Fold-Down Tines in Upper Rack

Adjustable tines can be shifted into one of three positions to accommodate deep or wide dishes.

Fold-Down Tines in Lower Rack

Can be adjusted in one of three positions so water can clean inside deep or wide dishes.

2 Fold-Down Shelves with Stemware Holders

Provides extra room in the upper rack that's perfect for additional cups, wine glasses, or longer items like utensils and spatulas.

Utility Basket (Upper Rack)

Provides a dedicated space for small items such as small lids and utensils.

Express Wash Cycle

Quickly and effortlessly handles the heaviest soils, even stubborn baked and seared-on messes in less time.

KUENBURG GIVEN  
LOT 2R

MM MM

DATE: Nov. 24 2016

**KitchenAid®**

FOR THE WAY IT'S MADE.®

**Undercounter Dishwasher**

**PRODUCT MODEL NUMBERS**

KDFE204E, KDFE454C, KDTE104E, KDTE204E, KDTE254E, KDTM354E, KDTM384E, KDTM404E, KDTM504E, KDTM704E, KDTM804E

**Electrical Requirements:** 120-volt, 60 Hz, AC-only, 15- or 20-amp. fused electrical supply. Copper wire only. A time delay fuse or circuit breaker and separate circuit is recommended.

**If direct wiring dishwasher:** Use flexible, armored or nonmetallic, sheathed copper wire with grounding wire that meets the wiring requirements for your home and local codes and ordinances. Use a UL Listed or CSA Approved conduit connector.

**If connecting dishwasher with a power supply cord:**

Use power supply cord kit (Part Number 4317824) marked for use with dishwashers. Follow the kit instructions for installing the power supply cord. Power supply cord must plug into a grounded 3 prong outlet located in the cabinet next to the dishwasher opening. Outlet must meet all local codes and ordinances.

**Water Supply Requirements:** A hot water line with 20 to 120 psi (138 to 862 kPa) water pressure. Water temperature must be 120°F (49°C) water at dishwasher. Use 3/8" O.D. copper tubing with compression fitting or flexible braided water supply line

**Note:** 1/2" minimum plastic tubing is not recommended. Use a 90° elbow with 3/4" hose connection with rubber washer (Part Number W10273460). Do not solder within 6" (15.2 cm) from water inlet valve.

**Drain Requirements:** A new drain hose is supplied with your dishwasher. If this is not long enough, use a new drain hose with a maximum length of 12' (3.7 m) (Part Number 3385556) that meets all current AHAM/IAPMO test standards, is resistant to heat and detergent, and fits the 1" (2.5 cm) drain connector of the dishwasher.


Make sure to connect the drain hose to waste tee or disposer inlet above drain trap in house plumbing and 20" (50.8 cm) minimum above the floor. It is recommended

that the drain hose either be looped up and securely fastened to the underside of the counter or be connected to an air gap.

Make sure to use an air gap if the drain hose is connected to house plumbing lower than 20" (50.8 cm) above subfloor or floor.

Use 1/2" (1.3 cm) minimum I.D. drain line fittings. If required, the air gap should be installed in accordance with the air gap installation instructions. When connecting the air gap, a rubber hose (not provided) will be needed to connect to the waste tee or disposer inlet.

**PRODUCT DIMENSIONS**

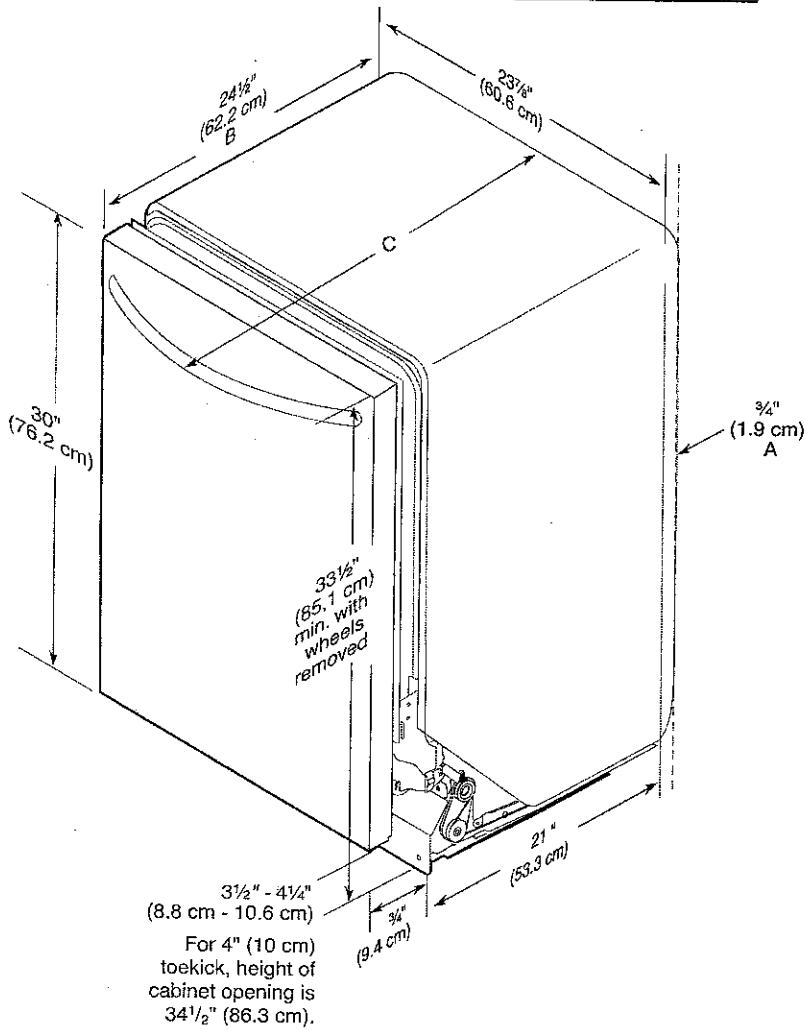

- A. Insulation may be compressed (not used on all models).
- B. For panel-ready models, dishwasher depth is 24" (60 cm) not including the 3/4" (1.9 cm) custom door panel.
- C. Door handles may protrude forward of the face of the dishwasher; varies by model.

KLEINBURG GREEN  
LOT 2R

MM MM


DATE: NOV. 24, 2016

CABINET CUTOUT DIMENSIONS

NOTE: Shaded areas of cabinet walls show where utility connections may be installed.

\*Measure from the lowest point on the underside of the countertop. May be reduced to 33½" (85.1 cm) by removing the rear leveling legs from dishwasher.

\*\*Minimum, measured from narrowest point of opening.

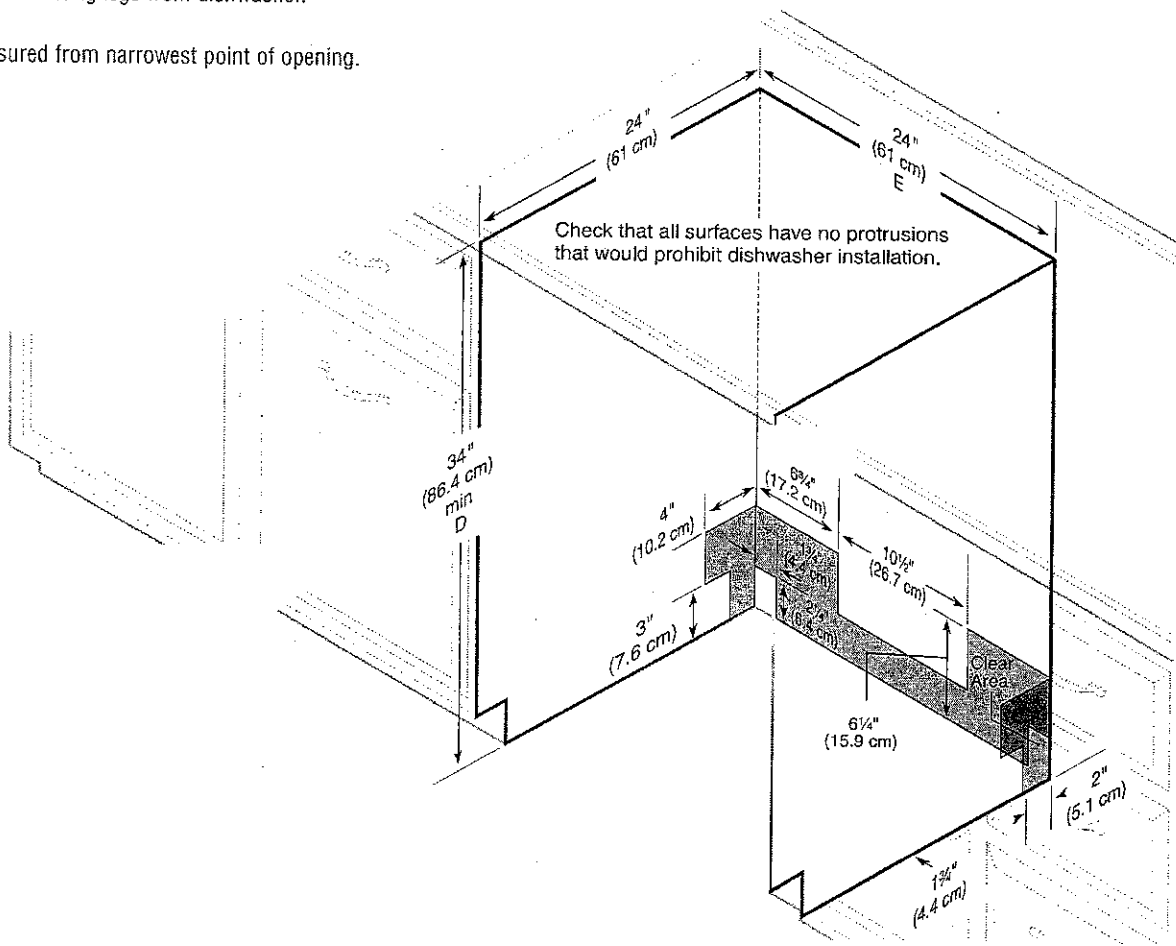


KLEINBURG GLEN  
LOT 2R

MM 4/4

DATE: NOV 24<sup>TH</sup> 2016

11/18/2016

25.8 Cu. Ft. 36" Multi-Door Freestanding Refrigerator with Platinum Interior Design (KRMF706EBS Black Stainless) | KitchenAid

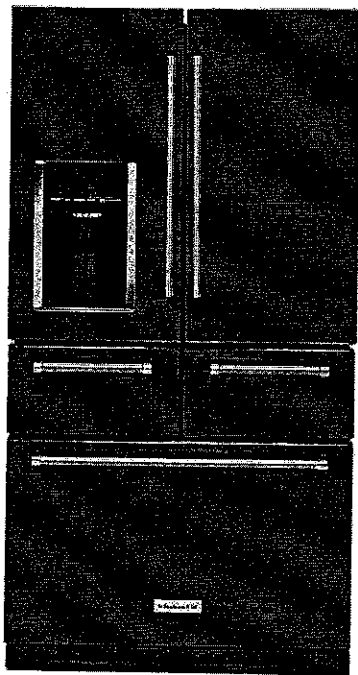

NEW


25.8 Cu. Ft. 36" Multi-Door Freestanding Refrigerator with Platinum Interior Design

0.0

[Write a Review](#)

This uniquely versatile, platinum interior refrigerator offers 5 doors, including 2 soft-close drawers, to deliver optimized storage. This refrigerator also features the Preserve® Food Care System which uses two independent cooling systems to help keep food fresh longer, while under-shelf LED lighting beautifully displays the food below for greater visibility.

AVAILABLE COLOR OPTIONS

 Black Stainless - KRMF706EBS

FEATURES

5-Door Configuration

Is a KitchenAid® innovation and industry first. This revolutionary configuration is a breakthrough in organization that puts all your food in ready sight and easy reach. It features soft close pantry doors to provide an additional level of convenience.

Preserva® Food Care System

Two independent cooling systems provide a dedicated refrigeration unit to help keep food fresh longer, and a separate system for frozen food. The FreshFlow™ Air Filter helps minimize odors while the two Produce Preservers help delay over-ripening.

Herb Storage

Keeps herbs like rosemary, oregano and thyme fresh in a dedicated storage compartment. An angled floor keeps the stems wet without covering the leaves, so your herbs bring all their flavor to your recipes.

Additional Features

2 Soft-Close Drawers

Offer optimized storage and are a first for freestanding refrigeration. The left drawer features 5 preset temperatures: meat/fish, drinks, greens/herbs, deli/cheese, thaw/marinate. The right drawer includes a Produce Preserver and is ideal for produce.

3-Tier Freezer Drawer with Storage Divider

Gives you easy access to frozen items with a three-level drawer, plus a divider in the lower basket to help you keep smaller items readily at hand.

SatinGlide® Crispers

Add a smooth experience to the crispier drawers. The rollers allow effortless in-and-out movement even when fully loaded.

Exterior Ice and Water Dispenser

In-Door-Ice® System

Adds interior room in the refrigerator with an ice bin that mounts on the inside left door of the refrigerator, keeping it

Professionally-Inspired Design

A bold blend of professionally-inspired styling and sleek touches for the home. This refrigerator features Satin Textured Handles with iconic KitchenAid Brand Medallions, a beautiful chrome frame surrounding the exterior water and ice dispenser and the KitchenAid® Badge.

LED Lighting

Illuminates the inside of the refrigerator and freezer giving for better visibility. Unlike incandescent bulbs, LED lights use less energy, are maintenance-free and never need to be replaced.

Adjustable Spill Resistant Glass Shelves

Are easy to clean and help prevent messes from spilling over into other parts of the refrigerator. The shelf edges are nano-etched with a finely textured surface that helps contain spills, and lets you use the whole shelf from edge-to-edge.

Measured Water Fill

Displays and automatically dispenses water in ounces, cups, or liters. It can be programmed to pour a measured amount, helping make food prep easier. It can even be set up to fill essential items on a daily basis like a coffee pot or a water bottle.

KLEINBURG GLEN

LOT 2R

MM MM

DATE: NOV 24<sup>th</sup> 2016

**KitchenAid®**  
FOR THE WAY IT'S MADE®

**PRODUCT MODEL NUMBERS**

KRMF606E      KRMF706E

**Electrical:** A 115 volt, 60 Hz, AC only, 15- or 20-amp fused, grounded electrical supply is required. It is recommended that a separate circuit serving only your refrigerator be provided. Use an outlet that cannot be turned off by a switch. Do not use an extension cord.

**Water:** A cold water supply with water pressure between 35 and 120 psi (241 and 827 kPa) is required to operate the water dispenser and ice maker. If you have questions about your water pressure, call a licensed, qualified plumber.


**NOTE:** If the water pressure is less than what is required, the flow of water from the water dispenser could decrease or ice cubes could be hollow or irregular shaped.

**Reverse Osmosis Water Supply:**  
**IMPORTANT:** The pressure of the water supply coming out of a reverse osmosis system going to the water inlet valve of the refrigerator needs to be between 35 and 120 psi (241 and 827 kPa).

If a reverse osmosis water filtration system is connected to your cold water supply, the water pressure to the reverse osmosis system needs to be a minimum of 40 to 60 psi (276 to 414 kPa).


**Bottom Mount Refrigerator**

**PRODUCT DIMENSIONS**

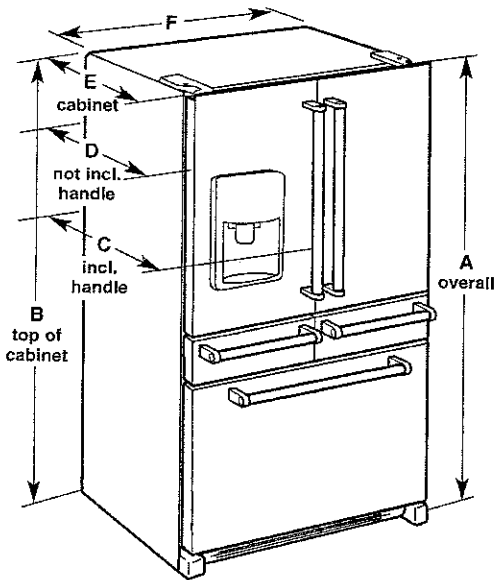

Model Size	Height - Overall "A"	Height - Top of Cabinet "B"	Depth - With Handles "C"	Depth - Without Handles "D"	Depth - Cabinet Only "E"	Width - Cabinet "F"
25.8	70 1/8" (178.1 cm)	66 3/8" (173.7 cm)	36 1/4" (92.1 cm)	34 1/2" (87.7 cm)	29" (73.7 cm)	35 3/8" (90.5 cm)

**LOCATION REQUIREMENTS**

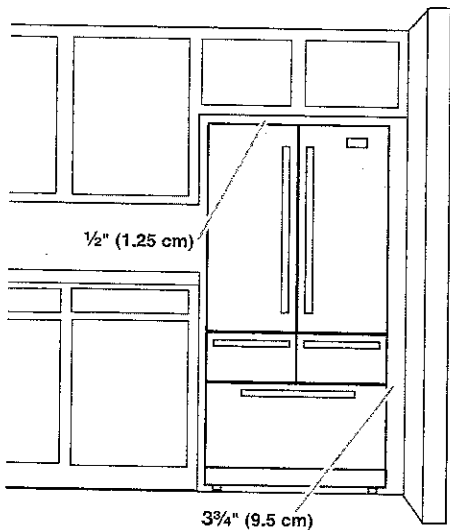

**IMPORTANT:** This refrigerator is designed for indoor, household use only.

To ensure proper ventilation for your refrigerator, allow for a 1/2" (1.25 cm) of space on each side and at the top. Allow for a 1" (2.54 cm) space behind the refrigerator. If your refrigerator has an ice maker, allow extra space at the back for the water line connections. When installing your refrigerator next to a fixed wall, leave a 3 3/4" (9.5 cm) minimum space between the refrigerator and wall to allow the door to swing open.

**NOTE:** This refrigerator is intended for use in a location where the temperature ranges from a minimum of 55°F (13°C) to a maximum of 110°F (43°C). The preferred room temperature range for optimum performance, which reduces electricity usage and provides superior cooling, is between 60°F (15°C) and 90°F (32°C). It is recommended that you do not install the refrigerator near a heat source, such as an oven or radiator.

KLEINBURG GLEN  
LOT 2R


MM MM

DATE: NOV. 24, 2016

11/18/2016

30" Wall-Mount, 3-Speed Canopy Hood (KVWB600DBS Black Stainless) | KitchenAid

KitchenAid®

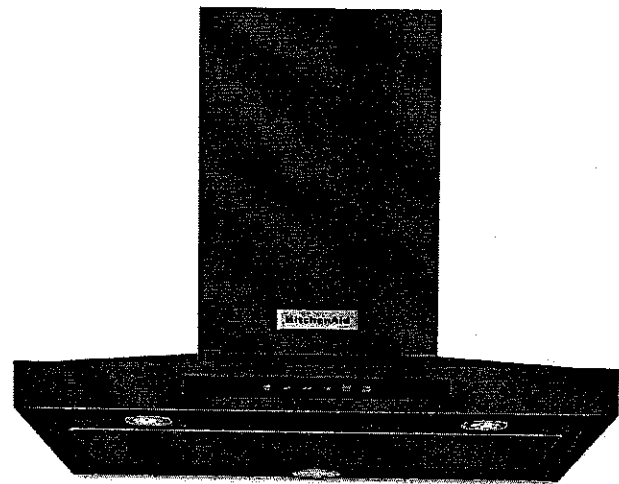

30" Wall-Mount, 3-Speed Canopy Hood

2.3

3 Reviews | Write a Review

This 3-speed vent hood has power to effectively vent an output of up to 65K BTUs. Auto speed sensing keeps the vent at the proper fan speed by sensing the amount of heat coming from the cooktop. This 30-inch wall-mount canopy hood has both LED and halogen lights to brighten almost any work area.

AVAILABLE COLOR OPTIONS

Black Stainless - KVWB600DBS

FEATURES

600 CFM/65K BTU Threshold

Allows installation over any KitchenAid regular 36- or 30-inch range or cooktop, and some commercial-style cooking surfaces with outputs up to 65K BTU.

Perimeter Ventilation

Increases ventilation system efficiency by pulling air from the edges of the hood and speeding up the movement of air at the center, allowing it to efficiently handle up to a 65K BTU total output.

Auto Speed Setting

Takes the guesswork out of protecting cabinets from steam, grease, and moisture by automatically adjusting fan speed to ventilation needs depending on the heat being produced.

Additional Features

LED Task Lights

Provide extra lighting over the cooking surface to help in the cooking process.

3-Speed Electronic Glass Touch Control with Boost Function (10 Min.)

Provides electronic operation with visual feedback on settings and selections. Enhances performance when using high-temperature cooking techniques by providing a timed, short burst of high-speed ventilation to effectively filter steam, grease, and odors from the air.

Easy In-line Conversion

Converts from a traditional set-up to an in-line blower installation for an even more quiet operation. Metal box purchase required.

Halogen Night Lights

Enhances the style of the ventilation system by providing soft, accent lighting in the kitchen. Whisper Quiet® System @ 49 dBA (1.5 sones) at Low Speed

Ensures that the ventilation system operates at a quiet level so it can be used while entertaining. At maximum speed, sound level is 65 dBA (5.4 sones).

Dishwasher Safe Grease Filters

Filter reduces steam, grease, and odor to help avoid contact with ceilings and countertops. The design increases filtration by obstructing the path of vented air to help capture more steam, grease, and odors as they are drawn through the vent.

KUENBURG GLEN  
LOT 2R

MM MM

DATE: NOV. 24. 2016

**KitchenAid®**  
FOR THE WAY IT'S MADE.™

**30" (72.6 cm) and 36" (91.4 cm) Wall-Mount Canopy Range Hood**

**PRODUCT MODEL NUMBERS**

KVWB600D      KVWB606D

**Electrical:** A 120 volt, 60 Hz., AC only, 15-amp, fused electrical circuit is required.

**VENTING METHODS**

This canopy range hood is factory set for venting through the roof or through the wall.

A 6" (15.2 cm) round vent system is needed for installation (not included). The hood exhaust opening is 6" (15.2 cm) round.

**NOTE:** Flexible vent is not recommended. Flexible vent creates back pressure and air turbulence that greatly reduce performance.

Vent system can terminate either through the roof or wall. To vent through a wall, a 90° elbow is needed.


**Rear Discharge**

A 90° elbow may be installed immediately above the hood.

**For Non-Vented (Recirculating) Installations**


If it is not possible to vent cooking fumes and vapors to the outside, the hood can be used in the non-vented (recirculating) version, using a Recirculation Kit (which includes charcoal filters and a deflector). To order, see the "Assistance or Service" section.

**Roof Venting**

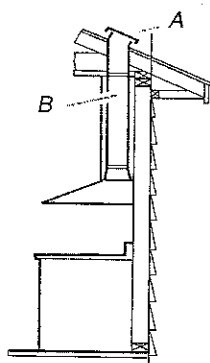


A. Roof cap  
B. 6" (15.2 cm) round vent

**Wall Venting**

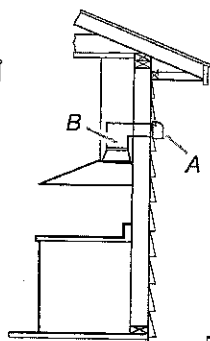

A. Wall cap  
B. 6" (15.2 cm) round vent

**Non-Vented (Recirculating)**

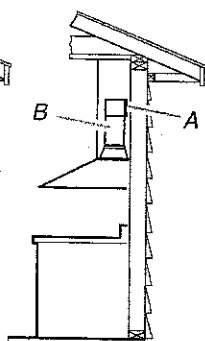

A. Diverter  
B. 6" (15.2 cm) round vent

**Calculating Vent System Length**

To calculate the length of the system you need, add the equivalent feet (meters) for each vent piece used in the system.

**Vent System**

**Vent Piece      6" (15.2 cm) Round**

45° elbow      2.5 ft (0.8 m)




90° elbow      5.0 ft (1.5 m)



Maximum equivalent vent length is 35 ft (10.7 m).


**Example Vent System**

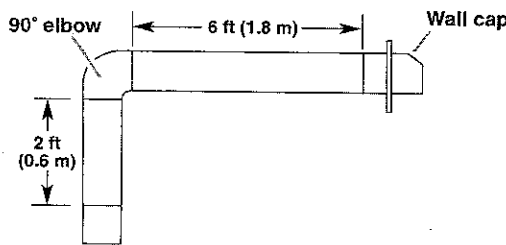

The following example falls within the maximum recommended vent length of 35 ft (10.7 m).

1 - 90° elbow	= 5.0 ft (1.5 m)
1 - wall cap	= 0.0 ft (0.0 m)
8 ft (2.4 m) straight	= 8.0 ft (2.4 m)
Length of system	= 13.0 ft (3.9 m)

**PRODUCT DIMENSIONS**

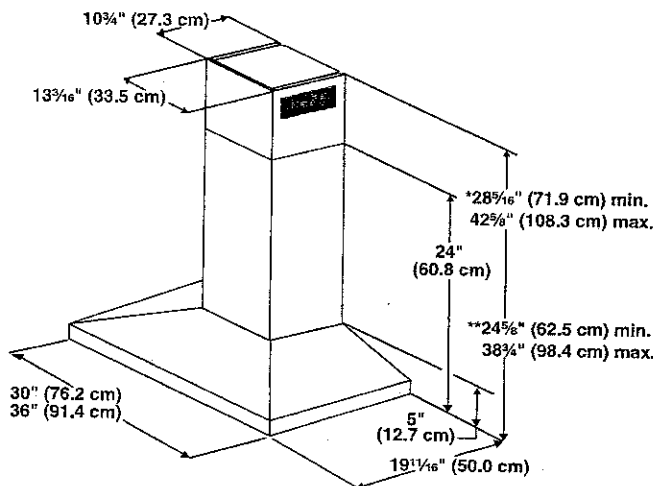

\*For non-vented (recirculating) installations

\*\*For vented installations


KLEINBURG GUEN  
LOT 2R

MM MM

DATE: NOV. 24. 2016



CABINET DIMENSIONS

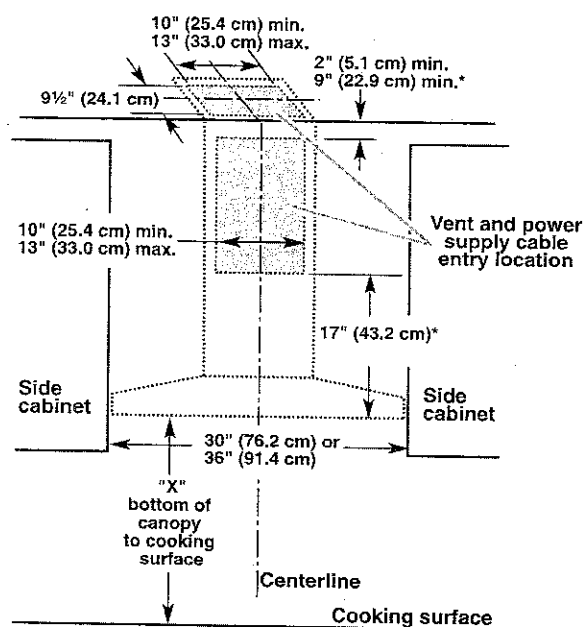

\*For non-vented (recirculating) installations

IMPORTANT:

- Minimum distance "X": 24" (61.0 cm) from electric cooking surface.
- Minimum distance "X": 27" (68.6 cm) from gas cooking surfaces.
- Suggested maximum distance "X": 36" (91.4 cm)

The chimneys can be adjusted for different ceiling heights. See the following chart.

Vented Installations		
	Min. ceiling height	Max. ceiling height
Electric cooking surface	7' 1" (2.16 m)	9' 2" (2.79 m)
Gas cooking surface	7' 4" (2.23 m)	9' 2" (2.79 m)

Non-vented (recirculating) Installations		
	Min. ceiling height	Max. ceiling height
Electric cooking surface	7' 1" (2.16 m)	9' 6" (2.9 m)
Gas cooking surface	7' 4" (2.23 m)	9' 6" (2.9 m)

**\*NOTE:** The range hood chimneys are adjustable and designed to meet varying ceiling or soffit heights depending on the distance "X" between the bottom of the range hood and the cooking surface. For higher ceilings, a Chimney Extension Kit is available from your dealer or an authorized parts distributor. The chimney extension replaces the chimney shipped with the range hood. To order, see the "Assistance or Service" section.

KLEINBURG GLEN  
LOT 2R

MM 44

DATE: NOV 24<sup>th</sup> 2016



18 Months Special Financing • Showroom • Rebate center • Pro

Sign In • Order Status • Help

Questions? Comments?  
(800) 570-3355

Orders over \$399

Free Delivery Nationwide

Q Search



Cooking



Refrigerators



Dishwashers



Washers & Dryers



Air Conditioners



Outdoor



Sinks & Faucets



Vacuums



Packages



Brands



On Sale

BlackFRIDAY

STARTS NOW  
SHOP EARLY FOR BEST SELECTION

SAVE UP TO 60%  
on select appliances

Free Delivery \$399+  
on eligible items before tax

No Interest For 18 Months  
on payments until May 2018

Home > Cooking Appliances > Cooktops > Gas Cooktops > Sealed Burner > RNCT305GBNG



### Dacor Renaissance RNCT305GBNG

#### 30 Inch Gas Cooktop

- 5 Sealed Burners
- SimmerSear Burner w/ Melting Feature
- Continuous Grates
- Perma-Flame Ignition
- Smart Flame Technology
- One Piece Spill Basin
- Illumina Indicator Lights
- Downdraft Compatible

☆ Be the first to review!

#### Option: Black, Natural Gas

 Stainless Steel, Natural Gas RNCT305GSNG \$1,149.00	 Stainless Steel, Natural Gas, High-Altitude RNCT305GSNGH \$1,149.00
 Stainless Steel, Liquid Propane RNCT305GSLP \$1,149.00	 Stainless Steel, Liquid Propane, High Altitude RNCT305GSLPH \$1,149.00
 Black, Natural Gas RNCT305GBNG \$1,149.00	 Black, Natural Gas, High Altitude RNCT305GBNGH \$1,149.00
 Black, Liquid Propane RNCT305GBLP \$1,149.00	 Black, Liquid Propane, High Altitude RNCT305GBLPH \$1,149.00

Price:

**\$1,149.00**

& FREE Nationwide Delivery

Price Match Guarantee

Qty

1

Add to Cart

#### Warranty

- ☐ 5 Year In Home Service - 50% Cash Back! +\$199.00
- ☐ 3 Year In Home Service +\$89.99
- ☒ Decline Protection

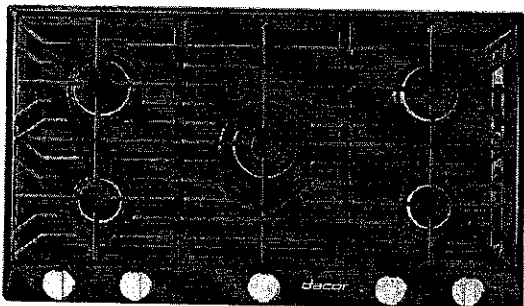


Image Disclaimer

KLEINBURG GLEN  
LOT 2R

MM MM

DATE: NOV. 24, 2016

#### Additional Options

##### Installation Kit

Add  
☐ 4' Gas Appliance Installation KitUGASKIT (required) preview

+ \$27.99

##### Other

Add  
☐ Reversible Grill-GriddleAGDCT12 preview

+ \$159.00

Add  
☐ Wok Ring for ER36D or ER48DAWR4 preview

+ \$79.00

Quick Specs

Product Information

Brand: Dacor  
Series: Renaissance  
Model: RNCT305GBNG  
MPN: RNCT305GB/NG

Appearance

Fuel Type: Gas  
Fuel Subtype: Natural Gas  
Style: Sealed Burner  
Type: Drop-In  
Continuous Grates: Yes  
Color: Black  
Surface Color: Black  
Trim Color: Black

Dimensions

Actual Width: 30 Inch  
Actual Depth: 21 Inch  
Actual Height: 6 Inch  
Cutout Width: 27 5/8 Inch  
Cutout Depth: 19 5/8 Inch

Burner Output

Set 1 QTY: 1  
Set 1 Output: 18000  
Set 2 QTY: 1  
Set 2 Output: 11000  
Set 3 QTY: 2  
Set 3 Output: 9000  
Set 4 QTY: 1  
Set 4 Output: 7000  
Grill: No  
Griddle: No  
French Top: No

Function

Burners / Elements: 5  
Control Type: Knobs  
Induction: No  
Sabbath Mode: No

Technical Details

ADA Compliant: No  
Star-K Certified: No  
Ignition Type: Electronic  
Modules Required: No  
LP Conversion: No  
Amps: 15  
Voltage: 120 Volts

ARE YOU A  
BUILDER?

Contact us for  
special pricing &  
volume discounts

Get Quote

Description Specifications Features Info & Guides Reviews

Features

Exclusive PermaClean Finish

- For easy, scratch-resistant clean-up and a beautiful finish for years to come.

One-Piece Spill Basin

- Ensures easy clean up.

Illumina Indicator Lights

- For both style and peace of mind in the kitchen.

Burner Power (5 burners)

- 1 SimmerSear Burner with Melting Feature (18,000 BTU)
- 4 Sealed burners with combined 36,000 BTU output

Ergonomic, Angled Controls

- For ease of use and a simplified cooking experience.

Die Cast Knobs

- For durability and style.

Perma-Flame Technology

- Automatically re-ignites a flame for continuous heating and uninterrupted cooking should a burner unexpectedly go out.

Smart Flame Technology

- For heat management to preserve the finish and the life of the grates.

Continuous Grates

- For the optimum cooking surface for larger pots.

4" Chassis Height

- For over-the-oven configurations.

Downdraft Compatible

- With ERV3015

KLEINBURG, GLEN  
LOT 2R

MM MM

DATE: Nov. 24, 2016

Shop By Category

Cooking Appliances

Laundry

# CORTINA

KITCHENS INC.

70 Regina Road Woodbridge ON L4L 8L6  
905-264-6464

## INFORMATION - PVC DOORS

Builder... GOLDPARK HOMES ... Project... KLEINBURG GLEN ... Lot #... 2R .....

All cabinets with PVC (Thermofoil) Doors come with melamine gables, panels and kick. The doors, crown moulding and light valance are PVC wrapped. Open shelves incorporated in design will only be available with melamine interiors. There will be variations in colour shades between the PVC parts (doors, crown and Light valance) and the melamine parts (open shelves, Gables, Panels and Kick) due to the difference in material.

Furring Panel with crown moulding to the ceiling is not available on all PVC door styles due to subtle variations in colour shades between the PVC parts (moulding) and the melamine parts (furring panel) due to the difference in material. Grain directions in wood grain pattern melamine, vary between the furring panel, crown moulding (horizontal) and the PVC doors (vertical).

Thank you for your understanding.

---

I am well informed of this information, and agree to the purchase of the above.

Purchaser: 

Date: NOV. 24. 2010

Purchaser: 

# CORTINA

70 Regina Road Woodbridge ON L4L 8L6  
905-264-6464

## DARK STAIN INFORMATION

Builder GOLDPARK HOMES Project KENNEDY GLEN Lot # 2R

Cortina Kitchens offers a wide variety of finishes, applied to oak and maple products. The subject finishes include the spray stains **Cocoa**, **Espresso**, **Graphite** as well as wiping stain **Ebony**.

Due to the very dark stains applied on natural maple and oak doors and joints, several characteristics are important to be noted when purchasing these products.

1. Shadow lines may be visible at the interior profile edges of a door or drawer front. If movement occurs shadow lines may increase or decrease, depending on the style and/or size of a door or drawer front.
2. Variation and unevenness may be visible in the finish.
3. Hairline cracks at the joints are created over time due to the nature of natural wood, caused by usage, humidity, or dryness. They tend to be more visible to darker stains, than lighter wood stains.

Please be advised that Cortina Kitchens will not replace doors nor parts that exhibit the above characteristics associated with this finish. These characteristics are not avoidable and are a result of the natural characteristics of wood and wood veneer, and the characteristics of darker stains on wood.

Thank you for your understanding.

\*\*\*\*\*

I am well informed of this information, and agree to the purchase of any of the subject finishes listed above.


Purchaser:



Date:

Nov. 24, 2016.


Purchaser:



## STANDARD HARDWARE



CSI-6

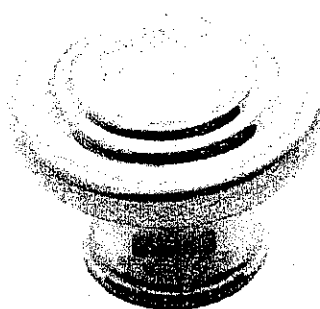

CSI-10



CSI-14


→ LAUNDRY




CSI-16




CSI-18

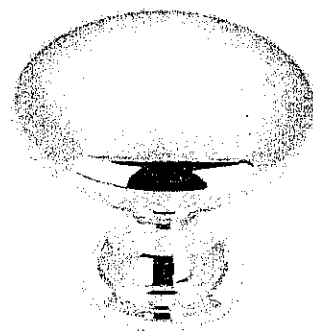

CSI-19

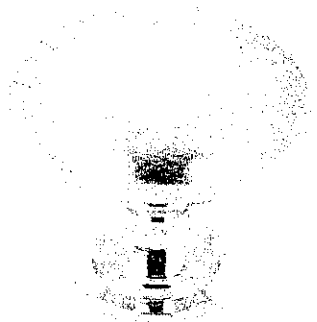


CSI-20

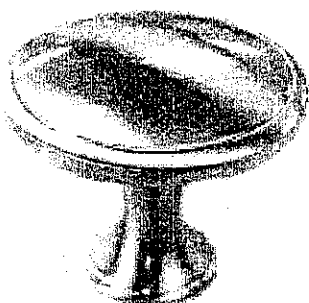


CSI-21

→ MASTER ENSUITE

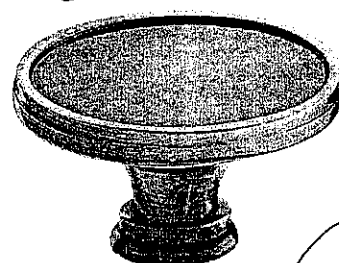


CSI-22

→ MAIN BATH

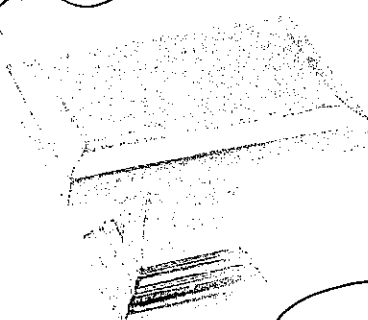


CSI-23

→ KITCHEN

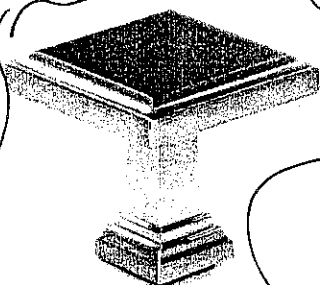

CSI-24

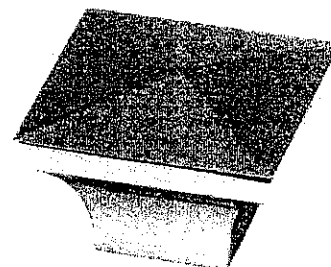

CSI-25

## \*NOTES:


- IMAGES ARE FOR QUICK REFERENCE PURPOSES ONLY
- ACTUAL SIZES AND FINISHES AS PER HARDWARE SAMPLE BOARD PROVIDED TO DECOR CENTRE

KLEINBURG GLEN  
LOT 2R.

MM MM


DATE: NOV. 24. 2016

**This layout has been explained to the purchaser by Cortina Kitchens Inc. and is understood by the purchaser.**

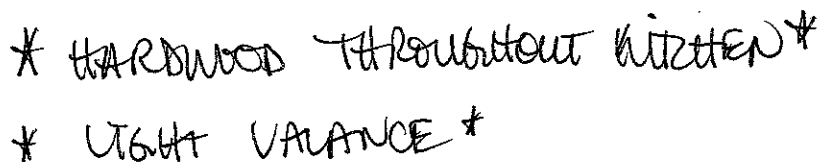


Trade Name: Gold Park Homes	Site location:	Model: 25-3
Address:	Project: Kleinburg Glen	Phase:

This layout has been explained to the purchaser by Cortina Kitchens Inc. and is understood by the purchaser.

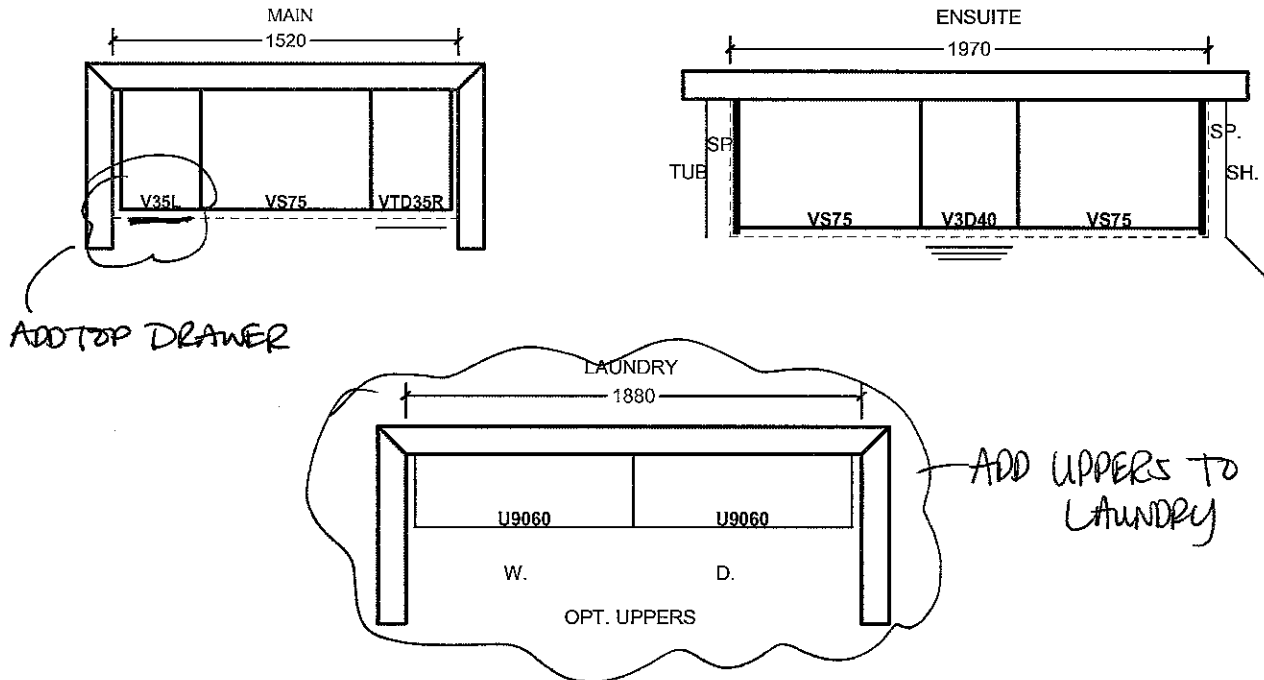

### OPT. SECOND FLOOR

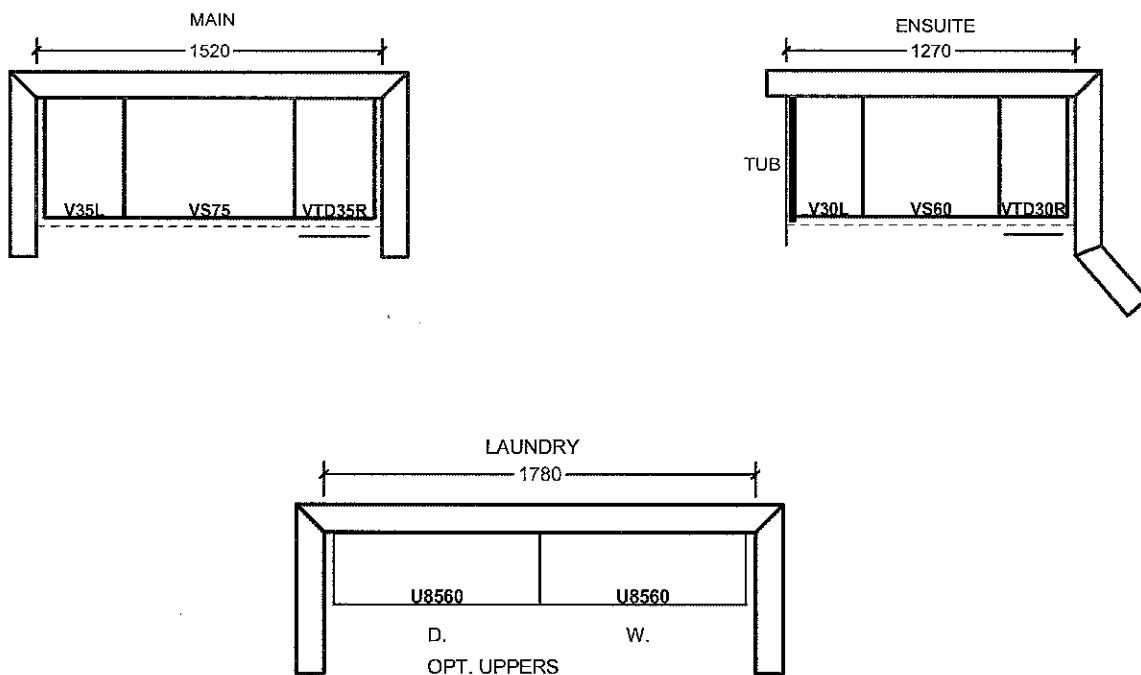

All prices subject to confirmation from head office.  
This quotation is subject to the terms & conditions set out

All agreements are contingent upon strikes, accidents, and delays beyond our control.  
Please provide our installer with template for sinkholes or \$150.00 will be charged for callback.

ACCEPTED DATE: NOV. 24, 2016

*[Signature]*

LOT 2R

*[Signature]*

Item A. Wood grain and colour are characteristics of the product. We cannot guarantee that such grain and colour will always match.  
Item B. Cortina Kitchens Inc. reserves the right to alter dimensions and make technical changes without notice.



Elevation A • 2,053 sq.ft.

Elevation B • 2,053 sq.ft.

UPGRADE TO CLEAR GLASS  
FRENCH DOORS WITH  
2 SIDE LITES

SPEAKER POUCH-IN  
IN SOFFIT

SPEAKER POUCH-IN

FAMILY ROOM  
POTLIGHTS  
ON SEP. SWITCH  
+ DIMMER.

110V + 220V REC.  
ON DEDICATED  
CIRCUIT FOR FUTURE  
MICROWAVE/WALL  
OVEN COMBO

KITCHEN  
POTLIGHTS ON  
SEP. SWITCH  
+ DIMMER.

GAS LINE  
FOR FUTURE  
GAS COOKTOP  
+ NO DEDICATED REC.

KITCHEN PENDANT  
LIGHTS OVER  
ISLAND, SEP.  
SWITCH

UNDER CABINET  
PUCK LIGHTS X5  
ON SEP. SWITCH


CATS LOCATION  
LEFT OF  
FRIDGE ON  
DISPLAY

PLEASE  
RELOCATE RECEPTACLE  
TO RIGHT OF  
FRIDGE  
BESIDE  
TELEPHONE

POT LIGHT IN  
POWDER ROOM ON  
SAME SWITCH AS  
VANITY LIGHT

SPEAKER  
POUCH-IN

HALLWAY POT LIGHTS  
ON SEP. SWITCH,  
WITH DIMMER  
+ SWAY

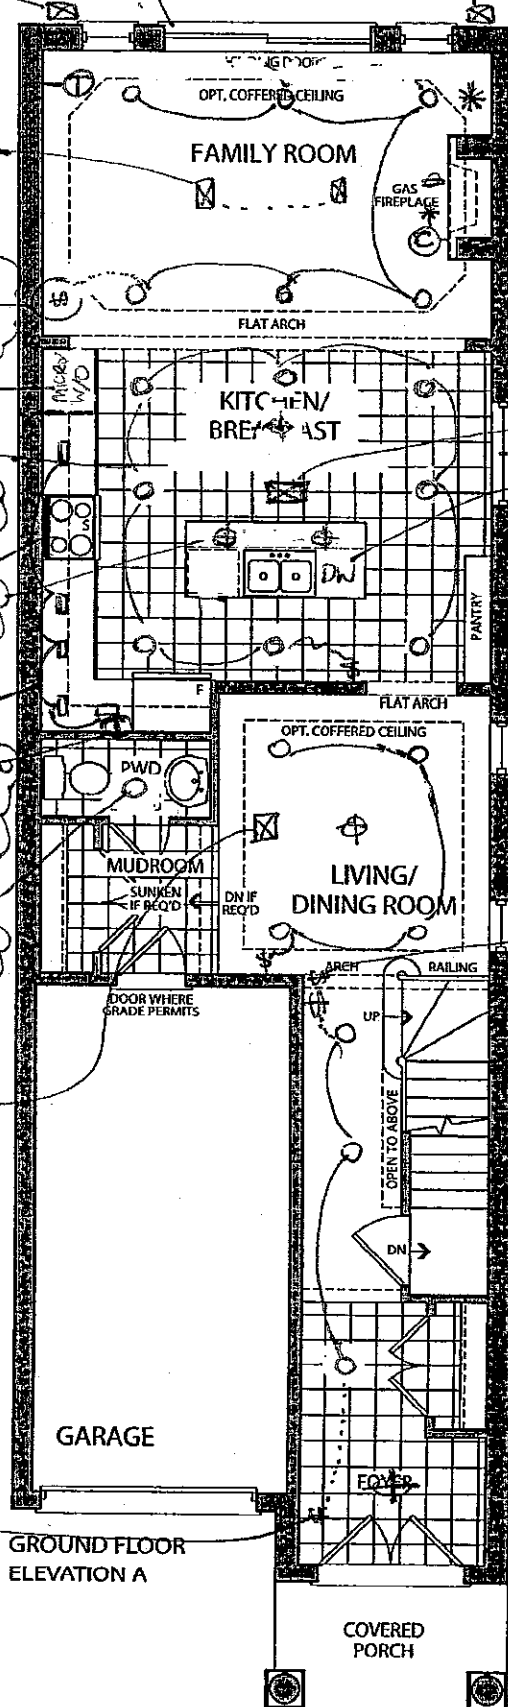

⊙ - 110V RECEPTACLE  
\* - CONDUIT, TERMINATING  
@ STANDARD  
HEIGHT, LEFT OF  
FIREPLACE.

⊙ - CABLE POUCH-IN  
SPEAKER POUCH-IN

RELOCATE DISHWASHER


HARDWOOD  
THROUGHOUT  
KITCHEN

SWAY SWITCH FOR 2ND FLOOR  
HALLWAY LIGHTS

GROUND FLOOR  
ELEVATION A

## LEGEND

- Ⓣ - TELEPHONE
- Ⓢ - CABLE
- \* - CONDUIT
- ⊙ - RECEPTACLE
- ⊠ - SPEAKER POUCH-IN
- ⊕ - CEILING LIGHTS
- - POT LIGHTS

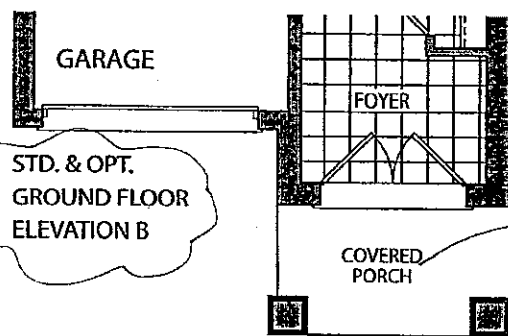

STD. & OPT.  
GROUND FLOOR  
ELEVATION B

MOTION SENSORED  
PORCH LIGHT

LOT 2R

MM MM


JULY 12, 2016

MM MM

NOV. 24, 2016

Elevation A • 2,053 sq.ft.

Elevation B • 2,053 sq.ft.

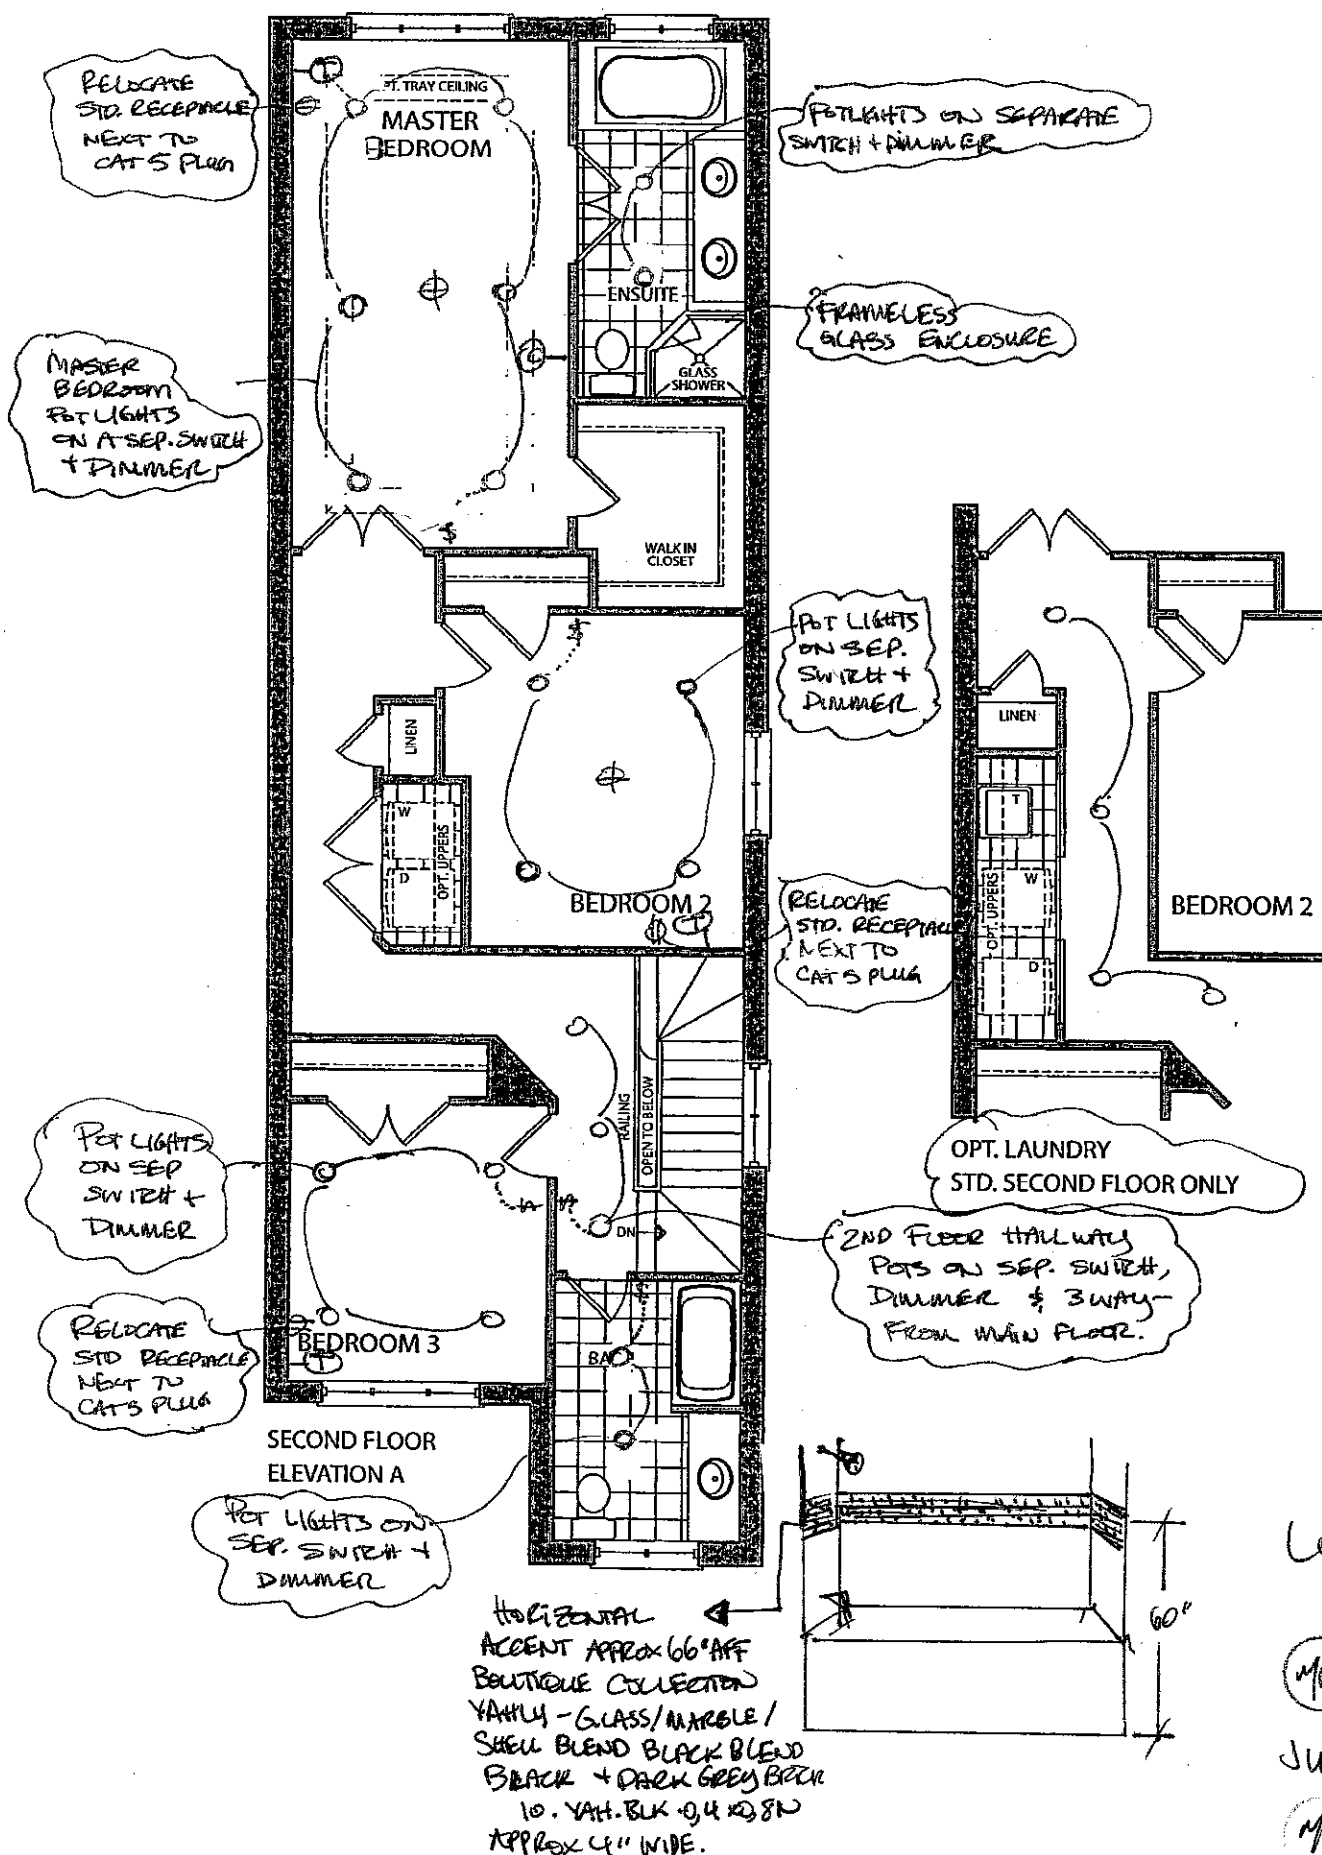

LOT 2R

MM MM


JULY 12, 2016

MM MM

NOV. 27, 2016

Elevation A • 2,053 sq.ft.


Elevation B • 2,053 sq.ft.

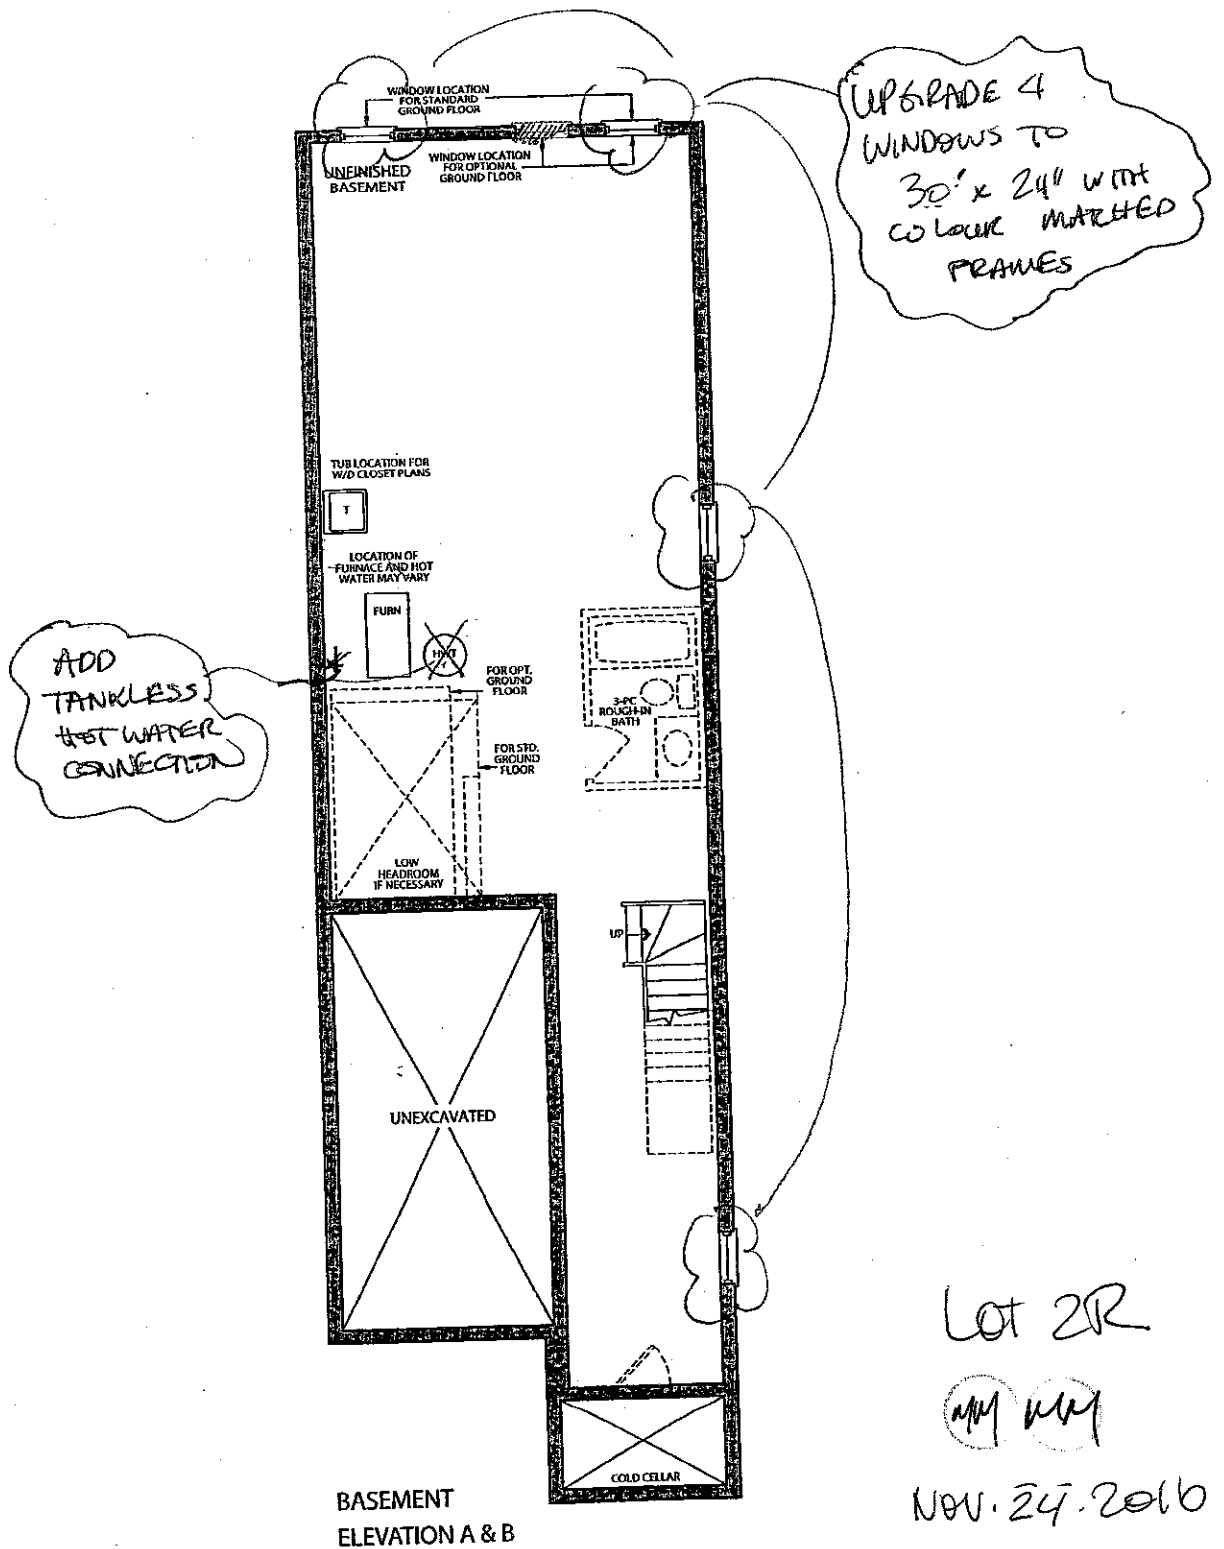




# the Oakmount

Elevation A • 2,053 sq.ft.  
Elevation B • 2,053 sq.ft.

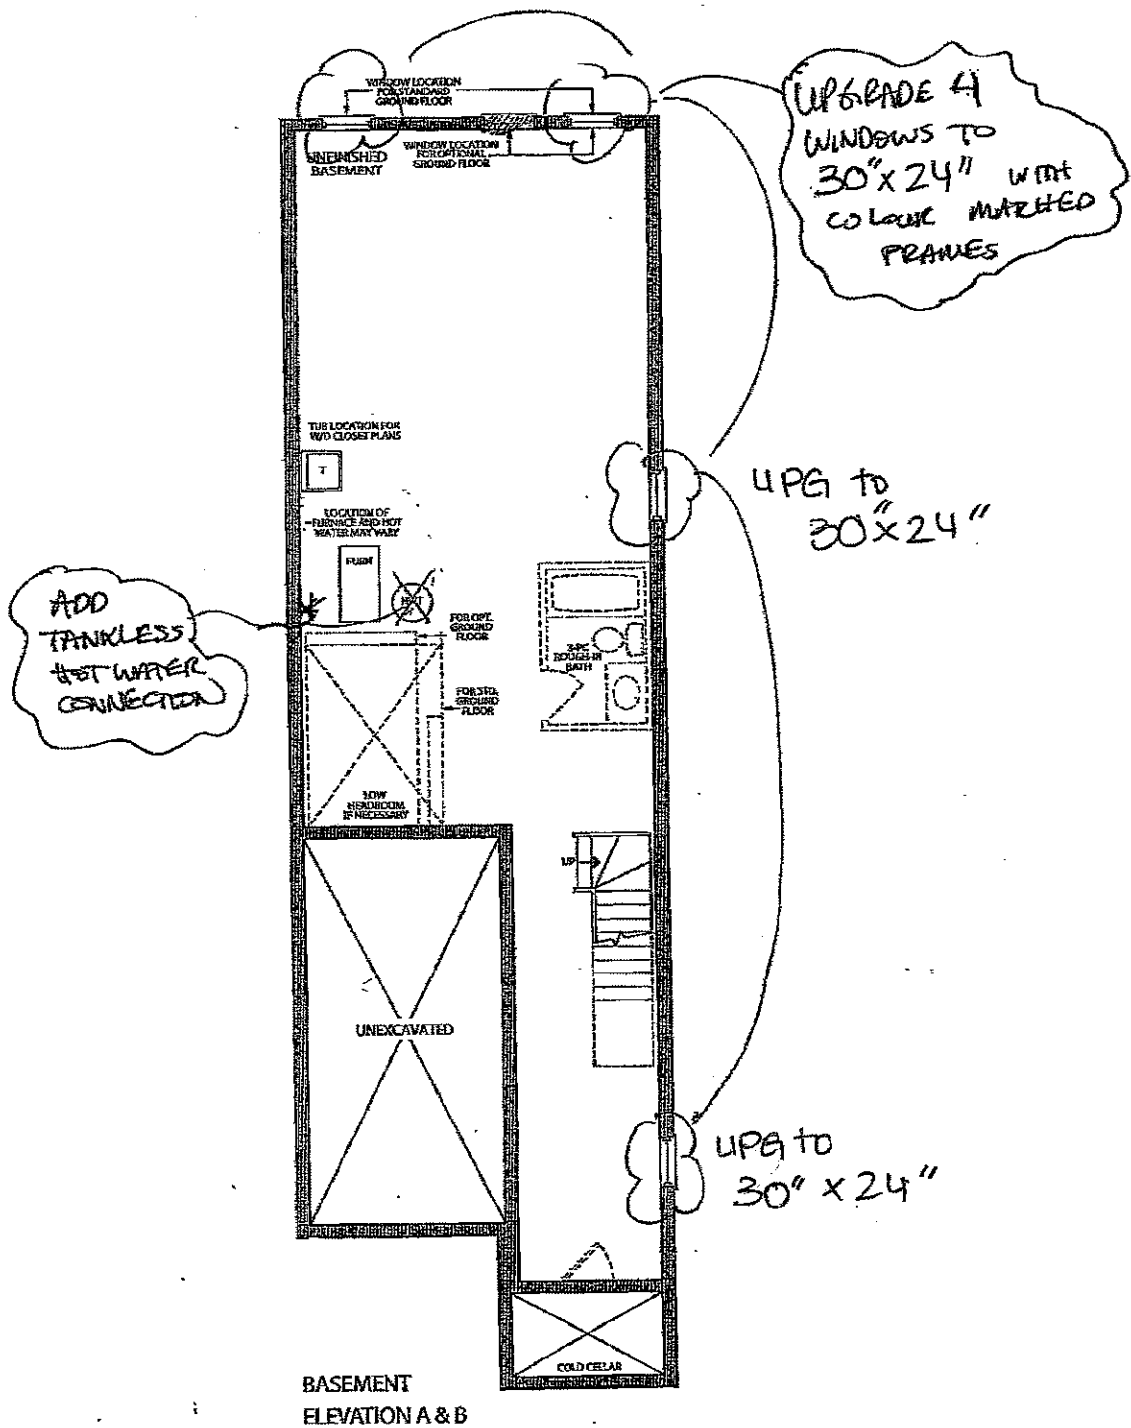

2R

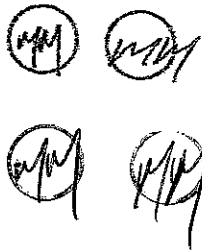

Prices, figures, illustrations, sizes, features and finishes are subject to change without notice. E&OE Areas and dimensions are approximate and actual useable floor space may vary from the stated area. Layout may be reverse of the unit purchased. E. & O.E.

**GOLDPARK**  
HOMES