CONSTRUCTION SUMMARY

115 - 1 - 38-3 Elev.A HAYDN

CENTRAL VAC AND WIRING

Inv.**628**	**1** - TELEPHONE AND CABLE ROUGH-IN LOCATIONS
Line**7933**	Note:
6Jul16 / 26Sep16	

Inv.**628**	**1** - FAMILY ROOM: INSTALL CONDUIT PIPE- FOR TELEVISION- ABOVE FIREPLACE, SEE SKETCH
Line**7934**	Note:
6Jul16 / 26Sep16	

ELECTRICAL

Inv.**628**	**1** - FAMILY ROOM: INSTALL 110V WALL RECEPTACLE ON DEDICATED CIRCUIT - ABOVE FIREPLACE FAN KIT -SEE SKETCH
Line**7935**	Note:
6Jul16 / 26Sep16	

Inv.**628**	**5** - EXTERIOR: INSTALL FIVE (X5) POT LIGHT: 4 INCH LINE VOLTAGE POT LIGHT - (EXTERIOR) -EACH. SEE SKETCH
Line**7936**	Note:
6Jul16 / 26Sep16	

Inv.**628**	**1** - KITCHEN: INSTALL KITCHEN CABINET STRIP VALANCE LIGHTS (UNDER CABINETS) - ROUGH - IN - DOES NOT INCLUDE (AND REQUIRES) KITCHEN UPGRADE PRICING
Line**7940**	Note:
6Jul16 / 26Sep16	

EXTERIOR COLOURS

Inv.**628**	**1** - EXTERIOR COLOUR PACKAGE 2
Line**11995**	Note:
6Jul16 / 26Sep16	

FORMING

Inv.**628**	**1** - EXTERIOR: INSTALL SIDE DOOR- HOME TO EXTERIOR- AS PER PLAN AND GRADE PERMITTING
Line**7938**	Note: YES GRADING DOES PERMIT BASED ON SITING DATED AUGUST 2, 2016
6Jul16 / 26Sep16	

FRAMING

Inv.**628**	**1** - GARAGE: INSTALL MANDOOR - GARAGE TO HOUSE- AS PER PLAN AND GRADE PERMITING
Line**7937**	Note: GIVEN IN AGREEMENT OF PURCHASE AND SALE
6Jul16 / 26Sep16	YES GRADING DOES PERMIT BASED ON SITING DATED AUGUST 2, 2016

MISC.

Inv.**628**	**1** - BONUS PACKAGE: $6570.95 (INCLUDING TAXES) WORTH OF UPGRADES FROM GOLD PARK HOMES DÉCOR CENTRE IS BEING APPLIED TOWARD THE STRUCTURAL APPOINTMENT. PURCHASER HAS A REMAINING AMOUNT OF $3429.05 (INCLUDING TAXES) TO BE USED TOWARD THE COLOUR APPOINTMENT.
Line**7941**	Note:
6Jul16 / 26Sep16	

CONSTRUCTION SUMMARY

115 - 1 - 38-3 Elev.A HAYDN

Inv.**628**	**1** - Purchaser has attended a Structural appointment at the Decor Centre & has DECLINED any additional upgrades and accepts and acknowledges that there will be no further structural changes/additions/deletions to be made upon signing on July 6, 2016
Line**7942**	Note:
6Jul16 / 26Sep16	

Inv.**628**	**1** - Purchasers are aware & accepts that ANY changes made to upgrades after signing this Purchasers Extra Form are subject to a minimum administration fee of $500. PLUS a 10% holdback fee
Line**7943**	Note:
6Jul16 / 26Sep16	

PLUMBING

Inv.**628**	**1** - BASEMENT: INSTALL ROUGH-IN - 3PC BASEMENT ROUGH-IN, AS PER PLAN
Line**7939**	Note:
6Jul16 / 26Sep16	

encore
BRAMPTON

Telephone — (T)
Cable — (C)
Electrical — (E)

The Haydn
38' SERIES

Elevation A • 2,454 sq.ft. | Elevation B • 2,448 sq.ft.

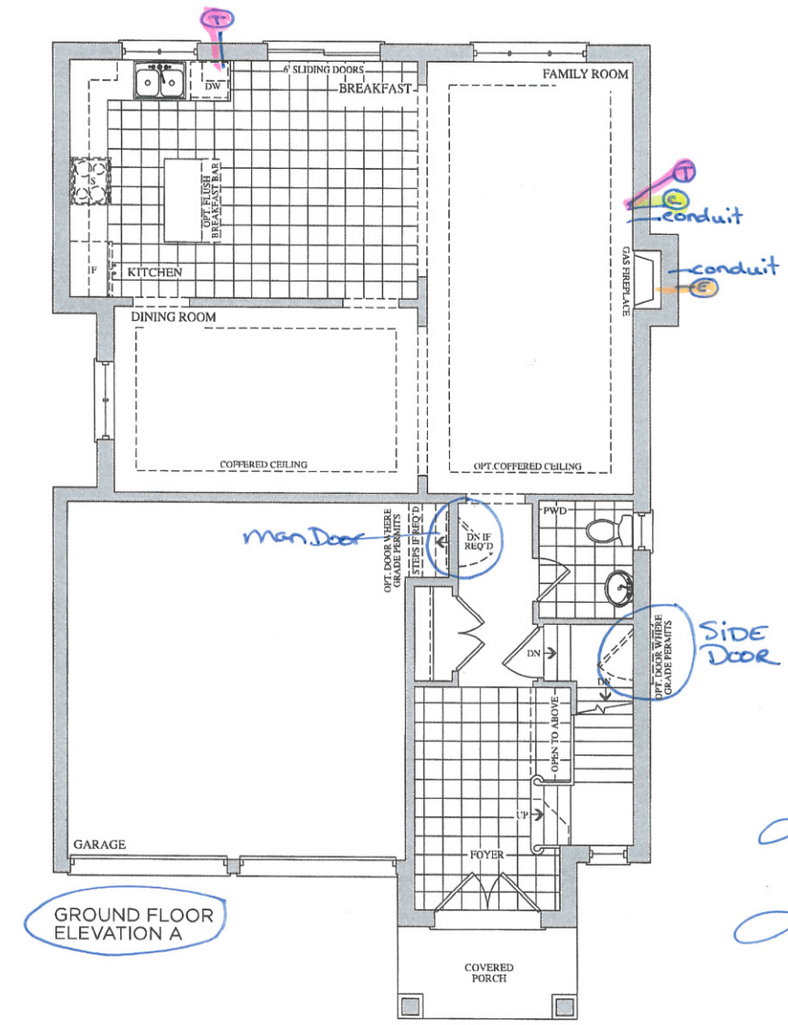

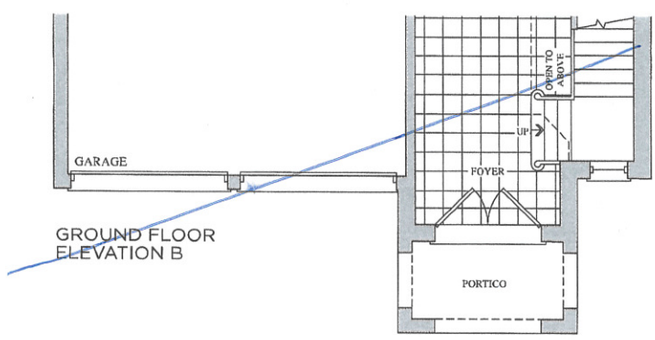

Lot 115
July 6, 16

Prices, figures, illustrations, sizes, features and finishes are subject to change without notice. E.&O.E. Areas and dimensions are approximate and actual usable floor space may vary from the stated area. Layout may be reverse of the unit purchased. E. & O.E.

GOLDPARK HOMES

encore
BRAMPTON

Telephone — (T)
Cable — (C)

The Haydn
38' SERIES

Elevation A • 2,454 sq.ft. | Elevation B • 2,448 sq.ft.

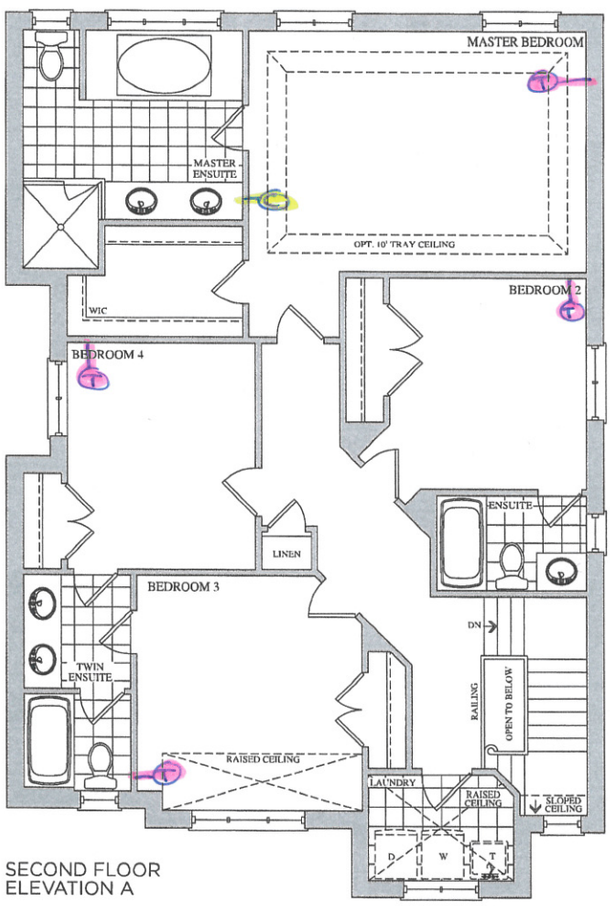

SECOND FLOOR
ELEVATION A

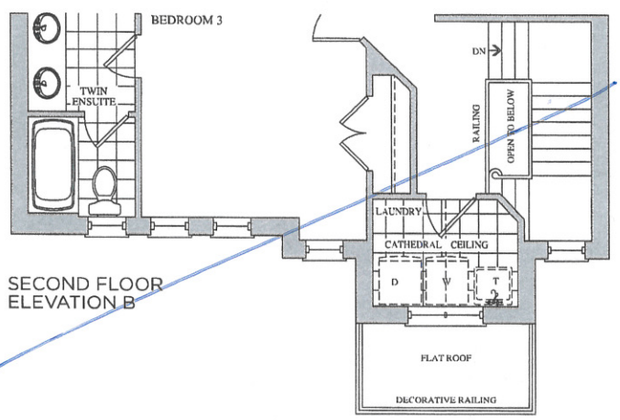

SECOND FLOOR
ELEVATION B

Lot 115
July 6, 16

Prices, figures, illustrations, sizes, features and finishes are subject to change without notice. E.&O.E. Areas and dimensions are approximate and actual usable floor space may vary from the stated area. Layout may be reverse of the unit purchased. E. & O.E.

GOLDPARK HOMES

encore
BRAMPTON

The Haydn
38' SERIES

Elevation A • 2,454 sq.ft. | Elevation B • 2,448 sq.ft.

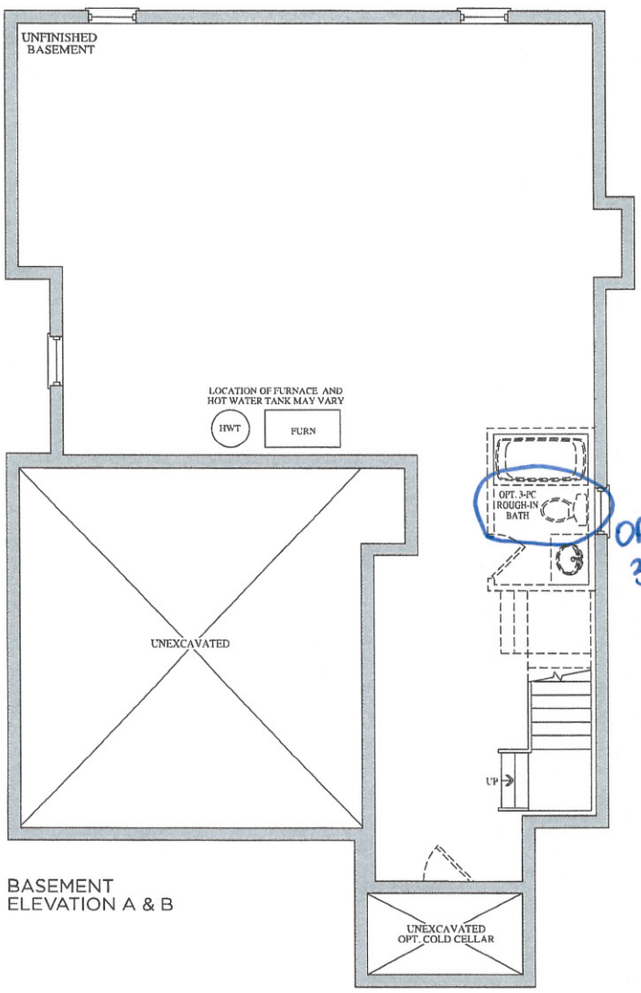

BASEMENT
ELEVATION A & B

Lot 115
July 6, 16

OPT. 3 Piece Rough-in

Prices, figures, illustrations, sizes, features and finishes are subject to change without notice. E.&O.E. Areas and dimensions are approximate and actual usable floor space may vary from the stated area. Layout may be reverse of the unit purchased. E. & O.E.

GOLDPARK HOMES

Lot 115

5 exterior pot lights, as per plan

July 6, 16

The Haydn

Elevation A • 2,454 sq.ft.

lot

April

GOLDPARK HOMES

Stacey Carlete
Project Coordinator

Claude Azzopardi
Contracts Manager

Nancy Ma
Corporate C

115
Lot #

encore
BRAMPTON

Model	38.1 The Bizet	
Elevation	Circle One: A	2189.6 Square Feet
	B	2186.7 Square Feet
Optional Layouts	Circle All that Apply	

Model	38.2 The Ravel	
Elevation	Circle One: A	2271.5 Square Feet
	B	2273.7 Square Feet
Optional Layouts	Circle All that Apply	

Model	38.3 The Haydn	
Elevation	Circle One: A	2394.5 Square Feet
	B	2388.3 Square Feet
Optional Layouts	Circle All that Apply	

Model	38.4 The Vivaldi	
Elevation	Circle One: A	2459.1 Square Feet
	B	2459.1 Square Feet
Optional Layouts	Circle All that Apply	

Model	38.5 The Handel	
Elevation	Circle One: A	2549.2 Square Feet
	B	2554.7 Square Feet
Optional Layouts	Circle All that Apply	

Model	38.9 The Puccini	
Elevation	Circle One: A	3628.0 Square Feet
	B	3634.7 Square Feet
Optional Layouts	Circle All that Apply: GFA1	GROUND FLOOR Optional Alternative Layout

Model	38.6 The Scarlatti	
Elevation	Circle One: A	3521.1 Square Feet
	B	3508.1 Square Feet
Optional Layouts	Circle All that Apply: GFA1	GROUND FLOOR Optional Alternative Layout

Model	38.7 The Schubert	
Elevation	Circle One: A	3593.8 Square Feet
	B	3610.5 Square Feet
Optional Layouts	Circle All that Apply: GFA1	GROUND FLOOR Optional Alternative Layout
	SFA4	SECOND FLOOR Additional Bedroom

Model	38.8 The Corelli	
Elevation	Circle One: A	3801.5 Square Feet
	B	3801.5 Square Feet
Optional Layouts	Circle All that Apply: GFA1	GROUND FLOOR Optional Alternative Layout
	SFA4	SECOND FLOOR Additional Bedroom w/ Ensuite

Model	41.1 The Strauss	
Elevation	Circle One: A	2554.2 Square Feet
	B	2571.2 Square Feet
Optional Layouts	Circle All that Apply: SFA1	SECOND FLOOR Shower In Lieu of Tub B2

Model	41.2 The Mozart	
Elevation	Circle One: A	2725.9 Square Feet
	B	2711.1 Square Feet
Optional Layouts	Circle All that Apply: SFA1	SECOND FLOOR Shower In Lieu of Tub B2

Model	41.3 The Chopin	
Elevation	Circle One: A	2800.0 Square Feet
	B	2810.5 Square Feet
Optional Layouts	Circle All that Apply	

Model	41.4 The Bach	
Elevation	Circle One: A	2894.4 Square Feet
	B	2894.5 Square Feet
Optional Layouts	Circle All that Apply	

Model	41.5 The Brahms	
Elevation	Circle One: A	3948.1 Square Feet
	B	3949.1 Square Feet
Optional Layouts	Circle All that Apply: GFA1	GROUND FLOOR Optional Alternative Layout
	SFA2	SECOND FLOOR Shower In Lieu of Tub B4
	SFA3	SECOND FLOOR Optional Laundry Layout

Model	41.6 The Verdi	
Elevation	Circle One: A	3862.5 Square Feet
	B	3866.4 Square Feet
Optional Layouts	Circle All that Apply: GFA1	GROUND FLOOR Optional Alternative Layout
	SFA3	SECOND FLOOR Optional Laundry Layout

July 6, 16