

It is the builder's complete responsibility to ensure that all plans submitted for approval fully comply with the Architectural Guidelines and all applicable regulations and requirements including zoning provisions and any provisions in the subdivision agreement. The Control Architect is not responsible in any way for examining or approving site (lotting) plans or working drawings with respect to any zoning or building code or permit matter or that any house can be properly built or located on its lot.

This is to certify that these plans comply with the applicable Architectural Design Guidelines approved by the City of VAUGHAN.

JUL 20 2016

John G. Williams Limited, Architect

client

project


title

project #

scale

lot(s)

40

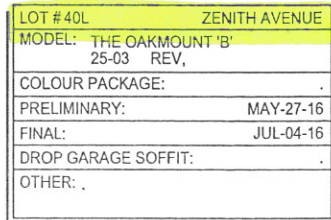

LOT #40R	ZENITH AVENUE
MODEL: THE BILTMORE 'A CORNER'	
25-08 STD,	
COLOUR PACKAGE:	.
PRELIMINARY:	MAY-27-16
FINAL:	JUL-04-16
DROP GARAGE SOFFIT:	.
OTHER: .	

