



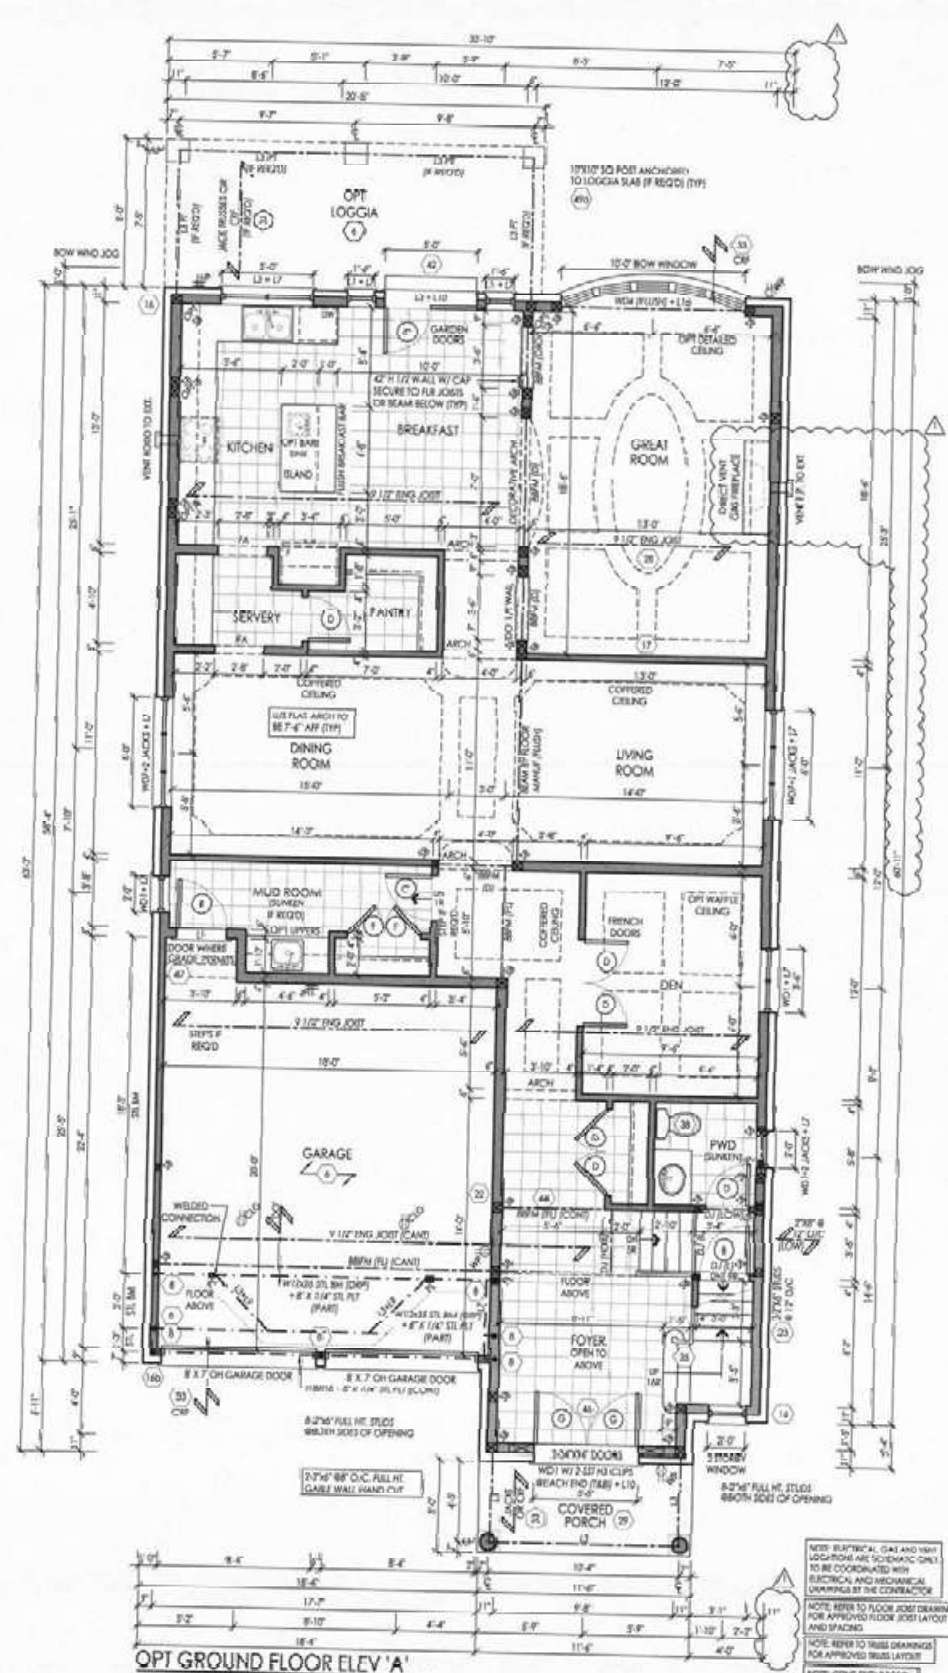

AN design
Imagine • Inspire • Create

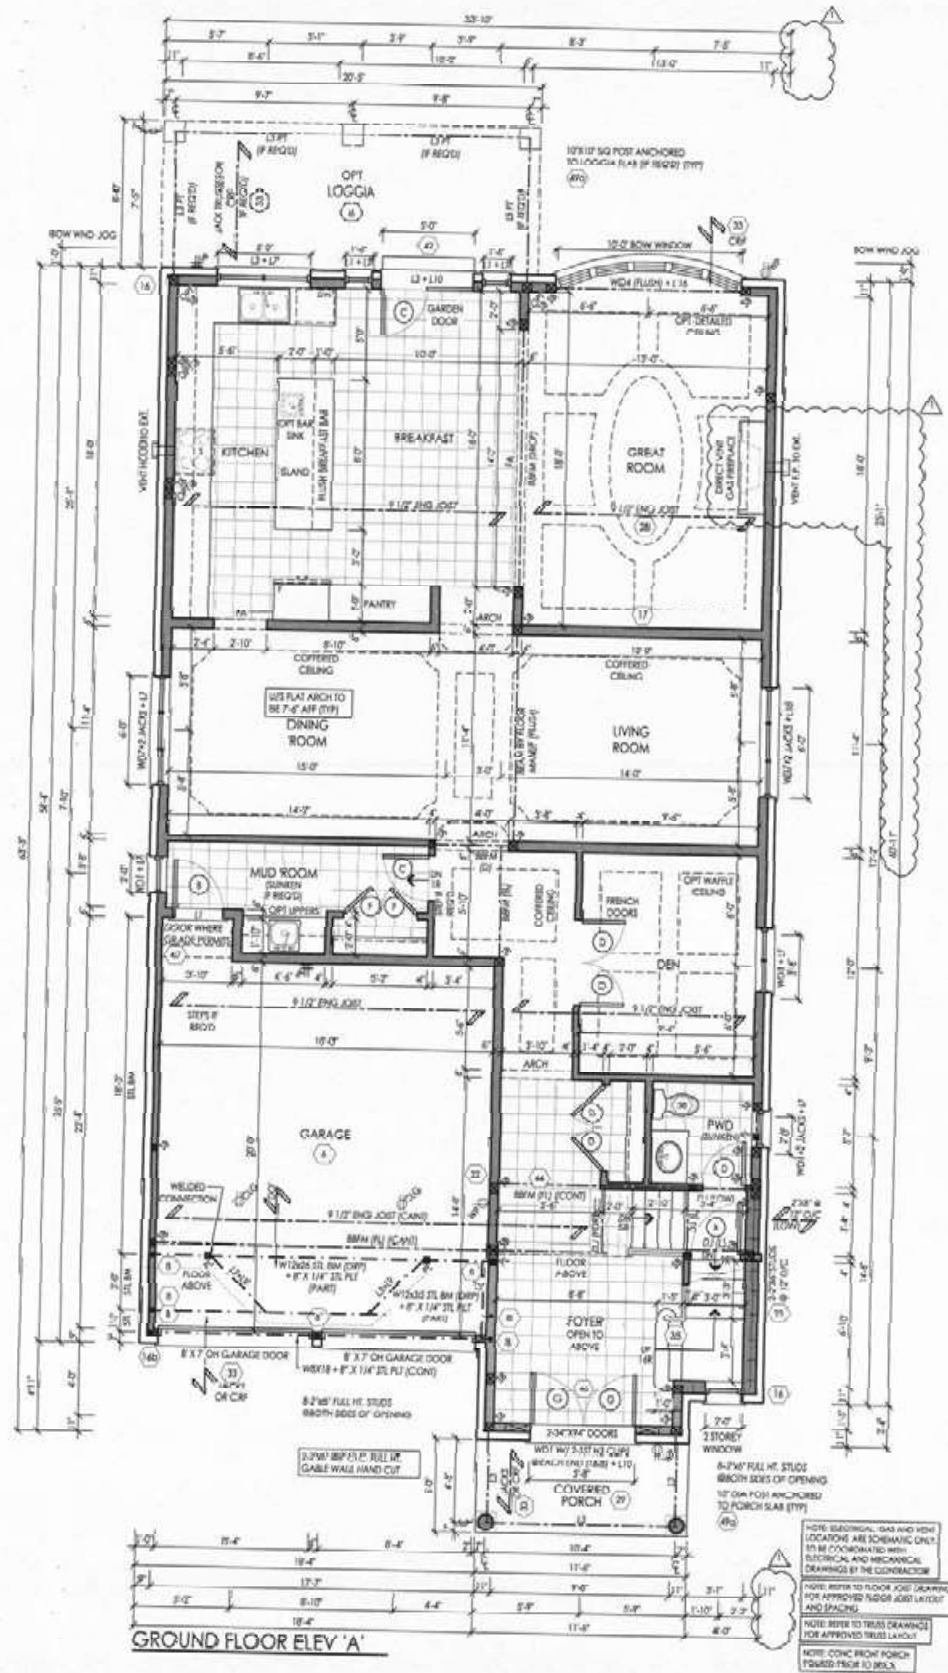

I, JAMES WILLIAMS, ARCHITECT, HAVE REVIEWED AND TAKEN DESIGN RESPONSIBILITY FOR THE DESIGN WORK ON BEHALF OF AN DESIGN LTD. UNDER DIVISION CHARTER SUBSECTION 3.2.4 OF THE BUILDING CODE. I AM QUALIFIED AND THE FIRM IS REGISTERED IN THE APPROPRIATE CLASS / CATEGORY.

QUARTER DESIGNER SIGN: JAMES WILLIAMS
DATE: MAR 27 2017
SIGNATURE: [Signature]



MAR 27 2017
FOR STRUCTURAL ONLY EXCLUDING
1. 17' x 4' STED ROOF TRUSS, FLOOR
JOIST & FLOOR SLAB DESIGN



This is to certify that these plans comply with the applicable Architectural Guidelines and are approved by the City of Vaughan.

ARCHITECTURAL REVIEW APPROVAL
MAR 27 2017
John G. Williams Limited, Architect

#	REVISIONS	DATE	BY	CHK
1	BASED FOR CITY REVIEW	MAR 20 17	AW	CK
2	REVISED AFTER FLOOR & TRUSS DESIGN	11 JUN 17	AW	CK
3	REVISED AFTER ENGINEERING COMMENTS	15 JUN 17	AW	CK
4	REVISED TRUSS AND FLOOR JOIST DESIGN	15 JUN 17	CK	CK
5	REVISED AFTER CITY COMMENTS	20 JUN 17	CK	CK
6	BASED FOR PERMIT	20 JUN 17	AW	CK
7				
8				
9				
10				
11				
12				

Gold Park Homes


KLEINBURG GLEN
PH-2
VAUGHAN, ON

42-5

14043

3/16" = 1'-0"

A2

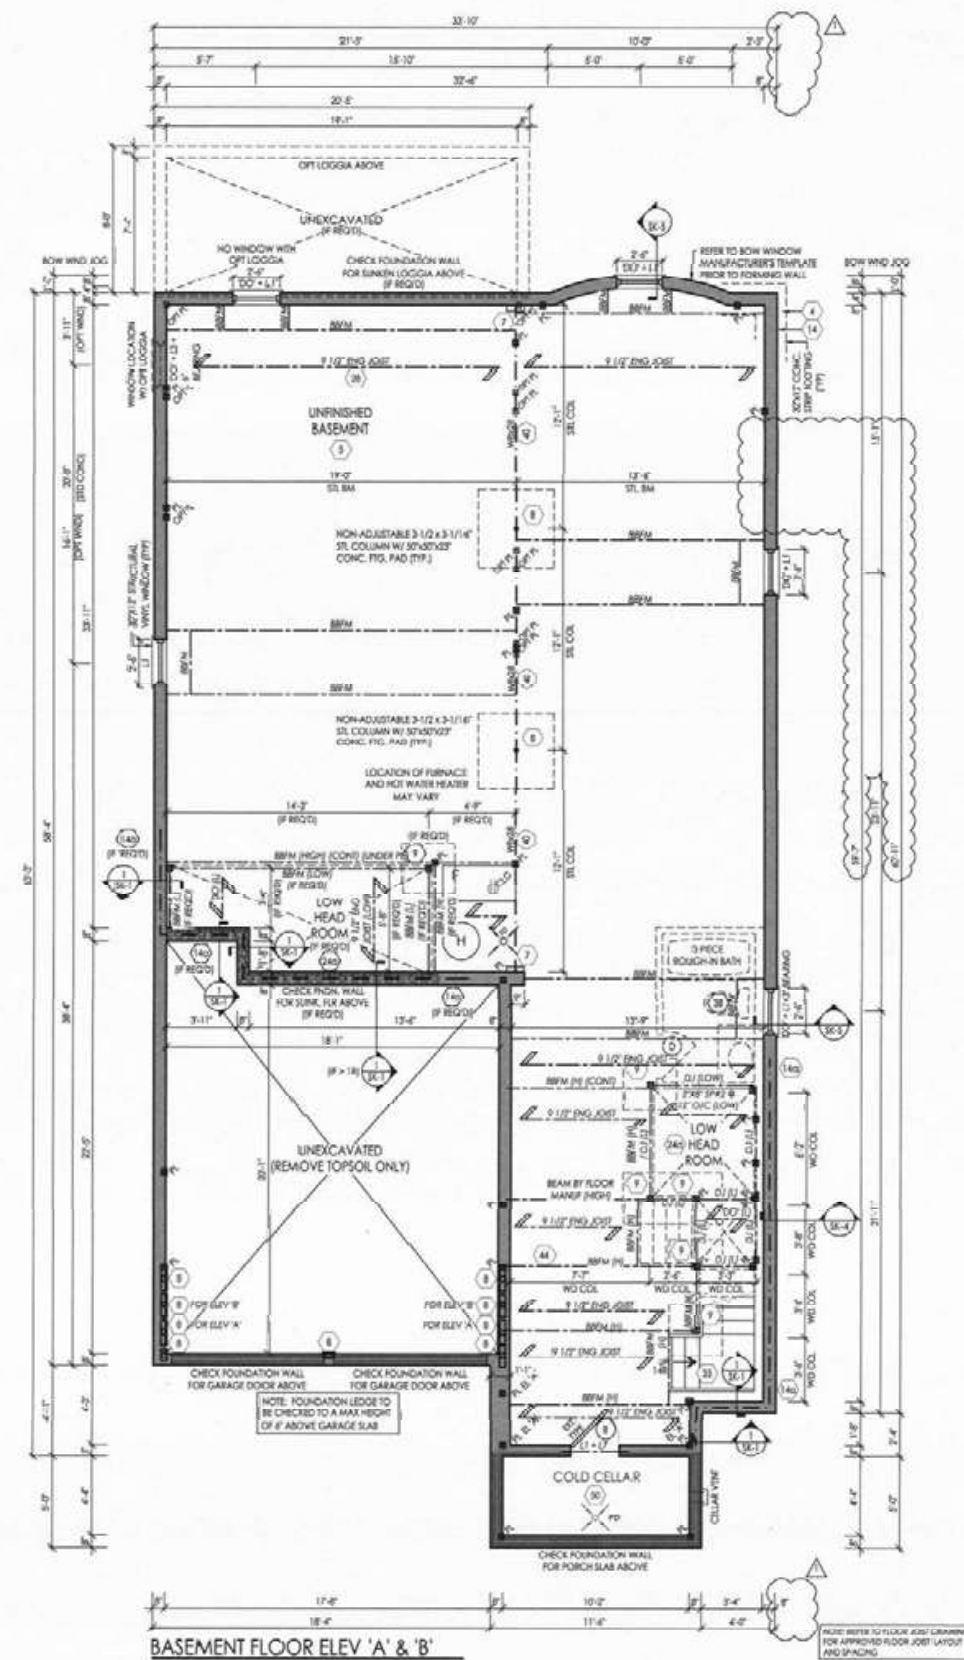

I, ALEX PRINCE, DECLARE THAT I HAVE REVIEWED AND TAKEN
 TECHNICAL RESPONSIBILITY FOR THE DESIGN WORK ON BEHALF
 OF RN DESIGN LTD. UNDER DIVISION 2, PART 3, SUBSECTION 2.2.4
 OF THE BUILDING CODE, I AM QUALIFIED AND THE FIRM IS
 REGISTERED IN THE APPROPRIATE CLASS / CATEGORY.

QUALIFIED DESIGNER SIGN: *[Signature]* 3688
 FIRM SIGN: 10010-4942
 DATE: MAR 17 2017

SIGNATURE



MAR 17 2017

FOR STRUCTURAL ONLY EXCLUDING
 EXCAVATED MOOF, FINISH FLOOR
 AND 5 FLOOR LEVEL, EXCAVATION

It is the builder's complete responsibility to
 ensure that all plans submitted for approval
 fully comply with the Architectural Ordinance
 and all applicable regulations and requirements
 in the jurisdiction. The Council
 Architect is not responsible for any errors or
 omissions or approving any (existing) plans or
 drawings, drawings, or designs, or any other
 building code or permit matter or that any
 other law or regulation may be violated.

This is to certify that these plans comply
 with the applicable Architectural Design
 Ordinance approved by the City of
 Vaughan.
 ARCHITECTURAL REVIEW & APPROVAL
 MAR 17 2017
 John G. Williams, Architect

#	REVISION	DATE	BY	CHK
1	ISSUED FOR CLERK REVIEW	16/03/17	AK	AK
2	REVISED AS PER ARCHITECT'S COMMENTS	16/03/17	AK	AK
3	REVISED AS PER ENGINEERING COMMENTS	16/03/17	AK	AK
4	REVISED AS PER ARCHITECT'S COMMENTS	16/03/17	AK	AK
5	REVISED AS PER CITY COMMENTS	16/03/17	AK	AK
6	ISSUED FOR PERMIT	16/03/17	AK	AK
7				
8				
9				
10				
11				
12				

Client: Gold Park Homes

Project: KLEINBURG GLEN
 PH-2
 VAUGHAN, ON

Model: 42-5

Project #: 14043

Scale: 3/16" = 1'-0"

Sheet: A1

QUALIFIED DESIGNER SIGNATURE: H. R. 30000
DATE: 10/10/2010



FOR STRUCTURAL ONLY EXCLUDING
EXPOSED ROOF TRUSS, FLOOR
JOIST & FLOOR/SLAB FORMWORK

APR 27 2017
John G. Williams Limited, Architect

7			
8			
9			
10			
11			


KLEINBURG GLEN
PH-2
VAUGHAN, ON

14043


SCORE $3/16'' = 1'-0''$

—


A4

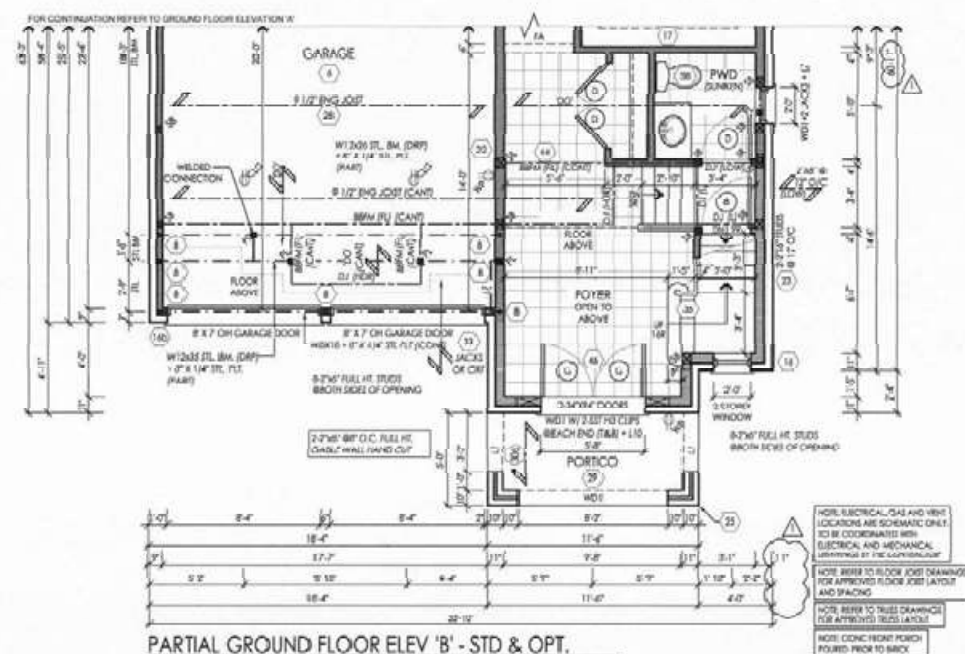



PARTIAL GROUND FLOOR ELEV 'B' - STD & OPT

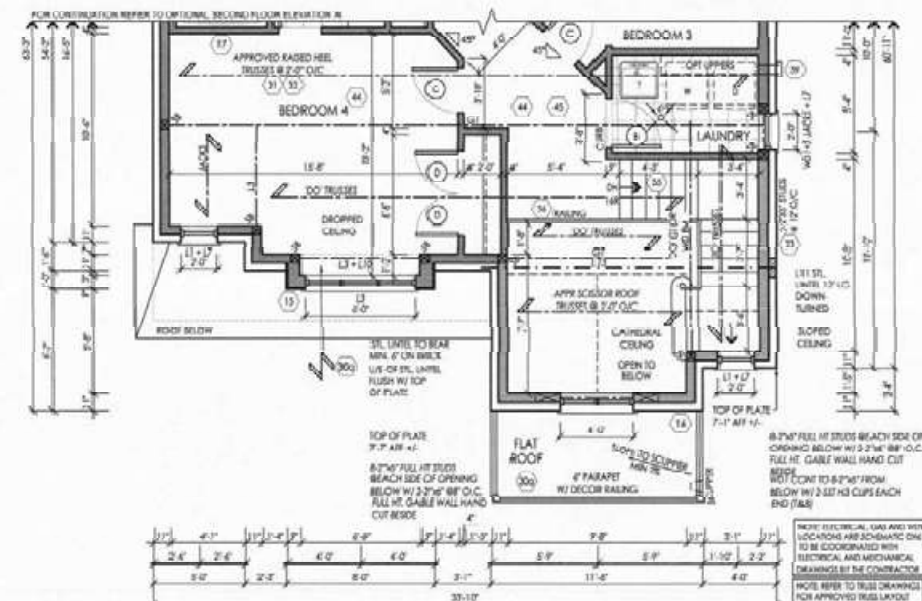

PARTIAL OPT SECOND FLOOR FLEV 'B'
W/ 5 BEDROOMS

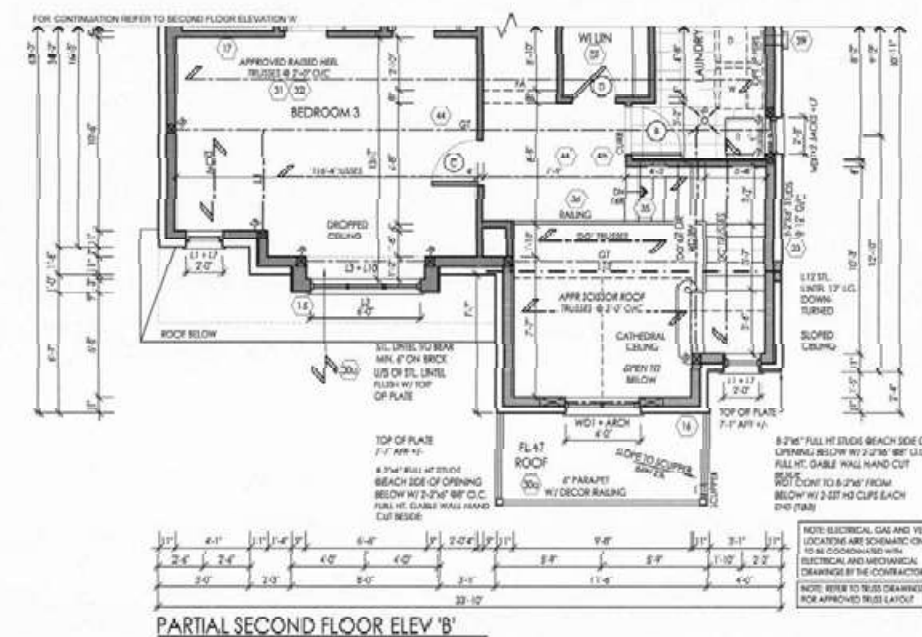

PARTIAL SECOND FLOOR ELEV 'B'

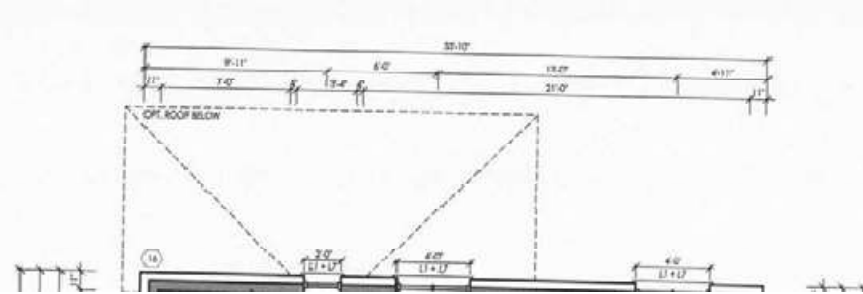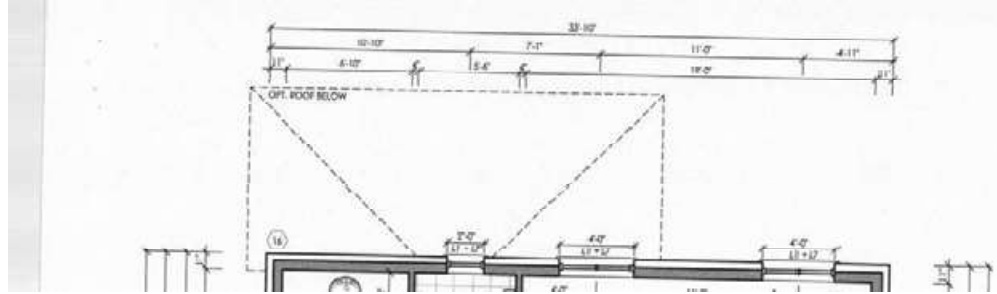

AN design
Imagine • Inspire • Create

