Schedule 1: Designer Information

Use one form for each individual who reviews and takes responsibility for design activities with respect to the project.

A. Project Information						
Building number, street name	Unit no.	Lot/con.				
Municipality East Gwillimbury	Postal code	Plan number/ other descript		JUK		
B. Individual who reviews and t	akes responsibil	ity for design activities				
Name	akes responsibil	Firm				
Eric Schneider		RN Design Limited				
Street address			Unit no.	Lot/con.		
8395 Jane Street			203			
Municipality	Postal code	Province	E-mail			
Vaughan	L4K 5Y2	Ontario	erics@rndesi	gn.com		
Telephone number (905) 738-3177	Fax number	E440	Cell number			
	(905) 738		ada Birdalan C Bad	2 T-1-1- 2 5 2 4		
C. Design activities undertaken by House	HVAC -					
☐ Small Buildings		Services	☐ Building Str☐ Plumbing –			
Large Buildings		on, Lighting and Power		All Buildings		
☐ Complex Buildings	☐ Fire Pro	tection		age Systems		
Description of designer's work Review of the site plan for Lot 30R model BERLIO SD-06 'D' STD door to side yard. Design responsibility excludes						
any structural design and specificati	odel BERLIO SD-0	6 'D' STD door to side yard.	Design responsi	bility excludes		
D. Declaration of Designer	ons outside of the	scope of Fart 9 of the OBC.				
Fric Schneide		declare that	at (choose one as a	appropriate):		
 (print name) I review and take responsibility for the design work on behalf of a firm registered under Division C, Part 3, subsection 3.2.4. of the Building Code. I am qualified, and the firm is registered, in the appropriate classes/categories: 						
Individual BCIN:	30840					
Firm BCIN:	26995					
I review and take responsibility for the design work and am qualified in the appropriate category as an "other designer" under Division C, Part 3, subsection 3.2.5 of the Building Code. Individual BCIN:						
Basis for exemption from registration:						
The design work is exempt Basis for exemption from re I certify that: 1. The information contained in t 2. I have authority to bind the co	egistration and quali	to the best of my knowledge.	ts of the Building C	ode.		
July 13, 2017		Elihal				
July 13, 2017 Date		Signature of D	esigner			

*For the purposes of this form, "individual" means the "person" referred to in Division C, Part 3, Clause 3.2.4.7. (1)(d), Division C, Part 3, Article 3.2.5.1. and all other persons who are exempt from qualification under Division C, Part 3, Subsections 3.2.4. and 3.2.5.


NOTE:

- 1. Firm and Individual BCIN numbers are not required for building permit applications submitted prior to January 1, 2006
- Schedule 1 does not need to be completed by architects, or holders of a Certificate of Practice or a Temporary License under the Architects
 Act

ARCHITECTURAL REVIEW & APPROVAL

JUL 0

John G. Willia

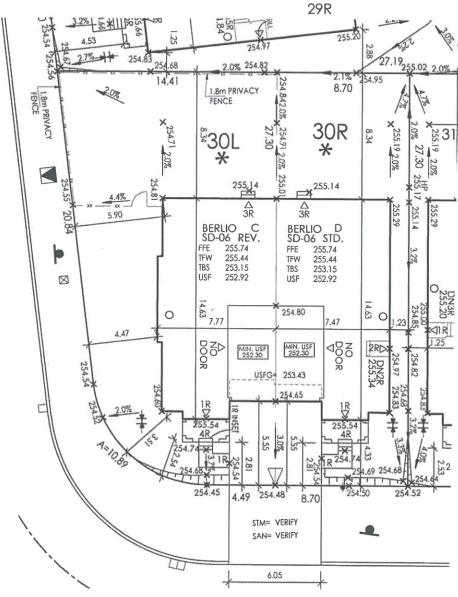

DOLOBRAM TRAIL

J. ORMONDE

100089999

URBANTECH NOTES:

- 1) No final utility location information at this time. Urbantech will not be responsible for future changes to design, Builder should notify purchaser's that street hardware and above ground utilify furniture may be added or removed
- uilder to lower underside of footings where adjacent to RLCB leads, Exact th to be determined on site during footing excavation,
- ilder to stake out driveway curb depressions at time of curb installation.
- 4) Builder to verify location of all hydrants, street lights, transformers and all other services. If min. dimensions are not maintained as per City standards, builder is to relocate at his own expense.
- 5) Builder to confirm service connection elevations and review for absence of conflict prior to footing excavation.
- 6) Final fence design have not been provided at this time. Purchaser to be advised that actual fencing details may not be as shown on this plan.

URBANTECH CONSULTING

We certify that the proposed grades at the lot corners are correct, and that the lot grading of the subject lot is in conformity to the approved subdivision grading plans and City standards.

REVIEWED BY: MW DATE: June 30, 2017

NOVINCE OF ONTARIO

NOTE: BUILDER TO VERIFY LOCATION OF ALL HYDRANTS, STREET LIGHTS, TRANSFORMERS AND OTHER SERVICES. IF MIN. DIMENSIONS ARE NOT MAINTAINED BUILDER IS TO RELOCATE AT HIS OWN EXPENSE

BUILDING STATISTICS REG. PLAN No. ZONE R2E-7.2-2203 LOT NUMBER 301 LOT AREA(m)2 237.5 339.74 BLDG AREA(m)2 N/A N/A N/A LOT COVERAGE(%) N/A No. OF STOREYS MEAN HEIGHT(m) 8.64 8.73 PEAK HEIGHT(m) N/A N/A DECK LINE(m) N/A N/A

FFE	FINISHED FLOOR .	\boxtimes	BELL PEDESTAL			
TFW	TOP OF FOUNDATION		CABLE PEDESTAL			
TBS	TOP OF BASEMENT SLAB	上	CATCH BASIN			
		щ	DBL. CATCH BASIN			
USF	UNDER SIDE FOOTING	*	ENGINEERED FILL			
USFR	UNDER SIDE FOOTING @ REAR		HYDRO CONNECTION			
USFG	UNDER SIDE FOOTING @	Ŷ	FIRE HYDRANT			
TEF	TOP OF ENGINEERED	SL	STREET LIGHT			
163	FILL	\boxtimes	MAIL BOX			
R	NUMBER OF RISERS TO GRADE	1	TRANSFORMER			
WOD	WALKOUT DECK	∇	SEWER CONNECTIONS 2 LOTS			
LOB	LOOKOUT BASEMENT	7	SEWER CONNECTIONS I			
WOB	WALK OUT BASEMENT	+	WATER CONNECTION			
REV	REVERSE PLAN STANDARD PLAN	0	WATER VALVE CHAMBER			
Δ	DOOR PLAN	\$	HYDRANT AND VALVE			
0	WINDOW	B	HYDRO METER			
DA	AIR CONDITIONING	•	GAS METER			
□	DOWN SPOUT TO	0	MANHOLE - STORM			
-	SPLASH PAD SWALE DIRECTION		MANHOLE - SANITARY			
SP	SUMP PUMP					
CHAINLINK FENCE						
	XX					
	XXX——— SOUND BARRIER					
			TO BE EXTENDED			
			MIN) BELOW GRADE			
		CONTRACTOR OF THE PERSON				

NO.	DESCRIPTION	DATE	DWN	CHK
1.	ISSUED FOR REVIEW	MAY 29/17	***	ES
2.	REVISED PER ENG COMM - FINAL	JUNE 27/17	ET	ES



RN DESIGN LTD.

8395 JANE STREET, SUITE 203 VAUGHAN, ONTARIO. L4K 5Y2 T:905-738-3177 | F: 905-738-5449

I, ERIC SCHNEIDER DECLARE THAT I HAVE REVIEWED AND

<u>Fric Schneider</u> declare that I have reviewed and take design responsibility for the design work on behalf of RN Design Limited under subsection 3.2.4 of the Building Code. I am qualified, and the firm is registered, in the appropriate

class/categories.
QUALIFIED DESIGNER BCIN 30840
FIRM BCIN 26995

GOLD PARK HOMES

PROJECT/LOCATION

MCLAUGHLIN AND MAYFIELD-PH2 BRAMPTON, ON

SITE PLAN

DRAWN BY	SCALE
ET	1:250
PROJECT No.	LOT NUMBER
13098-PH-2	LOT 30R & 30L