

**Brampton Encore - 17L - 2 - 28-8 Elev.A Beethoven**

**Exterior Colours**

Inv.1,619	1 - EXTERIOR COLOUR PACKAGE # 4
Line24584	Note:
19Oct17 / 31Oct17	

**FRAMING**

Inv.1,619	1 - MAIN FLOOR: EXTENDED HEIGHT ARCHWAY (PRICE PER DOORWAY) -96"
Line24582	Note:
19Oct17 / 31Oct17	

Inv.1,619	1 - MAIN FLOOR: STANDARD DOOR EXTENDED HEIGHT 96" (PRICE PER DOOR)- GROUND FLOOR 2 STOREY MODELS
Line24583	Note:
19Oct17 / 31Oct17	

Inv.1,619	1 - MANDOOR- GARAGE TO HOUSE- GRADE PERMITS
Line24586	Note:
19Oct17 / 31Oct17	

**INTERIOR TRIM AND DOORS**

Inv.1,619	4 - MAIN FLOOR: STANDARD DOOR EXTENDED HEIGHT 96" (PRICE PER DOOR)- GROUND FLOOR 2 STOREY MODELS
Line24439	Note:
19Oct17 / 31Oct17	

Inv.1,619	4 - MAIN FLOOR: EXTENDED HEIGHT ARCHWAY (PRICE PER DOORWAY) -96"
Line24438	Note:
19Oct17 / 31Oct17	

**MISC.**

Inv.1,619	1 - Purchasers are aware & accepts that ANY changes made to upgrades after signing this Purchasers Extra Form are subject to a minimum administration fee of \$500. PLUS a 10% holdback fee.
Line24441	Note:
19Oct17 / 31Oct17	





Inv.1,619	1 - Purchaser has attended a Structural appointment at the Decor Centre & has DECLINED any additional upgrades and accepts and acknowledges that there will be no further structural changes/additions/deletions to be made upon signing on October 19, 2017.
Line24440	Note:
19Oct17 / 31Oct17	

Inv.1,619	1 - BONUS PACKAGE: \$5,000.00 (INCLUDING TAXES) WORTH OF UPGRADES FROM GOLD PARK HOMES DÉCOR CENTRE IS BEING APPLIED TOWARD THE STRUCTURAL APPOINTMENT. PURCHASER HAS A REMAINING AMOUNT OF \$1836.00 (INCLUDING TAXES) TO BE USED TOWARD THE COLOUR APPOINTMENT.
Line24442	Note:
19Oct17 / 31Oct17	

**WINDOWS AND DOORS**

Inv.1,619	1 - MANDOOR- GARAGE TO HOUSE- GRADE PERMITS
Line24585	Note:
19Oct17 / 31Oct17	
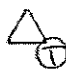
# LEGEND

-  PHONE
-  CABLE
-  96" ARCH
-  96" DOOR

encore  
BRAMPTON




BE2-17L

OCT. 19 2017



## The Beethoven SEMI SERIES

- Elevation A • 2,372 sq.ft.
- Elevation B • 2,372 sq.ft.
- Elevation C • 2,372 sq.ft.
- Elevation D • 2,372 sq.ft.

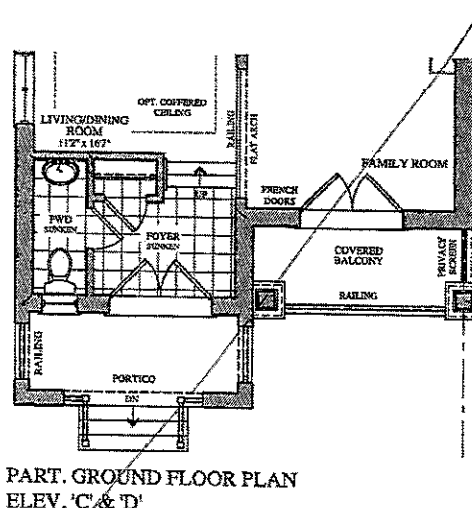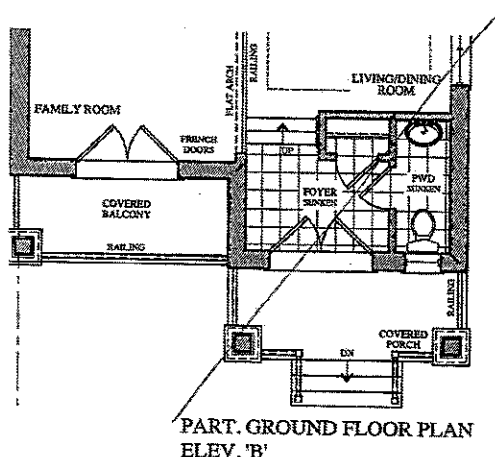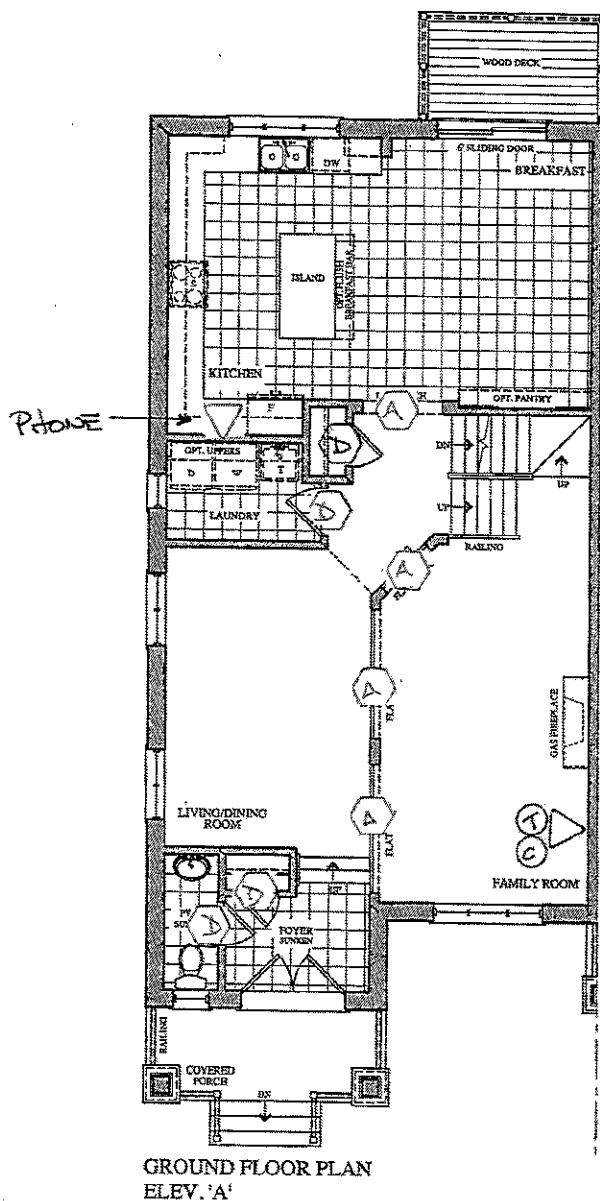

Prices, figures, illustrations, sizes, features and finishes are subject to change without notice. Areas and dimensions are approximate and actual usable floor space may vary from the stated area. Layout may be reverse of the unit purchased. E. & O.E.




GOLDPARK  
WORTH MORE™

encore  
BRAMPTON

BE2-17L  
Oct. 19 2017

The  
**Beethoven**  
SEMI SERIES

- Elevation A • 2,372 sq.ft.
- Elevation B • 2,372 sq.ft.
- Elevation C • 2,372 sq.ft.
- Elevation D • 2,372 sq.ft.

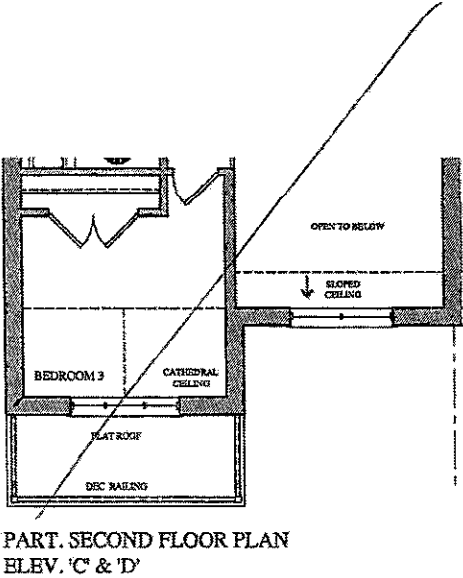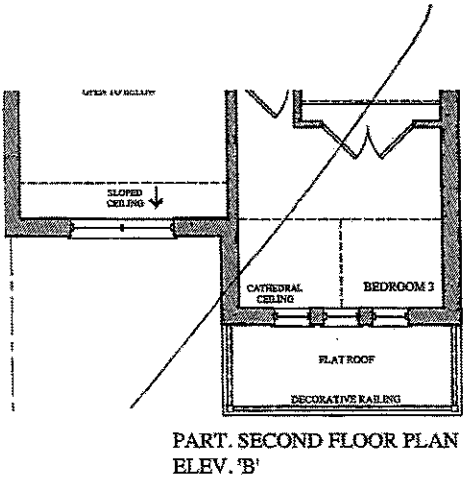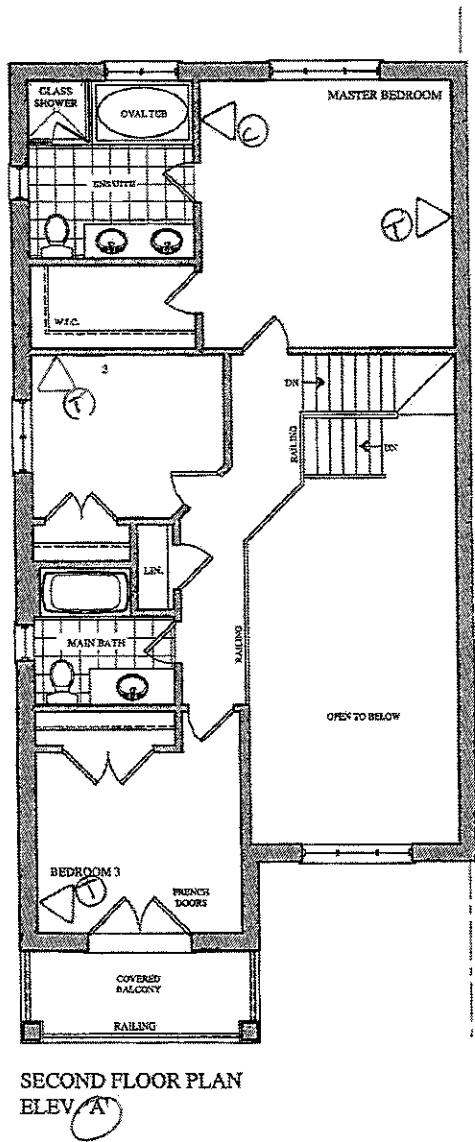

Prices, figures, illustrations, sizes, features and finishes are subject to change without notice. Areas and dimensions are approximate and actual usable floor space may vary from the stated area. Layout may be reverse of the unit purchased. E. & O.E.


**GOLDPARK**  
WORTH MORE™

encore  
BRAMPTON

BE2-17L (B)  
Oct 19 2017

The  
**Beethoven**  
SEMI SERIES

→ Elevation A • 2,372 sq.ft.  
Elevation B • 2,372 sq.ft.  
Elevation C • 2,372 sq.ft.  
Elevation D • 2,372 sq.ft.

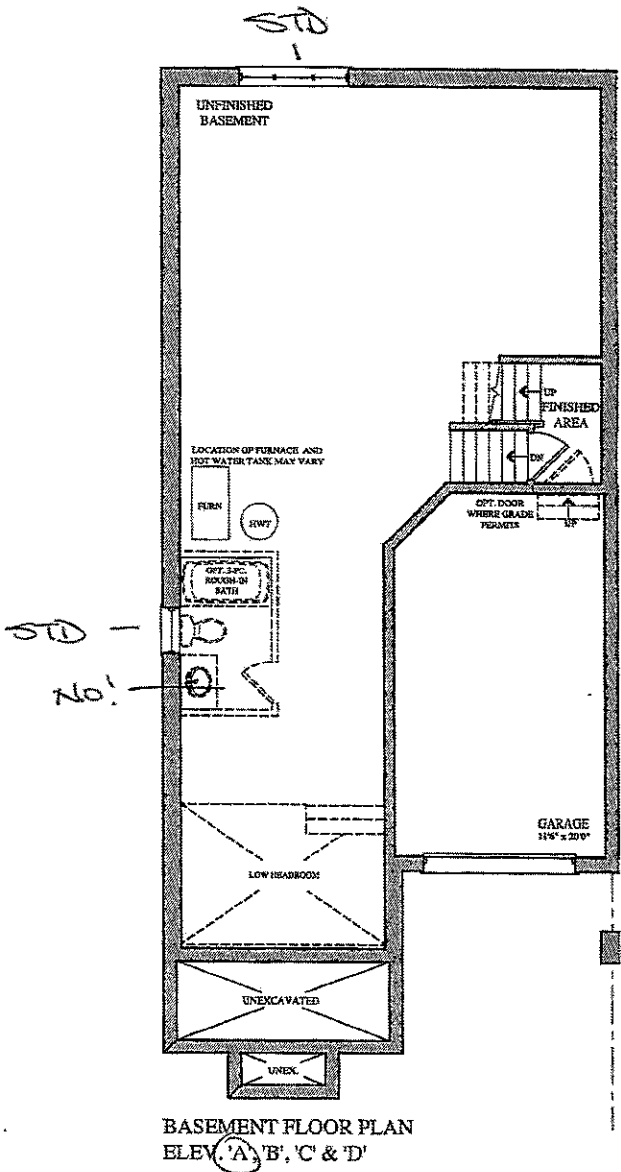

Prices, figures, illustrations, sizes, features and finishes are subject to change without notice. Areas and dimensions are approximate and actual usable floor space may vary from the stated area. Layout may be reverse of the unit purchased. E. & O.E.