

Brampton Encore - 40R - 2 - 28-2 Elev.CR SIREN

CONCRETE AND DRAIN

Inv.1,469	1 - ROUGH-IN - 3PC BASEMENT ROUGH-IN
Line22907	Note:
29Jun17 / 20Nov17	
Inv.1,469	1 - BACK-FLOW PREVENTER VALVE
Line22912	Note:
29Jun17 / 20Nov17	

Exterior Colours

Inv.1,469	1 - EXTERIOR COLOUR PACKAGE 1
Line24712	Note:
29Jun17 / 20Nov17	

MISC.

Inv.1,469	1 - REFUND- SIDE DOOR- HOME TO EXTERIOR- AS PER PLAN AND GRADE PERMITTING- GRADE DOESN'T PERMIT
Line22908	Note:
29Jun17 / 20Nov17	
Inv.1,469	1 - Purchaser has attended an appointment at the Decor Centre & has DECLINED any additional upgrades and accepts and acknowledges that there will be no further changes/additions/deletions to be made upon signing on June 29 2017.
Line22909	Note:
29Jun17 / 20Nov17	
Inv.1,469	1 - Purchasers are aware & accepts that ANY changes made to upgrades after signing this Purchasers Extra Form are subject to a minimum administration fee of \$500. PLUS a 10% holdback fee.
Line22910	Note:
29Jun17 / 20Nov17	
Inv.1,469	1 - BONUS PACKAGE: \$5,000.00 (INCLUDING TAXES) WORTH OF UPGRADES FROM GOLD PARK HOMES DÉCOR CENTRE IS BEING APPLIED TOWARD THE STRUCTURAL APPOINTMENT. PURCHASER HAS A REMAINING AMOUNT OF \$00 (INCLUDING TAXES) TO BE USED TOWARD THE COLOUR APPOINTMENT.
Line22911	Note:
29Jun17 / 20Nov17	

WINDOWS - BASEMENT


Inv.1,469	2 - BASEMENT WINDOWS - UPGRADE EXISTING BASEMENT WINDOW TO 30 INCH X 24 INCH - MAY REQUIRE INSTALLATION OF WINDOW WELL
Line22906	Note:
29Jun17 / 20Nov17	

BE2-40R (82)
JUNE 29 2017

The Siren

SEMI SERIES


Elevation A • 1,688 sq.ft.
Elevation B • 1,677 sq.ft.
→ Elevation C • 1,687 sq.ft.

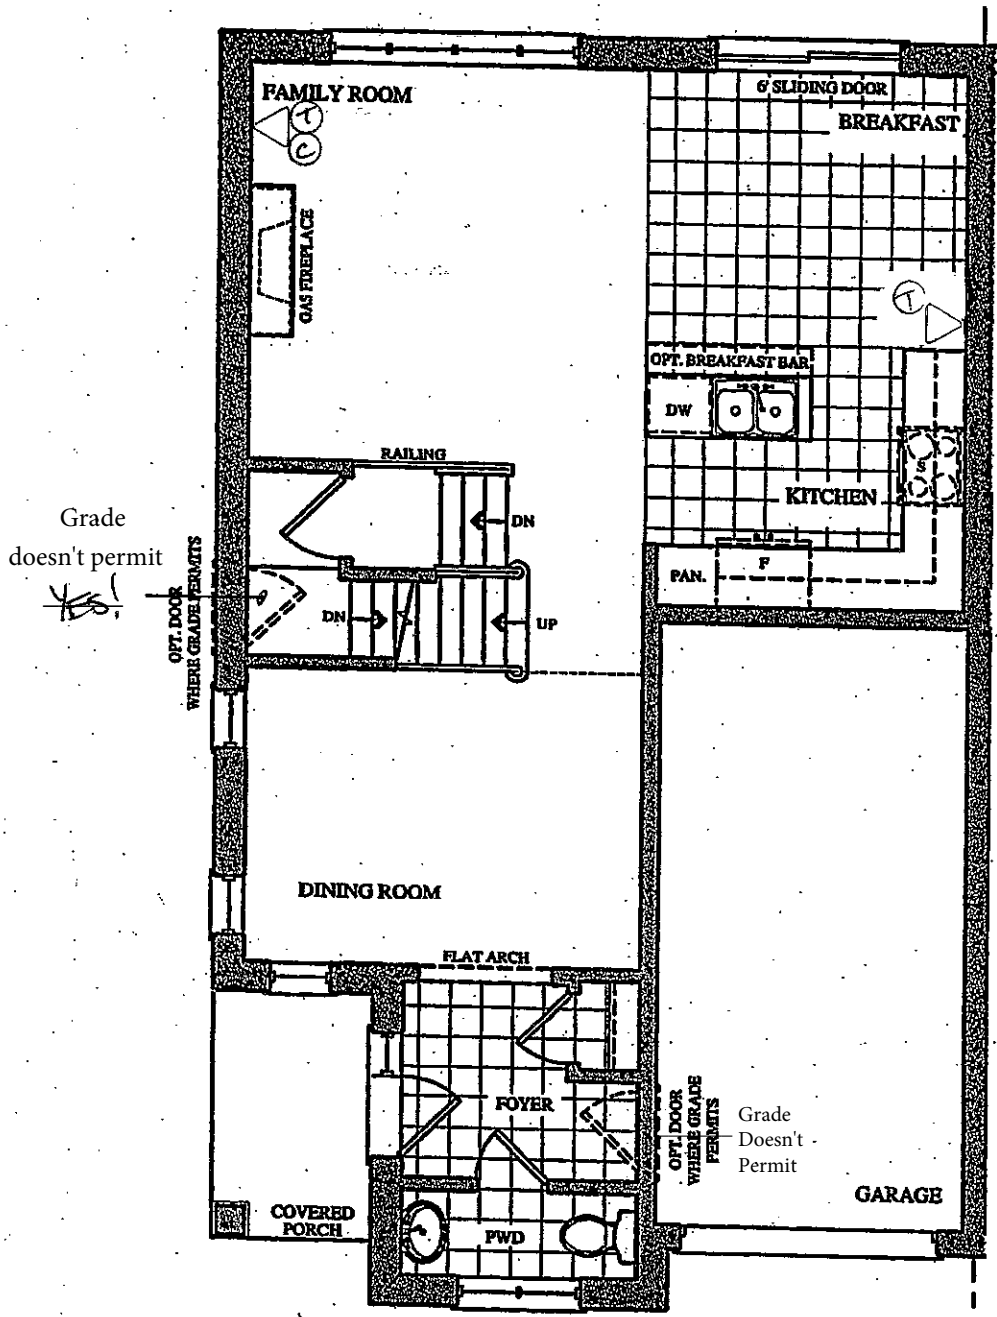


GROUND FLOOR PLAN
ELEV. 'A' & 'B'

LEGEND

- △① PHONE
- △② CABLE

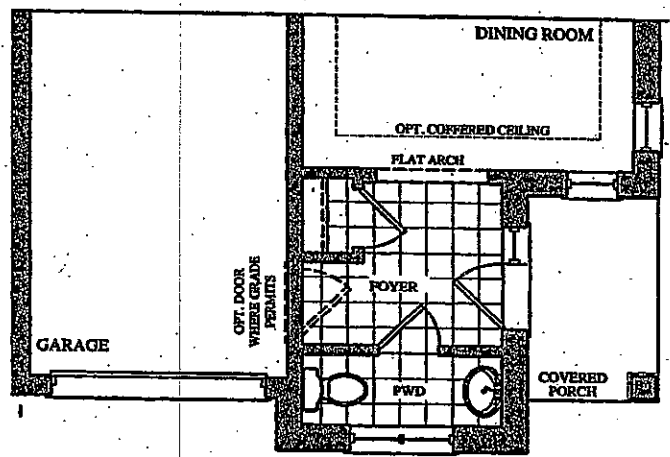


PART. GROUND FLOOR PLAN
ELEV. 'C'


BE2 402 
JUNE 29 2017

The Siren SEMI SERIES


Elevation A • 1,688 sq.ft.
Elevation B • 1,677 sq.ft.
Elevation C • 1,687 sq.ft.

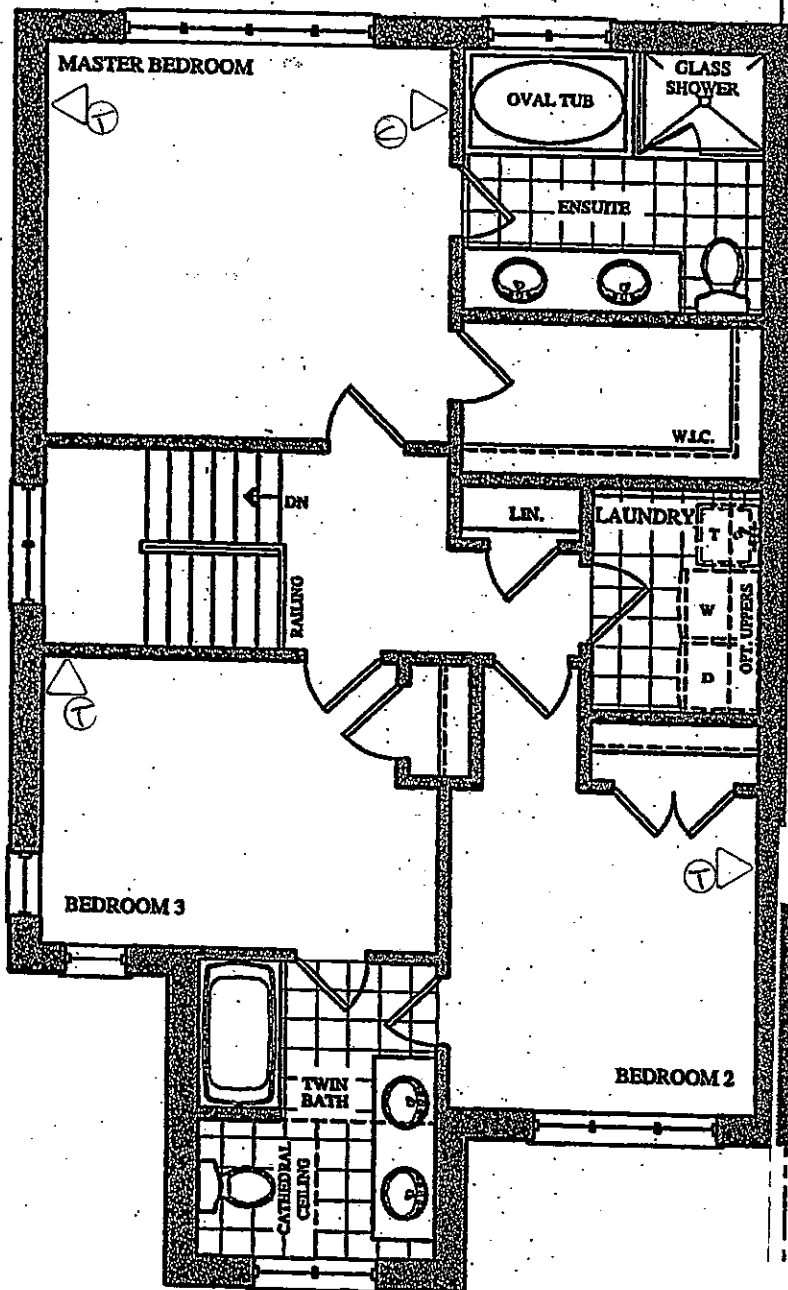

~~SECOND FLOOR PLAN
ELEV. 'A'~~

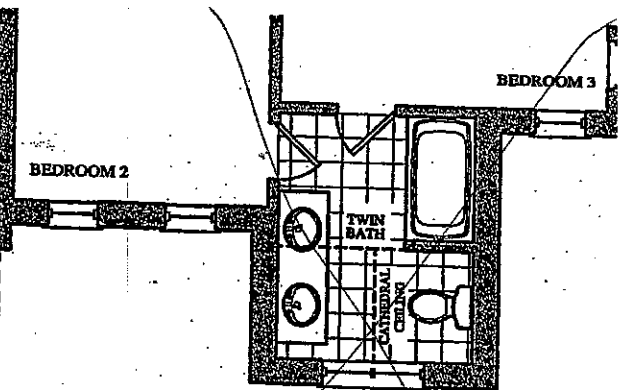

~~PART. SECOND FLOOR PLAN
ELEV. 'B'~~

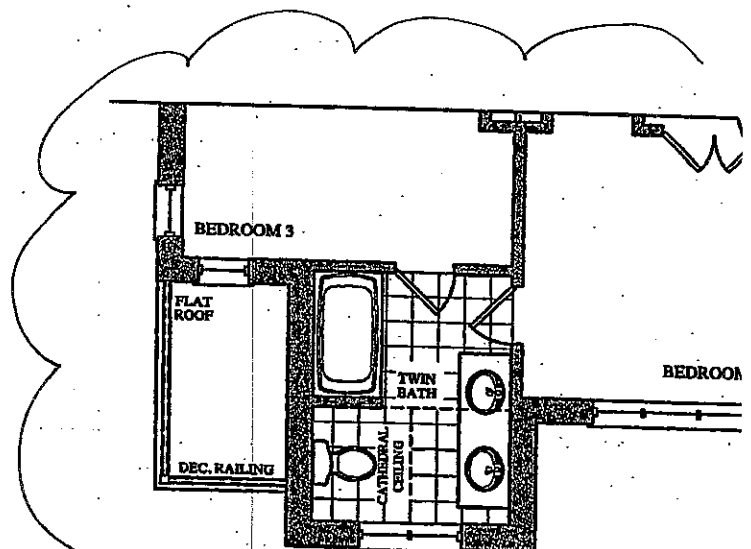

PART. SECOND FLOOR PLAN
ELEV. 'C'

BEZ-40R

JUNE 29 2017



The Siren

SEMI SERIES

Elevation A • 1,688 sq.ft.
Elevation B • 1,677 sq.ft.
→ Elevation C • 1,687 sq.ft.

